

INDEX TO DRAWINGS	
SHEET NO.	DESCRIPTION
1	TITLE SHEET
2	STANDARD PLANS SUMMARY
3	GENERAL NOTES
4	LEGEND
5	CONSTRUCTION NOTES WITHIN COUNTY RIGHT-OF-WAY
6 – 7	WATER POLLUTION AND EROSION CONTROL NOTES
8 – 12	TYPICAL SECTIONS
13	PAVEMENT DETAILS
14	MISCELLANEOUS DETAILS
15 – 17	ROADWAY PLAN
18 – 19	PORTABLE CONCRETE BARRIER
20	PAVEMENT MARKING LEGEND, DETAILS AND NOTES
21 – 23	PAVEMENT MARKING AND TRAFFIC SIGNING PLAN
24 – 26	STRIPING PLAN AT INTERSECTIONS
27	DETECTABLE WARNING PLAN AND DETAILS
28 – 30	LOOP DETECTOR PLAN
31	LOOP DETECTOR DETAILS
32	LOW SPEED UNDIVIDED HIGHWAY WORK ZONE SAFETY PLAN, NOTES AND DETAILS
33	TRAFFIC CONTROL PLAN WITHIN COUNTY RIGHT-OF-WAY

STATE OF HAWAII

DEPARTMENT OF TRANSPORTATION

HIGHWAYS DIVISION

HONOLULU, HAWAII

"AS-BUILT"

PLANS FOR



KAPULE HIGHWAY RESURFACING

RICE STREET TO AHUKINI ROAD

PROJECT NO. 51B-01-08M

DISTRICT OF LIHUE
ISLAND OF KAUAI

FED. ROAD DIST. NO.	STATE	PROJ. NO.	FISCAL YEAR	SHEET NO.	TOTAL SHEET
HAWAII	HAW.	51B-01-08M	2008	1	33

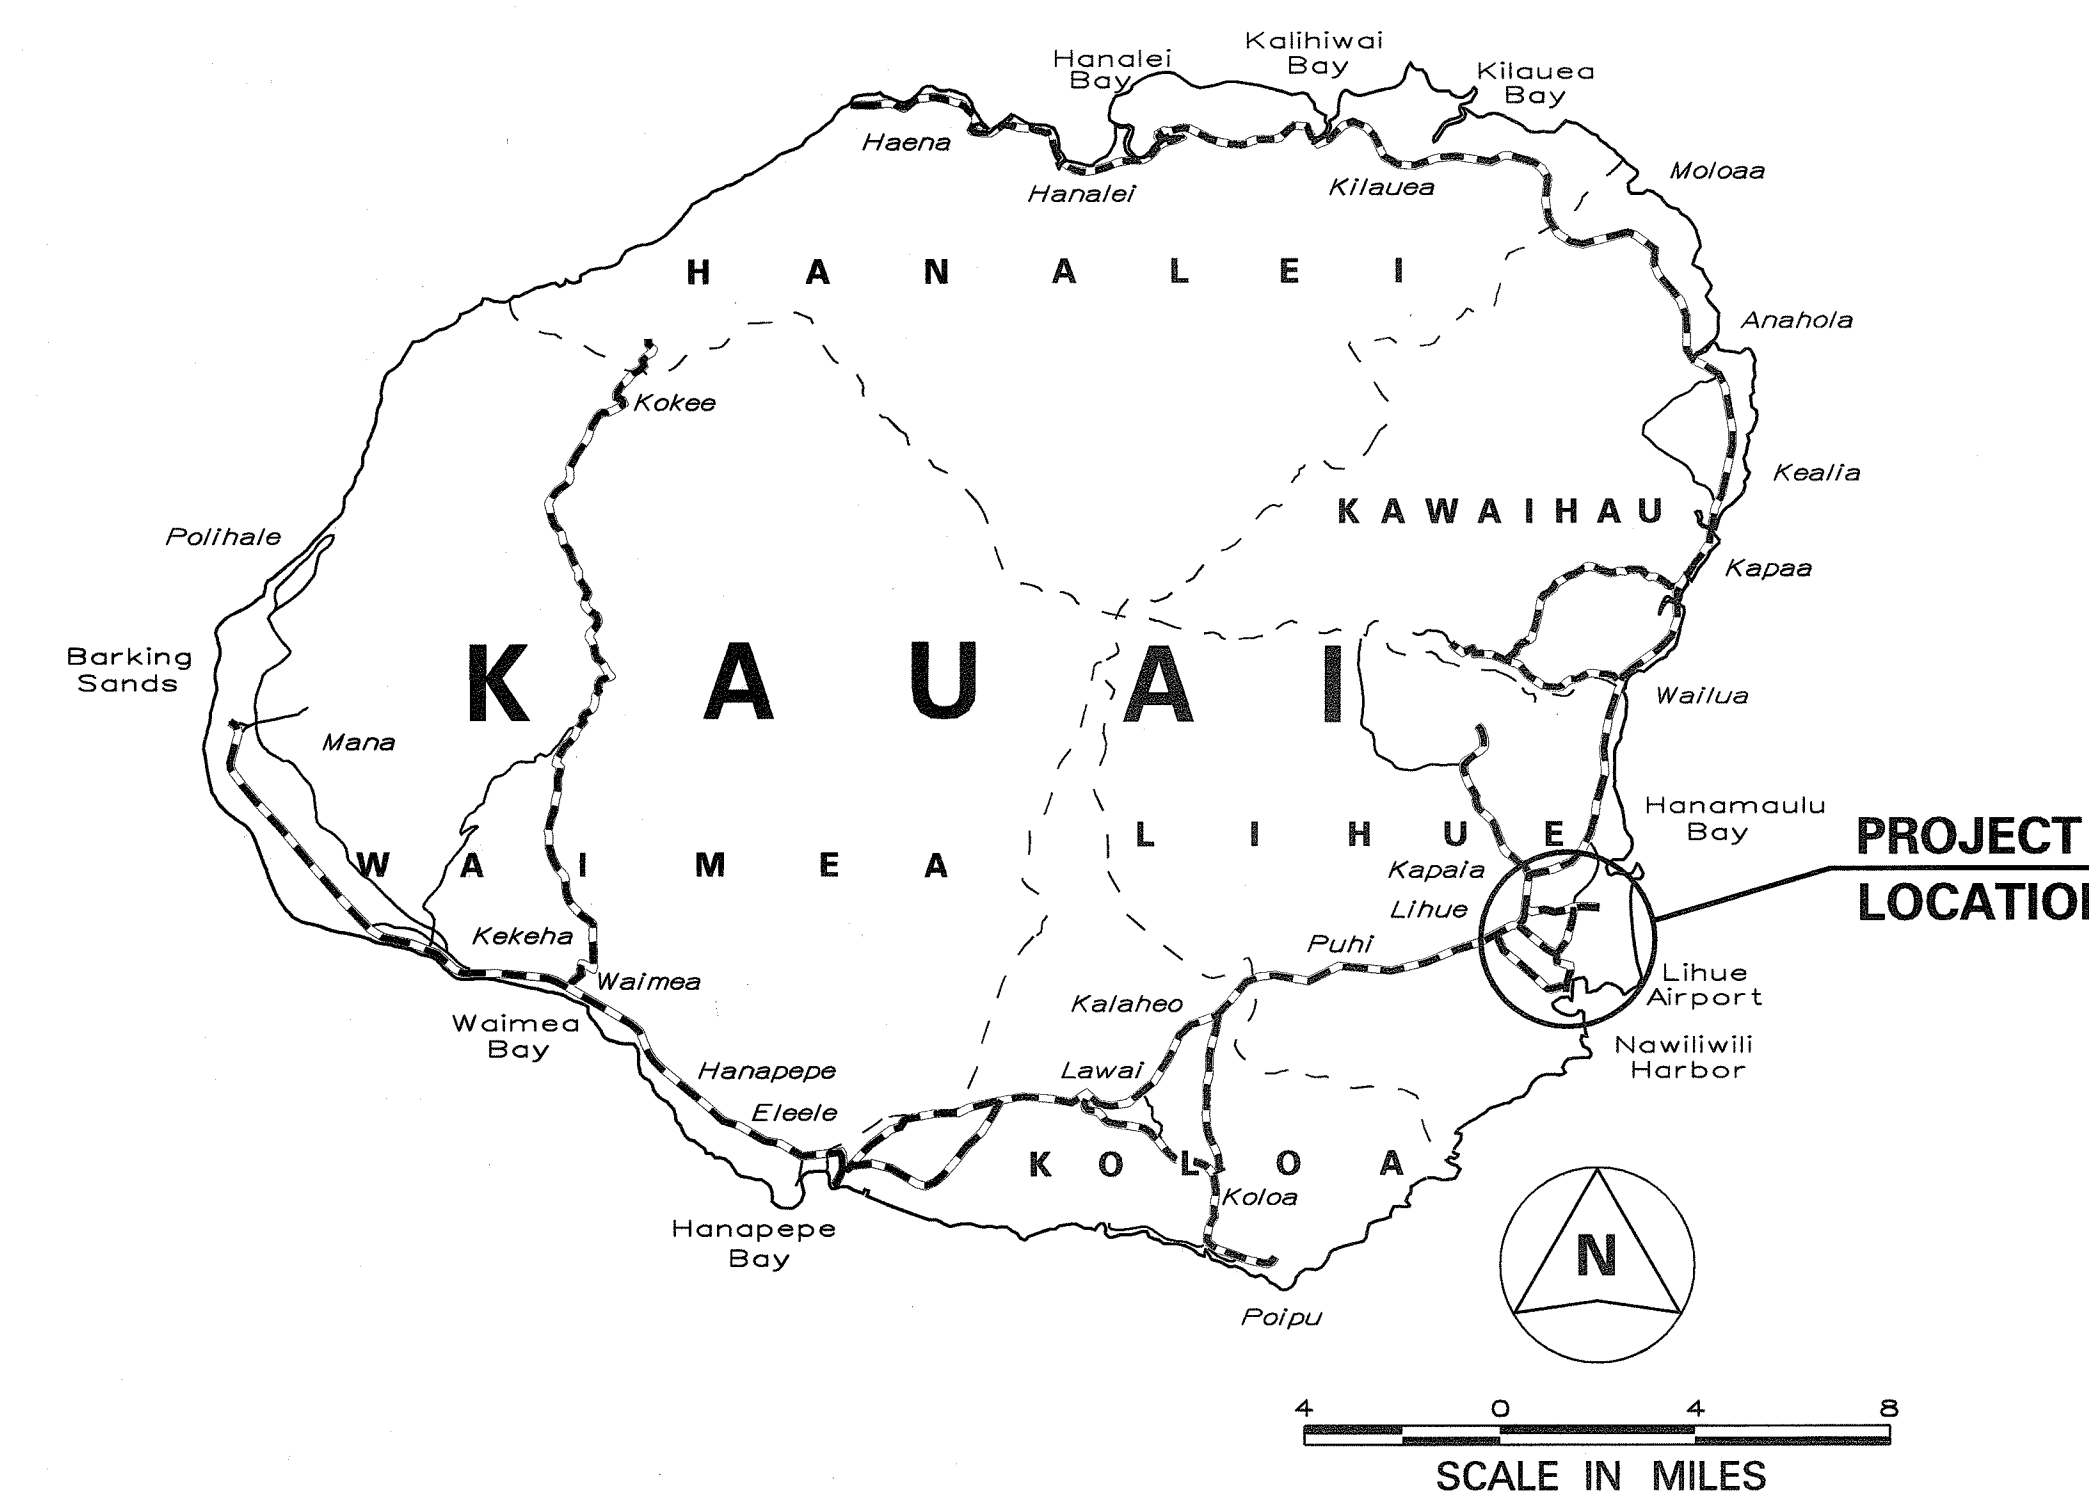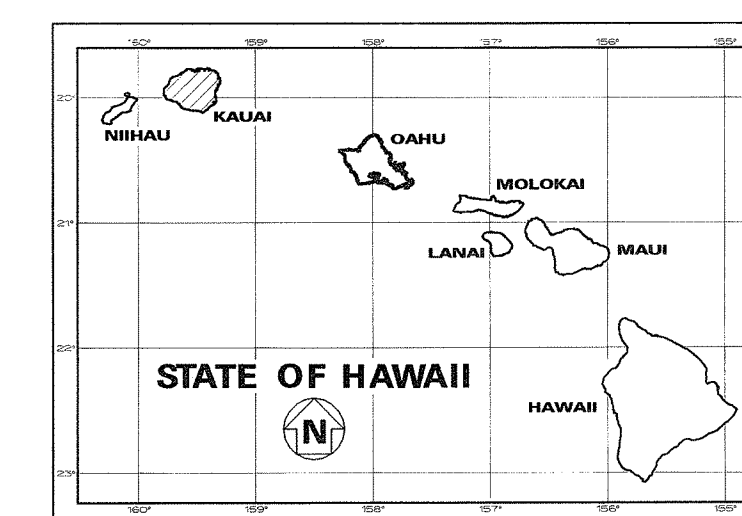

 FEDERAL AID PROJECTS PREVIOUSLY CONSTRUCTED
OR UNDER CONSTRUCTION

MILE POST 1.00 TO MILE POST 1.95

CHANGES MADE DURING CONSTRUCTION WERE INCORPORATED IN THESE PLANS EXCEPT CHANGES IN THE ORIGINAL THEORETICAL QUANTITIES. ACTUAL QUANTITIES, REFER TO PROJECT LOG AND/OR CONSTRUCTION DRAW.

3/14/11

DEPARTMENT OF TRANSPORTATION
STATE OF HAWAII

APPROVED: for Dora M. Gami 4.24.08
DIR. OF TRANSPORTATION DATE