
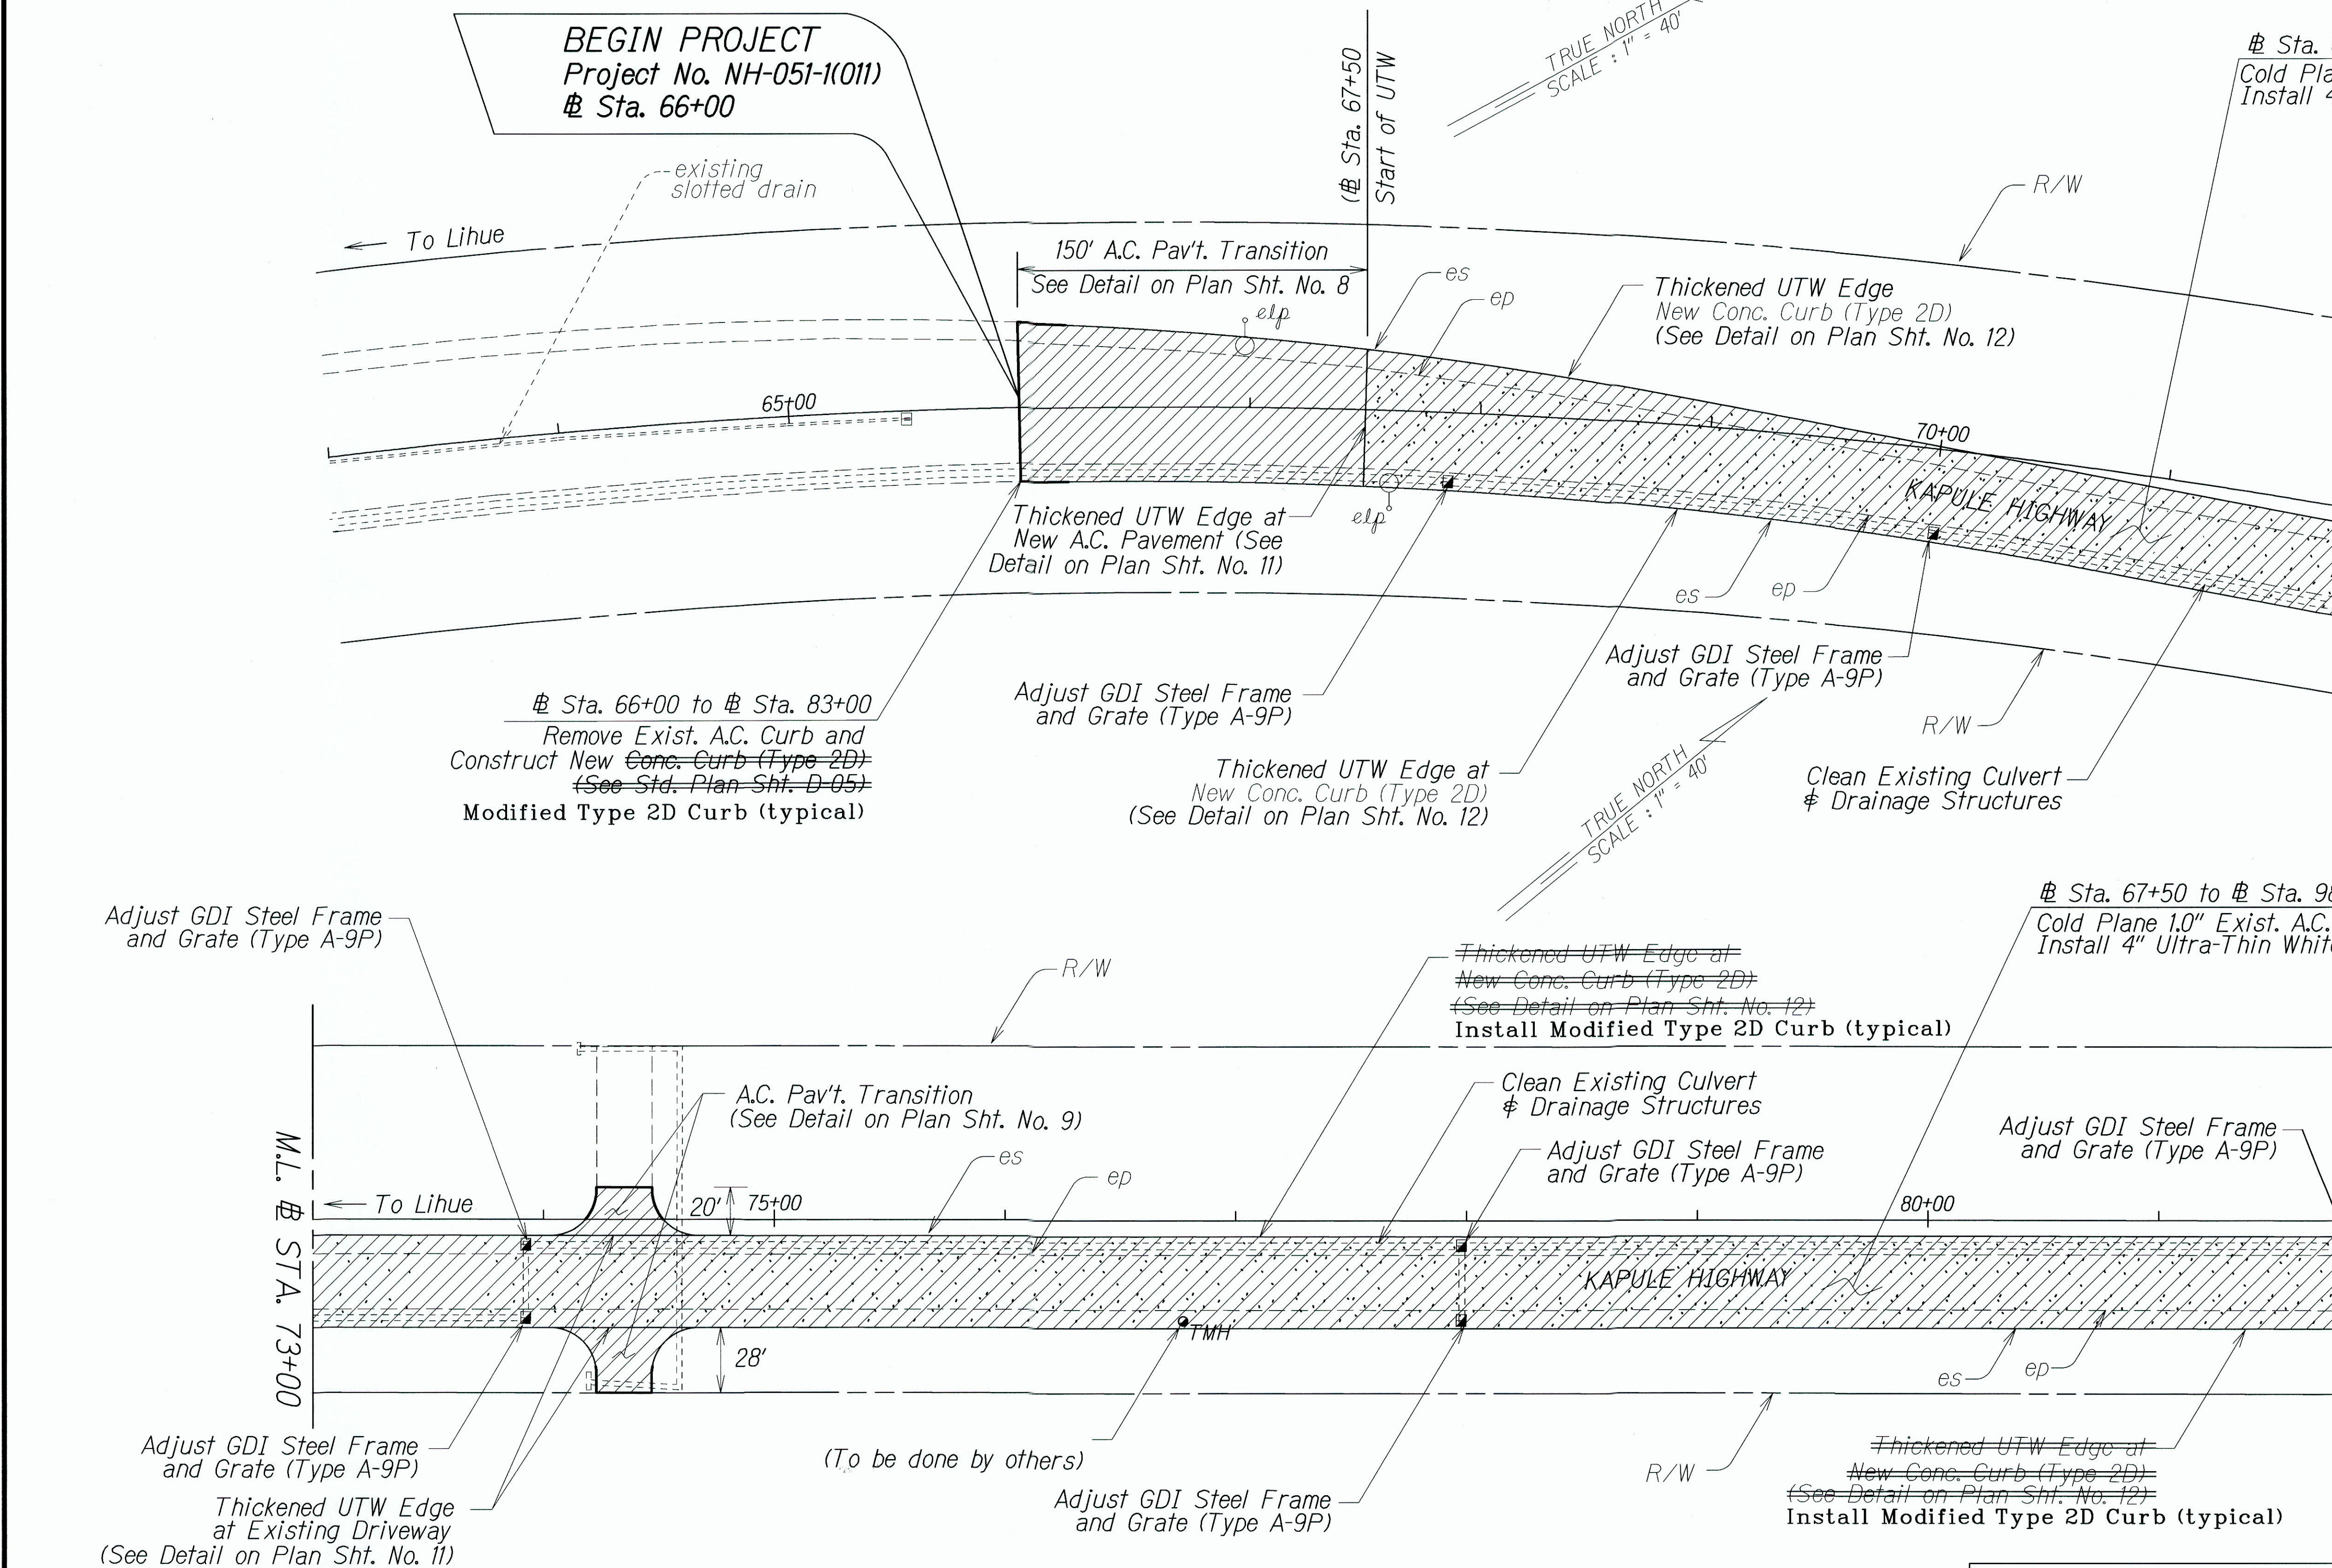 




A. 73+00
 Adjust GDI Steel Frame and Grate (Type A-9P)
 Thickened UTW Edge at Existing Driveway (See Detail on Plan Sht. No. 11)
 28'
 T.M.H.
 (To be done by others)
 Adjust GDI Steel Frame and Grate (Type A-9P)
 R/W
 Thickened UTW Edge at Existing Driveway (See Detail on Plan Sht. No. 11)
 Install Modified Type 2D Curb (typical)
 KAPULE HIGHWAY
 es
 ep
LEGEND FOR AS-BUILT POSTINGS
 Squiggly line for as-built deletion
 Double line for as-built deletion

ROADWAY PLAN


KAPULE HIGHWAY RESURFACING
Ahukini Road to Kuhio Highway
Fed-Aid Proj. No. NH-051-1(011)

Scale: 1" = 40' Date: April 2011

SHEET No. 1 OF 4 SHEETS

13


FED. ROAD DIST. NO.	STATE	FED-AID PROJ. NO.	FISCAL YEAR	SHEET NO.	TOTAL SHEETS
HAWAII	HAW.	NH-051-1(011)	2011	14	25

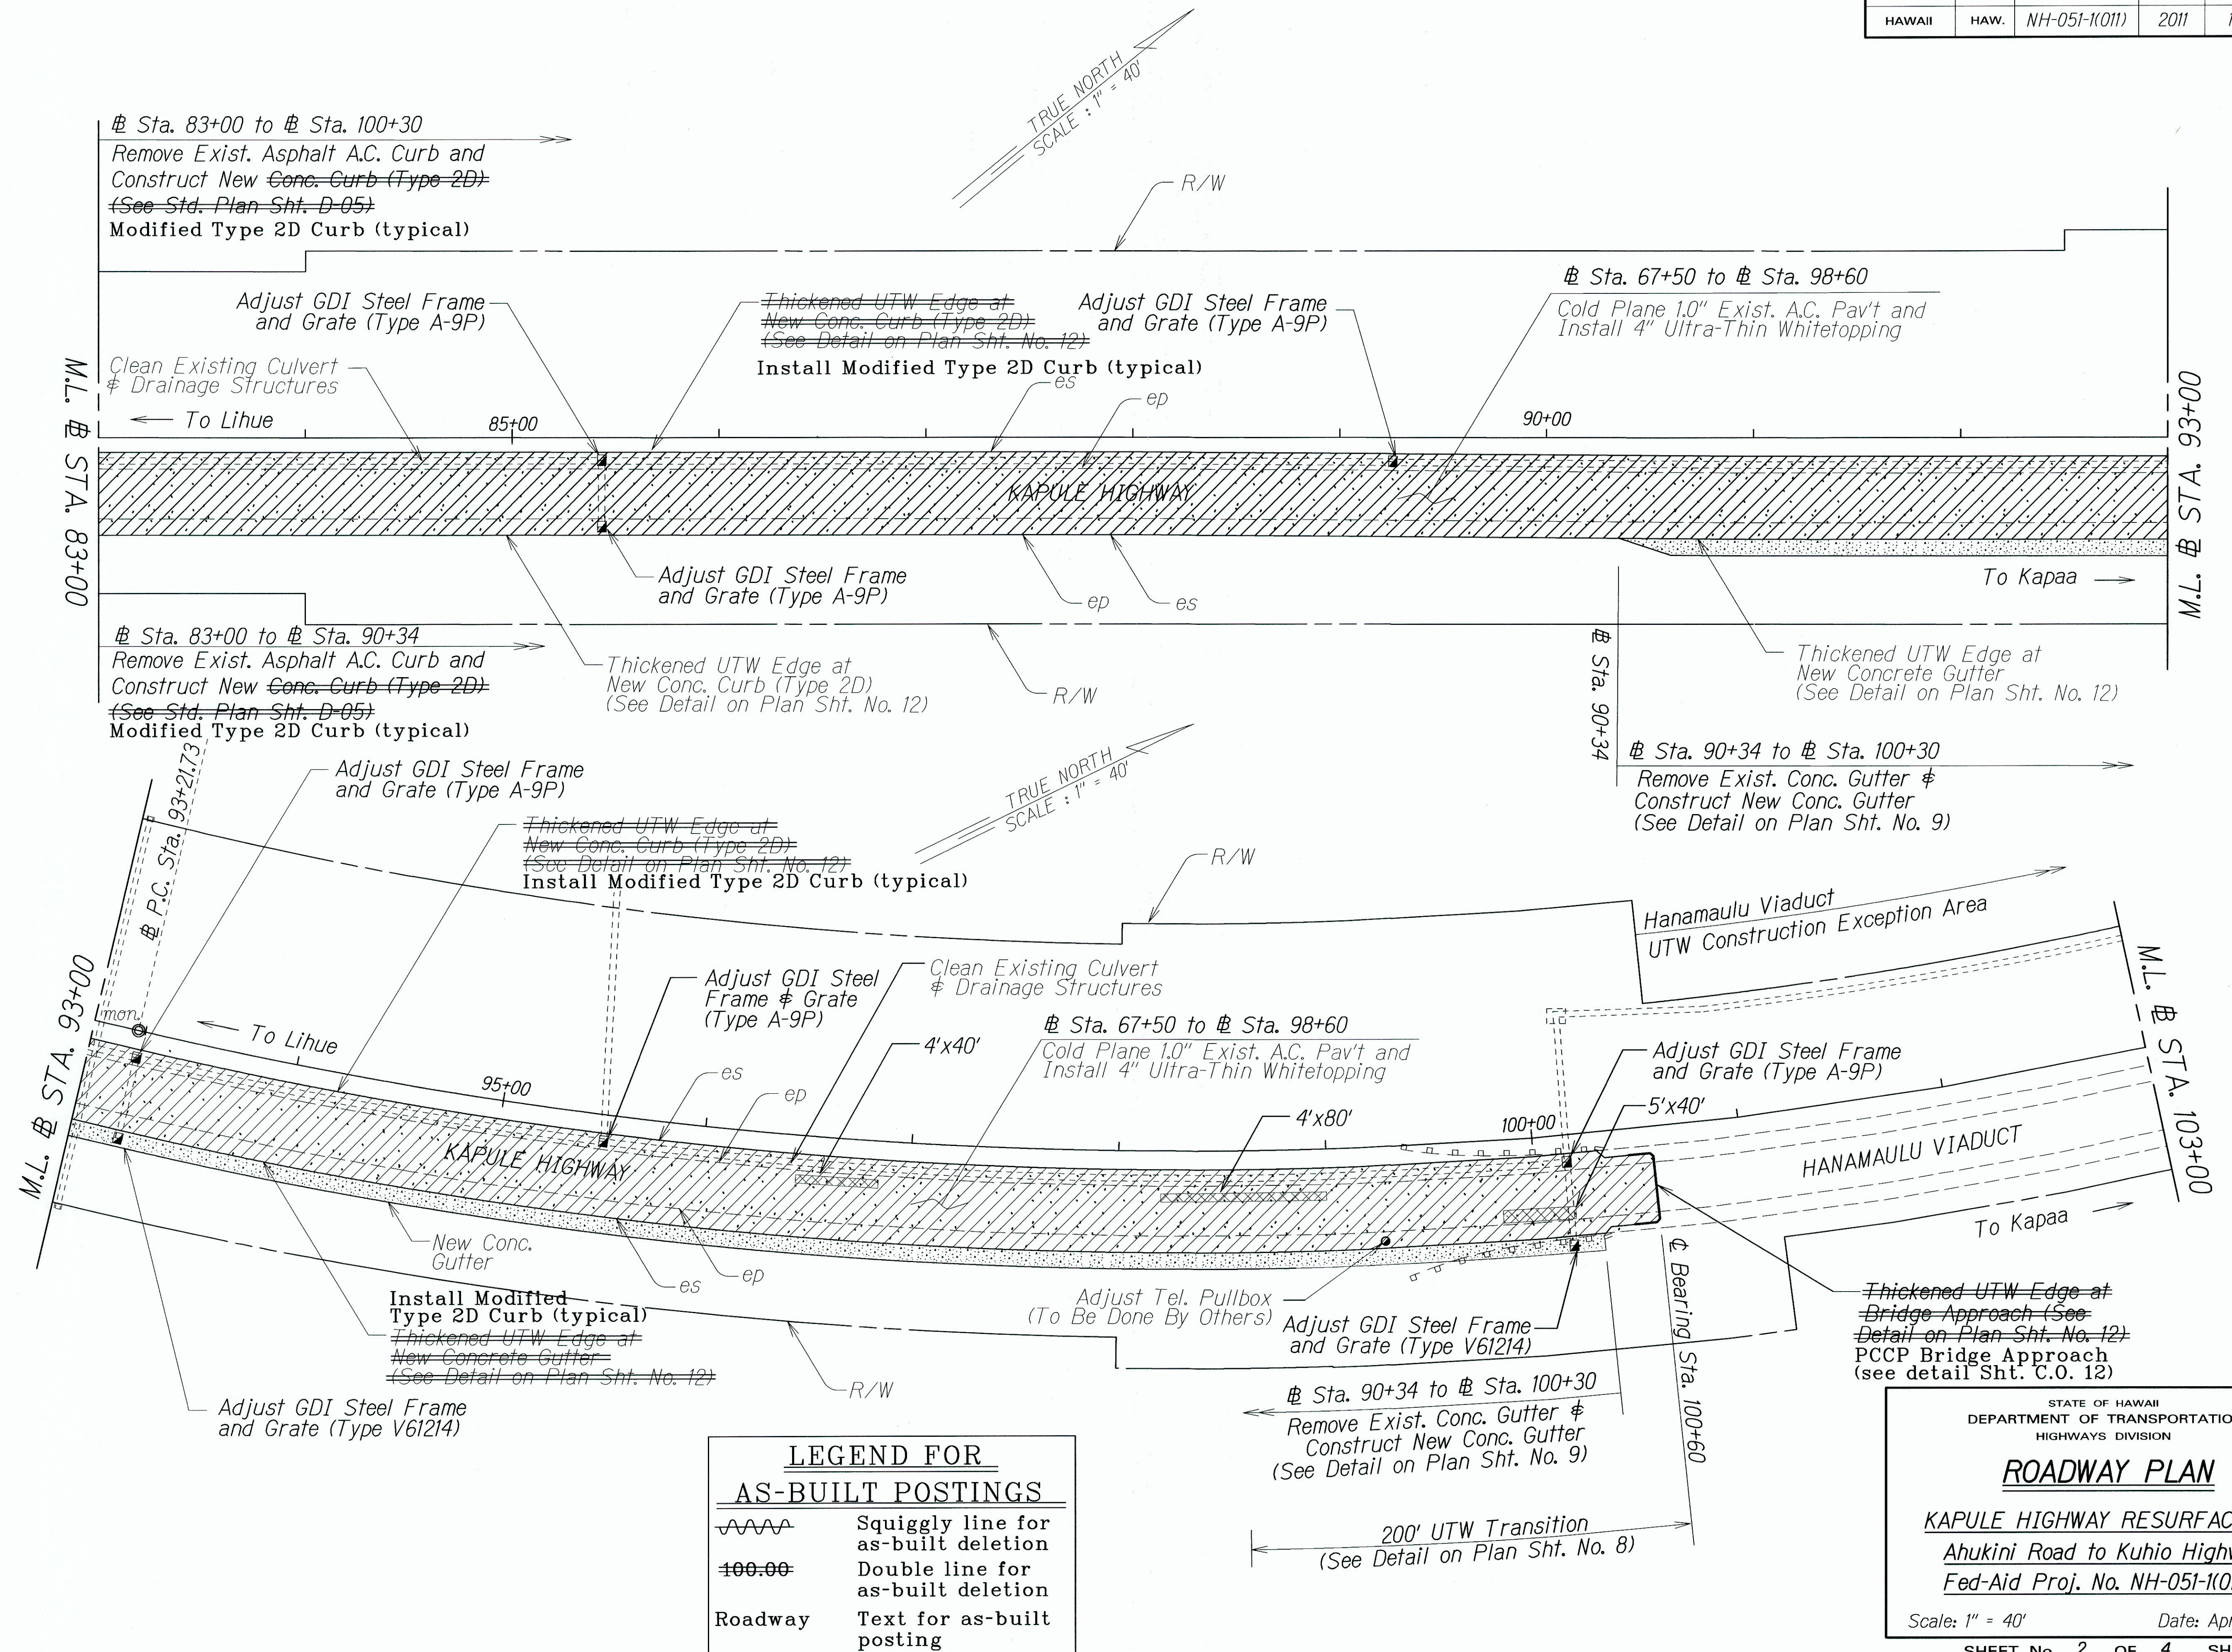

SURVEY PLOTTED BY	DATE
DESIGNED BY	
QUANTITIES BY	
CHECKED BY	
NOTE BOOK	
DATE	
NO.	

"AS-BUILT"

FED. ROAD DIST. NO.	STATE	FED-AID PROJ. NO.	FISCAL YEAR	SHEET NO.	TOTAL SHEETS
HAWAII	HAW.	NH-051-1(011)	2011	15	25

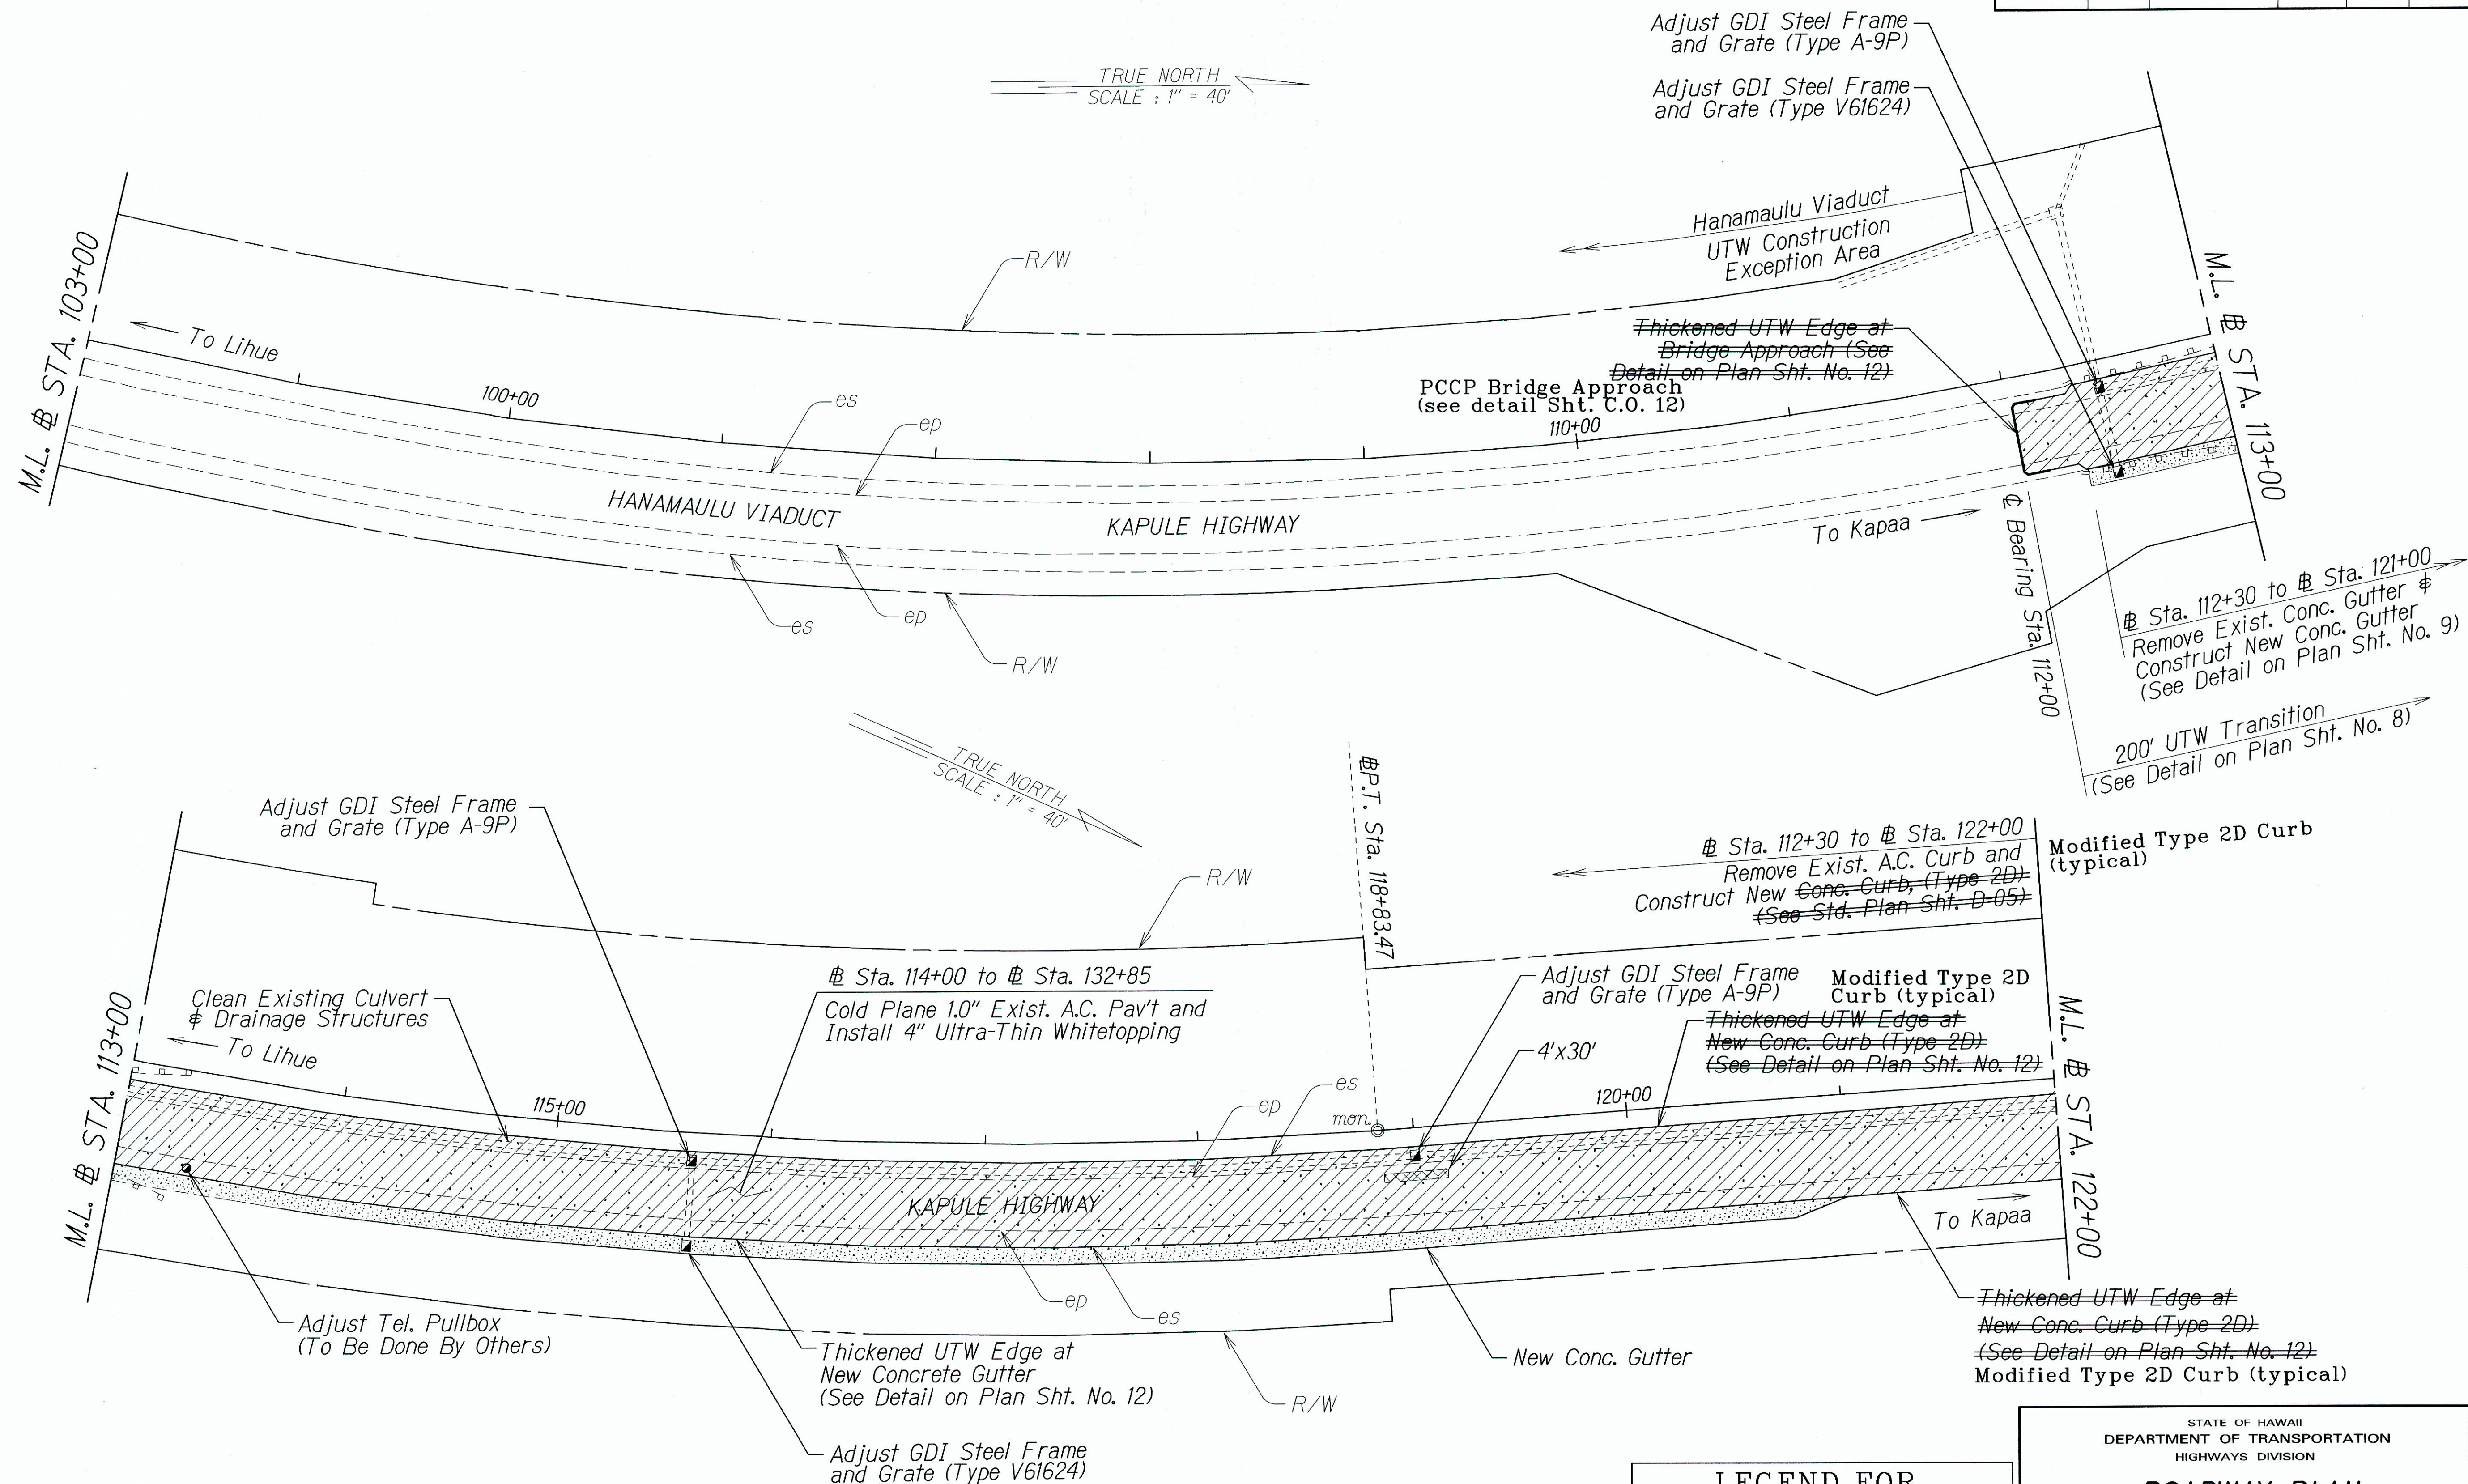

DATE	11/17/11
SURVEY PLOTTED BY	...
DRAWN BY	...
DESIGNED BY	...
CHECKED BY	...
NOTED BY	...
QUANTITIES BY	...
CHECKED BY	...

LEGEND FOR AS-BUILT POSTINGS	
	Squiggly line for as-built deletion
	Double line for as-built deletion
Roadway	Text for as-built posting

STATE OF HAWAII
DEPARTMENT OF TRANSPORTATION
HIGHWAYS DIVISION

ROADWAY PLAN

KAPULE HIGHWAY RESURFACING
Ahukini Road to Kuhio Highway
Fed-Aid Proj. No. NH-051-1(011)

Scale: 1" = 40'
Date: April 2011

SHEET No. 3 OF 4 SHEETS

