


FED. ROAD DIST. NO.	STATE	PROJ. NO.	FISCAL YEAR	SHEET NO.	TOTAL SHEETS
HAWAII	HAW.	51AB-01-15M	2017	ADD. 9	24



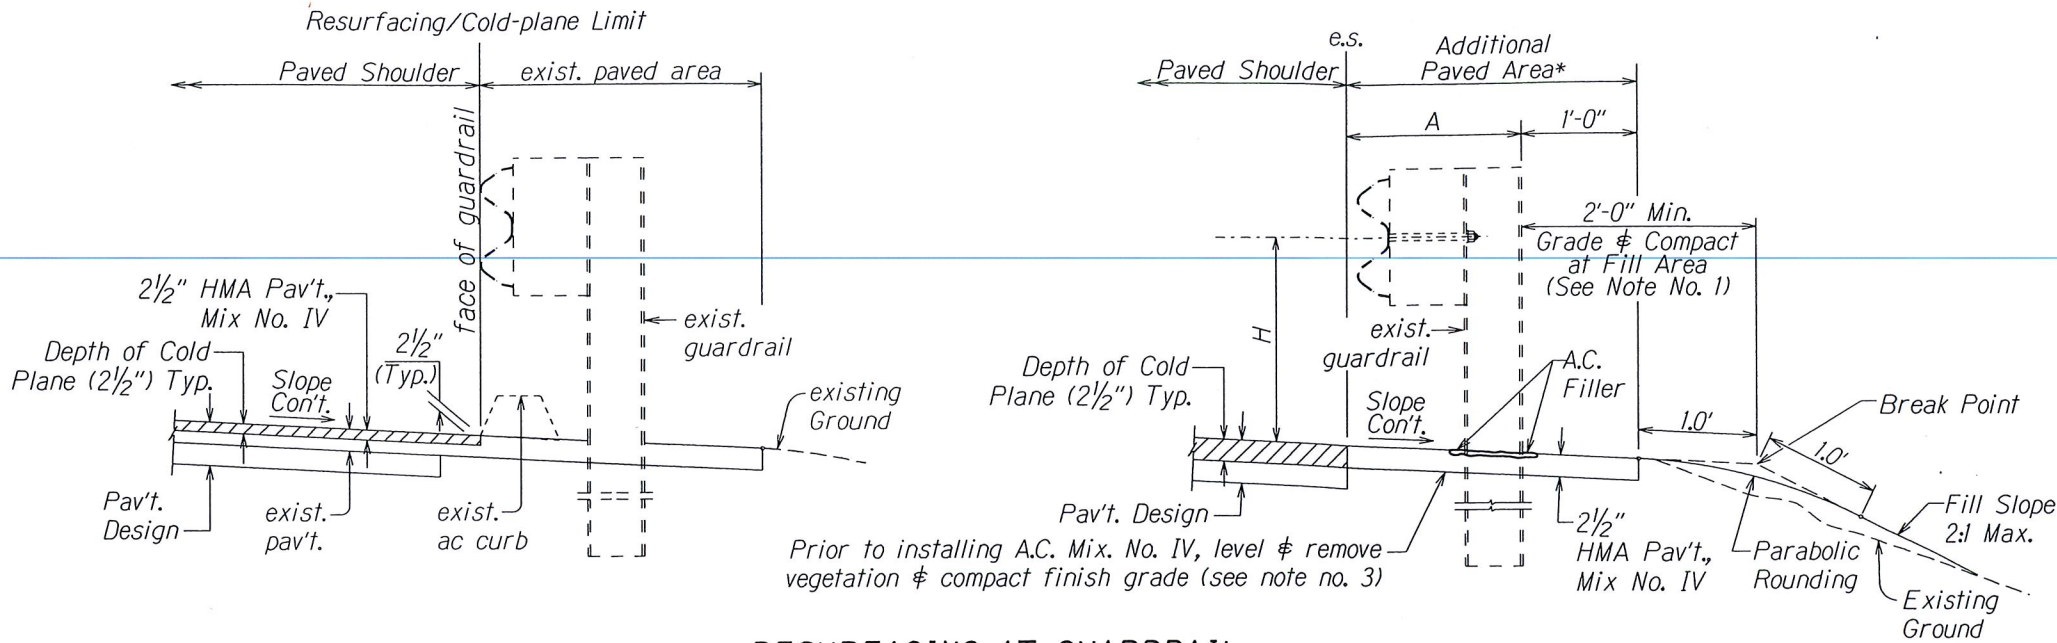


Notes for Resurfacing at Guardrail:

- When standards for the fill slope area cannot be met, a site specific, Engineer approved design may be used.
- New A.C. pavement at guardrails shall extend 6.0 feet longitudinal beyond existing terminal ends.
- Compact finished grade until there is no visible evidence of further consolidation. This work is subsidiary to Item No. 401.0400 - HMA Pavments, Mix No. IV.


RESURFACING AT GUARDRAIL

Not to Scale

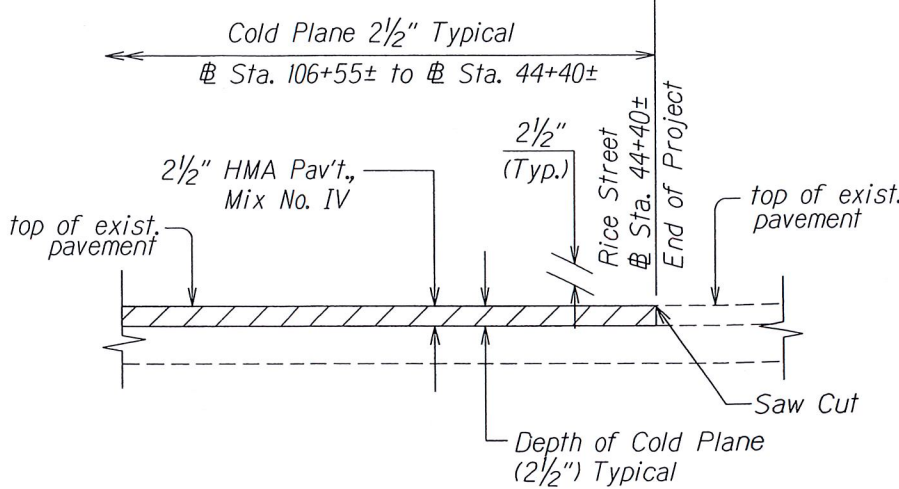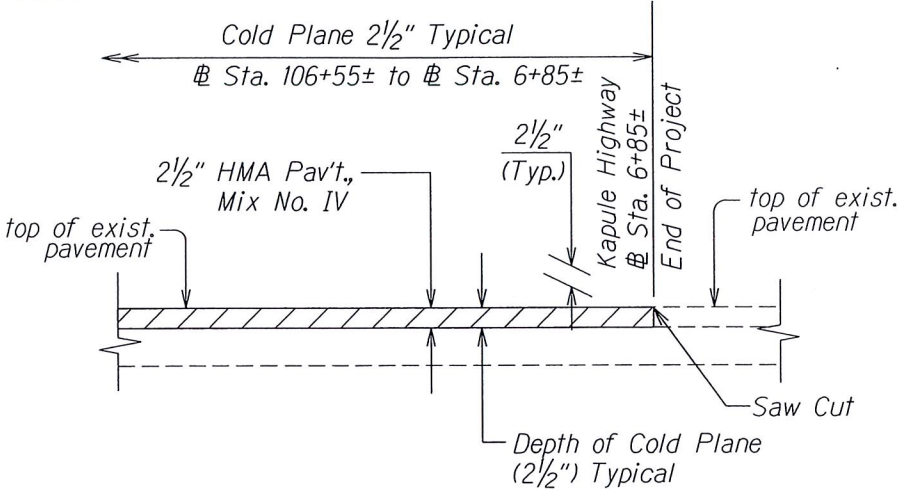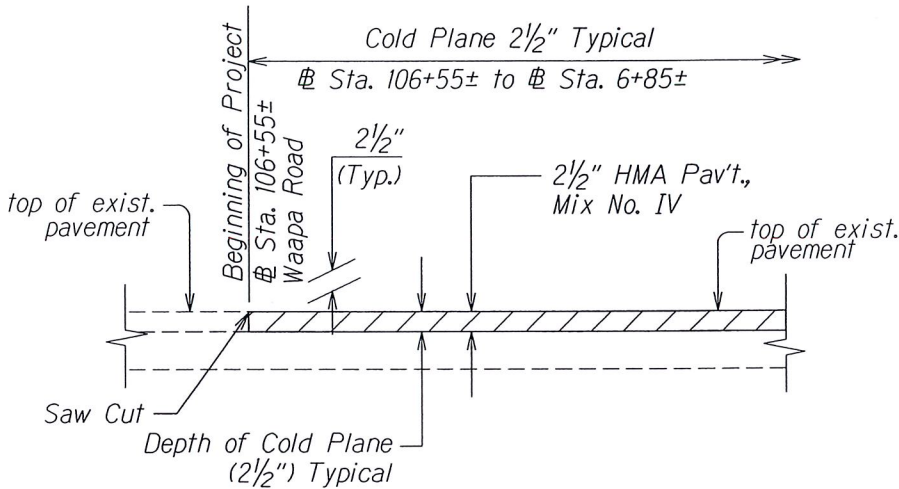


COLD PLANED TRANSITION TO EXISTING A.C. PAVEMENT AT THE BEGINNING AND END OF PROJECT

Not to Scale

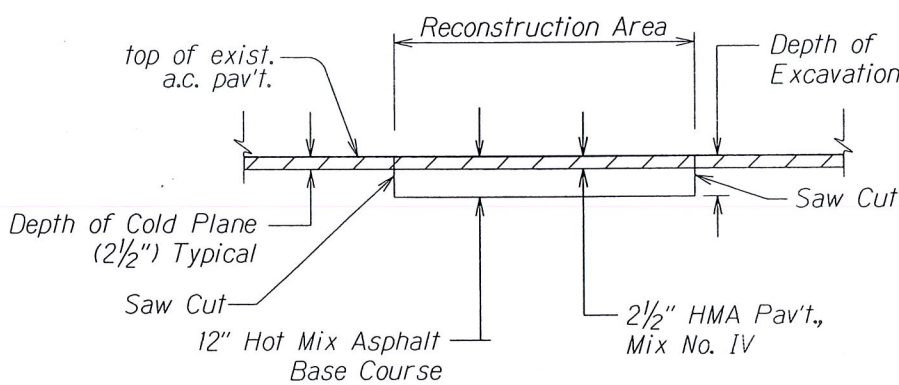

WILCOX ROAD TO LALA ROAD
 STA. 106+55± to STA. 1+95.87±
 Not to Scale

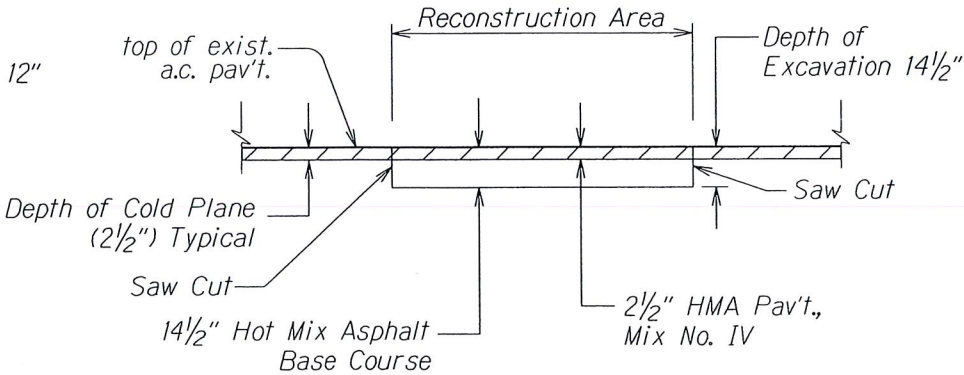

LALA ROAD TO HALAU STREET
 STA. 1+95.87± to STA. 6+85±
 Not to Scale



A.C. PAVEMENT RECONSTRUCTION DETAIL

Notes for Reconstruction Areas:

- Reconstruct weakened pavement areas prior to cold plane.
- The exposed remaining base course or subbase materials should be properly recompact to dense and unyielding conditions prior to placement of the asphalt concrete base layer.

11/9/16	△ - Limits of Reconstruction Areas
DATE	REVISION
STATE OF HAWAII DEPARTMENT OF TRANSPORTATION HIGHWAYS DIVISION	
TYPICAL SECTIONS	
WAAPA ROAD/RICE STREET/ KAPULE HIGHWAY RESURFACING	
Wilcox Road to Halau Street Project No. 51AB-01-15M	
Not to Scale	Date: May 2015
SHEET No. 3 OF 3 SHEETS	

FED. ROAD DIST. NO.	STATE	PROJ. NO.	FISCAL YEAR	SHEET NO.	TOTAL SHEETS
HAWAII	HAW.	51AB-01-15M	2017	ADD. 17	24

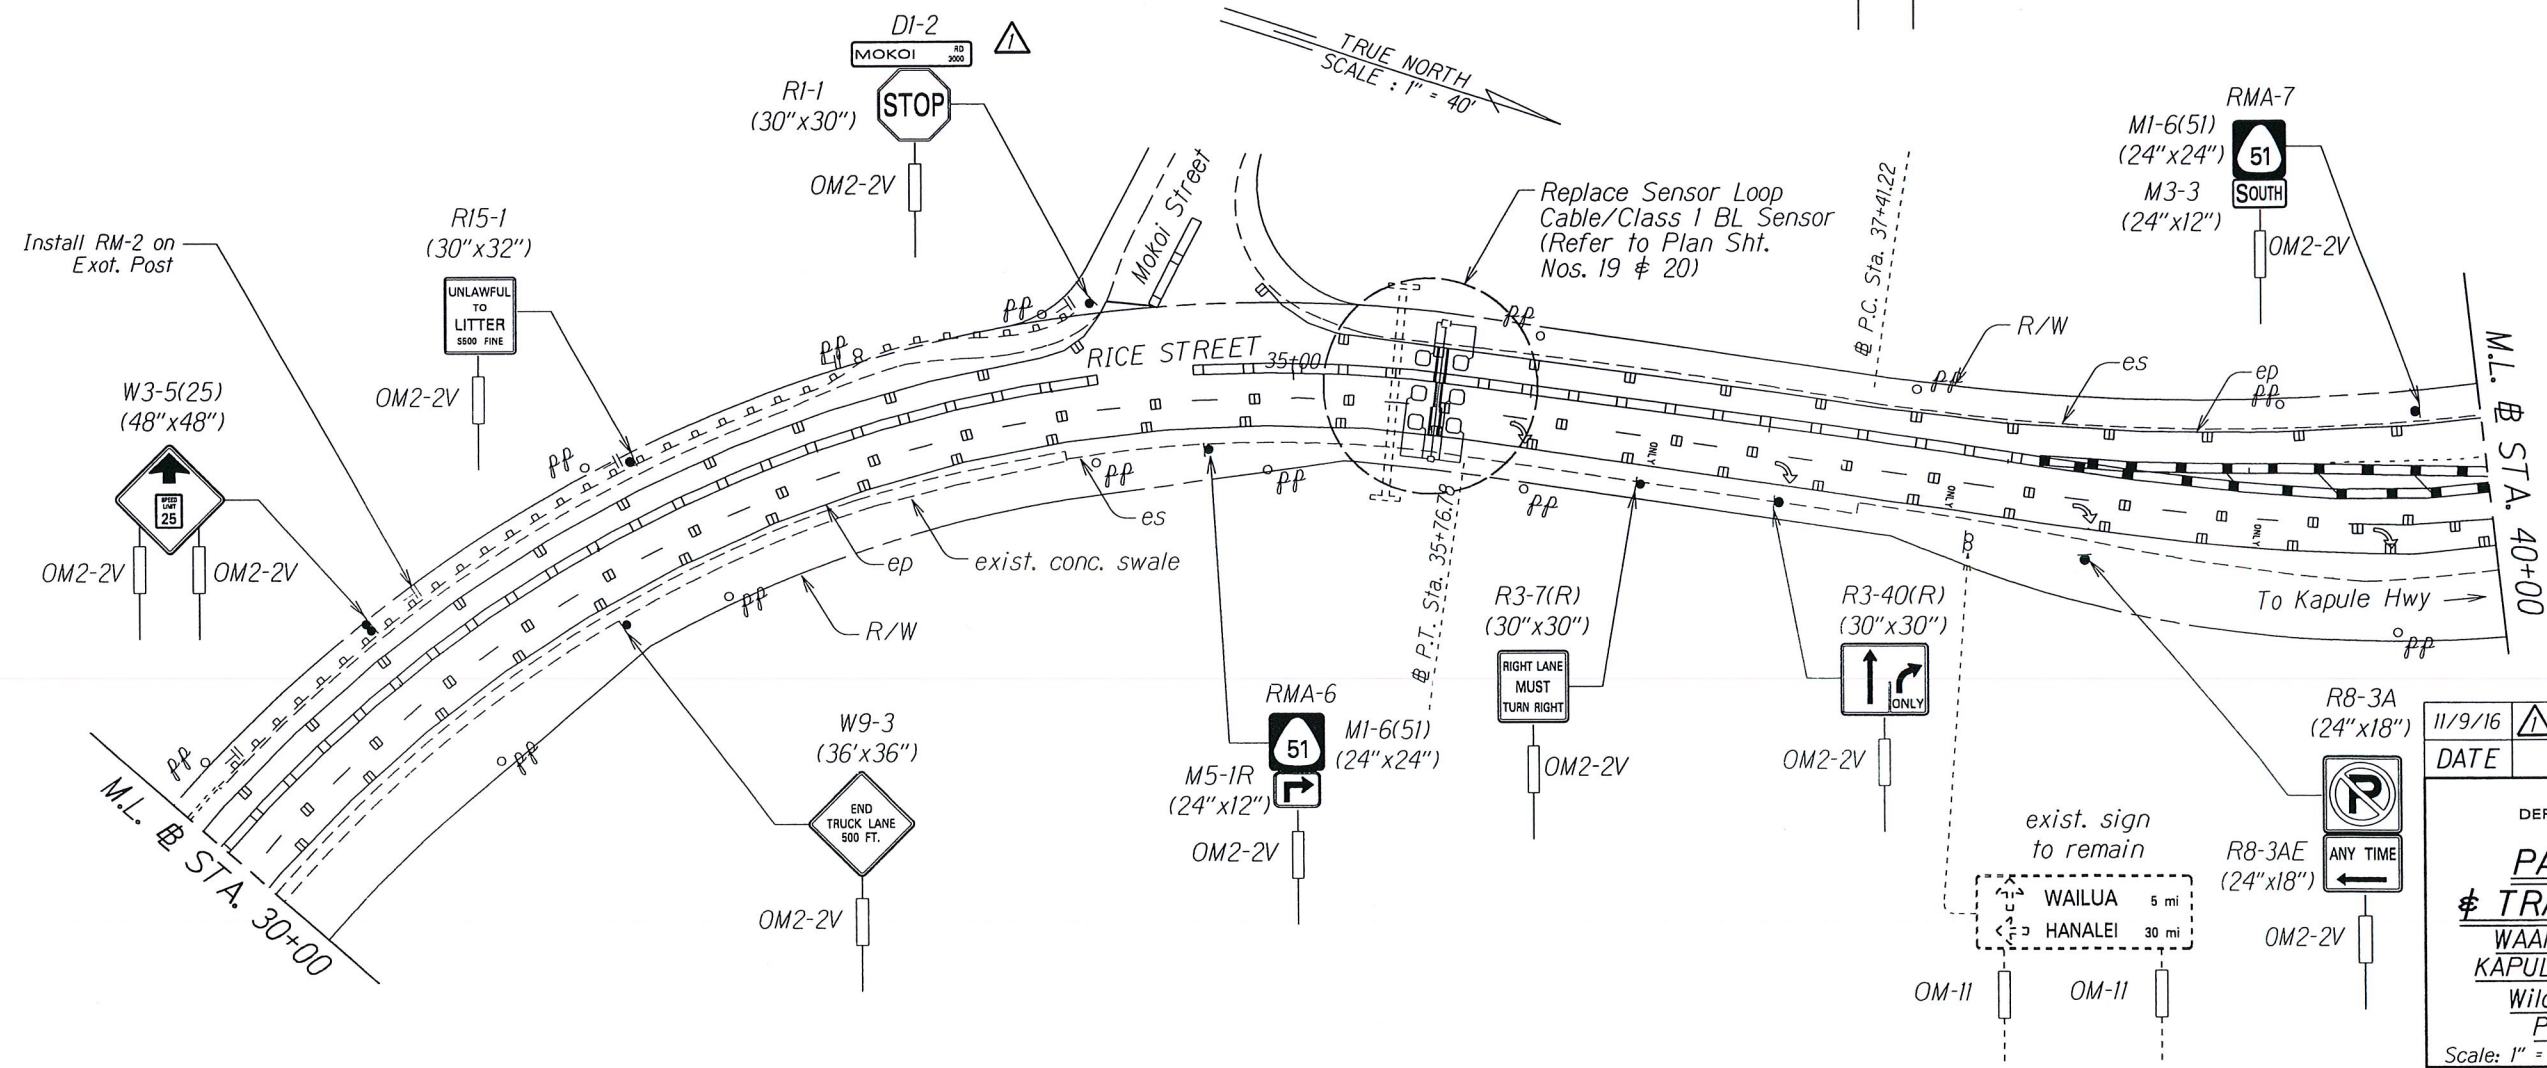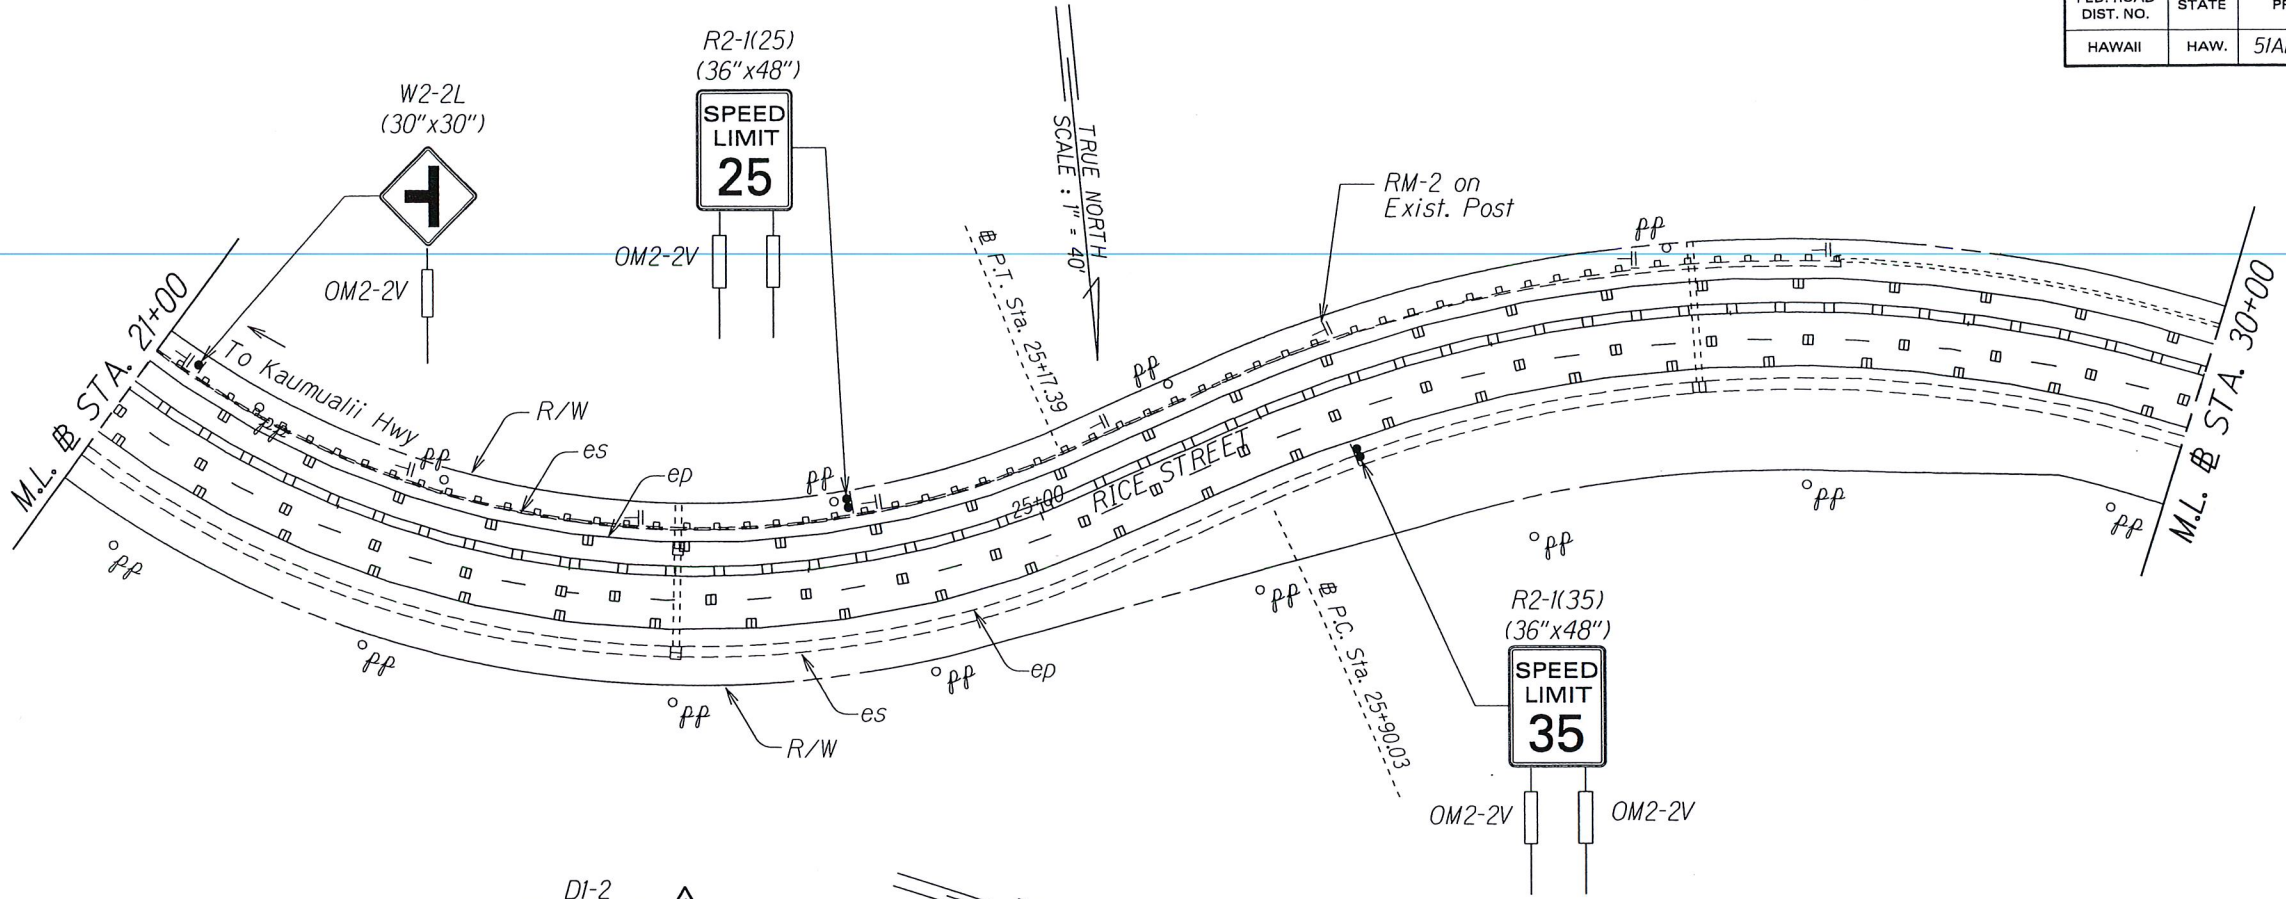

SURVEY PLOTTED BY	DATE
DRAWN BY	
NOTED BY	
CHECKED BY	
ORIGINAL PLAN	
NO. ADD. 17/24	

11/9/16	△ - Street Name Sign
DATE	REVISION
STATE OF HAWAII DEPARTMENT OF TRANSPORTATION HIGHWAYS DIVISION	
PAVEMENT MARKING	
TRAFFIC SIGNING PLAN	
WAAPA ROAD/RICE STREET/ KAPULE HIGHWAY RESURFACING	
Wilcox Road to Halau Street	
Project No. 51AB-01-15M	
Scale: 1" = 40'	Date: May 2016
SHEET No. T4 OF 5 SHEETS	

11/9/16	 - Street Name Sign
DATE	REVISION

STATE OF HAWAII
DEPARTMENT OF TRANSPORTATION
HIGHWAYS DIVISION

PAVEMENT MARKING
\$ TRAFFIC SIGNING PLAN
WAAPA ROAD/RICE STREET /
KAPULE HIGHWAY RESURFACING
Wilcox Road to Halau Street
Project No. 51AB-01-15M

Scale: 1" = 40' Date: May 2016

SHEET No. 75 OF 5 SHEETS

