


FED. ROAD DIST. NO.	STATE	PROJ. NO.	FISCAL YEAR	SHEET NO.	TOTAL SHEETS
HAWAII	HAW.	51AB-01-15M	2017	15	24

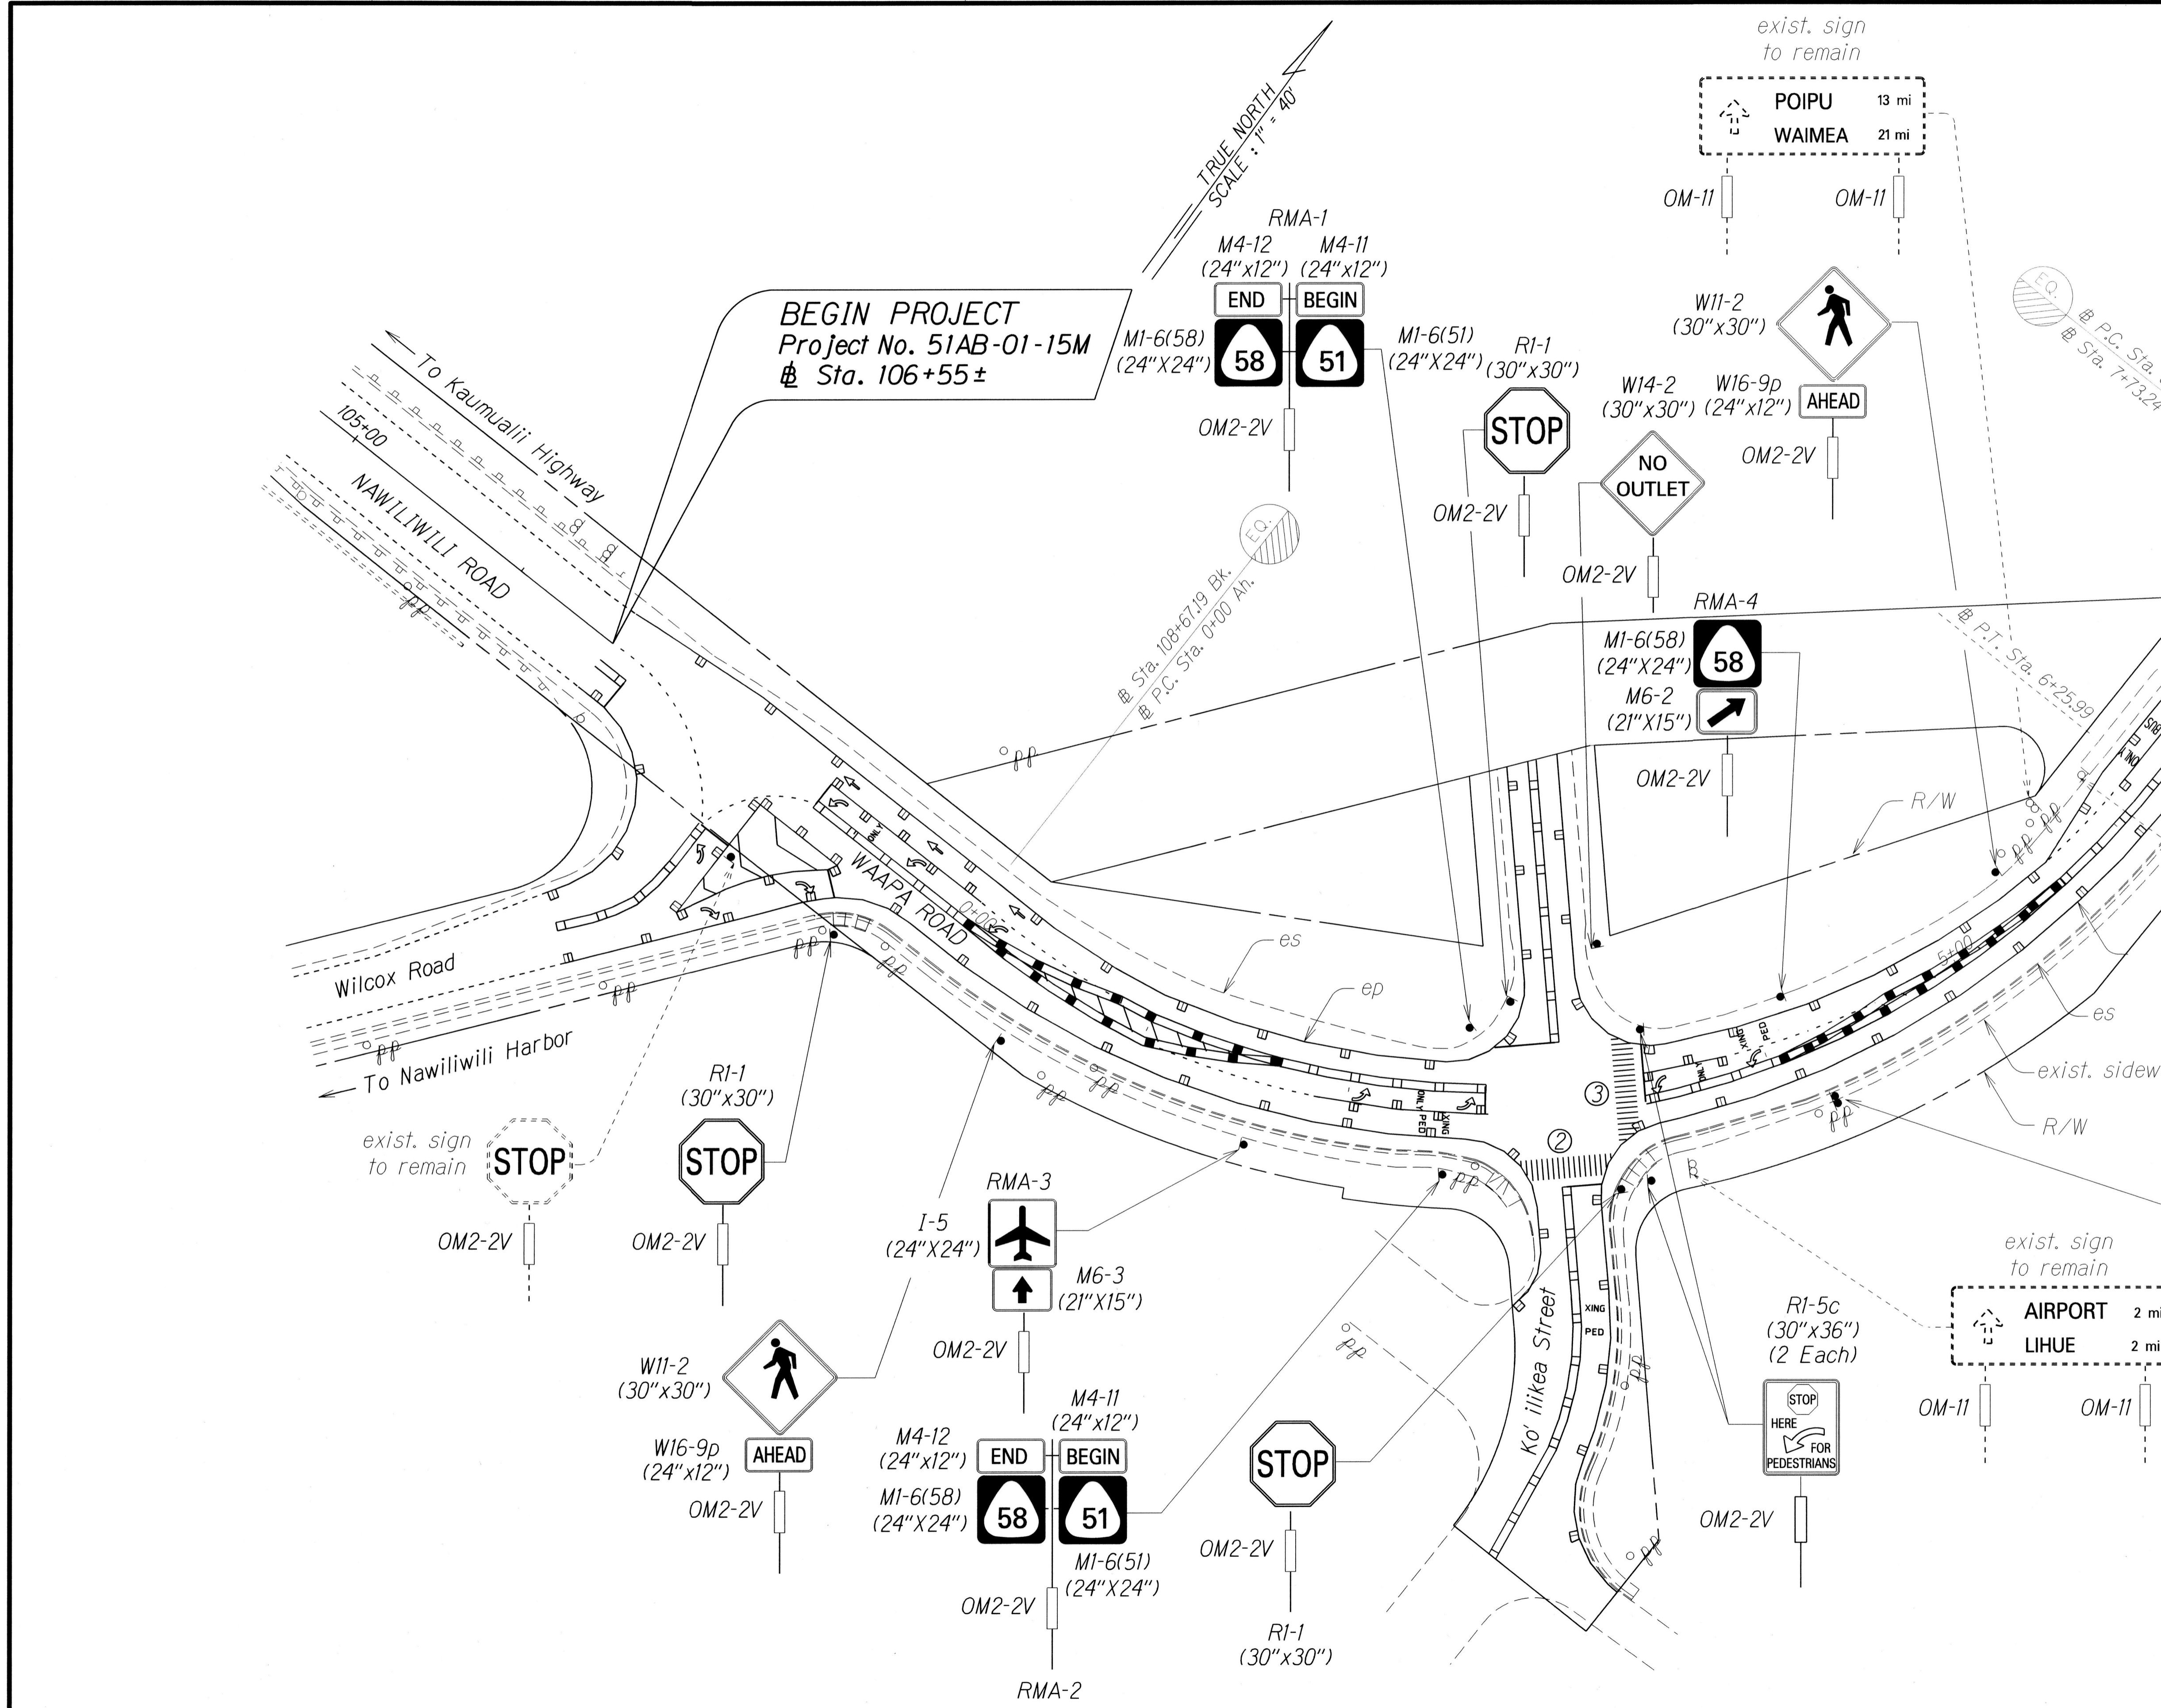

DESIGNED BY	DATE
TRACED BY	
DESIGNED BY	
QUANTITIES BY	
CHECKED BY	
ORIGINAL PLAN	
NOTE: BOOK	

STATE OF HAWAII
DEPARTMENT OF TRANSPORTATION
HIGHWAYS DIVISION


**PAVEMENT MARKING
& TRAFFIC SIGNING PLAN**

WAAPA ROAD/RICE STREET/
KAPULE HIGHWAY RESURFACING
Wilcox Road to Halau Street
Project No. 51AB-01-15M

Scale: 1" = 40' Date: May 2016

SHEET No. T2 OF 5 SHEETS

FED. ROAD DIST. NO.	STATE	PROJ. NO.	FISCAL YEAR	SHEET NO.	TOTAL SHEETS
HAWAII	HAW.	51AB-01-15M	2017	16	24

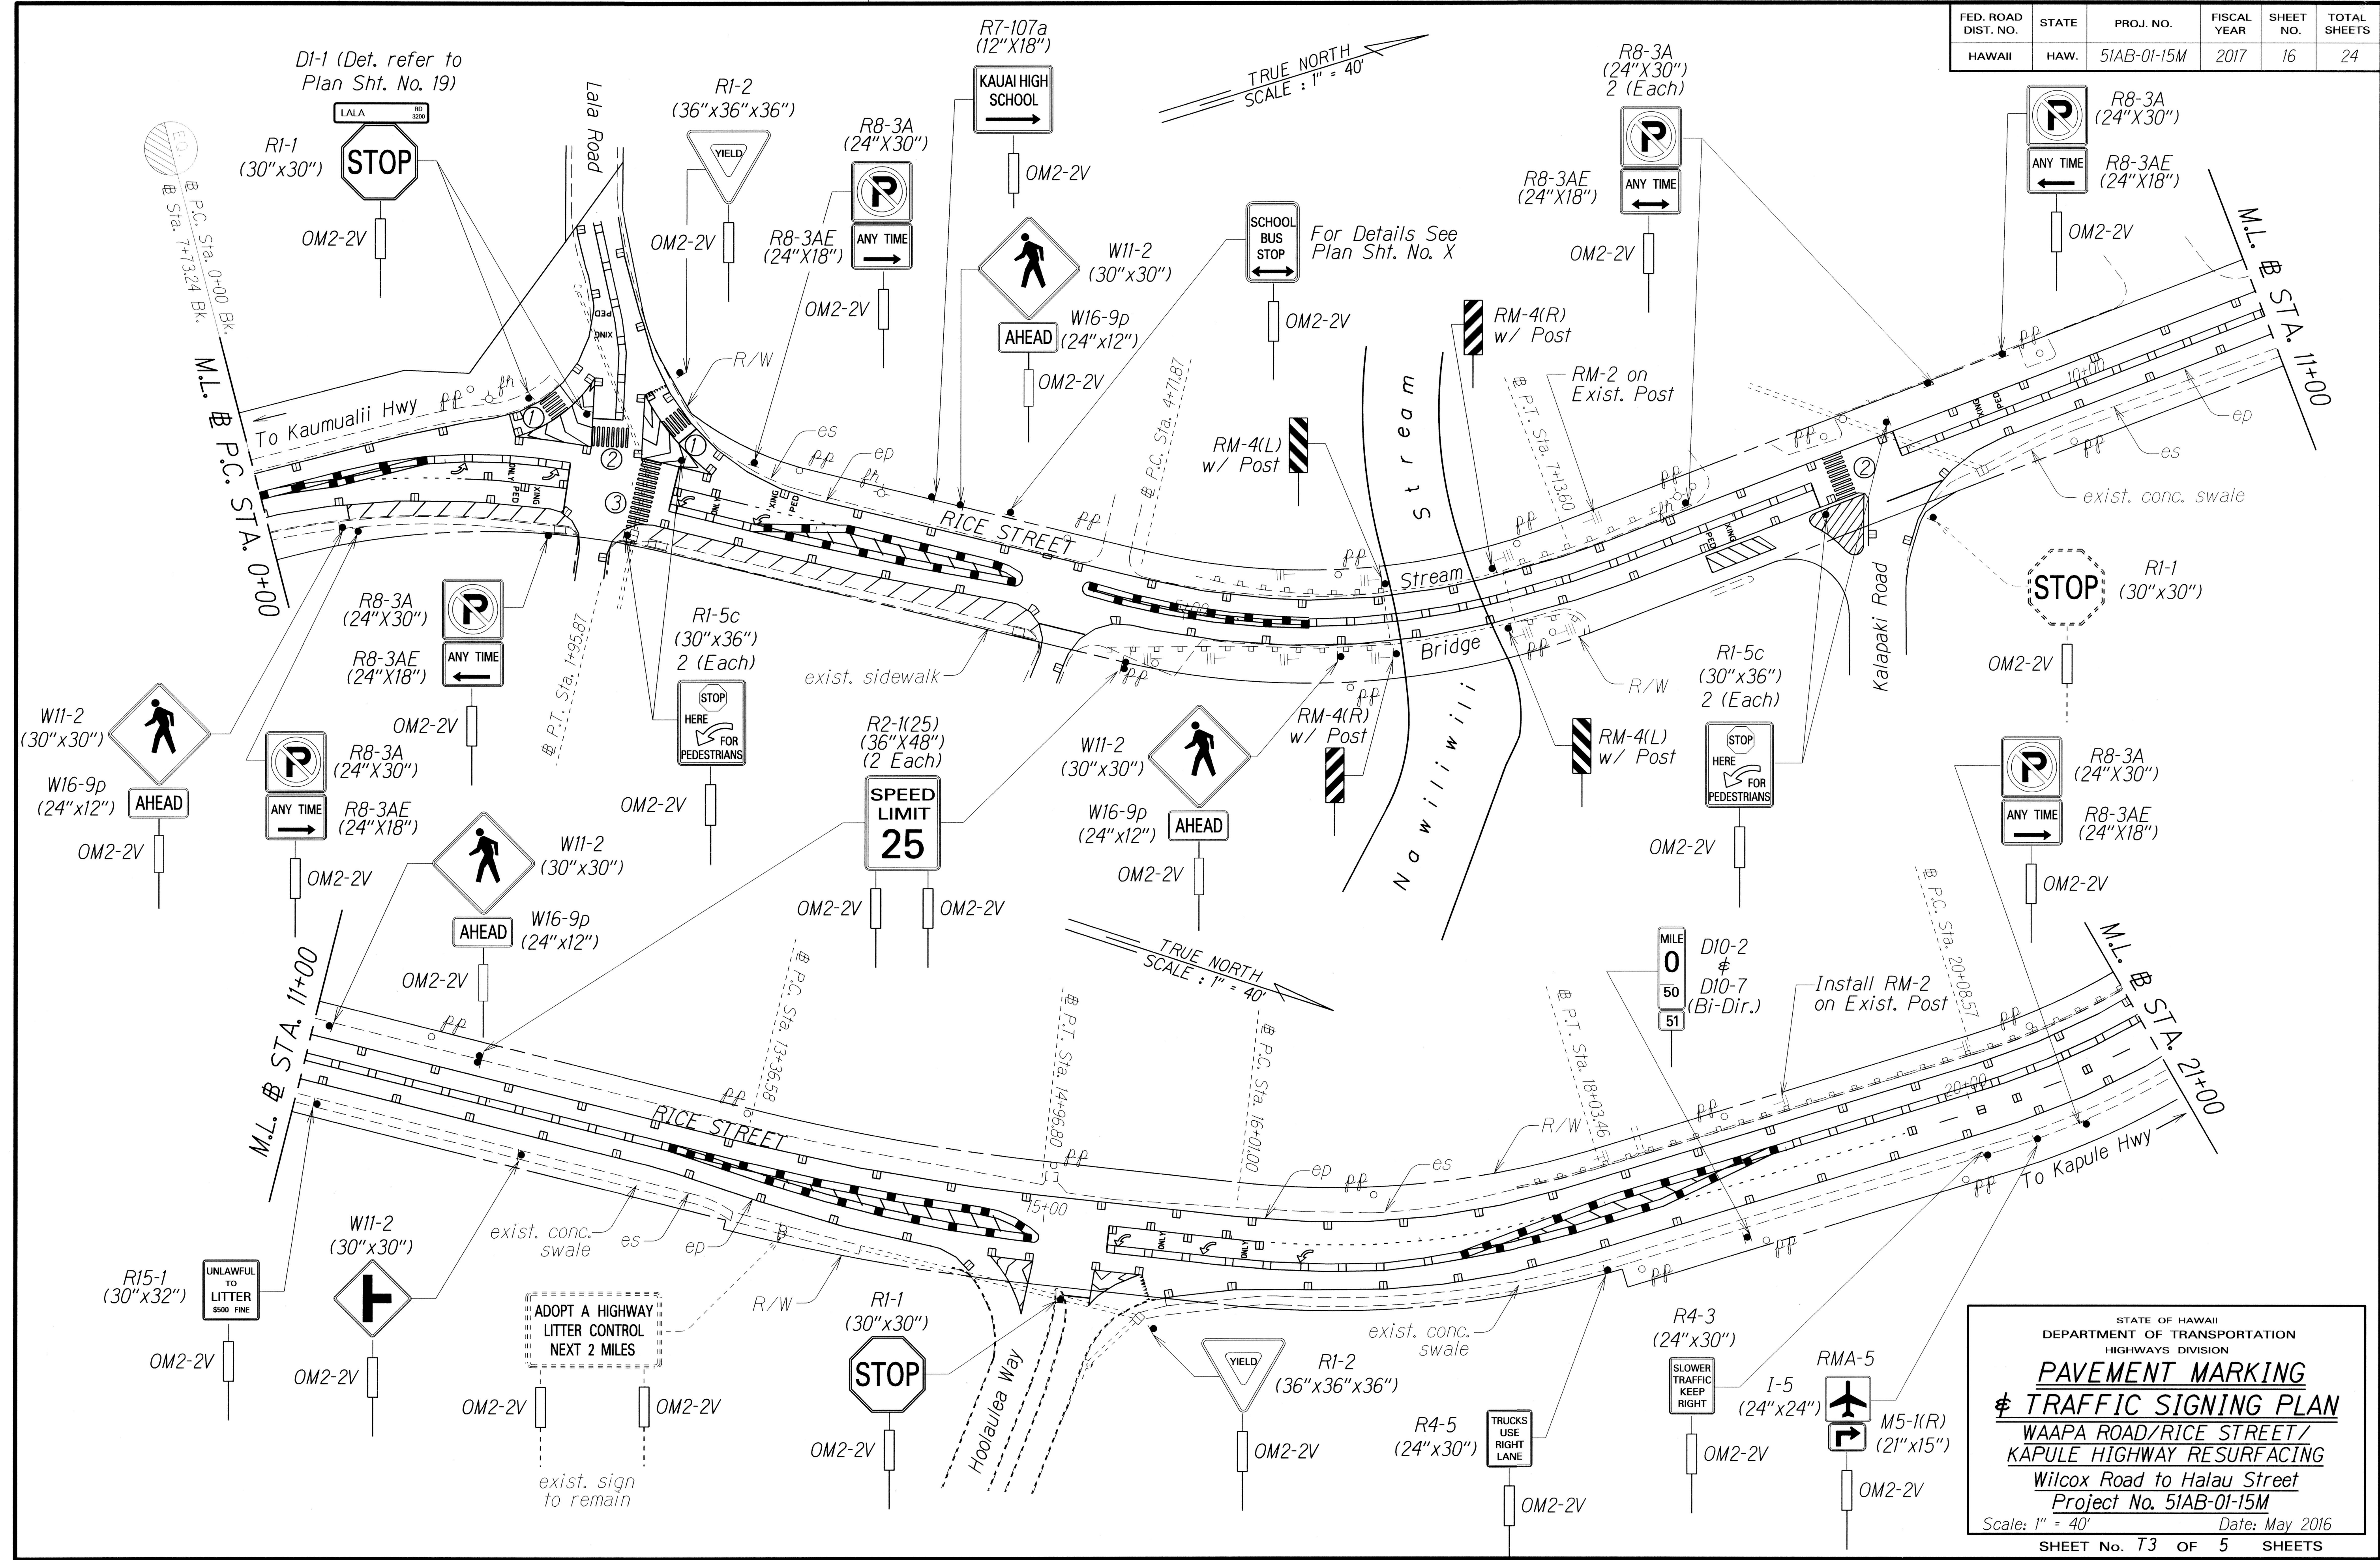

DATE	_____
DESIGNED BY	_____
TRACED BY	_____
QUANTITIES BY	_____
CHECKED BY	_____


STATE OF HAWAII
DEPARTMENT OF TRANSPORTATION
HIGHWAYS DIVISION

PAVEMENT MARKING & TRAFFIC SIGNING PLAN

WAAPA ROAD/RICE STREET/
KAPULE HIGHWAY RESURFACING
Wilcox Road to Halau Street
Project No. 51AB-01-15M

Scale: 1" = 40' Date: May 2016
SHEET No. T3 OF 5 SHEETS

FED. ROAD DIST. NO.	STATE	PROJ. NO.	FISCAL YEAR	SHEET NO.	TOTAL SHEETS
HAWAII	HAW.	51AB-01-15M	2017	ADD. 17	24

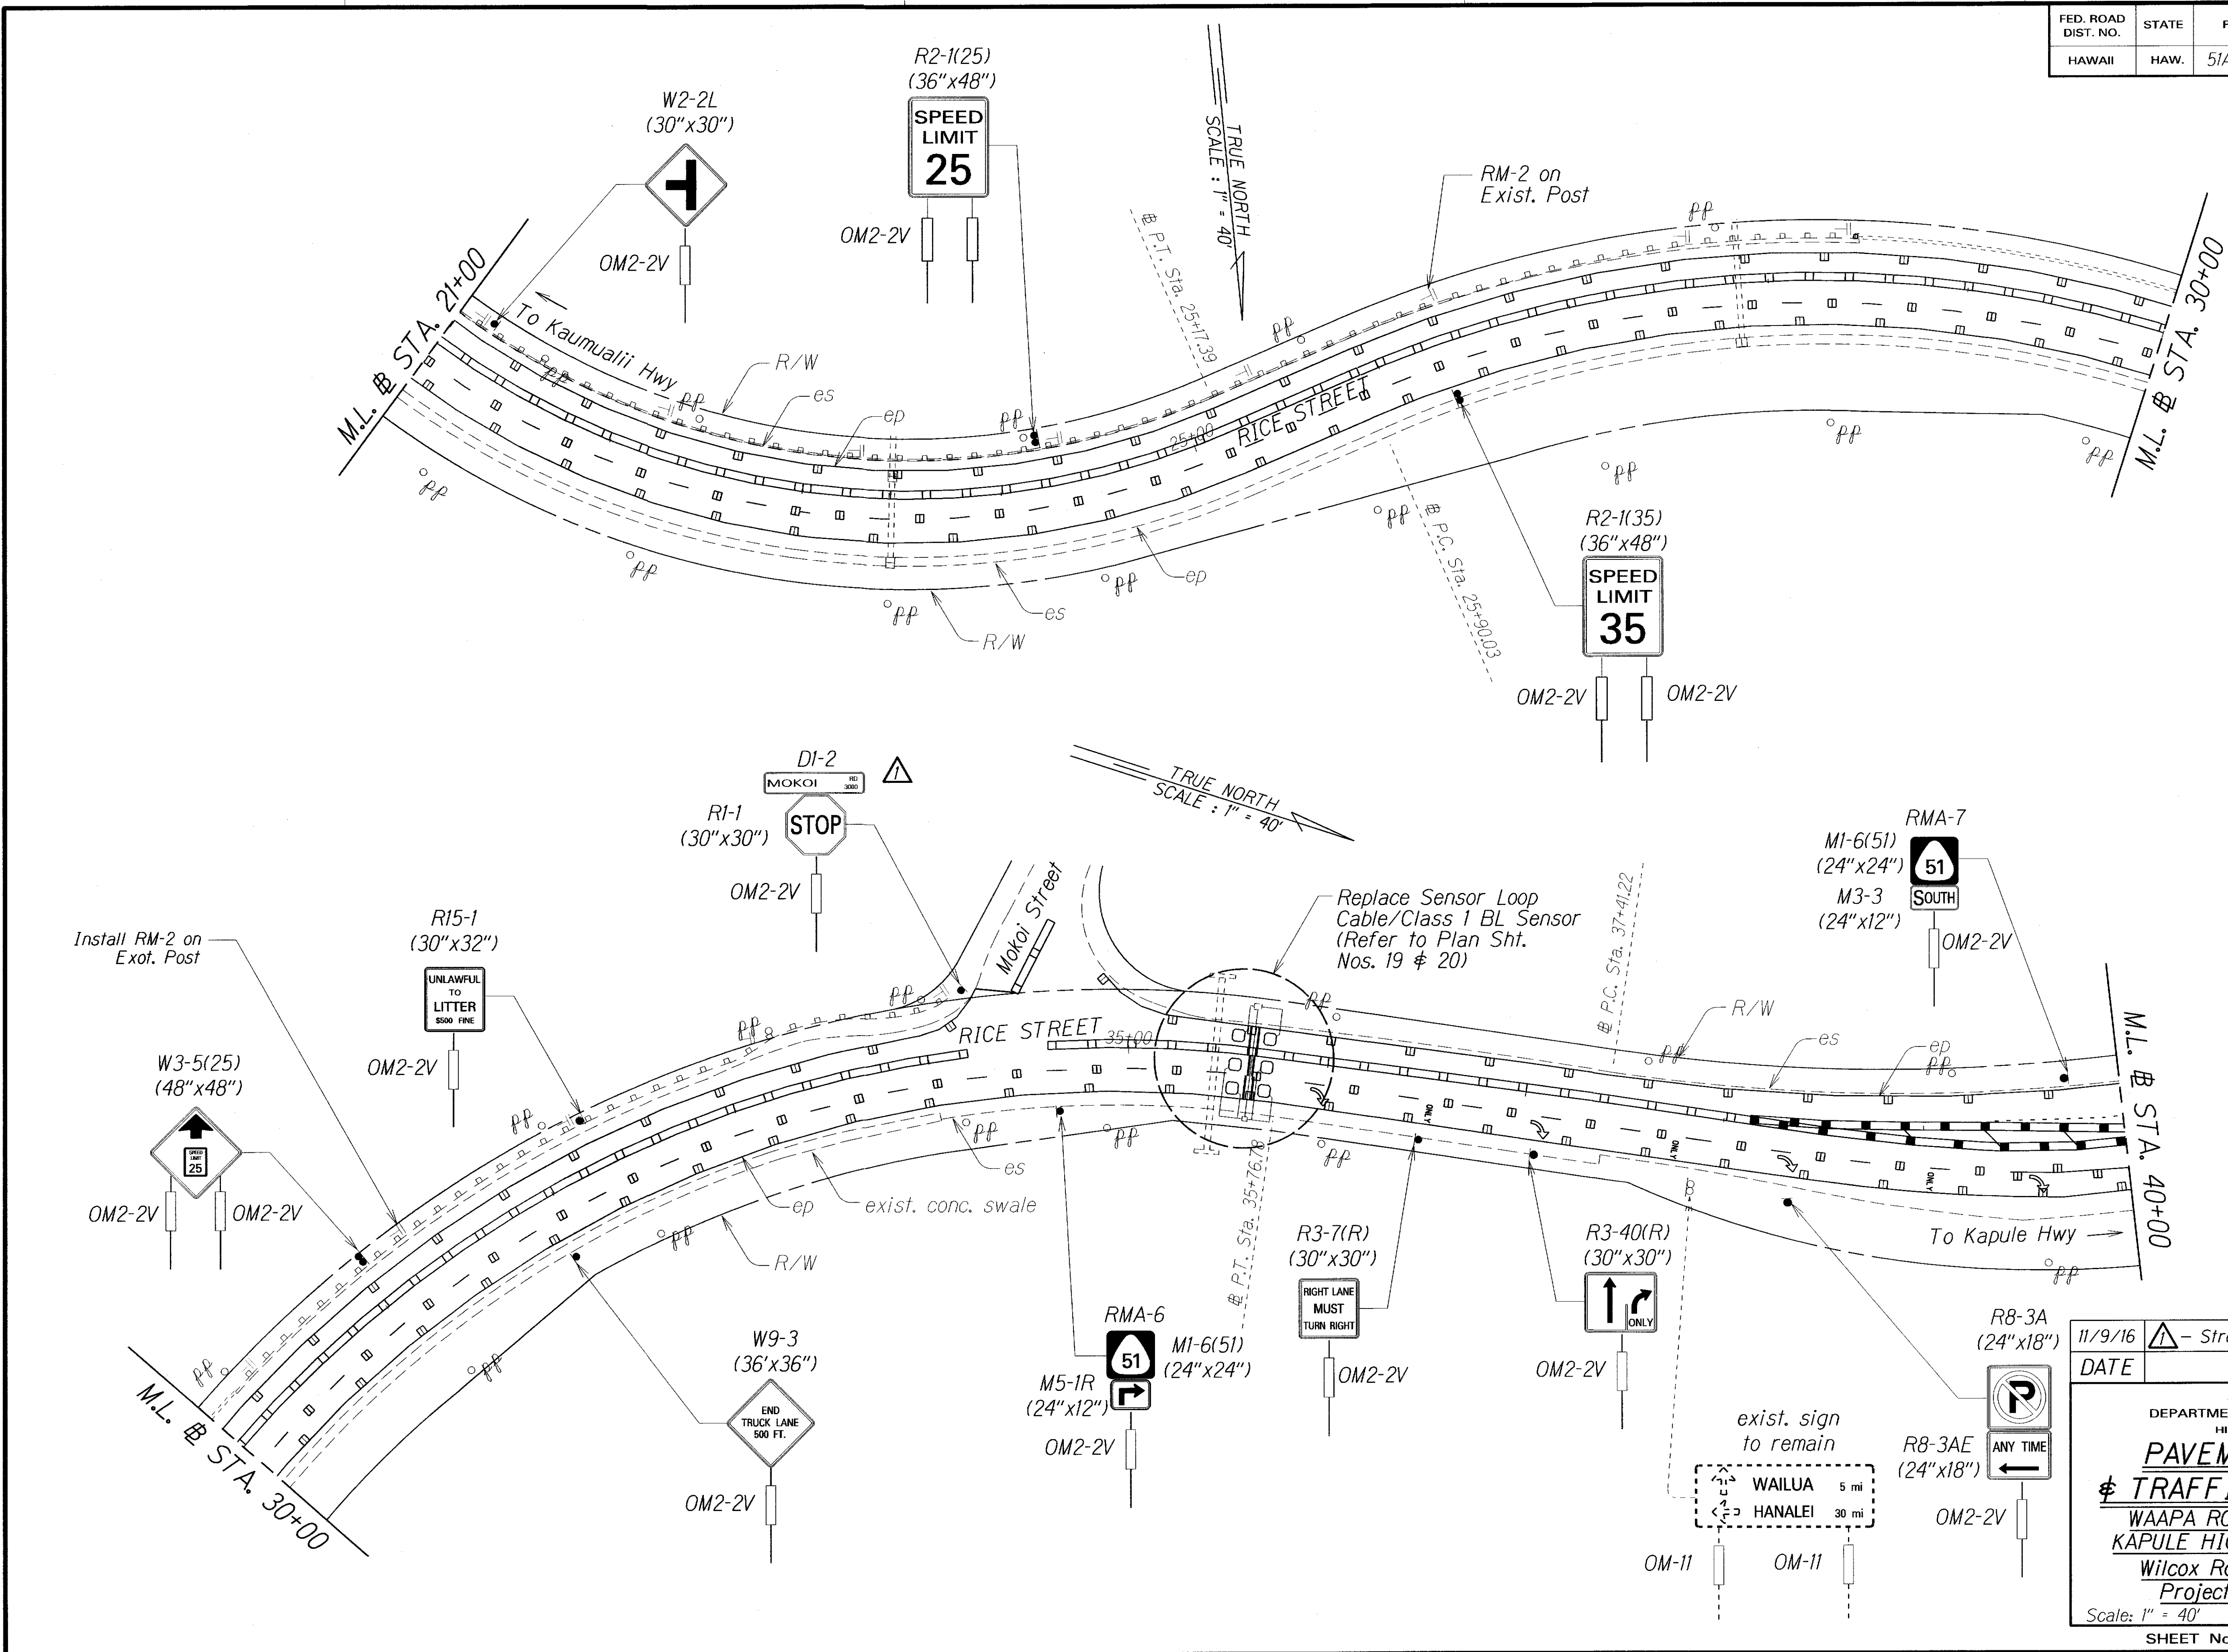


DATE	
SURVEY PLOTTED BY	
DRAWN BY	
NOTED BY	
DESIGNED BY	
QUANTITIES BY	
CHECKED BY	
NO.	

11/9/16	△ - Street Name Sign
DATE	REVISION
STATE OF HAWAII DEPARTMENT OF TRANSPORTATION HIGHWAYS DIVISION	
PAVEMENT MARKING	
TRAFFIC SIGNING PLAN	
WAAPA ROAD/RICE STREET/ KAPULE HIGHWAY RESURFACING Wilcox Road to Halau Street Project No. 51AB-01-15M	
Scale: 1" = 40'	Date: May 2016
SHEET No. 14 OF 5 SHEETS	

ADD. 17

FED. ROAD DIST. NO.	STATE	PROJ. NO.	FISCAL YEAR	SHEET NO.	TOTAL SHEETS
HAWAII	HAW.	51AB-01-15M	2017	ADD. 18	24

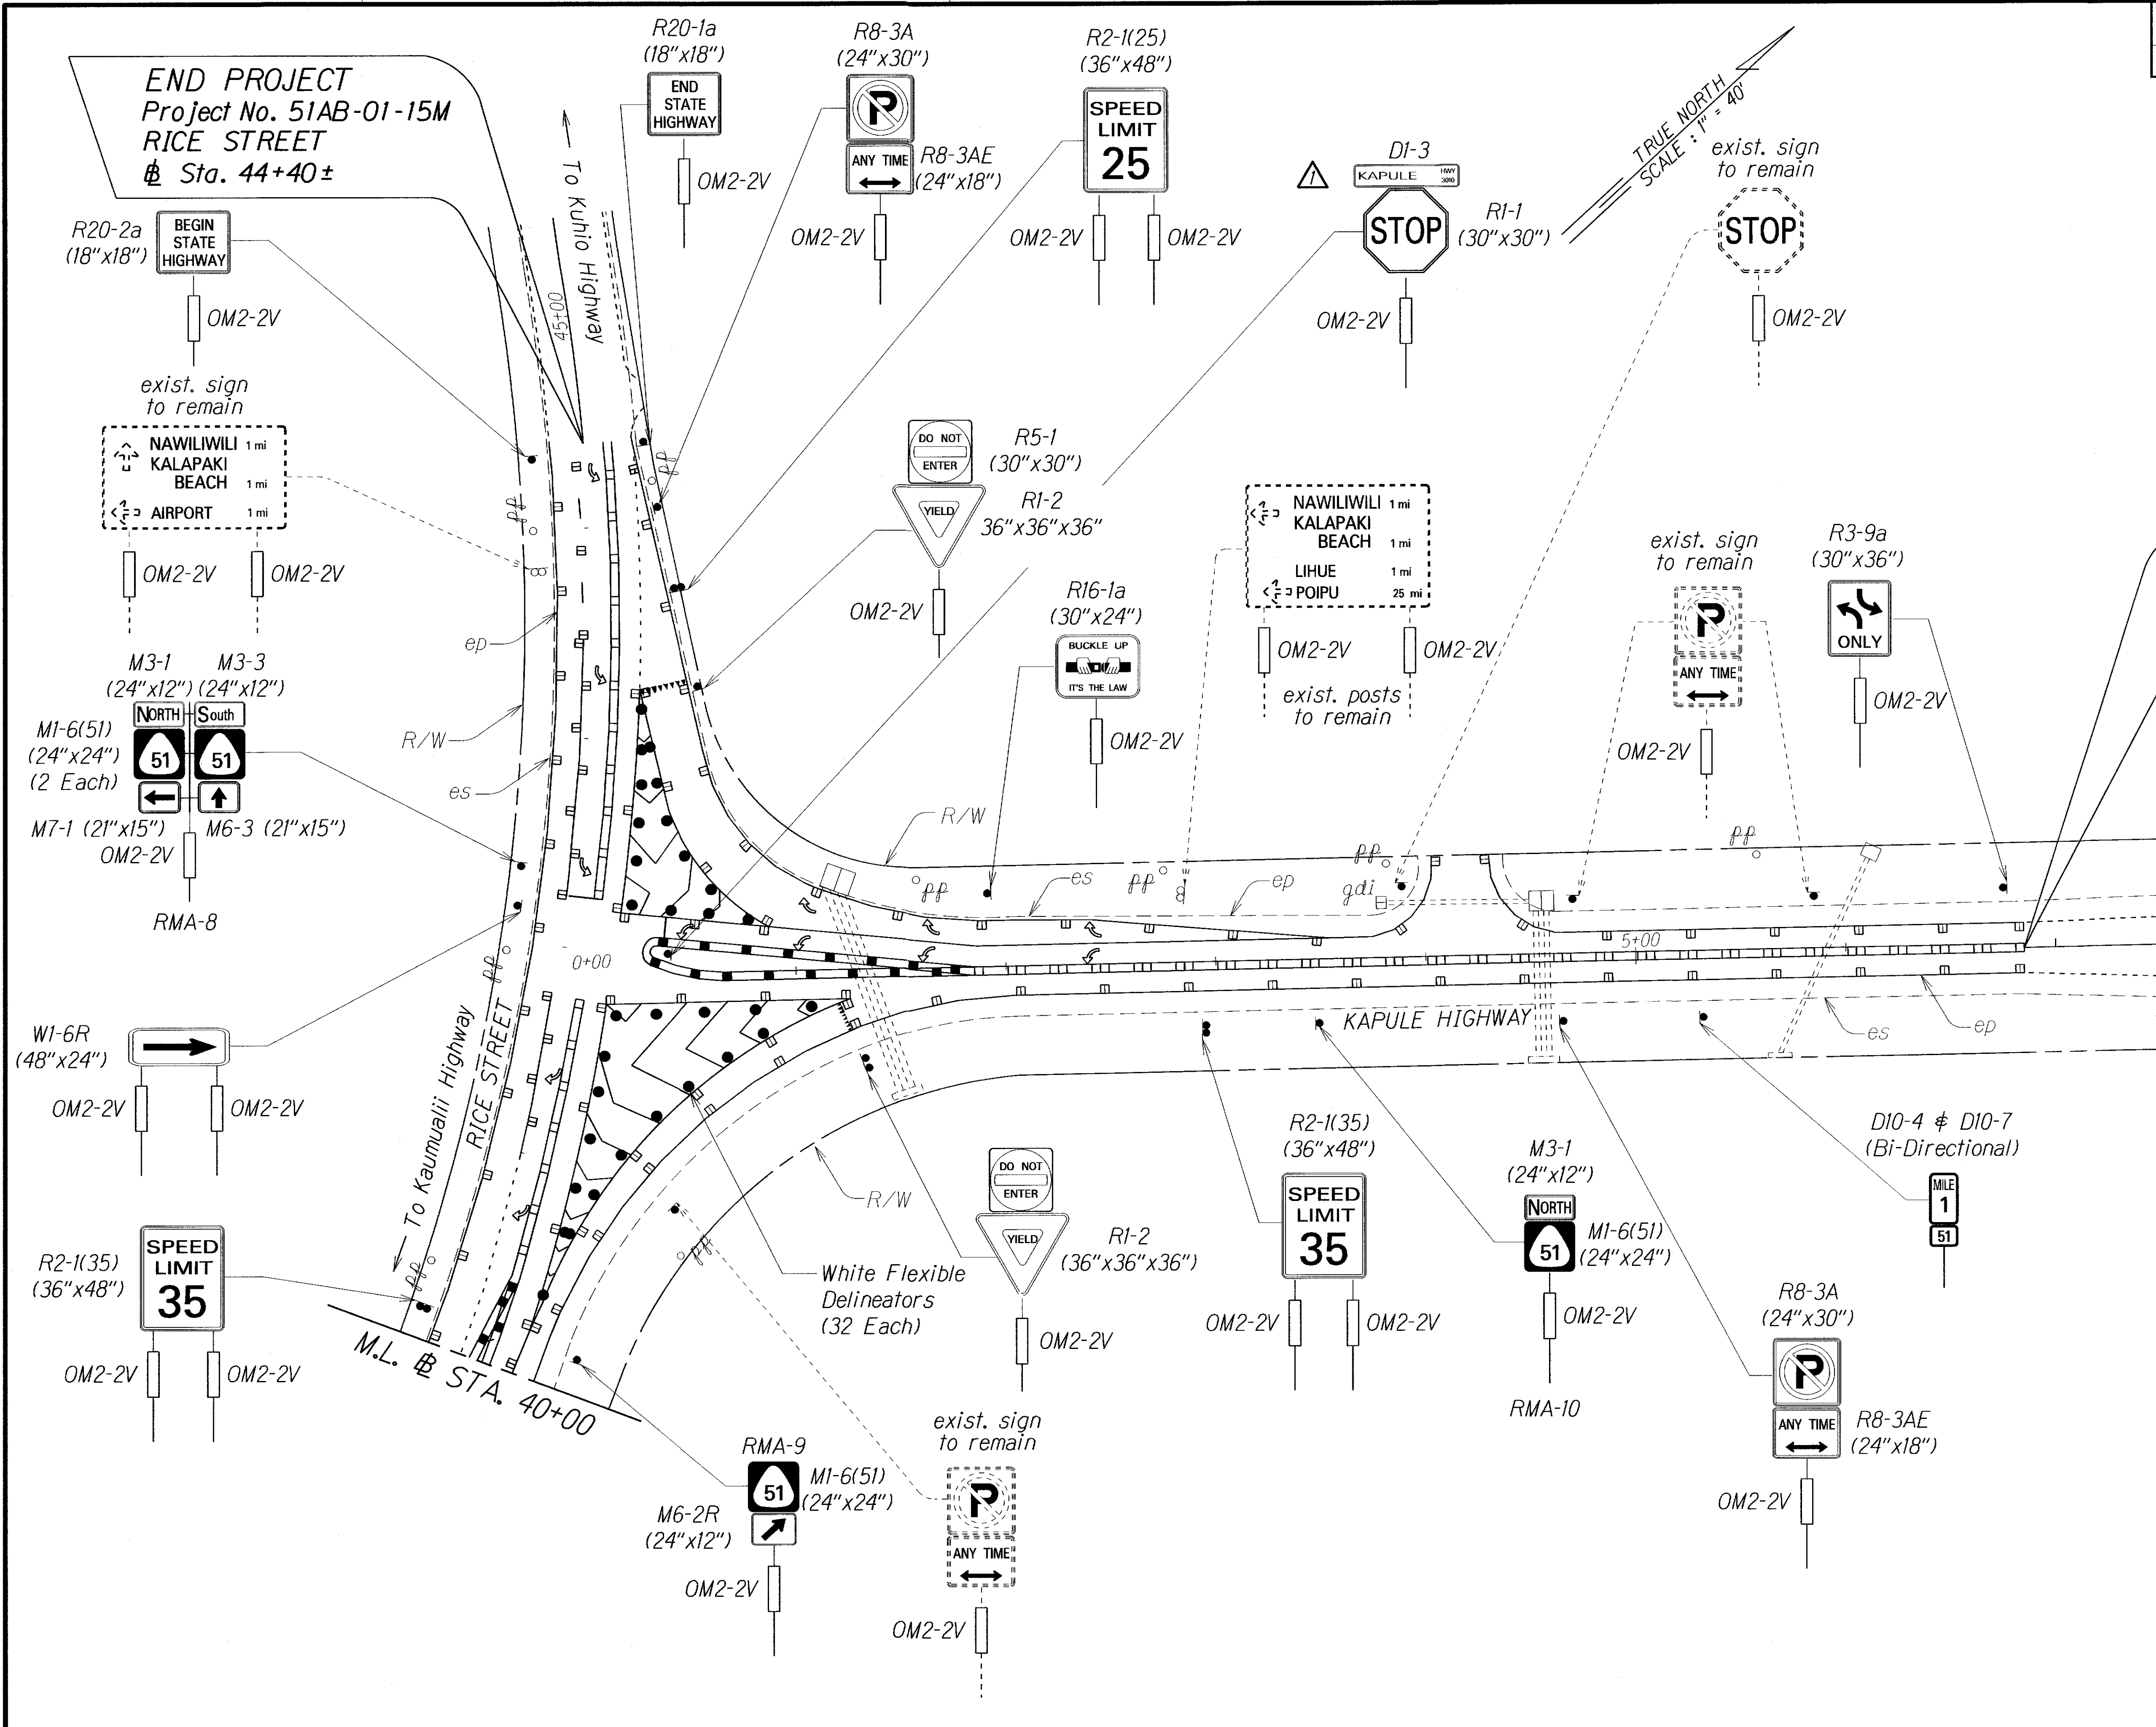

SURVEY PLOTTED BY	DATE
DRAWN BY	
DESIGNED BY	
QUANTITIES BY	
CHECKED BY	
ORIGINAL PLAN	
NOTE BOOK	
DATE	
No.	

11/9/16	△ - Street Name Sign
DATE	REVISION
STATE OF HAWAII DEPARTMENT OF TRANSPORTATION HIGHWAYS DIVISION	
PAVEMENT MARKING	
TRAFFIC SIGNING PLAN	
WAAPA ROAD/RICE STREET/ KAPULE HIGHWAY RESURFACING Wilcox Road to Halau Street Project No. 51AB-01-15M	
Scale: 1" = 40'	Date: May 2016
SHEET No. 75 OF 5 SHEETS	