



LEGEND

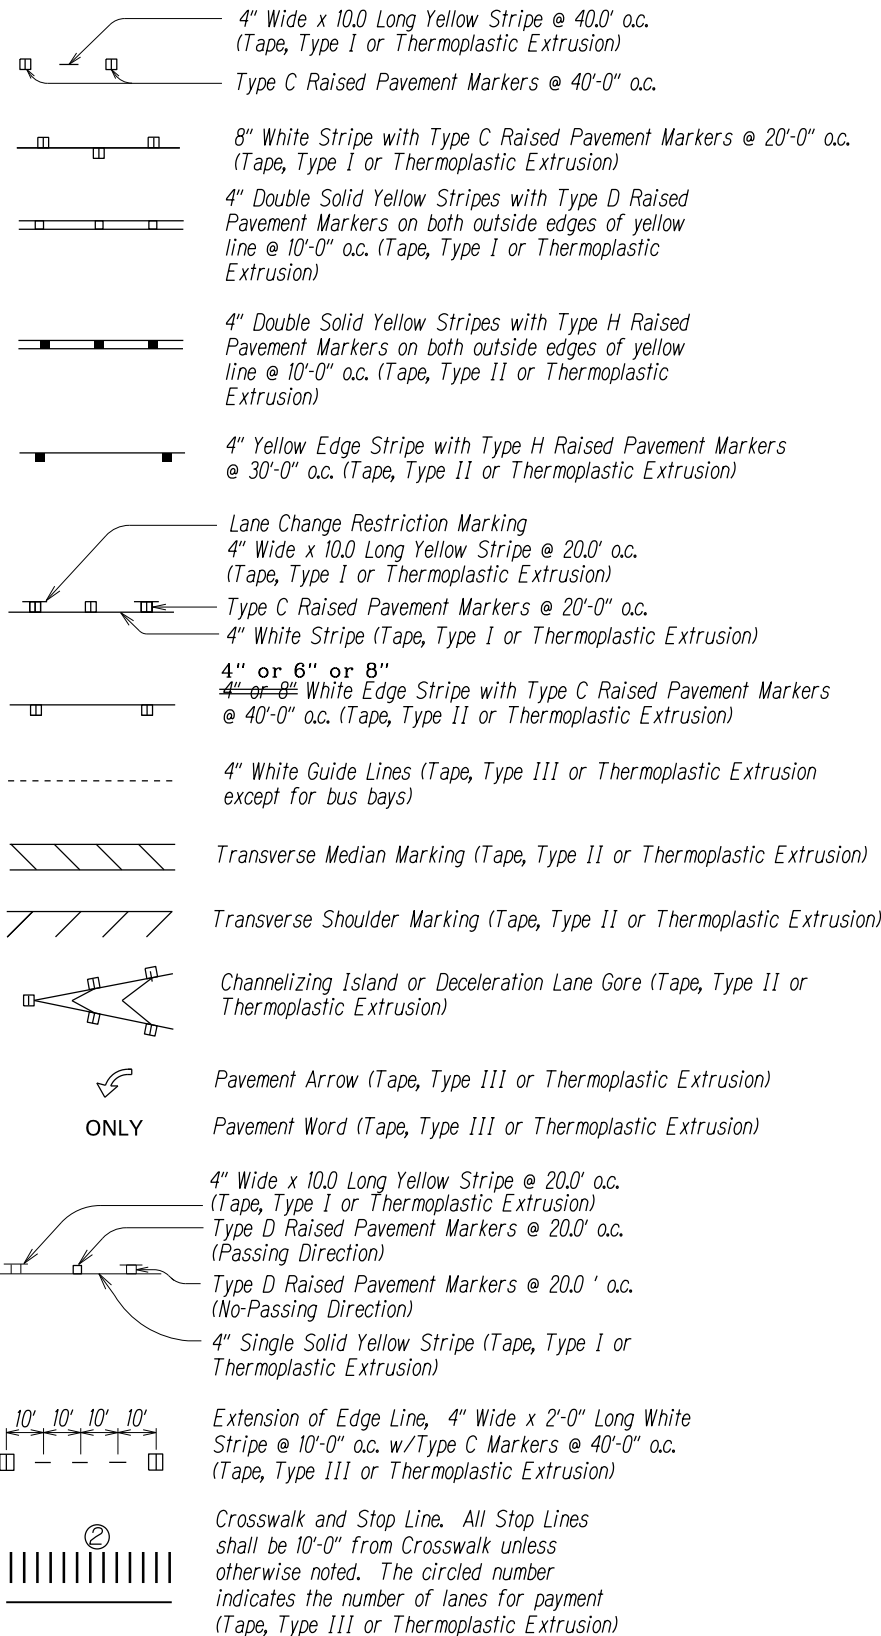


NOTES


- Layout of pavement markings and striping shall be done by the Contractor and approved by the Engineer prior to any installation work.
- Existing pavement markings not incorporated in the final traffic pattern shall be removed as directed by the Engineer. Costs shall be incidental to the various pavement marking items.
- Raised pavement markers shall not be installed within crosswalks.
- Final locations of all stop lines shall be approved by the Engineer prior to installation.
- All pavement striping shall be as noted on the legend or plans.
- Pavement marking (Tape or Thermoplastic Extrusion) over existing and new pavement shall be applied with an approved primer as recommended by the manufacturer and as approved by the Engineer. The primer shall be allowed to dry to the tacky stage prior to tape application.
- The Contractor shall erect at the beginning of the project and at the end of the project advance construction warning signs as indicated on the plans or as directed by the Engineer. The signs shall be kept in place for the duration of the project and shall be maintained by the Contractor. These signs shall be placed in addition to the required traffic control signs called for in Section 645 - Work Zone Traffic Control. The advance construction warning signs shall be new and become the property of the Contractor.
- Bikelane pavement symbol and marking shall conform to the latest editions and amendments of the Manual on Uniform Traffic Control Devices.
- All pavement markings and striping at portland cement concrete pavement shall be surrounded by a 2" wide non-reflective black border. Non-reflective boarder shall be Sealmaster Fast-Dry Traffic Paint or approved equal. Follow manufacturer's installation recommendation. This work shall be considered incidental to various contract items.

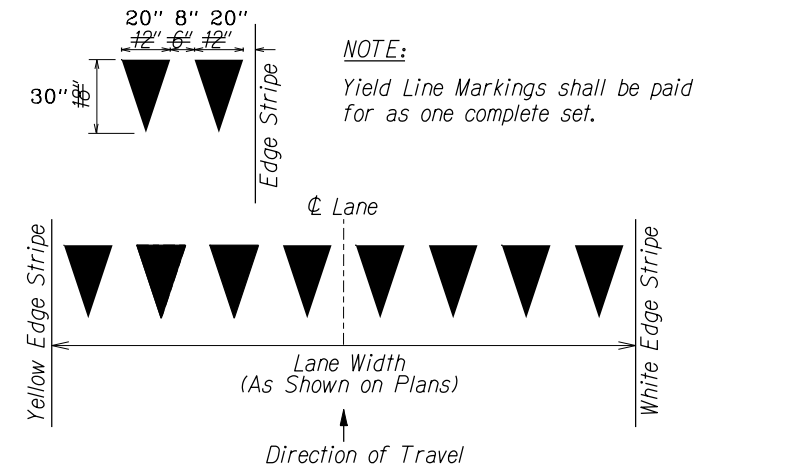

YIELD LINE DETAIL
Not to Scale

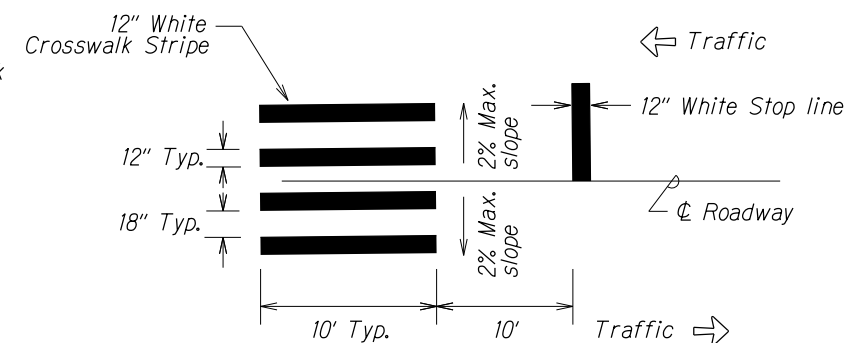

CROSSWALK DETAIL
Not to Scale

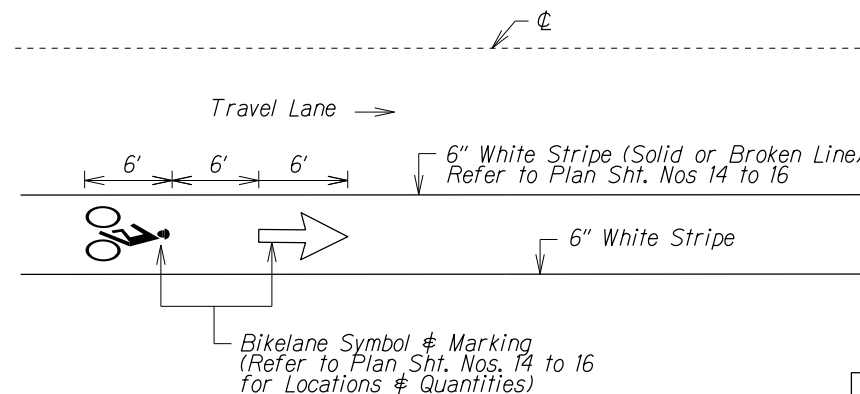

PAVEMENT MARKING FOR BICYCLE LANE
Not to Scale

LEGEND FOR AS-BUILT POSTINGS	
	Squiggly line for as-built deletion
	Double line for as-built deletion
Roadway	Text for as-built posting

STATE OF HAWAII DEPARTMENT OF TRANSPORTATION HIGHWAYS DIVISION
PAVEMENT MARKING LEGEND, DETAILS, NOTES & SUMMARY
KAPULE HIGHWAY PAVEMENT REPAIR Halau Street to Ahukini Road Proj. No. 51B-01-17M
Date: Jan. 2017
SHEET No. 71 OF 4 SHEETS