
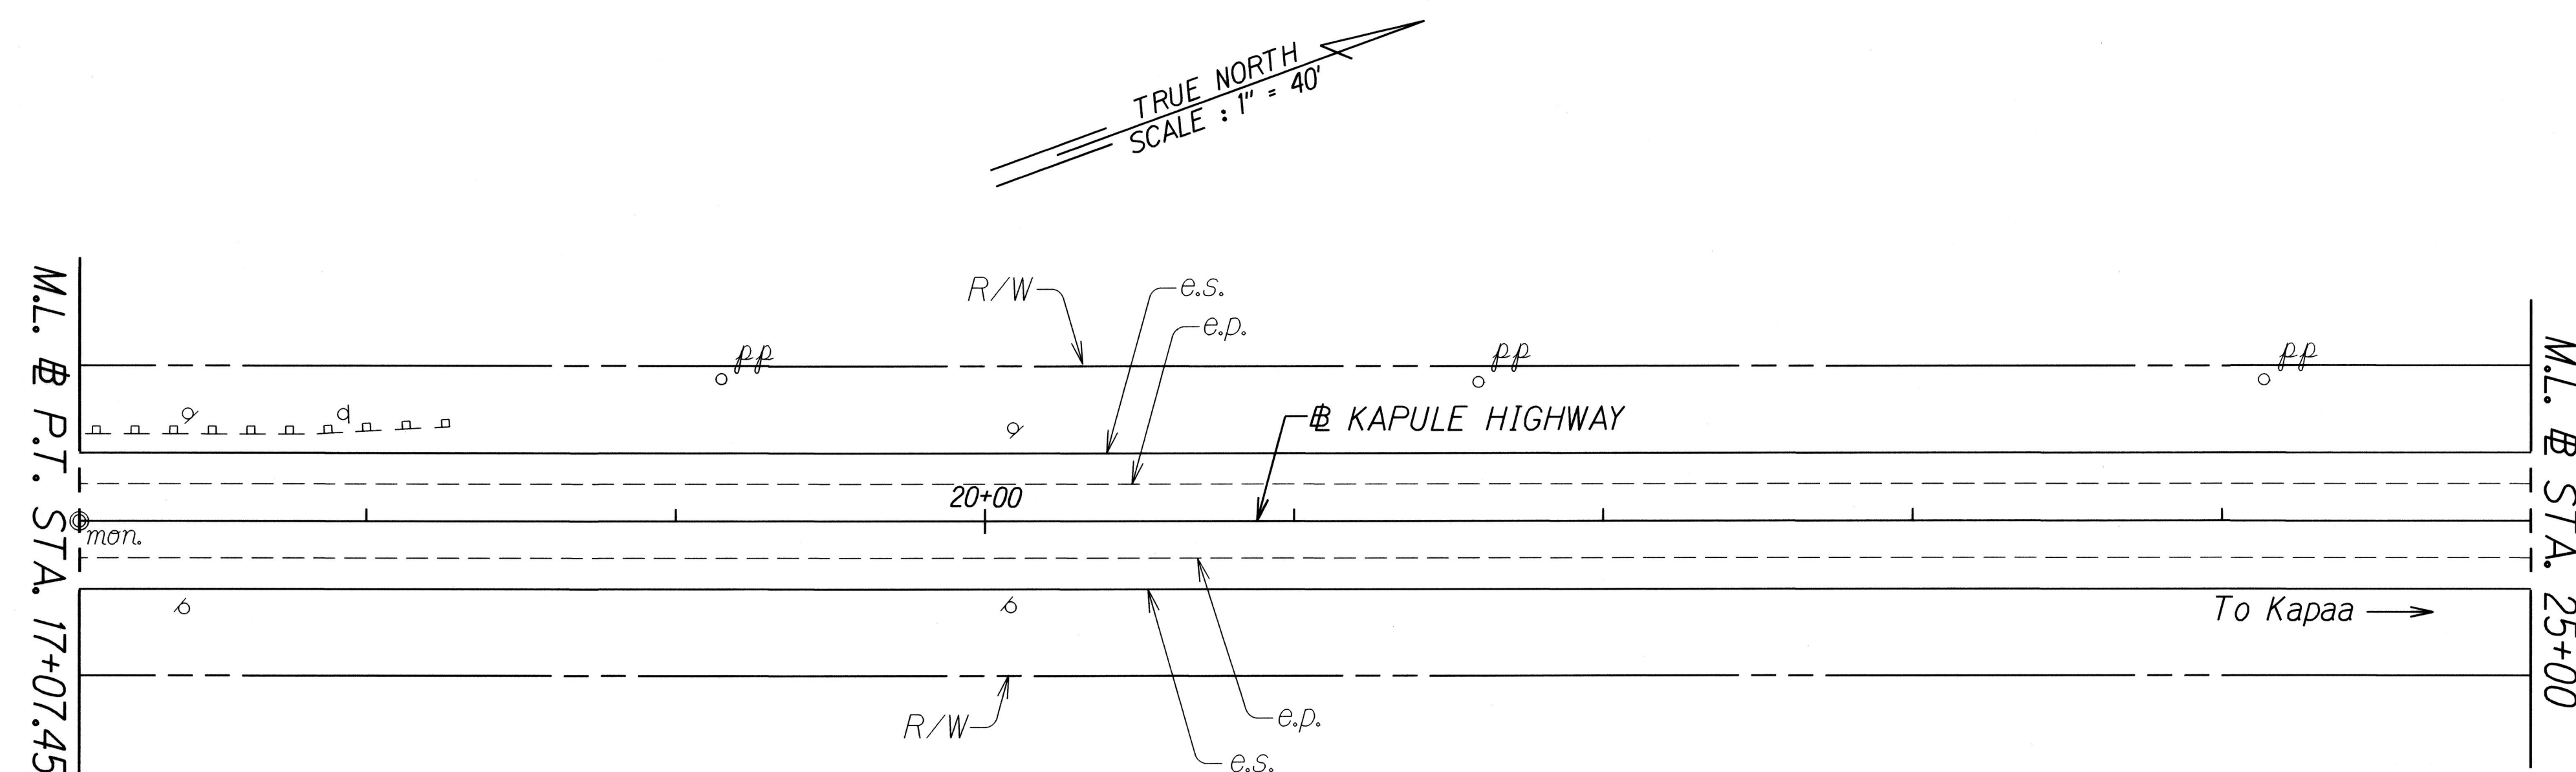


FED. ROAD DIST. NO.	STATE	PROJ. NO.	FISCAL YEAR	SHEET NO.	TOTAL SHEETS
HAWAII	HAW.	51B-01-17M	2017	10	21

⊕ CURVE DATA

$\Delta = 21^{\circ}27'00''$
 $R = 2,010.00$
 $T = 380.70$
 $C = 748.10$
 $LC = 752.49$

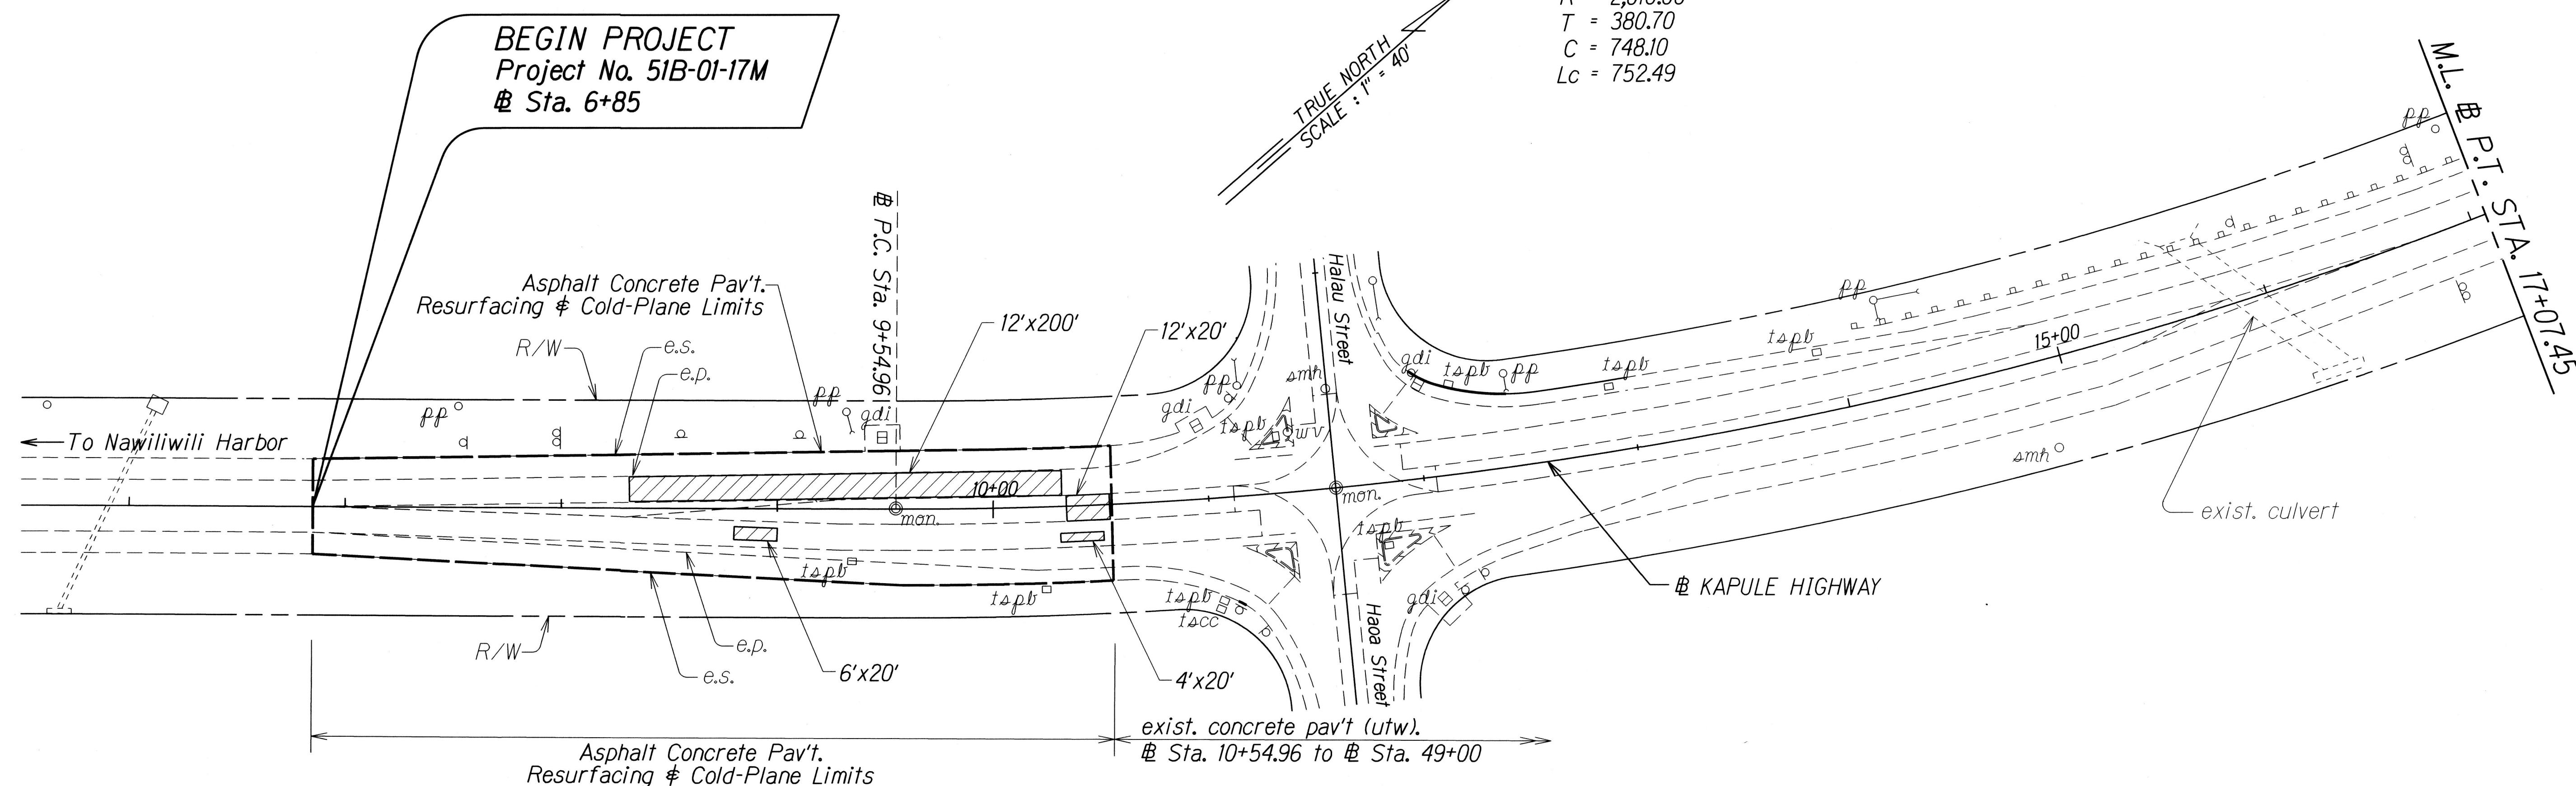

ORIGINAL PLAN	SURVEY PLOTTED BY	DATE
NOTE BOOK	DRAWN BY	
	TRACED BY	
	QUANTITIES BY	
	CHECKED BY	


STATE OF HAWAII
 DEPARTMENT OF TRANSPORTATION
 HIGHWAYS DIVISION

ROADWAY PLAN
 KAPULE HIGHWAY PAVEMENT REPAIR
 Halau Street to Ahukini Road
 Project No. 51B-01-17M

Scale: 1" = 40' Date: Jan. 2017


SHEET No. 1 OF 3 SHEETS

FED. ROAD DIST. NO.	STATE	PROJ. NO.	FISCAL YEAR	SHEET NO.	TOTAL SHEETS
HAWAII	HAW.	51B-01-17M	2017	11	21

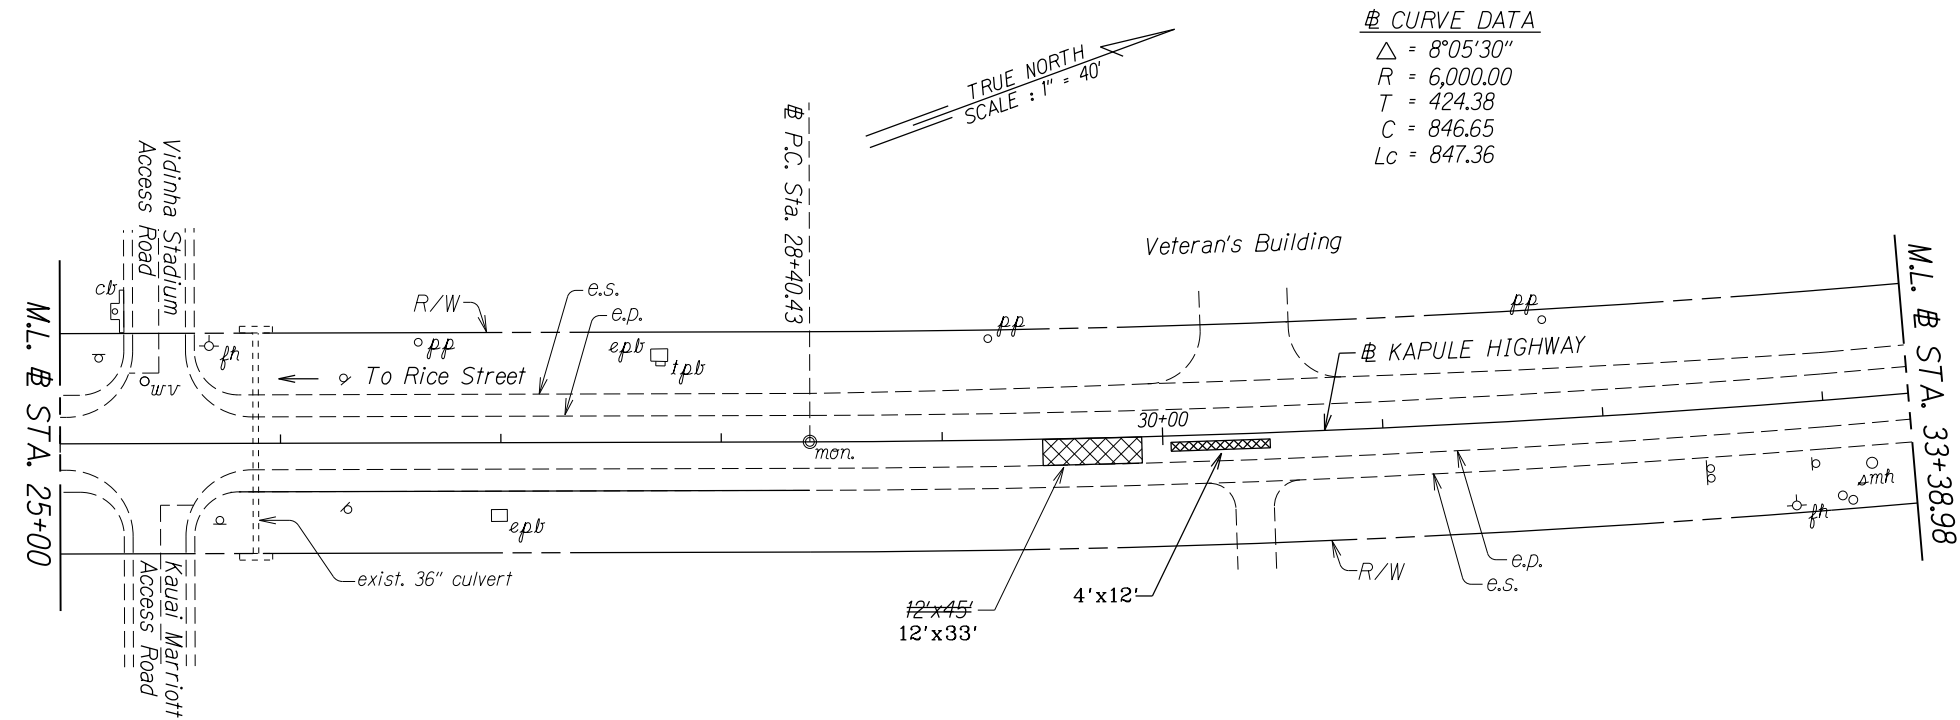

Δ CURVE DATA
Δ = 8°05'30"
R = 6,000.00
T = 424.38
C = 846.65
Lc = 847.36

Δ CURVE DATA
Δ = 8°05'30"
R = 6,000.00
T = 424.38
C = 846.65
Lc = 847.36

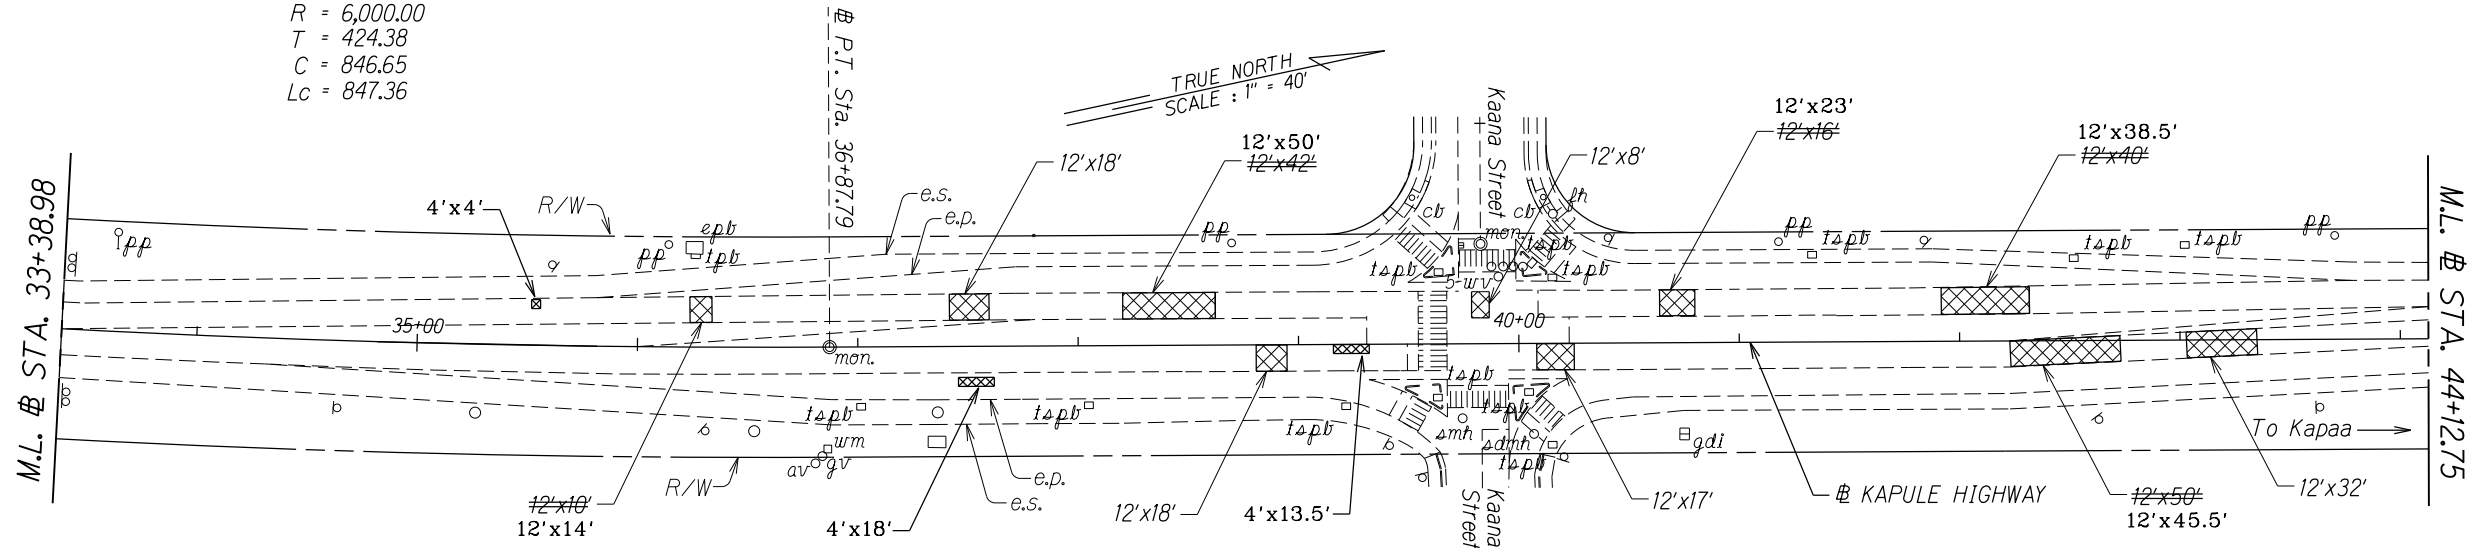

DATE	1/11/17
SURVEY PLOTTED BY	Y
DESIGNED BY	Y
QUANTITIES BY	Y
CHECKED BY	Y

LEGEND FOR AS-BUILT POSTINGS	
	Squiggly line for as-built deletion
	Double line for as-built deletion
Roadway	Text for as-built posting

STATE OF HAWAII
DEPARTMENT OF TRANSPORTATION
HIGHWAYS DIVISION


ROADWAY PLAN
KAPULE HIGHWAY PAVEMENT REPAIR
Halau Street to Ahukini Road
Project No. 51B-01-17M

Scale: 1" = 40' Date: Jan. 2017


SHEET No. 2 OF 3 SHEETS

"AS-BUILT"

FED. ROAD DIST. NO.	STATE	PROJ. NO.	FISCAL YEAR	SHEET NO.	TOTAL SHEETS
HAWAII	HAW.	51B-01-17M	2017	12	21

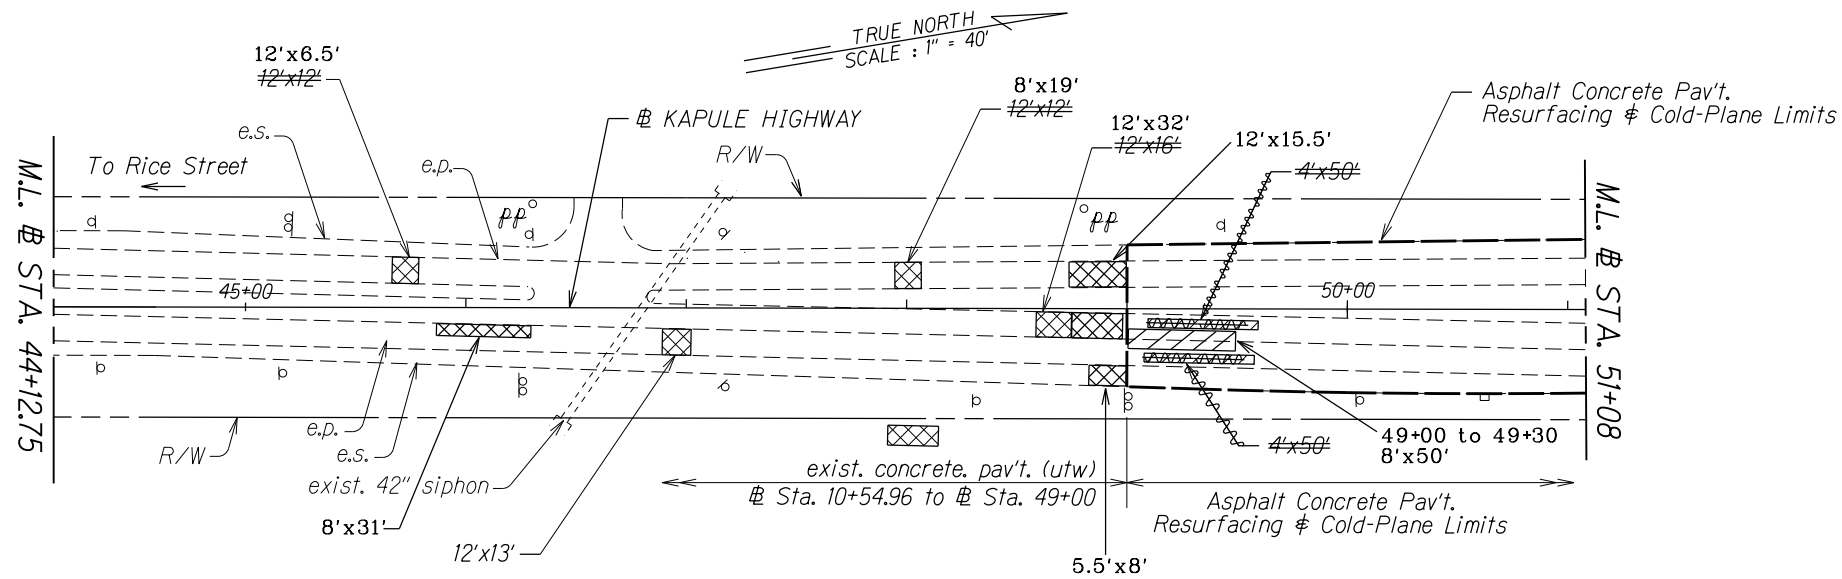

END PROJECT
Project No. 51B-01-17M
Sta. 56+29

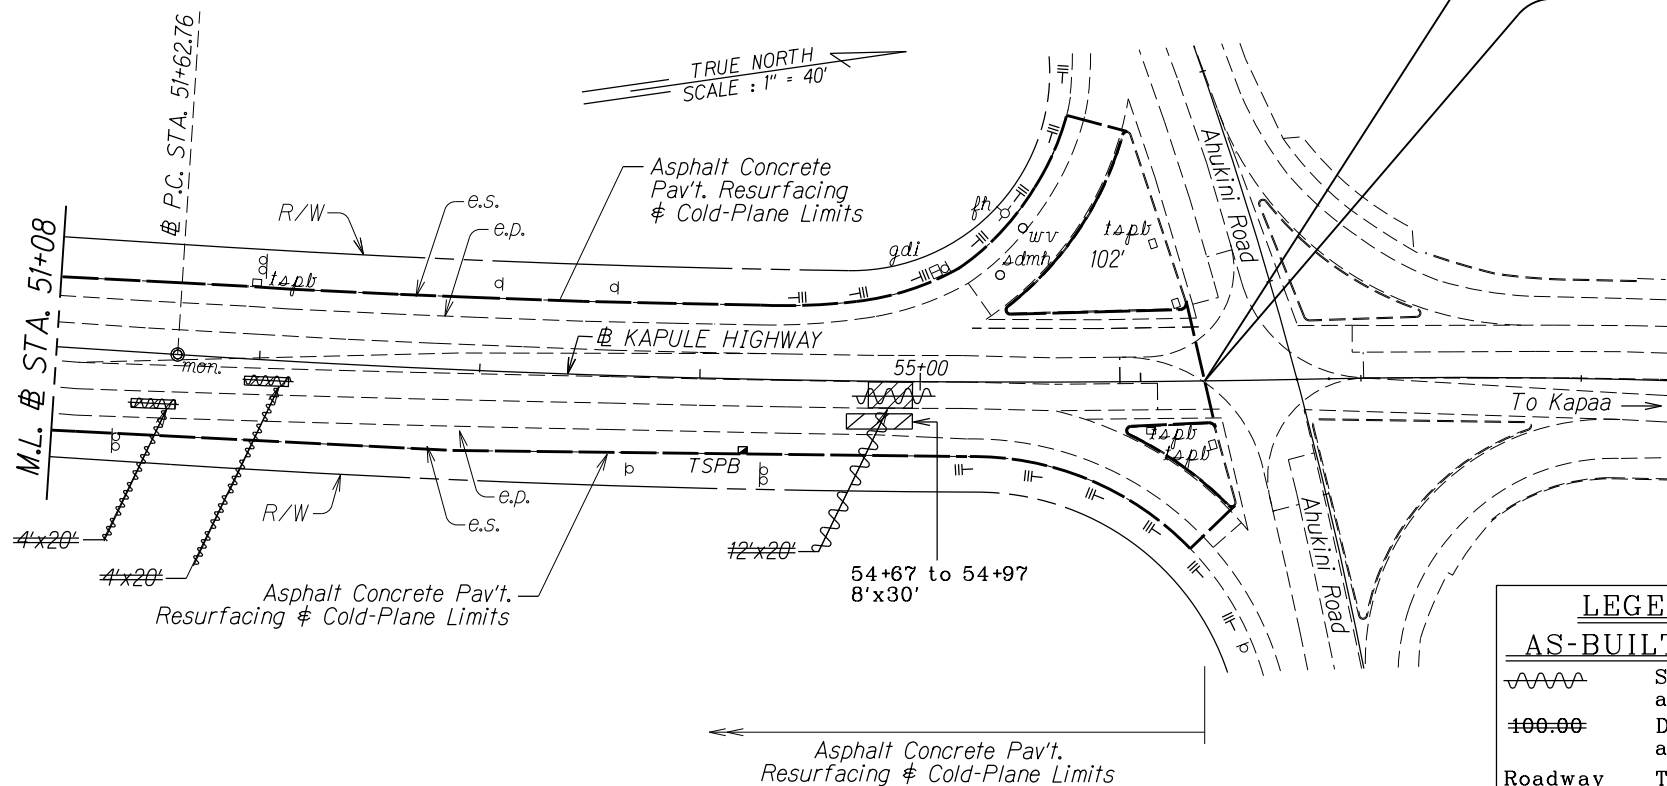

LEGEND FOR AS-BUILT POSTINGS	
	Squiggly line for as-built deletion
	Double line for as-built deletion
Roadway	Text for as-built posting

STATE OF HAWAII
DEPARTMENT OF TRANSPORTATION
HIGHWAYS DIVISION

ROADWAY PLAN

KAPULE HIGHWAY PAVEMENT REPAIR
Halau Street to Ahukini Road
Project No. 51B-01-17M

Scale: 1" = 40' Date: Jan. 2017

SHEET No. 3 OF 3 SHEETS

"AS-BUILT"

ORIGINAL PLAN	DATE	BY
NOTE BOOK		
DESIGNED BY		
QUANTITIES BY		
CHECKED BY		