
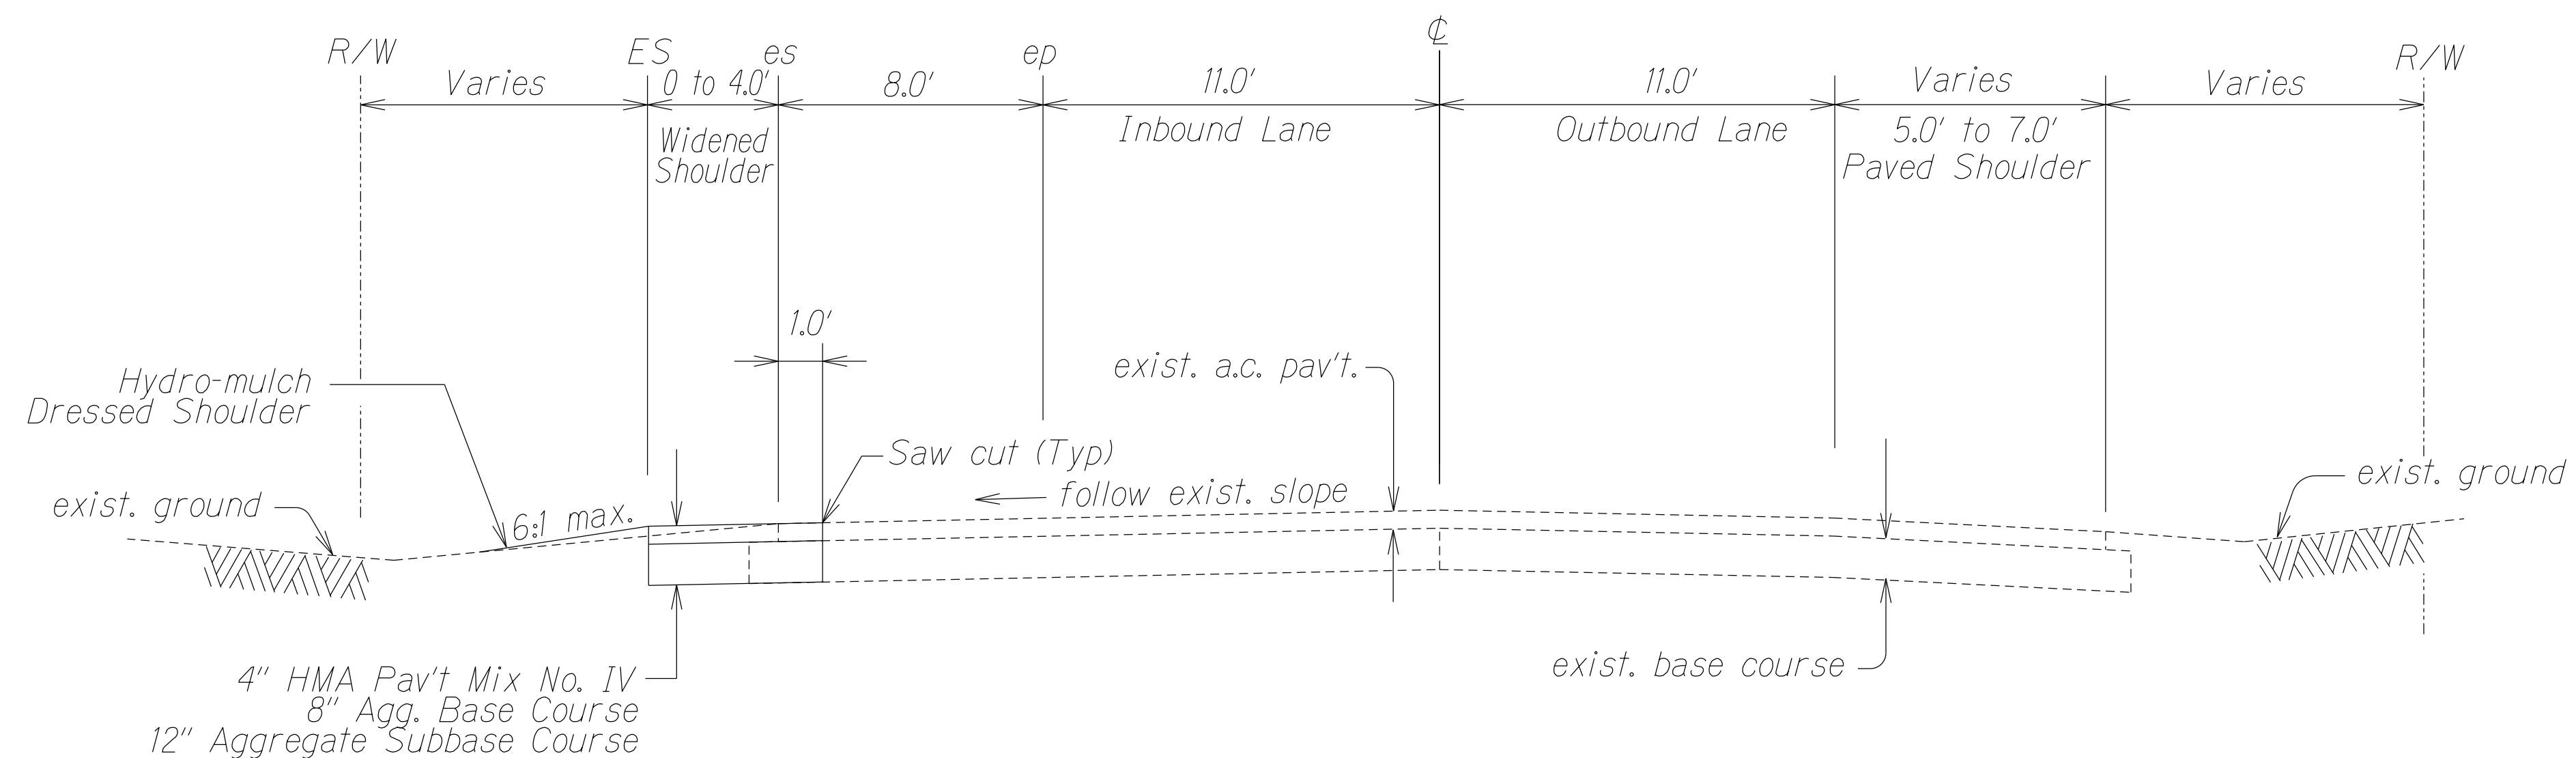


FED. ROAD DIST. NO.	STATE	FED-AID PROJ. NO.	FISCAL YEAR	SHEET NO.	TOTAL SHEETS
HAWAII	HAW.	HSIP-050-1(044)	2024	ADD.11	40

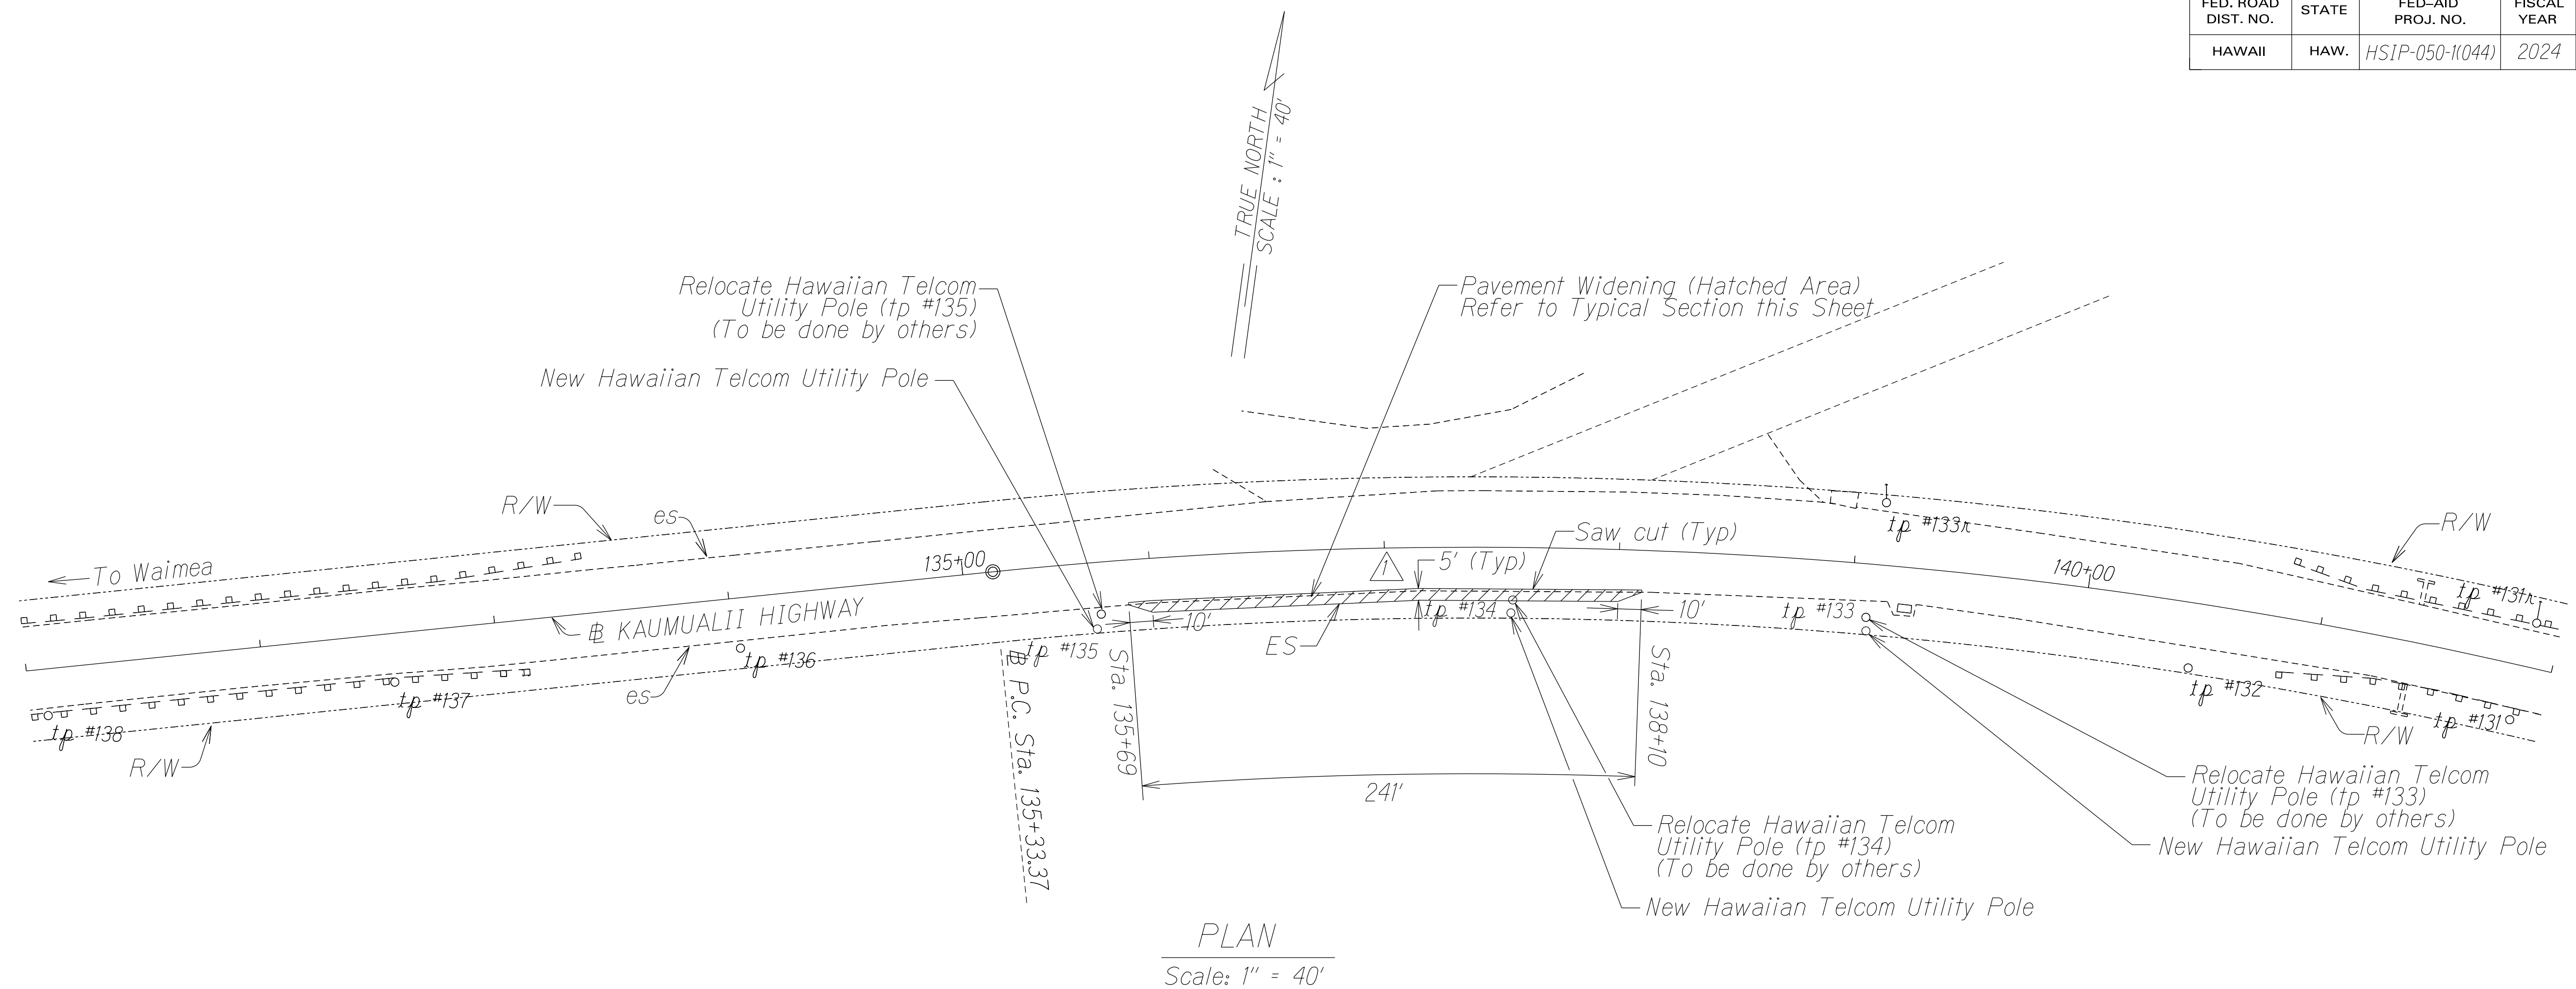

TYPICAL SECTION STA. 135+69 TO STA. 138+10

Not to Scale

APPROVED:


Manager, Hawaiian Telcom

Date


6/27/24	△ - Revise PLAN
DATE	REVISION
STATE OF HAWAII DEPARTMENT OF TRANSPORTATION HIGHWAYS DIVISION	
ROADWAY PLAN	
KAUMUALII HIGHWAY SAFETY IMPROVEMENTS Kipu Road to Omao Road Fed-Aid Project No. HSIP-050-1(044)	
Scale as shown	Date: May, 2024
SHEET No. 1	OF 2 SHEETS

ADD.11

FED. ROAD DIST. NO.	STATE	FED-AID PROJ. NO.	FISCAL YEAR	SHEET NO.	TOTAL SHEETS
HAWAII	HAW.	HSIP-050-1(044)	2024	ADD.12	40

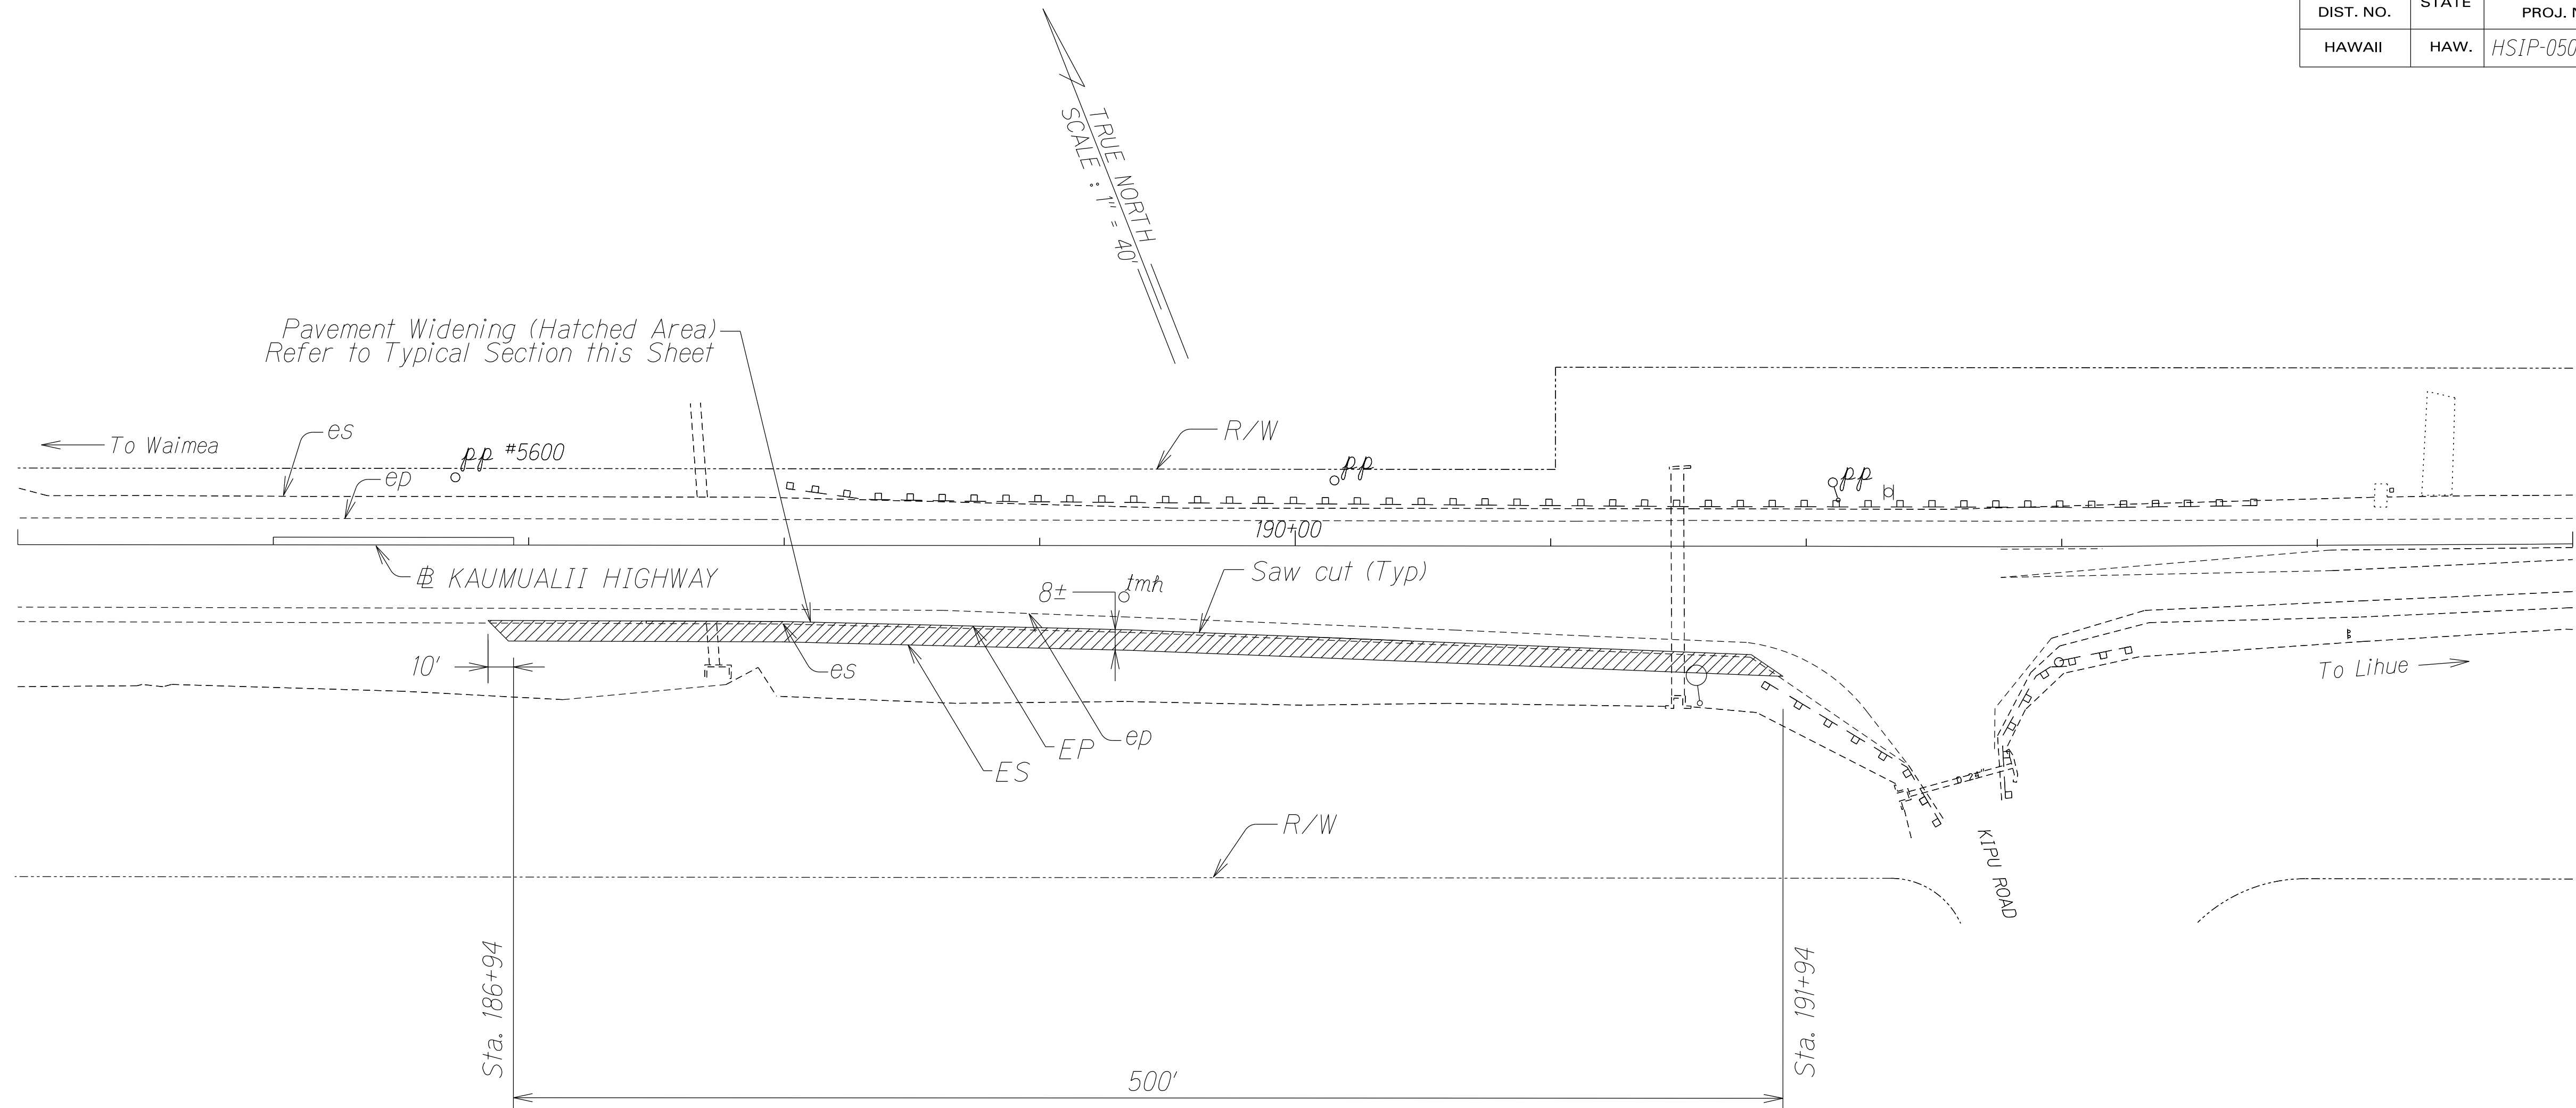

PLAN
Scale: 1" = 40'

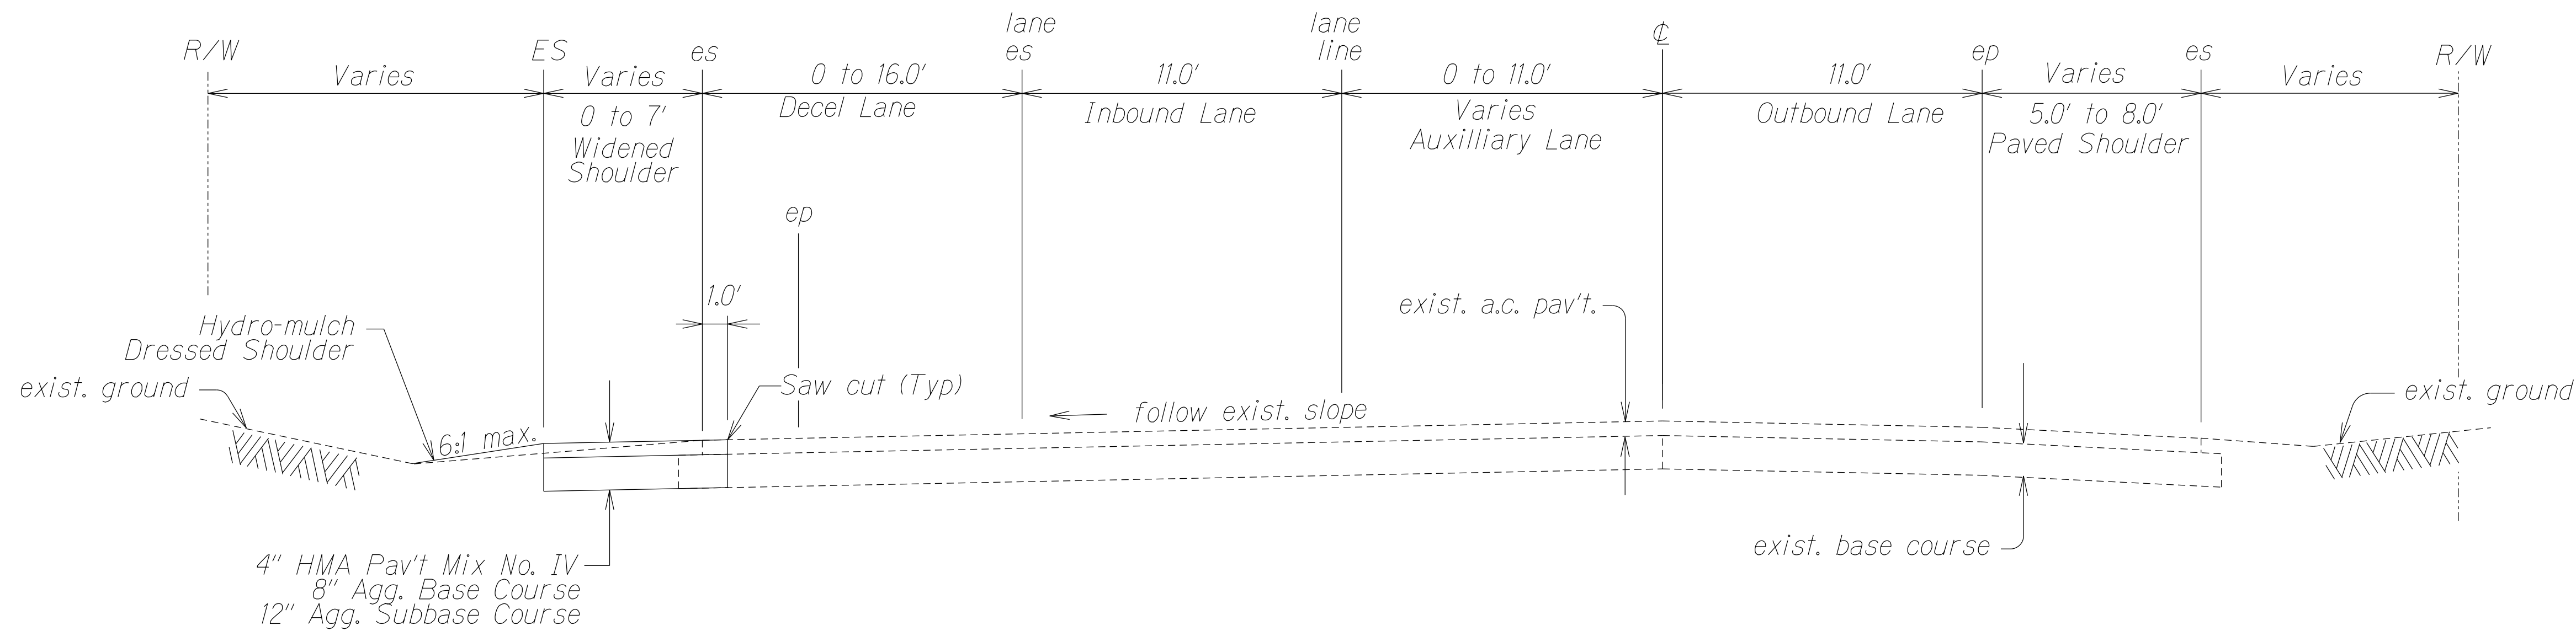

TYPICAL SECTION STA. 186+94 TO STA. 191+94
Not to Scale

6/27/24	1 - Revise PLAN
6/27/24	1 - Revise TYPICAL SECTION
DATE	REVISION
STATE OF HAWAII DEPARTMENT OF TRANSPORTATION HIGHWAYS DIVISION	
ROADWAY PLAN	
KAUMUALII HIGHWAY SAFETY IMPROVEMENTS Kipu Road to O'ao Road Fed-Aid Project No. HSIP-050-1(044)	
Scale as shown Date: May, 2024	
SHEET No. 2 OF 2 SHEETS	