




FED. ROAD DIST. NO.	STATE	PROJ. NO.	FISCAL YEAR	SHEET NO.	TOTAL SHEETS
KAUAI	HAW.	51AB-01-23	2025	13	28

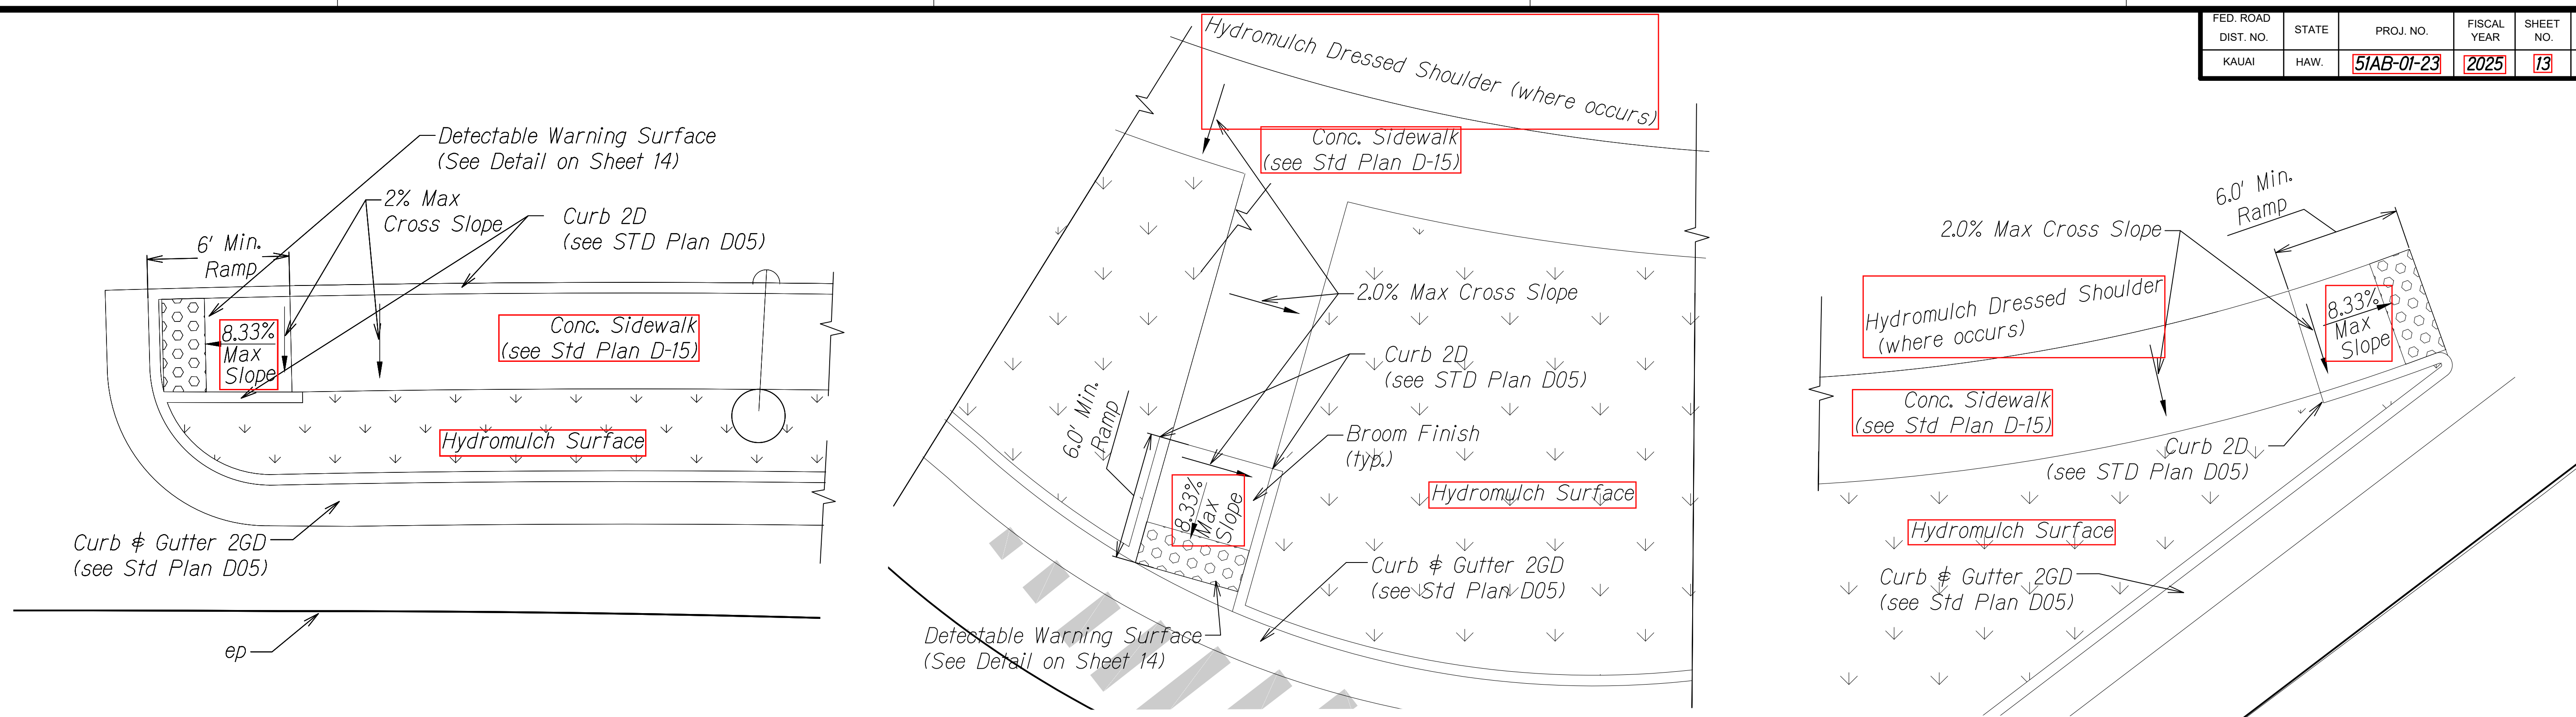


CURB RAMPS @ END OF CONCRETE SIDEWALKS
Scale: 1" : 4'

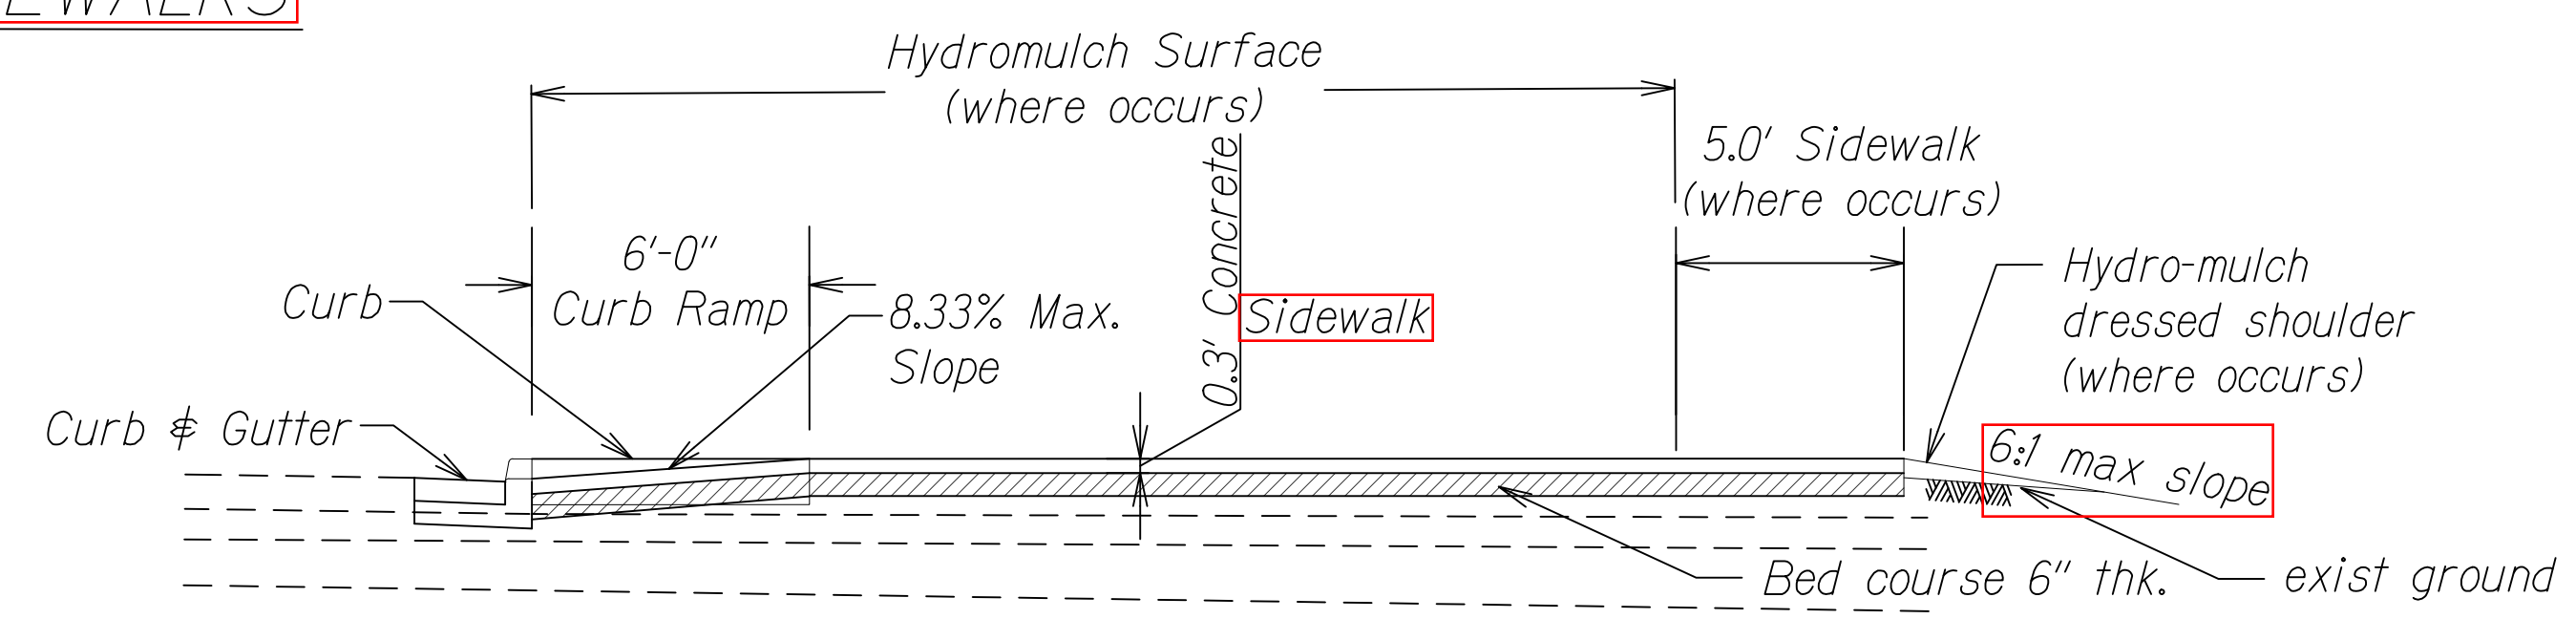

LONGITUDINAL SECTION
CURB RAMP @ END OF CONCRETE SIDEWALK
Scale: 1" : 4'

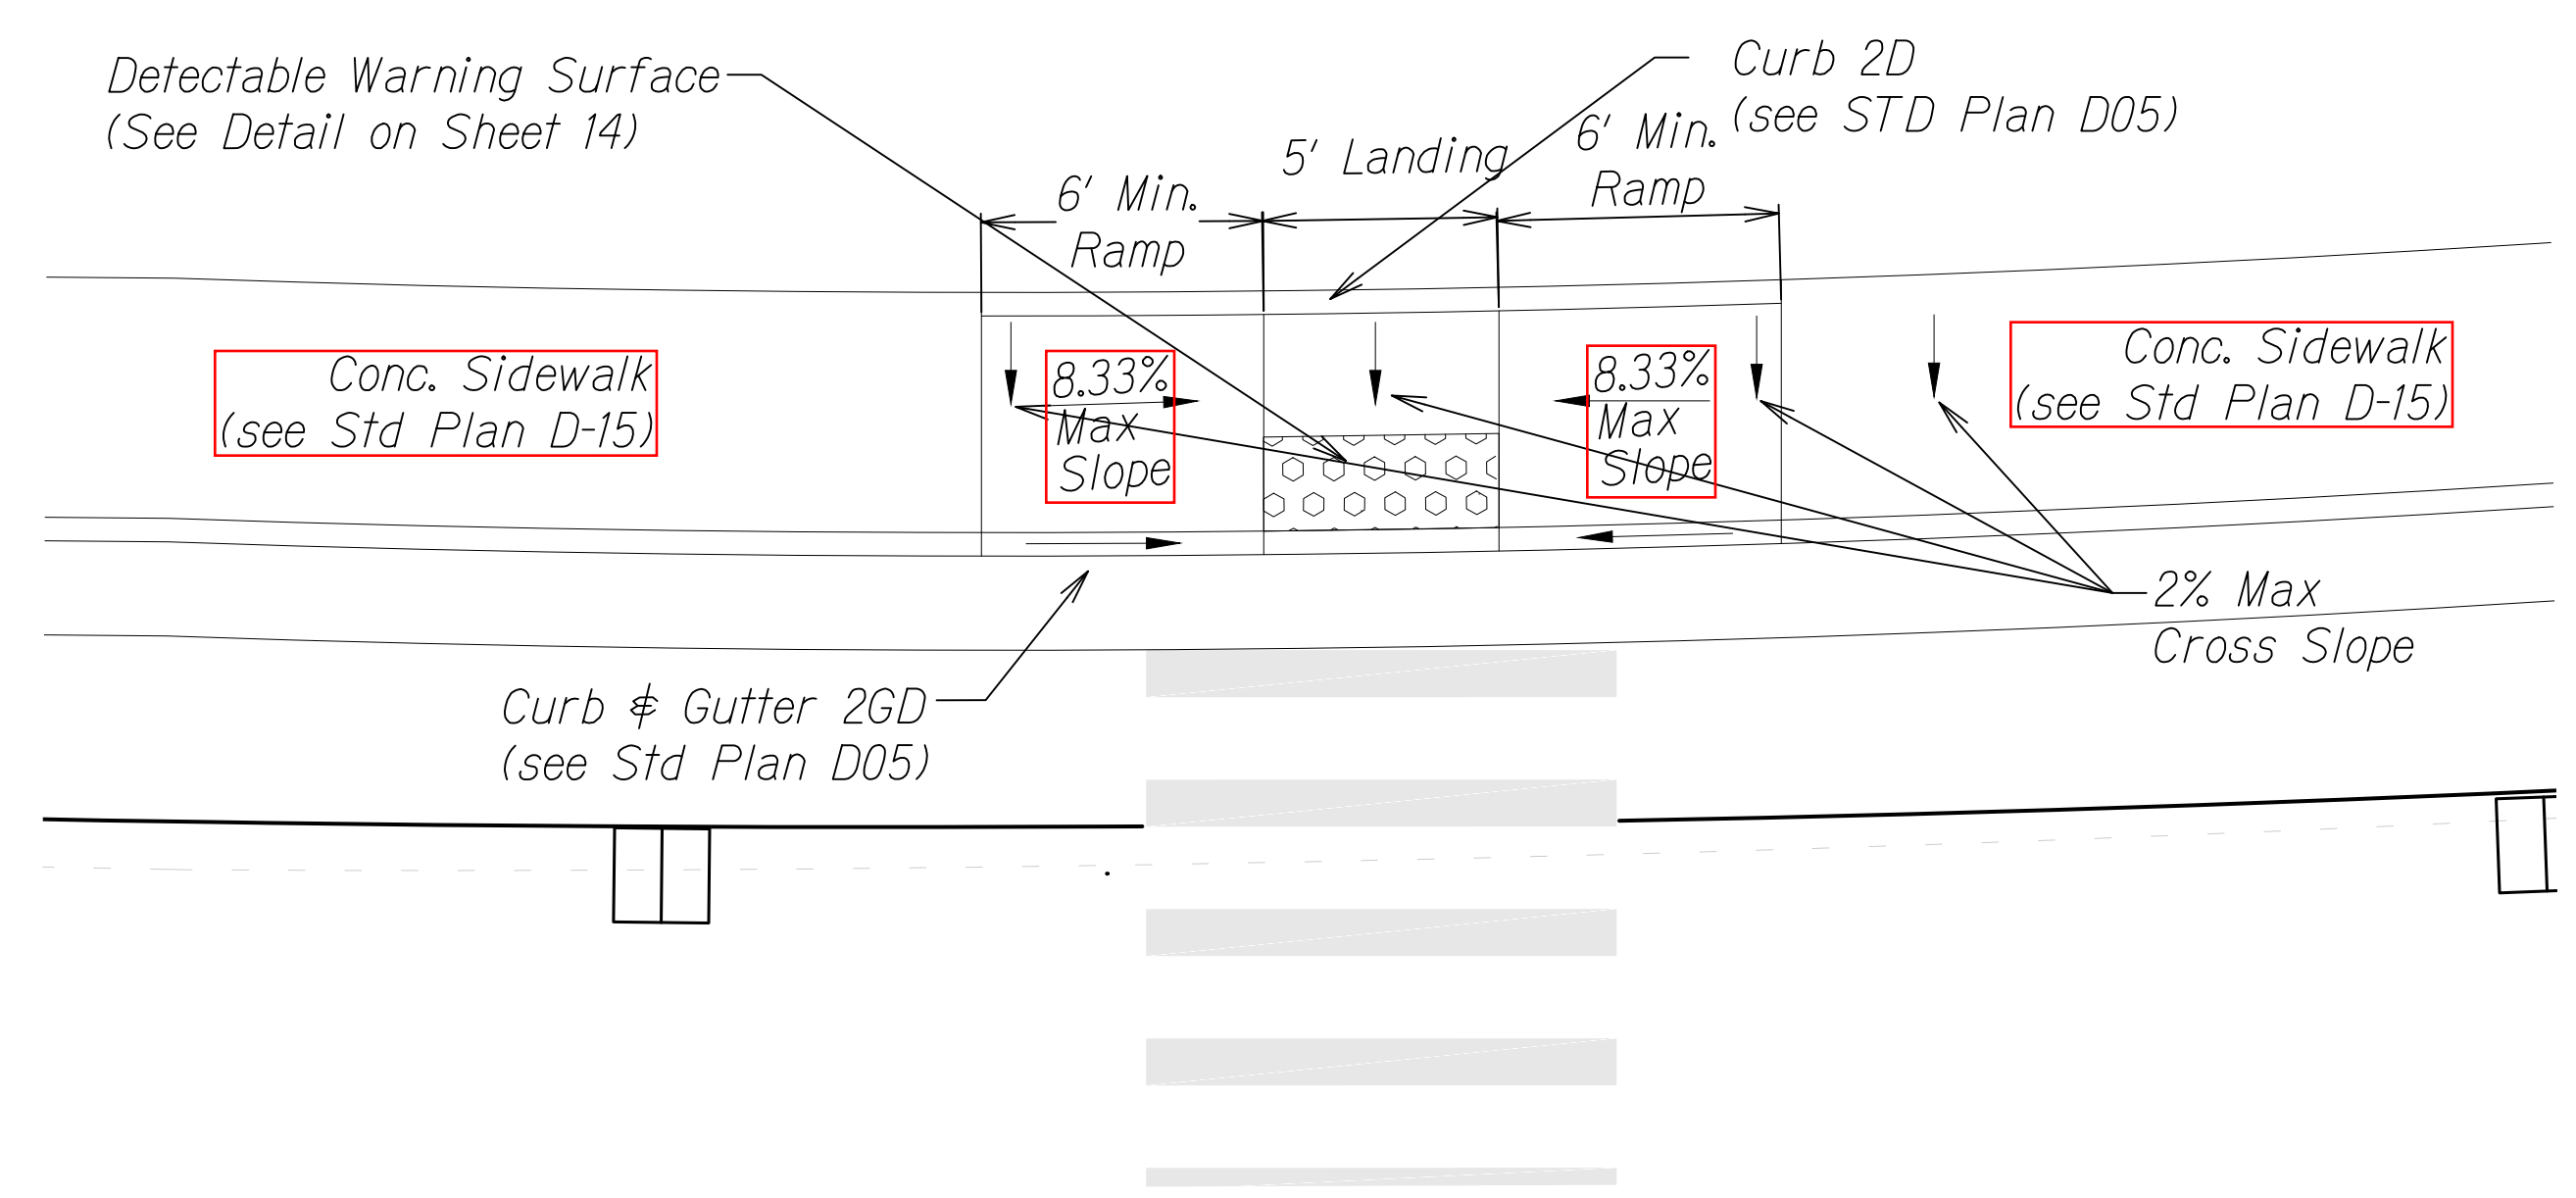

CURB RAMP ALONG CONCRETE SIDEWALK
Scale: 1" : 4'

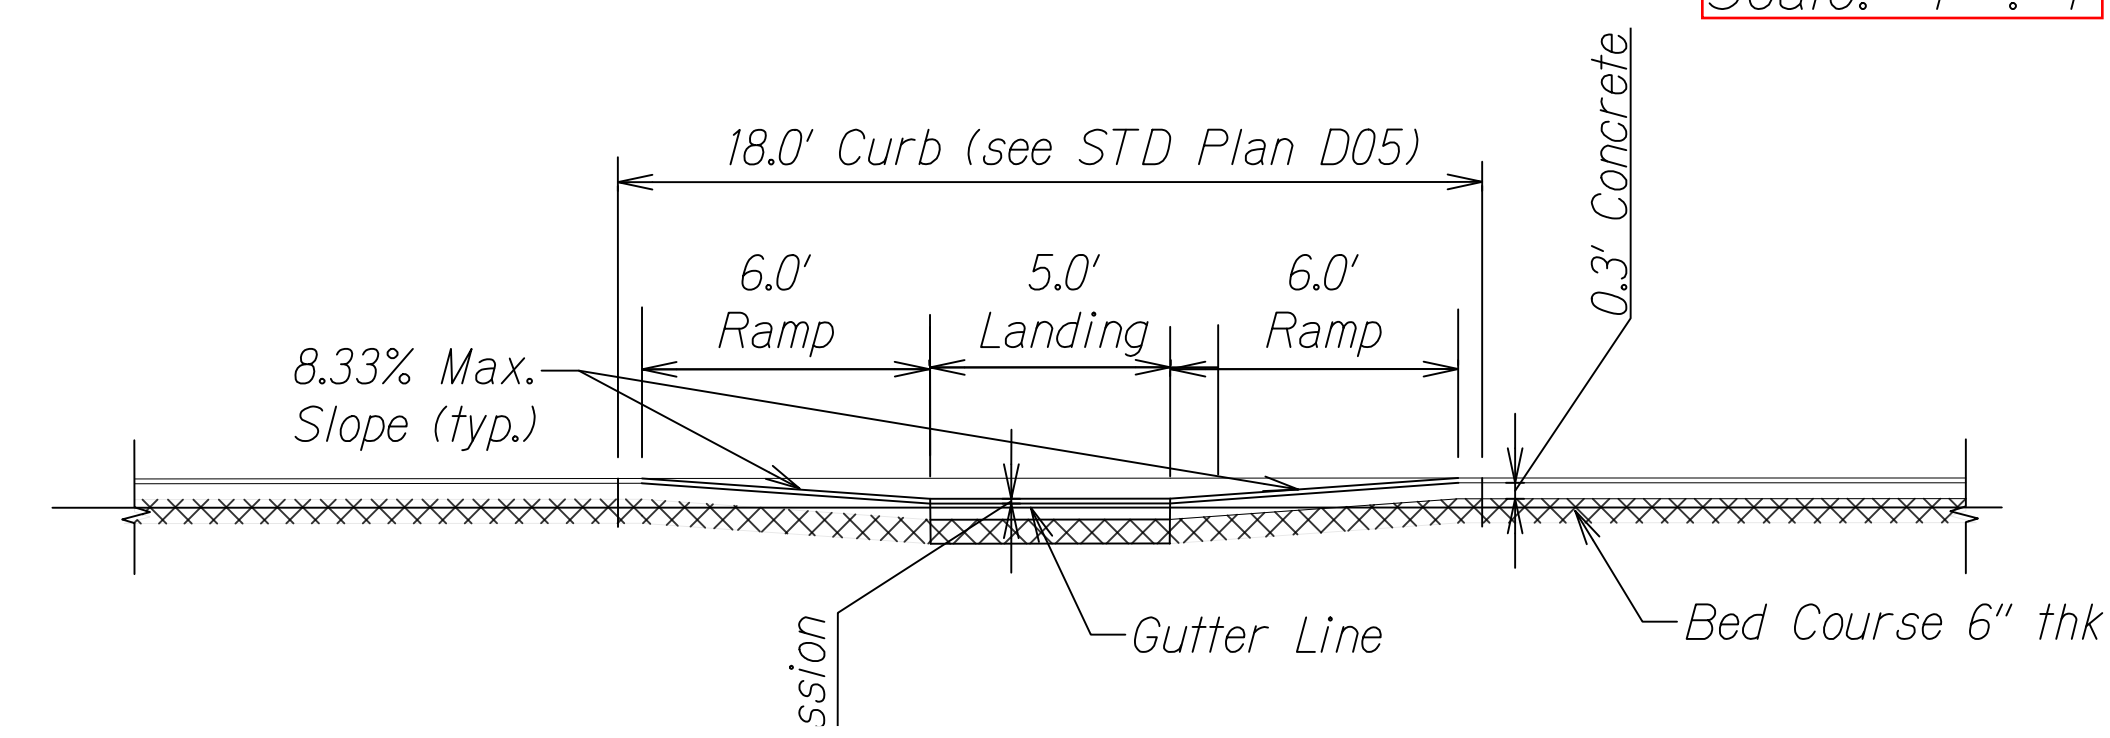

LONGITUDINAL SECTION
CURB RAMP ALONG CONCRETE SIDEWALK
Scale: 1" : 4'

STATE OF HAWAII
DEPARTMENT OF TRANSPORTATION
HIGHWAYS DIVISION


MISCELLANEOUS DETAIL

RICE STREET IMPROVEMENTS
Nawiliwili Bridge to
Kauai Veterans Memorial Highway
Project No. 51AB-01-23
Date: Sept. 2024


SHEET No. 1 OF 3 SHEETS

DATE	0000
DESIGNED BY	
CHECKED BY	
IN CHARGE	
NOTED BY	
REVISIONS	
NO.	

FED. ROAD DIST. NO.	STATE	PROJ. NO.	FISCAL YEAR	SHEET NO.	TOTAL SHEETS
KAUAI	HAW.	51AB-01-23	2025	15	28

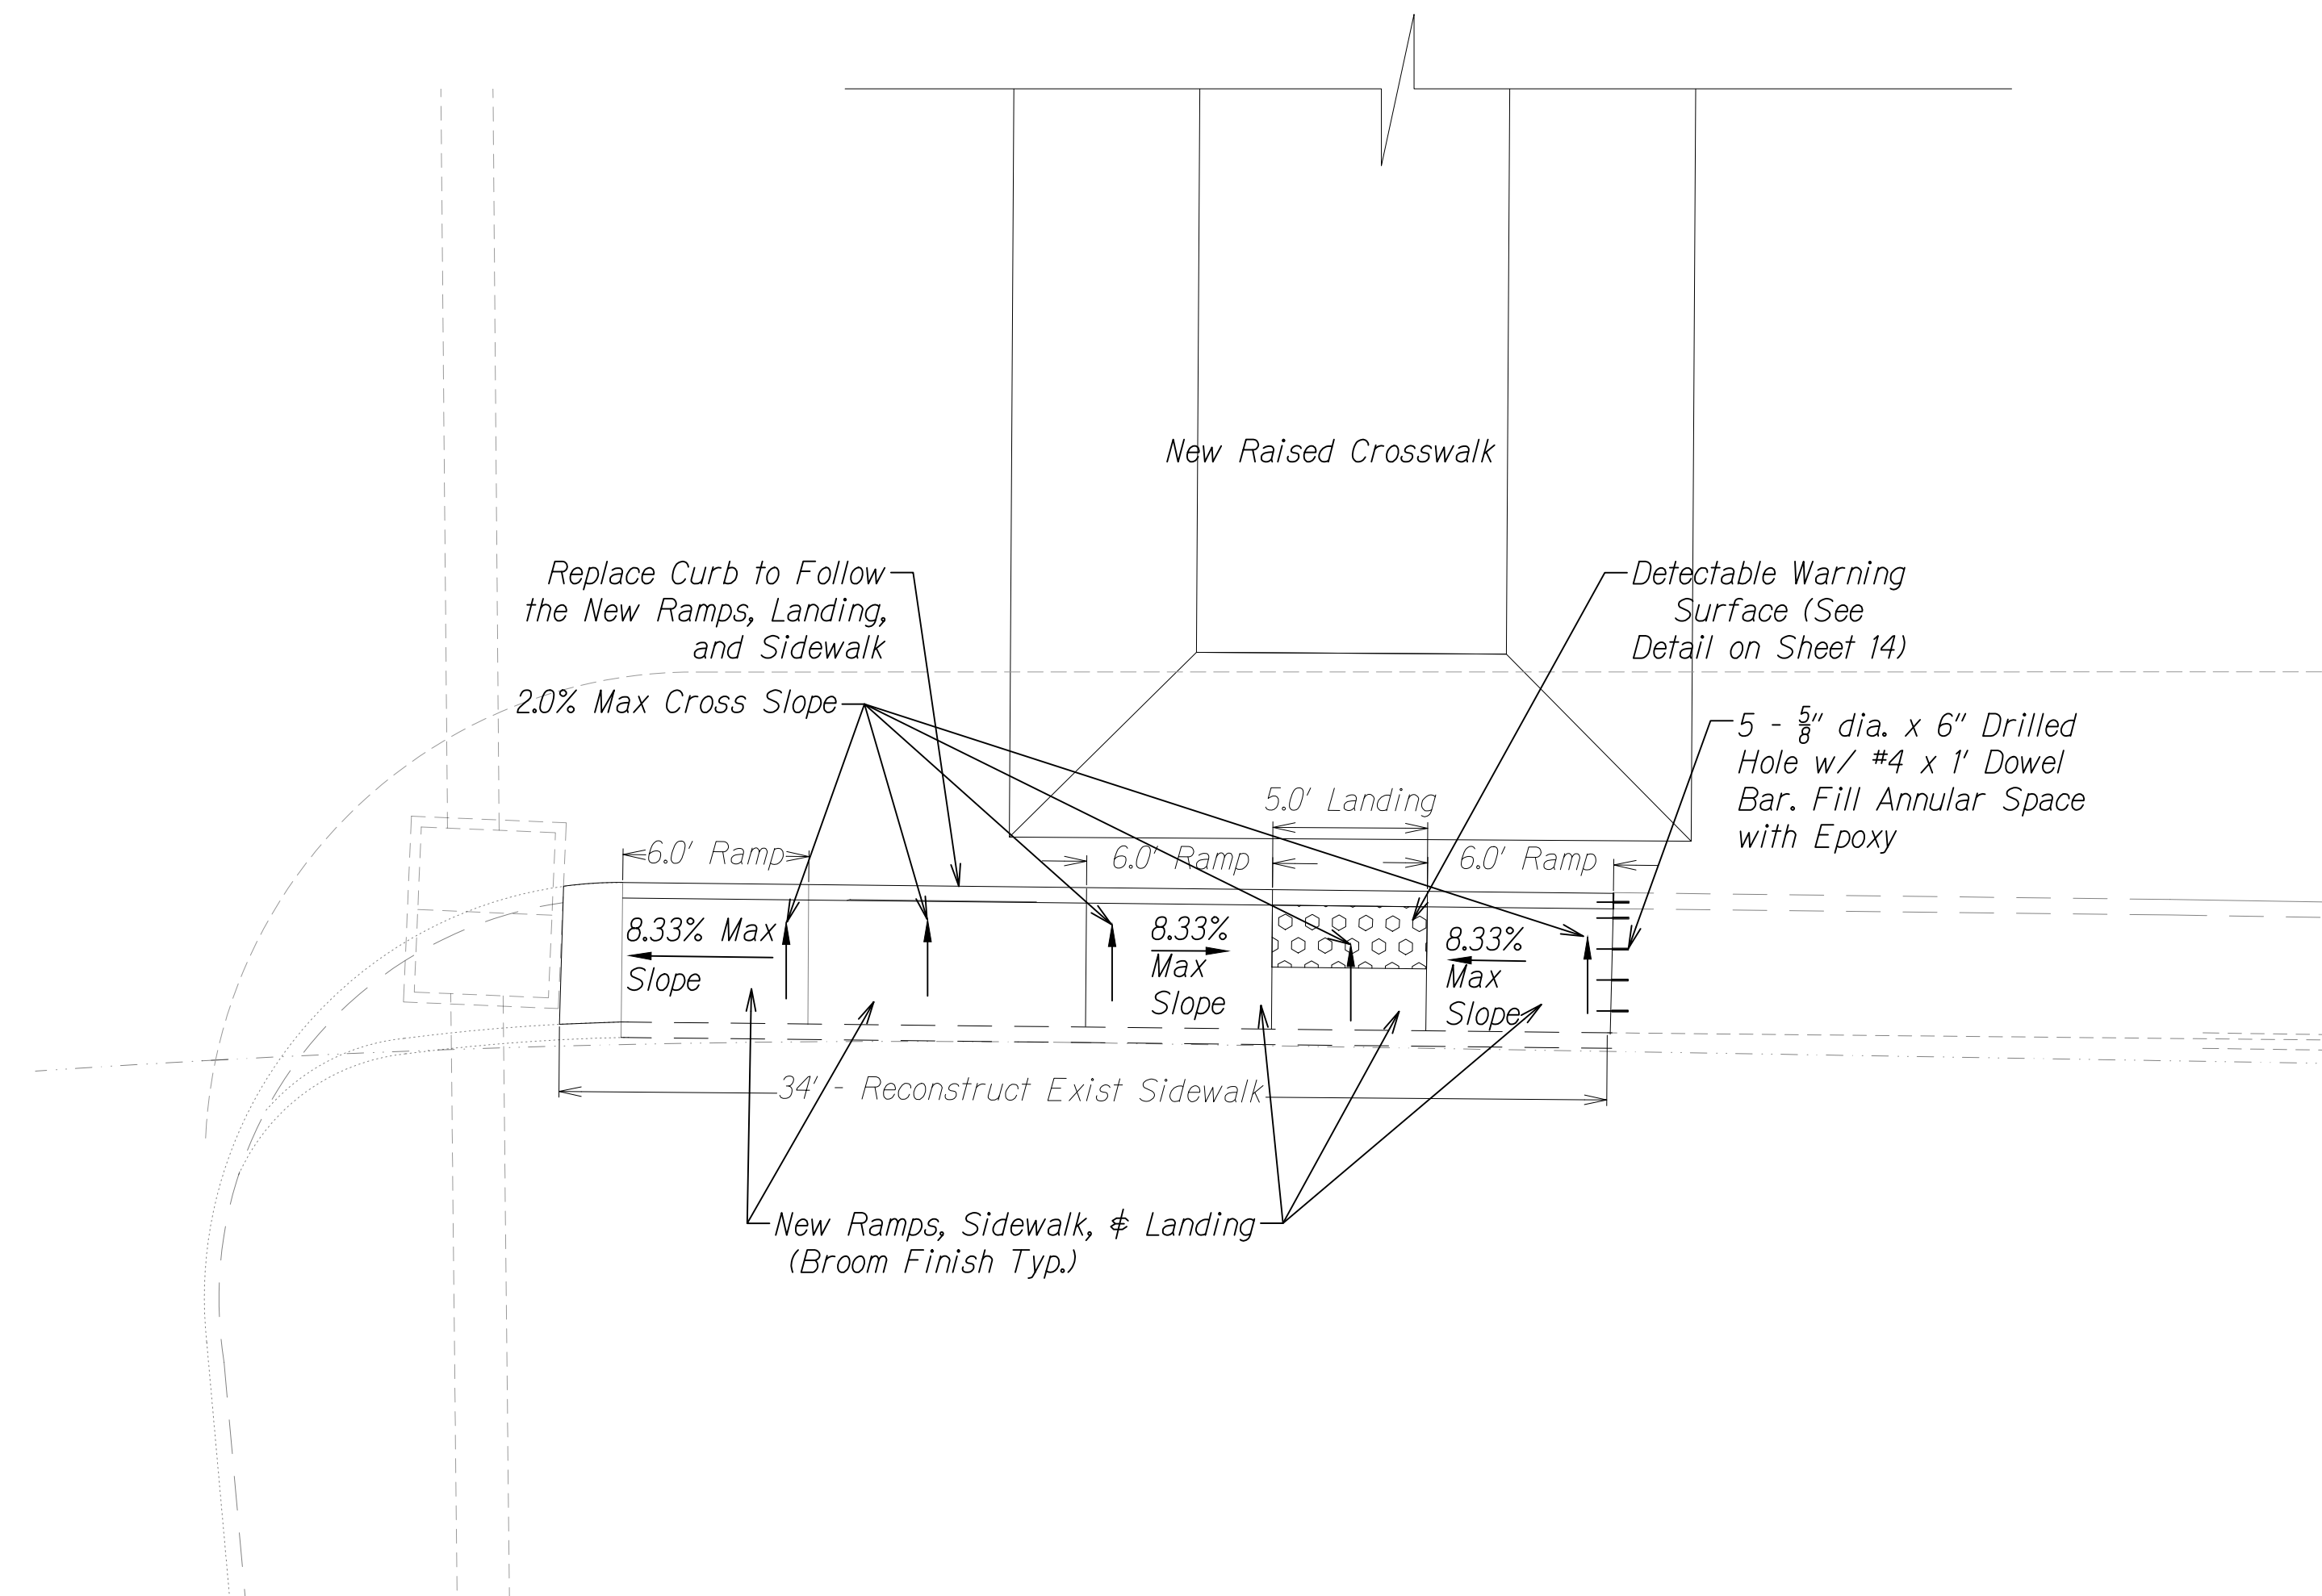

ADJUSTED CURB RAMP & LANDING @ STA. 2+32
Scale: 1" : 4'

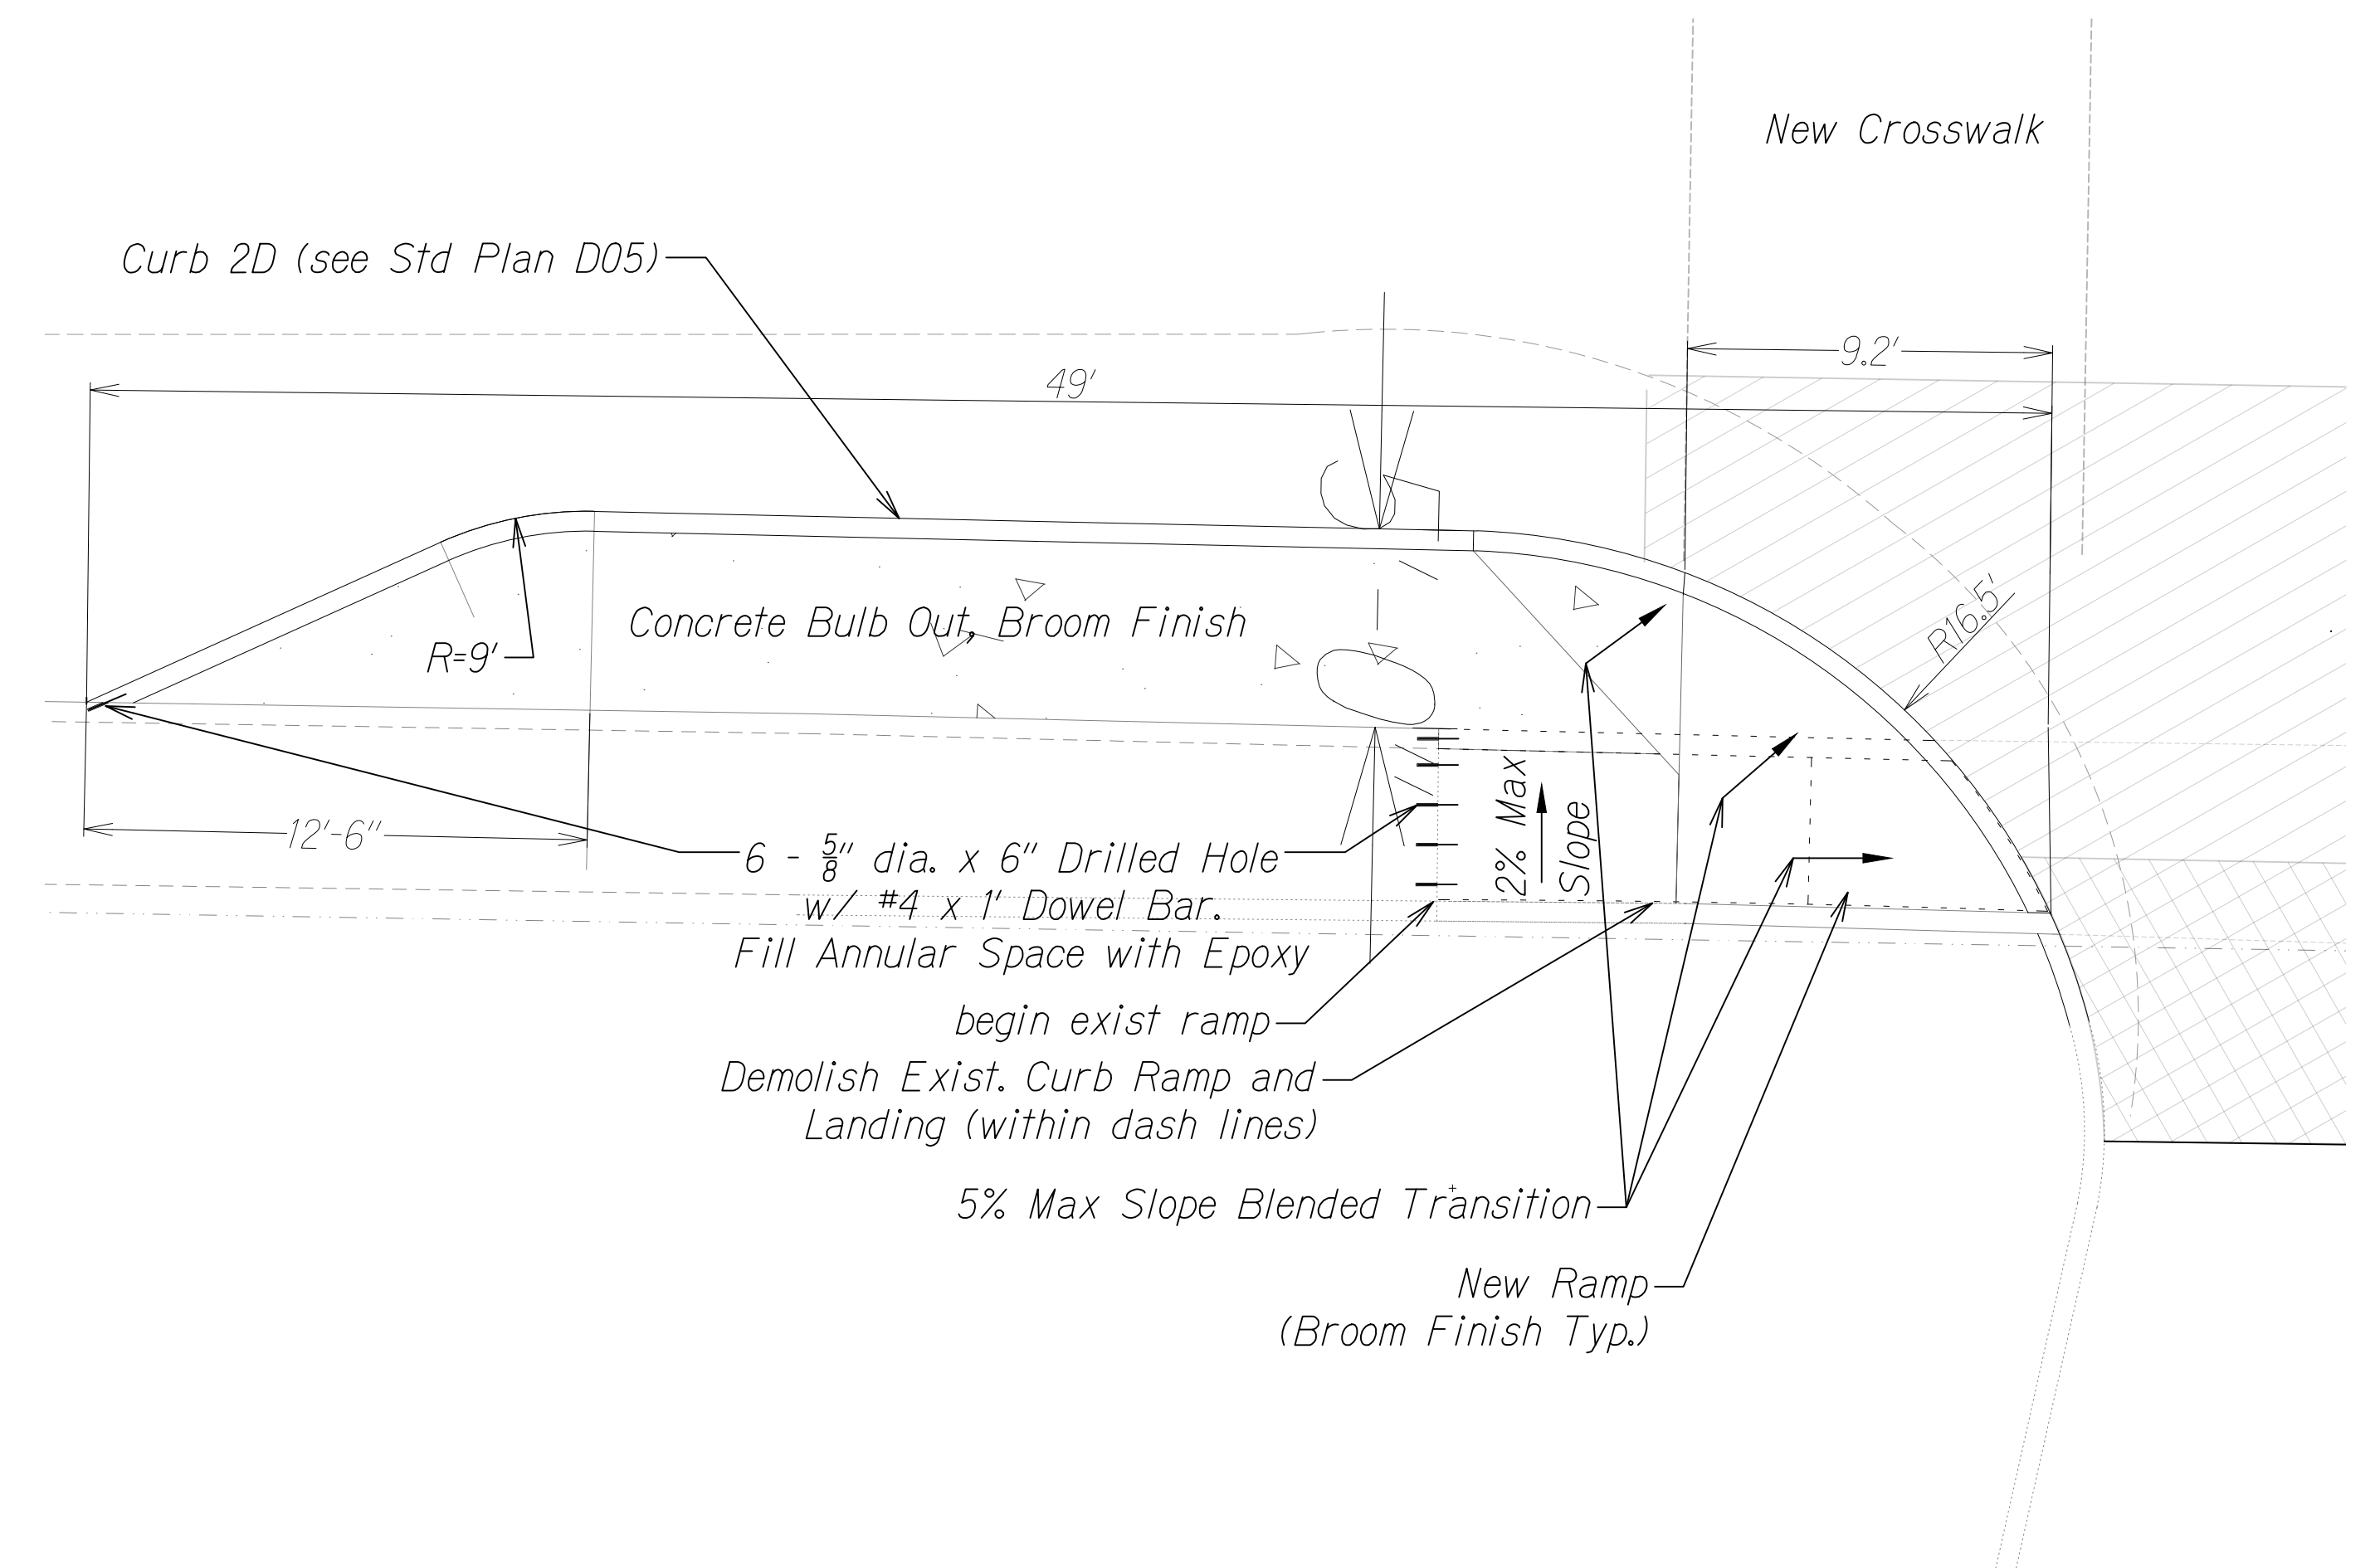

BULB OUT, $\neq$ CURB RAMP, TYPE "E" MODIFIED @ STA. 4+21
Scale: 1" : 4'

ORIGINAL PLAN	DATE
NOTE BOOK	
663r/rfo	
No. akgsmd02.dwg	
TRACED BY	
DESIGNED BY	

STATE OF HAWAII DEPARTMENT OF TRANSPORTATION HIGHWAYS DIVISION <u>MISCELLANEOUS DETAIL</u> <u>RICE STREET IMPROVEMENTS</u> <u>Nawiliwili Bridge to</u> <u>Kauai Veterans Memorial Highway</u> <u>Project No. 51AB-01-23</u> <u>Date: Sept. 2024</u>
