

INDEX TO DRAWINGS	
SHEET NO.	DESCRIPTION
1	Title Sheet.
2	Typical Road Sections, Details.
3-23	Plans & Profile.
24-25	Standard Details.
26	Miscellaneous Details.
27-28	Special Box Culvert Details.
29-36	Bridge Details.
37-56	Cross Sections.

TERRITORY OF HAWAII

TERRITORIAL HIGHWAY DEPARTMENT

HONOLULU T. H.


PLANS OF

KAUAI BELT ROAD

EMERGENCY CONSTRUCTION HIGHWAY PROJECT F.A.P E-12 A.

DISTRICTS OF LIHUE AND KAWAIHAU

KAUAI T. H.

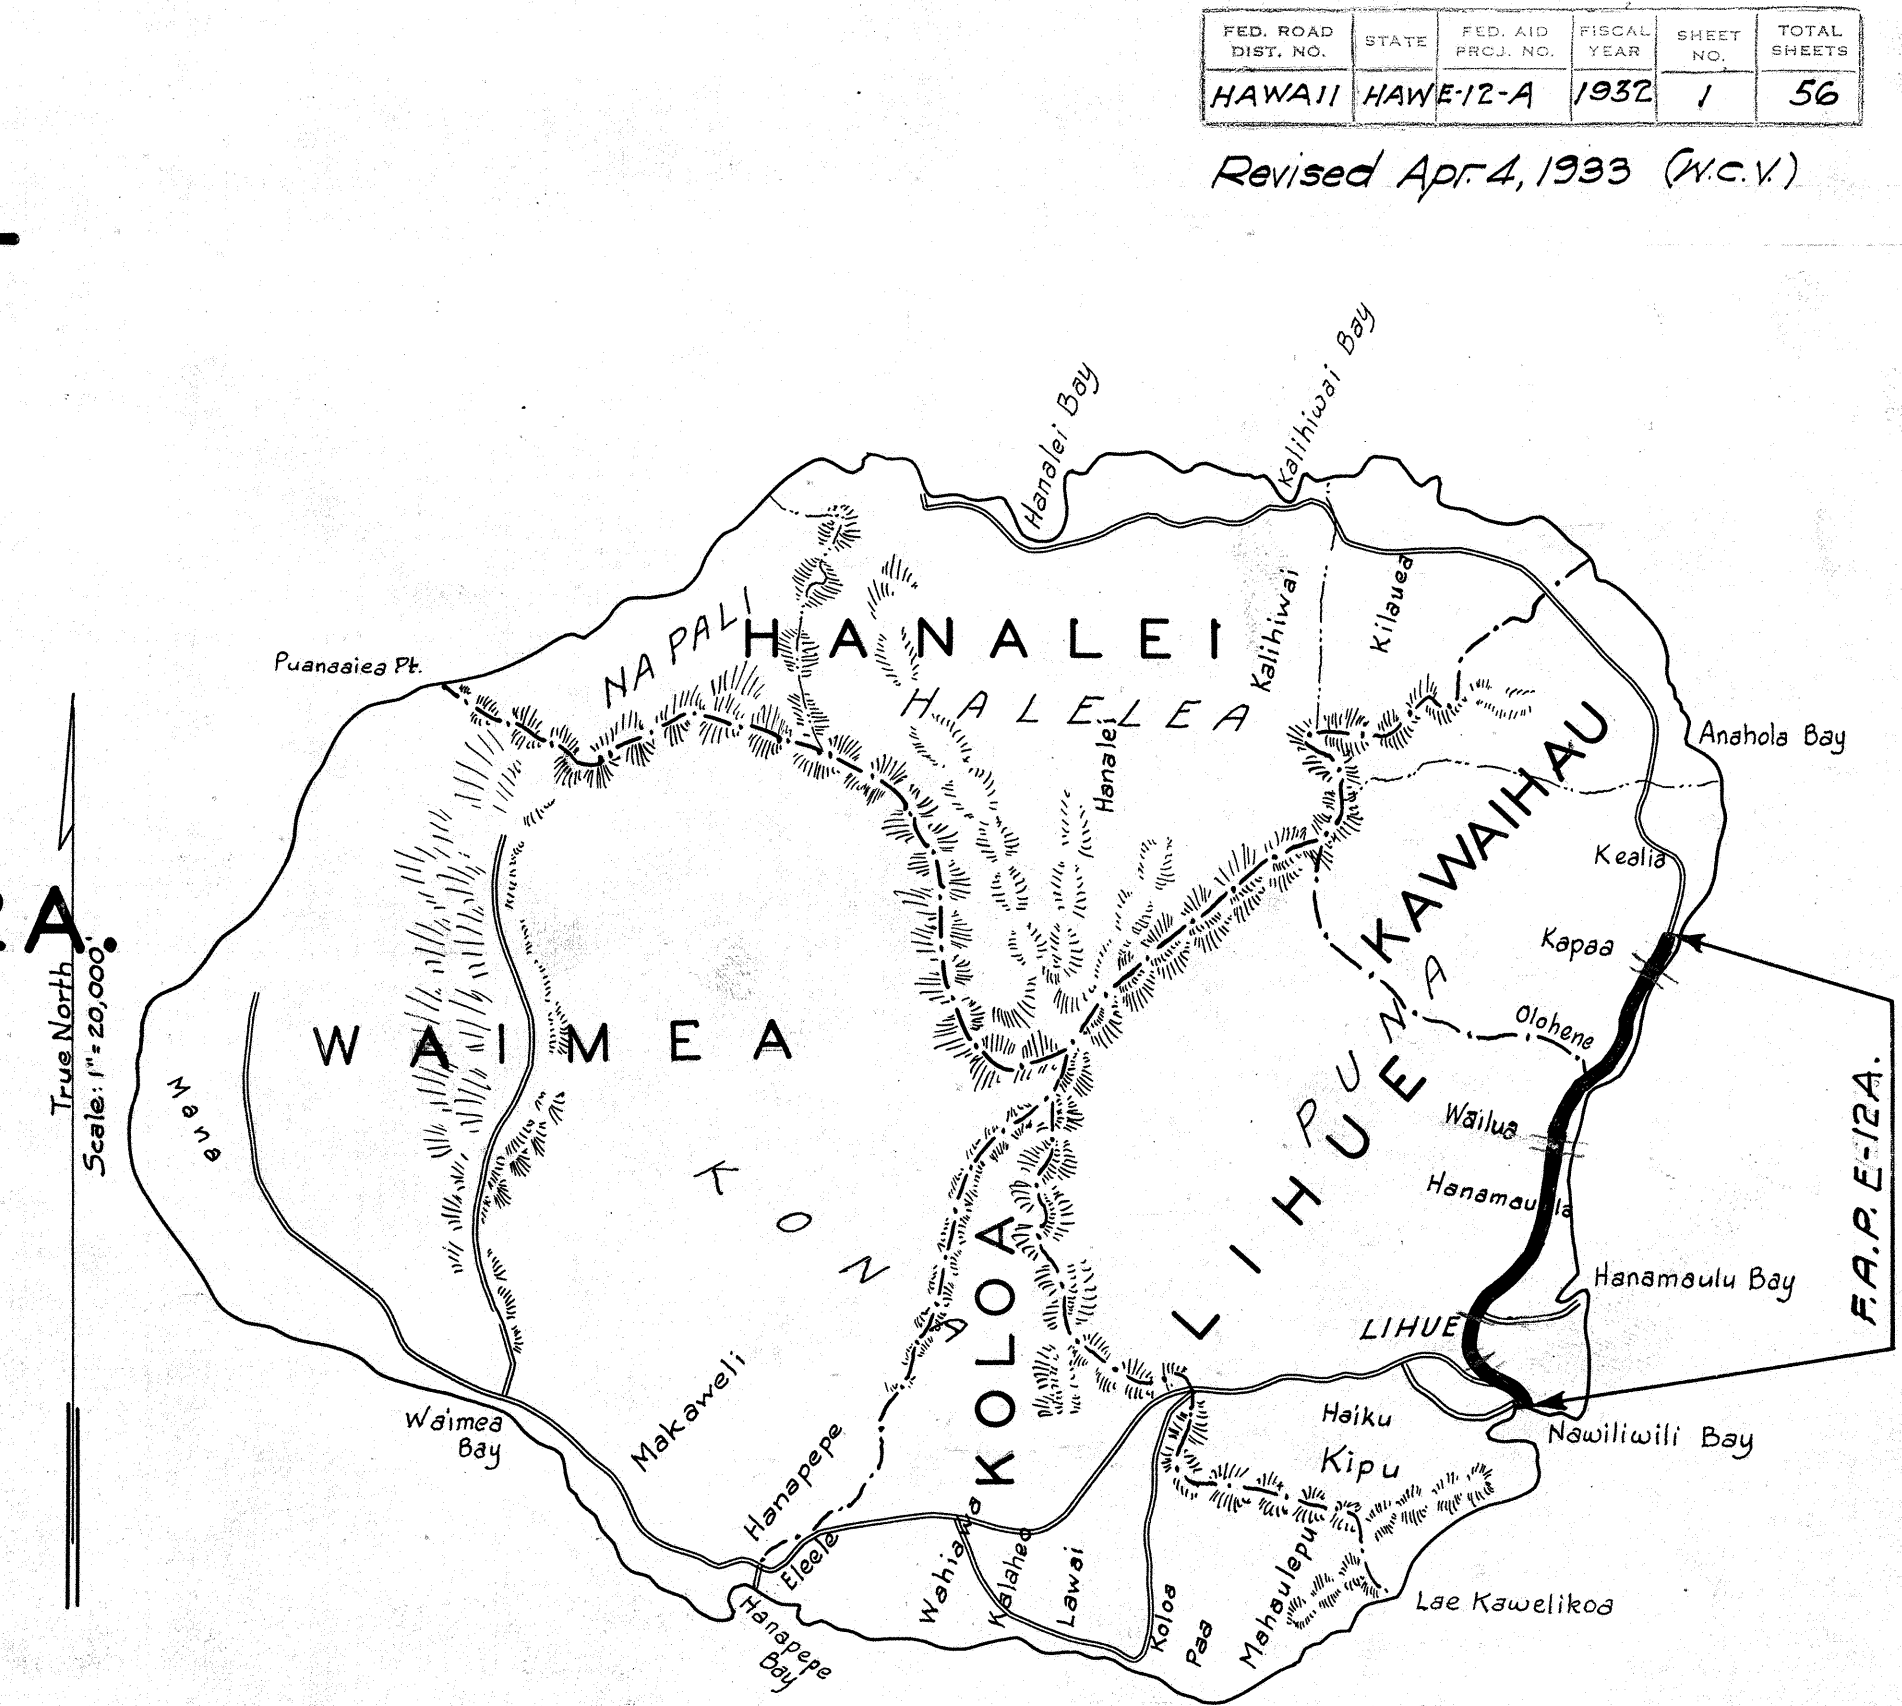


True North
Scale: 1" = 20,000'

CONVENTIONAL SIGNS

Edge of existing Road	-----
Existing Fence	- x - x -
Boundary Line (not fenced)	-----
Existing Stone Wall	=====
Railroad	+ + + + +
Center Line	- o - o -
Future Pavement	=====
Cement Rubble Masonry Retaining Wall	=====
Bridge	=====

SCALES

PLANS	1 INCH = 100 FEET
PROFILE	HOR. 1 INCH = 100 FEET
	VERT. 1 INCH = 20 FEET
CROSS SECTIONS	1 INCH = 10 FEET

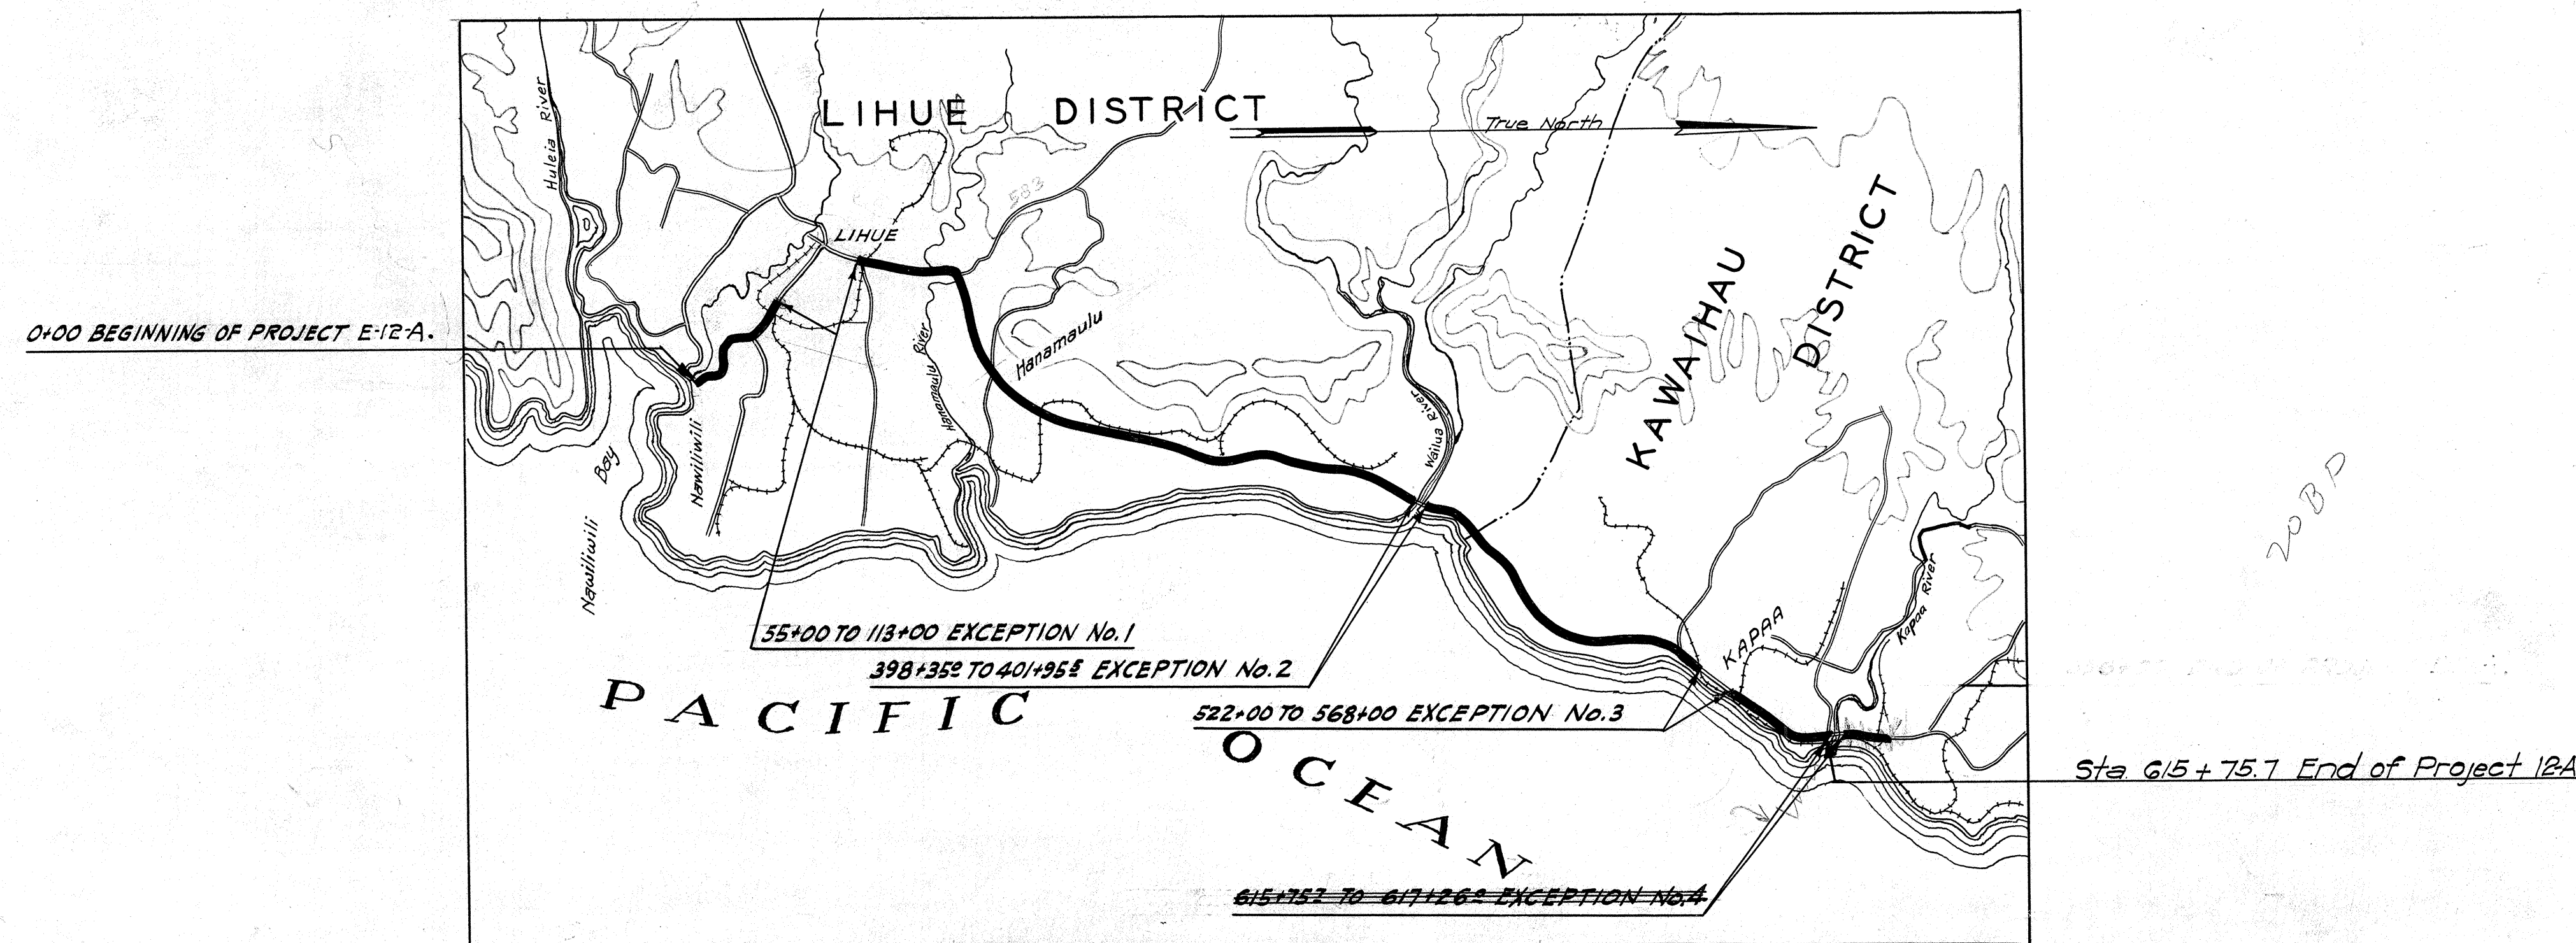

LAYOUT OF PROJECT

SCALE- 1:62500

NOTE :- Elevations are refered to B.M. No. 1 U.S.G.S. Tablet located on steps of Nawiliwili Hawaiian Church Elevation 28.35 ft. which refers to a datum of mean sea level.	EXCEPTION NO. 1 = 1.098 MI. EXCEPTION NO. 2 = .068 " EXCEPTION NO. 3 = .871 " EXCEPTION NO. 4 = .028 " TOTAL 1 TO 3 INC.=2.037 "	GROSS LENGTH = 11.561 MI. TOTAL EXCEPTIONS = 2.037 MI. LENGTH OF PROJECT= 9.524 MI. BRIDGES (OVER 20 FT.) = 0.040 MI. NET LENGTH = 9.484 MI.
---	--	--

APPROVED

7/22/32

TERRITORIAL HIGHWAY ENGINEER

RECOMMENDED FOR APPROVAL

8-12-32.

PRINCIPAL HIGHWAY ENGINEER Bureau of Public Roads.

RECOMMENDED FOR APPROVAL

CHIEF ENGINEER Bureau of Public Roads.

APPROVED

DIRECTOR Bureau of Public Roads.

4258.1