


FED. ROAD DIST. NO.	STATE	FED. AID PROJ. NO.	FISCAL YEAR	SHEET NO.	TOTAL SHEETS
HAWAII	HAWAII	F-12(W)	1945	18	20

FINAL SURVEY SURVEYED BY DATE
NOTE BOOK NO. TEMPLATE AREAS CHECKED

ORIGINAL SURVEY SURVEYED BY DATE
NOTE BOOK NO. TEMPLATE AREAS CHECKED

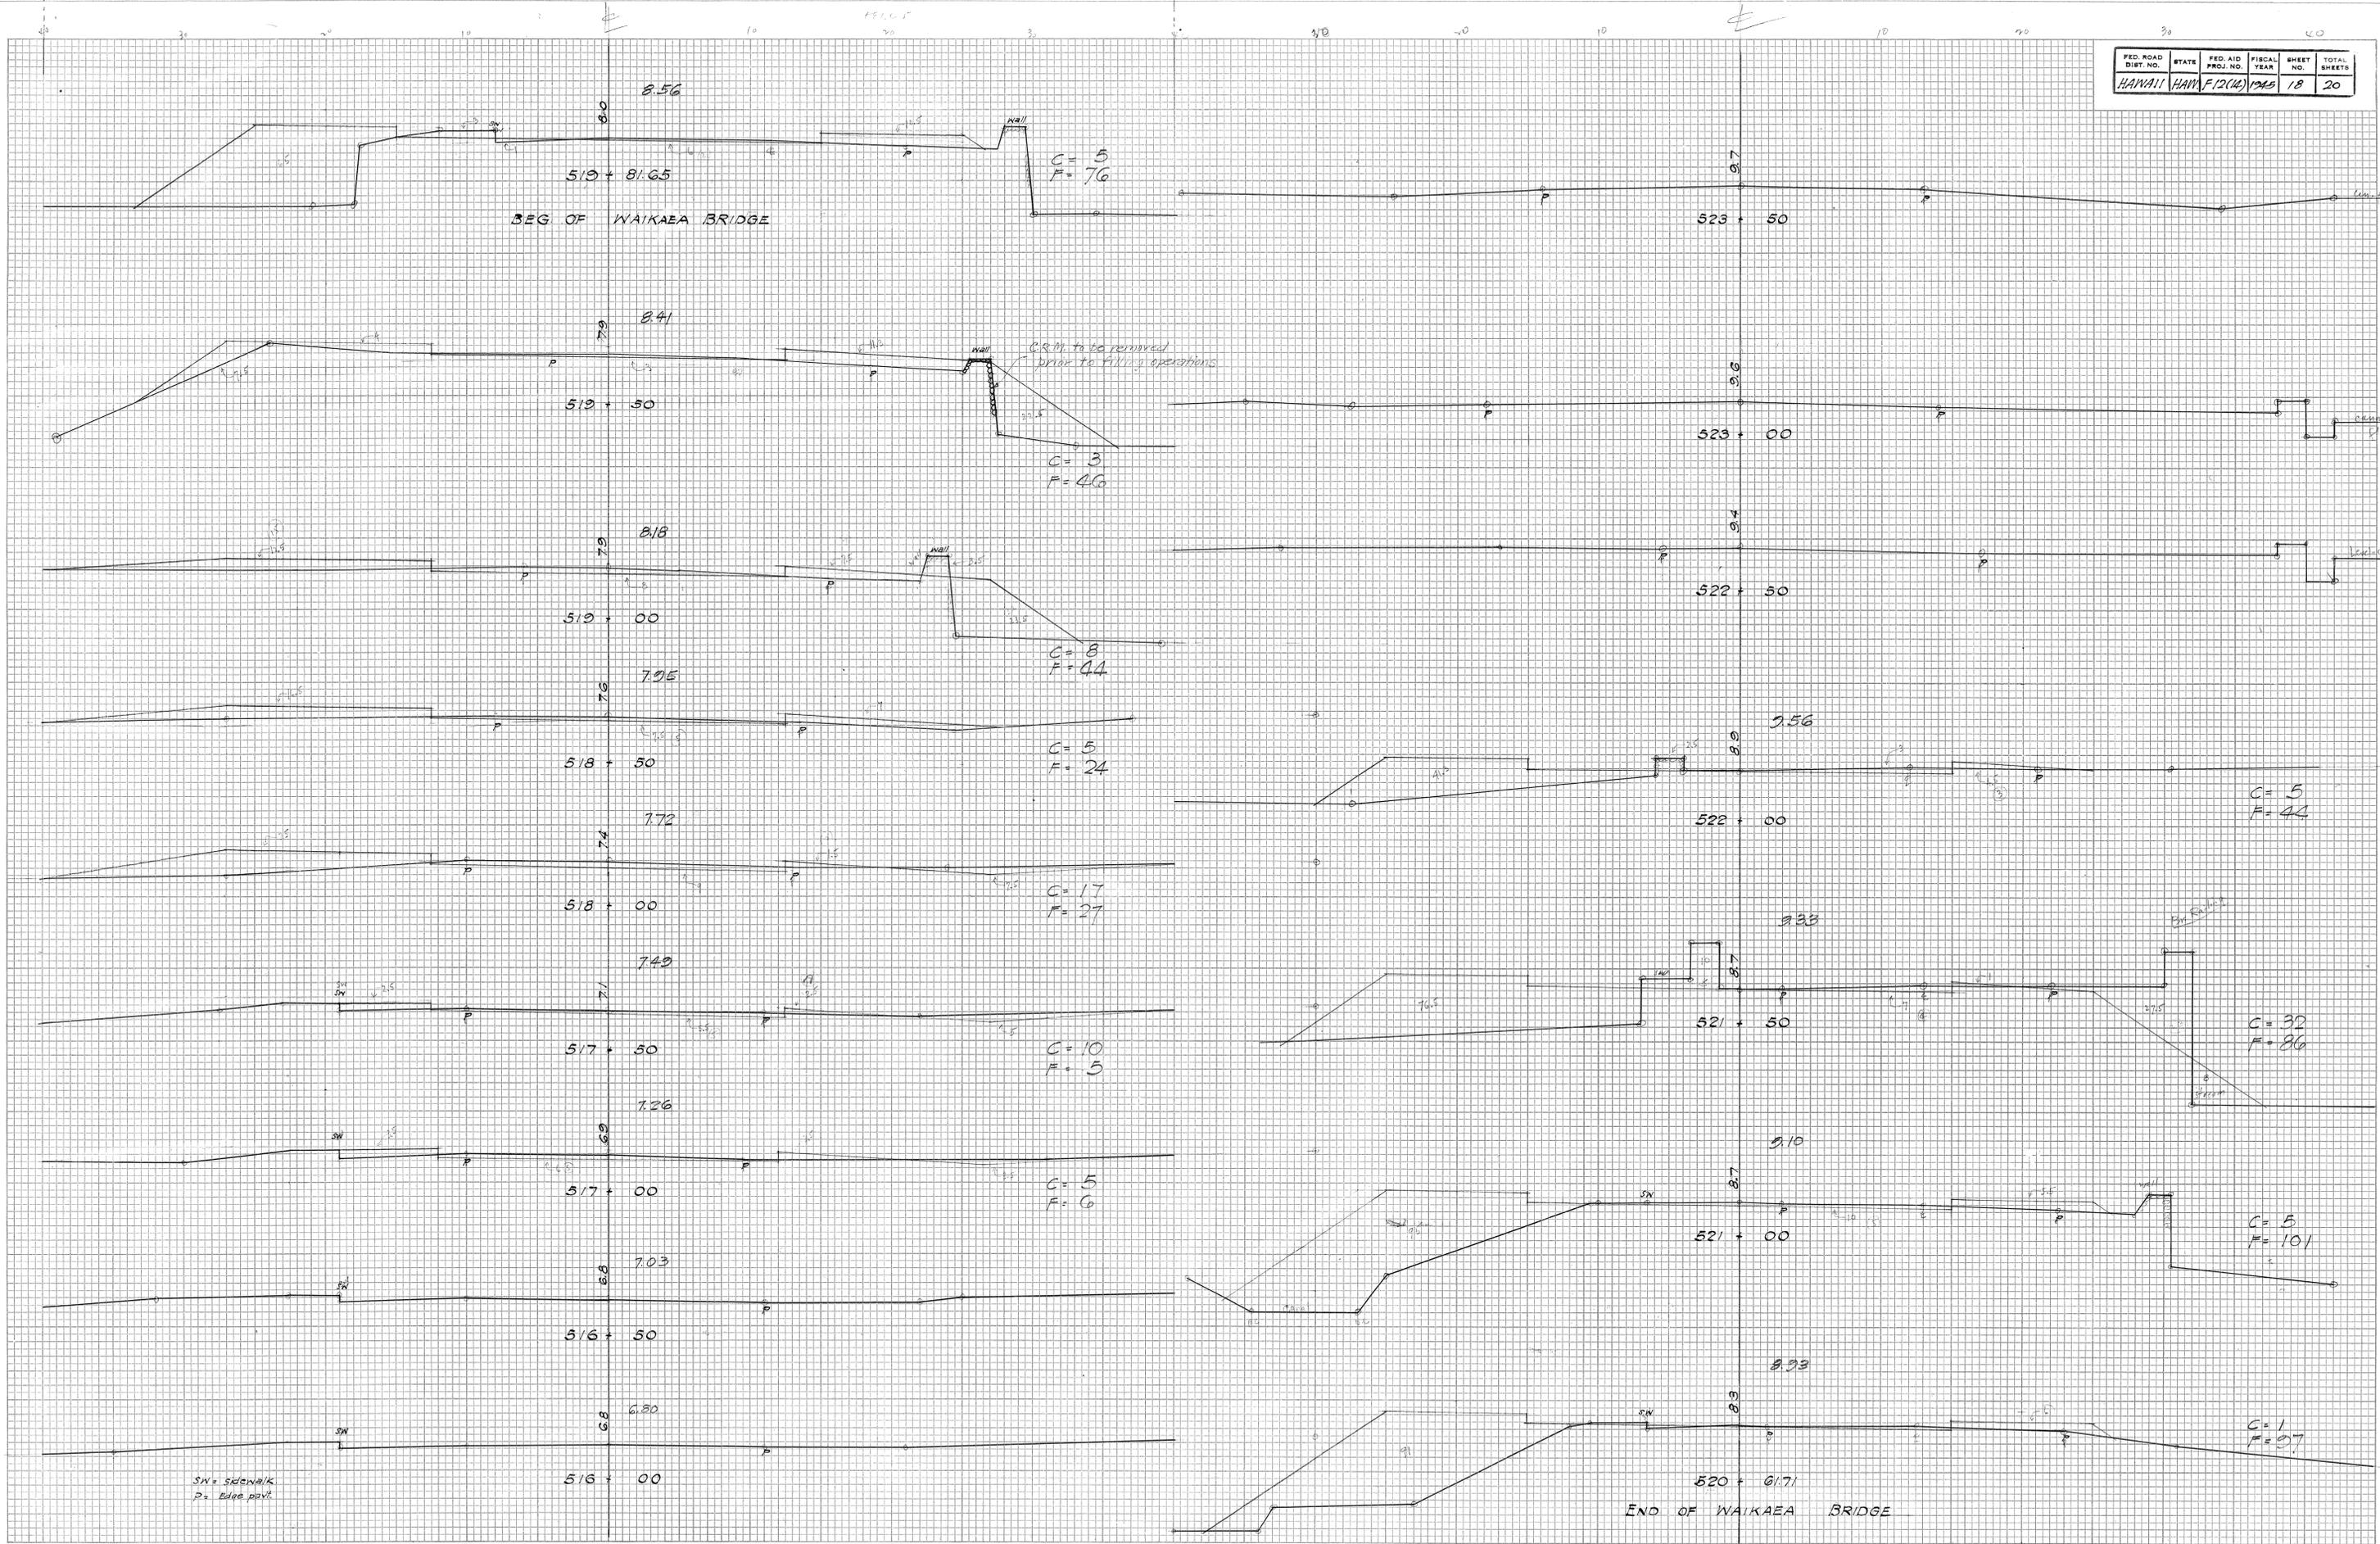

SW = sidewalk
P = Edge pavt

FED. ROAD DIST. NO.	STATE	FED. AID PROJ. NO.	FISCAL YEAR	SHEET NO.	TOTAL SHEETS
HAWAII	HAW	F12(14)	1945	19	20

DATE	BY

FINAL SURVEY	DATE

DATE	BY
12/22/44	F. L. J.

ORIGINAL SURVEY	DATE

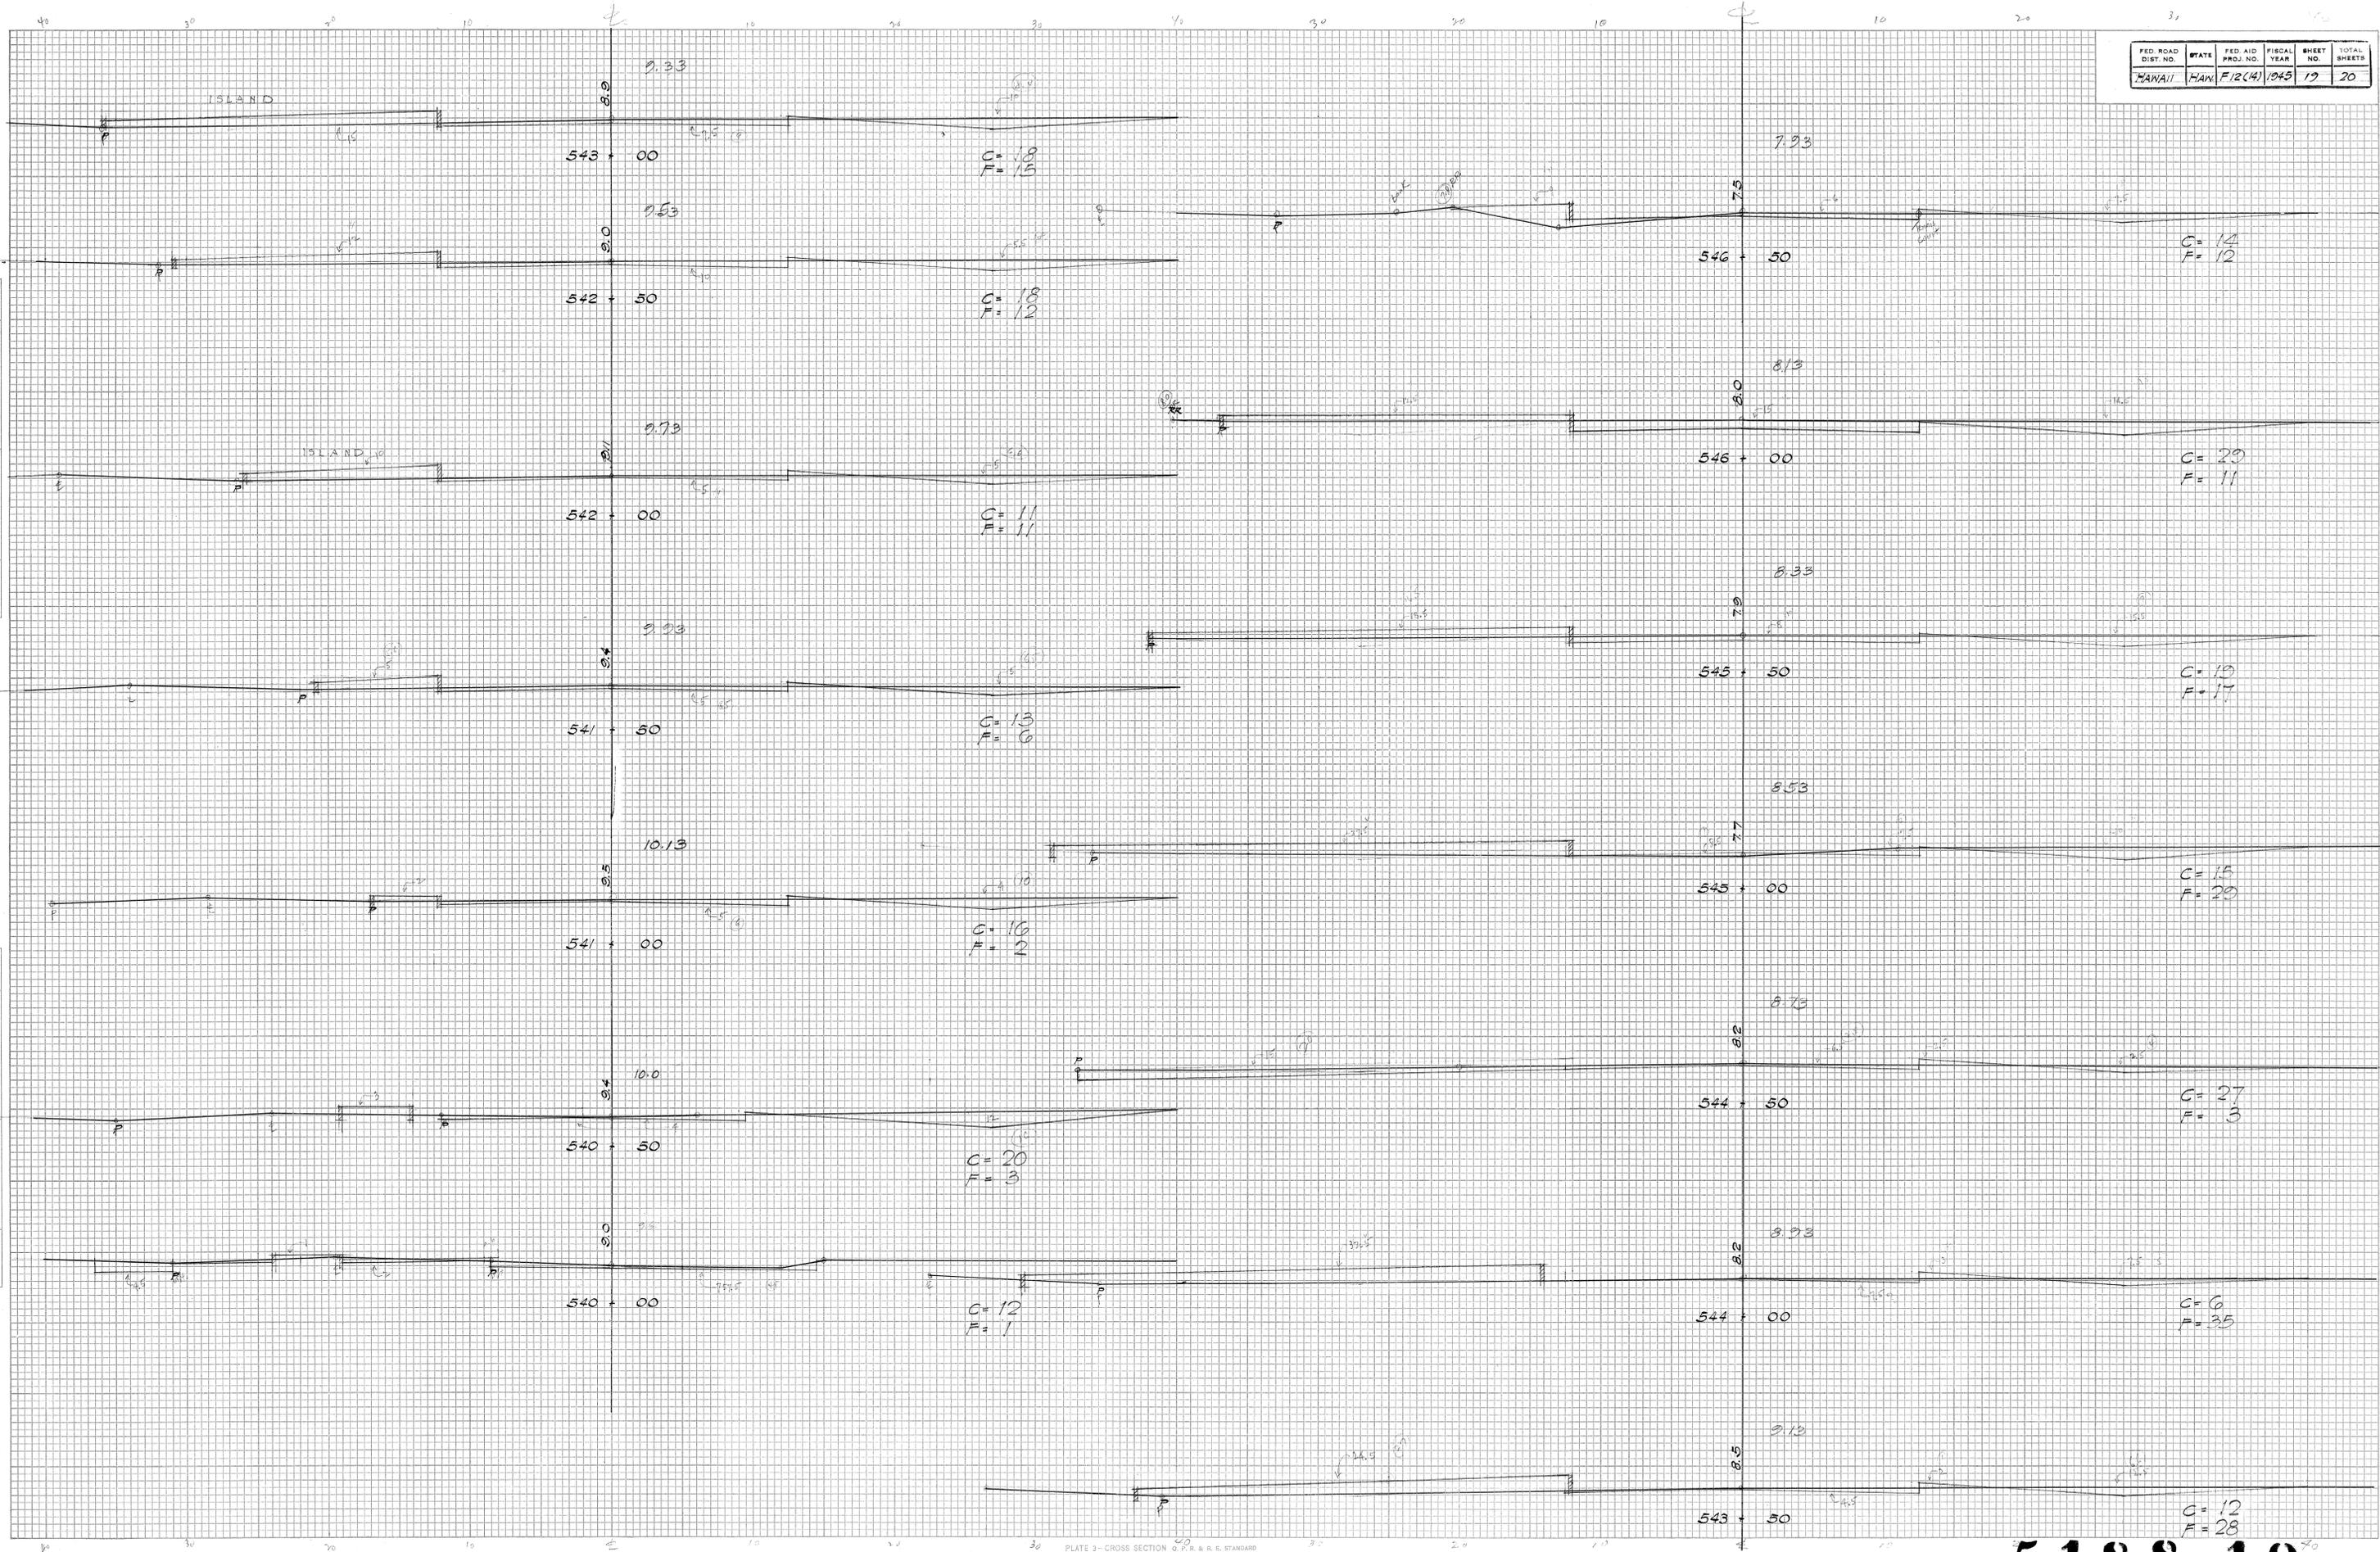


PLATE 3 - CROSS SECTION O. P. & R. E. STANDARD
KEUFFEL & ESSER CO., NEW YORK.

5188.19

PROJECT NO.	STATE	FED. AID PROJ. NO.	FISCAL YEAR	SHEET NO.	TOTAL SHEETS
HAWAII	HAW	F12041045	20	20	20

DATE	BY	NO.

DATE	BY	NO.
4-2-70	F.L.J.	11

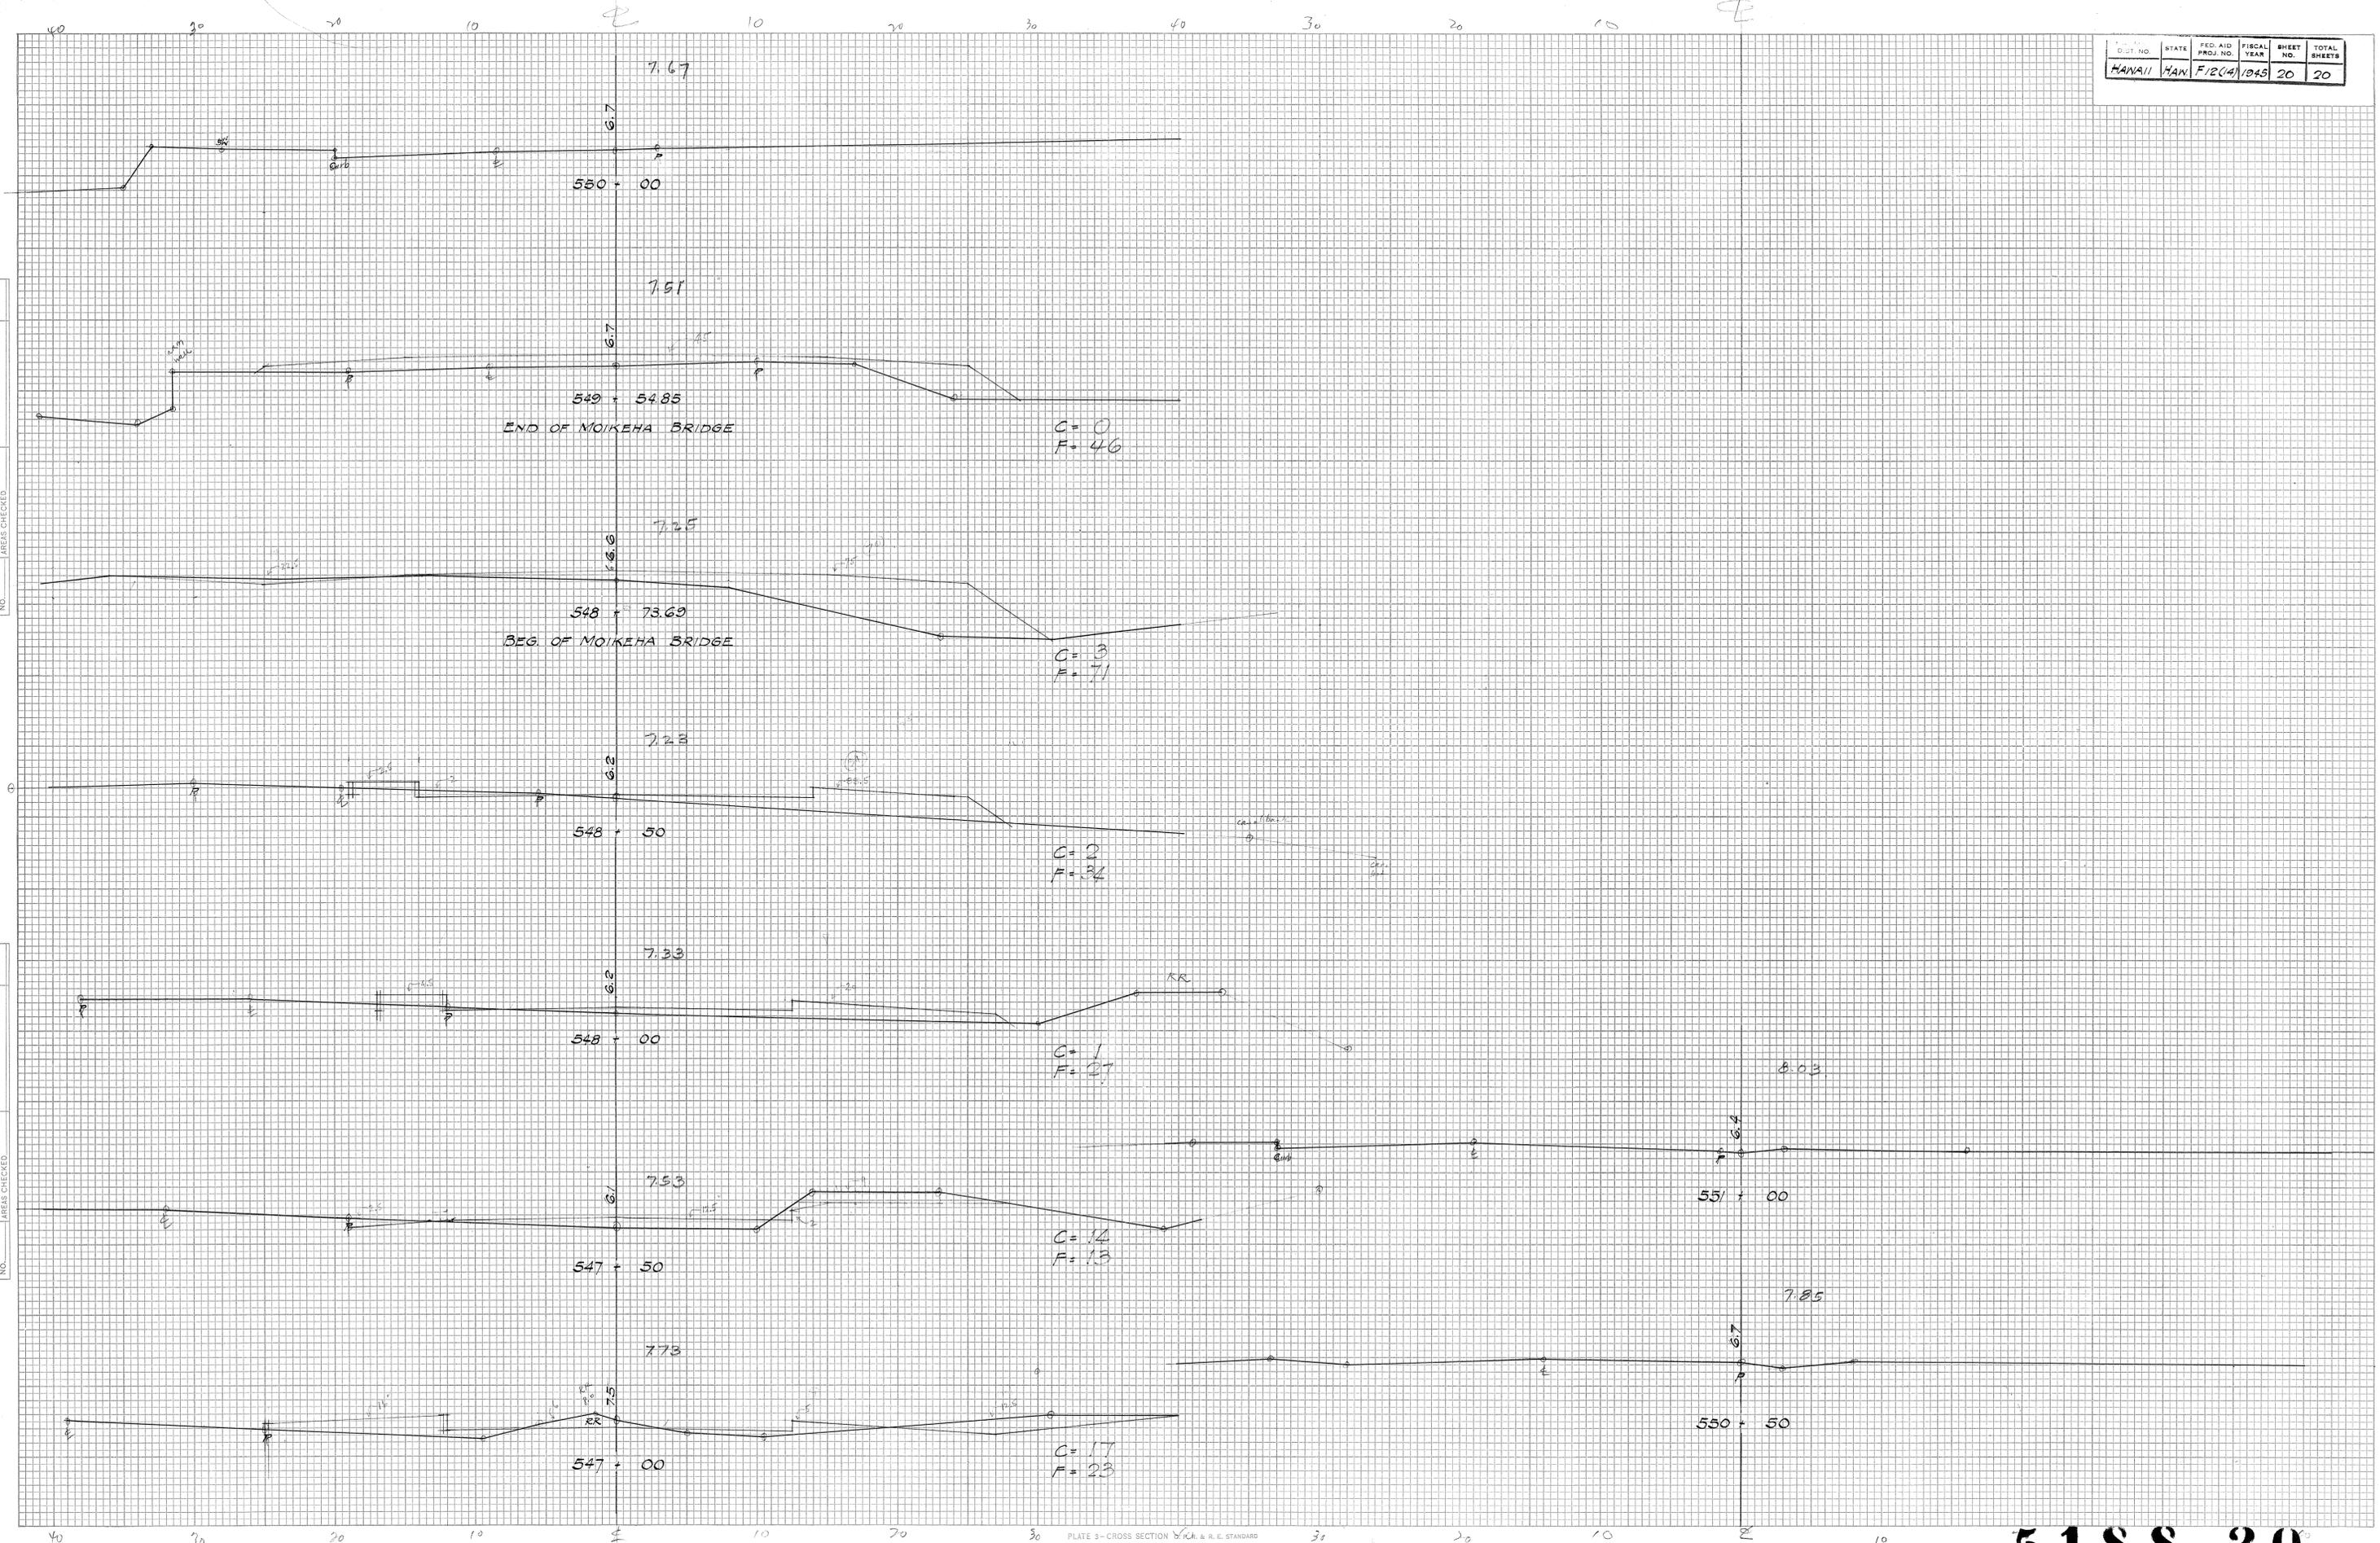


PLATE 3 - CROSS SECTION OF R. & E. STANDARD
KEUFFEL & ESSER CO., NEW YORK.

5188.20