
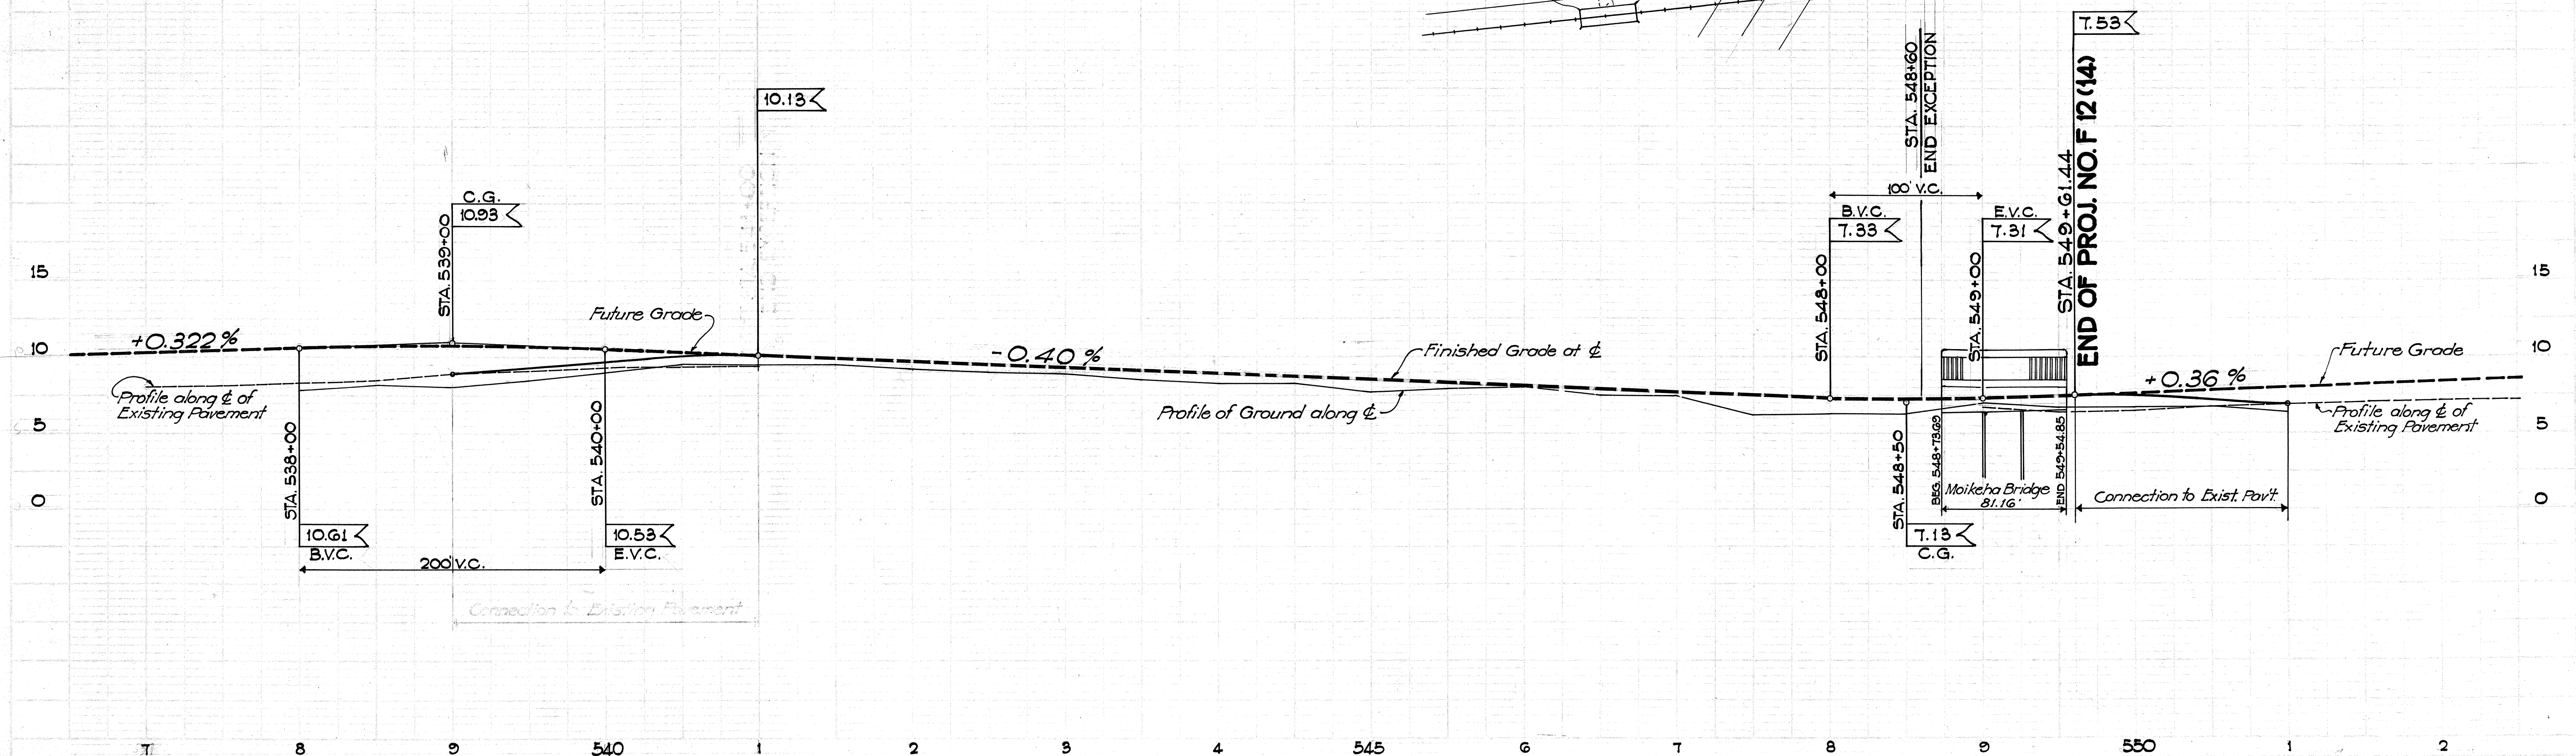


Second Revision: May 3, 1946
Revision: Apr. 10, 1946 Islands revised.

FED. ROAD DIST. NO.	STATE	FED. AID PROJ. NO.	FISCAL YEAR	SHEET NO.	TOTAL SHEETS
HAWAII	HAW.	F. 12 (14)	1945	4	20

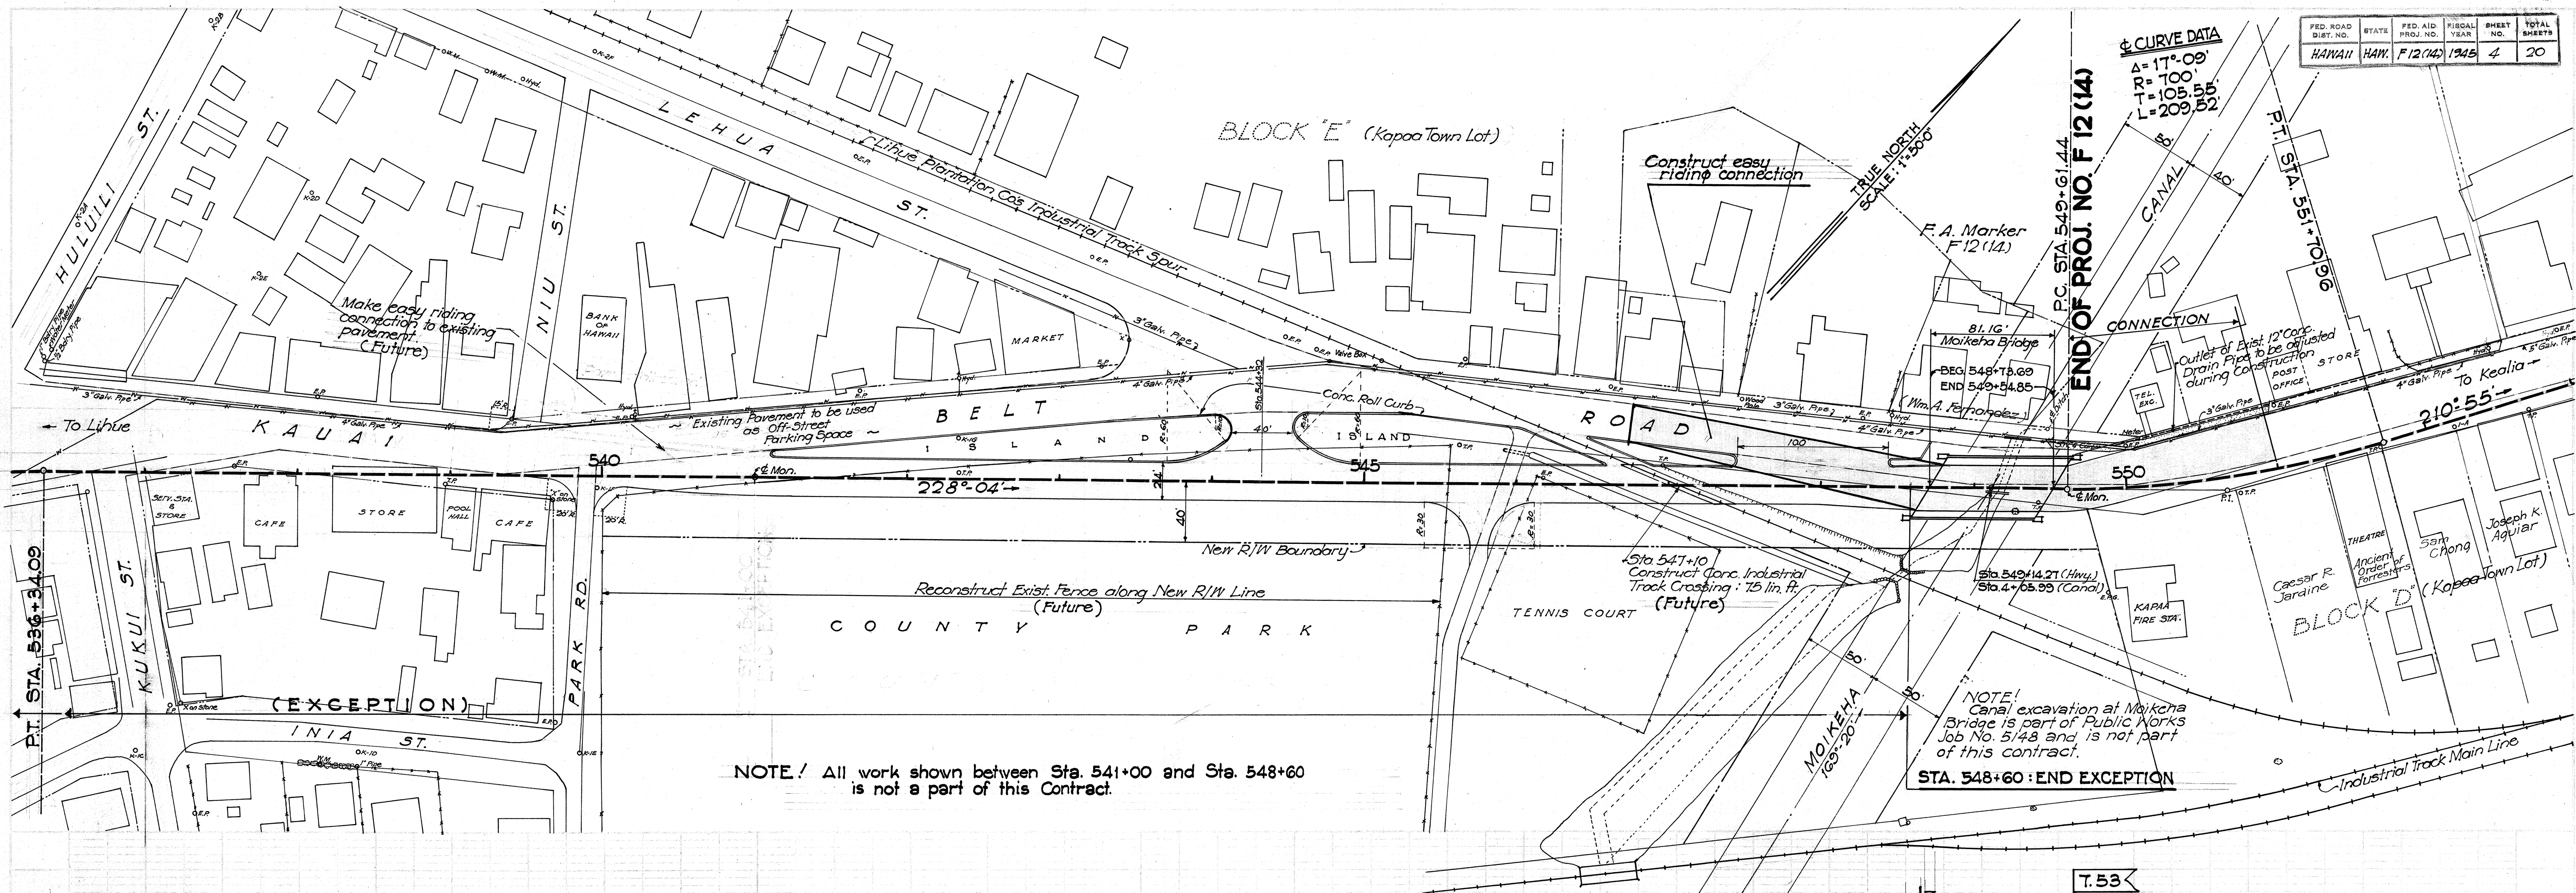

5188.4