

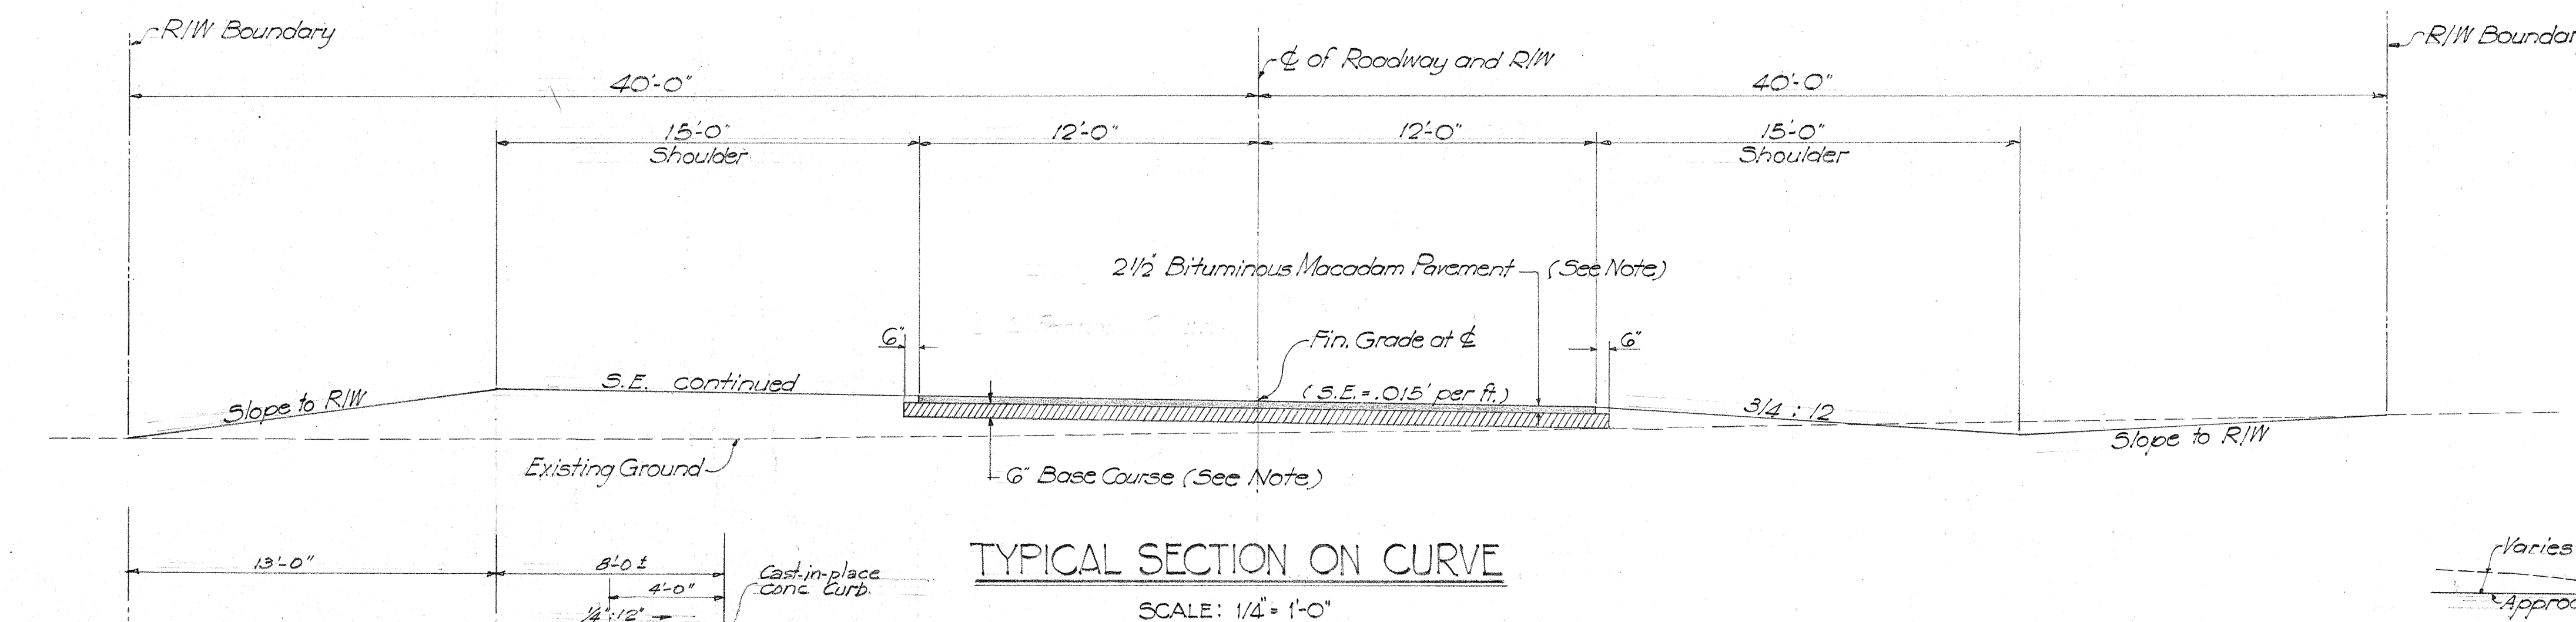


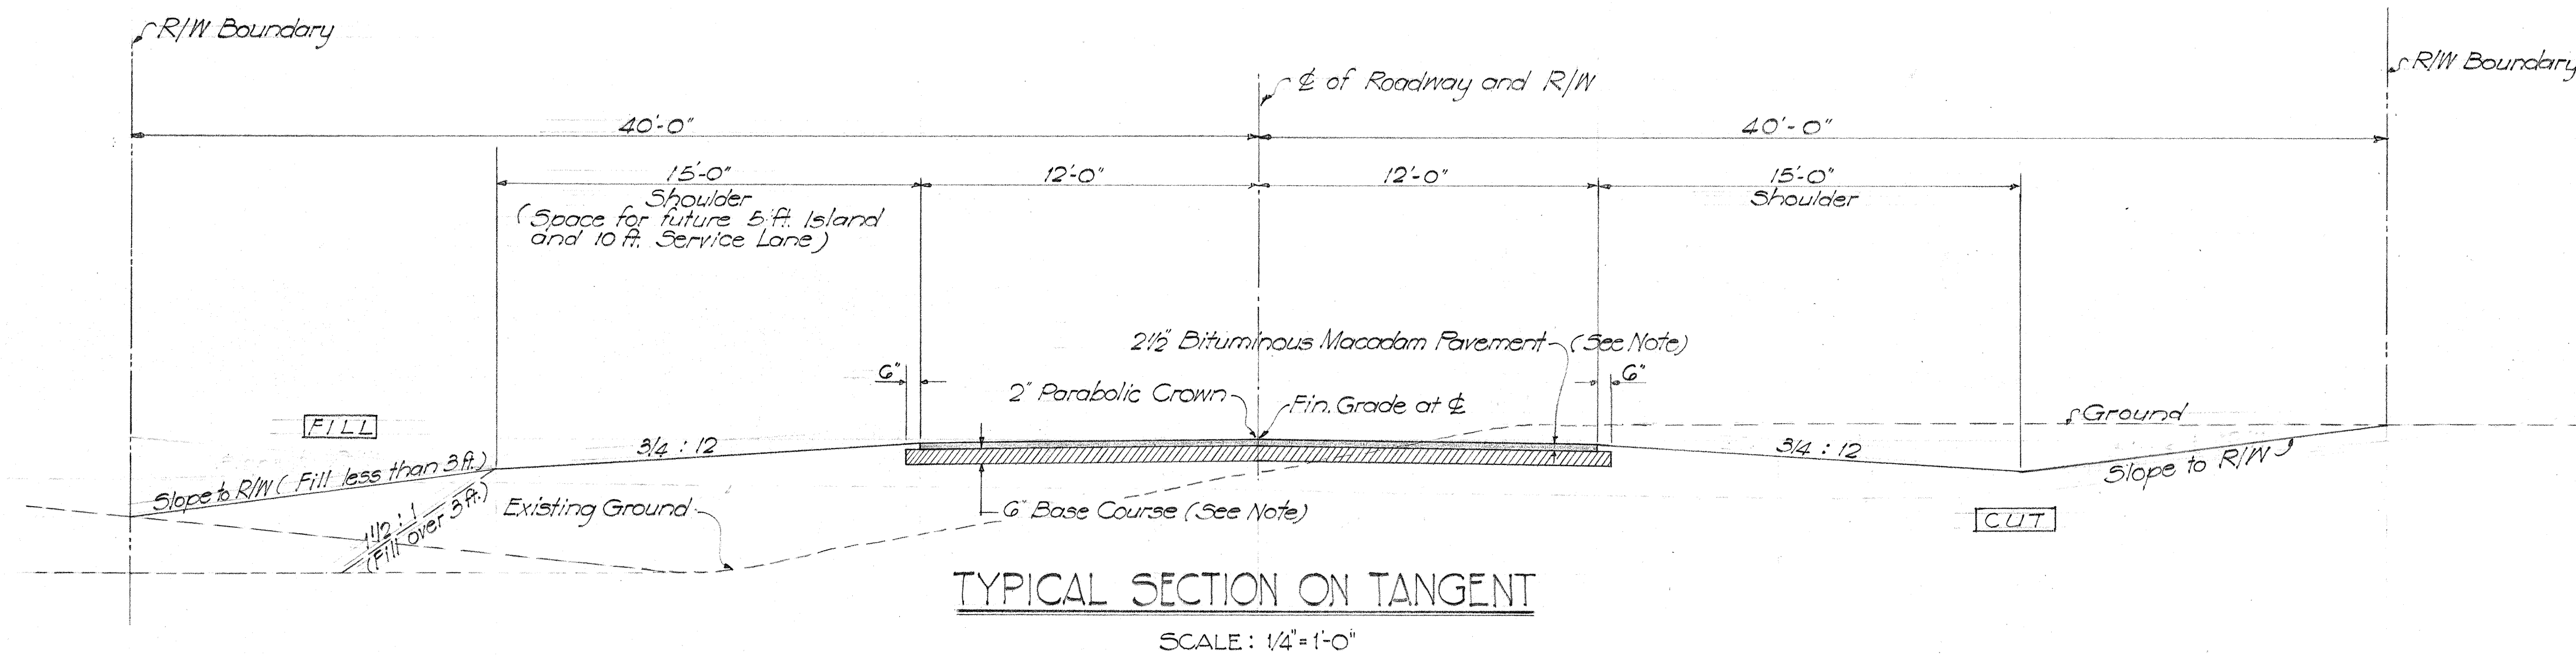


DETAIL OF CURB & SIDEWALK SECTION
STA. 517+50 TO 519+90 ON LEFT
Scale: 1/4" = 1'-0"

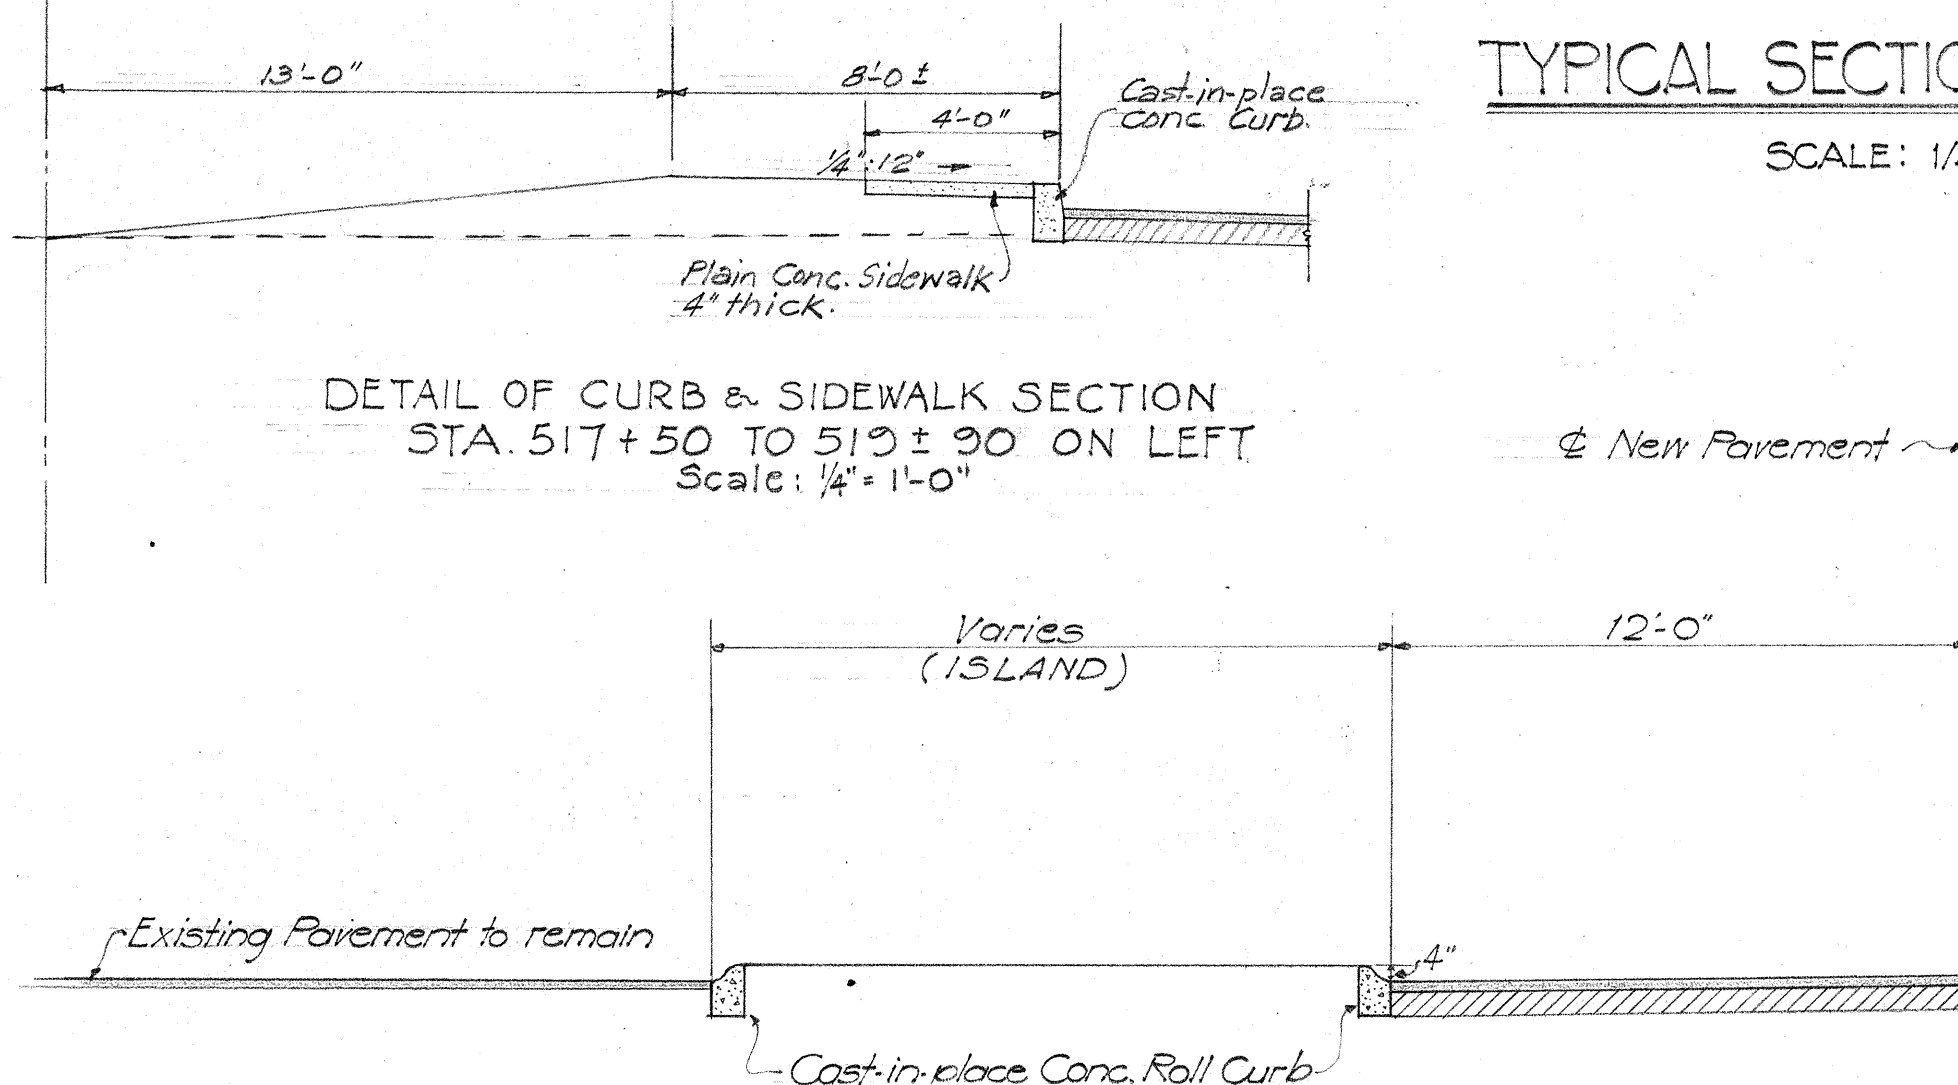


TYPICAL SECTION ~ SHOWING ISLAND
ON LEFT --- STA 541+00 TO STA 549+00



SCALE: 1/4" = 1'-0"
Detail does not apply to this Project.

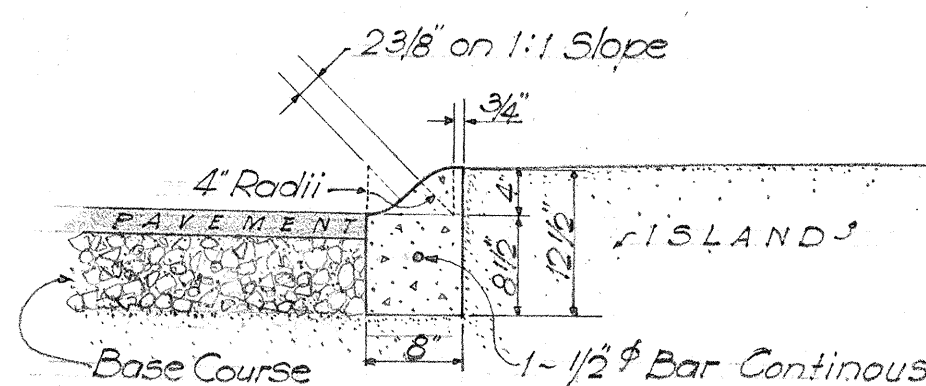



CAST-IN-PLACE CONC. ROLL CURB
SCALE: 3/4" = 1'-0"
Detail does not apply to this Project.

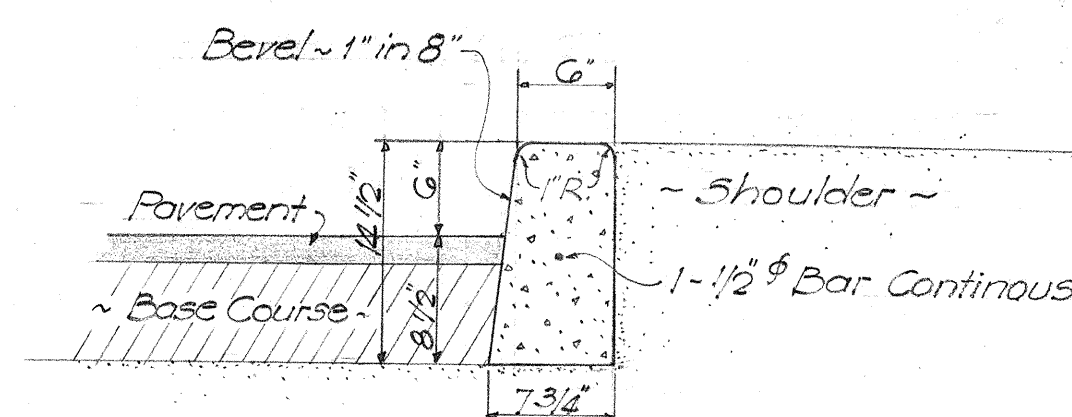

CAST-IN-PLACE CONC. CURB
SCALE: 1" = 1'-0"

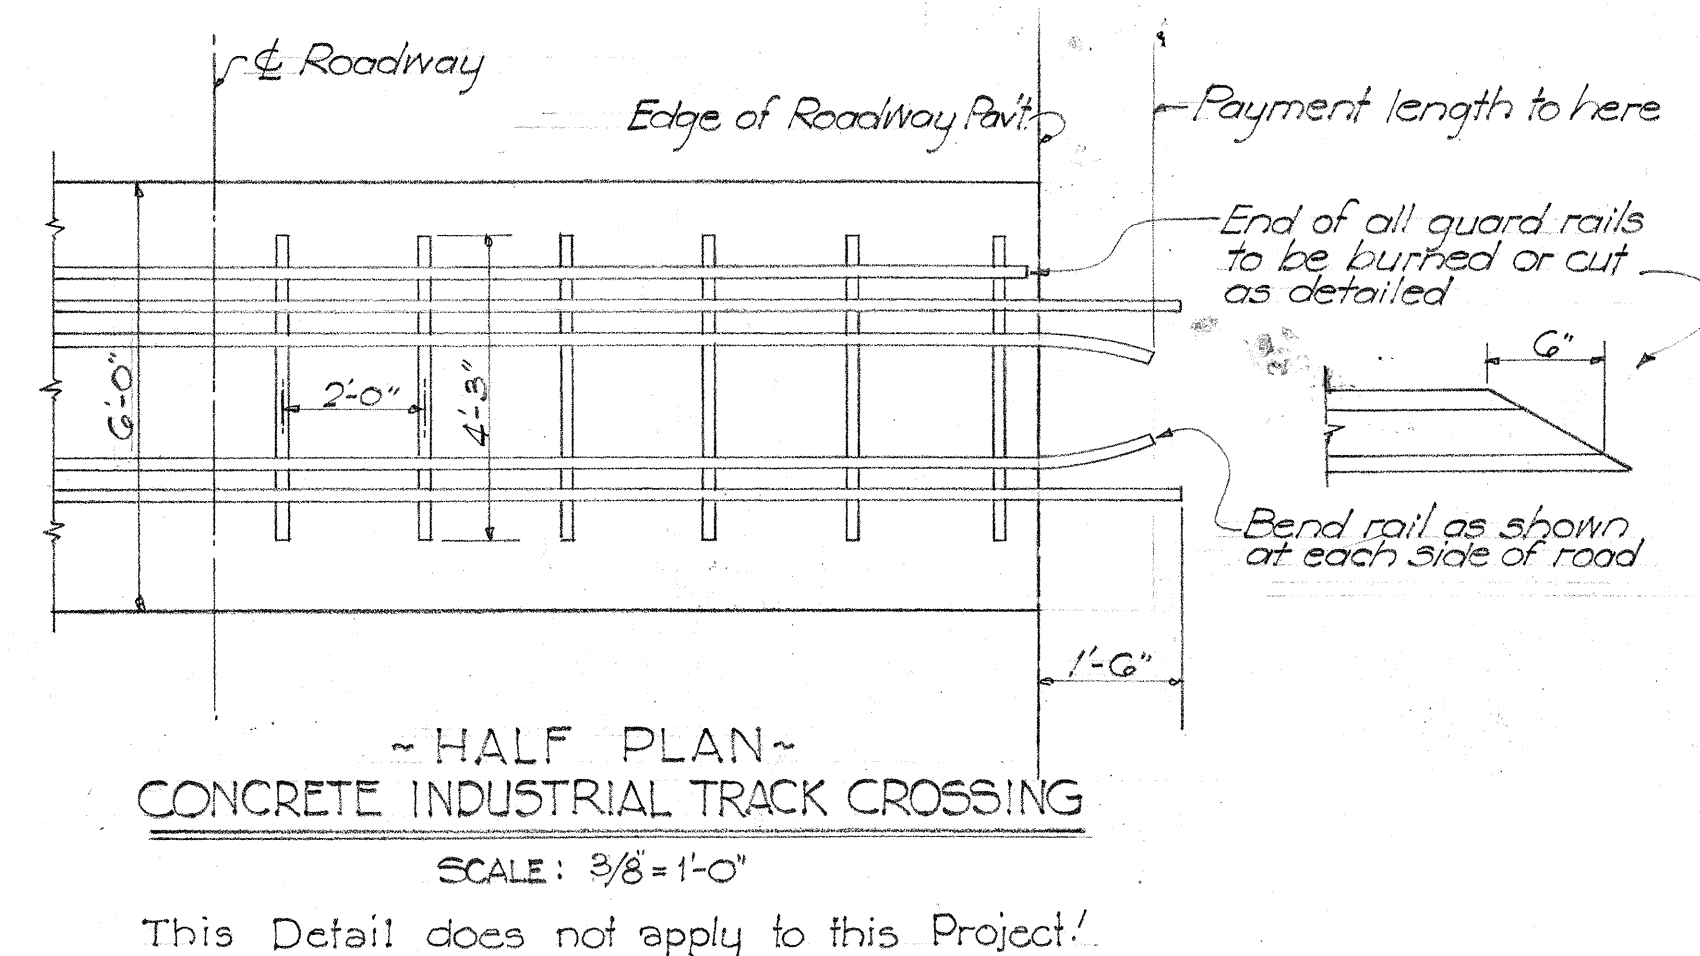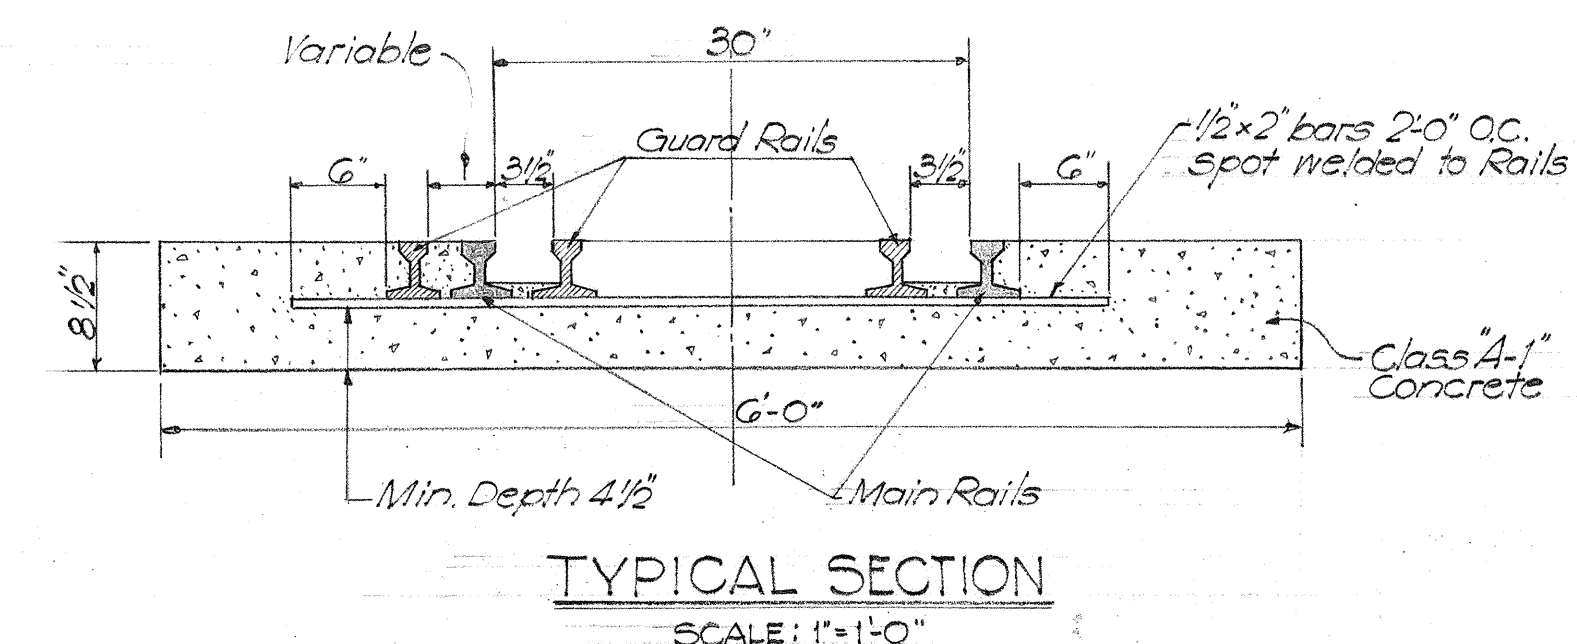

This Detail does not apply to this Project.

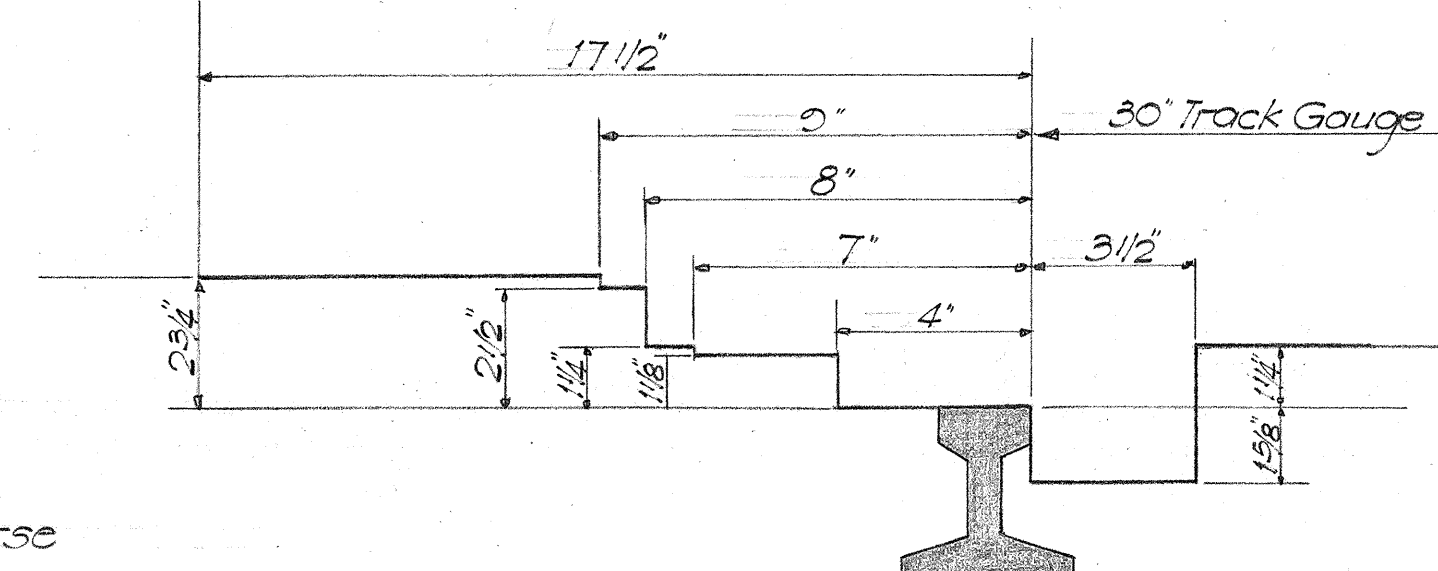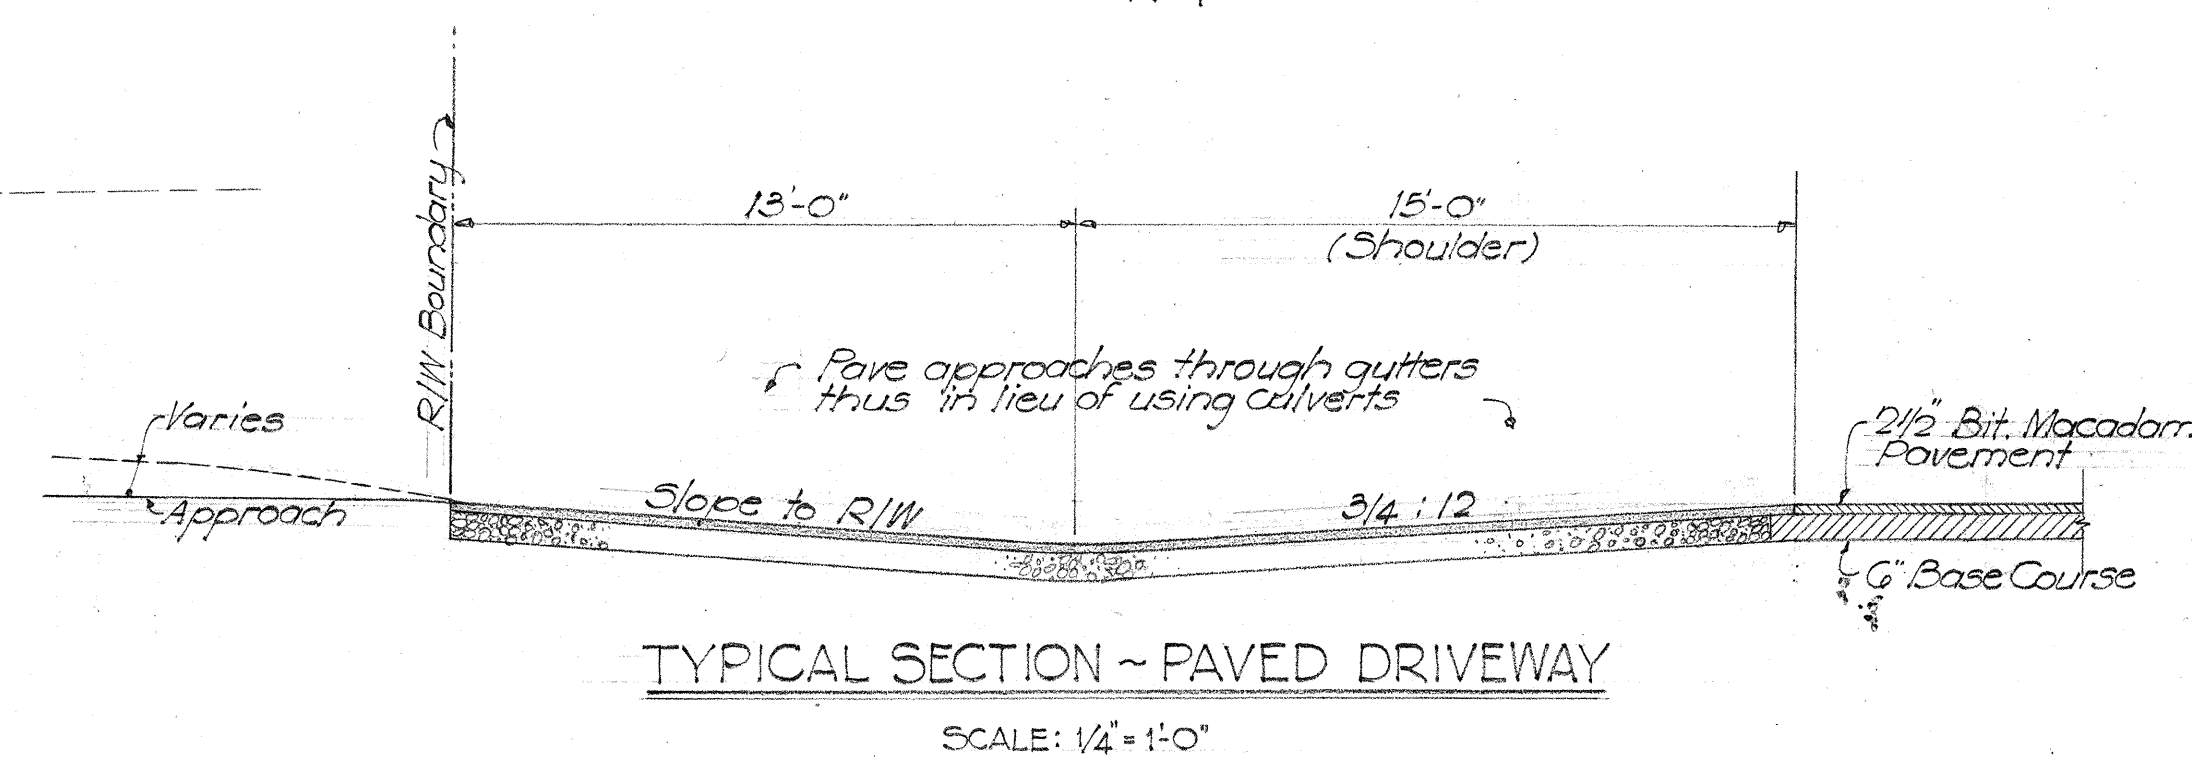

TERRITORIAL HIGHWAY DEPARTMENT
TERRITORY OF HAWAII
TYPICAL SECTIONS
PROJECT NO. F 12 (14)
Detail does not apply to this Project.

TERRITORIAL HIGHWAY DEPARTMENT
TERRITORY OF HAWAII
TYPICAL SECTIONS
PROJECT NO. F 12 (14)
SCALE: As Shown
DEC. 1945
SHEET No. OF SHEETS