




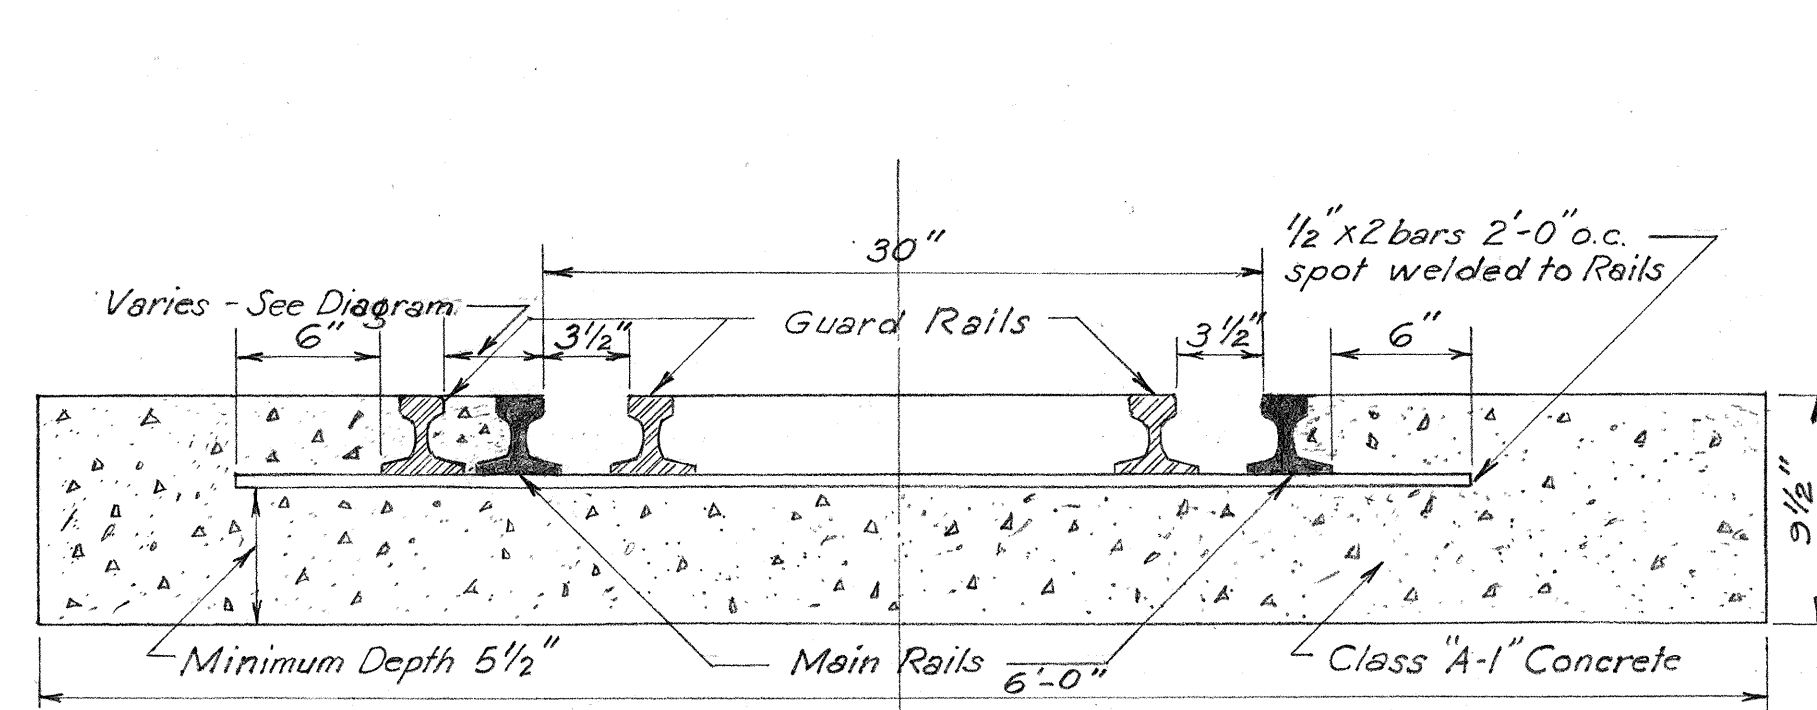


TYPICAL SECTION
Scale 1 1/2" = 1'-0"

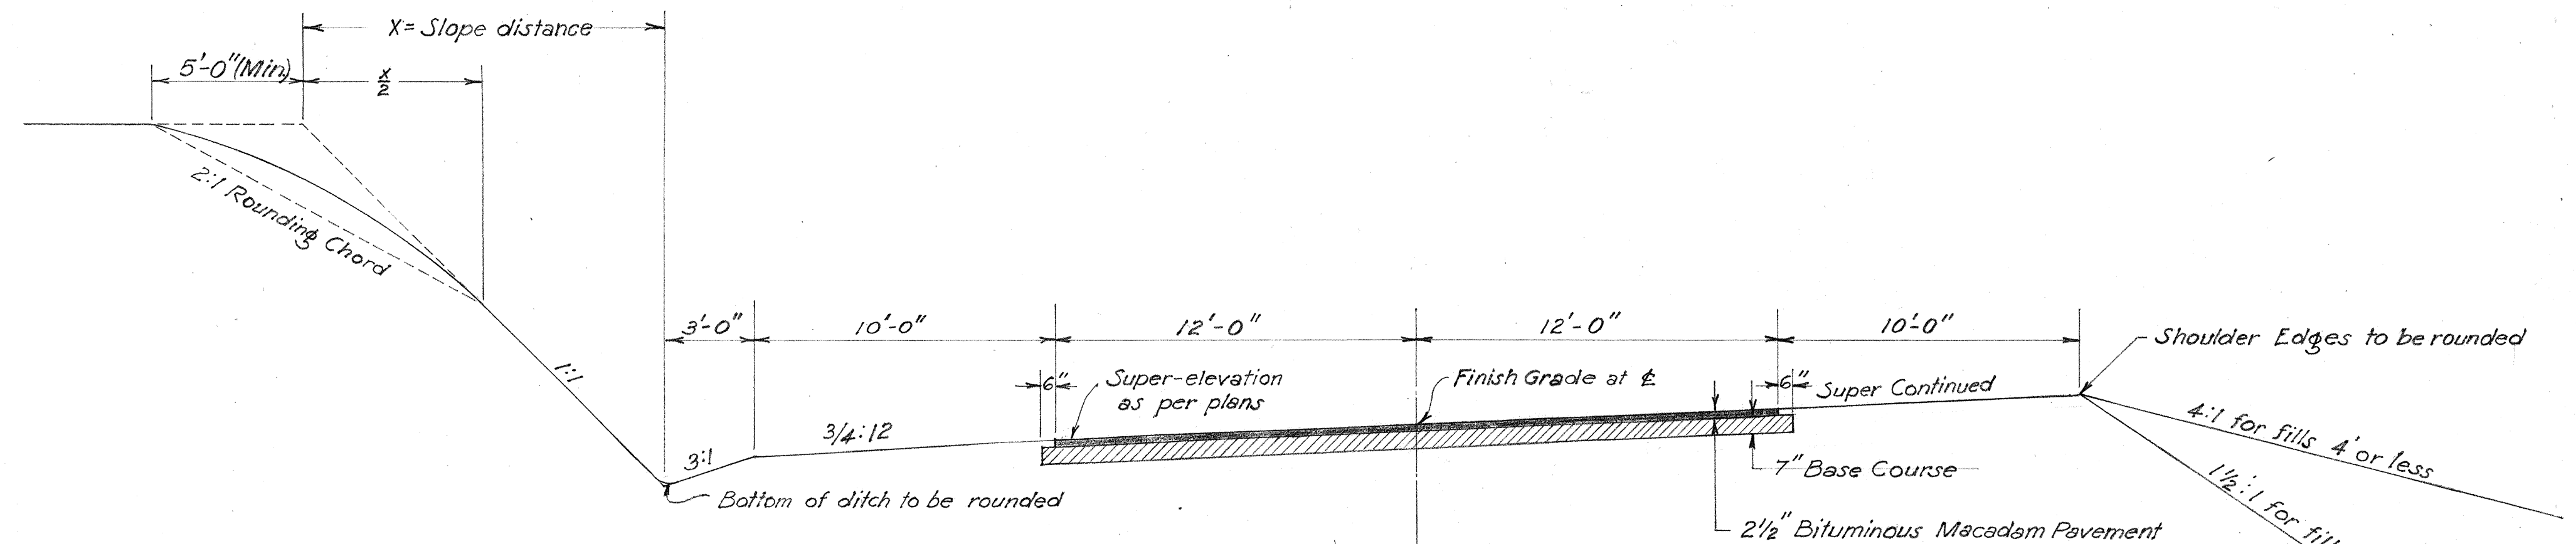


TYPICAL ROAD SECTIONS ON CURVES
Scale 1/4" = 1'-0"

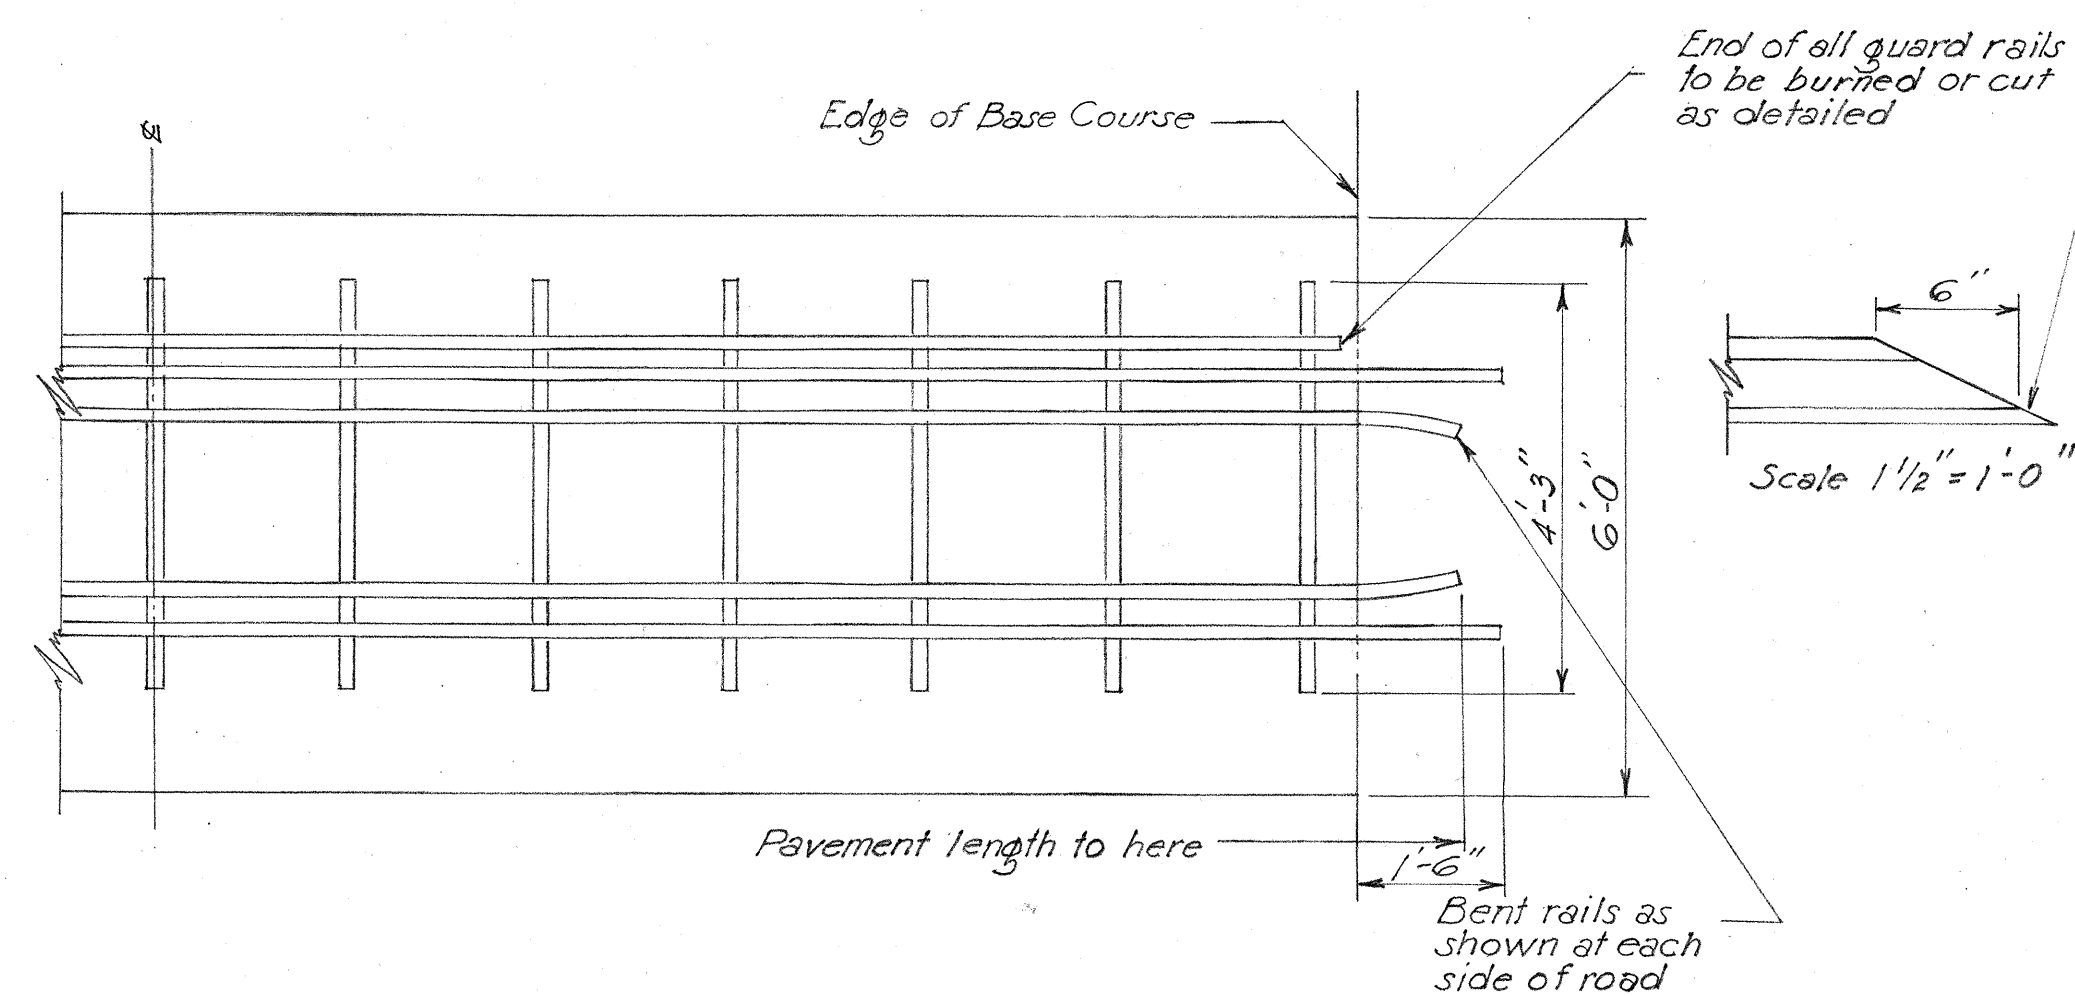


HALF PLAN
CONCRETE INDUSTRIAL TRACK CROSSING
Scale 1/2" = 1'-0"

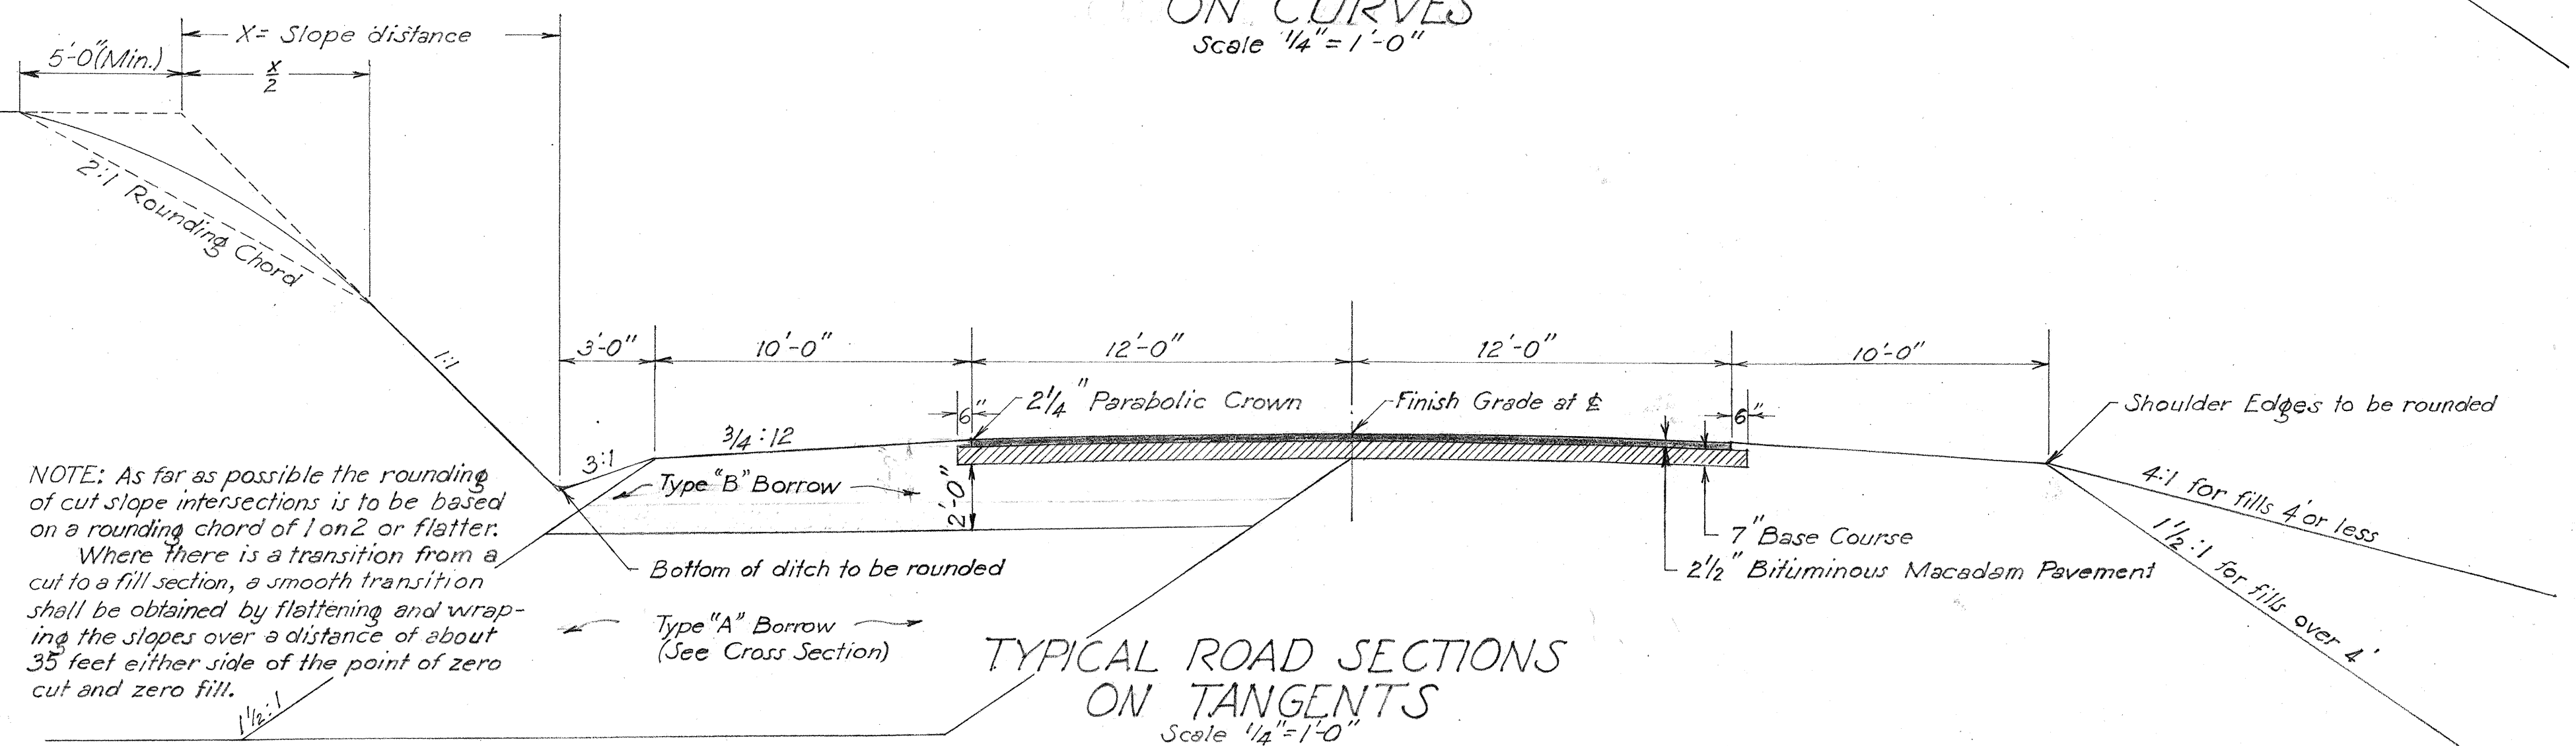

TYPICAL ROAD SECTIONS ON TANGENTS
Scale 1/4" = 1'-0"

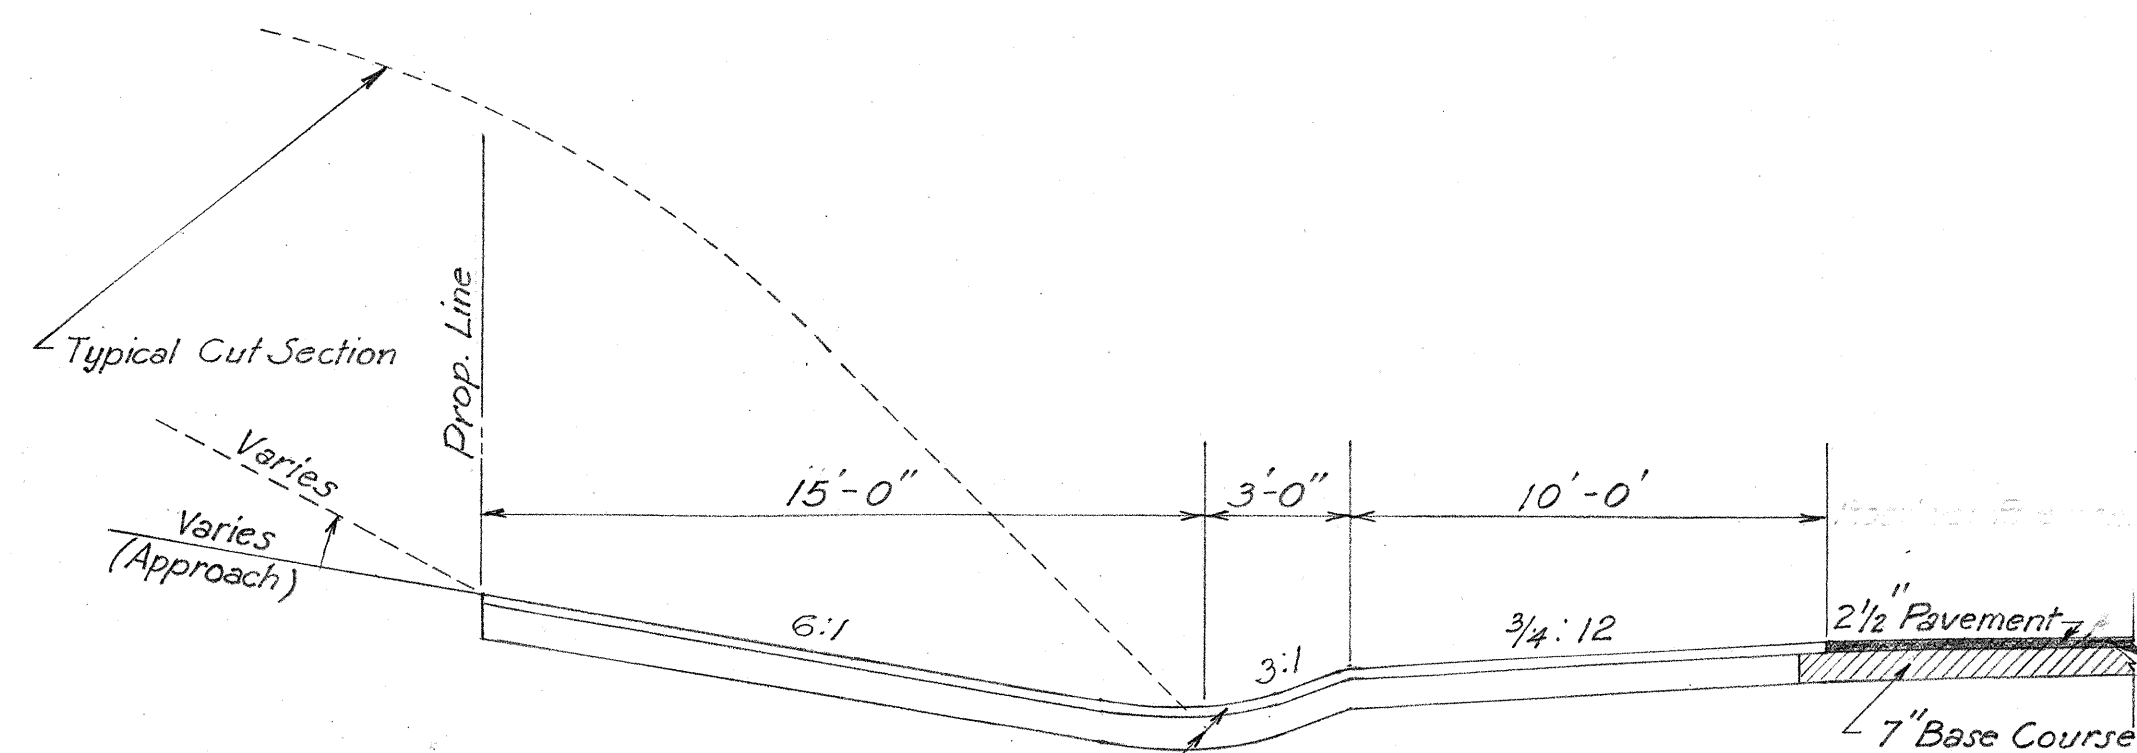

TYPICAL SECTION - DRIVEWAY
Scale 1/4" = 1'-0"

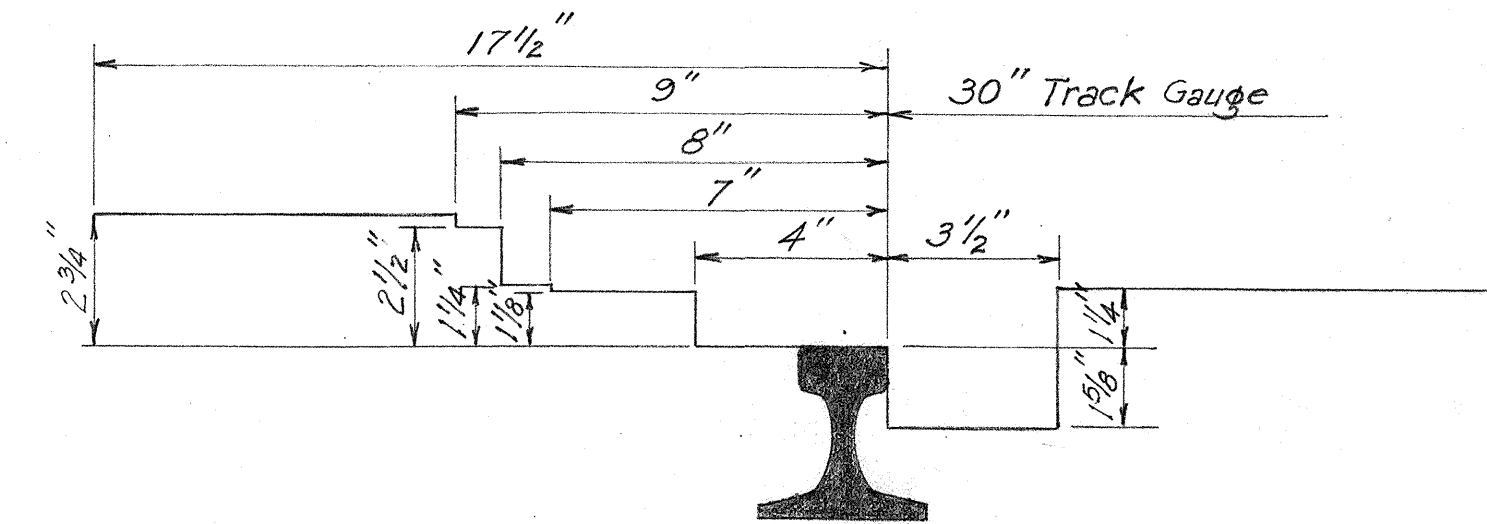

TRACK CLEARANCE DIAGRAM
Scale 3" = 1'-0"

NOTES ON PAVEMENT AND BASE COURSE

PAVEMENT--- Shall be a Bituminous Macadam Pavement with a 2 1/2" finished or compacted thickness all as follows: 2 1/2" (compacted) coarse rock (2 1/2"-1"); 1.25 gals. per sq. yd. of Bituminous Binder (85-100); approximately 0.01 cu. yd. per sq. yd. of Keystone (3/4"-#4); 0.40 gal. per sq. yd. of Bituminous Binder; approximately 0.005 cu. yd. per sq. yd. of chips, (3/8"-#10). Seal Coat - 0.20 gal. Bituminous Binder covered with 0.003 cu. yd. per sq. yd. of Rock Sand (#4-#20).

BASE COURSE--- Water-bound Macadam Base Course having 7" compacted thickness of mineral aggregate and filler.

General Notes: Refer to Specifications and Special Provisions covering all these items of work.

TERRITORIAL HIGHWAY DEPARTMENT
TERRITORY OF HAWAII
TYPICAL ROAD SECTIONS
& CONCRETE INDUSTRIAL TRACK
CROSSING DETAILS
KAUAI BELT ROAD F12(15)

SHEET No. OF SHEETS

5178.2