


FED. ROAD DIST. NO.	STATE	FED. AID PROJ. NO.	FISCAL YEAR	SHEET NO.	TOTAL SHEETS
HAWAII	HAW	F12(18)	1950	24	26

FINAL SURVEY	SURVEYED	BY	DATE
NOTE BOOK	PLOTTED		
	TEMPLATE		
	AREAS		
NO. _____	AREAS CHECKED		


ORIGINAL			
SURVEY	SURVEYED	BY	DATE
	PLOTTED		
NOTE BOOK	TEMPLATE		
	AREAS		
NO.	AREAS CHECKED		

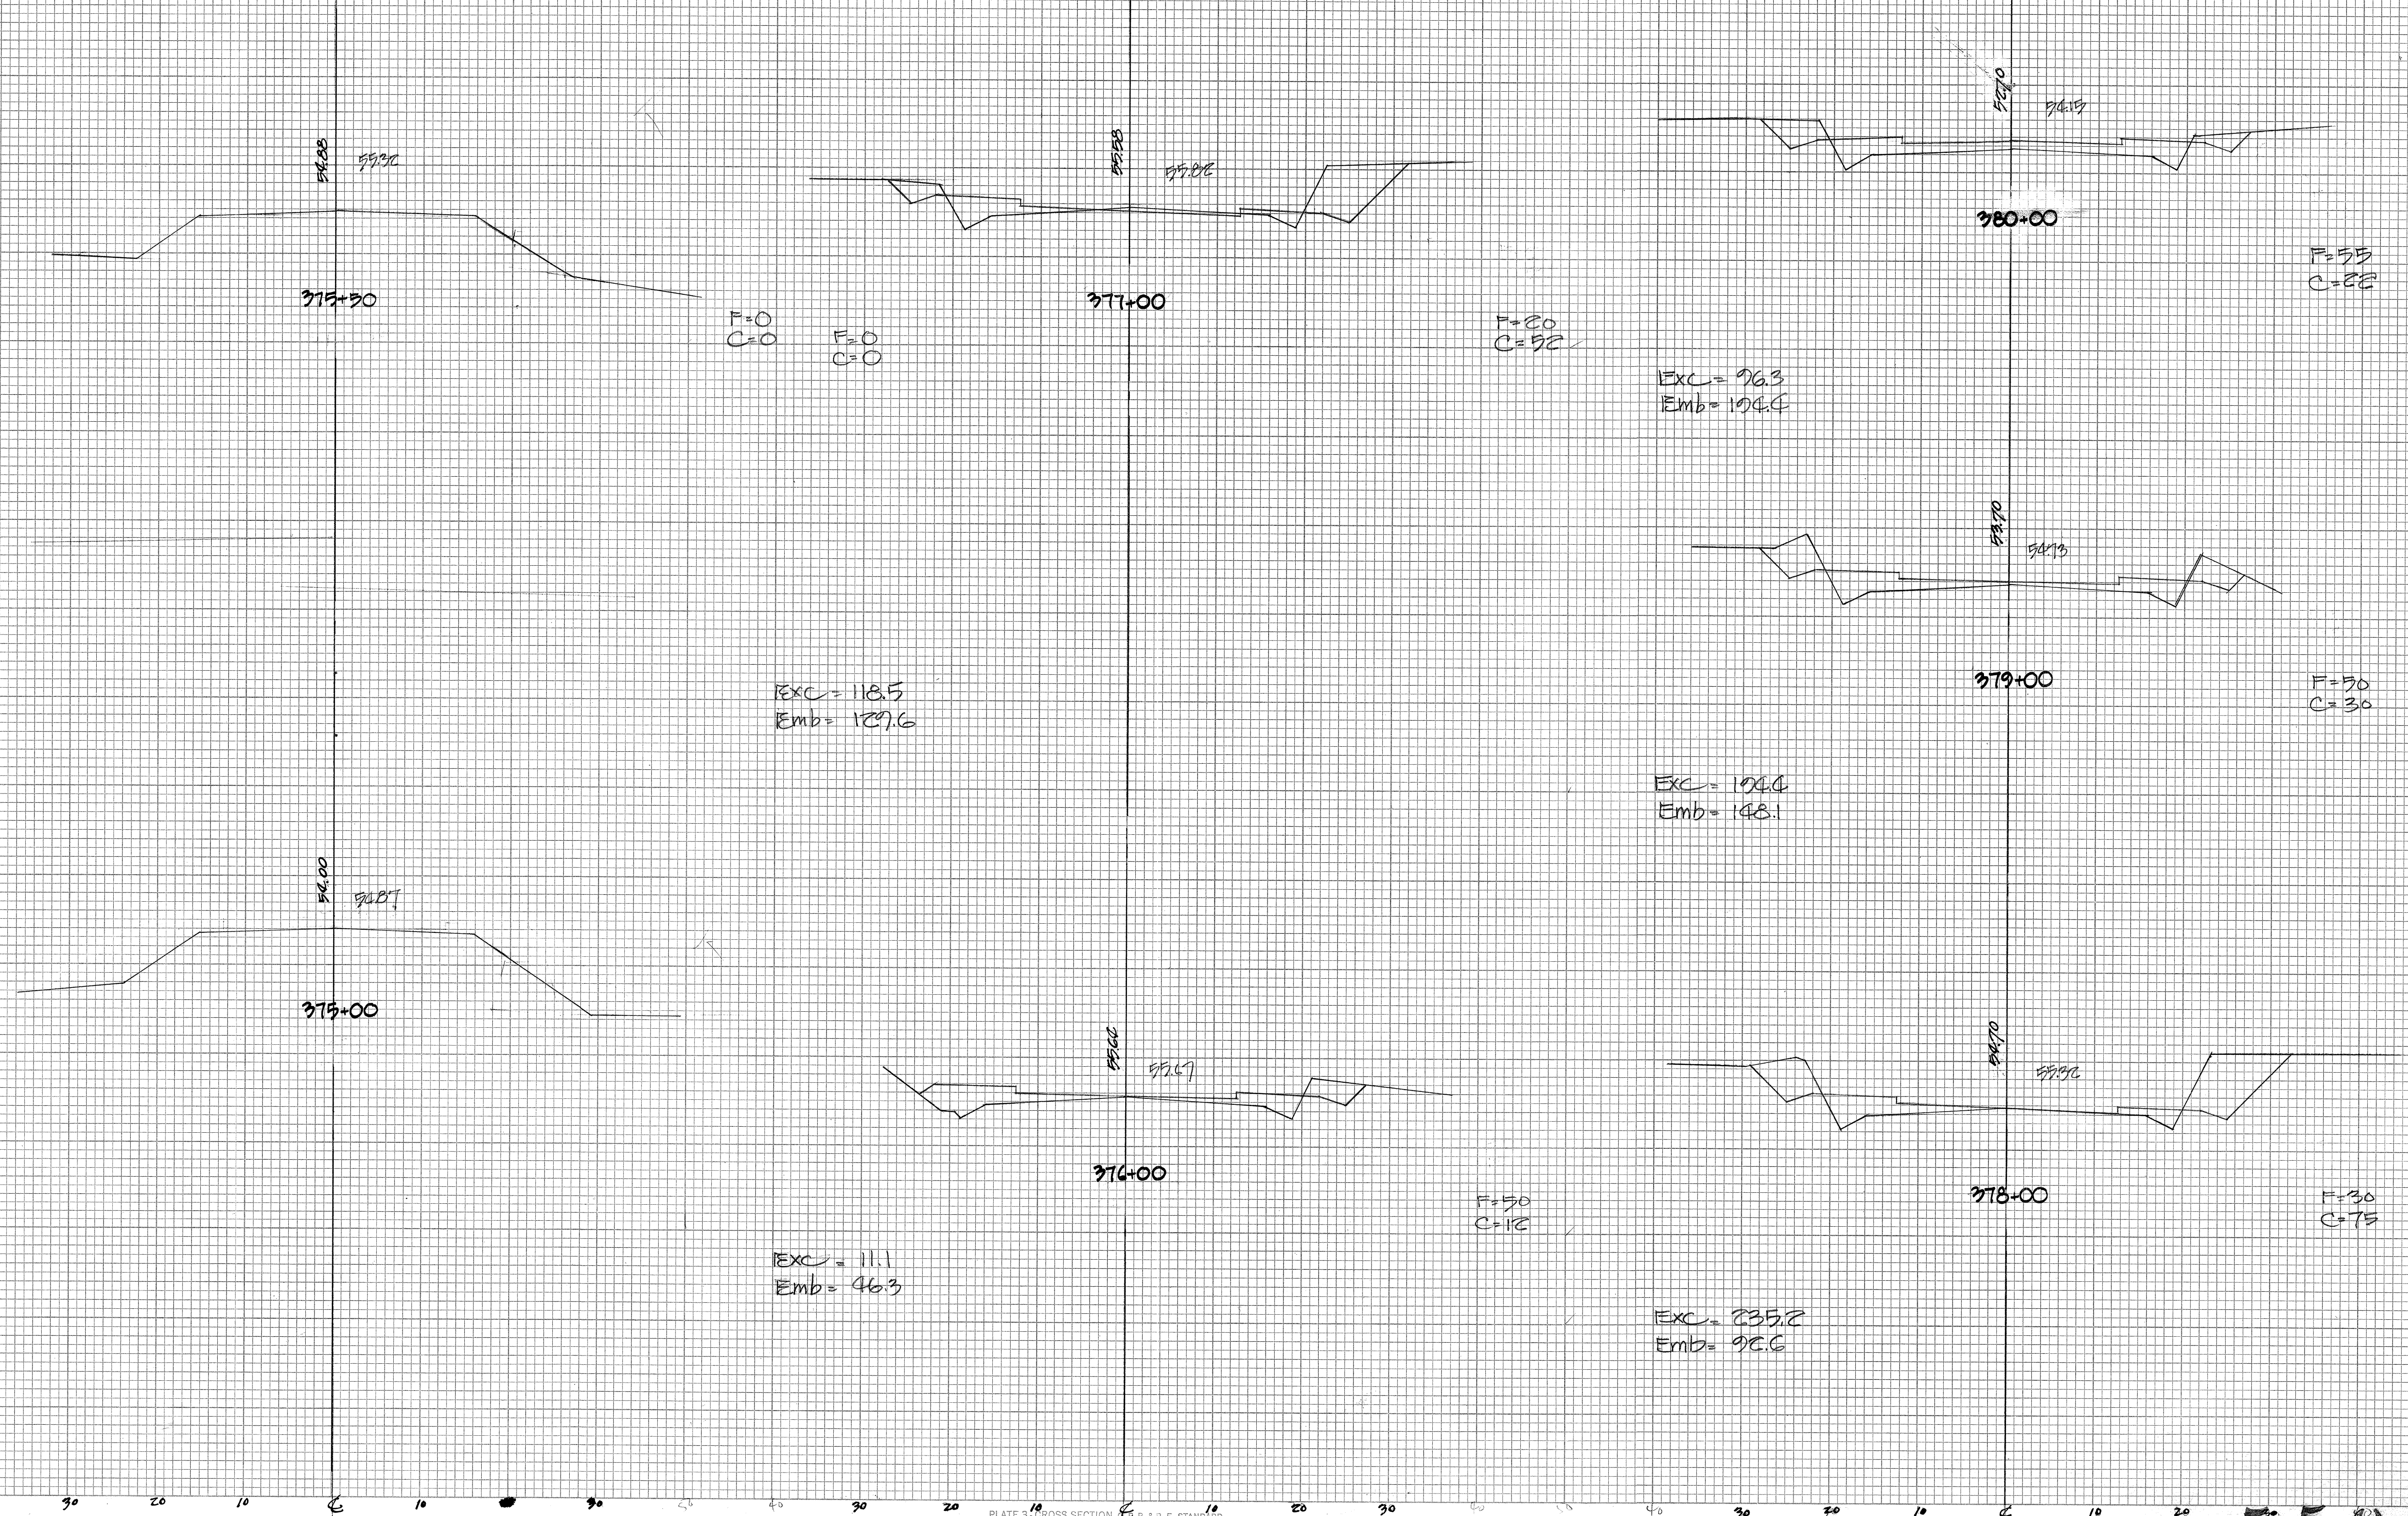

5501.24


FINAL SURVEY PLOTTED
NOTE BOOK NO. 100
DATE 1/1/50
BY [Signature]
AREAS CHECKED

ORIGINAL SURVEY PLOTTED
NOTE BOOK NO. 100
DATE 1/1/50
BY [Signature]
AREAS CHECKED

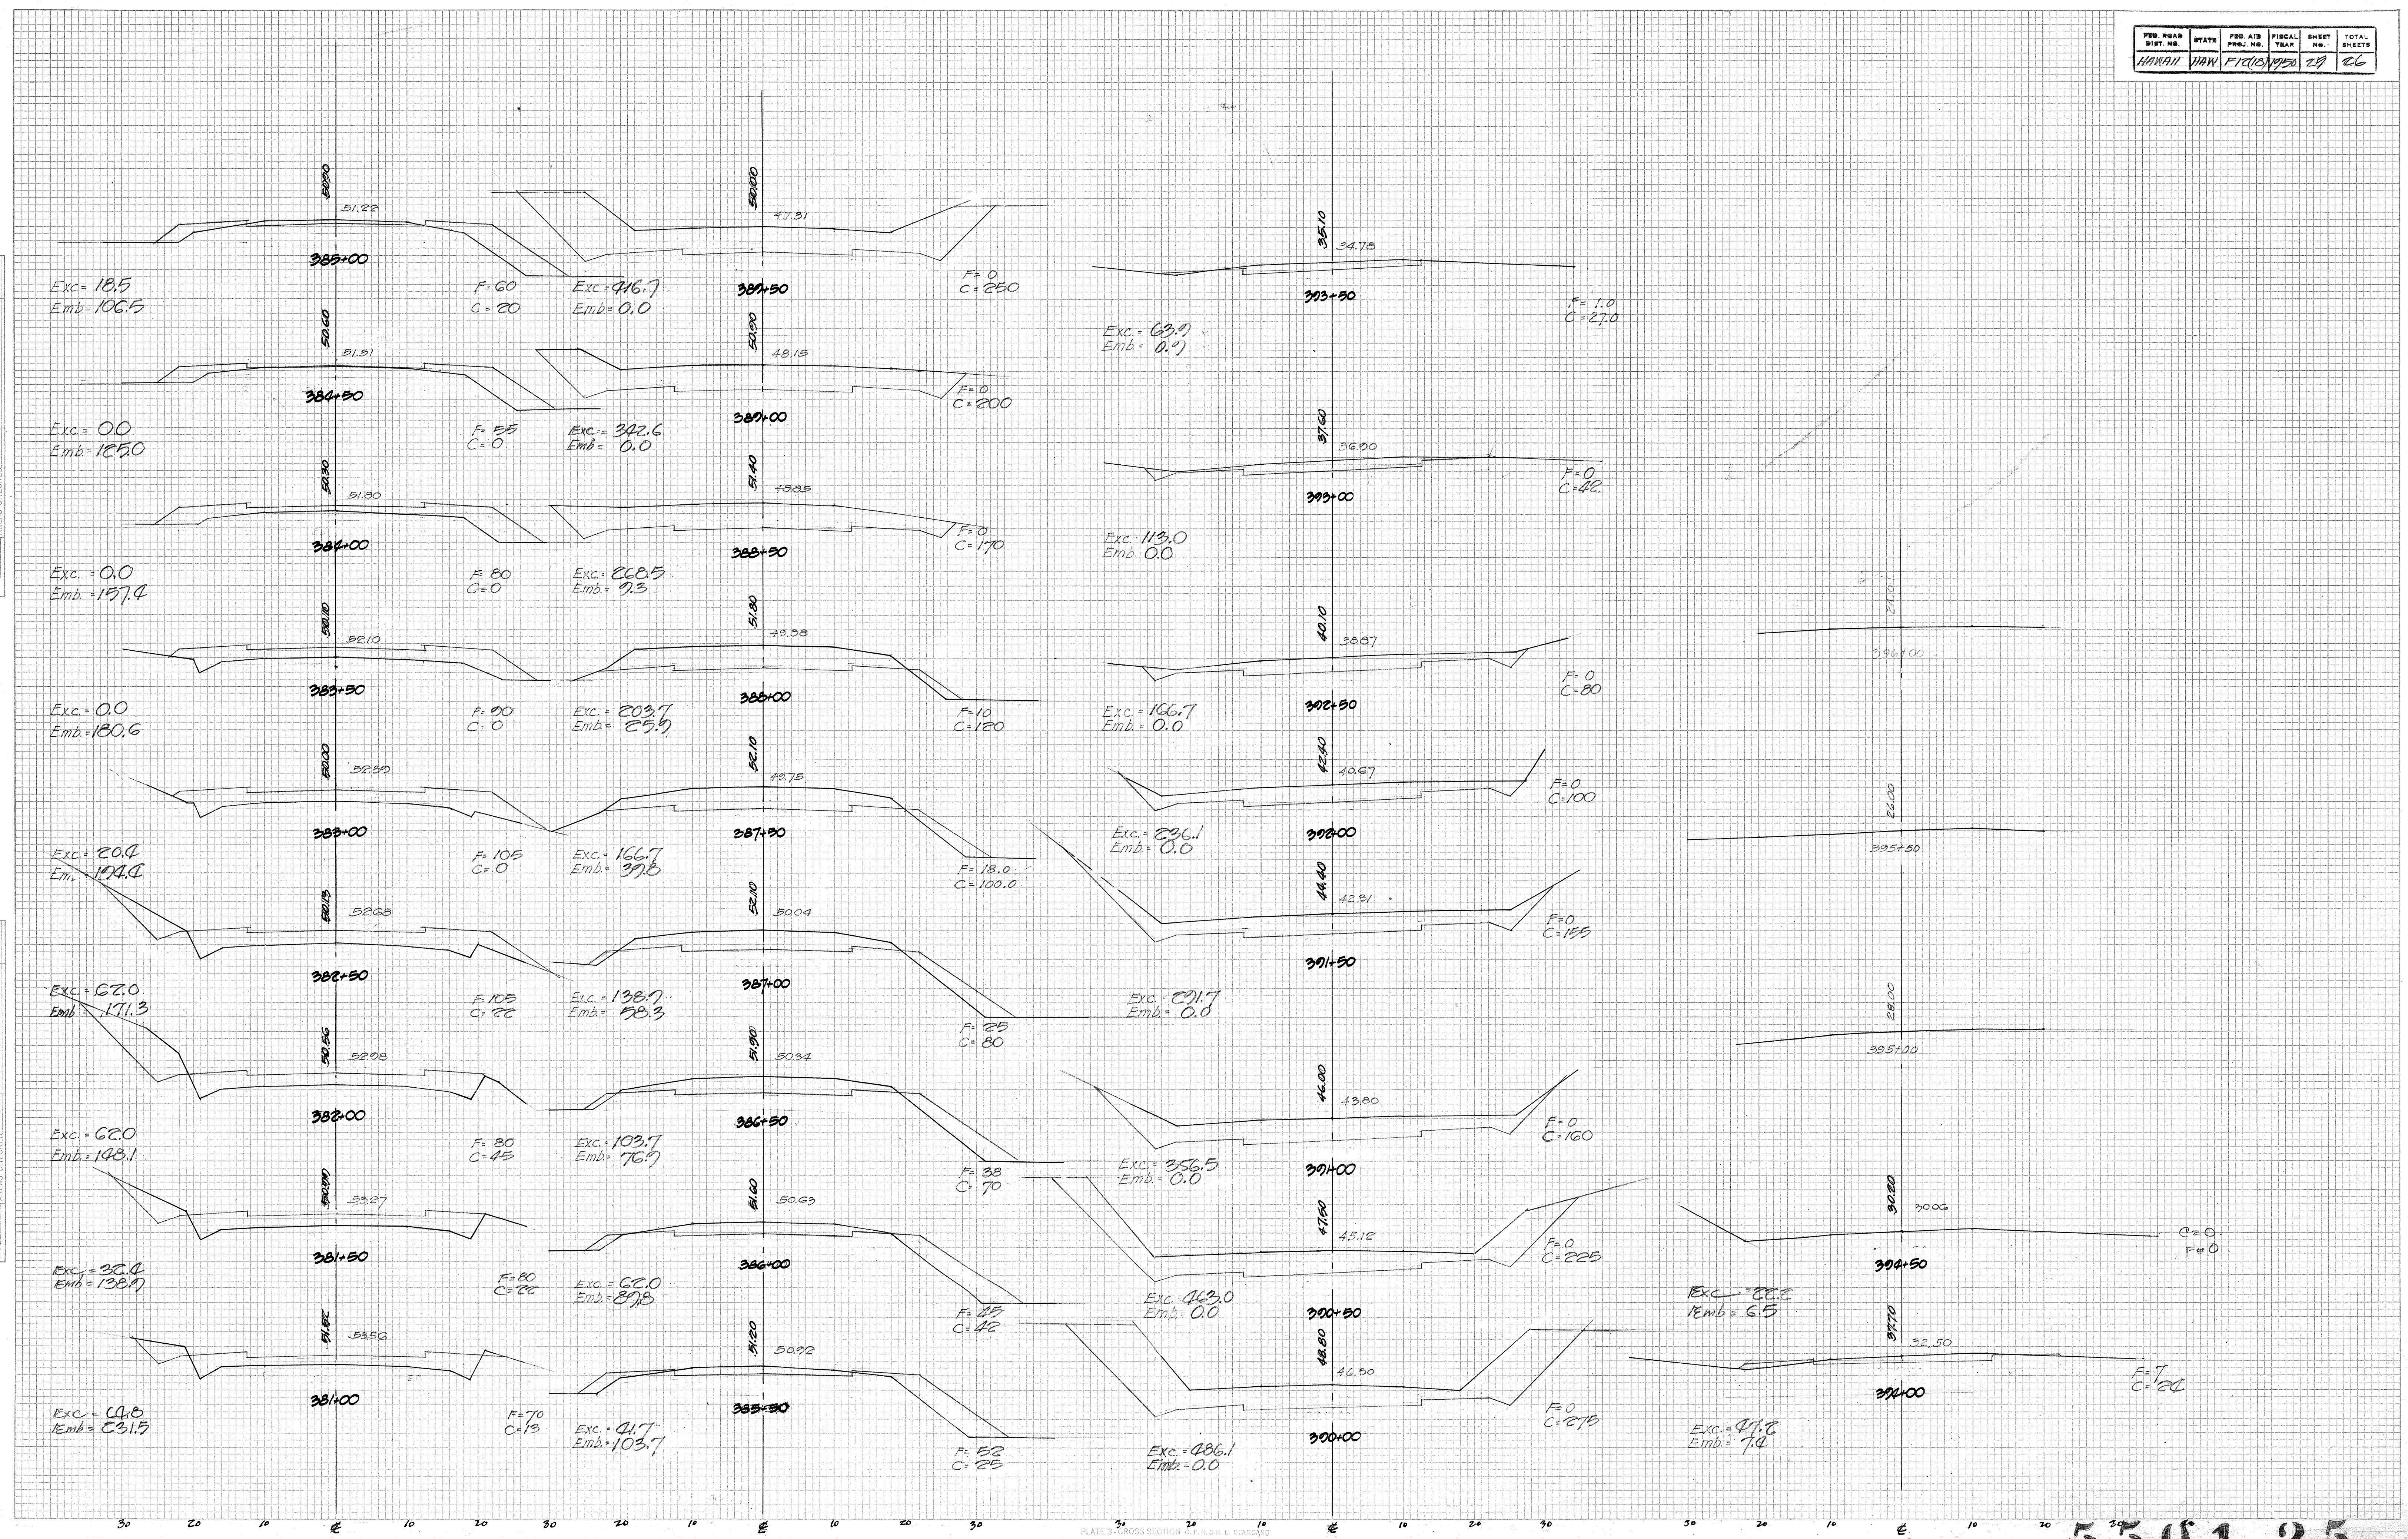

FINAL SURVEY	BY	DATE
NOTE BOOK		
NO. _____		
AREAS CHECKED		
SURVEYED		
PLOTTED		
TEMPLATE		
AREAS		

ORIGINAL	BY	DATE
SURVEYED		
PLOTTED		
TEMPLATE		
AREAS		
NO.		
AREAS CHECKED		

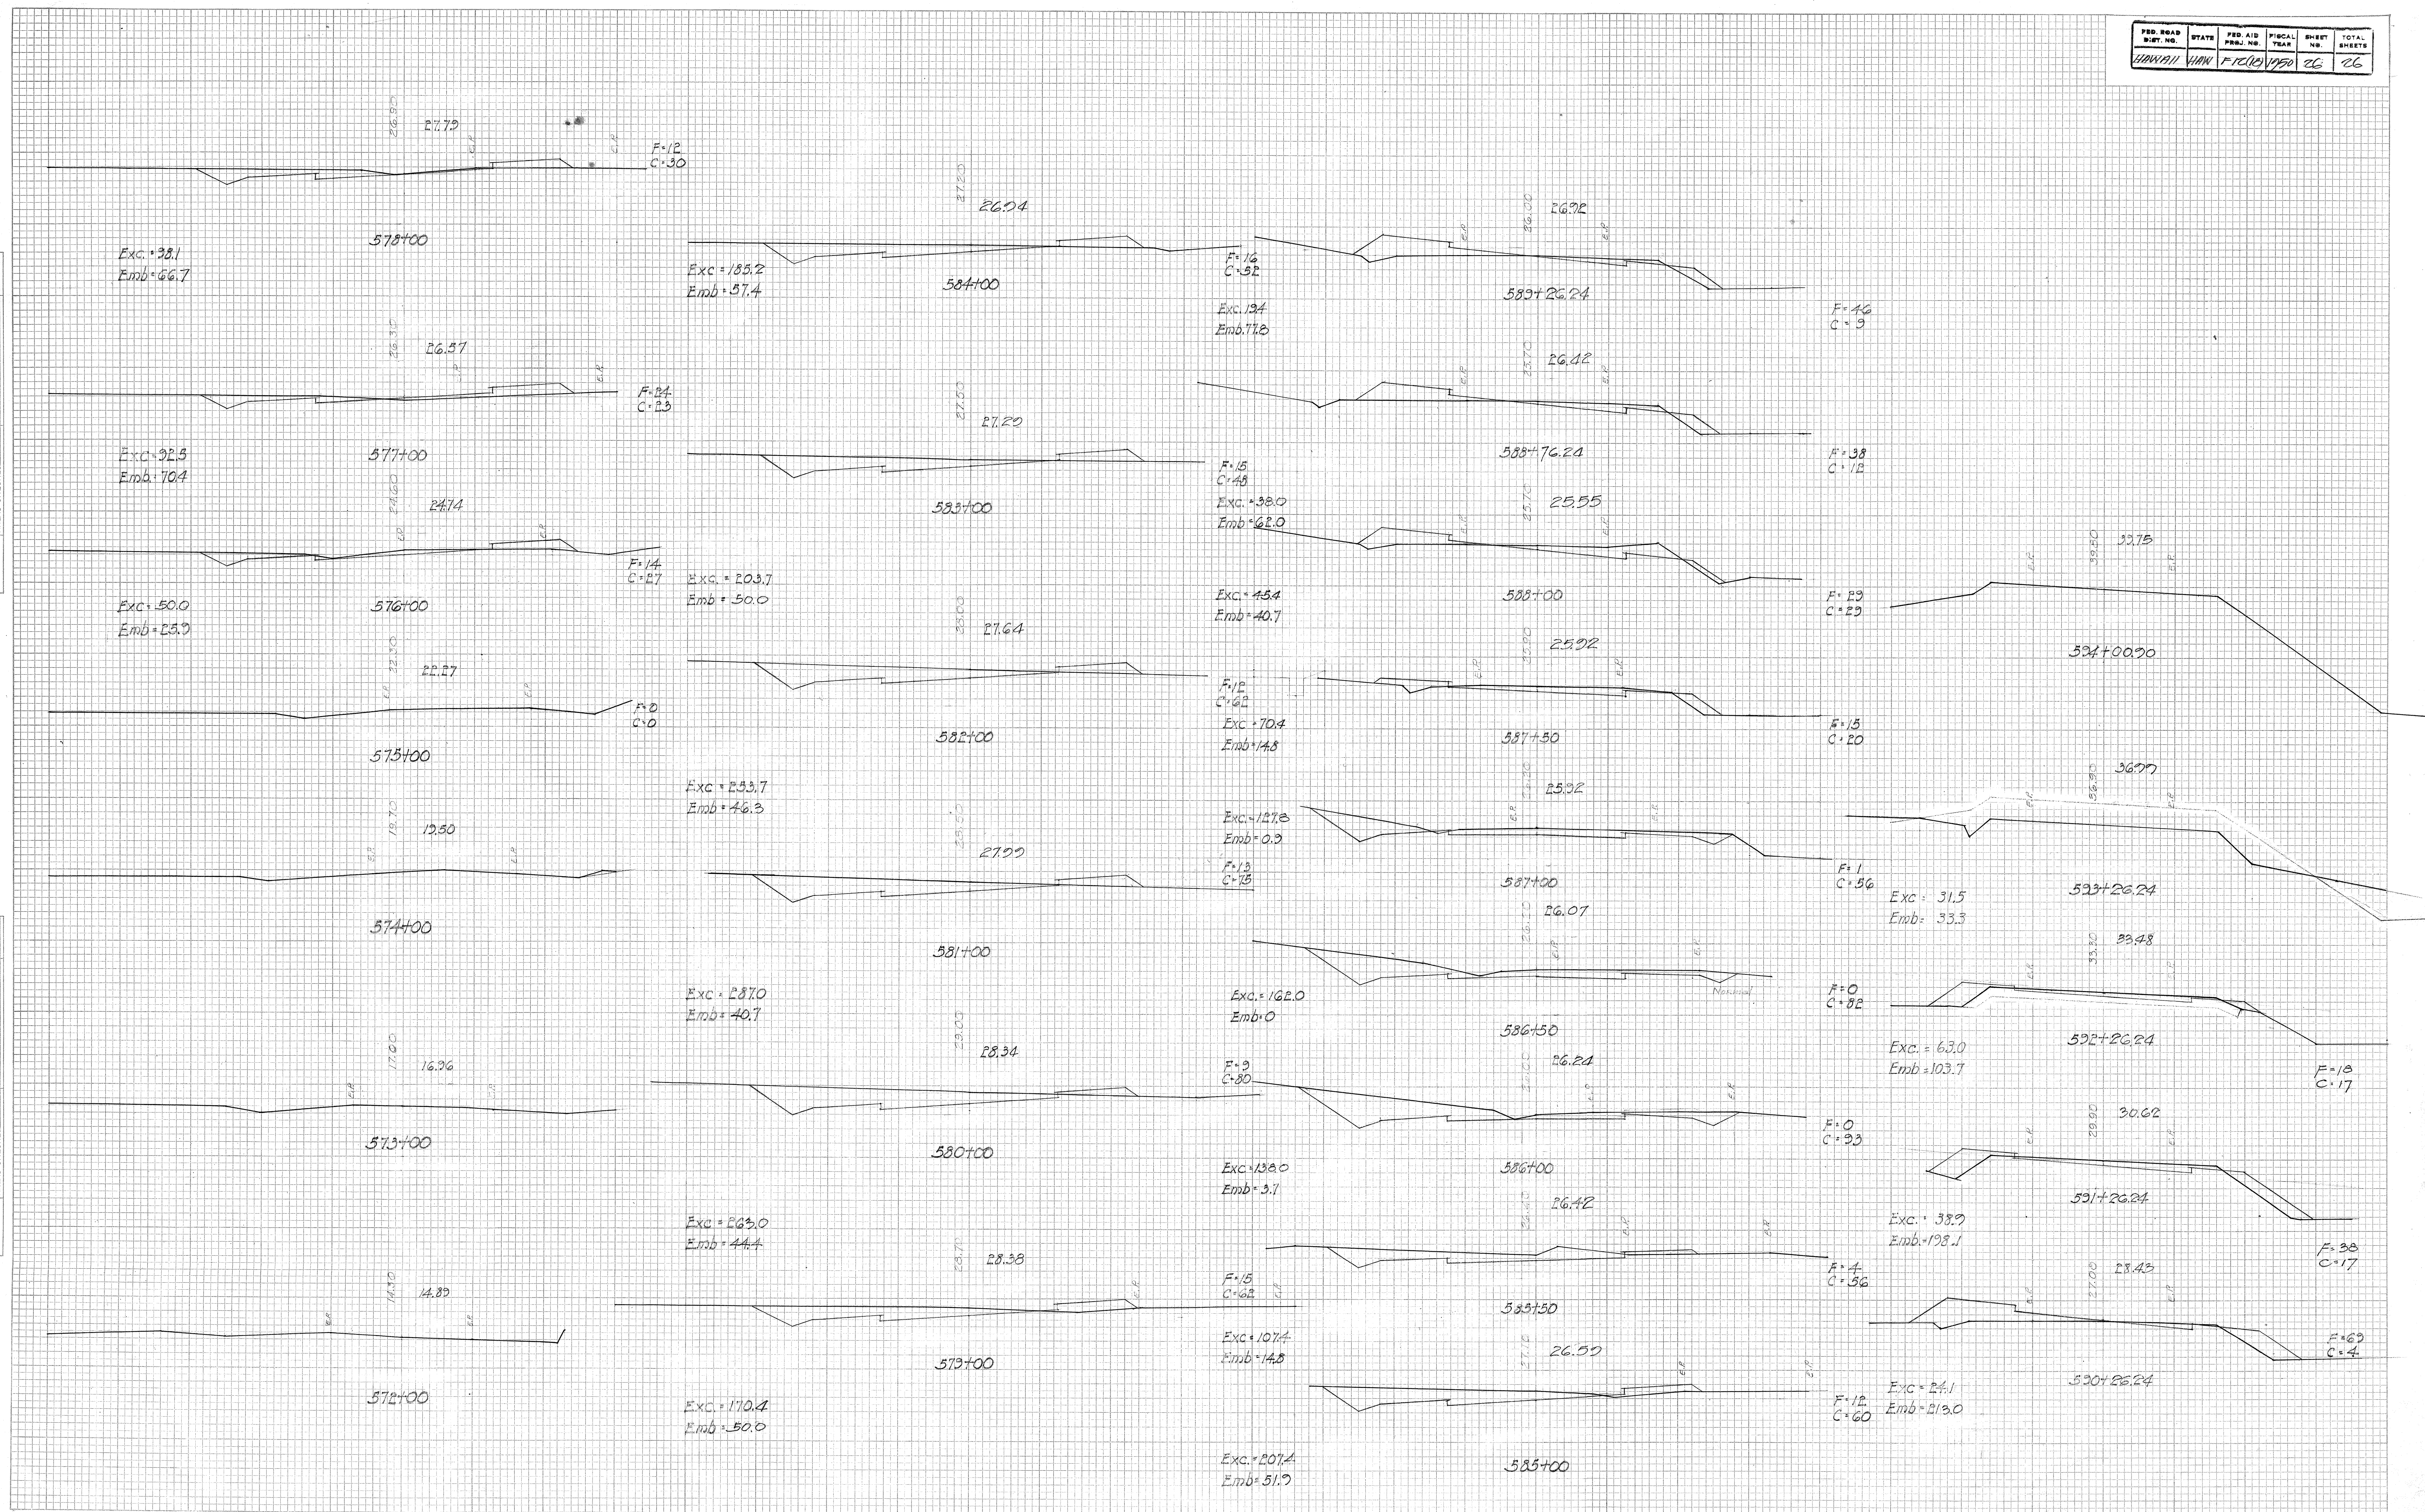

5501.26