

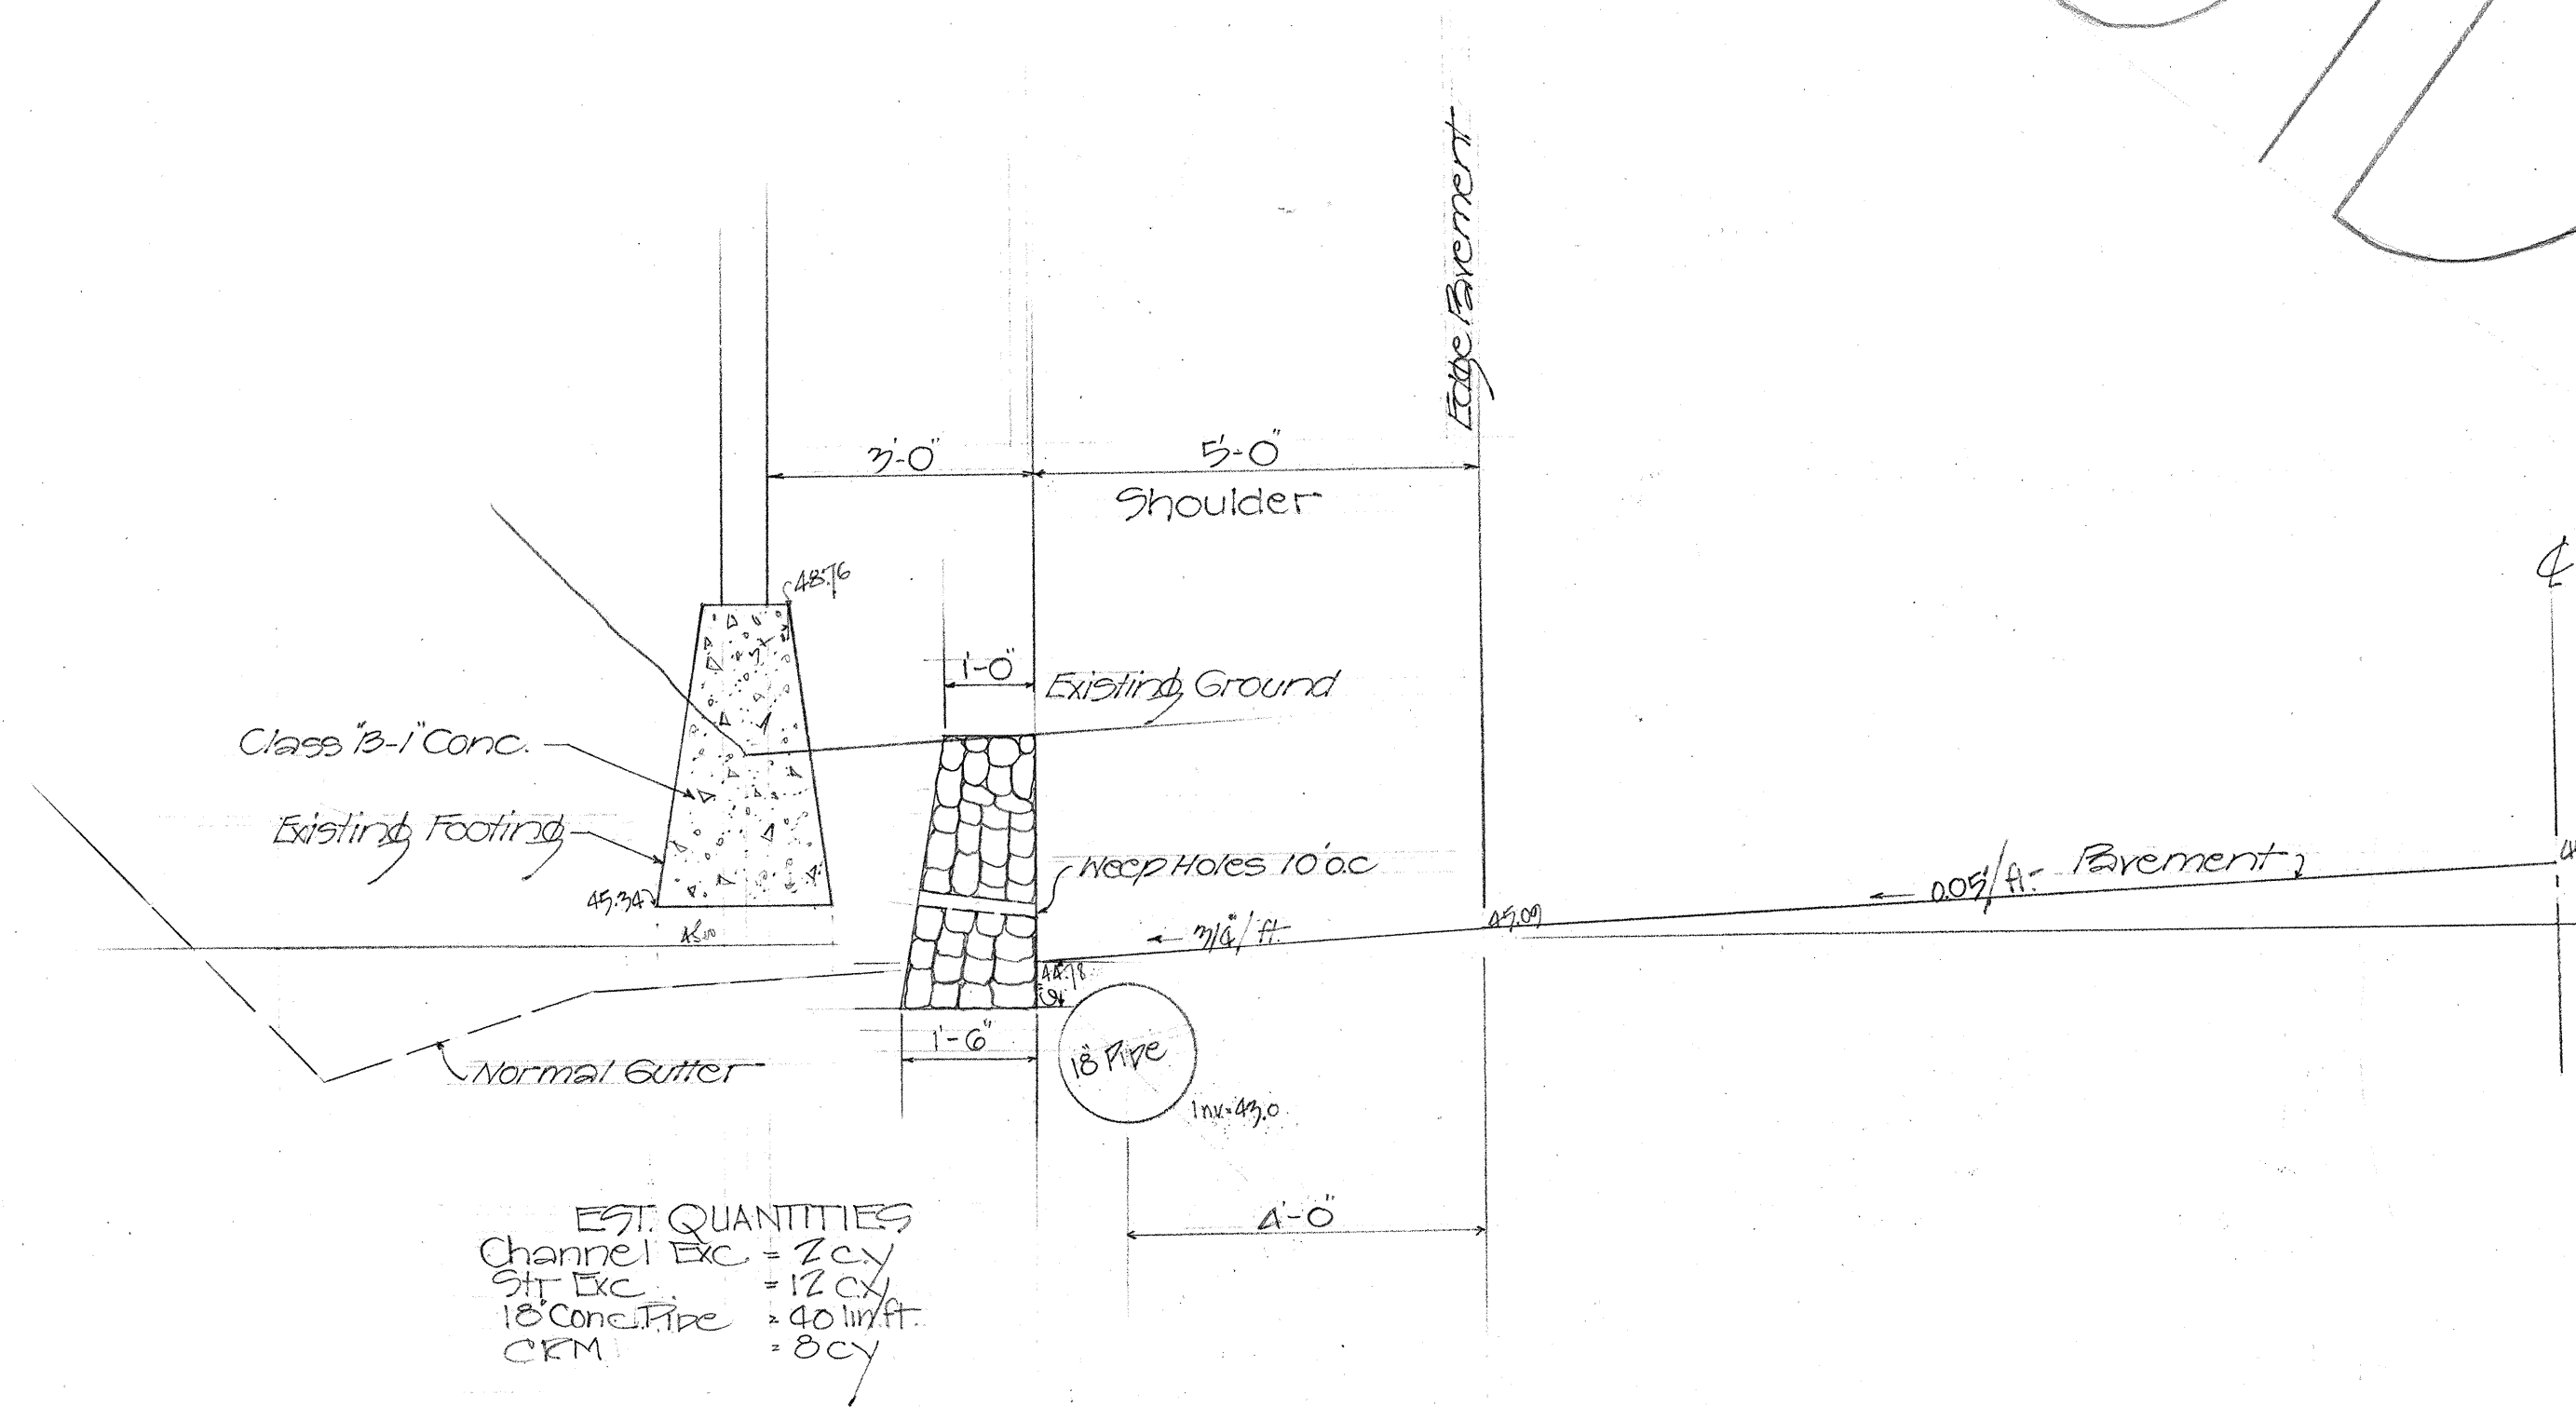


FED. ROAD DIST. NO.	STATE	FED. AID PROJ. NO.	FISCAL YEAR	SHEET NO.	TOTAL SHEETS
HAWAII	HAW	F12(18)	1950	23	26

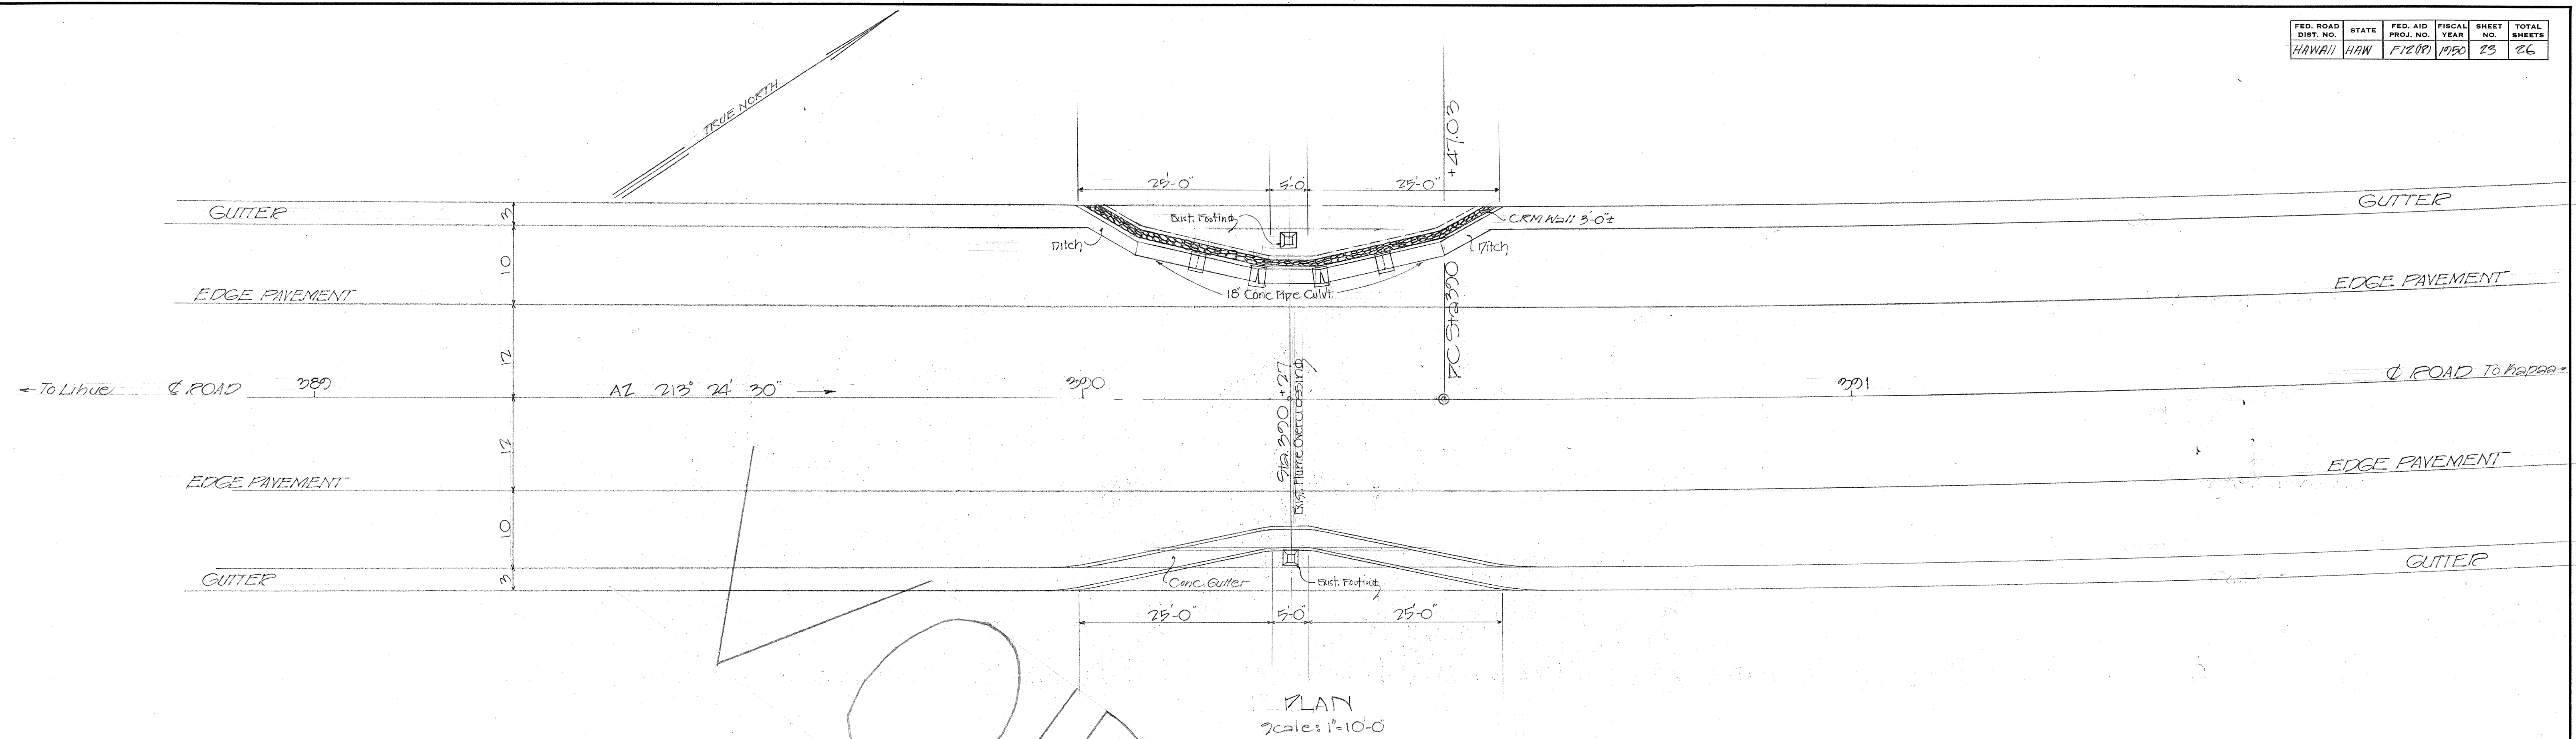

ELEVATION AT STA 390+27
Scale: 1/2" = 1'-0"

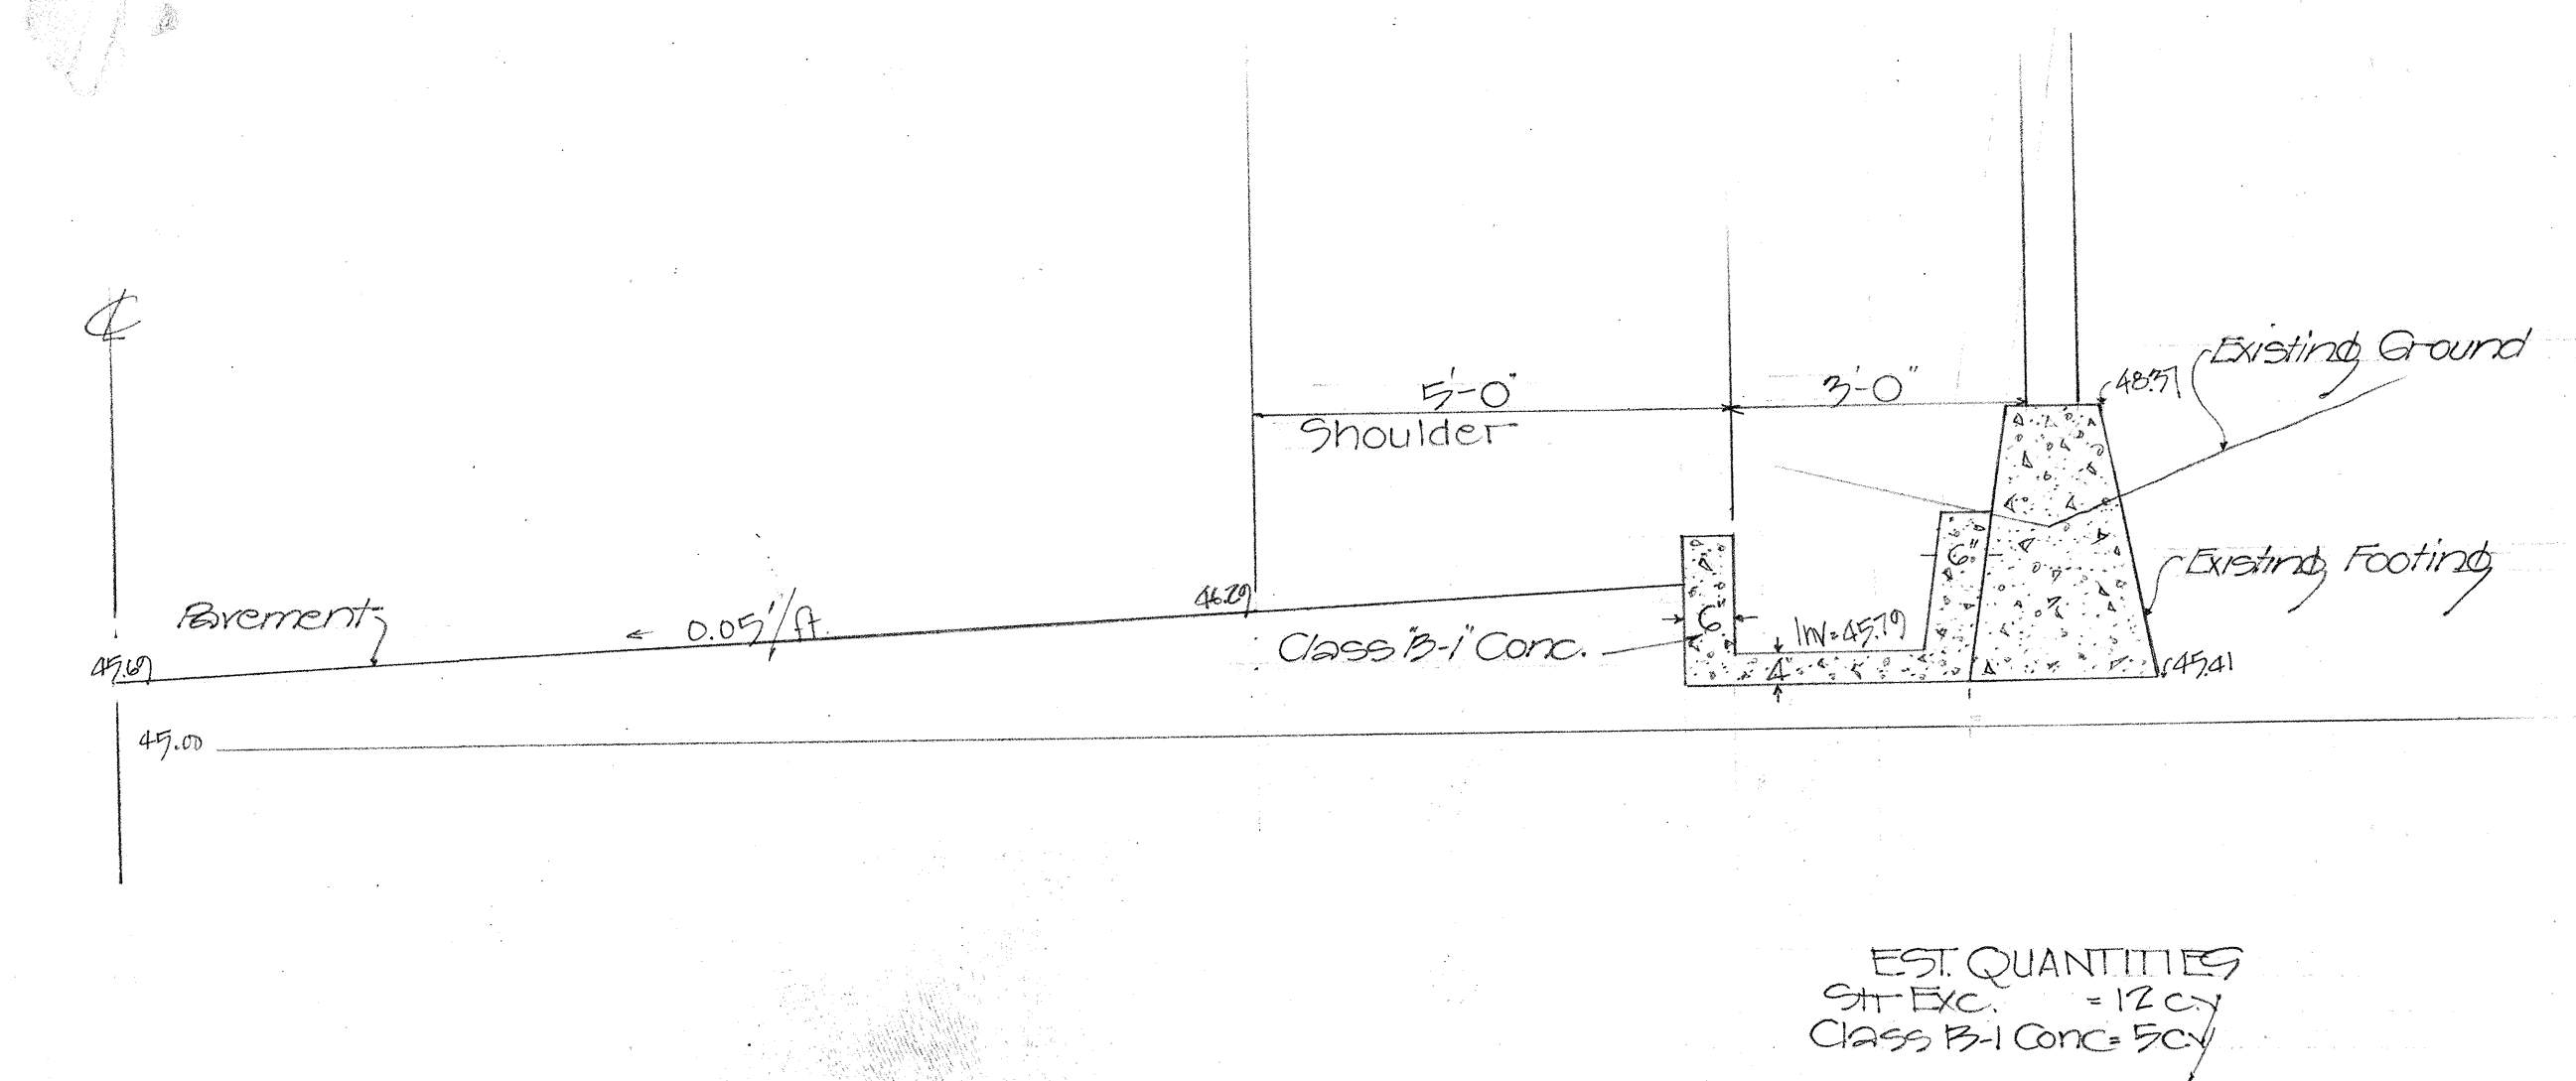

EST. QUANTITIES
Gut. Exc. = 12 cy
Class B-1 Conc. = 50 cy

SURVEY PLOTTED BY	DATE
DESIGNED BY	
DRAWN BY	
TRACED BY	
QUANTITIES CHECKED BY	
CHECKED BY	
ORIGINAL PLAN NO.	
NOTE BOOK NO.	

TERRITORIAL HIGHWAY DEPARTMENT
TERRITORY OF HAWAII

GUTTER DETAIL
STA. 390+27

HAWAII BELT RD. PROJ. NO. F12(18)
SCALE AS SHOWN SEPT 1950

SHEET No. 1 OF 1 SHEETS

5501.23