

INDEX TO DRAWINGS	
SHEET NO.	DESCRIPTIONS
1	Title Sheet
2	Typical Sections
3	Plan & Profile
4-7	Standard Details
8-16	Bridge Details
17	Standard Bridge Details
18-20	Cross Sections

FED. ROAD DIST. NO.	STATE	FED. AID PROJ. NO.	FISCAL YEAR	SHEET NO.	TOTAL SHEETS
Hawaii	Haw.	F12(20)	1951	1	20

TERRITORY OF HAWAII

TERRITORIAL HIGHWAY DEPARTMENT

HONOLULU T. H.

PLANS OF



KAUAI BELT ROAD

FEDERAL AID PROJECT NO.F12 (20)

DISTRICT OF KAWAIHAU

ISLAND OF KAUAI

SCALES	
PLAN	1 IN. = 100 FT.
PROFILE	HOR. 1 IN. = 100 FT.
	VERT. 1 IN. = 10 FT.
CROSS SECTION	HOR. 1 IN. = 10 FT.
	VERT. 1 IN. = 10 FT.

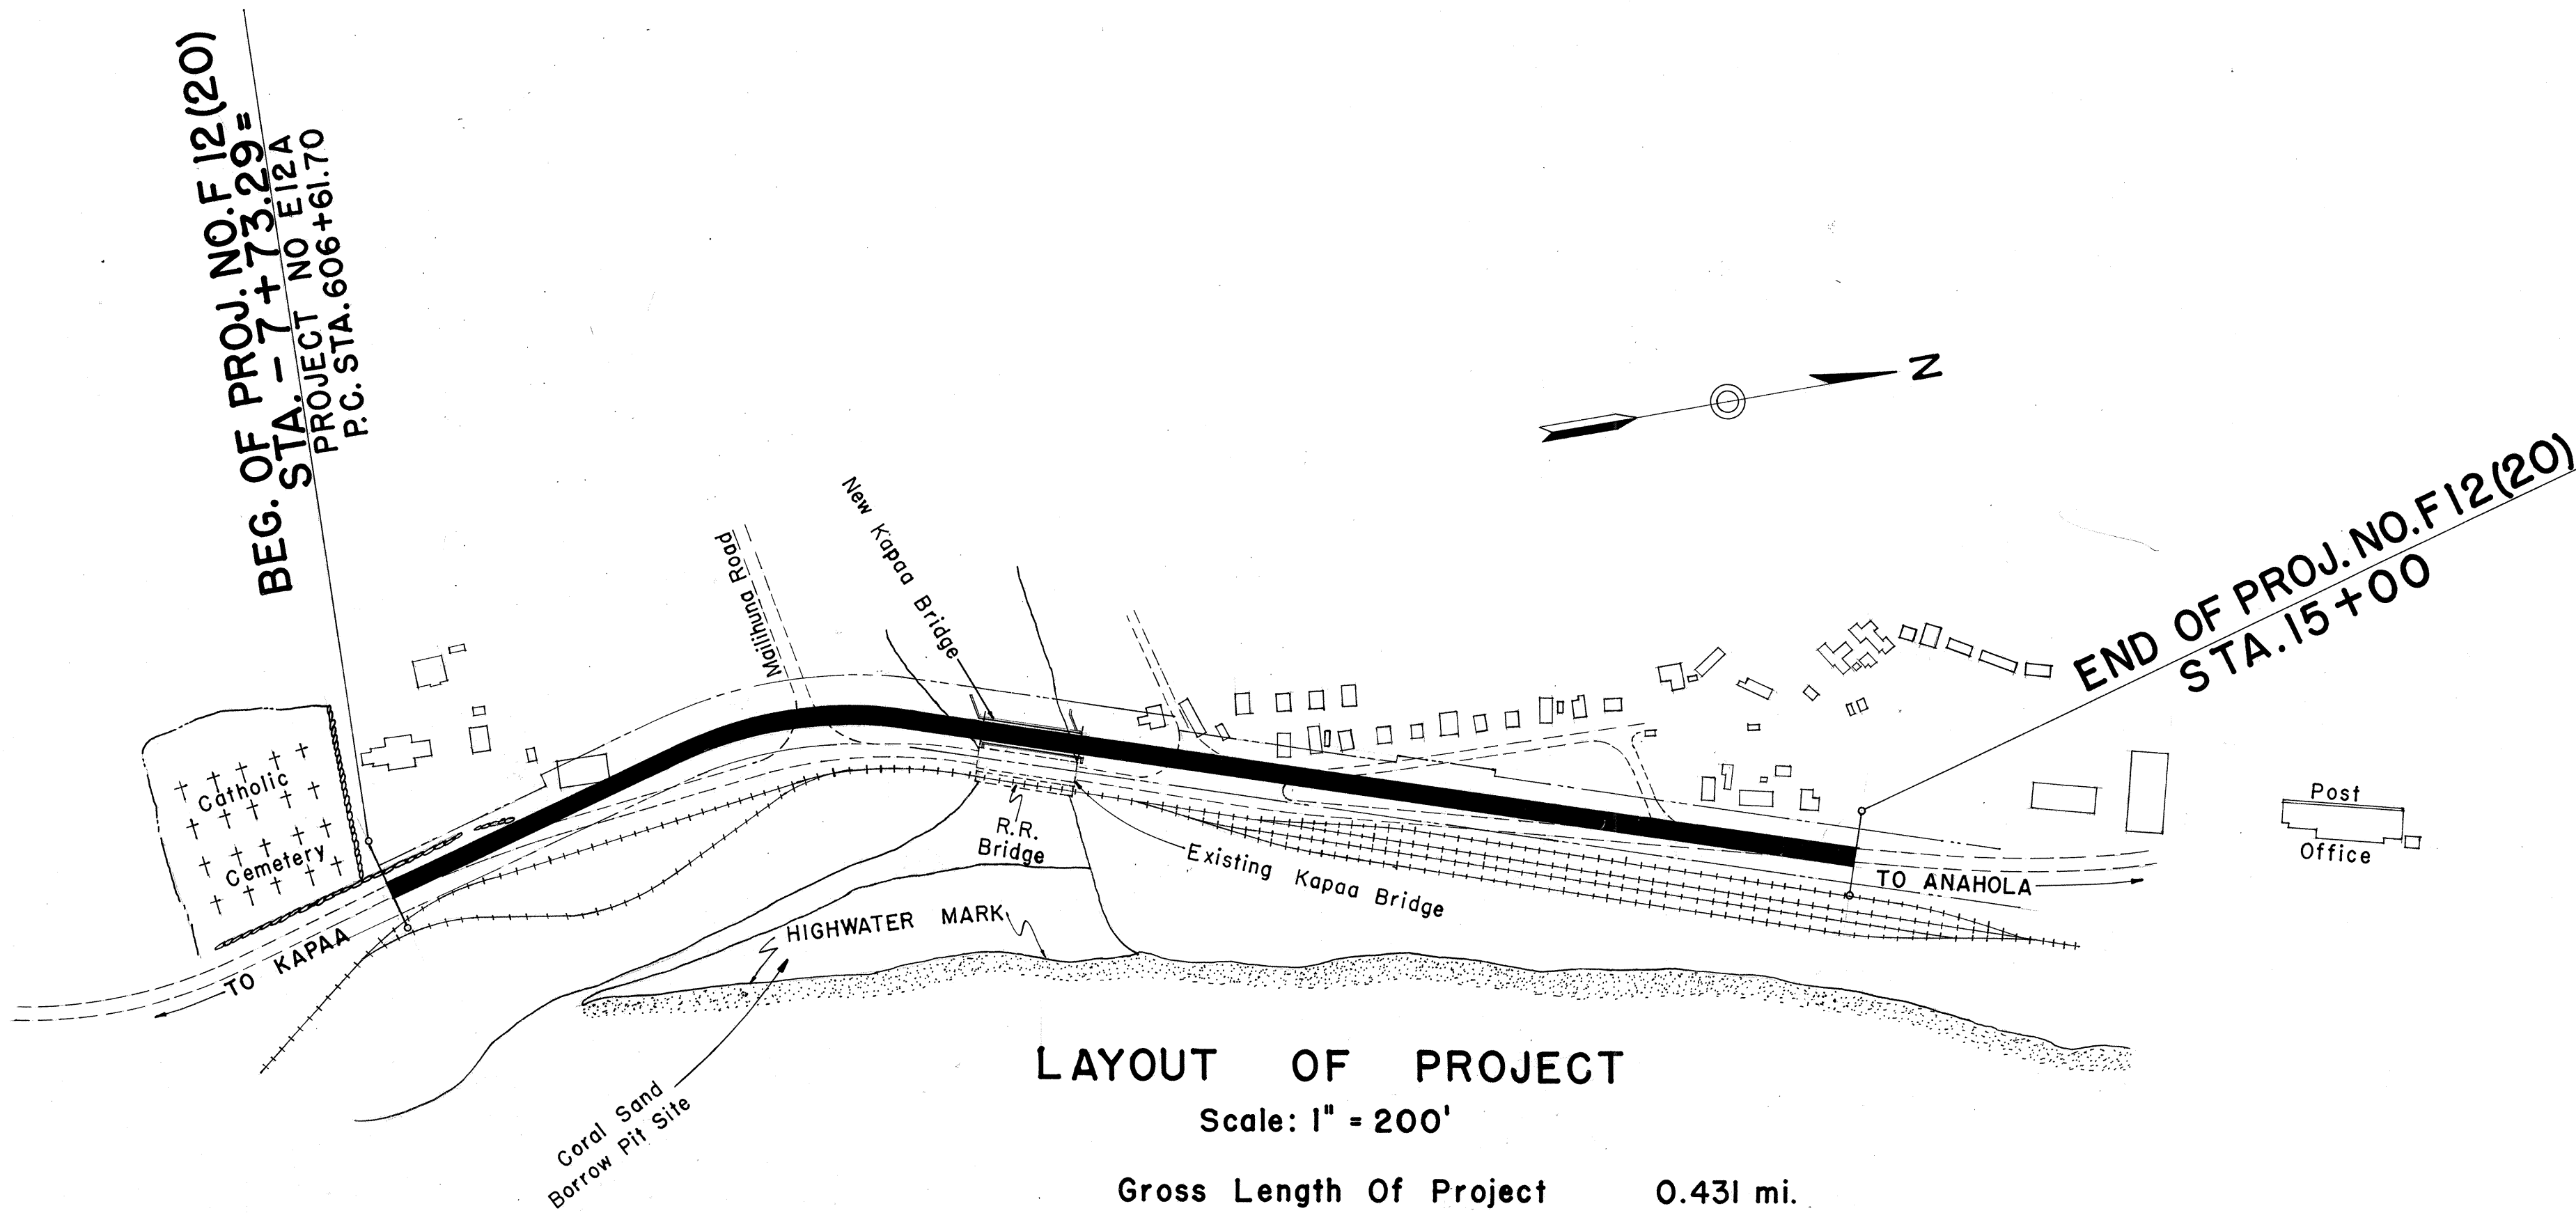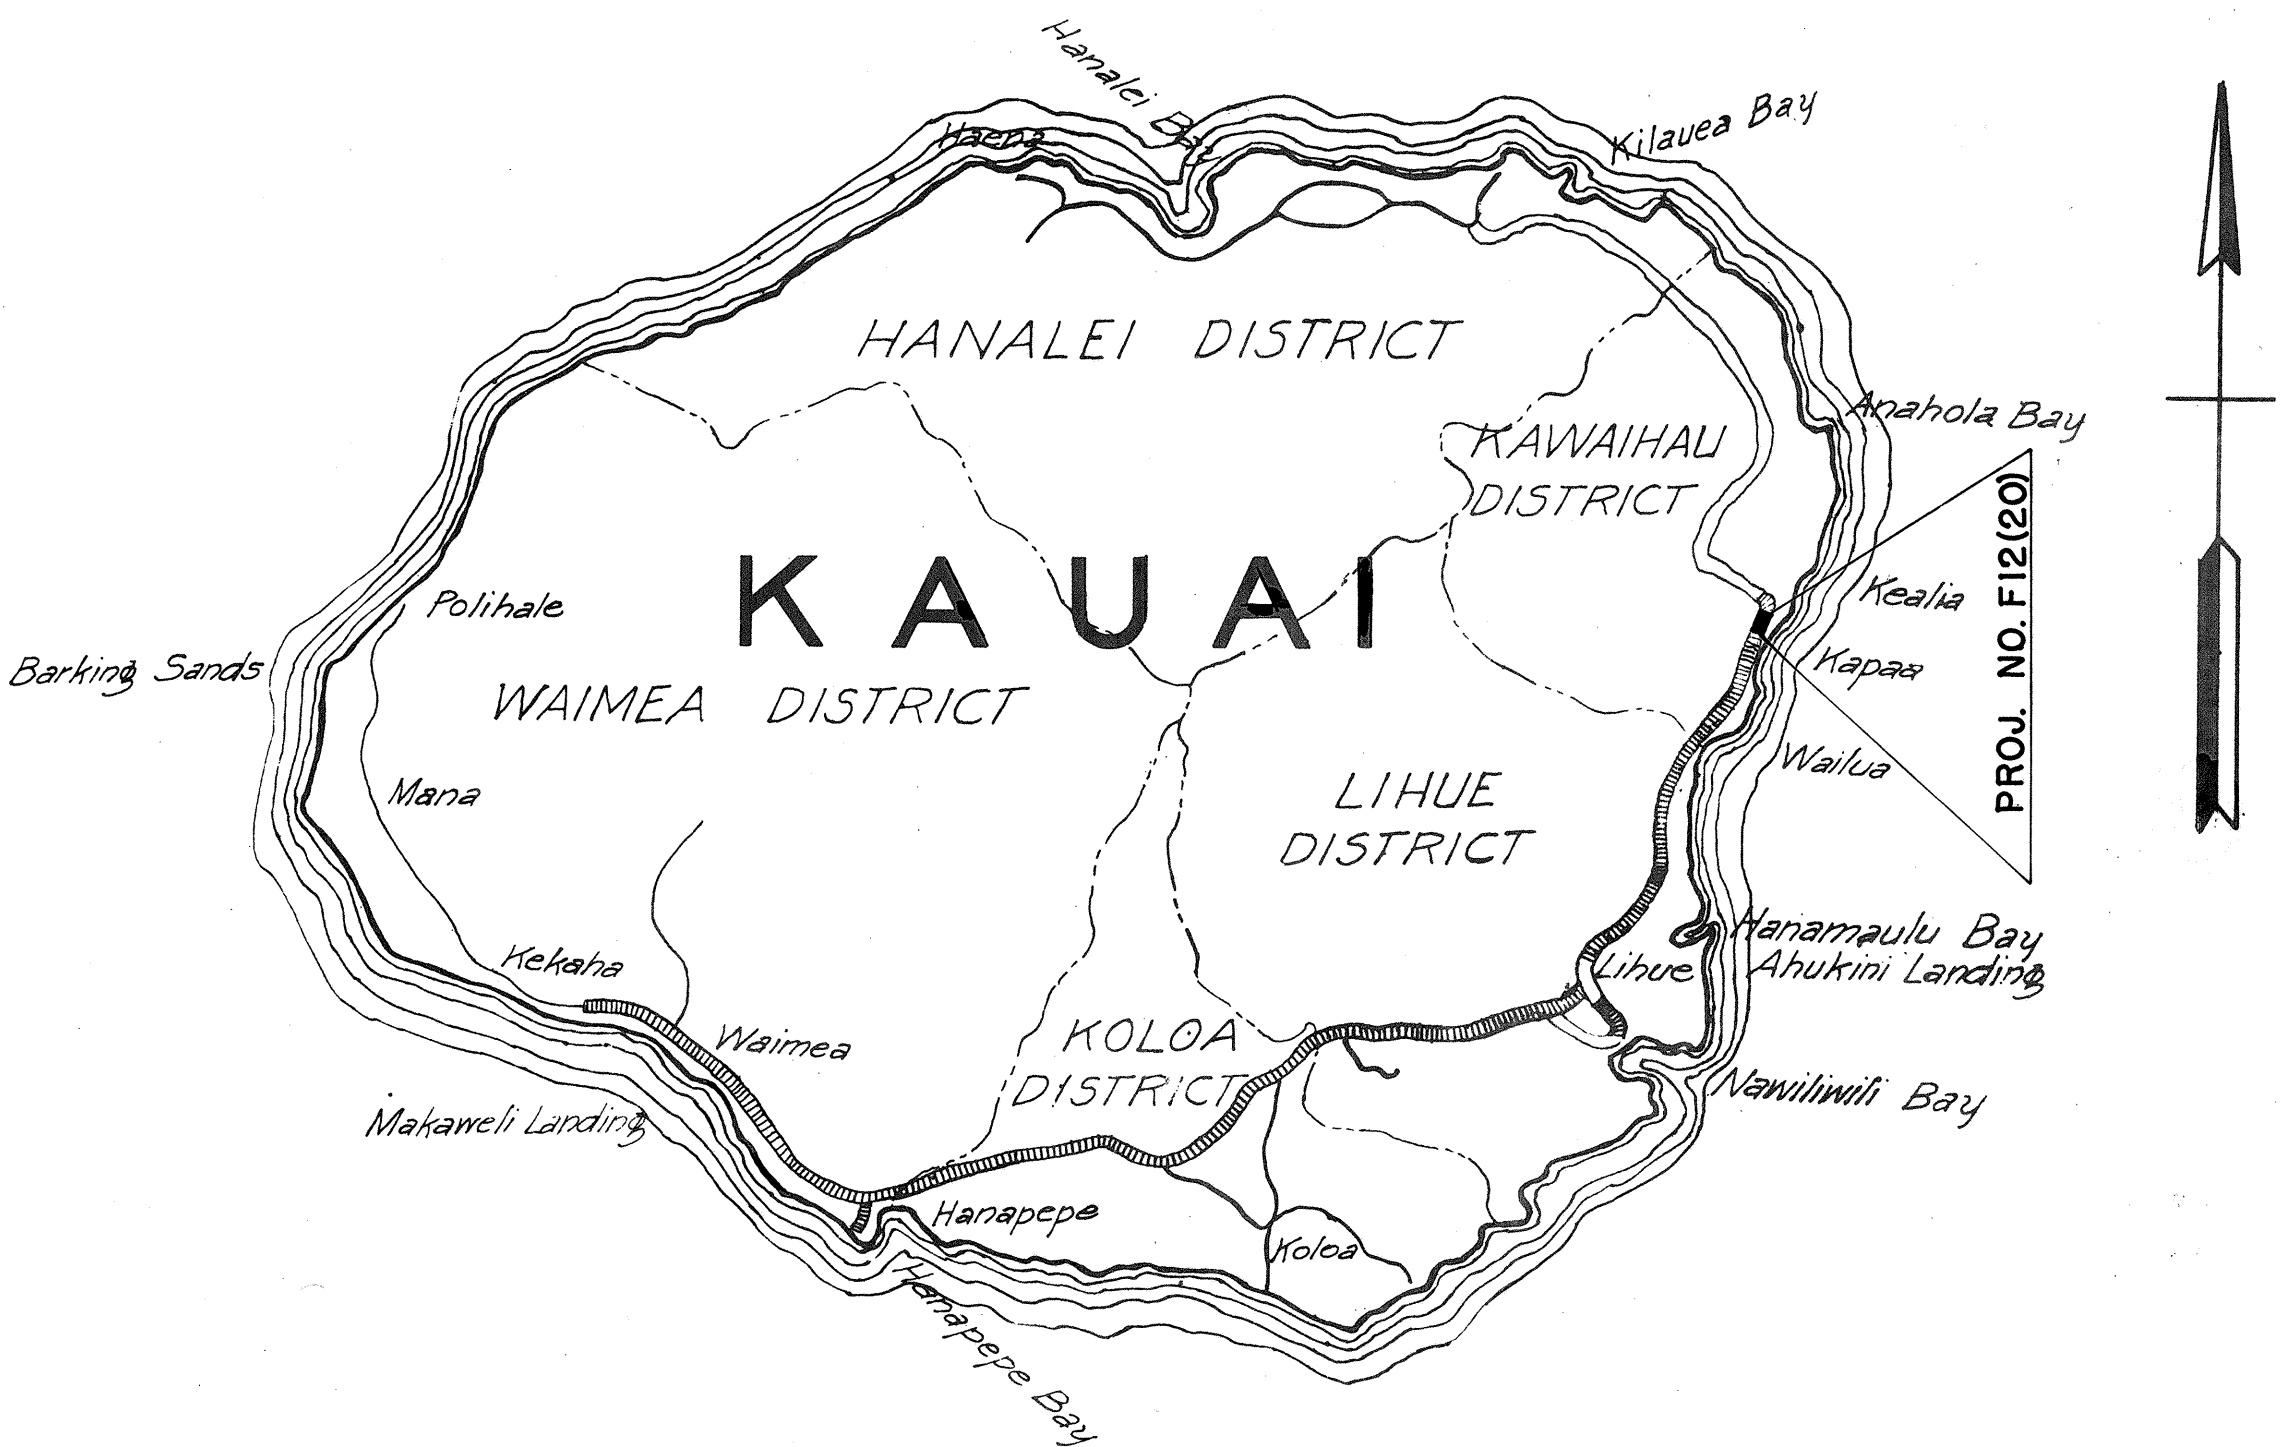

NOTE:

ALL CHANGES MADE DURING CONSTRUCTION

HAVE BEEN NOTED IN RED ON THESE TRACINGS

AND CHECKED BY:

John T. Schumacher

RESIDENT ENGINEER

March 9, 1951

DATE

LAYOUT OF PROJECT

Scale: 1" = 200'

Gross Length Of Project	0.431 mi.
Bridges Over 20 ft. Span	0.029 mi.
Net Length Of Roadway	0.402 mi.

APPROVED: *John T. Schumacher*

DATE: 10-5-51

TERRITORIAL HIGHWAY ENGINEER

DEPARTMENT OF COMMERCE

BUREAU OF PUBLIC ROADS

RECOMMENDED FOR APPROVAL:

DISTRICT ENGINEER

DATE

DIVISION ENGINEER

DATE