



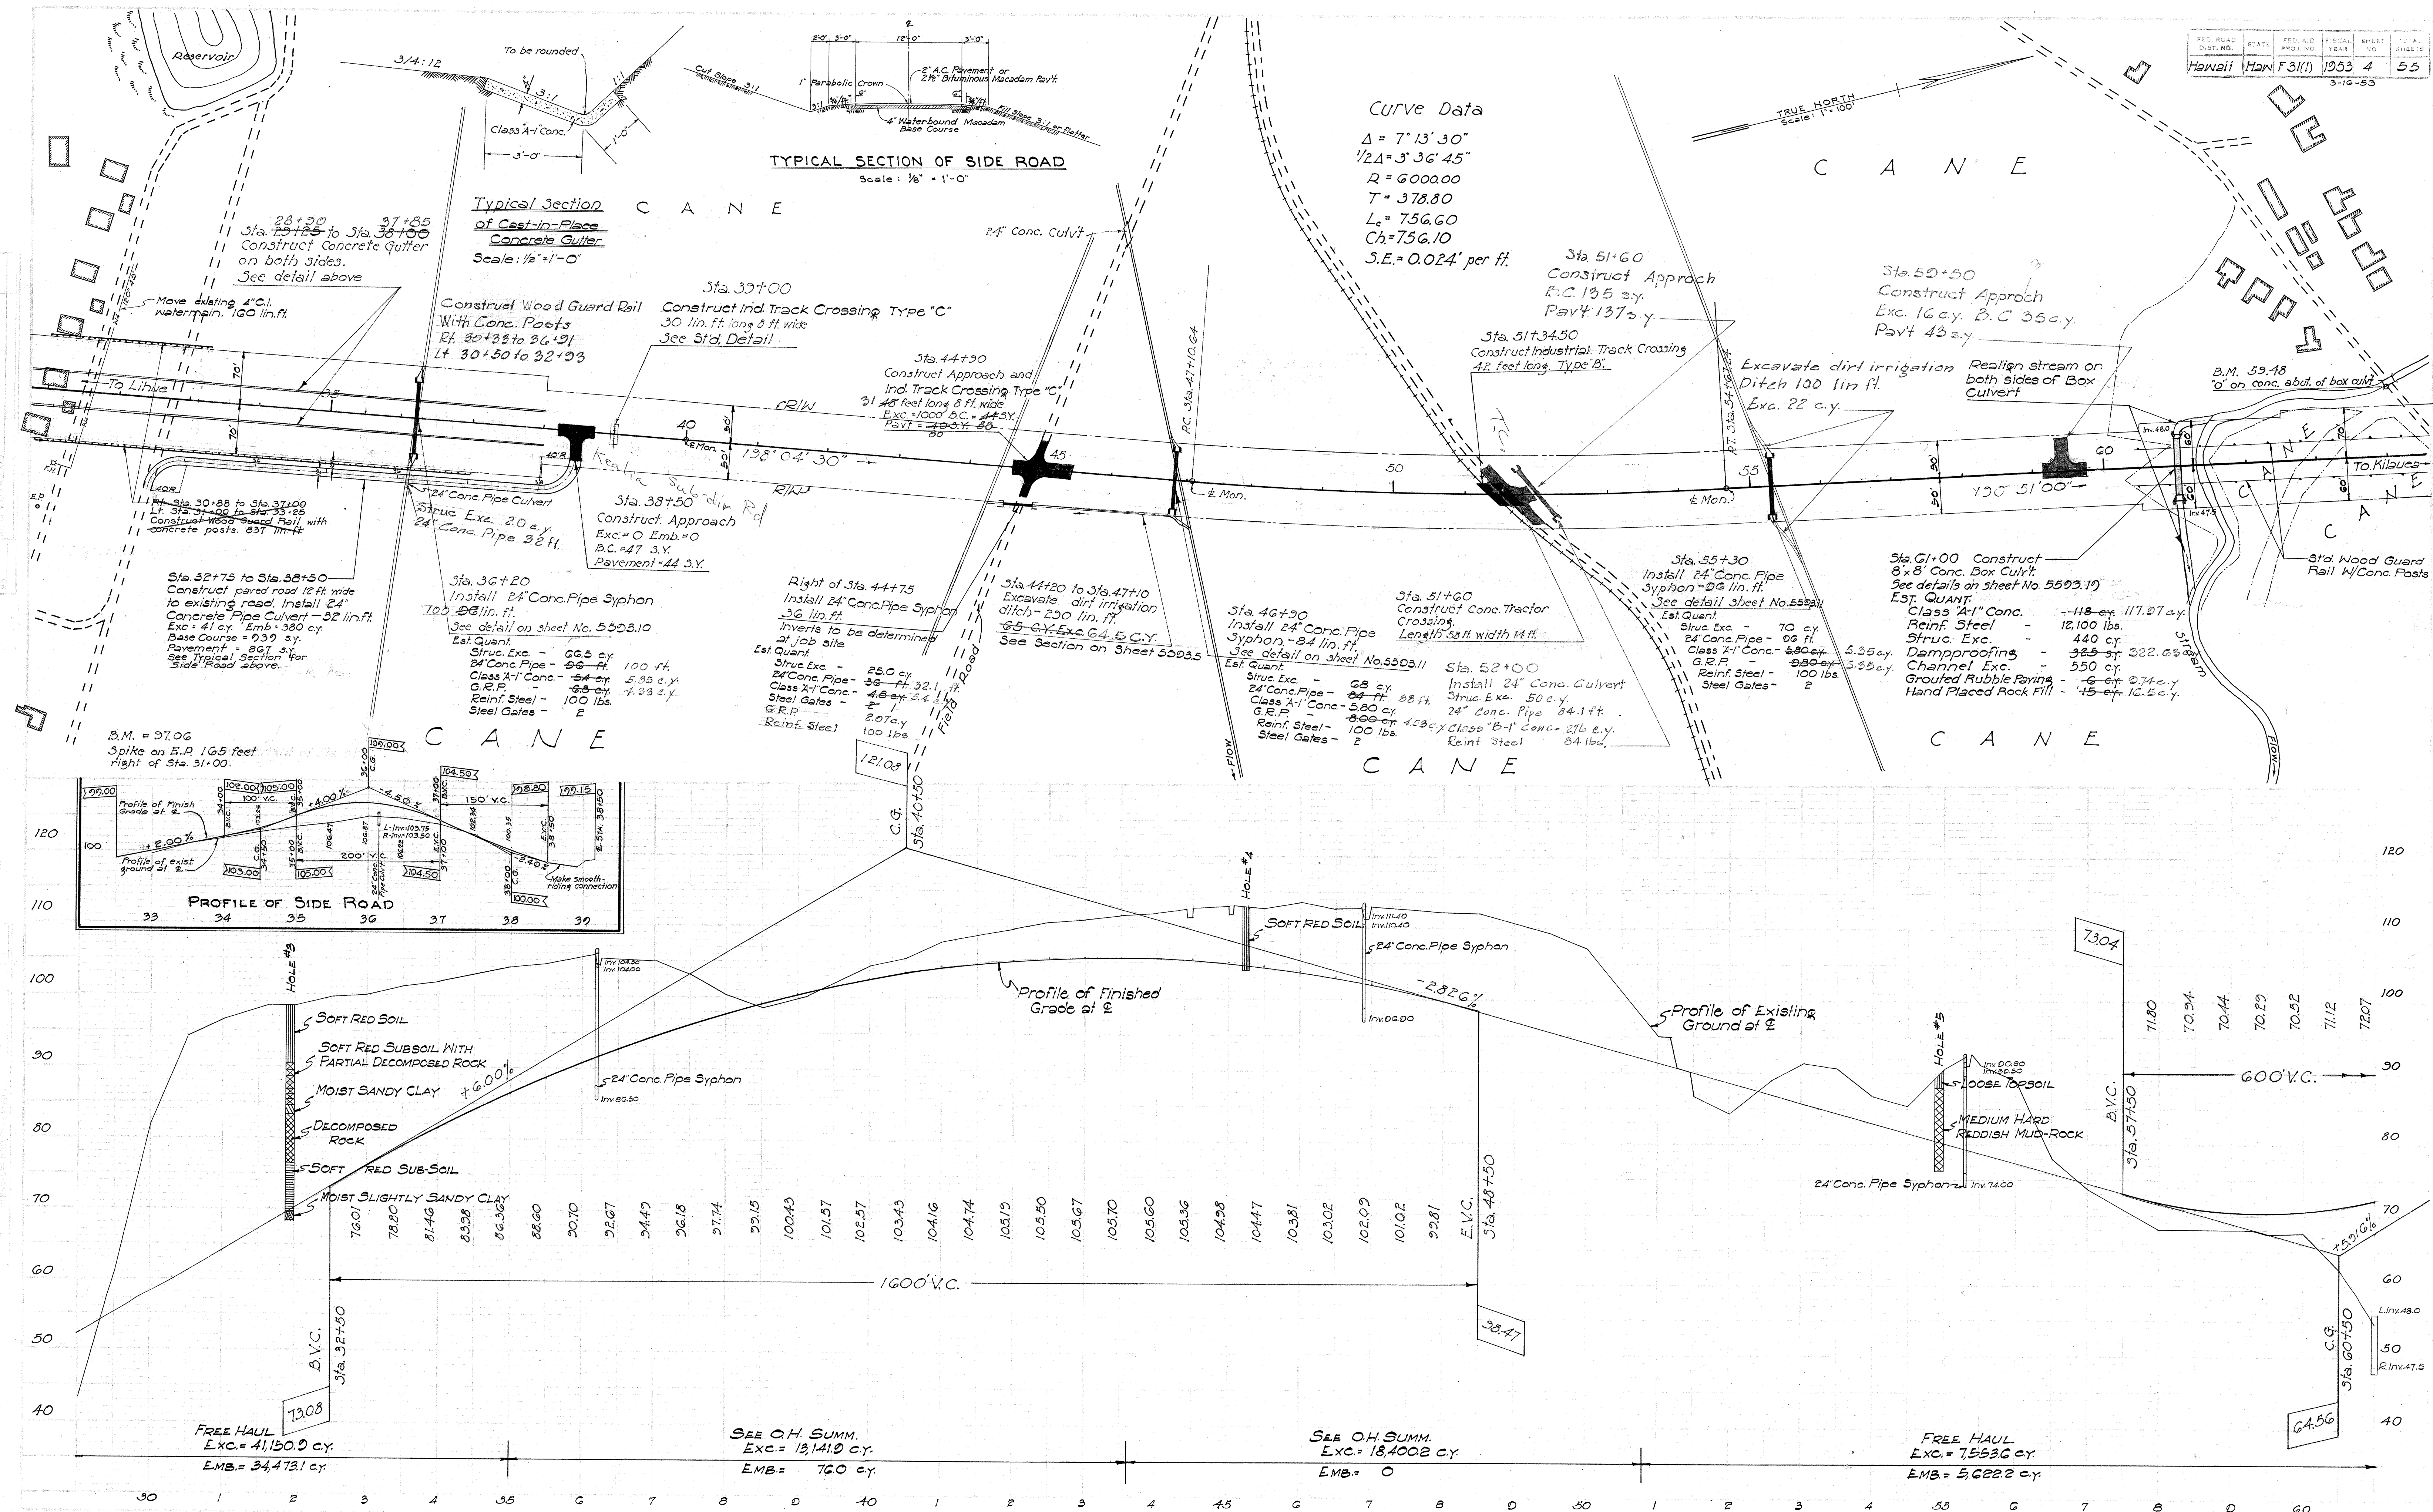
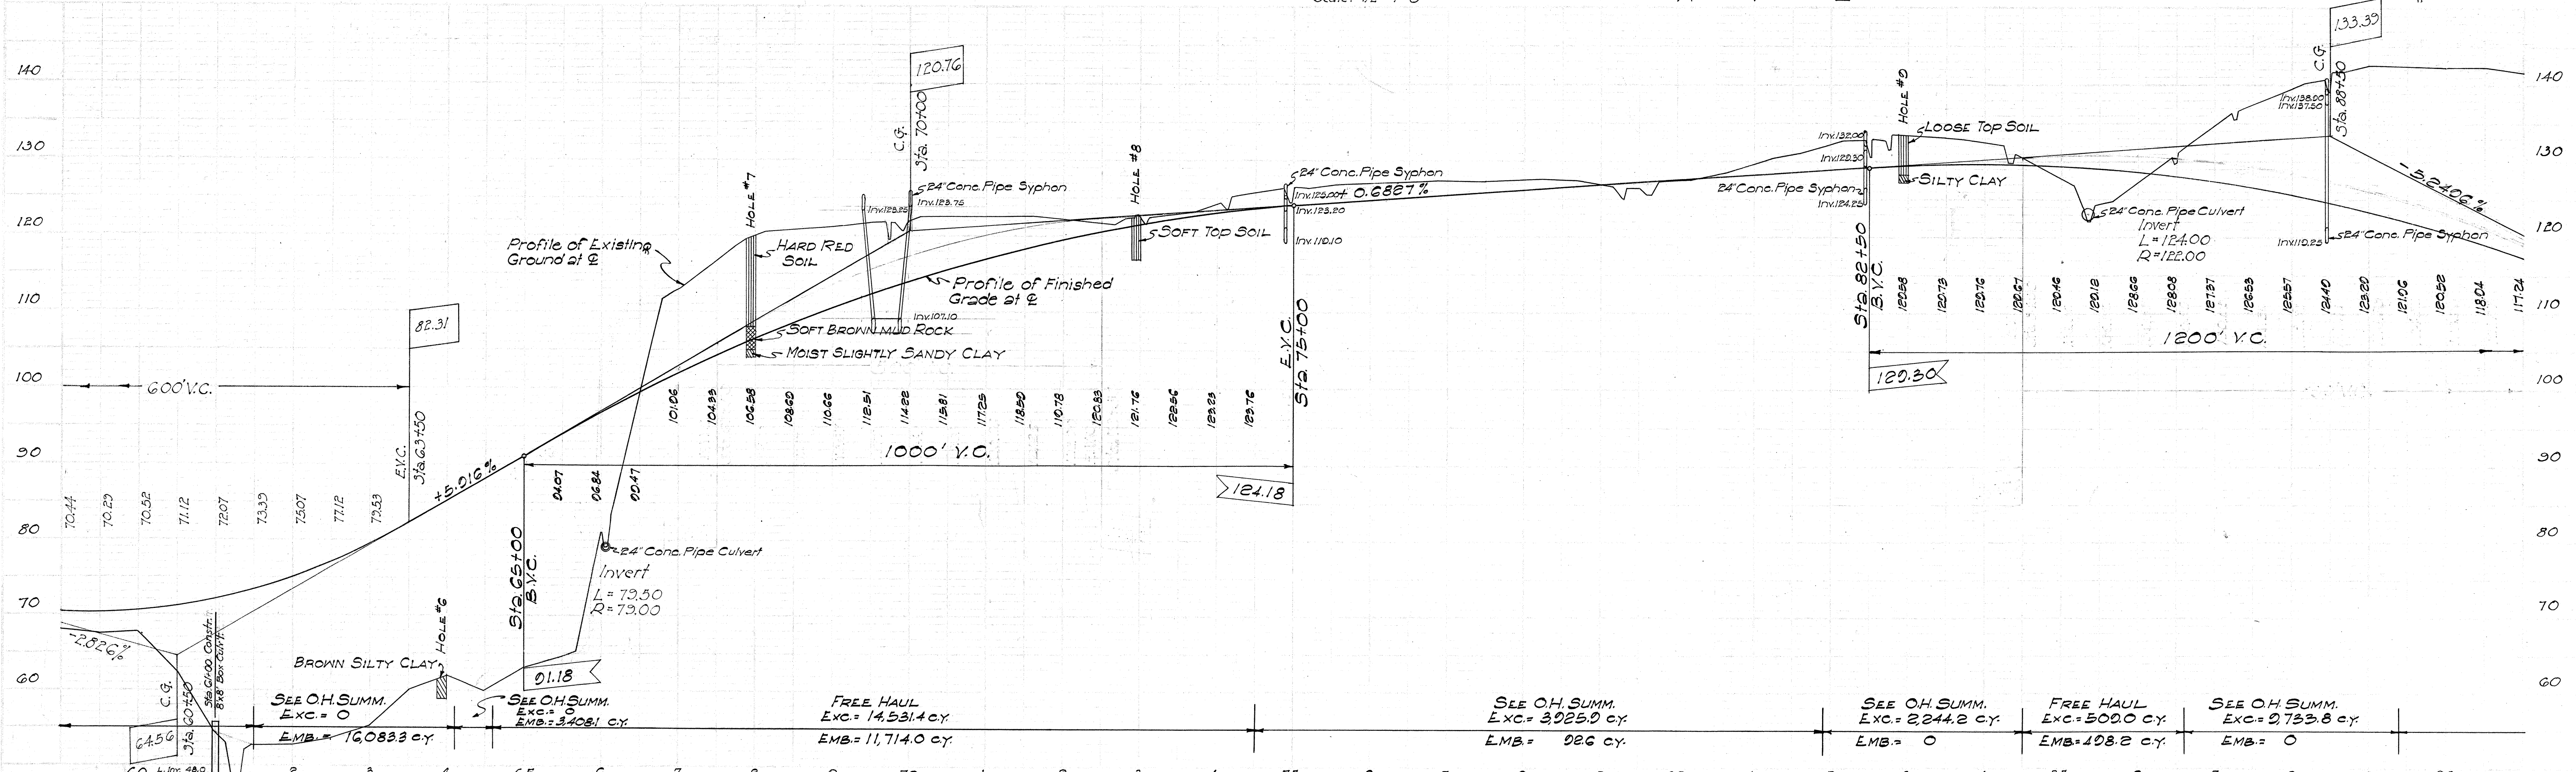
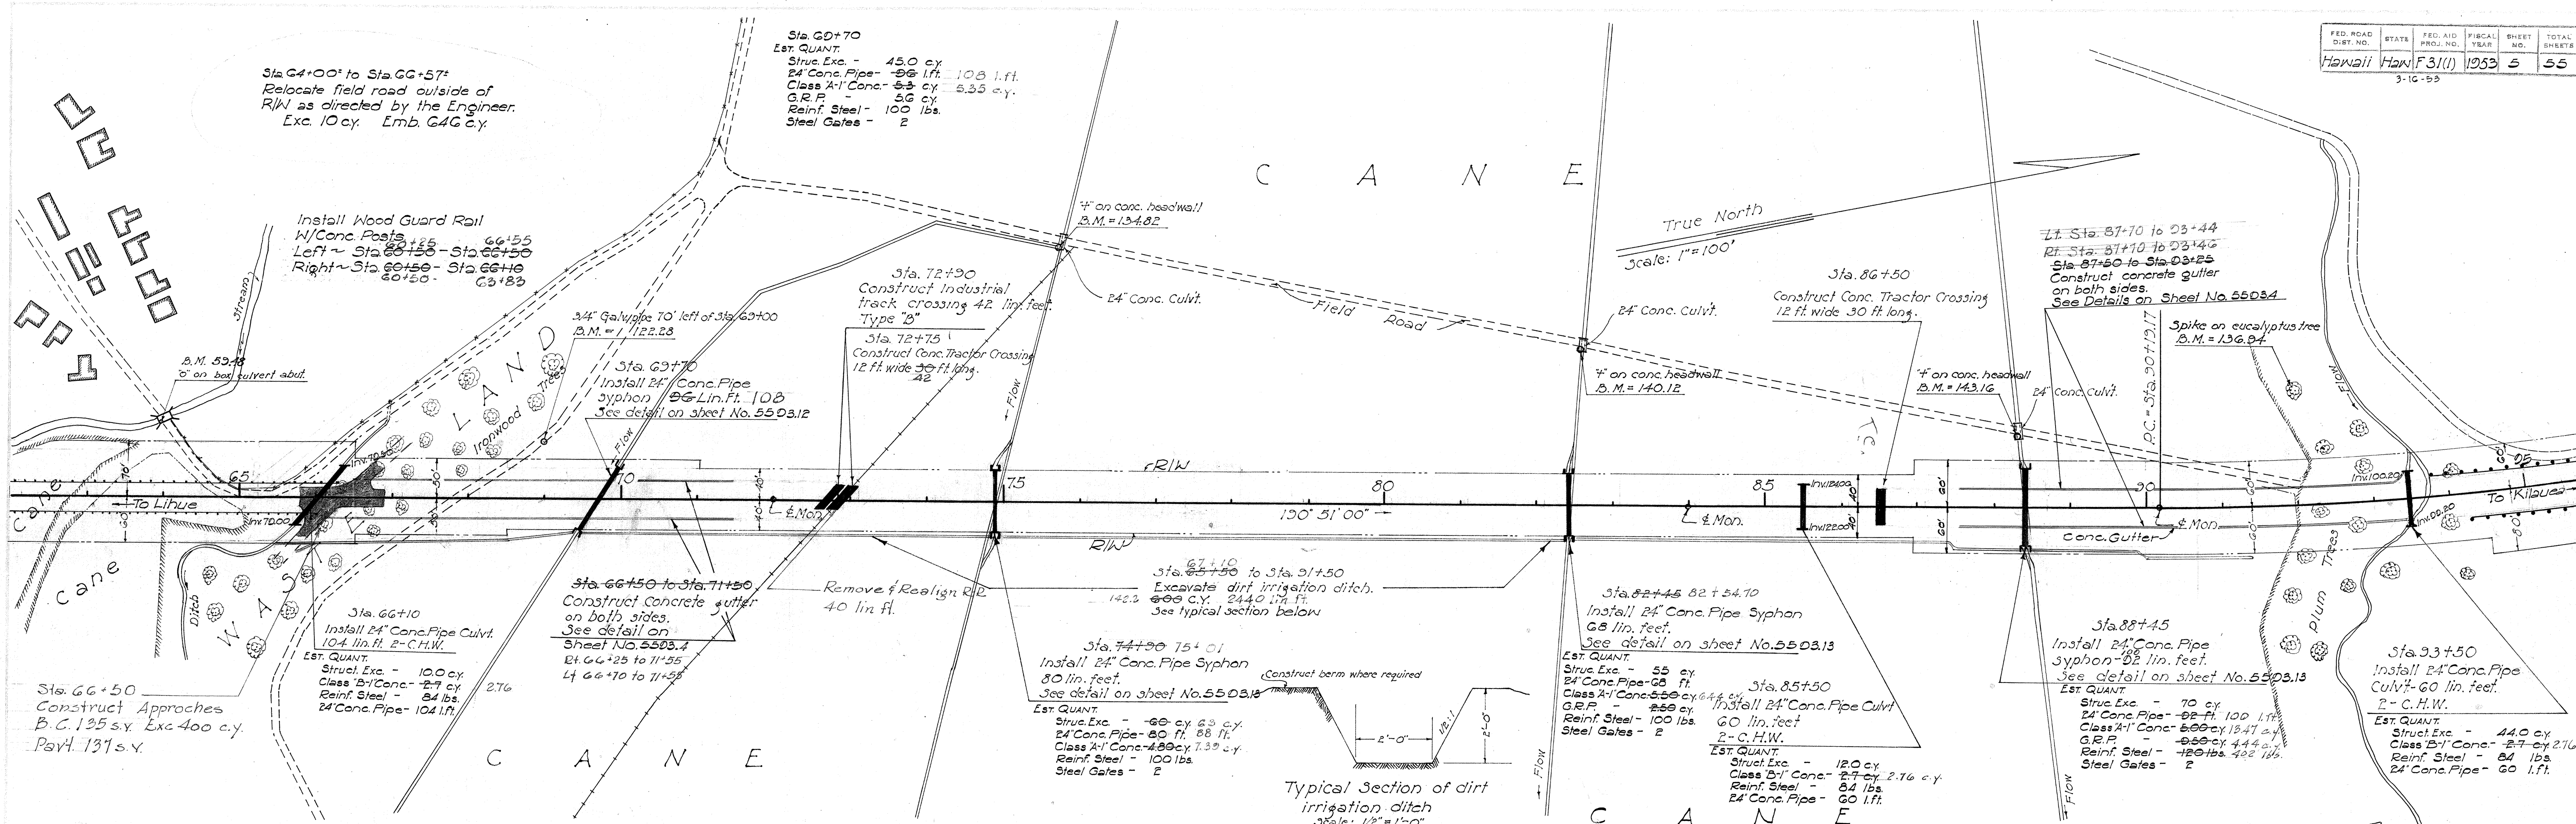


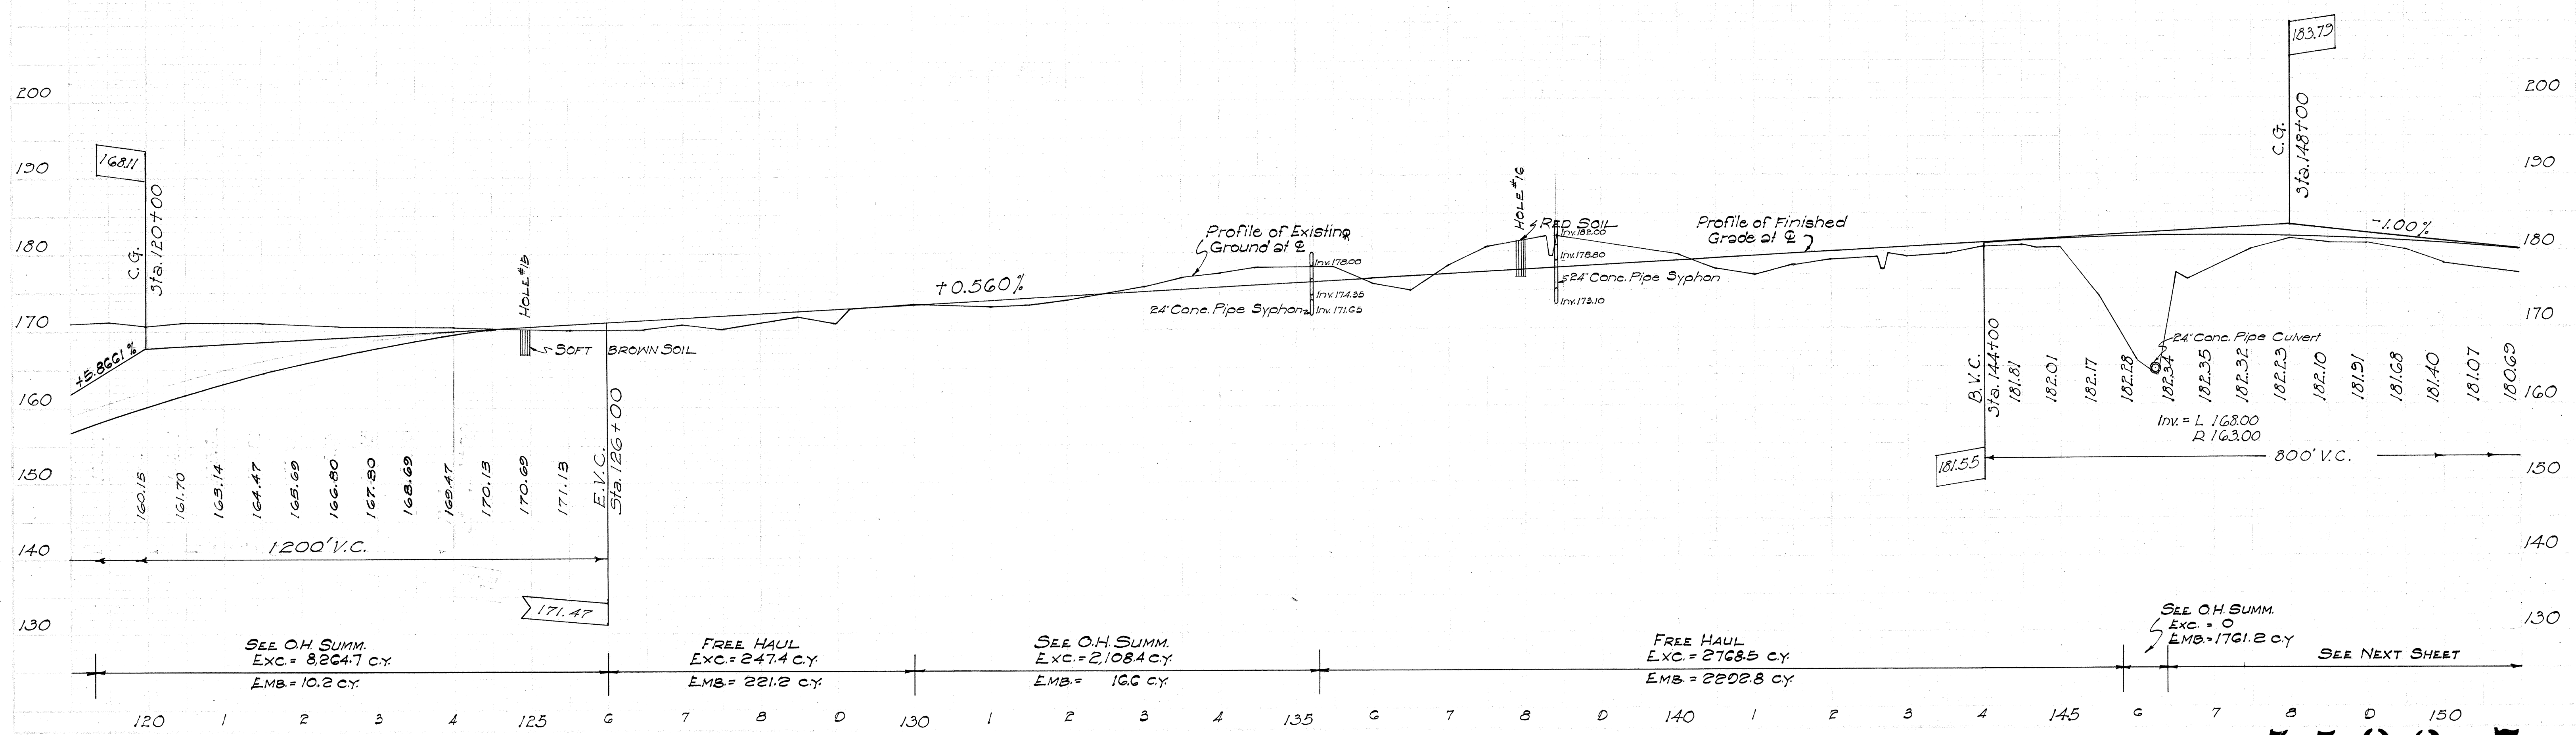

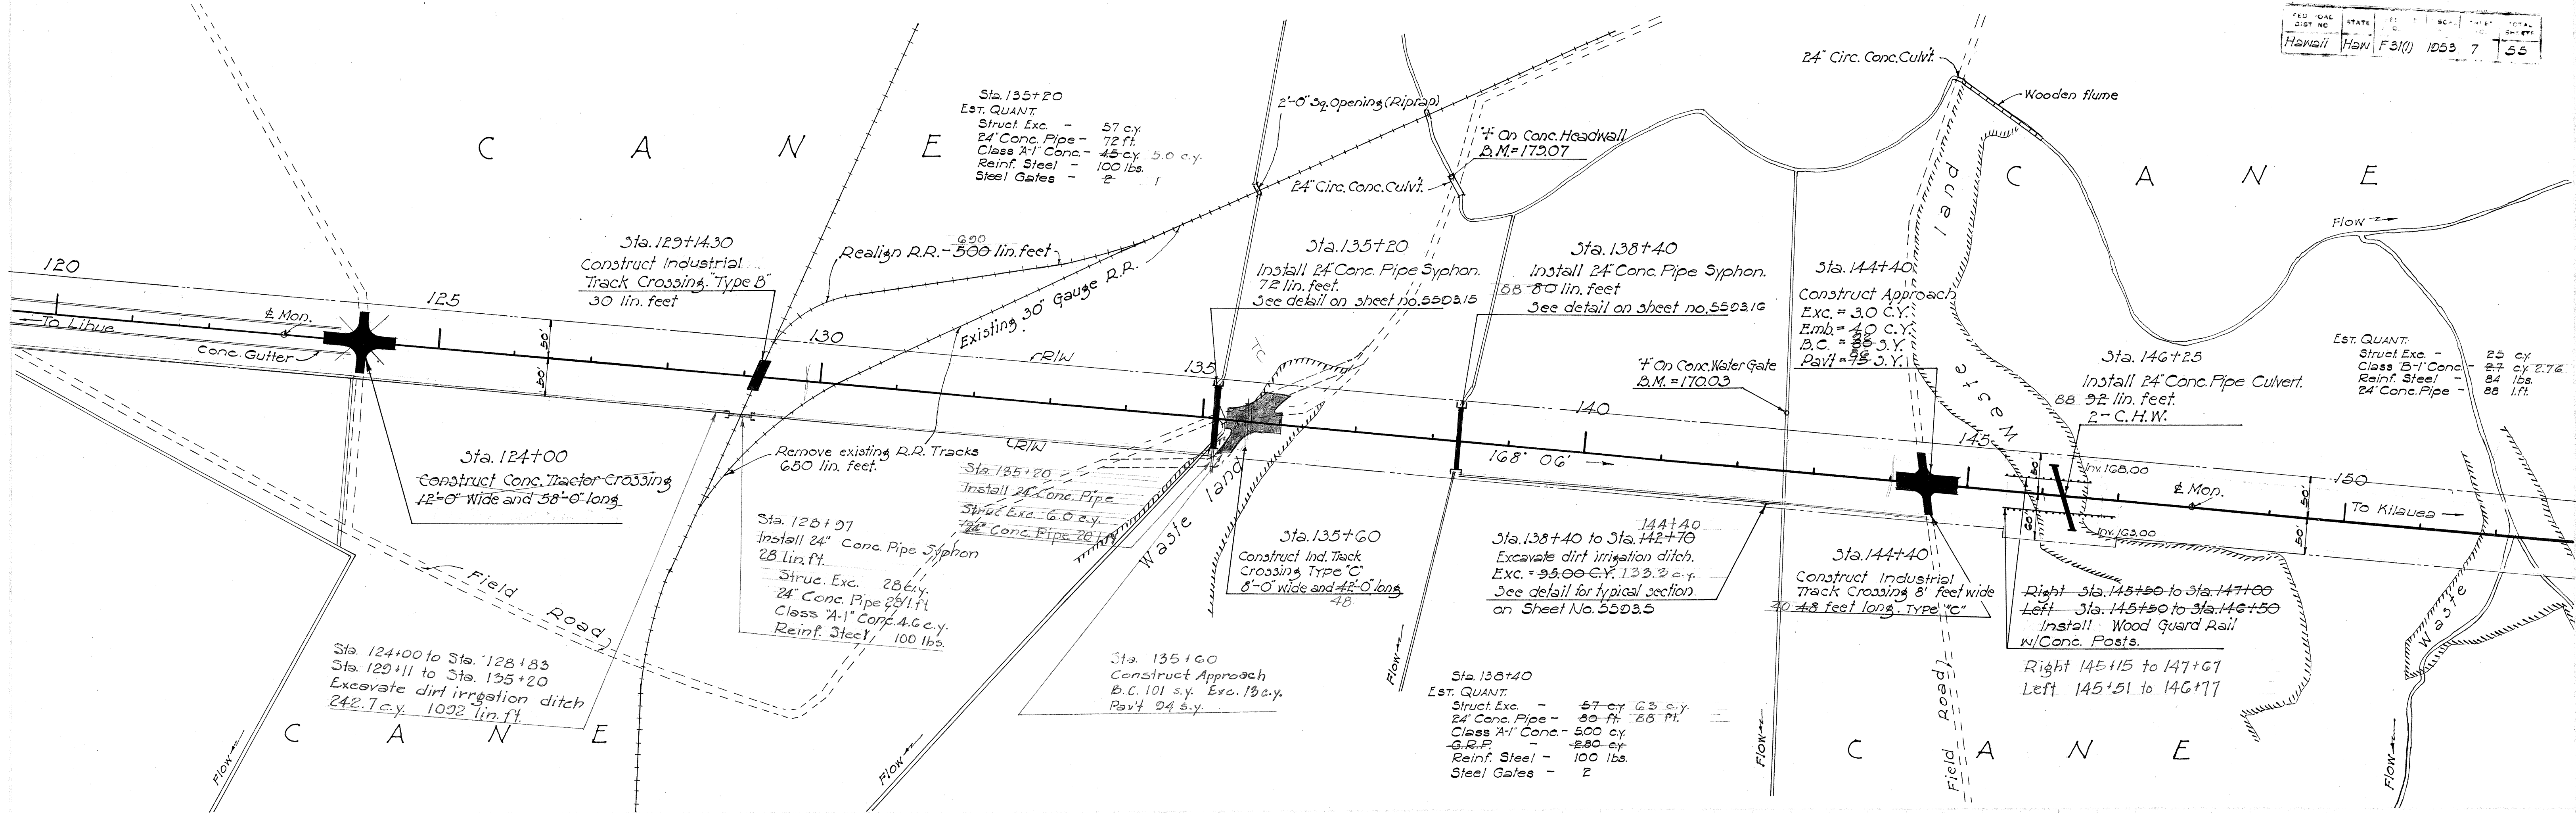



5593.6

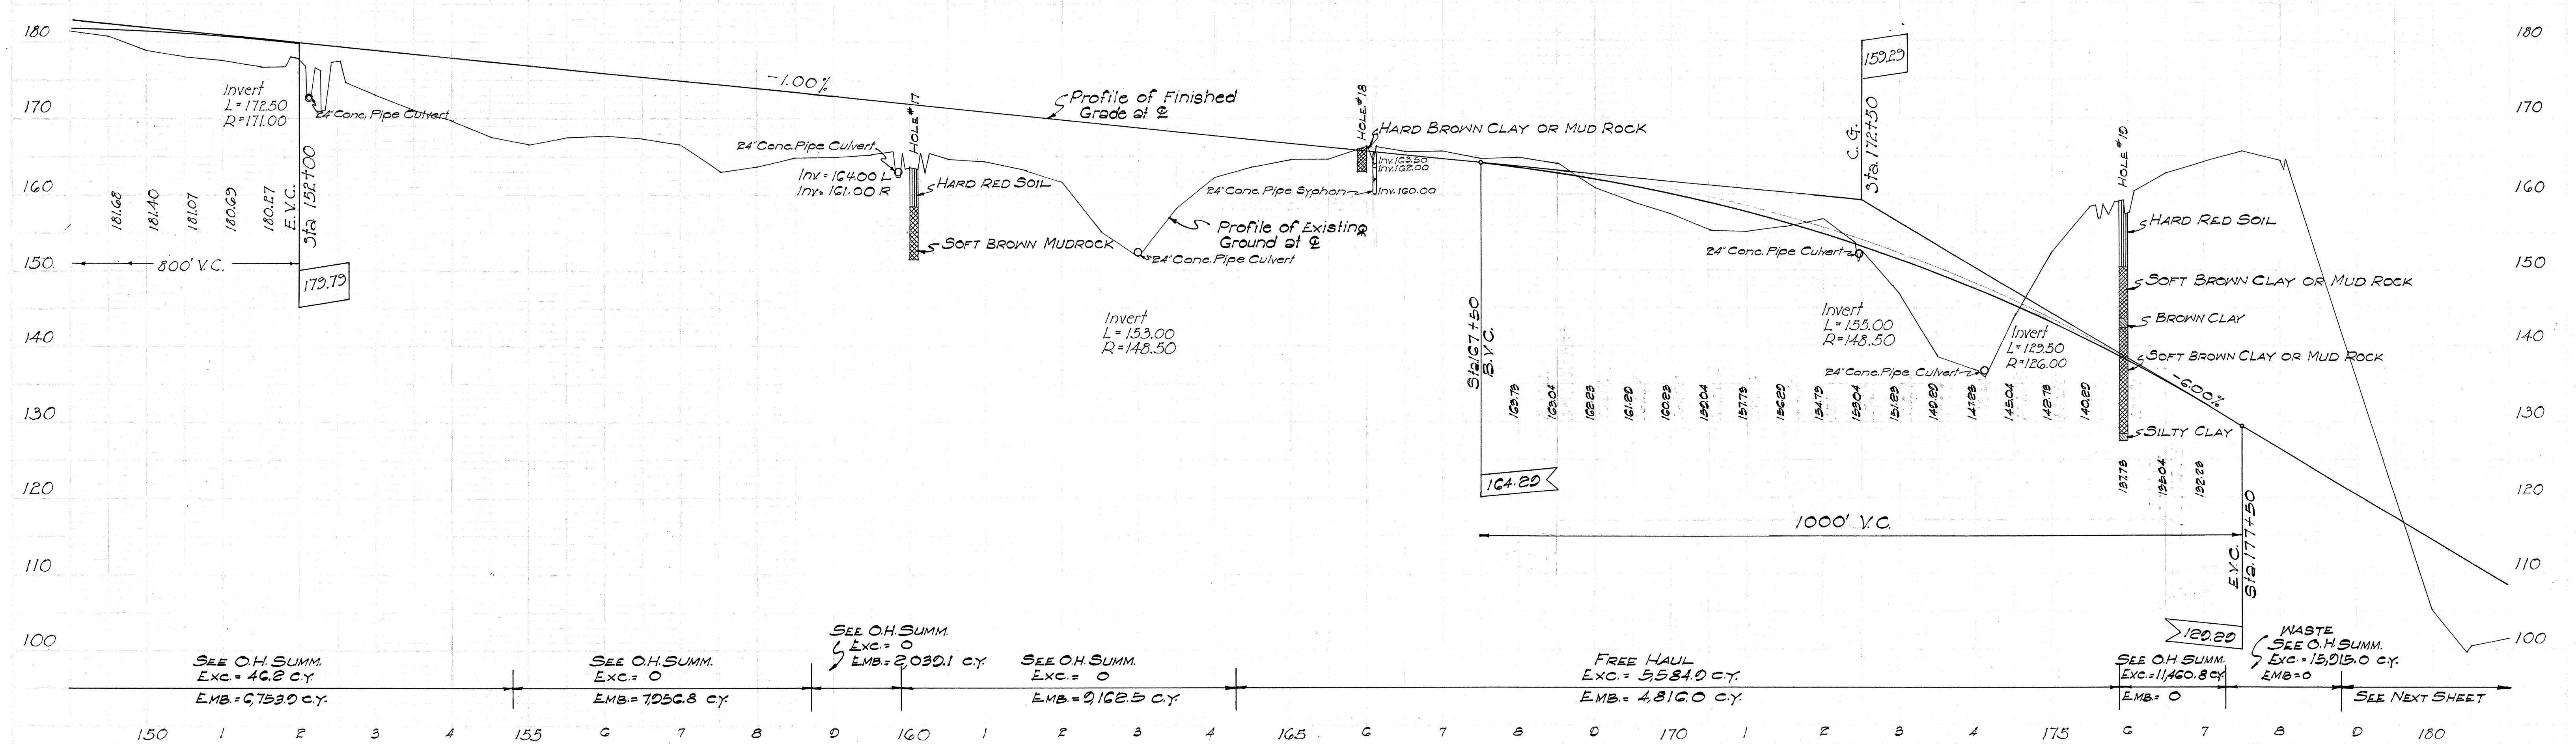

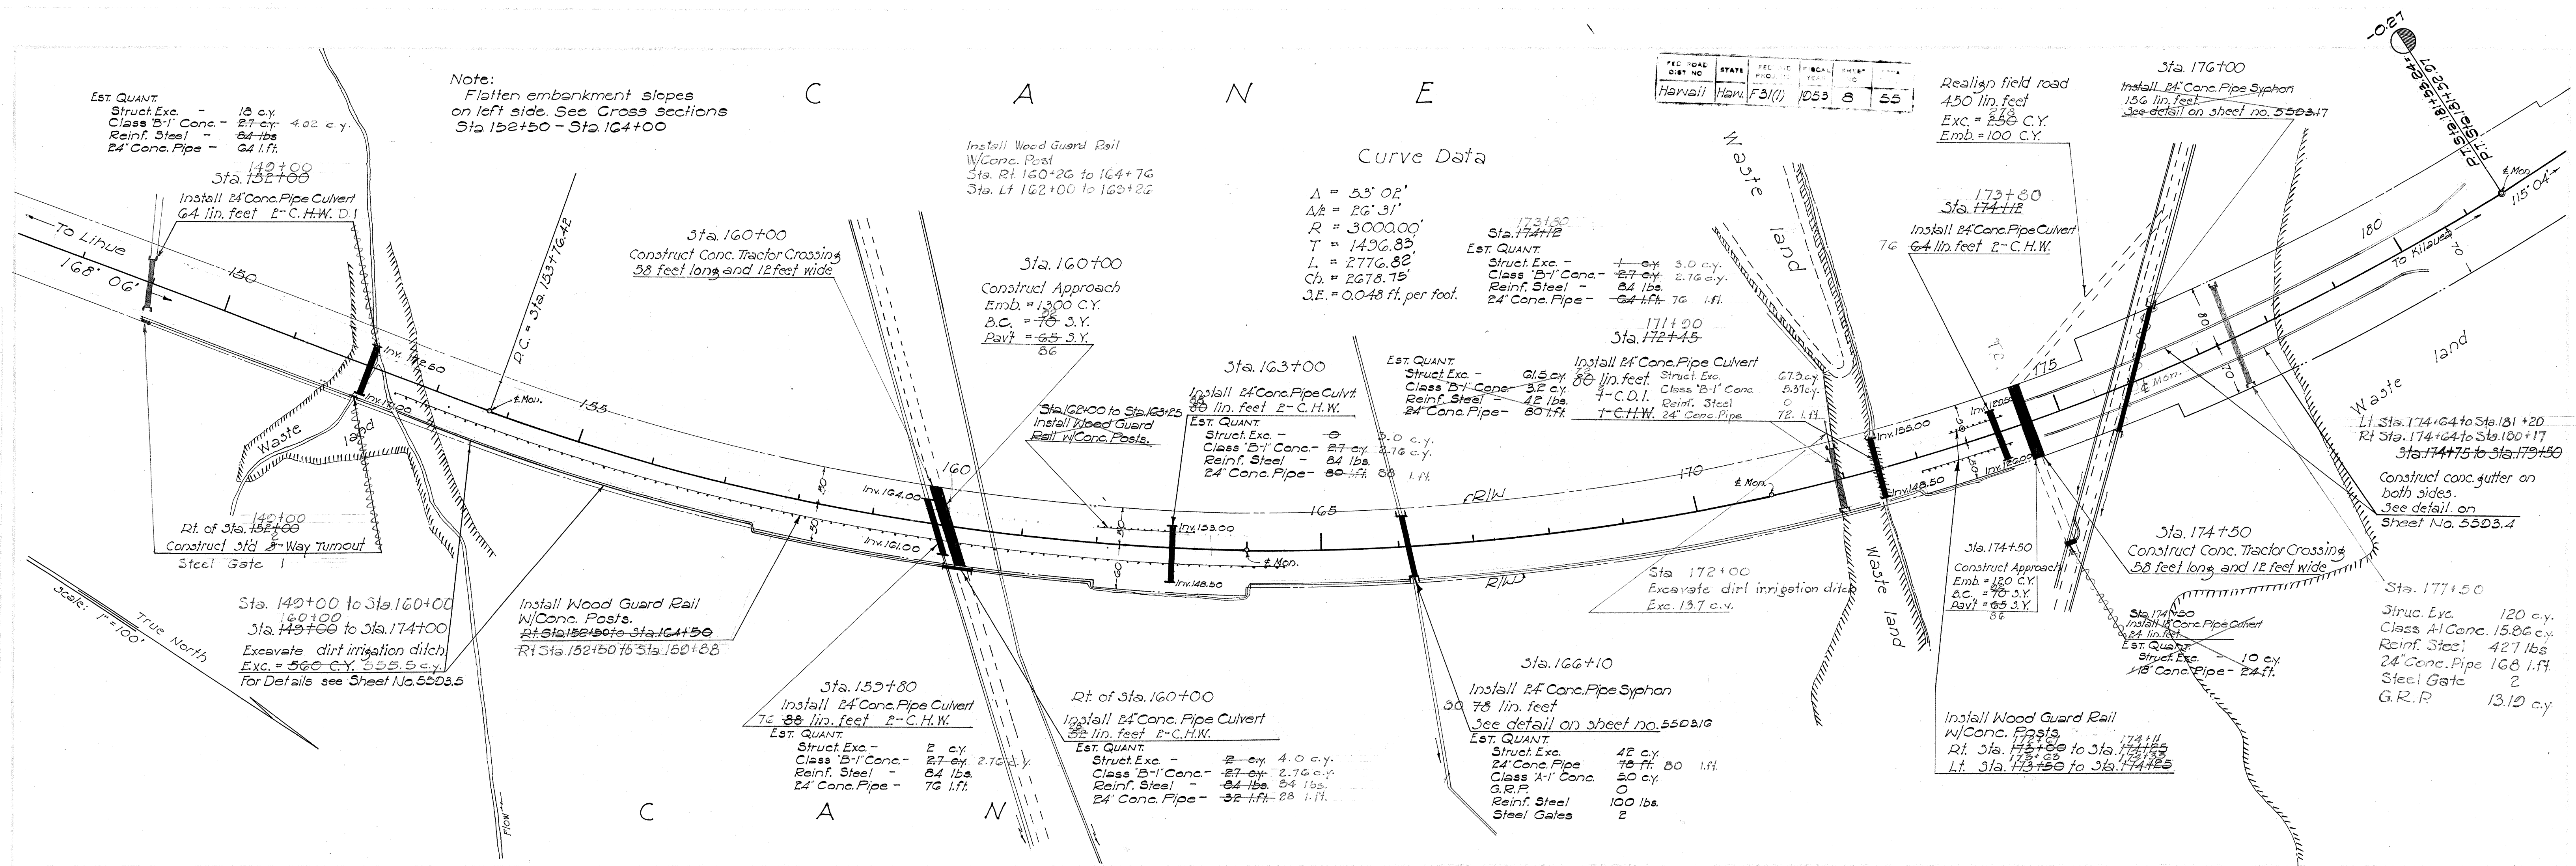

5593.8

FED. ROAD DIST. NO.	STATE	FED. AID PROJ. NO.	FISCAL YEAR	SHEET NO.	TOTAL SHEETS
HAWAII	HAWAII	F31(1)	1953	0	55

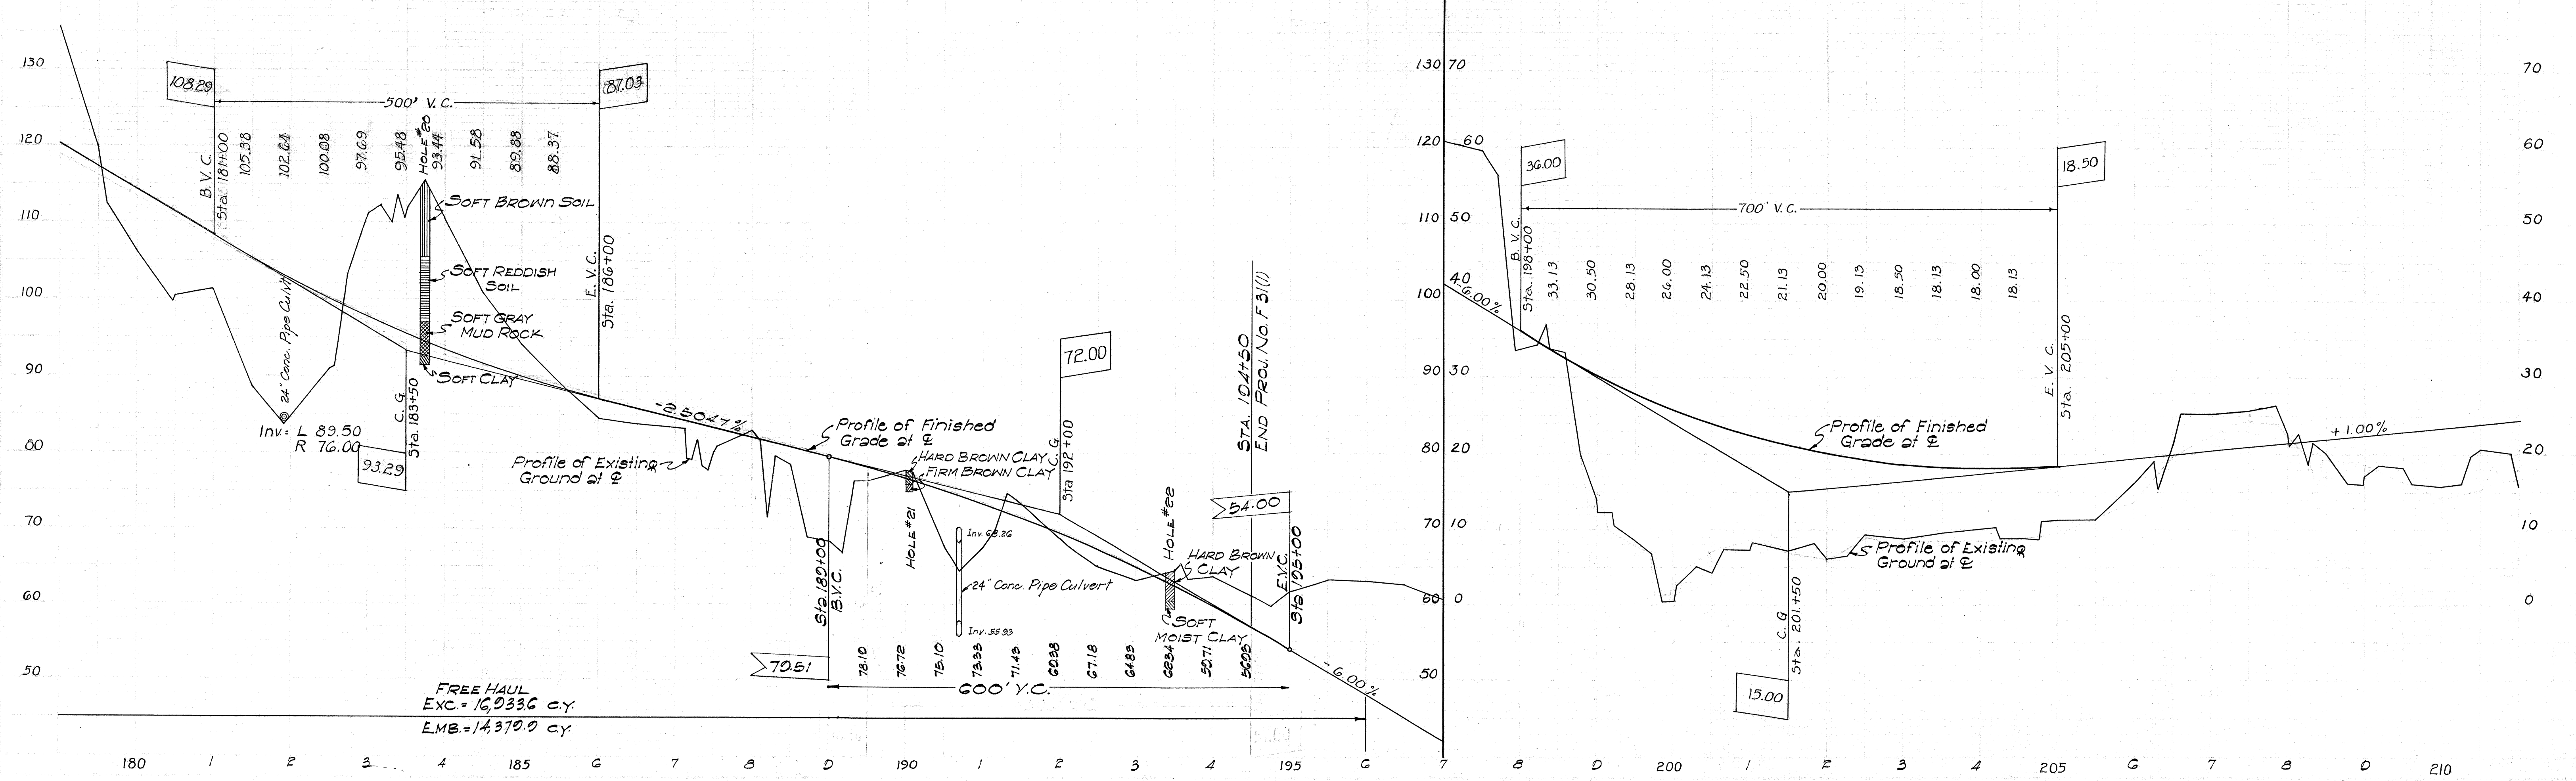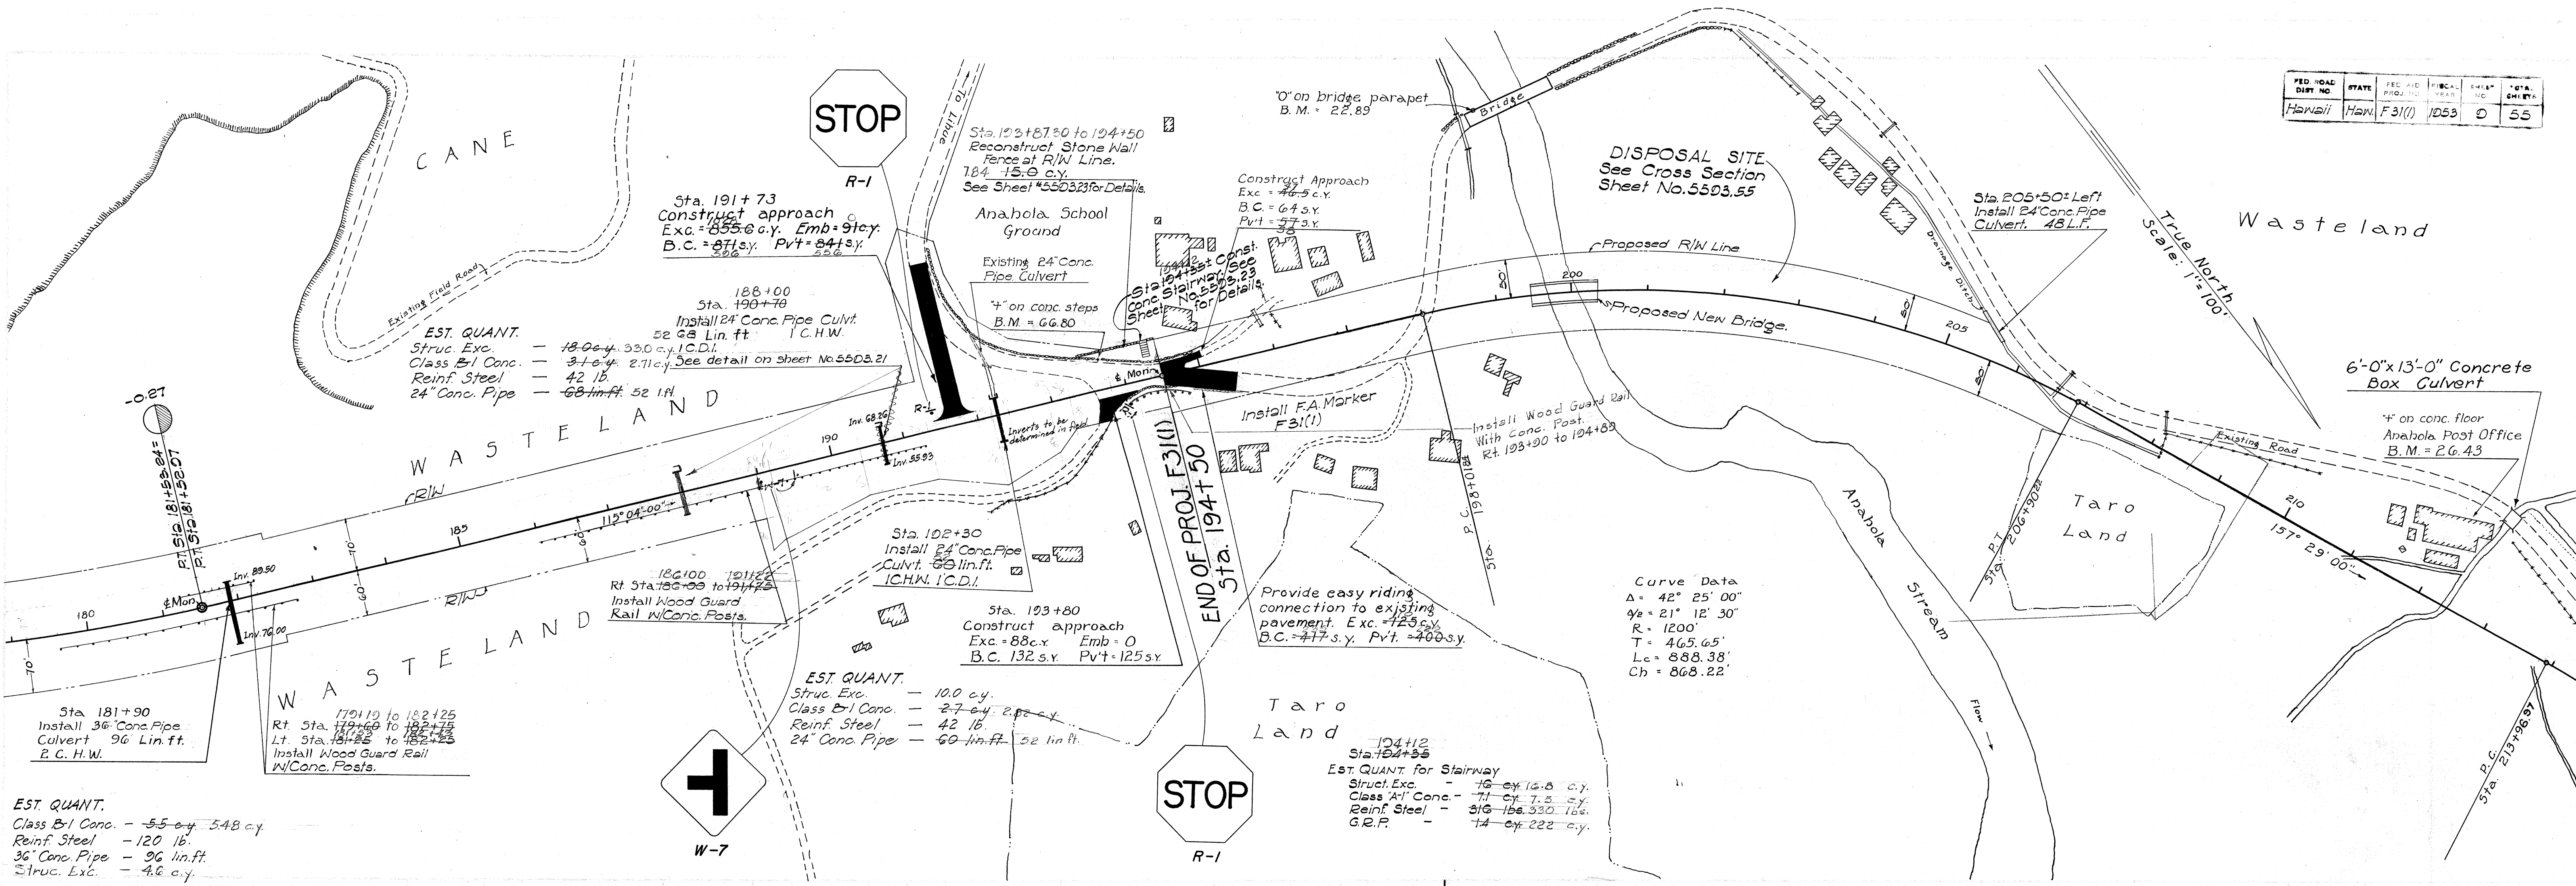

5593.9