




| FED. ROAD DIST. NO. | STATE | FED. AID PROJ. NO. | FISCAL YEAR | SHEET NO. | TOTAL SHEETS |
|---------------------|-------|--------------------|-------------|-----------|--------------|
| HAWAII              | HAW.  | F31(1)             | 1953        | 23        | 55           |

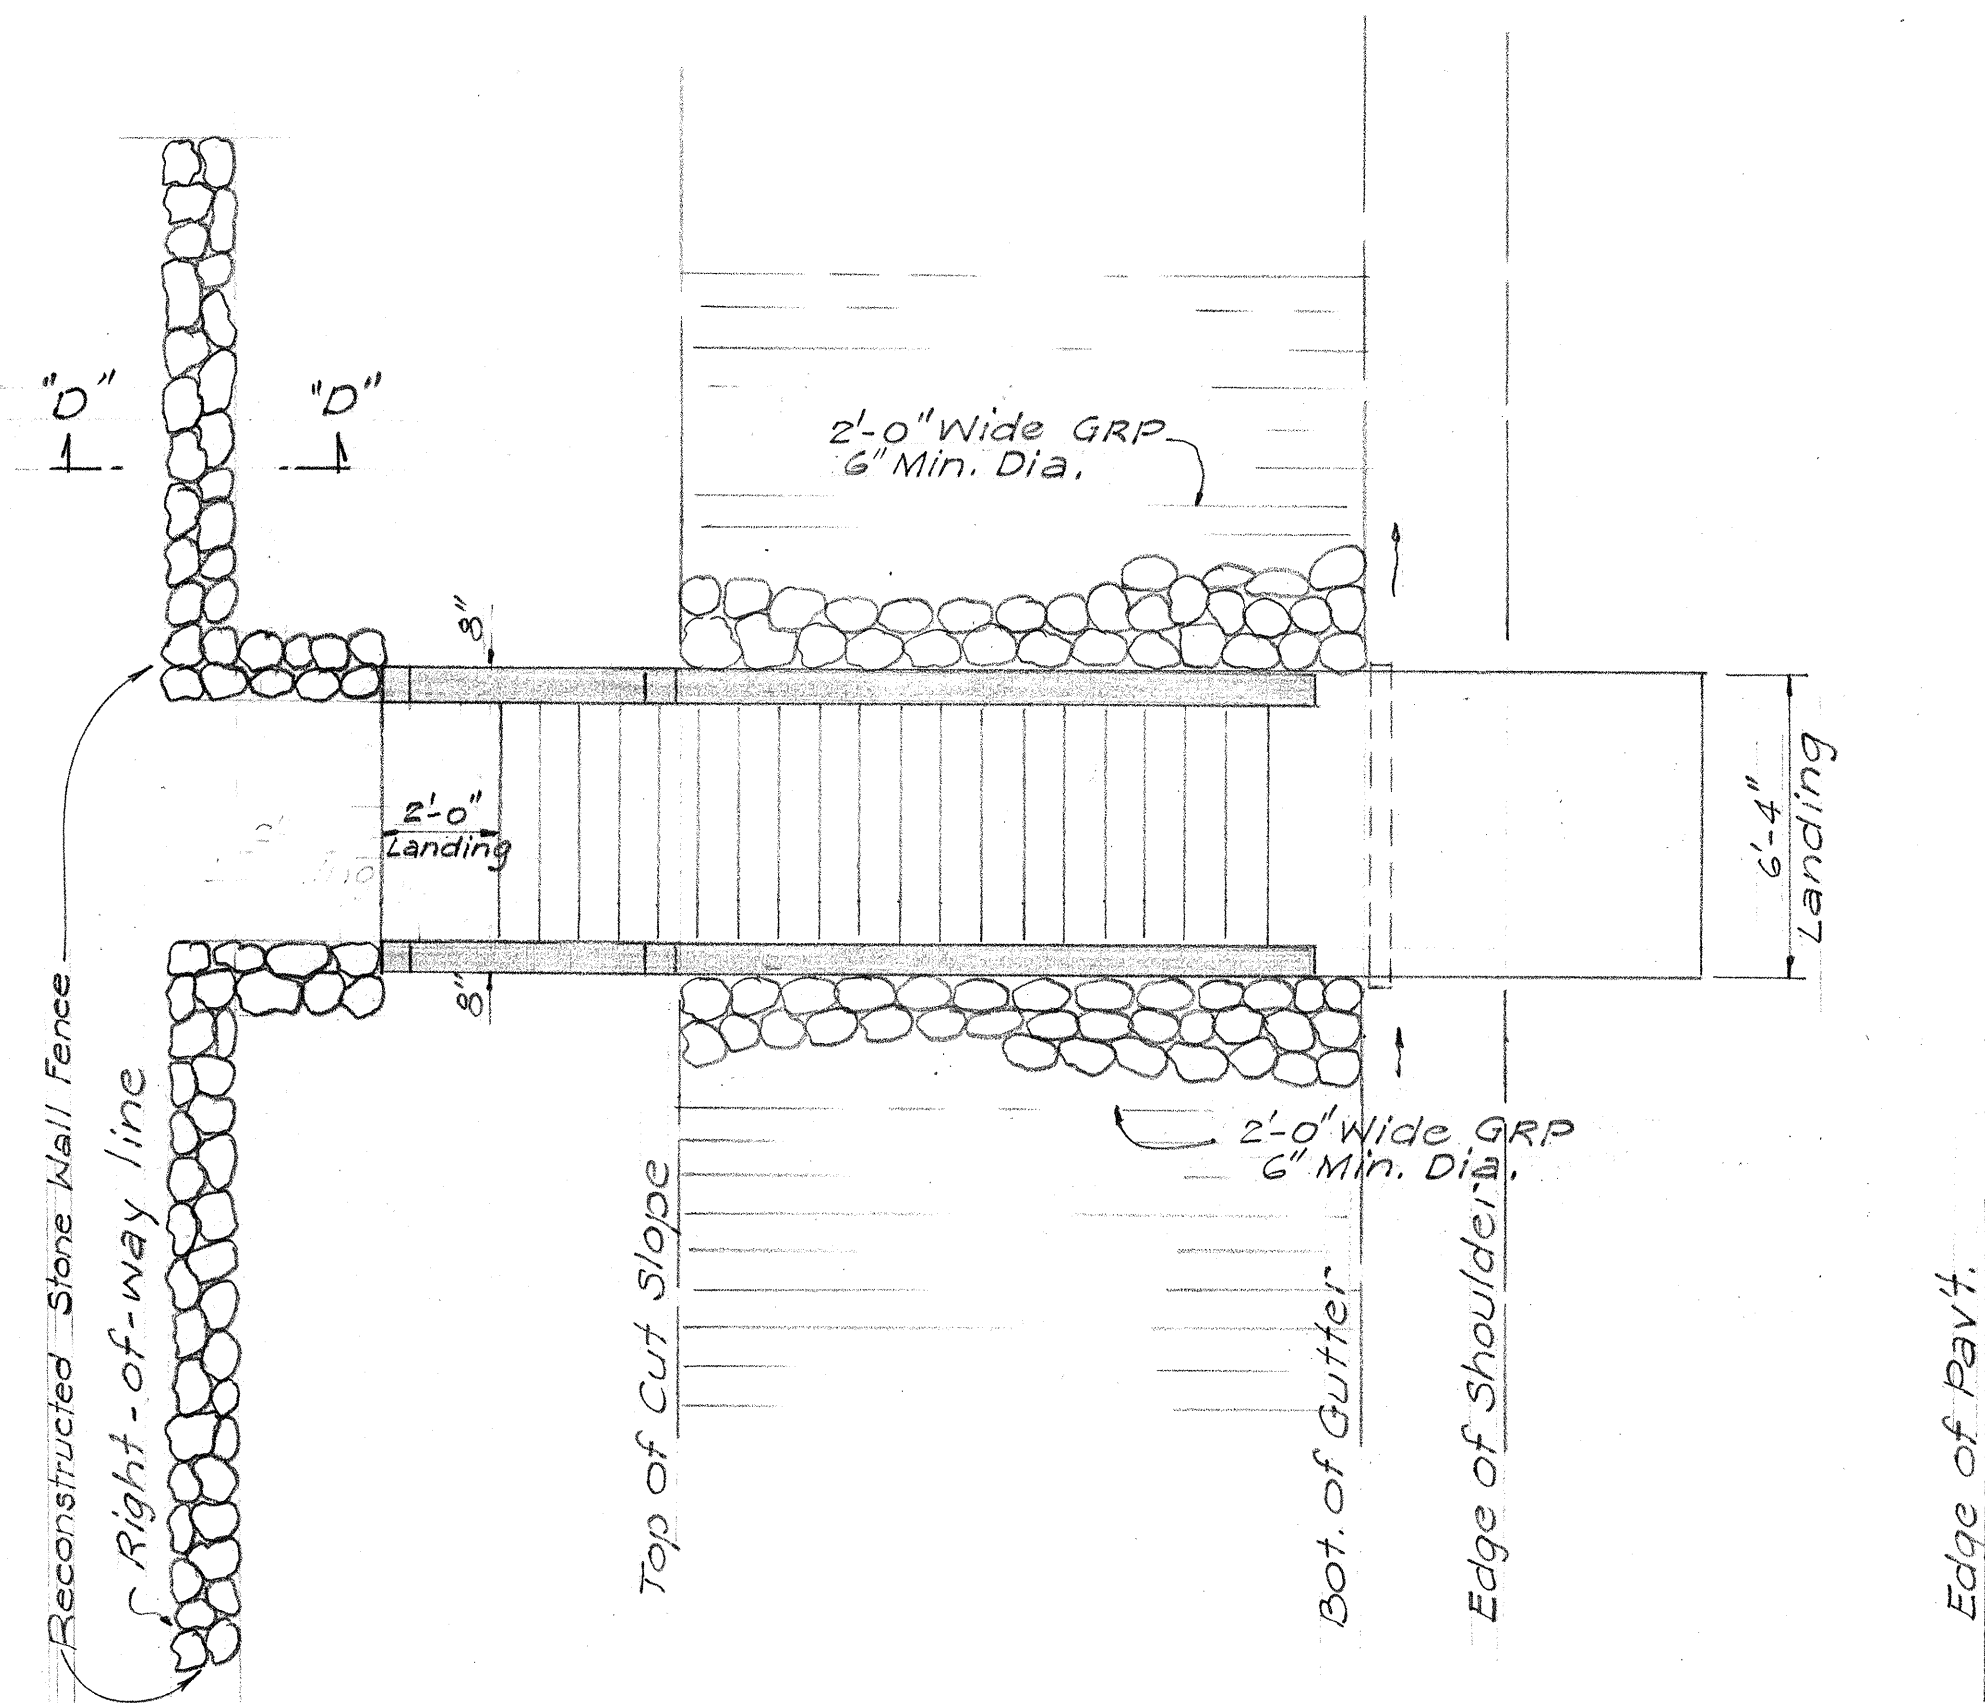


PLAN OF STAIRWAY  
 $\frac{1}{4}" = 1'-0"$

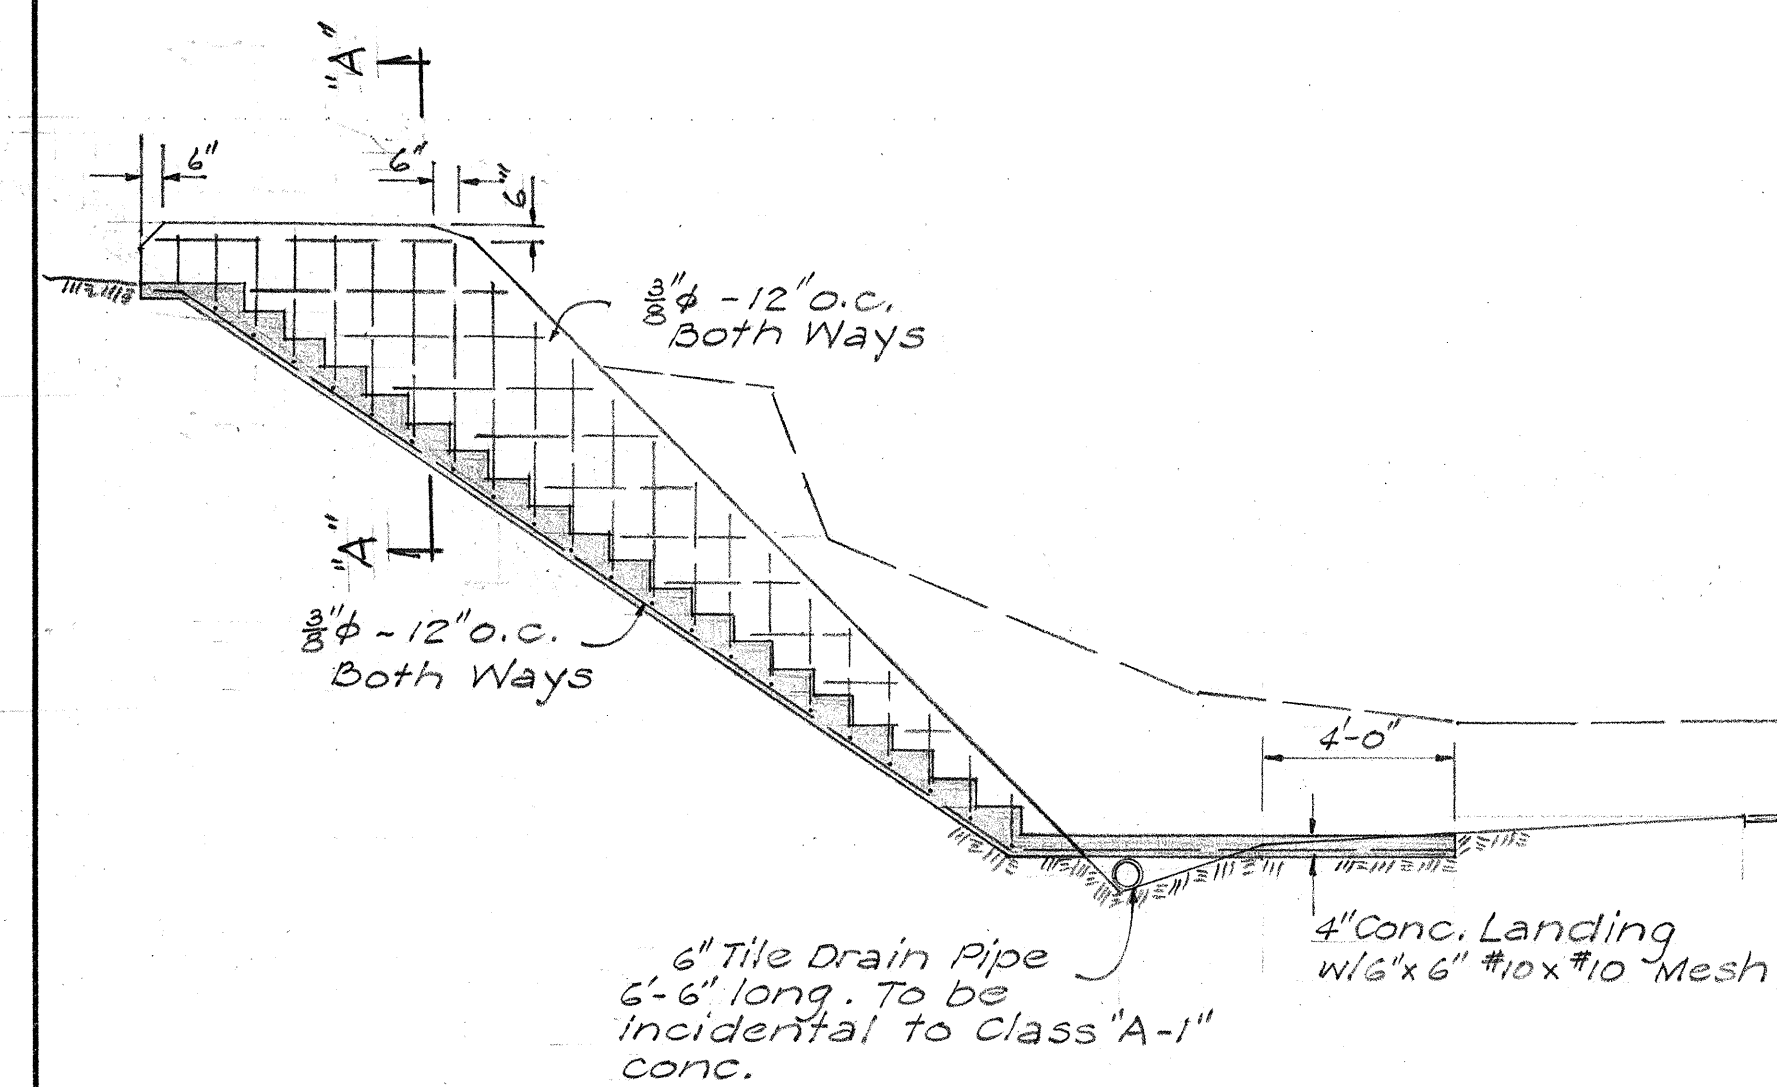


SECTION THRU STAIRWAY  
STA. 194+35  
 $\frac{1}{4}" = 1'-0"$

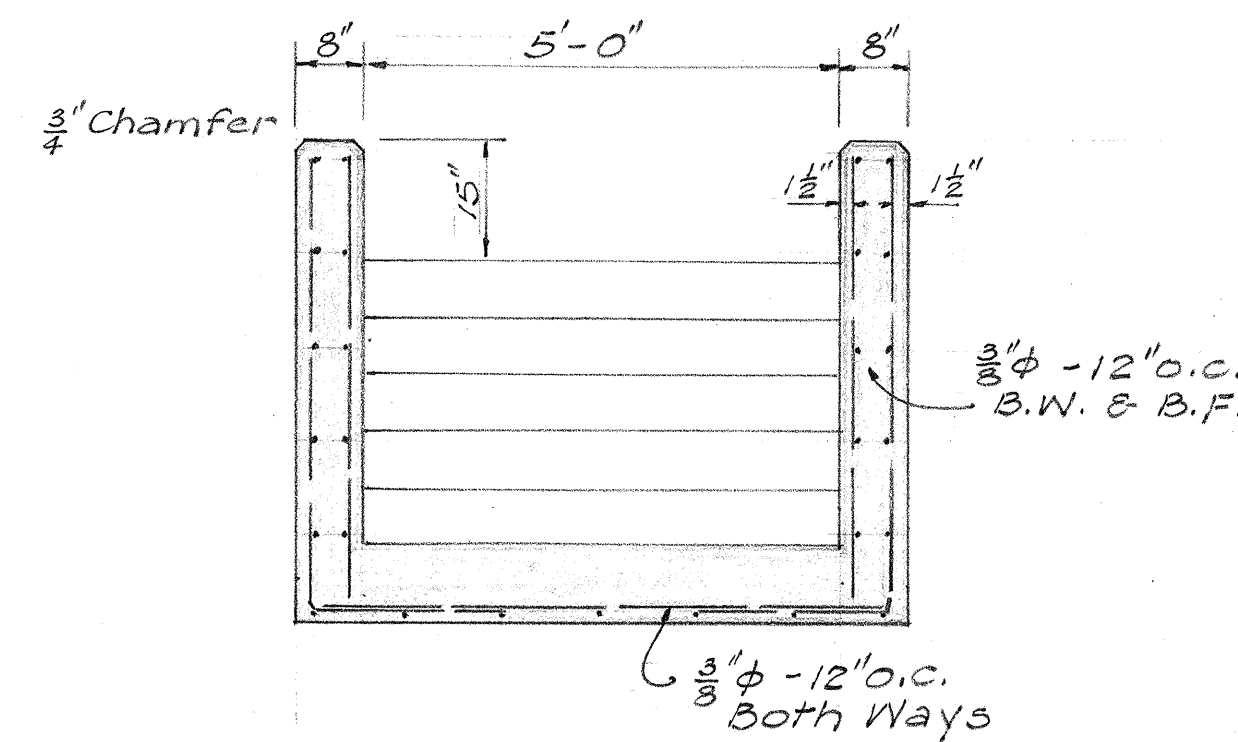

SECTION "A-A"  
 $\frac{1}{2}" = 1'-0"$

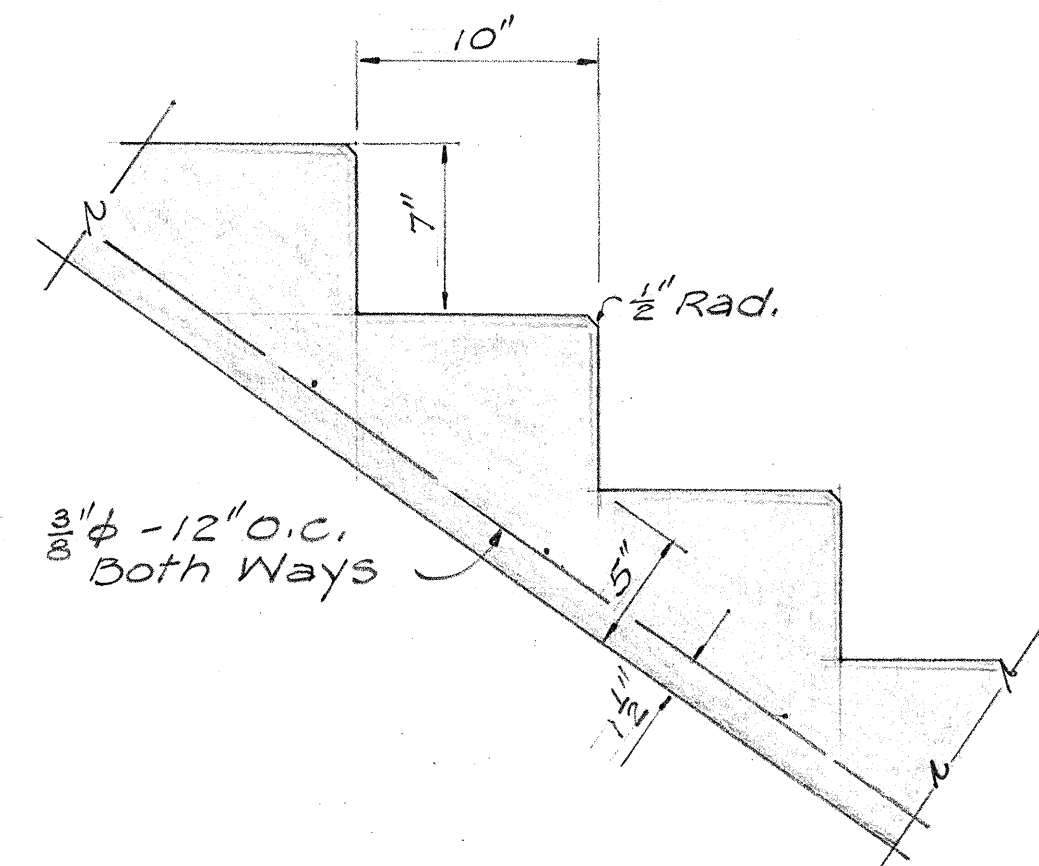

SECTION THRU STAIRS  
 $\frac{1}{2}" = 1'-0"$

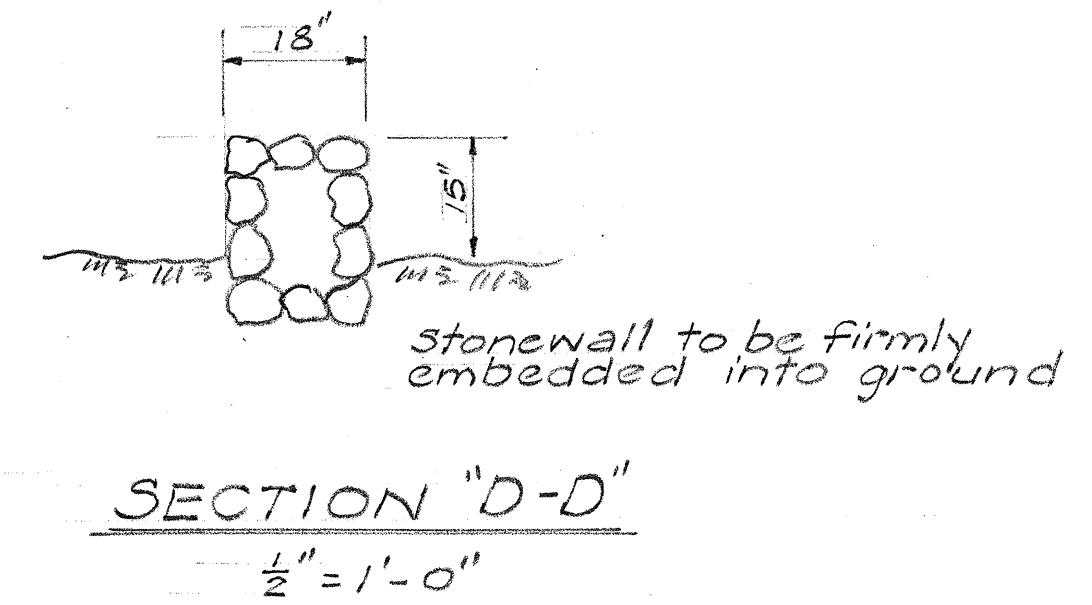

SECTION "D-D"  
 $\frac{1}{2}" = 1'-0"$

Estimated Quantities

|                 |           |
|-----------------|-----------|
| Class A-1 Conc. | 7.1 C.Y.  |
| Reinf. Steel    | 316 Lbs.  |
| Struc. Exc.     | 16.0 C.Y. |
| G.R. Paving     | 1.4 C.Y.  |

|                                |
|--------------------------------|
| TERRITORIAL HIGHWAY DEPARTMENT |
| TERRITORY OF HAWAII            |
| DETAIL OF STAIRWAY             |
| STA. 194+35                    |
| KAUAI BELT ROAD                |
| PROJ. No. F31(1)               |
| Scales: As Shown               |
| January 1953                   |

SHEET No. 1 OF 1 SHEETS

5593.23

|                   |      |
|-------------------|------|
| SURVEY PLOTTED BY | DATE |
| DESIGNED BY       |      |
| TRACED BY         |      |
| QUANTITIES BY     |      |
| CHECKED BY        |      |
| NO.               |      |