


FED. ROAD DIST. No.	STATE	FED. AID PROJ. No.	FISCAL YEAR	SHEET No.	TOTAL SHEETS
HAWAII	HAW.	ERS-11	1956	16	20

FINAL SURVEY	DATE
NO. _____	_____
BY _____	_____
SURVEYED _____	_____
NOTE BOOK _____	_____
AREAS _____	_____
CHECKED _____	_____

ORIGINAL SURVEY	DATE
NO. _____	_____
BY _____	_____
SURVEYED _____	_____
NOTE BOOK _____	_____
AREAS _____	_____
CHECKED _____	_____

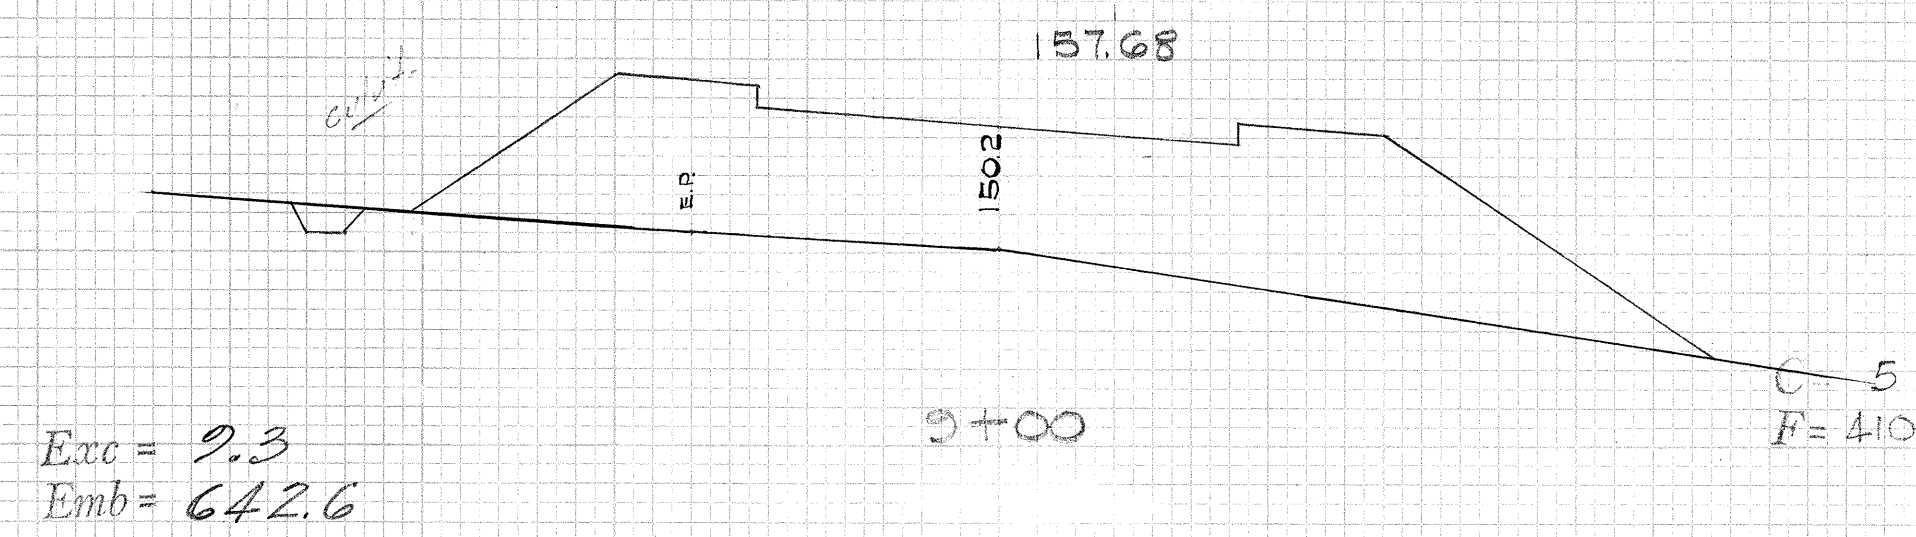

Exc = 127.8
Emb = 115.7


11+00

C= 99
F= 9

Exc = 60.2
Emb = 166.7

13+00

C= 7
F= 163

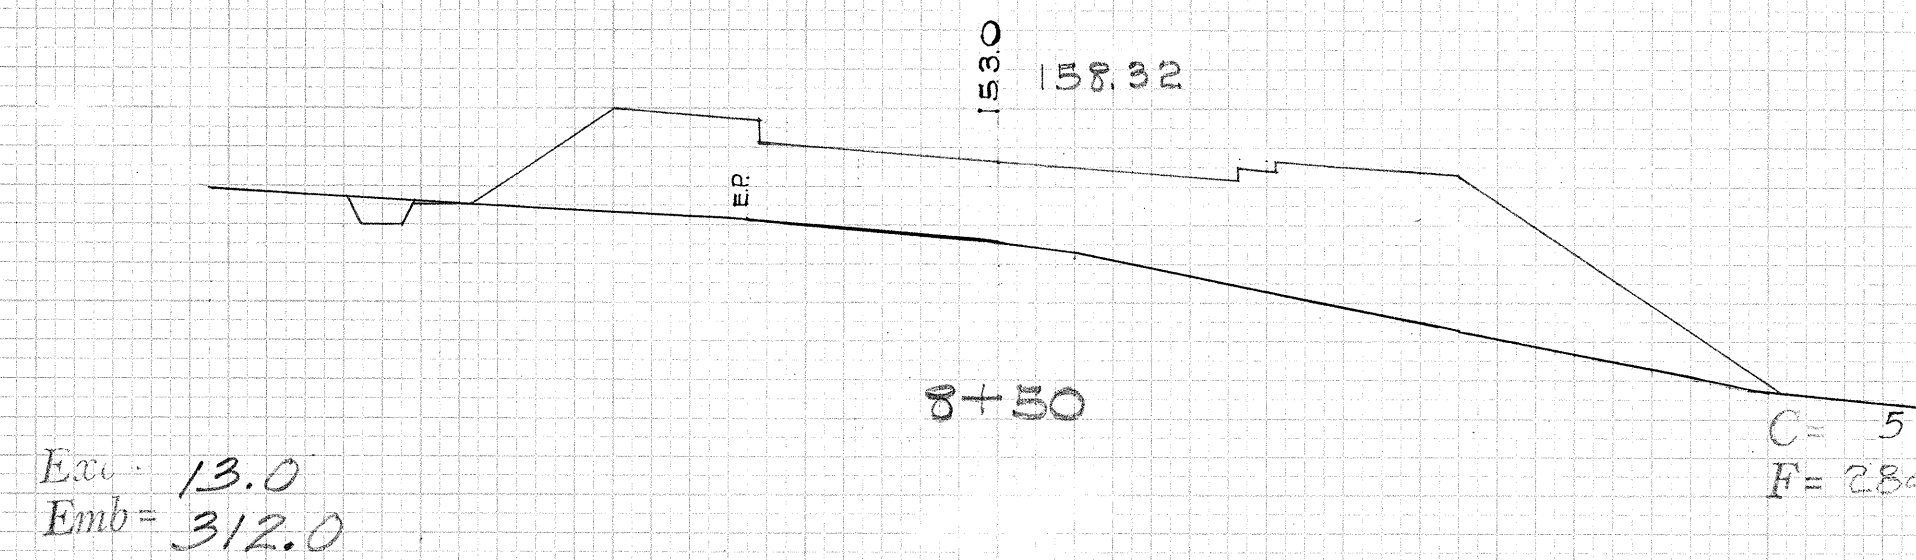

Exc = 39.8
Emb = 362.0


10+50

C= 39
F= 116

Exc = 191.7
Emb = 15.7

12+50

C= 58
F= 17

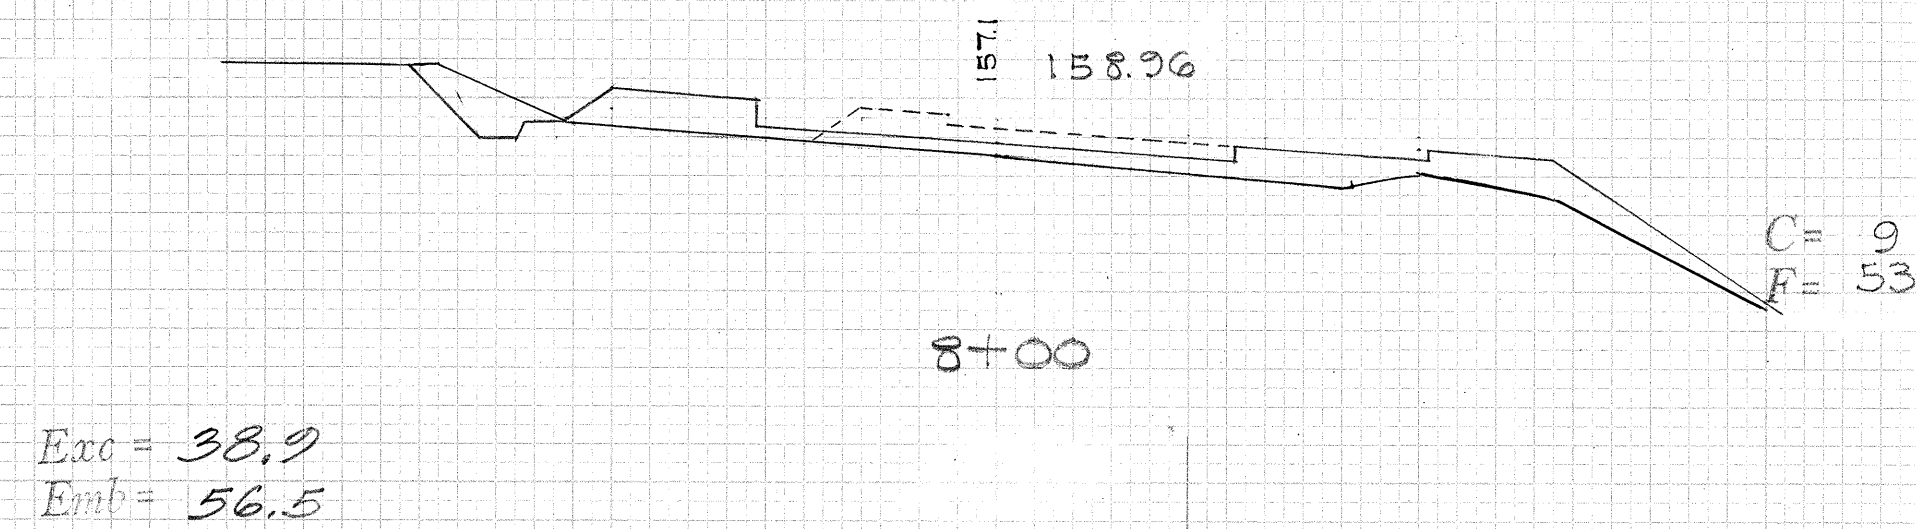

Exc = 5.6
Emb = 554.6


10+00

C= 4
F= 215

Exc = 323.1
Emb = 0

12+00

C= 149
F= 0

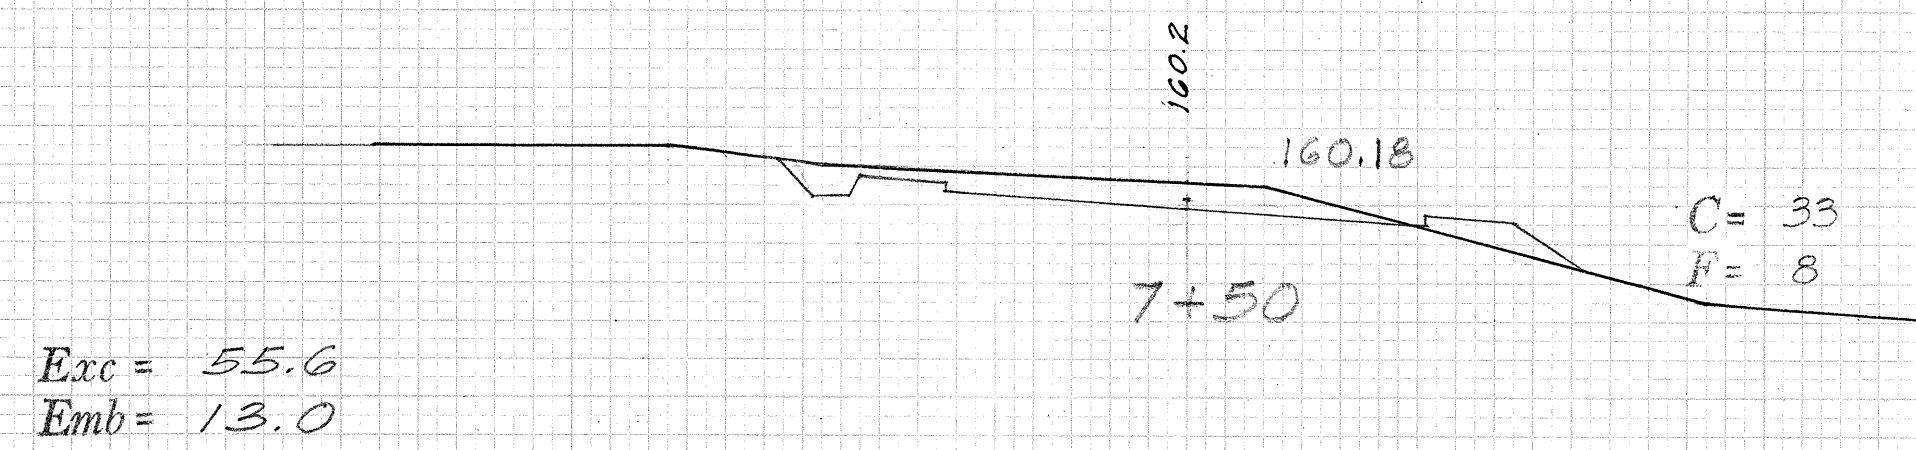

Exc = 6.5
Emb = 679.6


9+50

C= 2
F= 324

Exc = 276.9
Emb = 8.3

11+50


C= 200
F= 0

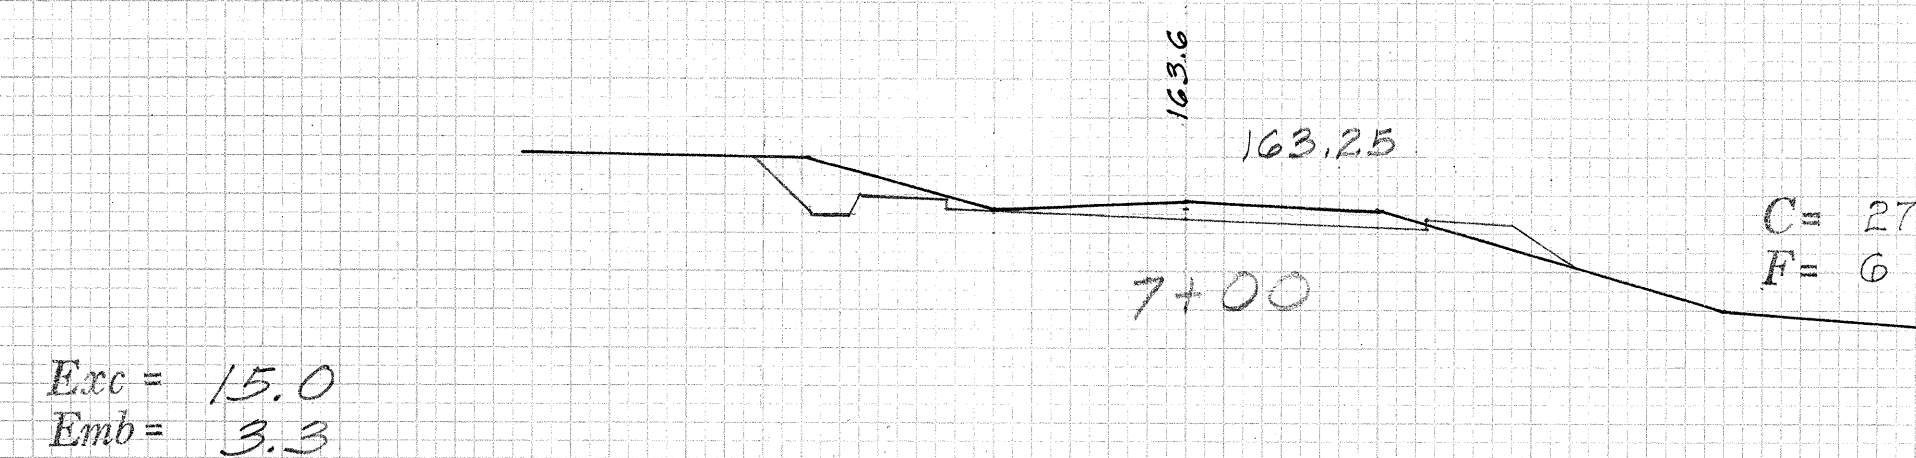



FINAL	SURVEYED	DATE
SURVEY	PLOTTED	BY
NOTE BOOK	TEMPLATE	
NO.	AREAS CHECKED	

ORIGINAL	SURVEYED	DATE
SURVEY	PLOTTED	BY
NOTE BOOK	TEMPLATE	
NO.	AREAS CHECKED	


FED. ROAD DIST. No.	STATE	FED. AID PROJ. No.	FISCAL YEAR	SHEET No.	TOTAL SHEETS
HAWAII	HAW.	ERB(1)	1956	17	20

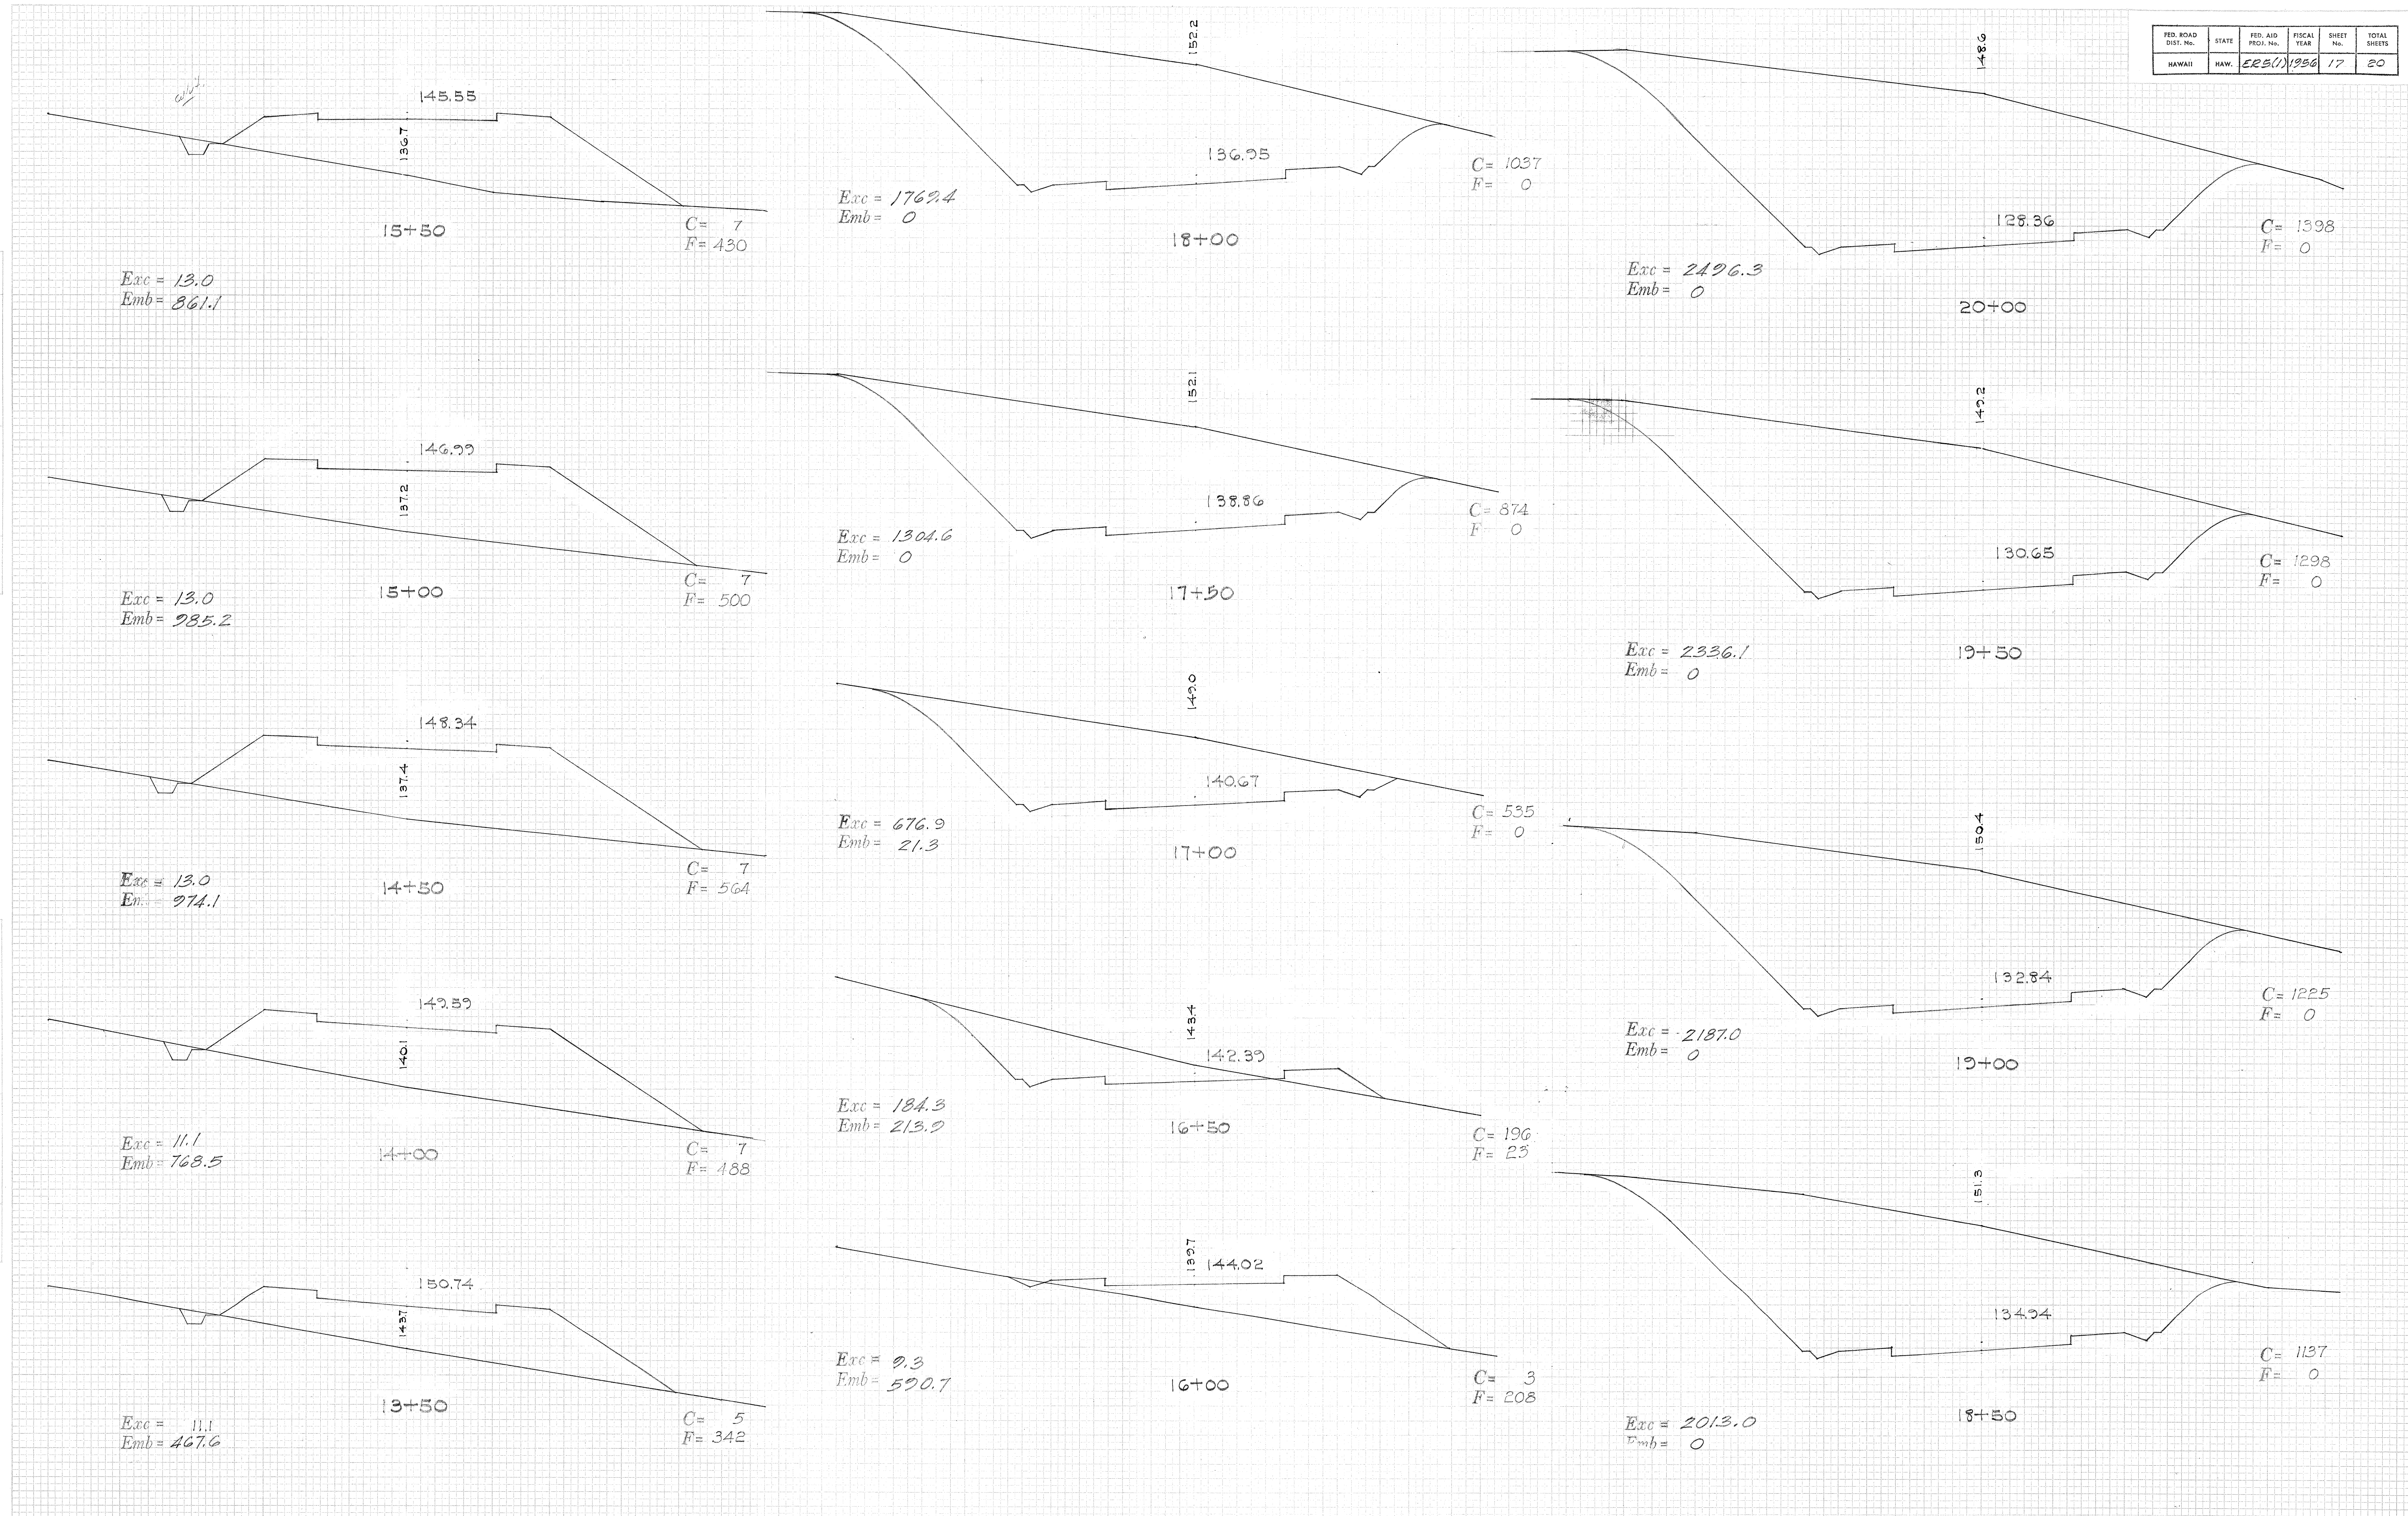

FINAL SURVEY	SURVEYED PLOTTED	BY	DATE
NOTE BOOK	TEMPLATF		
NO.	AREAS AREAS CHECKED		

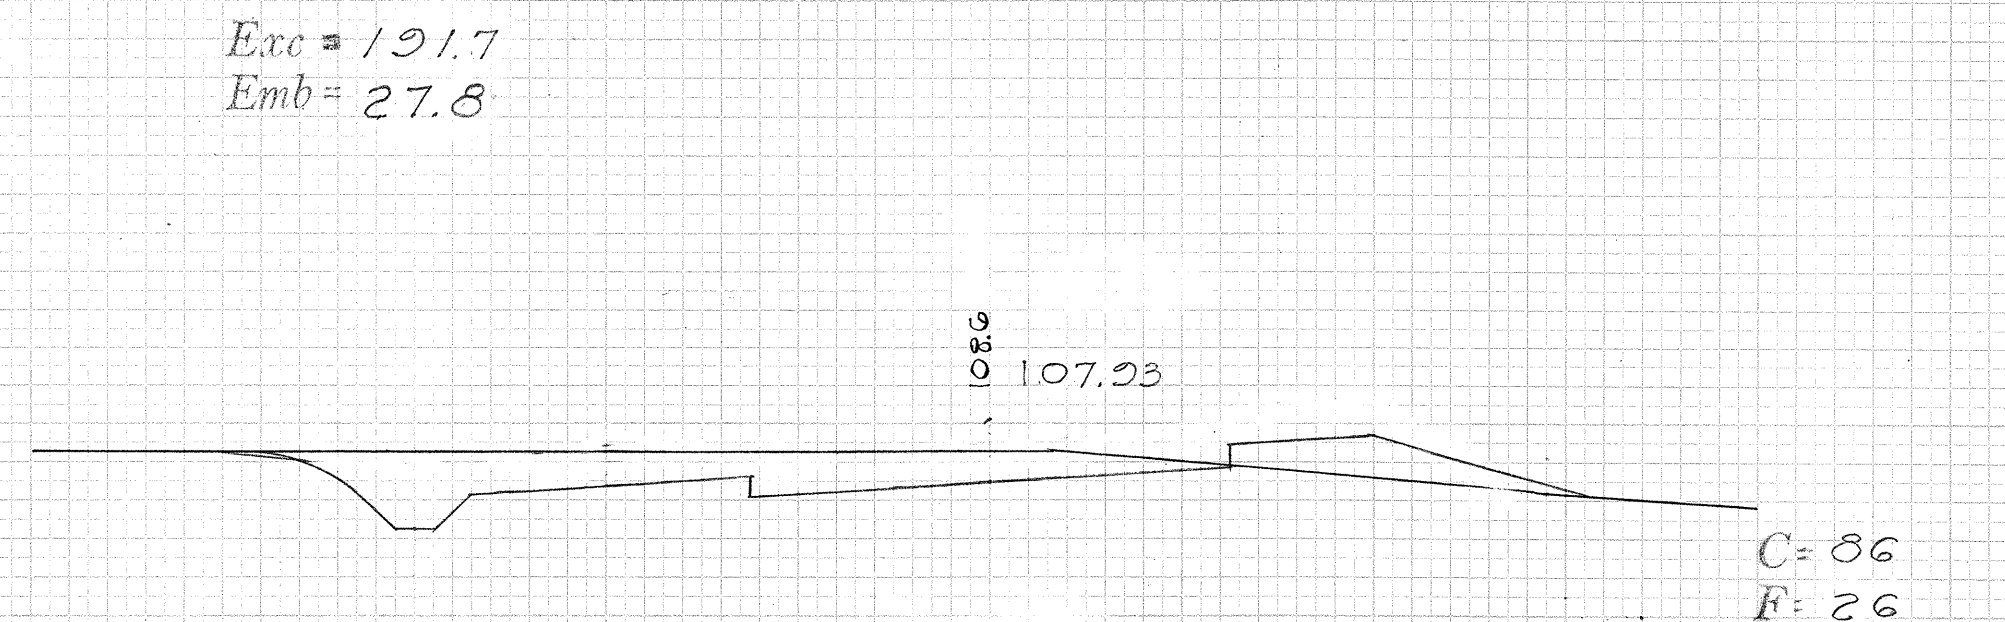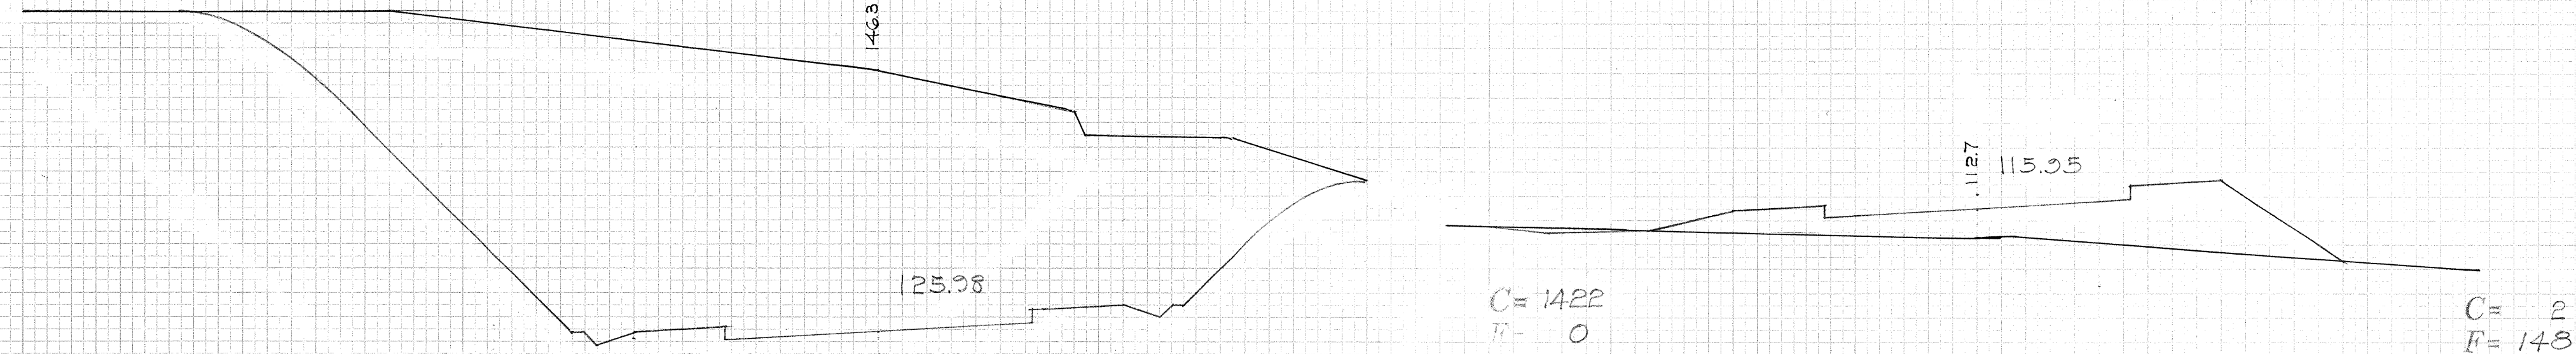



ORIGINAL SURVEY	BY	DATE
SURVEYED	M.M.	
PLOTTED	M.M.	
TEMPLATE	M.M.	
AREAS	M.M.	
AREAS CHECKED		
NO.		

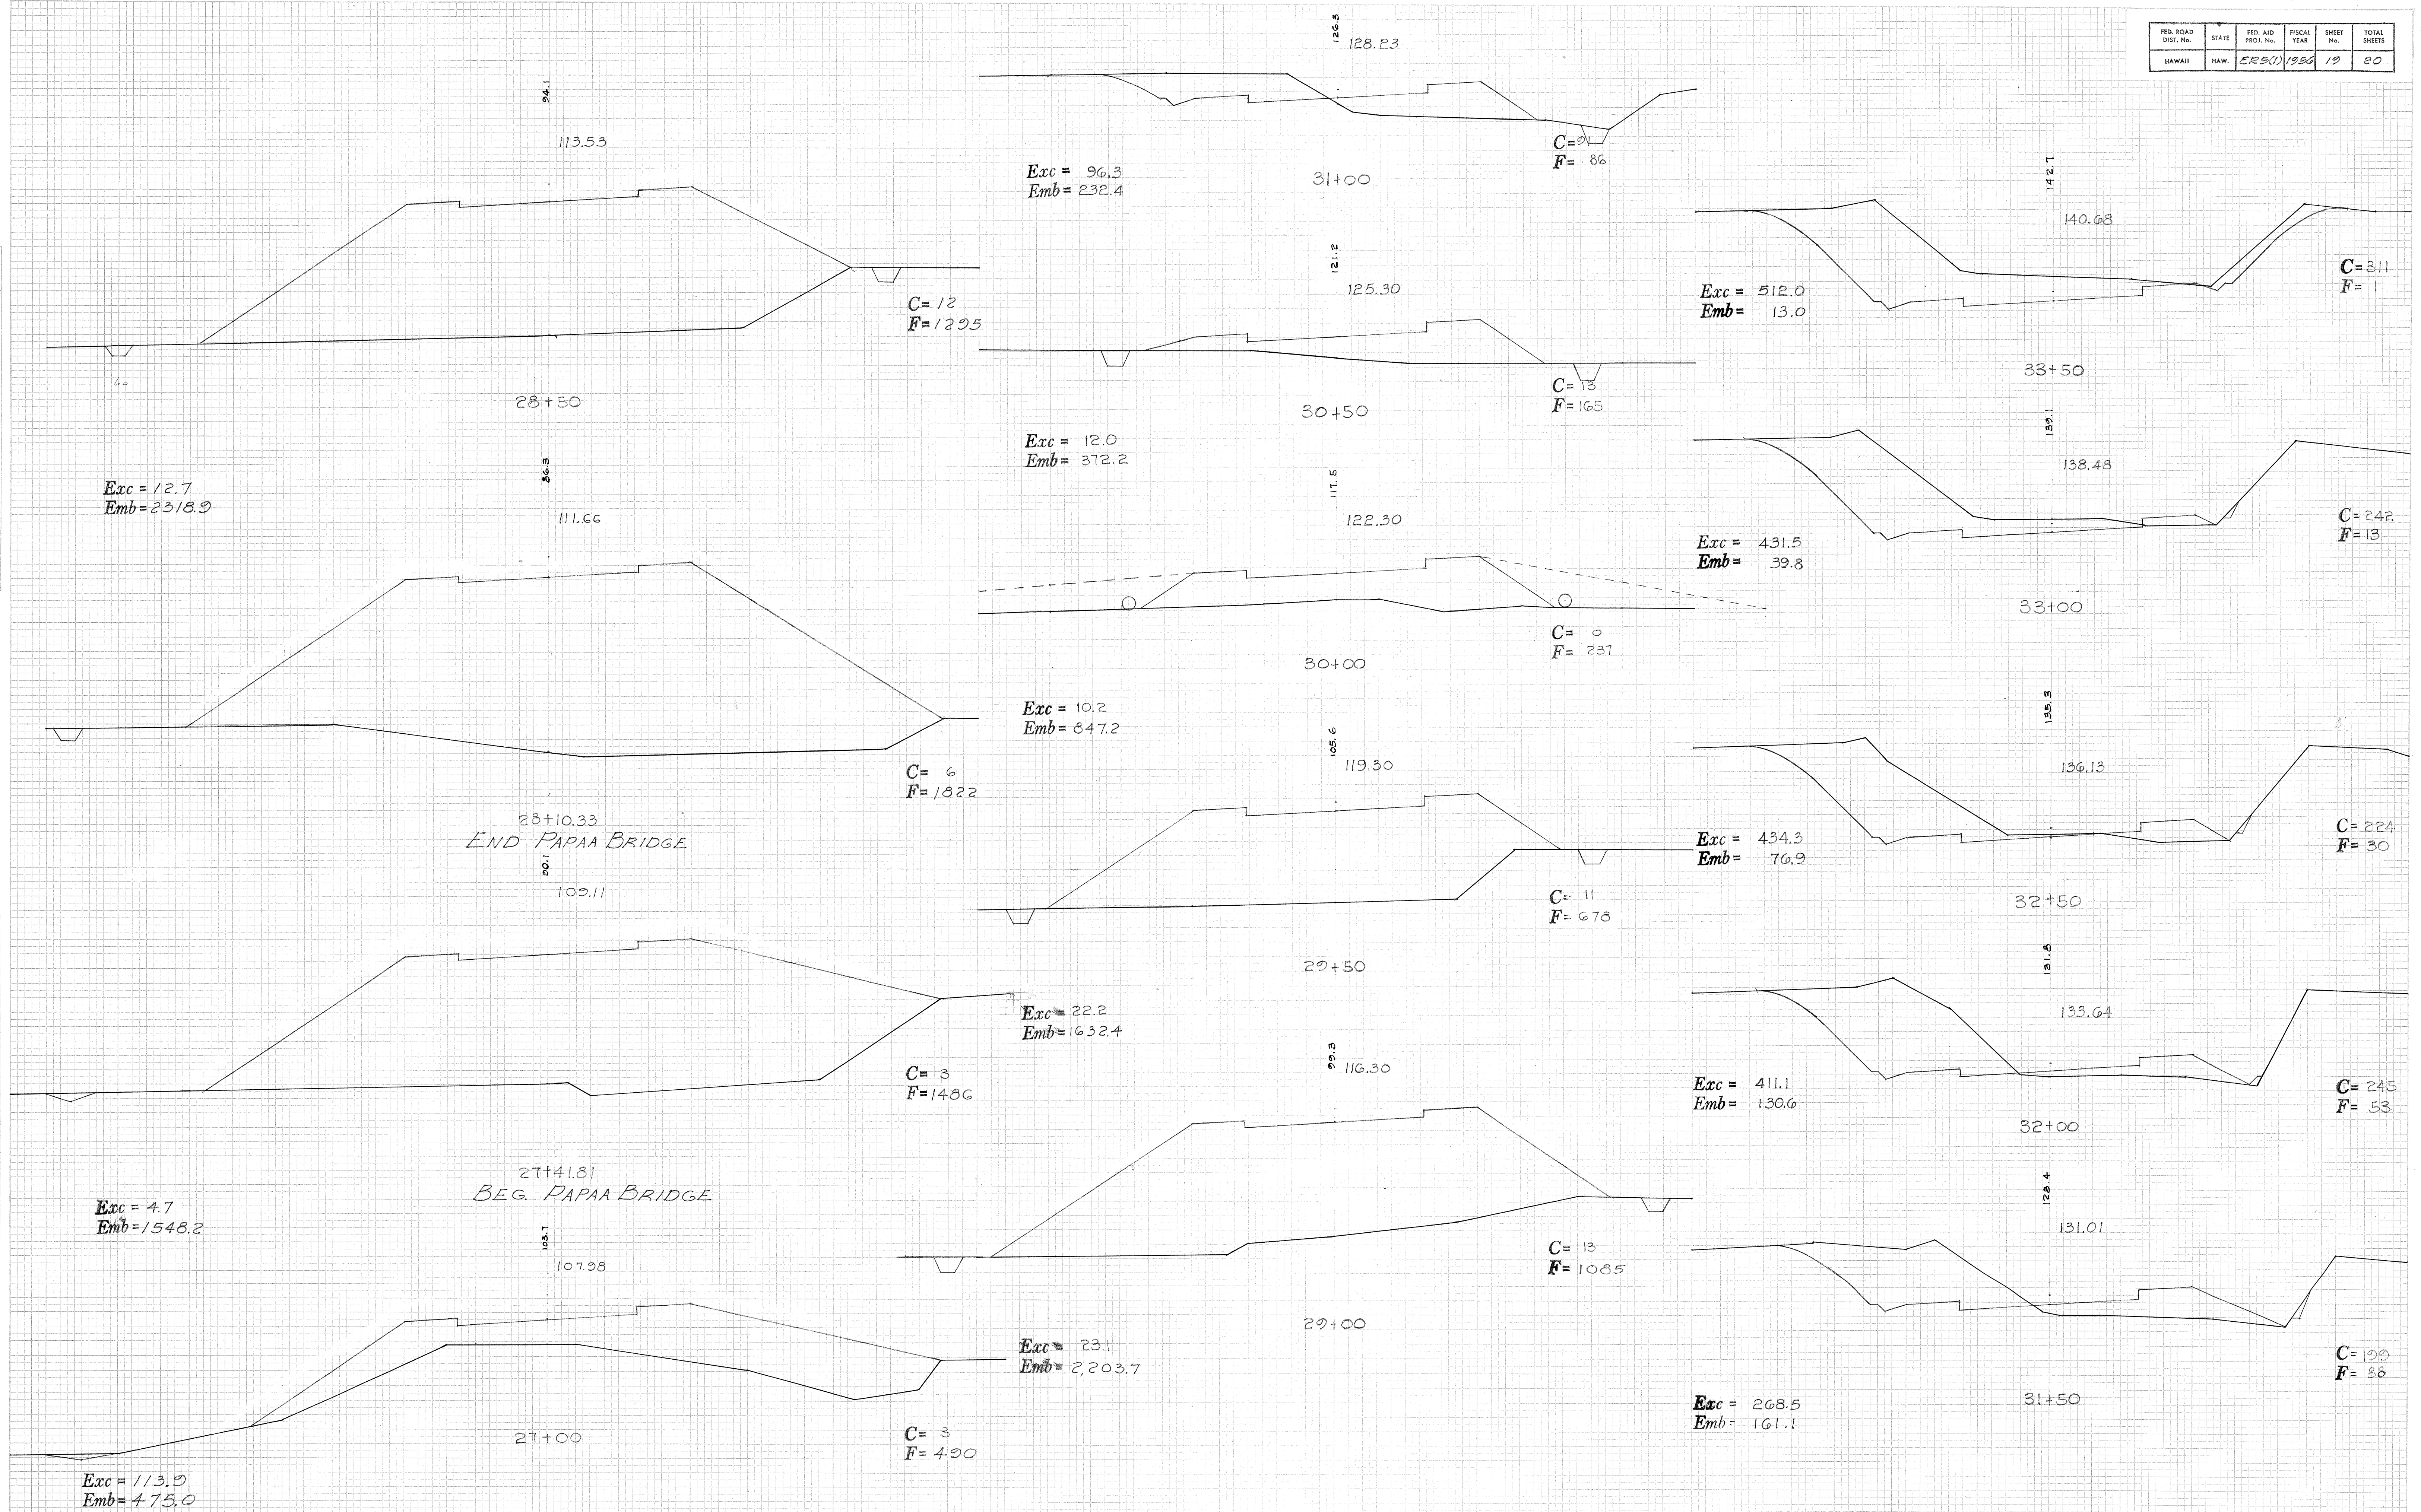

FED. ROAD DIST. No.	STATE	FED. AID PROJ. No.	FISCAL YEAR	SHEET No.	TOTAL SHEETS
HAWAII	HAW.	ER 5(1)	1956	20	20

FINAL SURVEY	NO.	DATE	BY
SURVEYED			
PLOTTED			
TEMPLATE			
NOTE BOOK			
AREAS CHECKED			

ORIGINAL SURVEY	NO.	DATE	BY
SURVEYED			
PLOTTED			
TEMPLATE			
NOTE BOOK			
AREAS CHECKED			

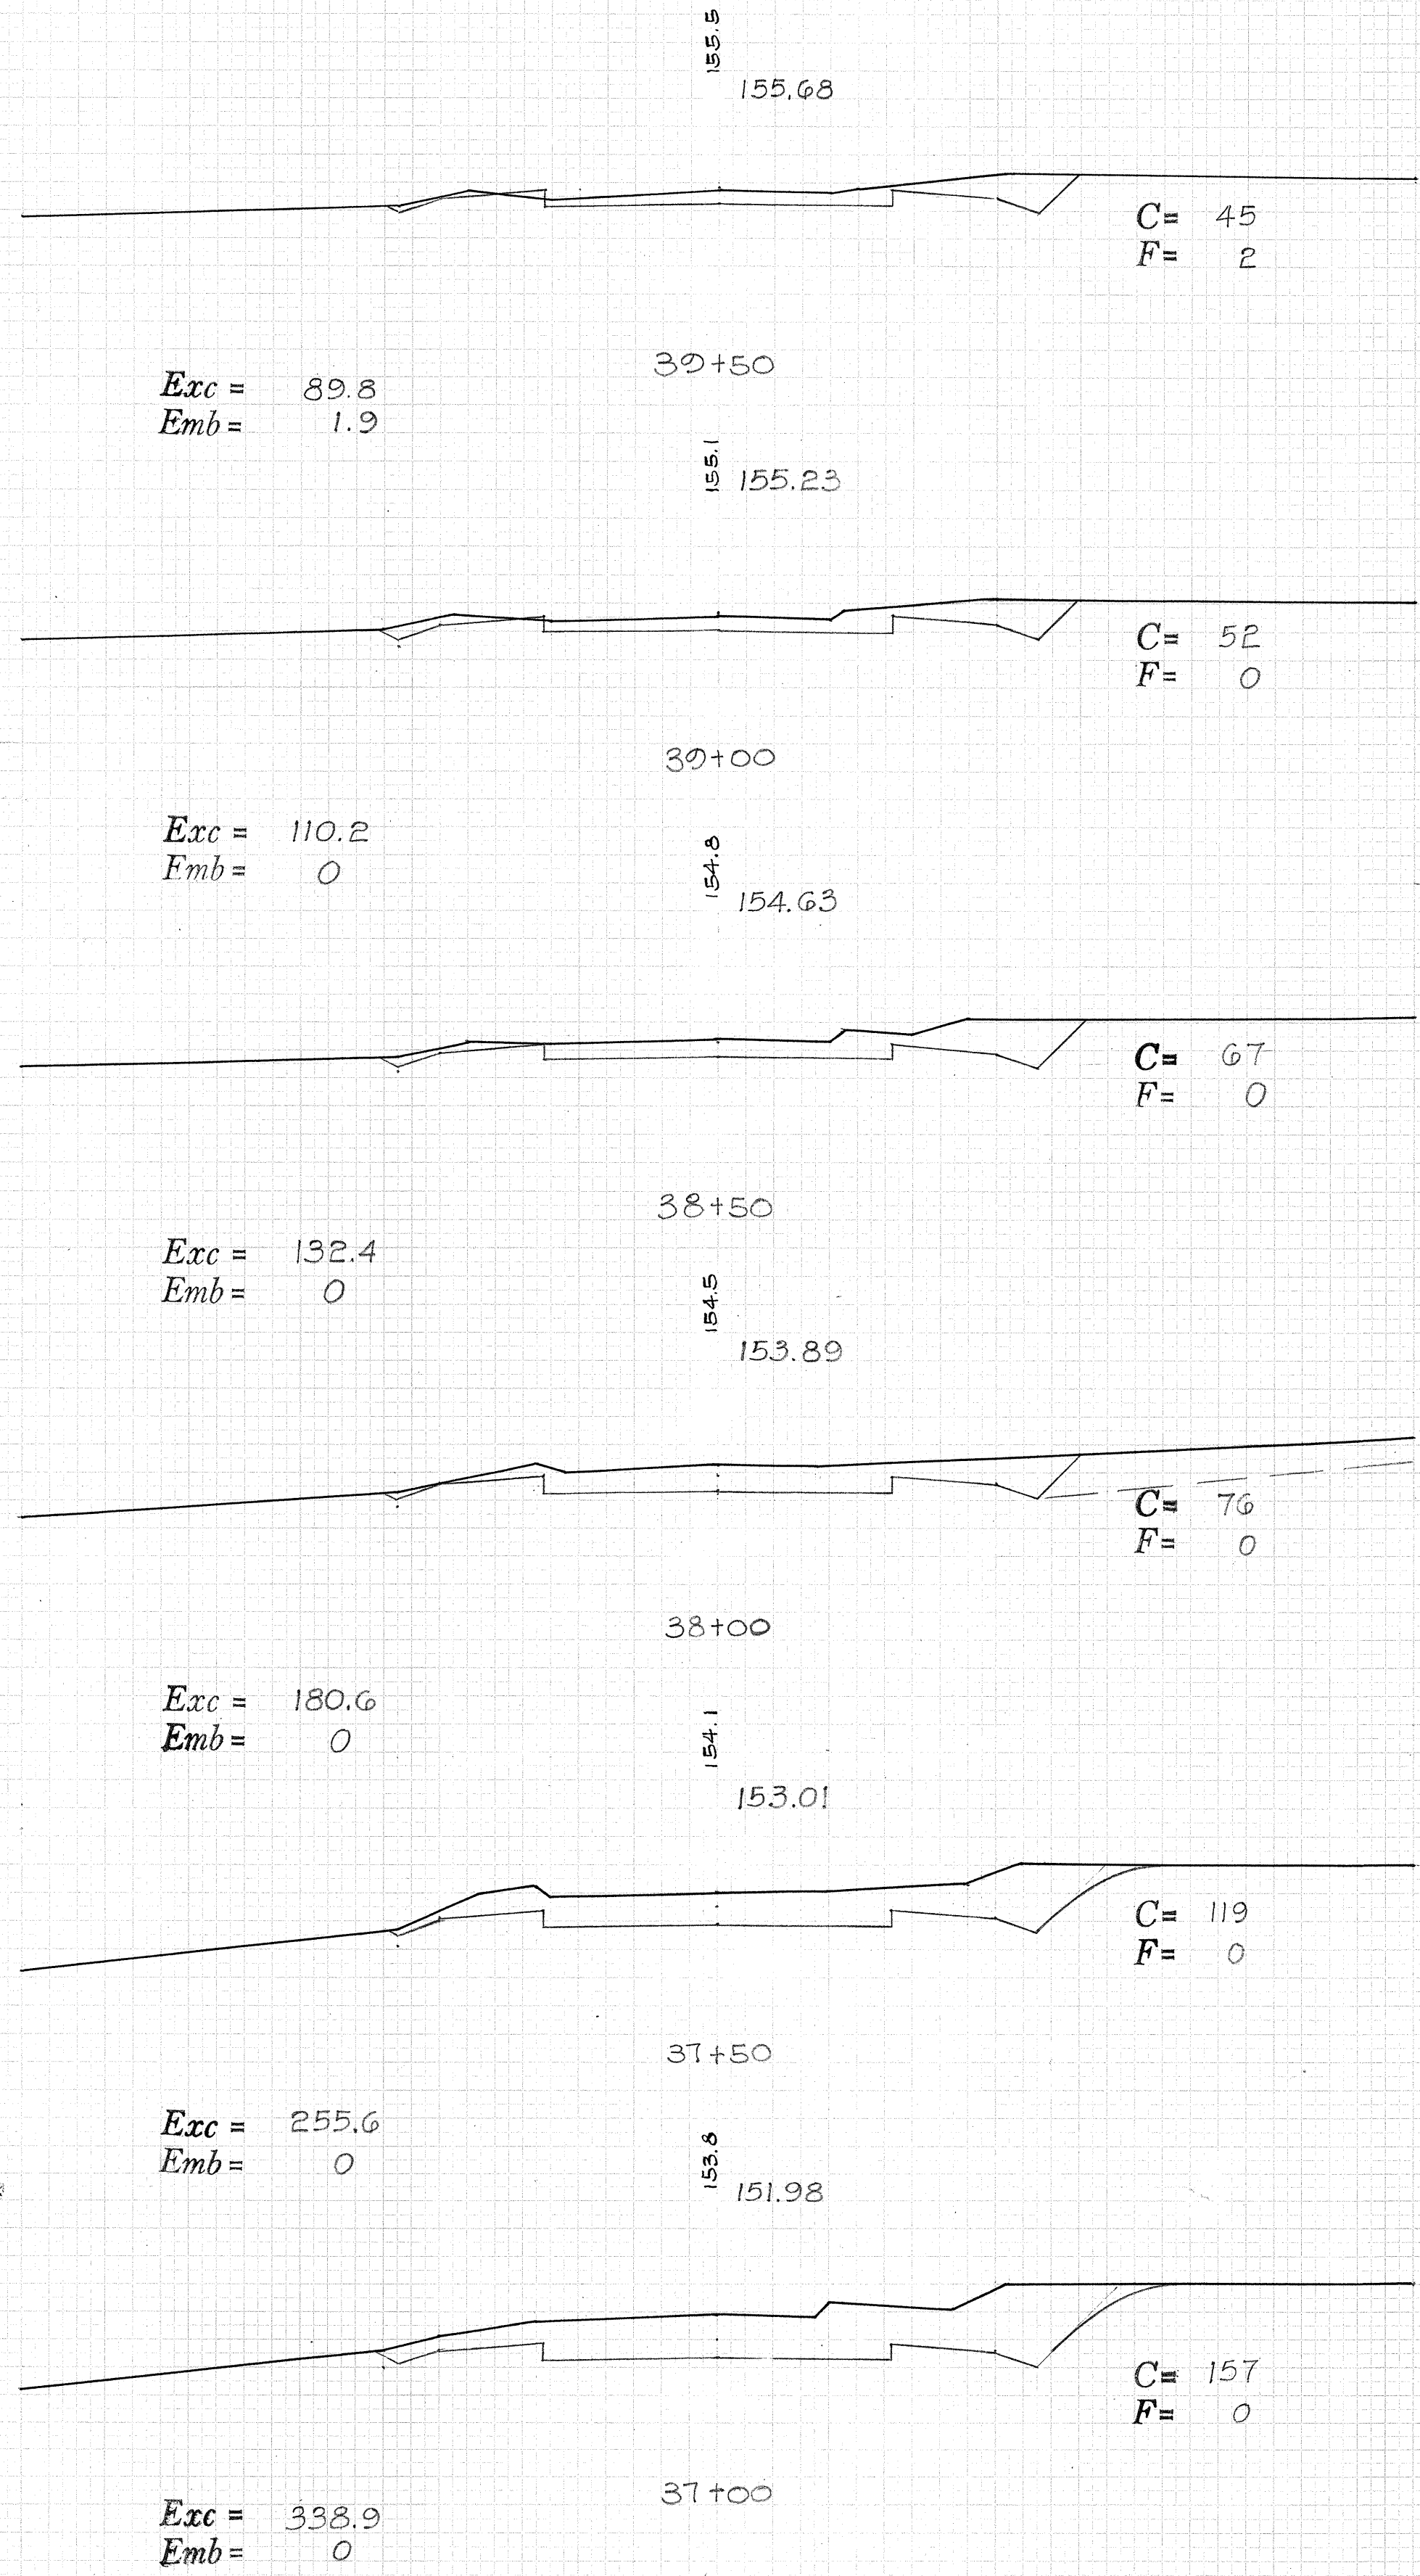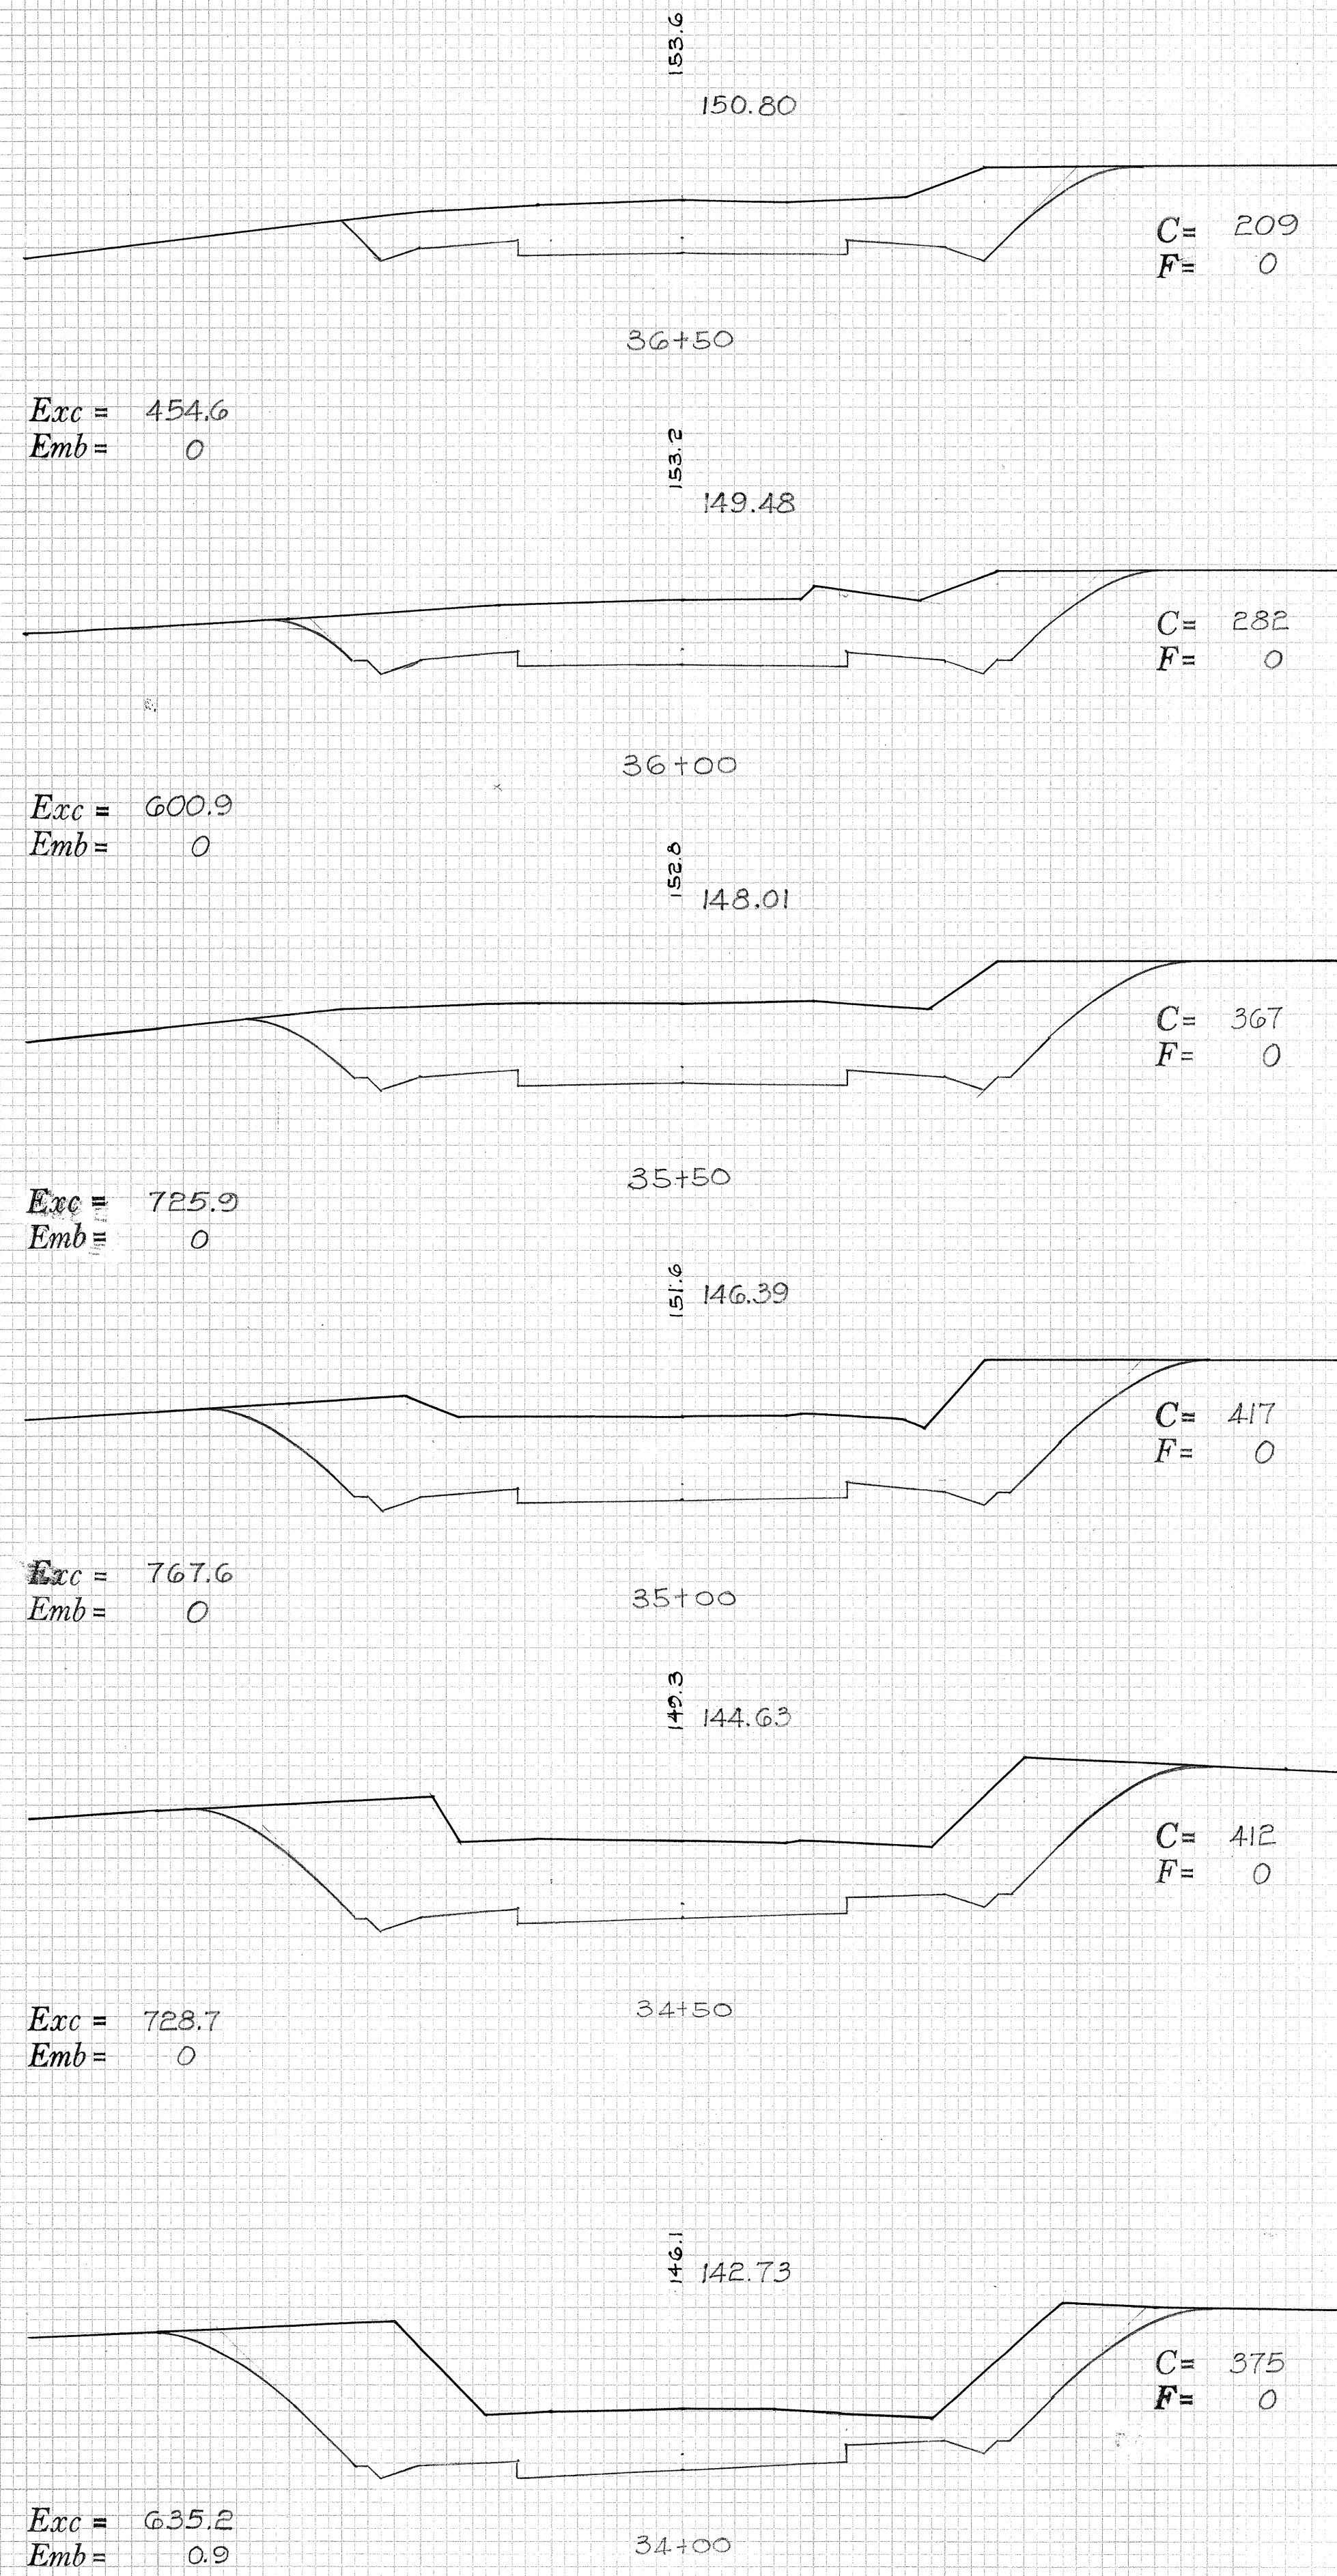

END PROJ. ER 5(1)