

INDEX TO DRAWINGS	
SHEET NO	DESCRIPTORS
1	TITLE SHEET
2	TYPICAL SECTIONS
3 - 4	PLAN AND PROFILE
5 - 7	STANDARD DETAILS
8 - 14	PAPAA BRIDGE
15	STANDARD BRIDGE DETAILS
16 - 20	CROSS SECTIONS

TERRITORY OF HAWAII

TERRITORIAL HIGHWAY DEPARTMENT

HONOLULU T. H.

PLANS OF

KAUAI BELT ROAD

(PAPAA BRIDGE AND APPROACHES)

EMERGENCY RELIEF PROJECT NO. ER 5(I)

DISTRICT OF KAWAIHAU

ISLAND OF KAUAI

SCALES



PLAN ----- 1 INCH = 100 FT.

PROFILE ----- HOR. 1 INCH = 100 FT.

VER. 1 INCH = 10 FT.

CROSS SECTION ----- HOR. 1 INCH = 10 FT.

VER. 1 INCH = 10 FT.

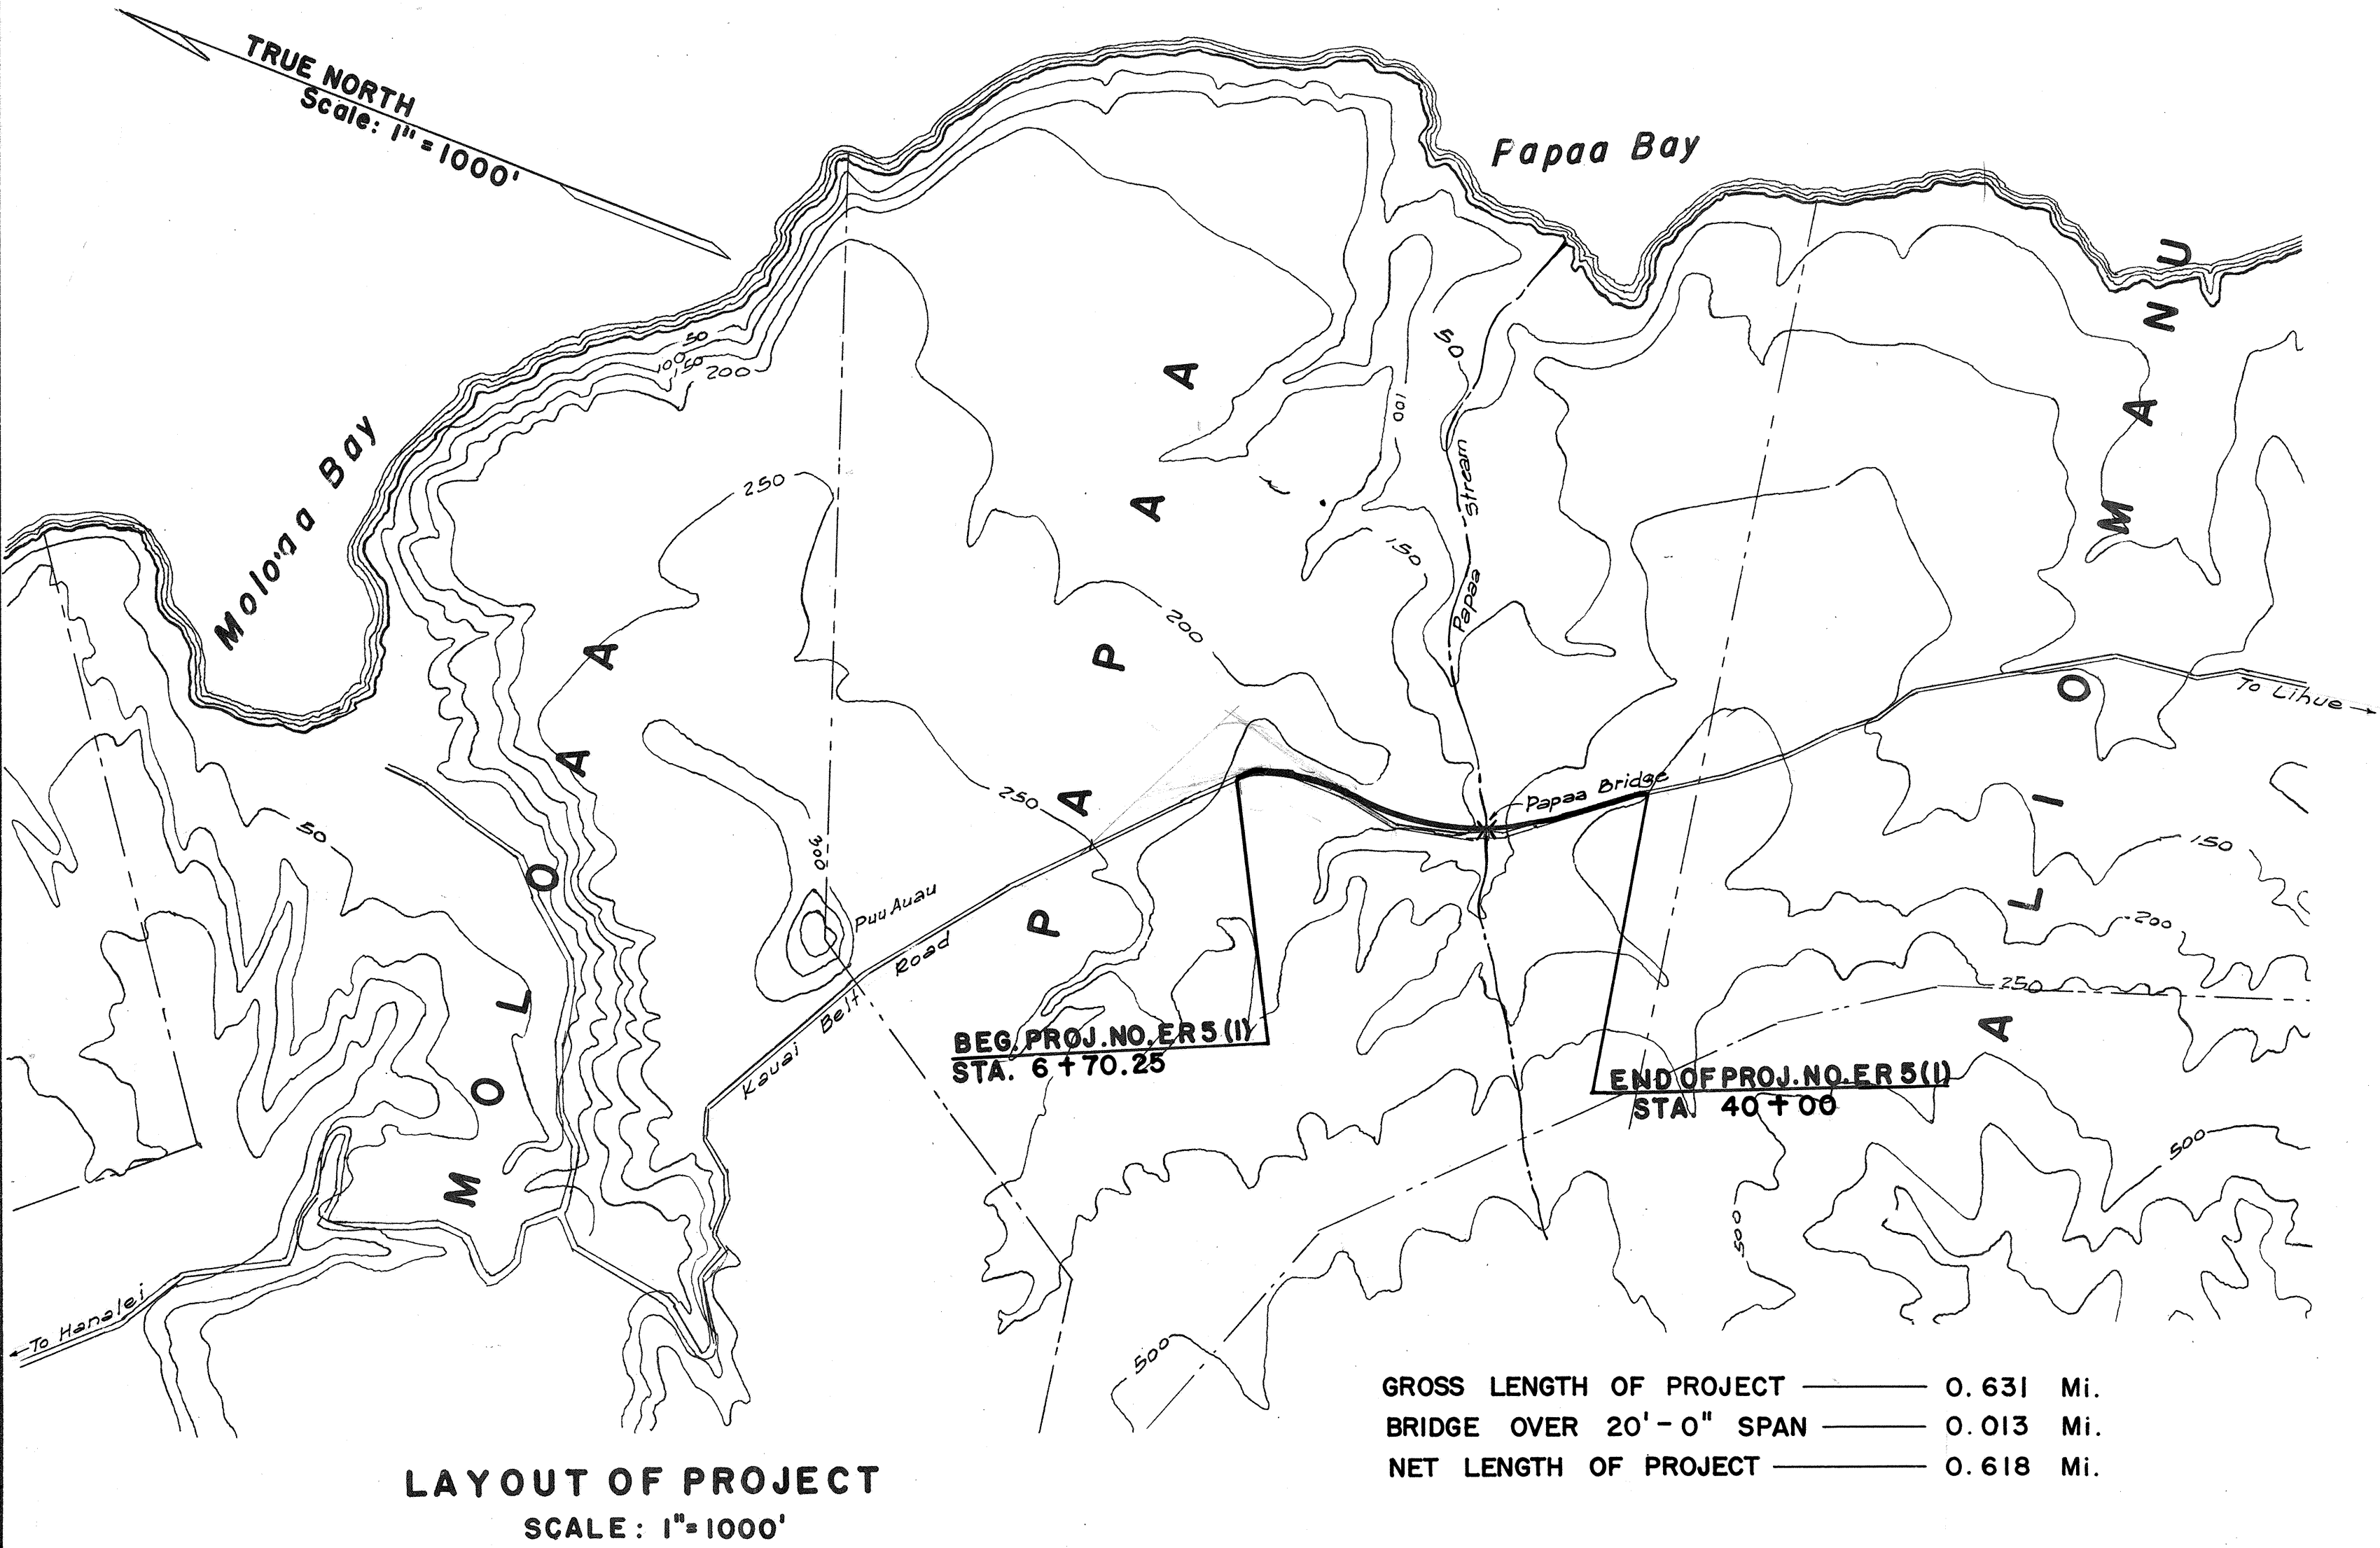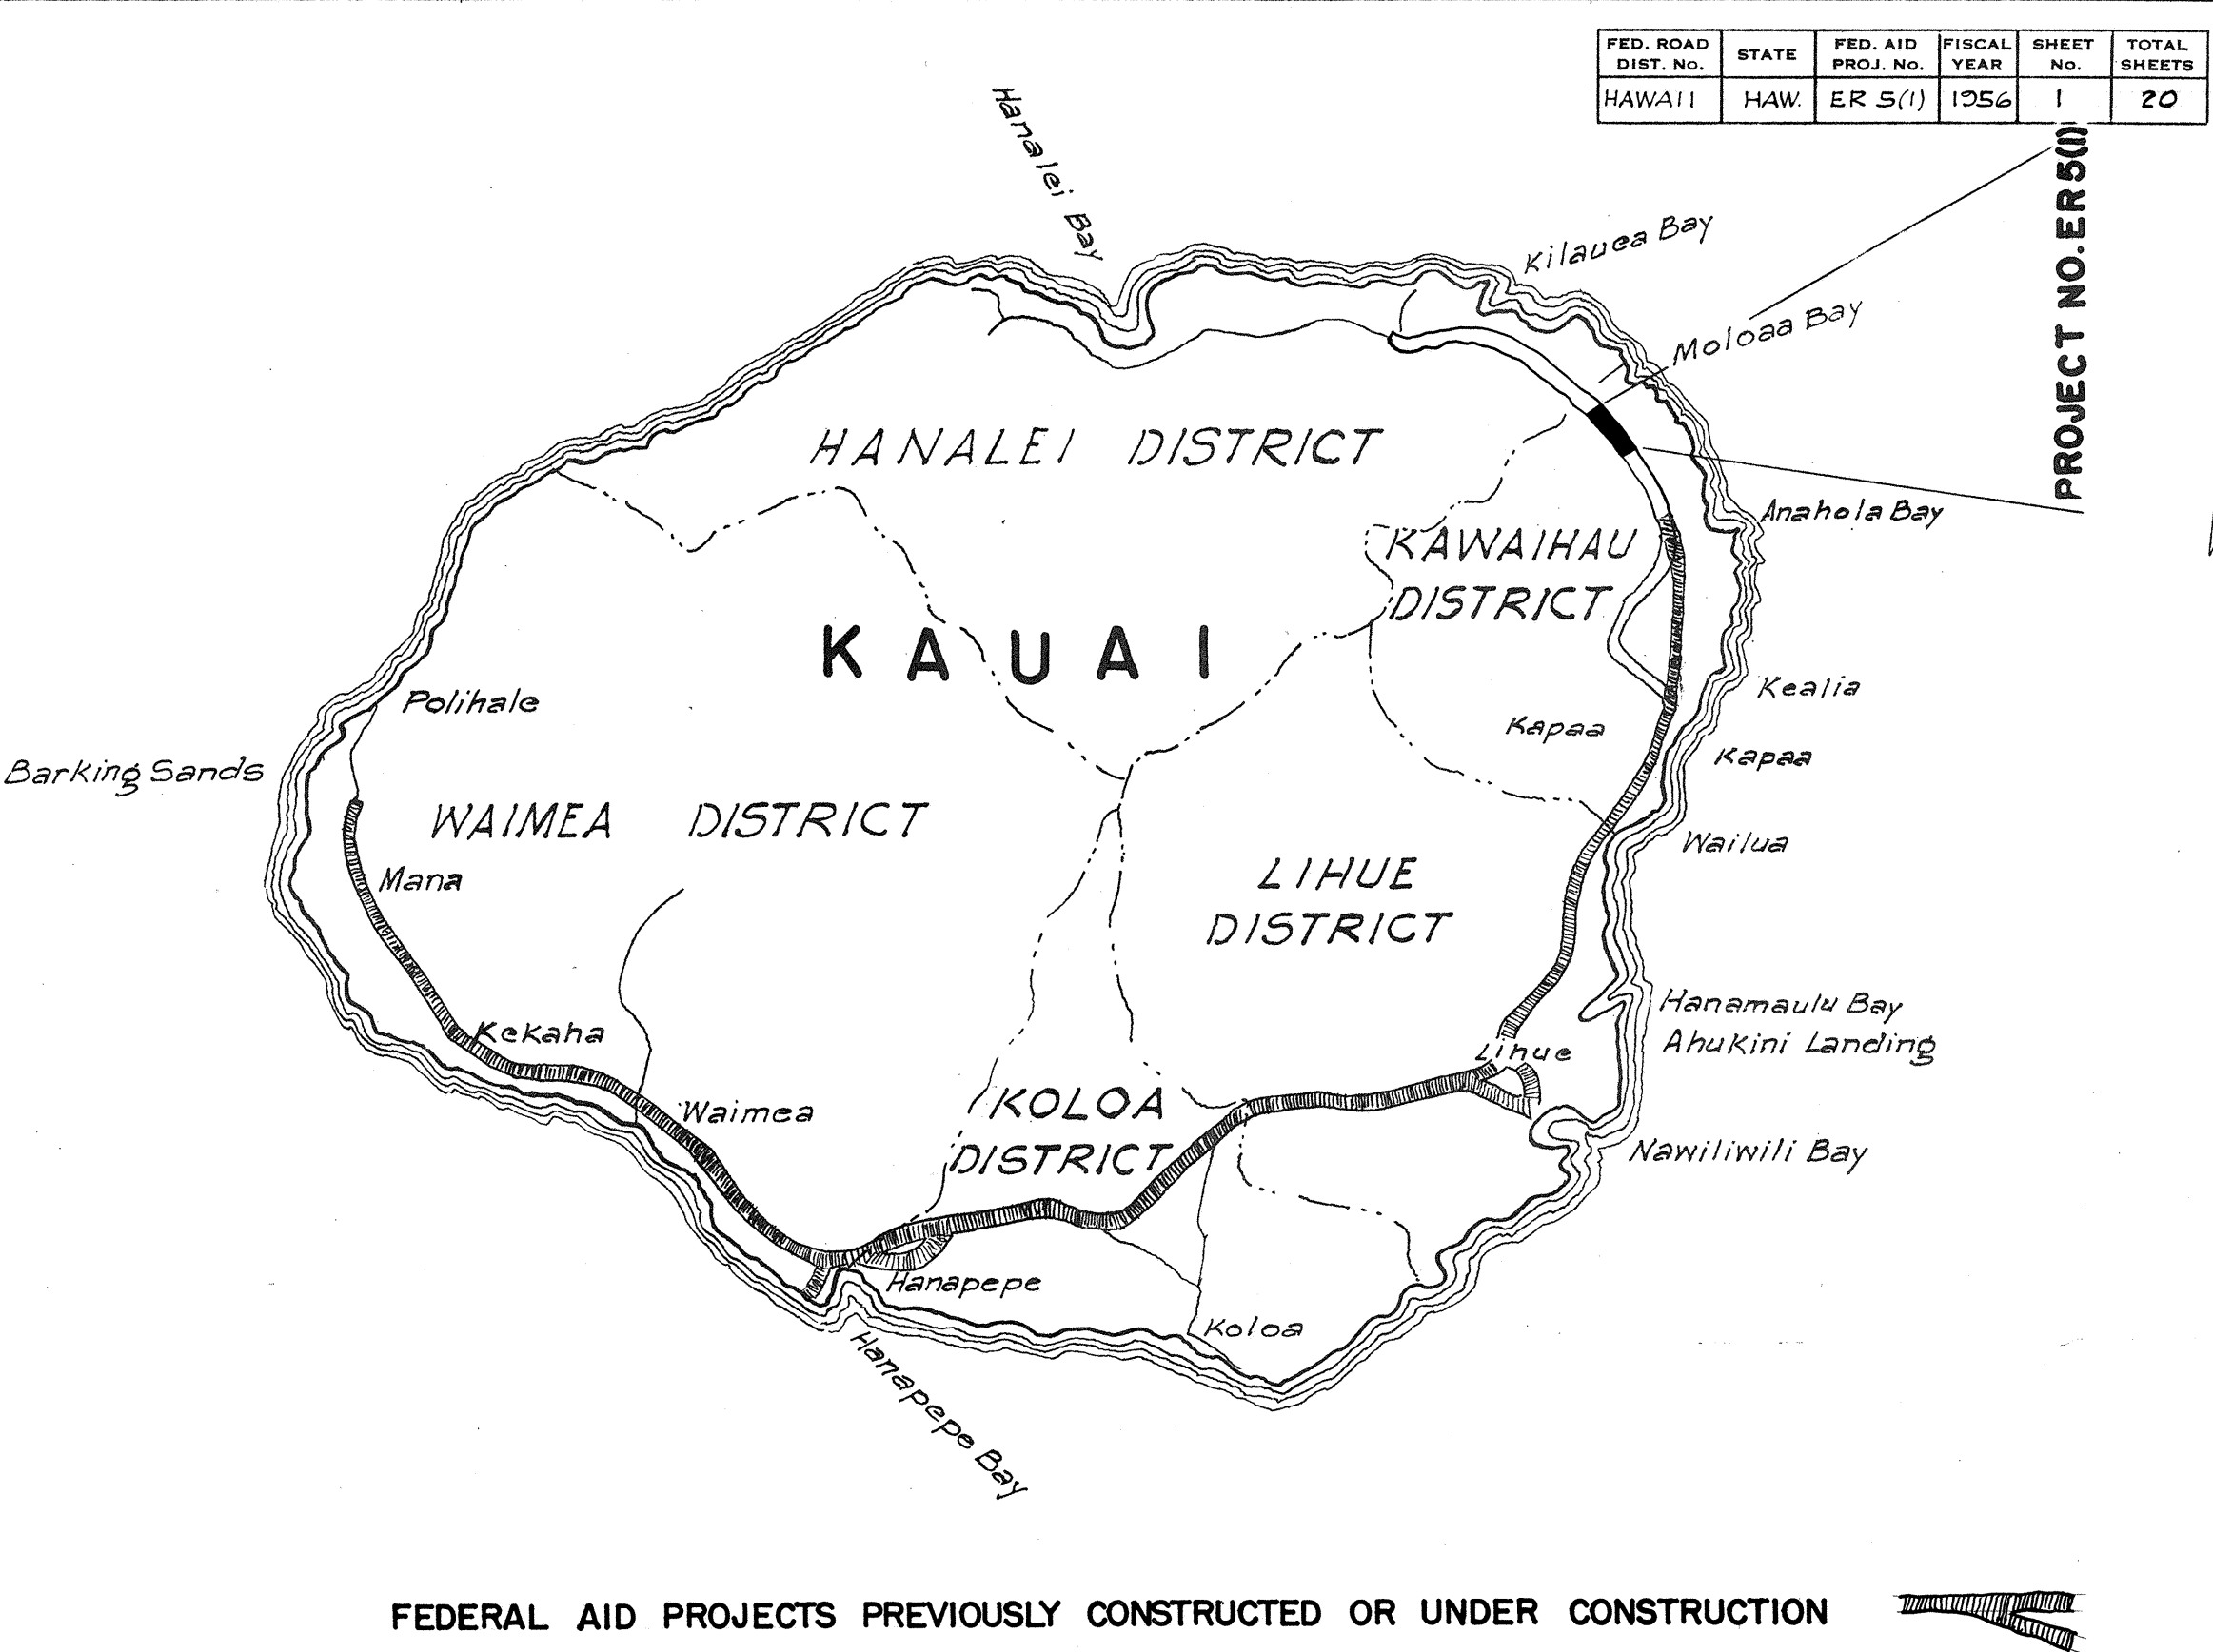

NOTE:

ALL CHANGES MADE DURING CONSTRUCTION HAVE BEEN NOTED IN RED ON THESE TRACINGS AND CHECKED BY:

Ed Nakano

PROJECT ENGINEER

June 28, 1957

DATE

GROSS LENGTH OF PROJECT ----- 0.631 Mi.

BRIDGE OVER 20'-0" SPAN ----- 0.013 Mi.

NET LENGTH OF PROJECT ----- 0.618 Mi.

APPROVED: _____ DATE 4/12/56

Bruce E. Richter

TERRITORIAL HIGHWAY ENGINEER

DEPARTMENT OF COMMERCE

BUREAU OF PUBLIC ROADS

APPROVED: _____

DISTRICT ENGINEER

DATE