

FED. ROAD DIST. NO.	STATE	FED. AID PROJ. NO.	FISCAL YEAR	SHEET NO.	TOTAL SHEET
Hawaii	Haw	F-056(1)	1956	1	6

[illegible]

TERRITORY OF HAWAII
TERRITORIAL HIGHWAY DEPARTMENT
HONOLULU T. H.

"AS BUILT" PLANS OF

ROADSIDE LANDSCAPING OF

KAUAI BELT ROAD



(KEALIA TO ANAHOLA)

FEDERAL AID PROJECT NO. F 056-1(I)

DISTRICT OF KAWAIHAU

ISLAND OF KAUAI

SCALE : AS NOTED

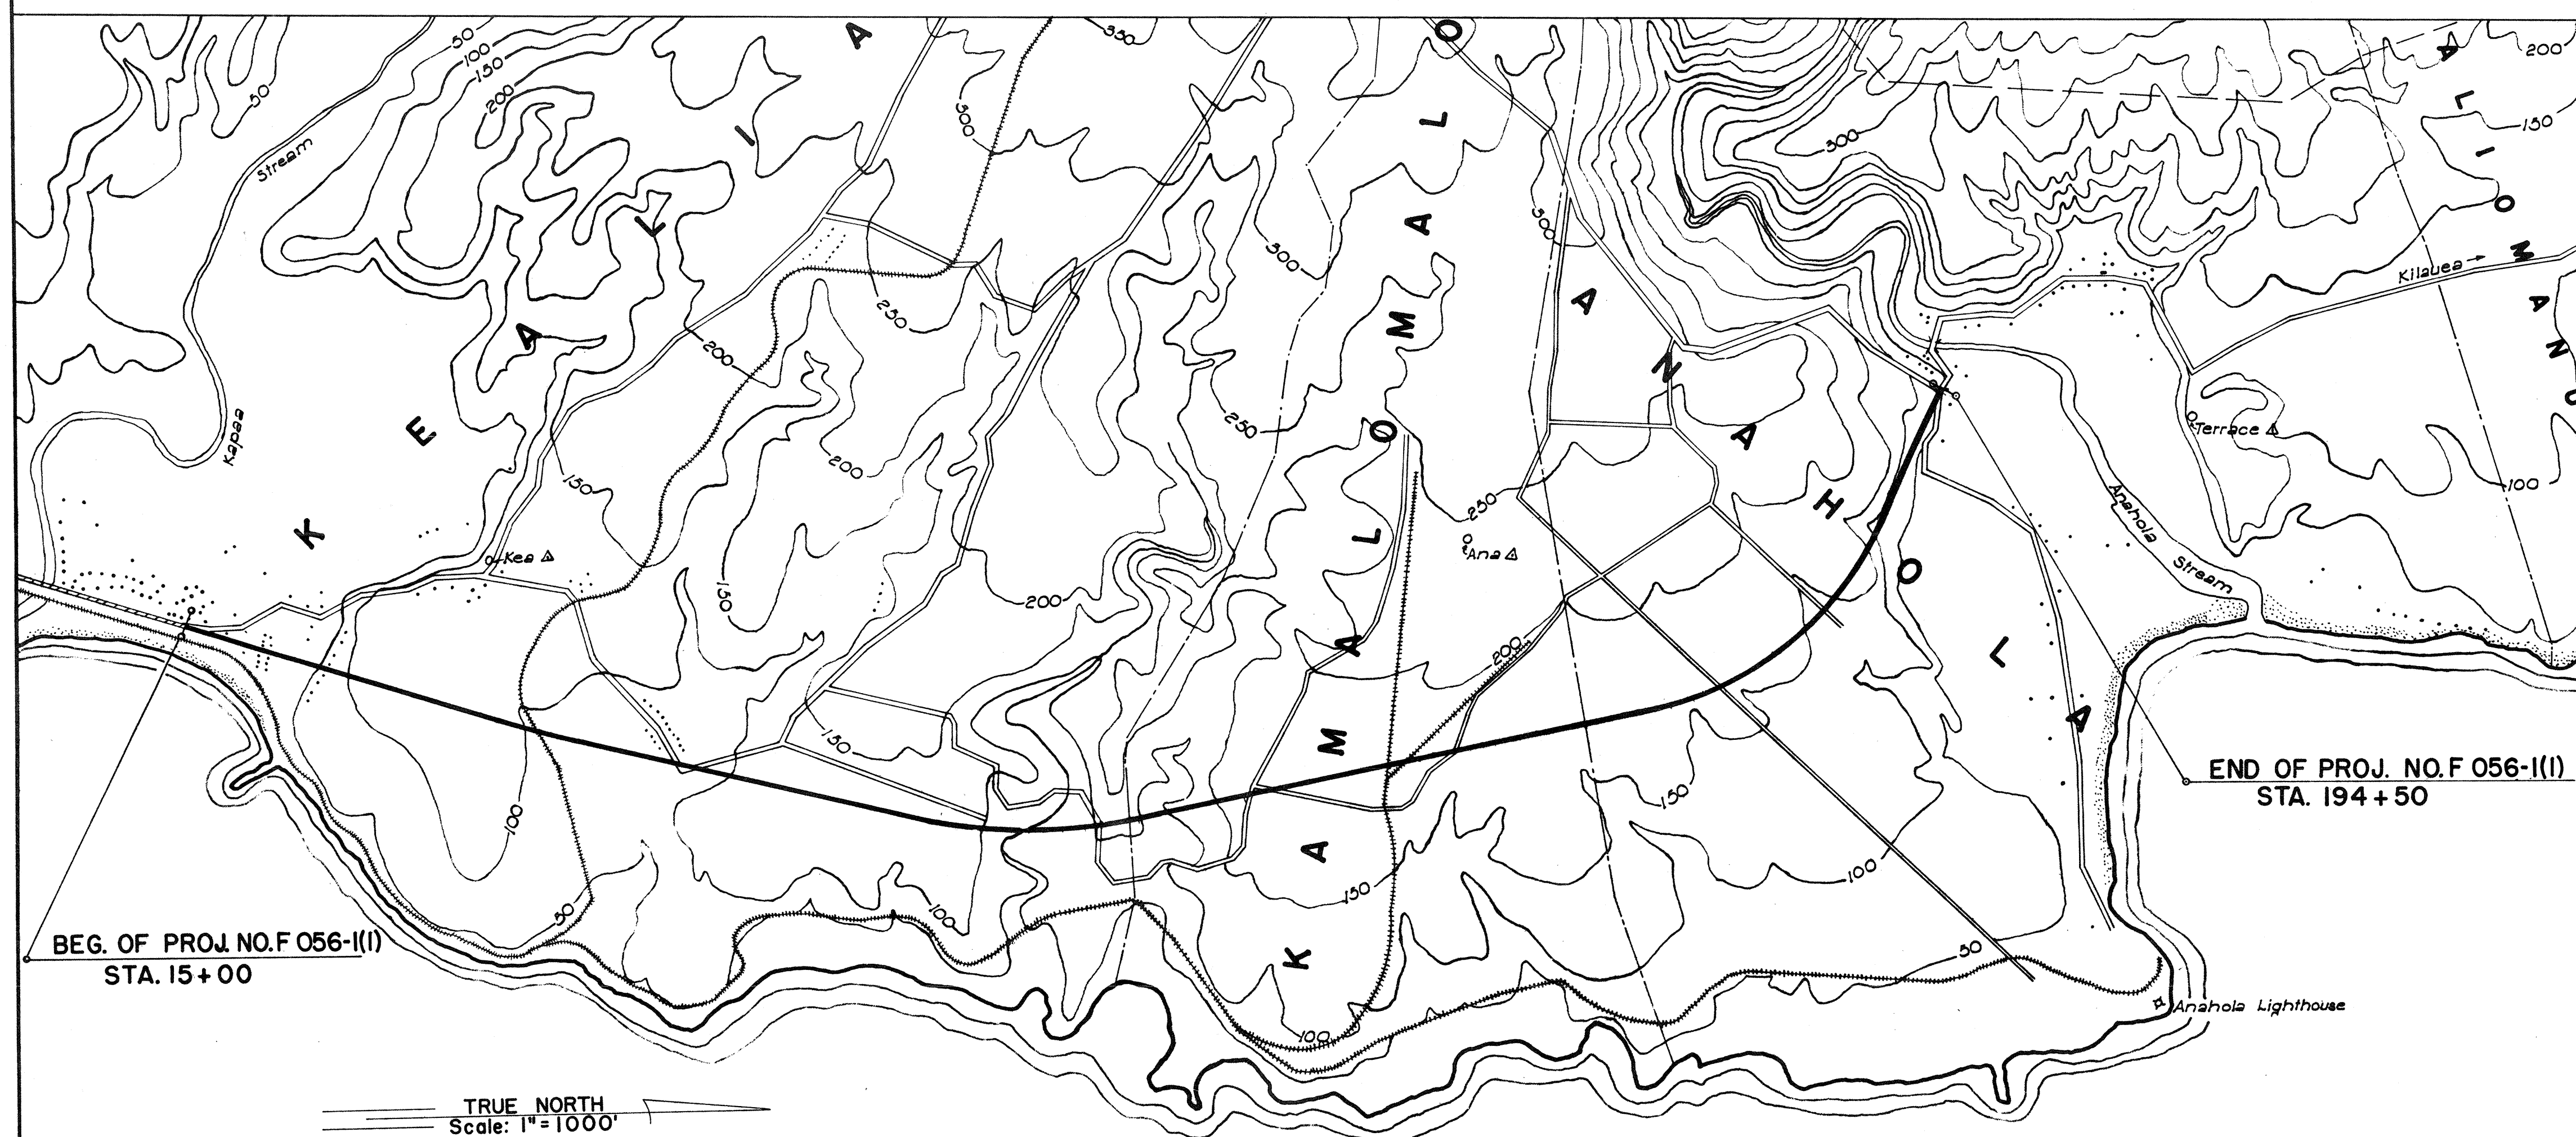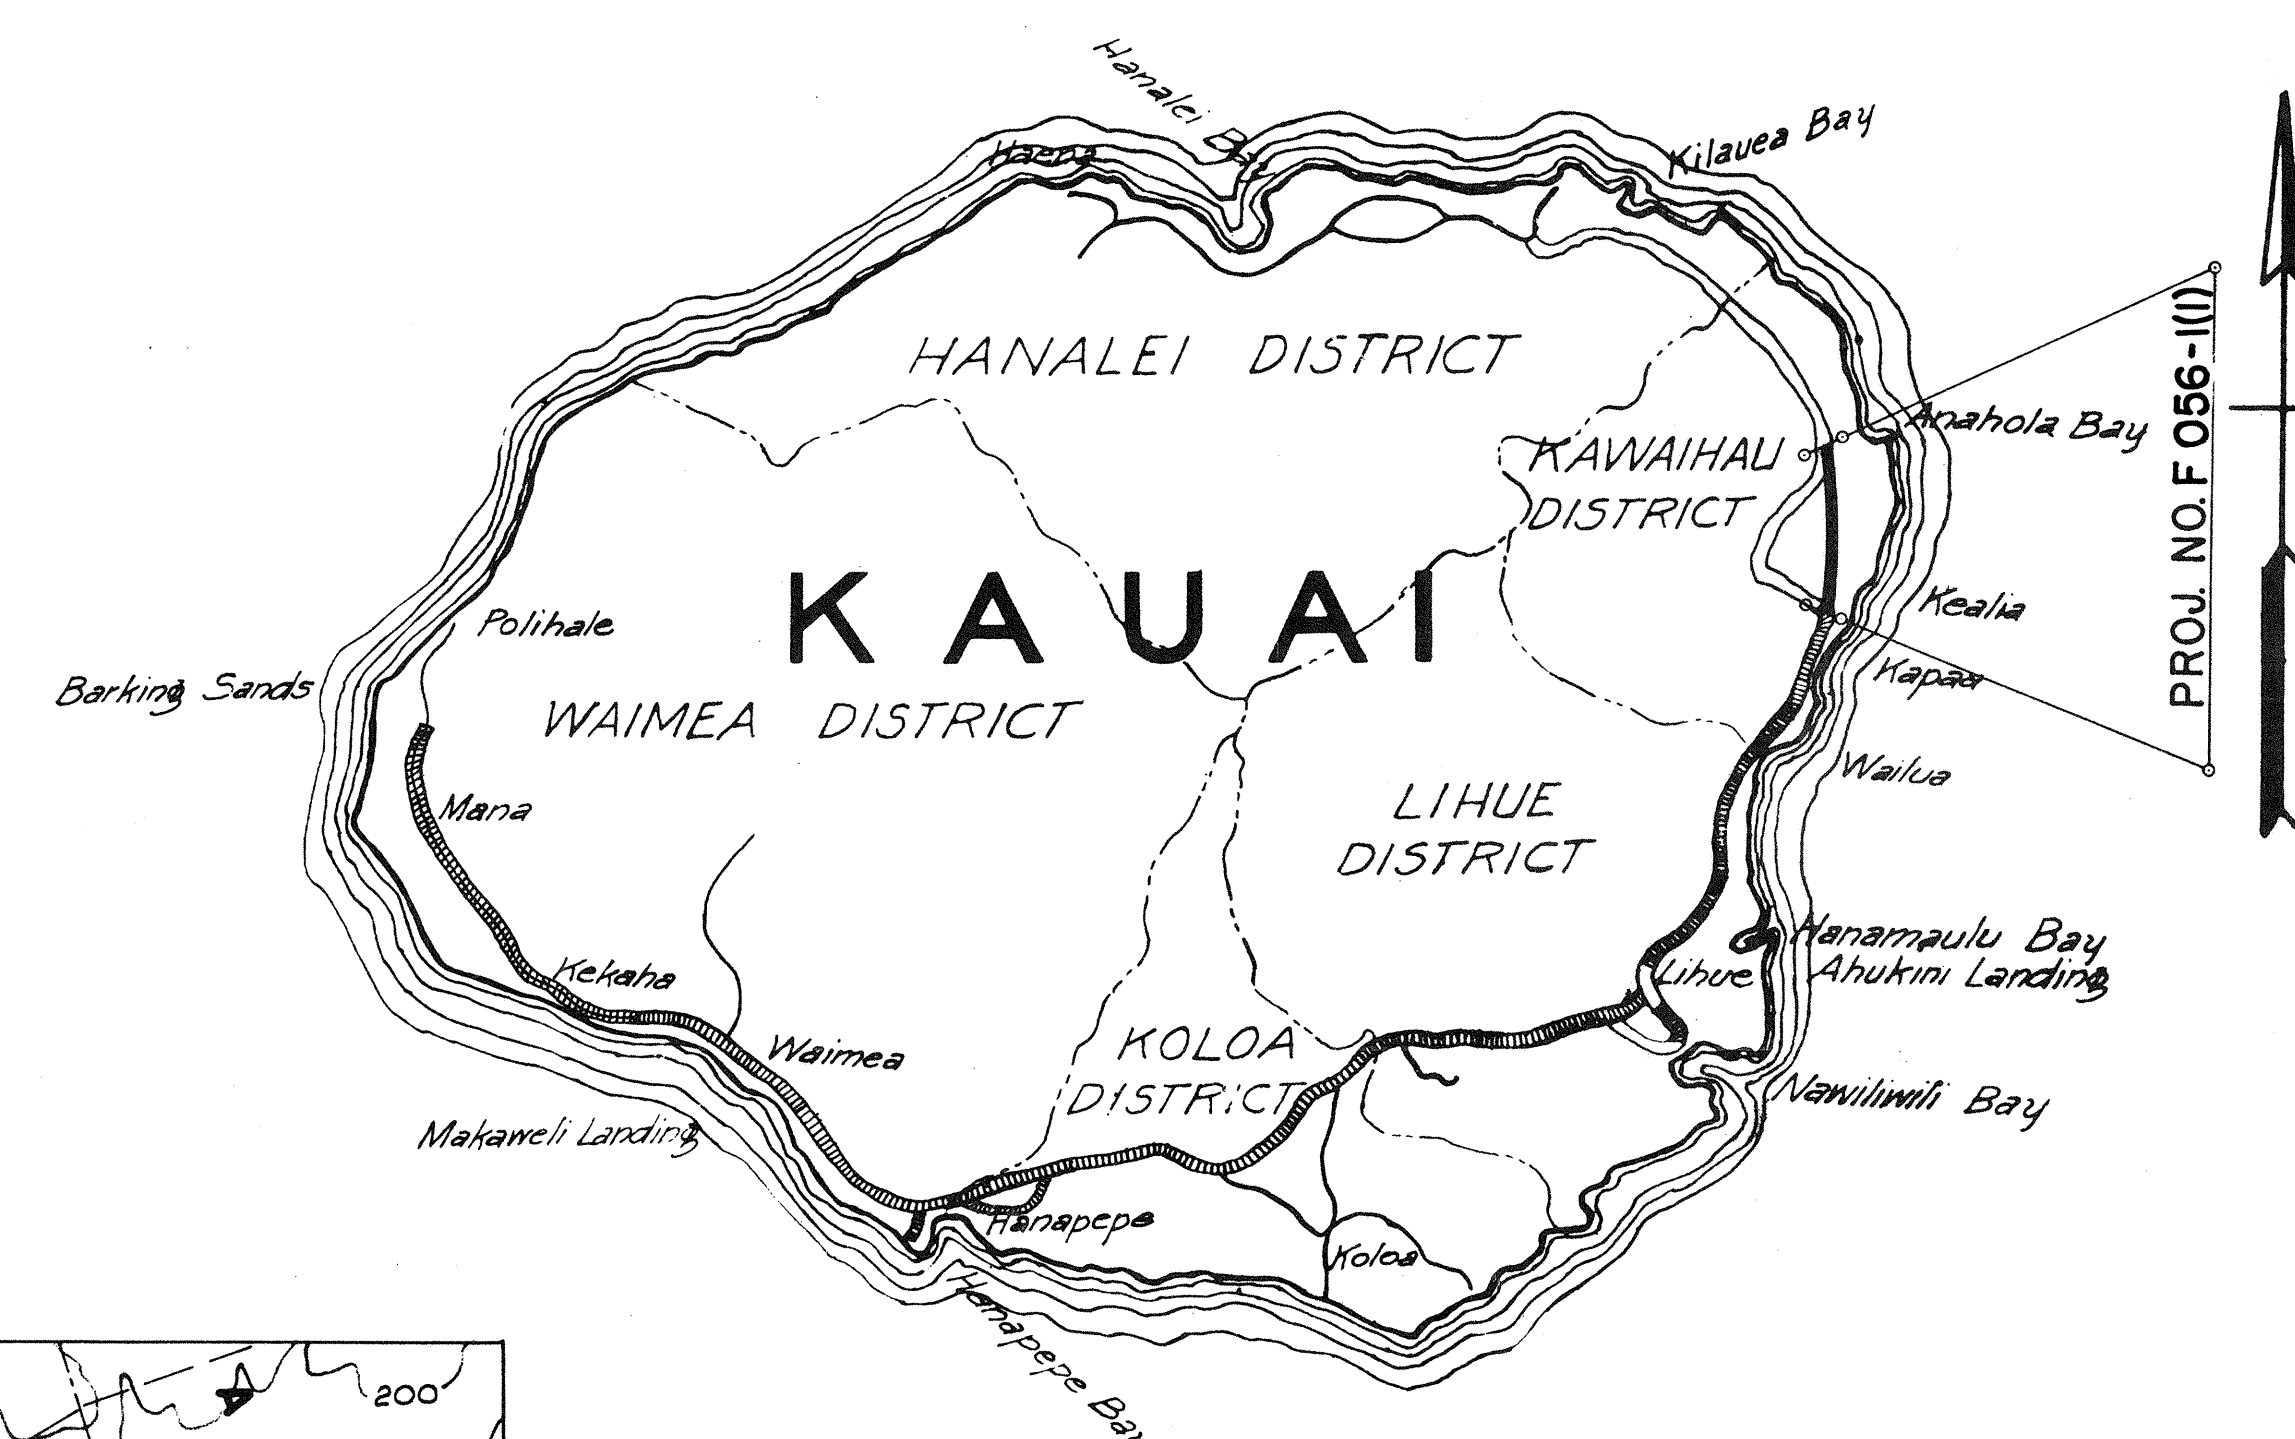

NOTE:

ALL CHANGES MADE DURING CONSTRUCTION
HAVE BEEN NOTED IN RED ON THESE TRACINGS
AND CHECKED BY:

Masami Murakami
RESIDENT ENGINEER

DATE Jan. 14, 195

END OF PROJ. NO.F 056-1(1)
STA. 194 + 50

BEG. OF PROJ. NO. F 056-1(1)
STA. 15+00

LAYOUT OF PROJECT

SCALE: 1"=1000'

GROSS AND NET LENGTH OF ROADWAY = 3.400 MILES

APPROVED : DATE .. 12 / 4 / 56

Bern E. Neether
TERRITORIAL HIGHWAY ENGINEER

DEPARTMENT OF COMMERCE
BUREAU OF PUBLIC ROADS

APPROVED:

DISTRICT ENGINEER DATE _____

5878.01