

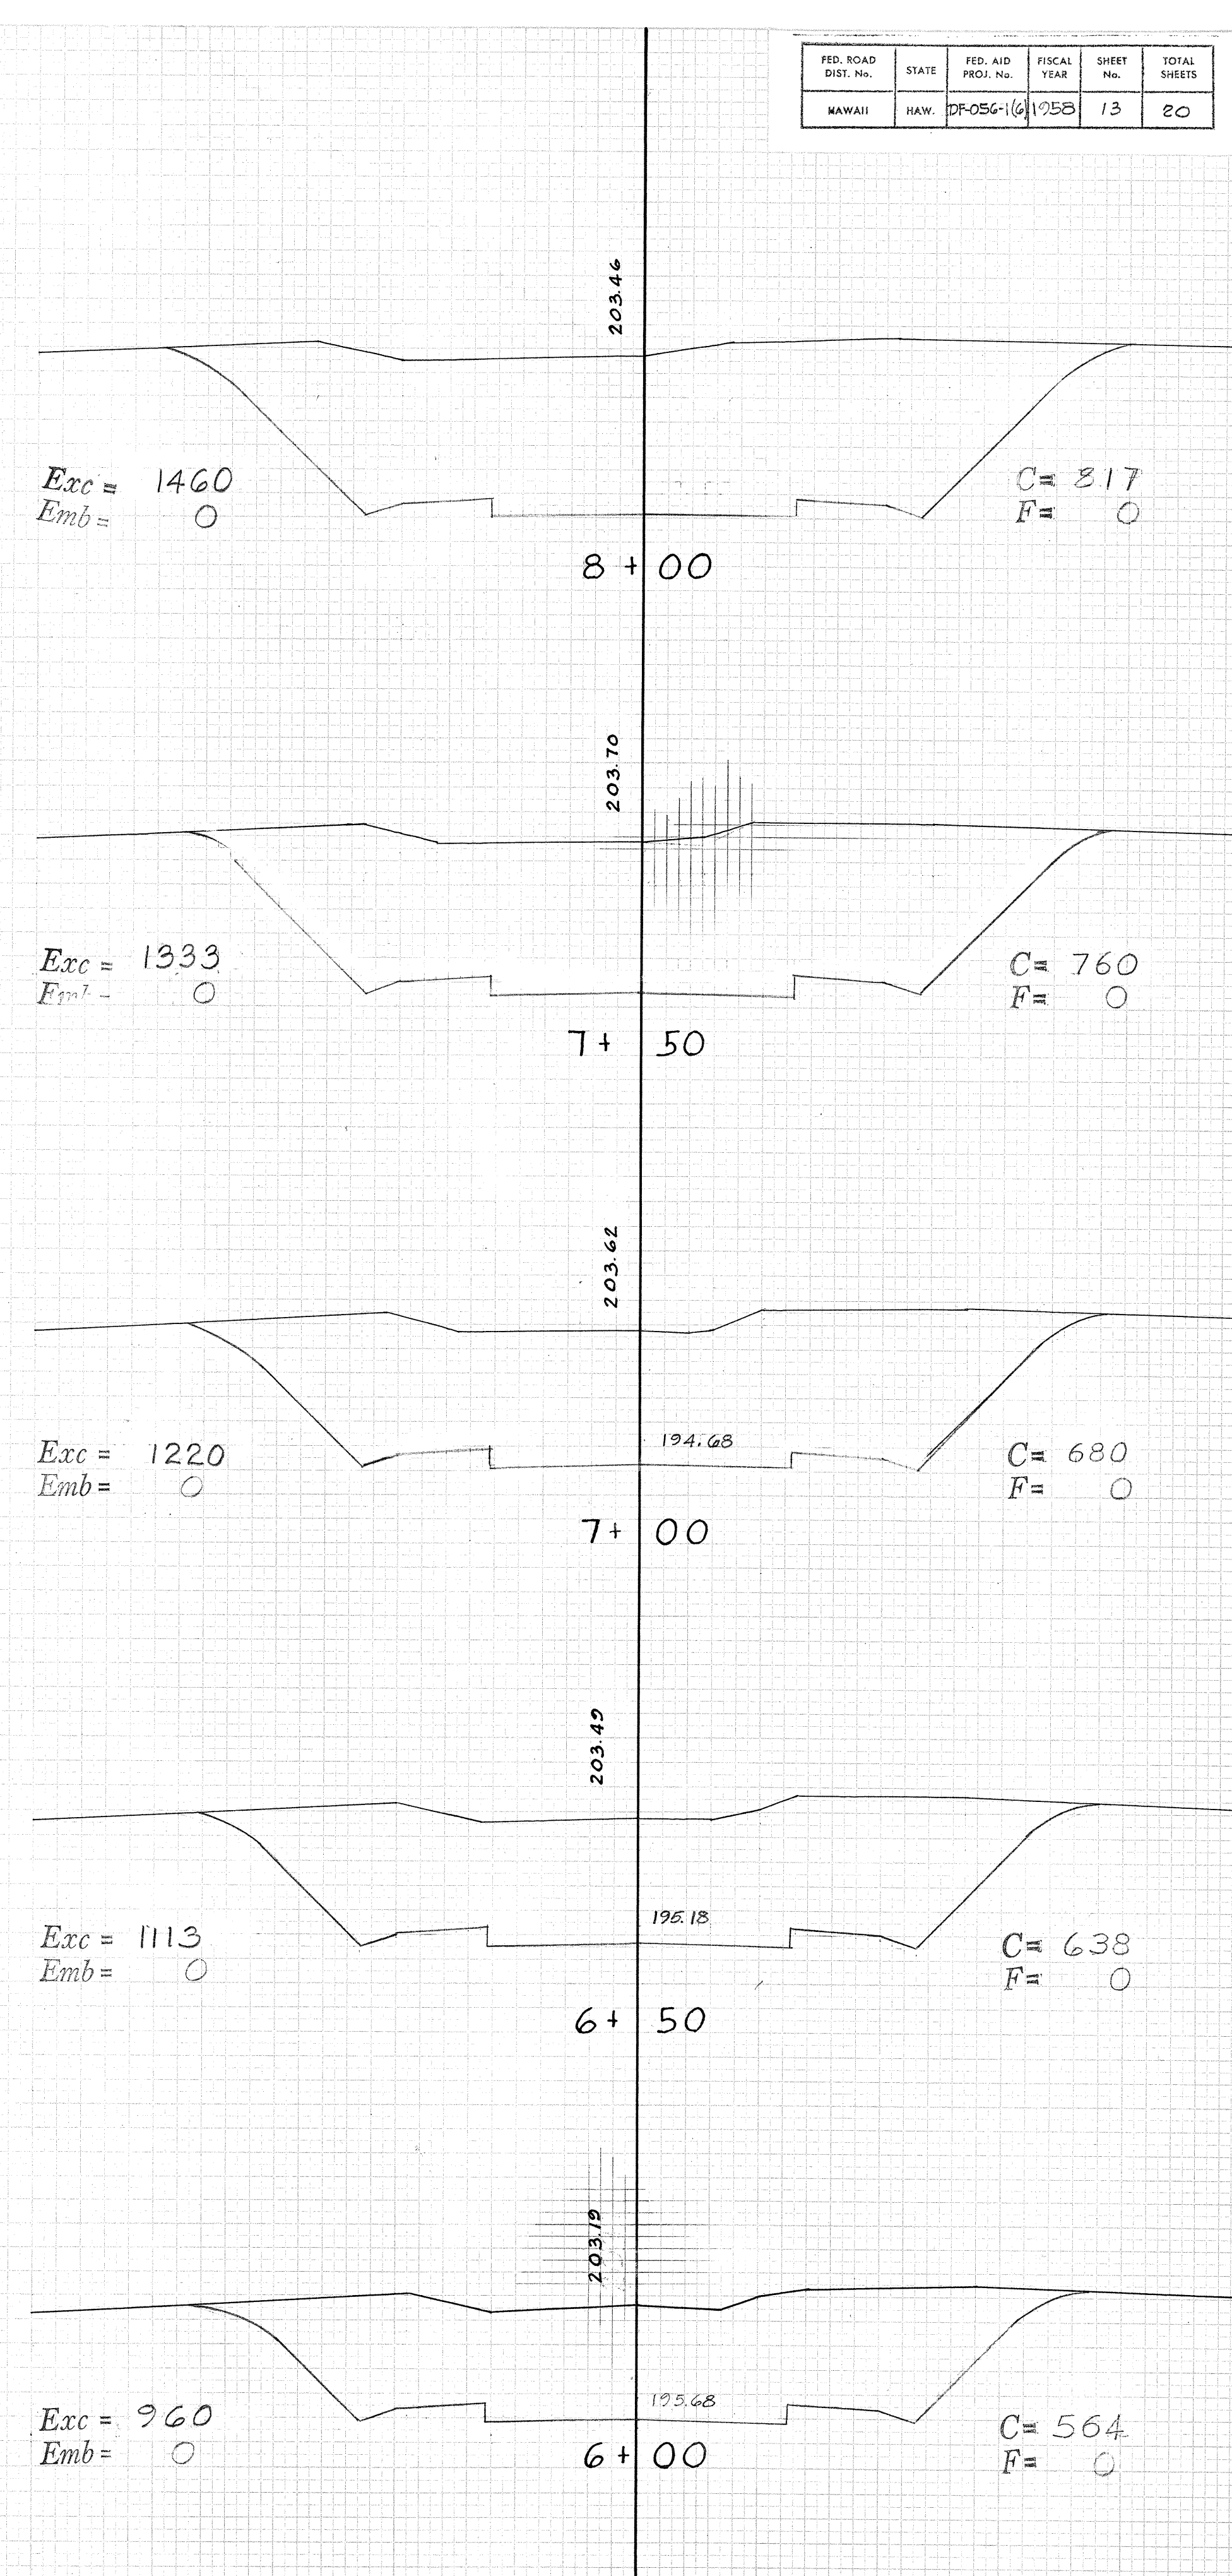
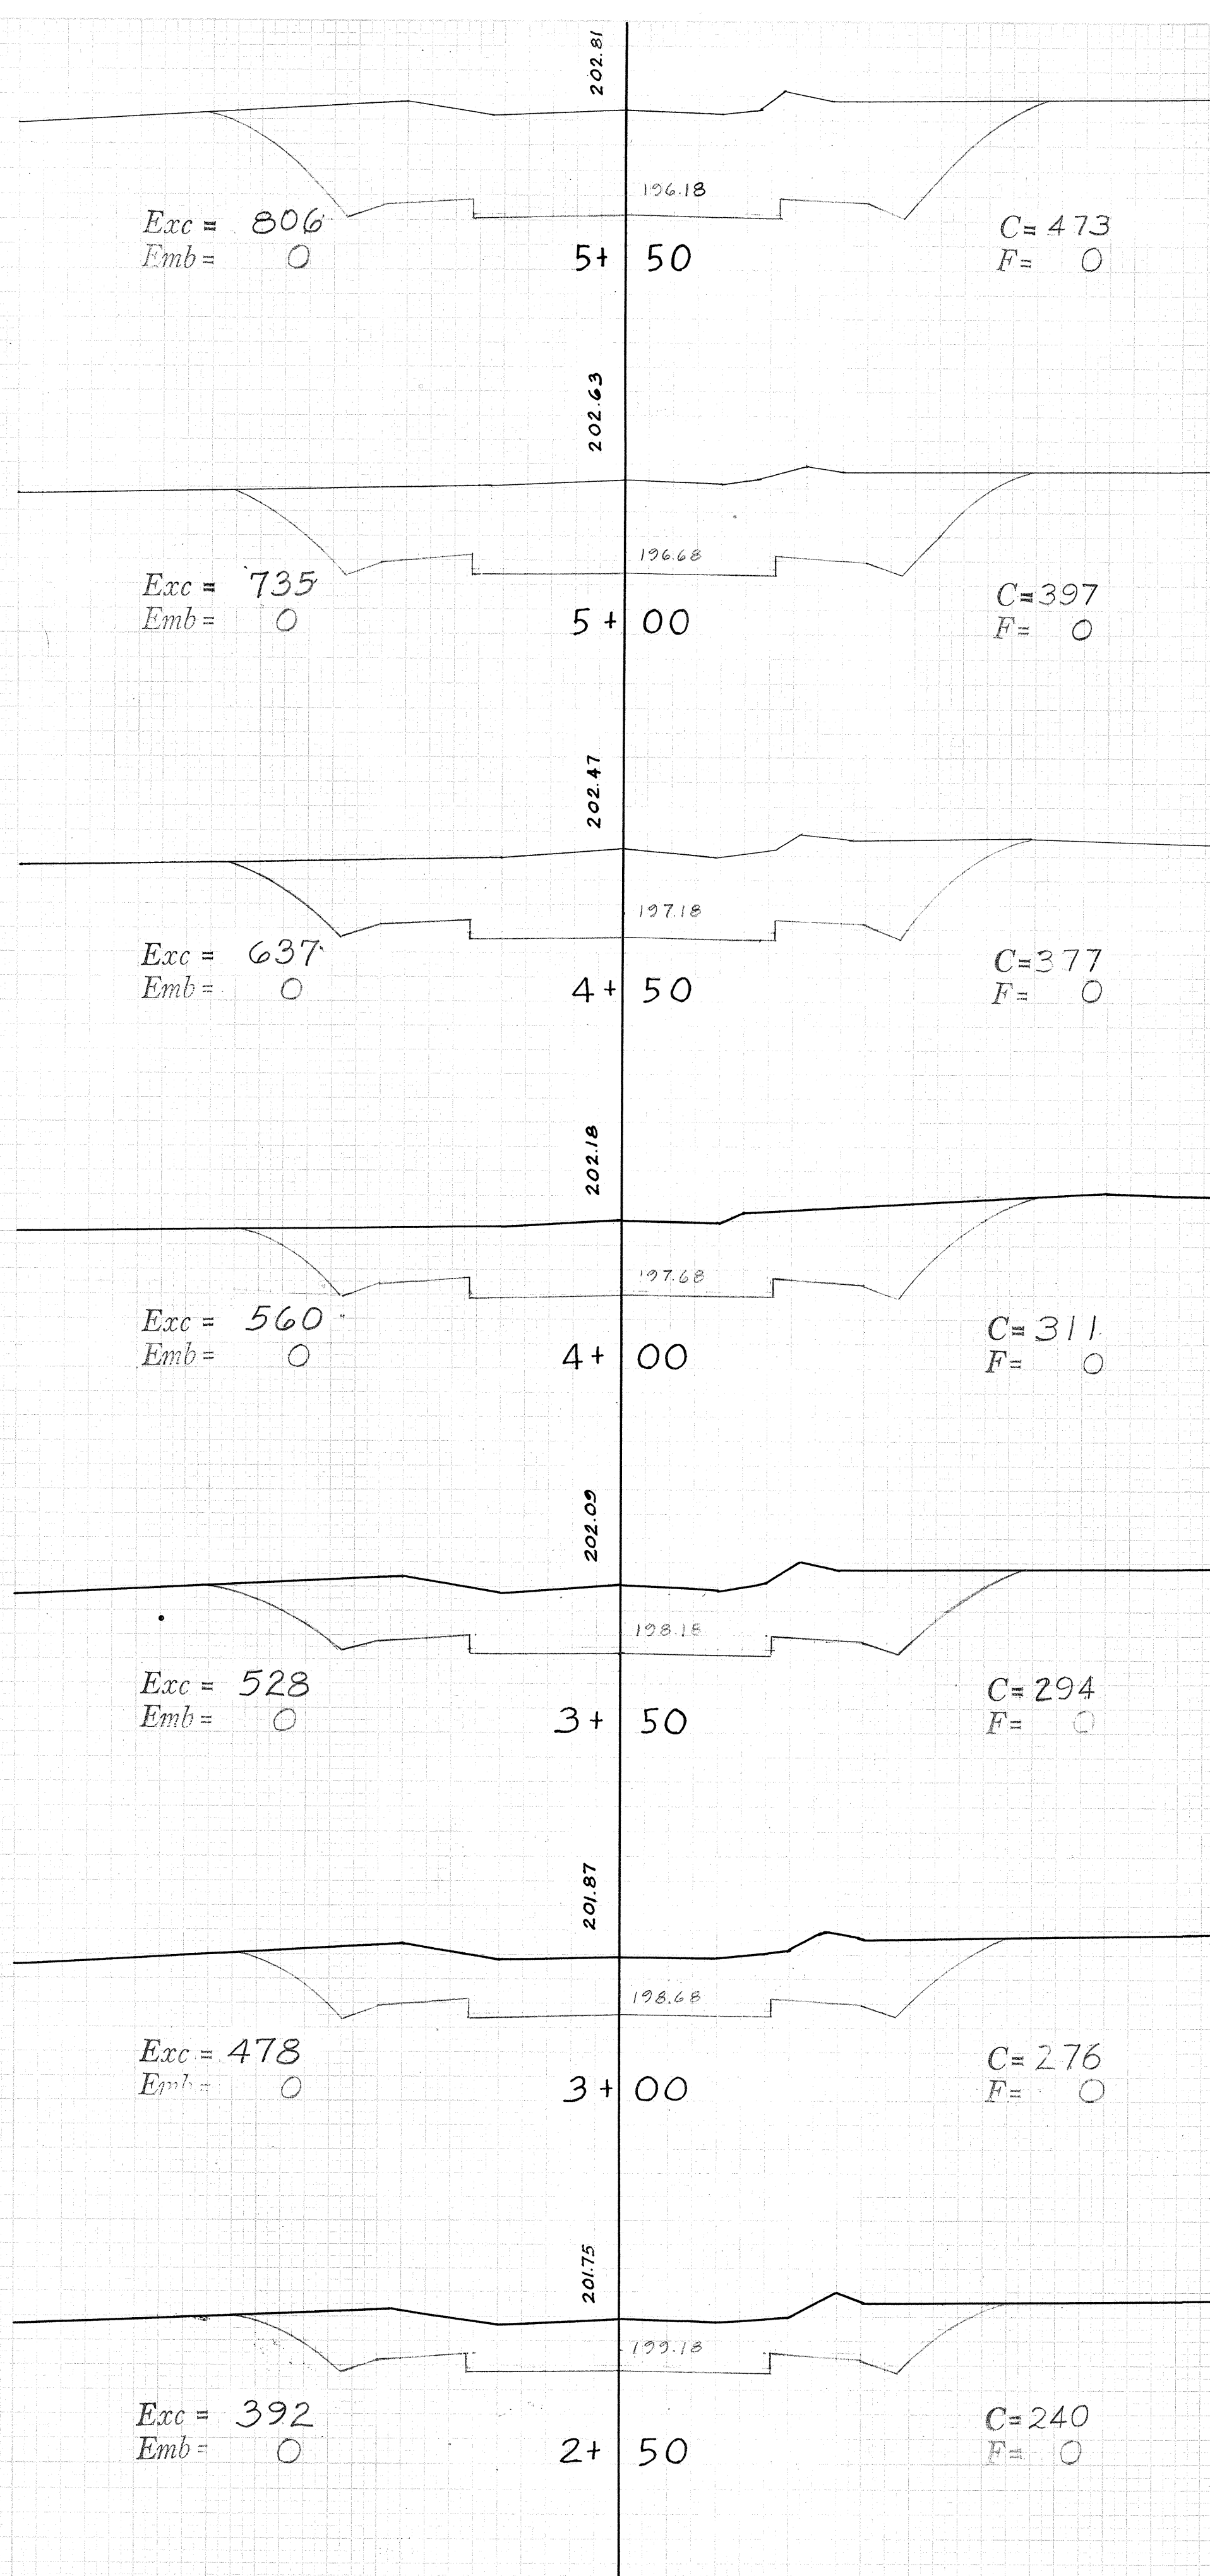
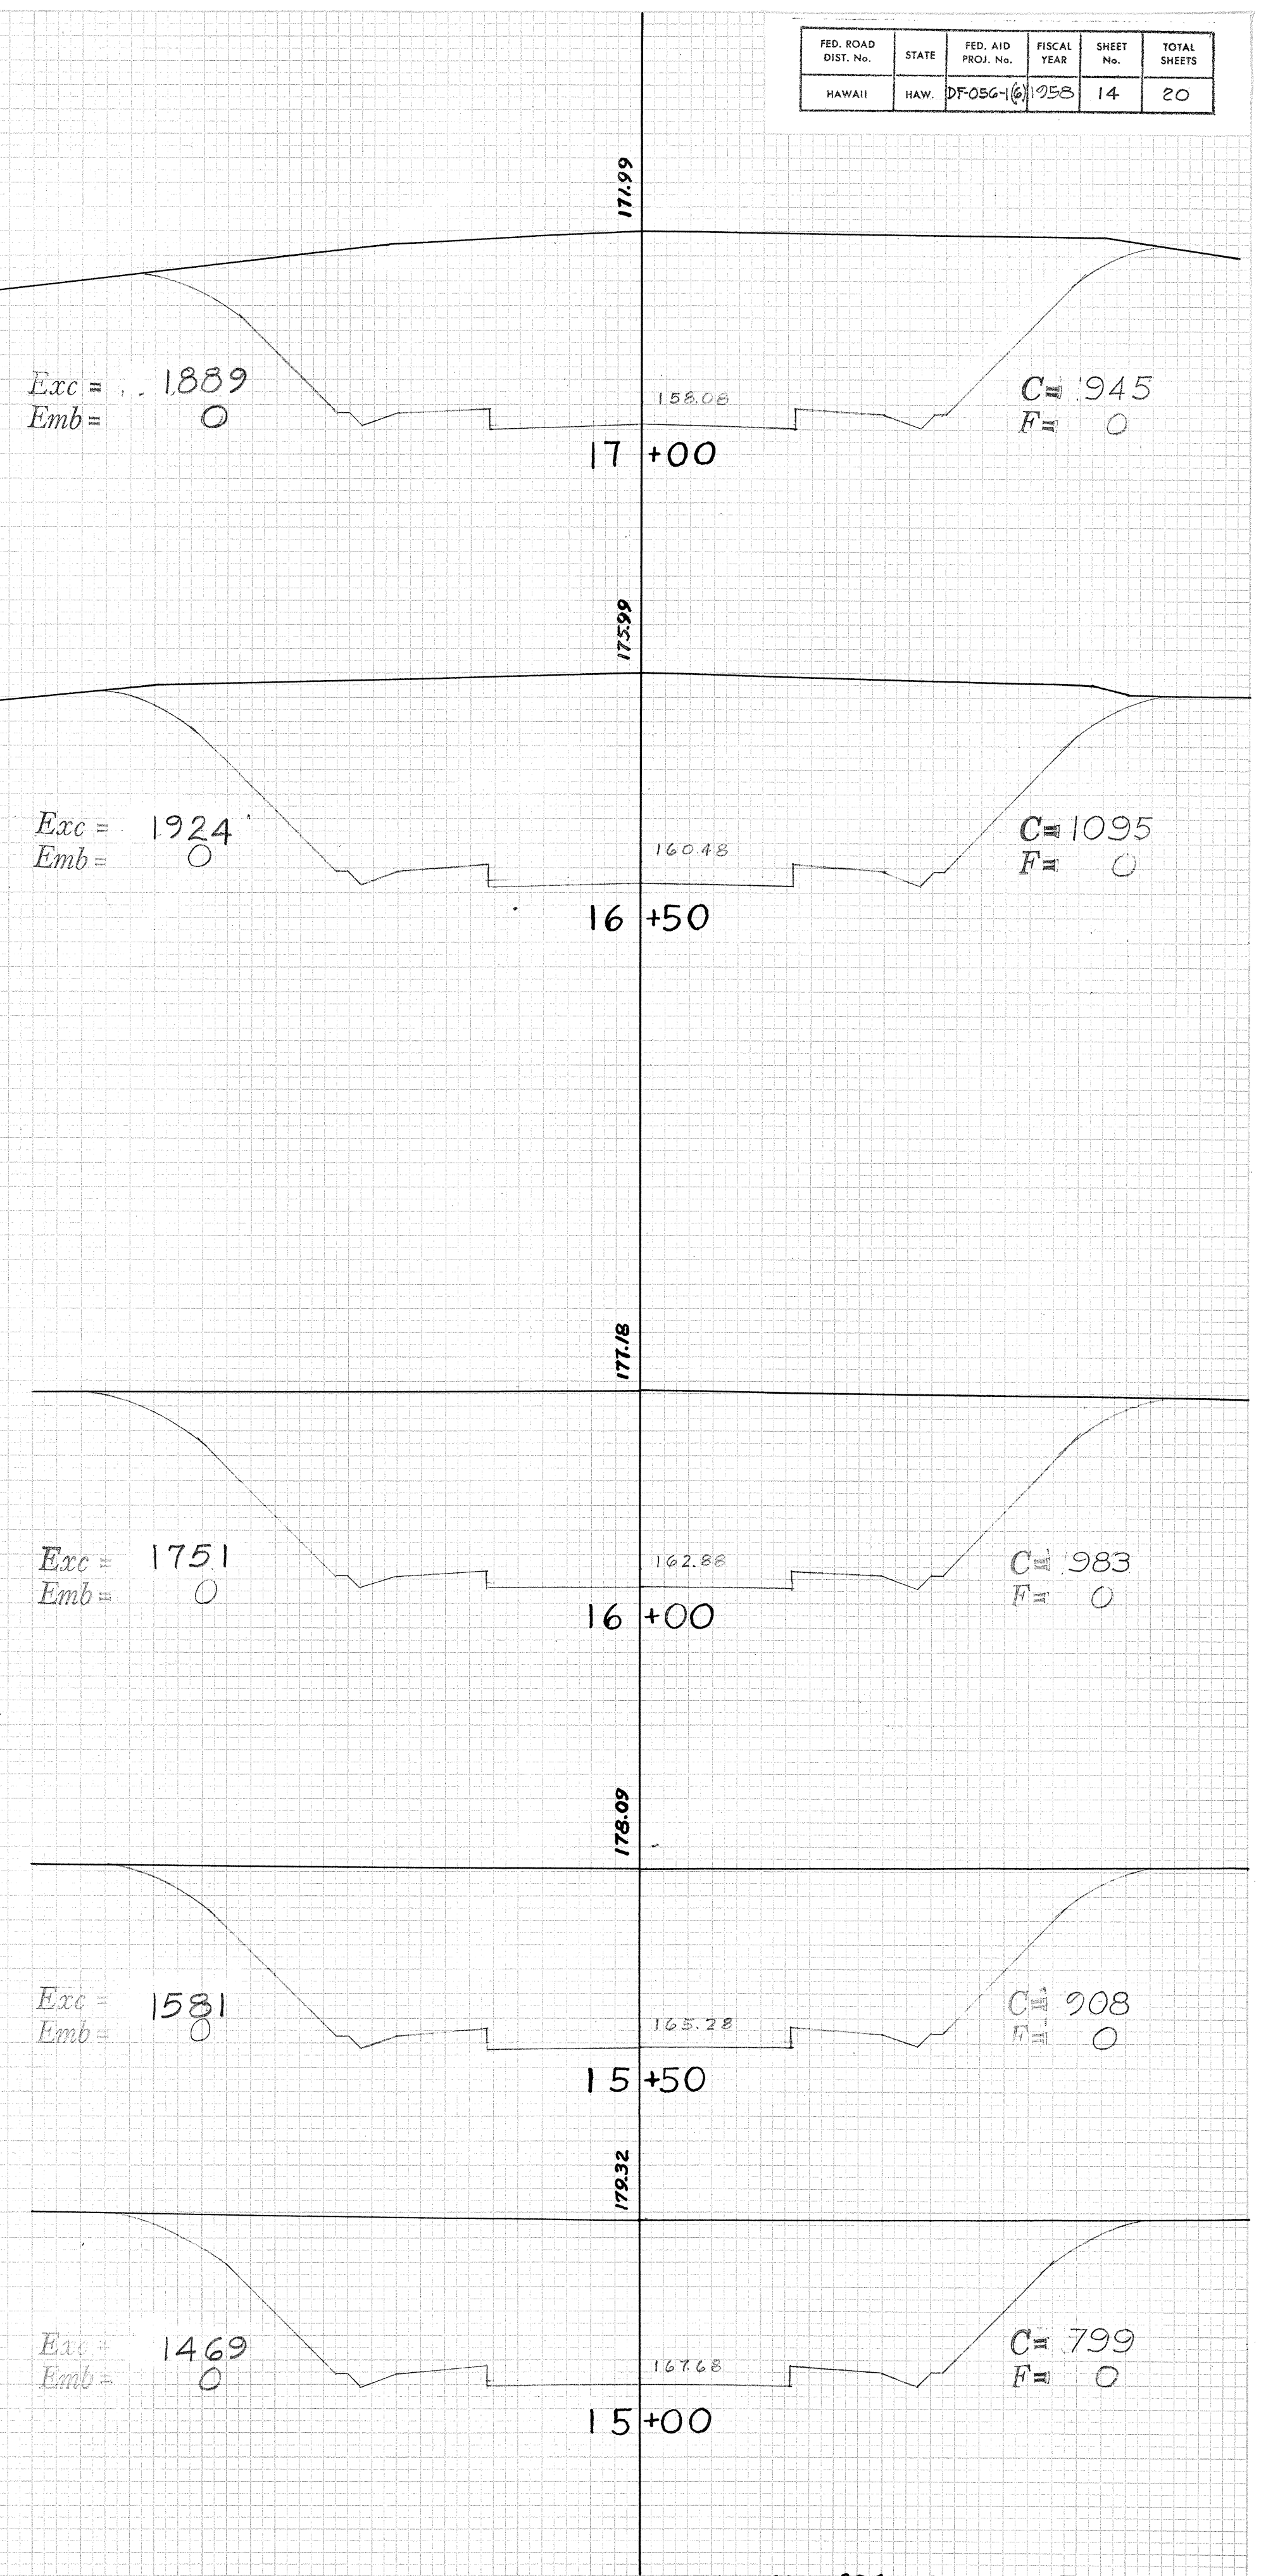


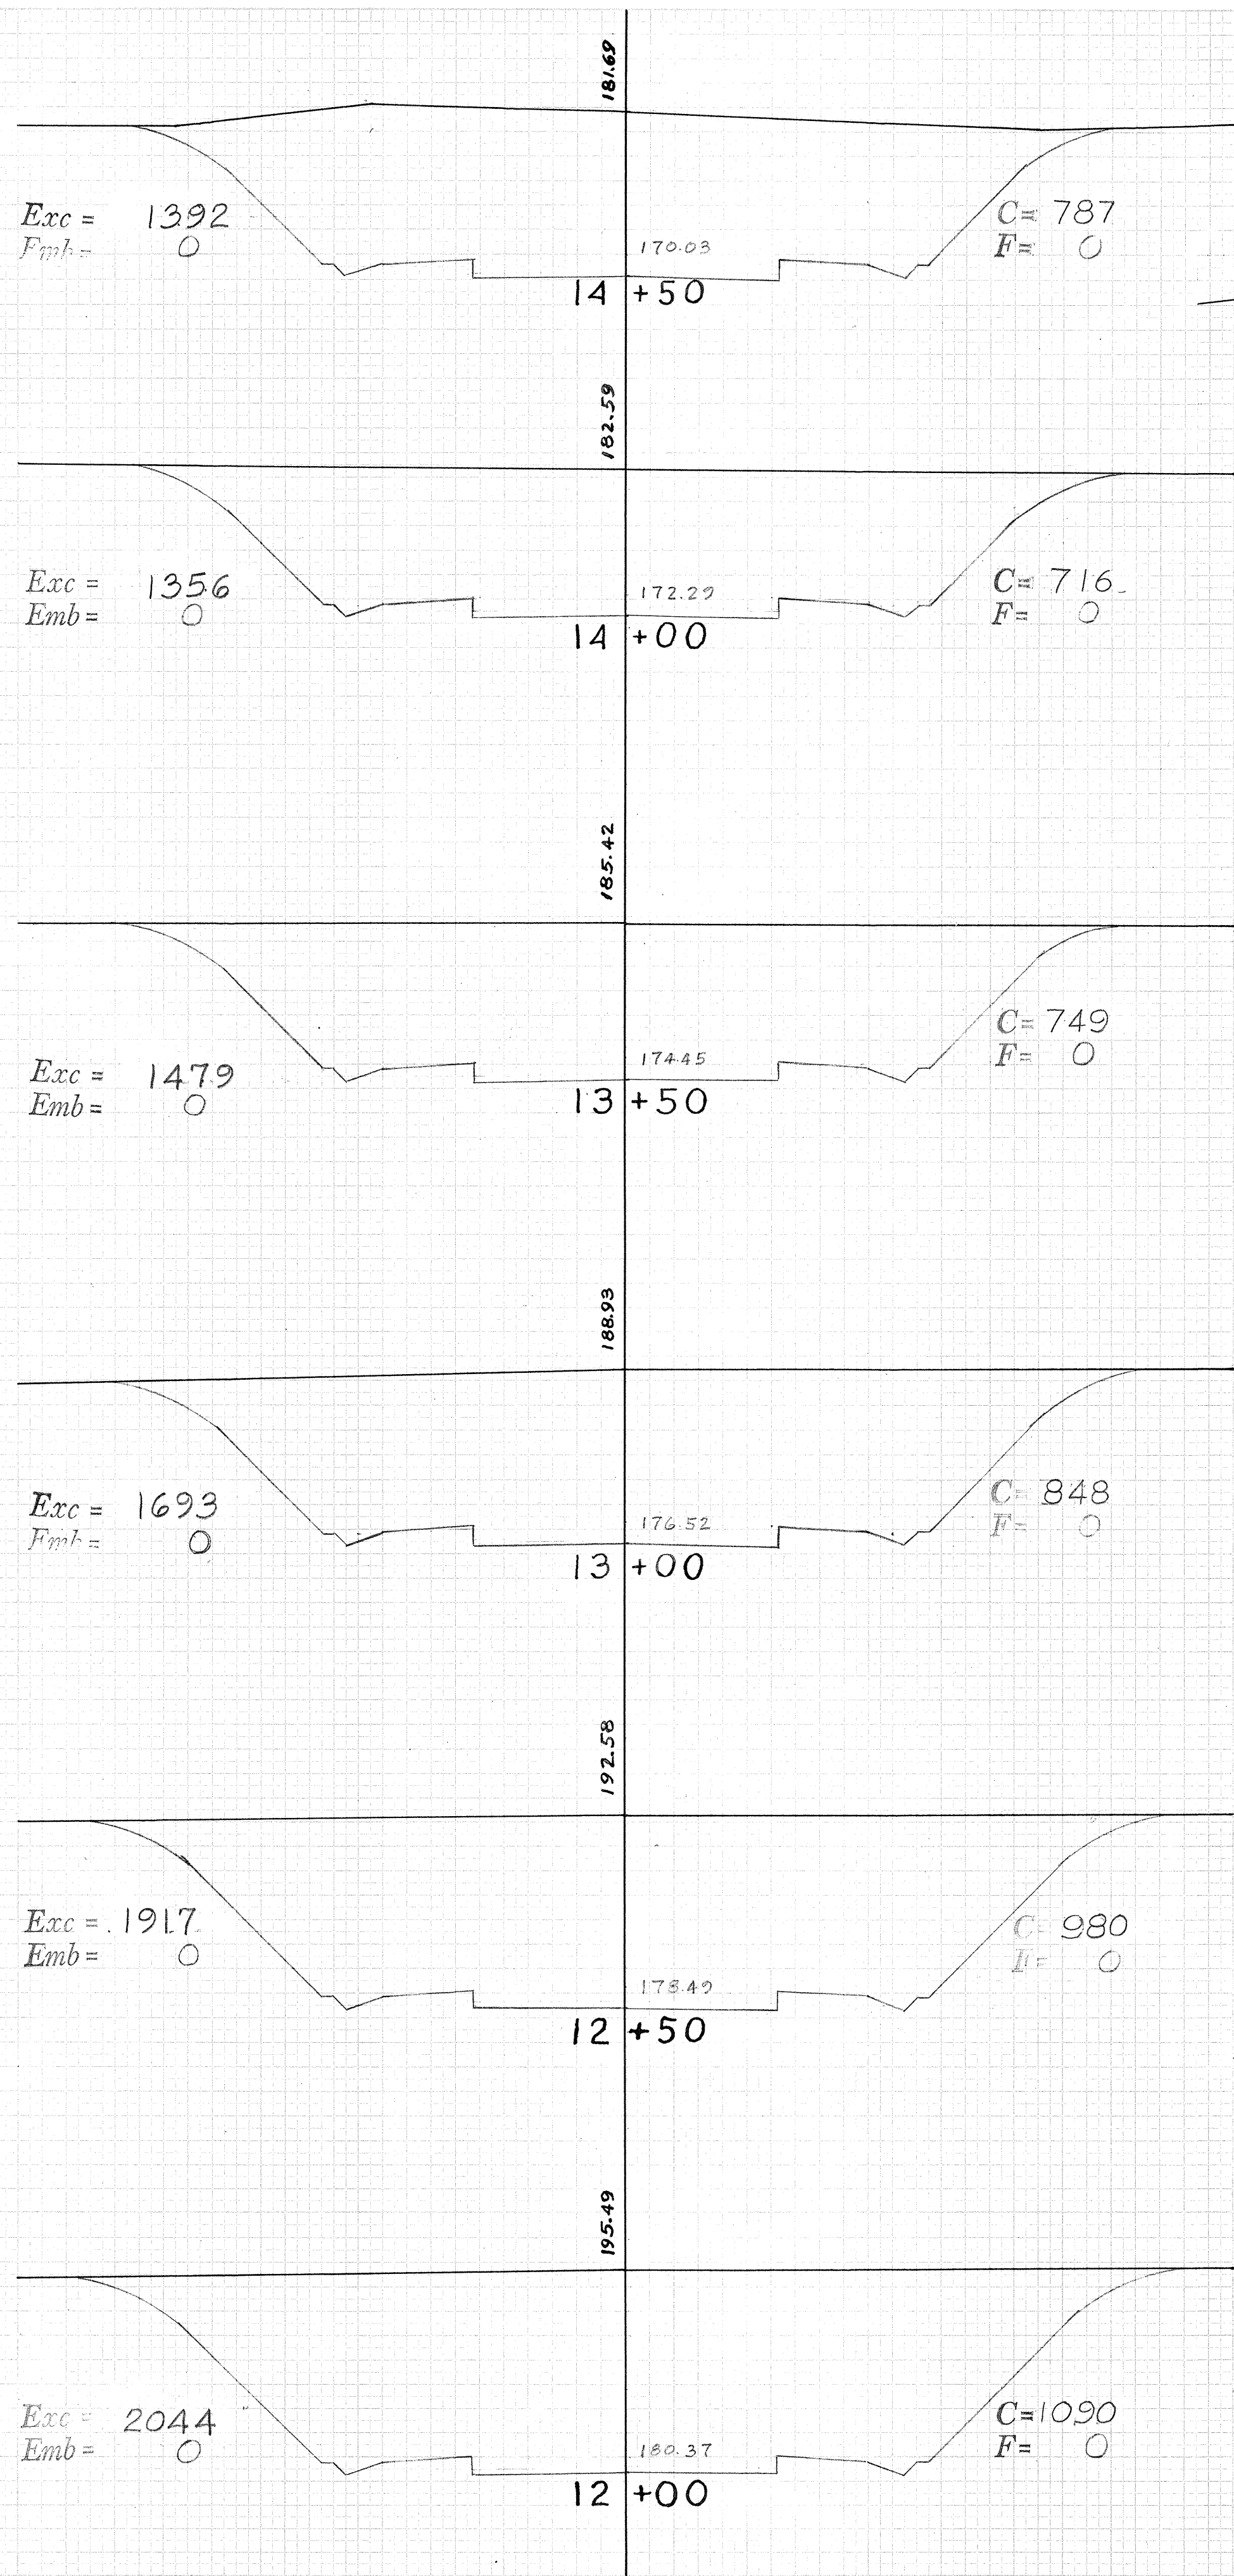

FED. ROAD DIST. No.	STATE	FED. AID PROJ. No.	FISCAL YEAR	SHEET No.	TOTAL SHEETS
HAWAII	HAW.	DF-056-16	1953	14	20

DATE	BY
DATE	BY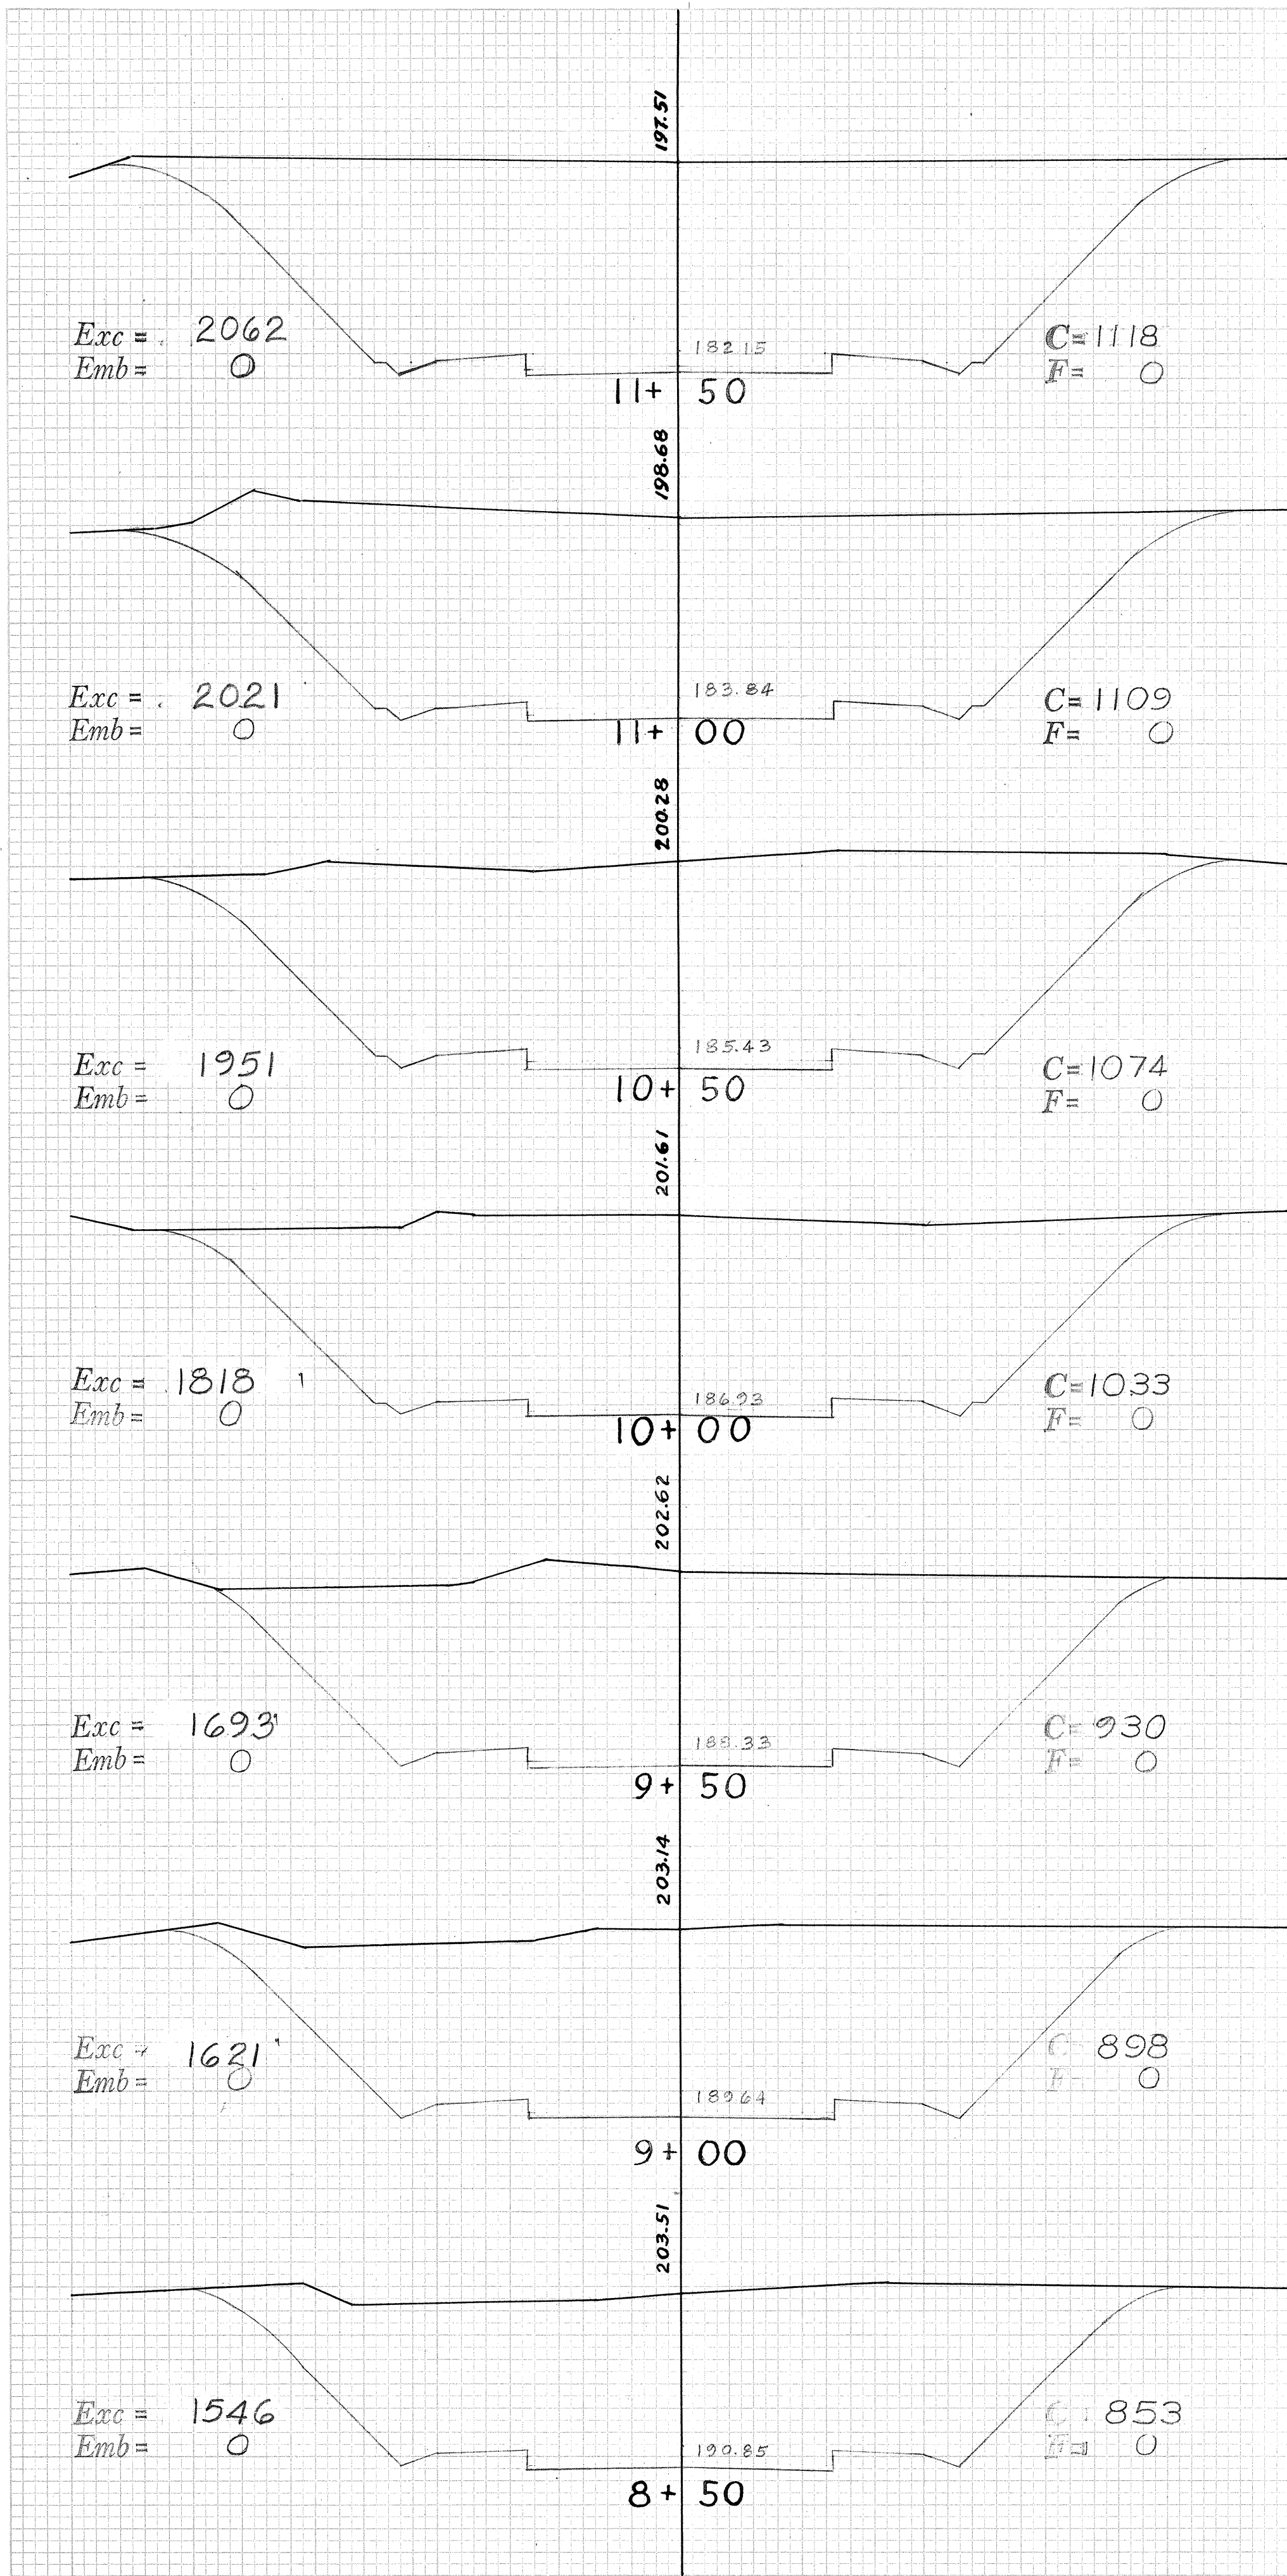
FED. ROAD DIST. No.	STATE	FED. AID PROJ. No.	FISCAL YEAR	SHEET No.	TOTAL SHEETS
HAWAII	HAW.	DF-056-16	1955	15	20

DATE	BY	FINAL SURVEY	NO.
		NO. 1	
		NO. 2	
		NO. 3	
		NO. 100	

DATE	BY	ORIGINAL SURVEY	NO.
		NO. 1	
		NO. 2	
		NO. 3	
		NO. 100	

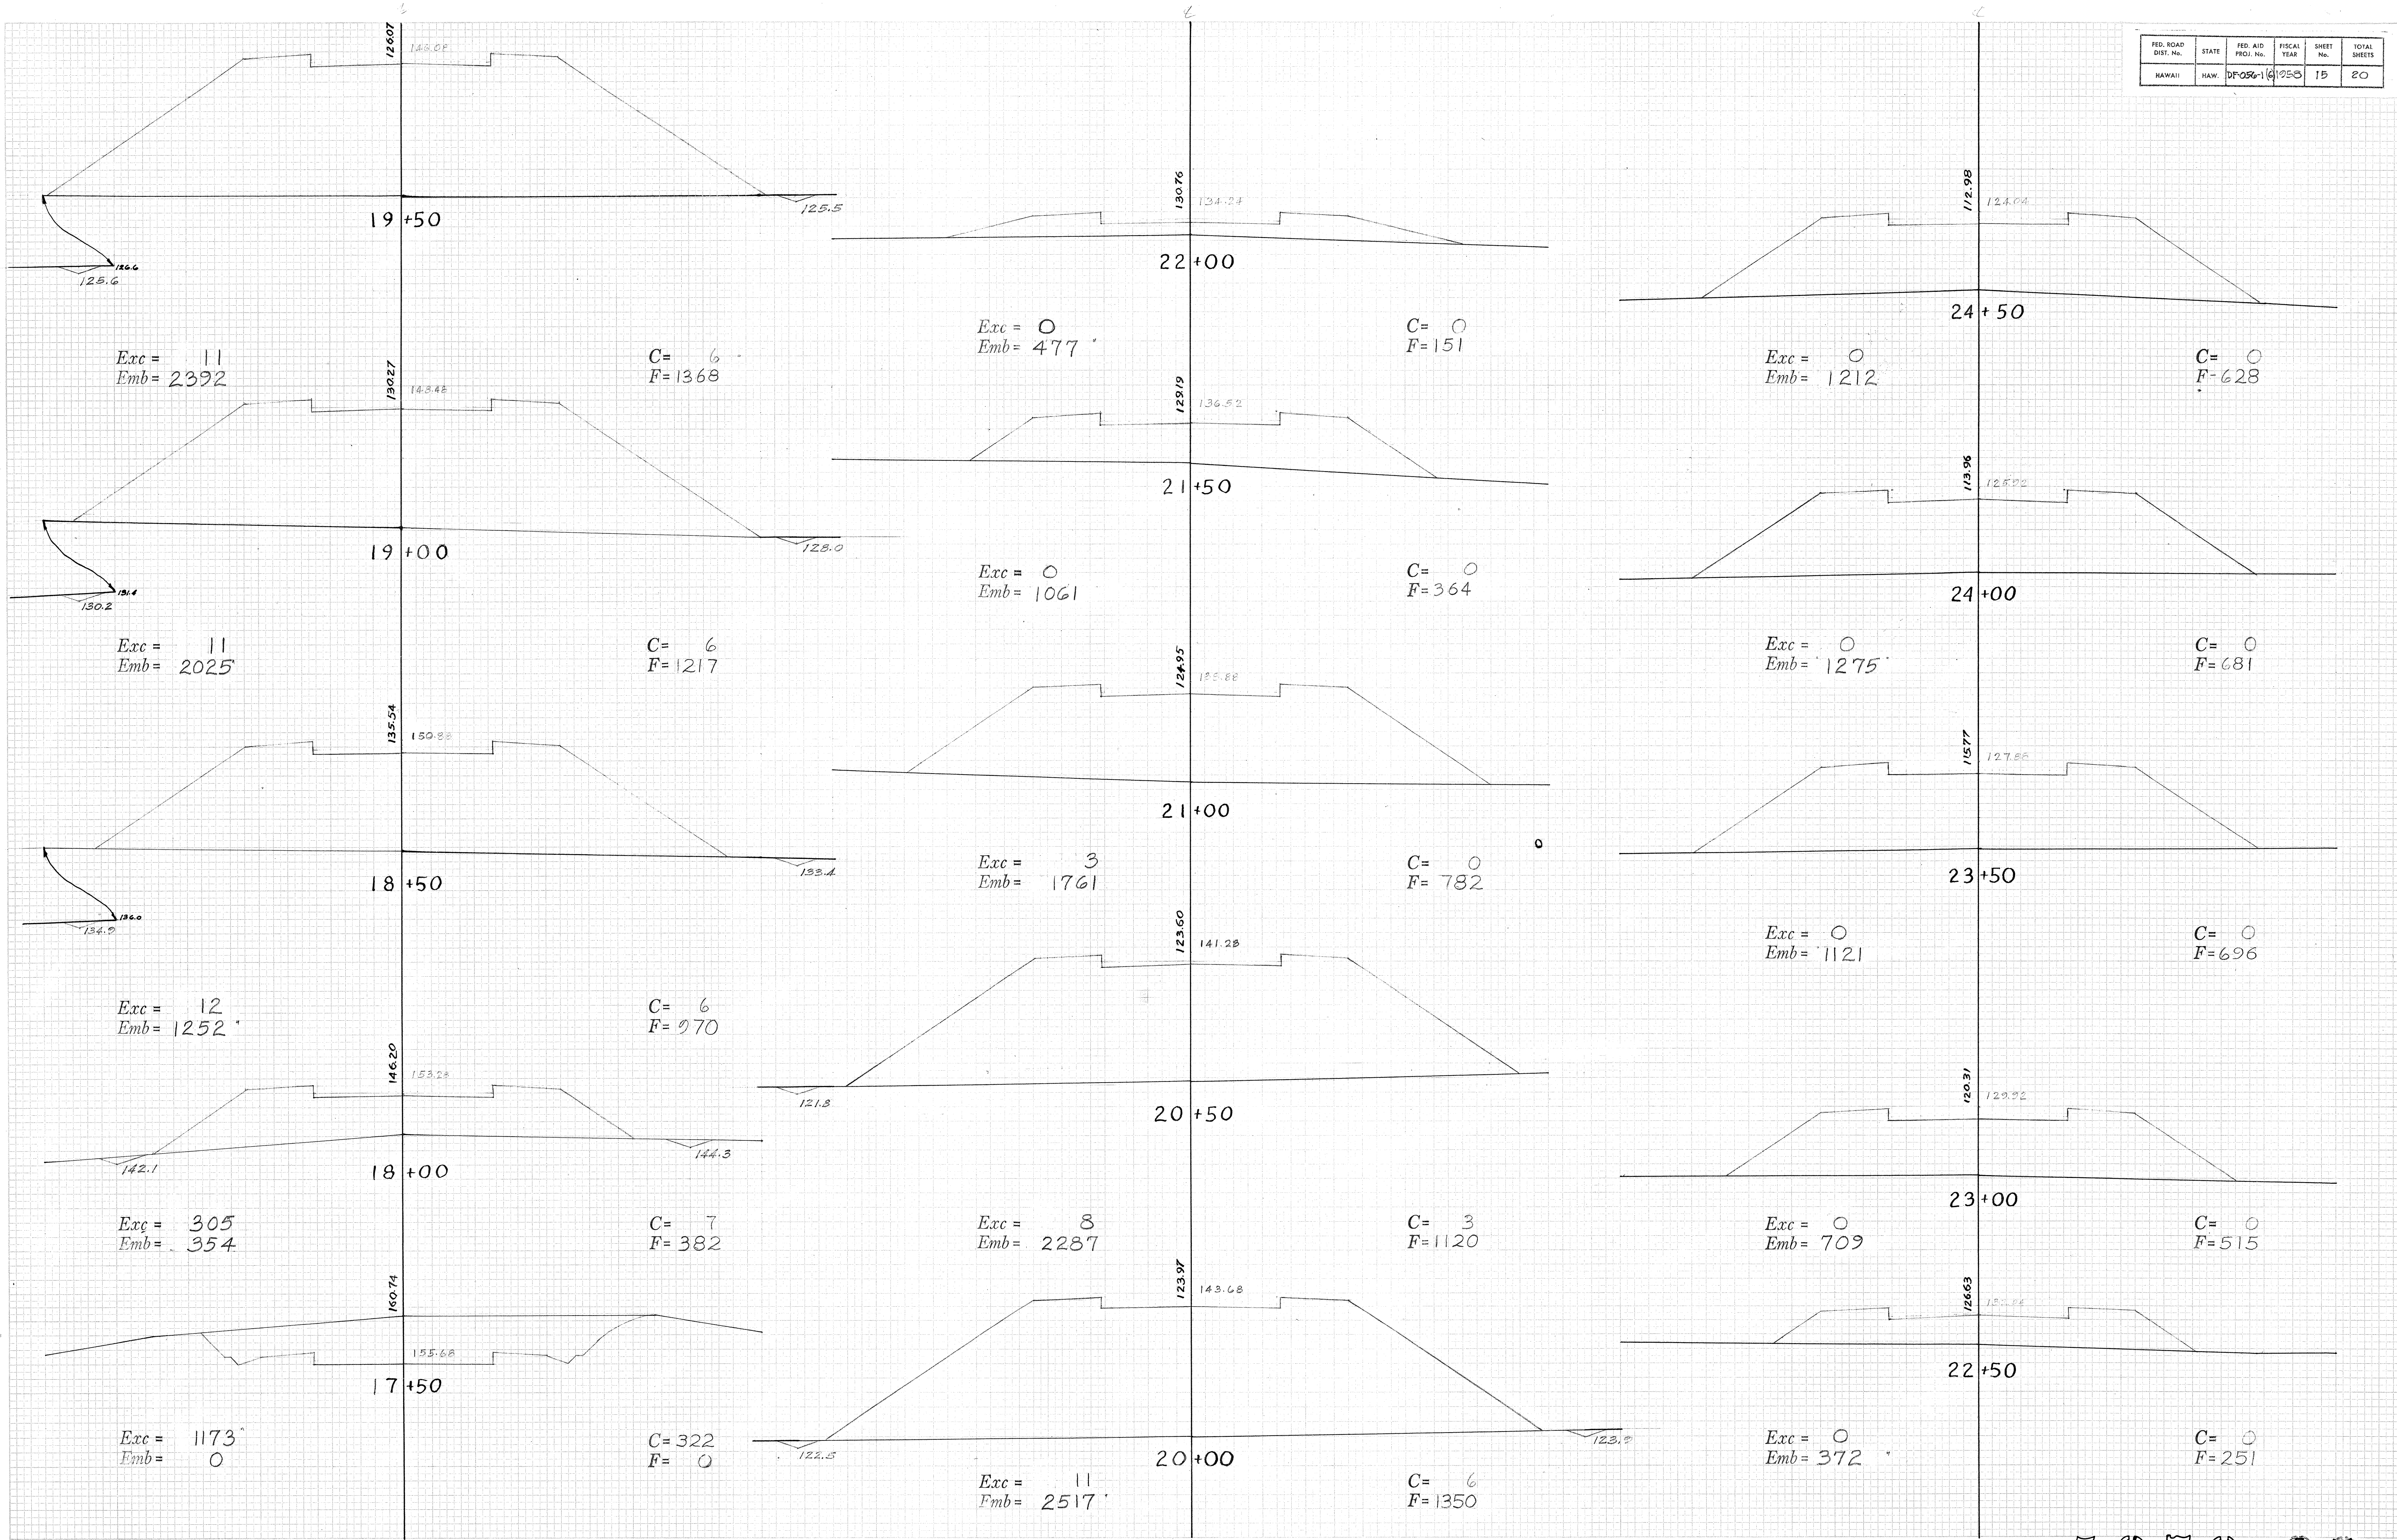

FED. ROAD DIST. No.	STATE	FED. AID PROJ. No.	FISCAL YEAR	SHEET No.	TOTAL SHEETS
HAWAII	HAW.	DF-056-16	1955	16	20

FINAL SURVEY	DATE
SURVEYED	BY
PLOTTED	BY
NOTE BOOK	NO.
AREAS	
CHECKED	

ORIGINAL SURVEY	DATE
SURVEYED	BY
PLOTTED	BY
NOTE BOOK	NO.
AREAS	
CHECKED	



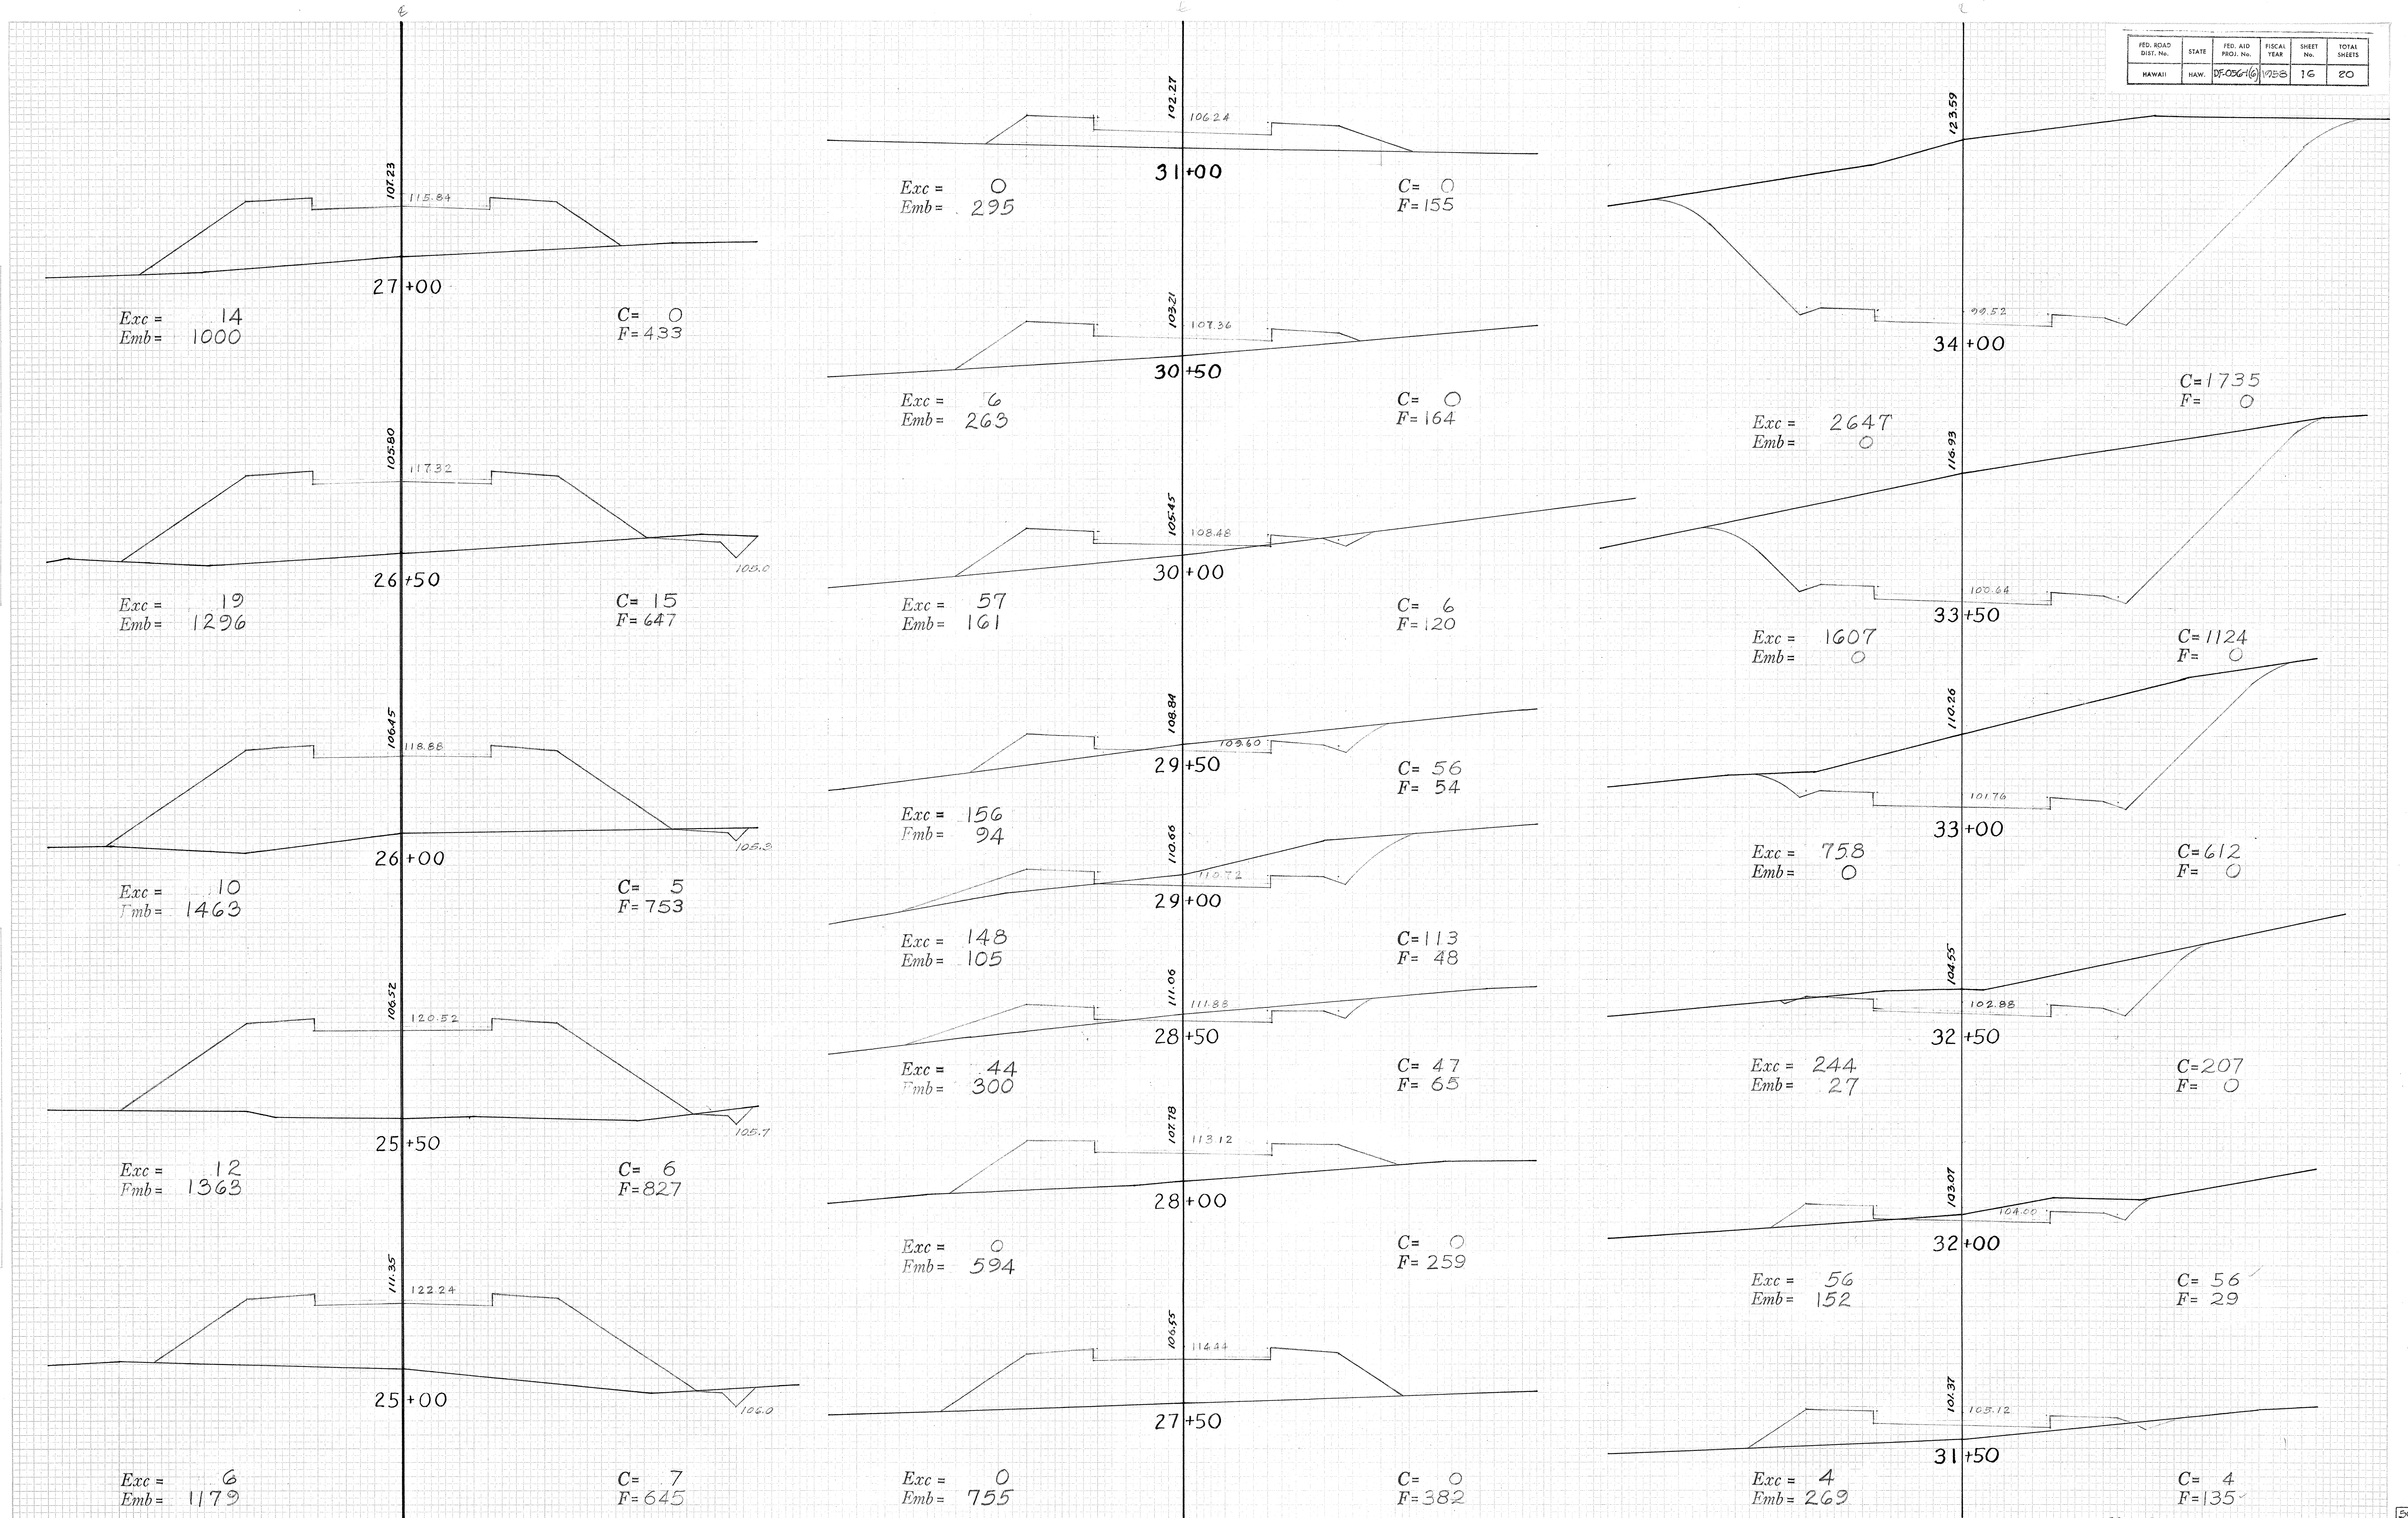


PLATE 3: CROSS SECTION OF ROADWAY
KENNELL & ESSER CO., NEW YORK

FINAL	SURVEYED	DATE
SURVEY	PLOTTED	BY
NOTE BOOK	TEMPERATURE	
NO.	AREAS CHECKED	

ORIGINAL	SURVEYED	DATE
SURVEY	PLOTTED	BY
NOTE BOOK	TEMPERATURE	
NO.	AREAS CHECKED	




FED. ROAD DIST. No.	STATE	FED. AID PROJ. No.	FISCAL YEAR	SHEET No.	TOTAL SHEETS
HAWAII	HAW.	DT-056-10	1958	18	20

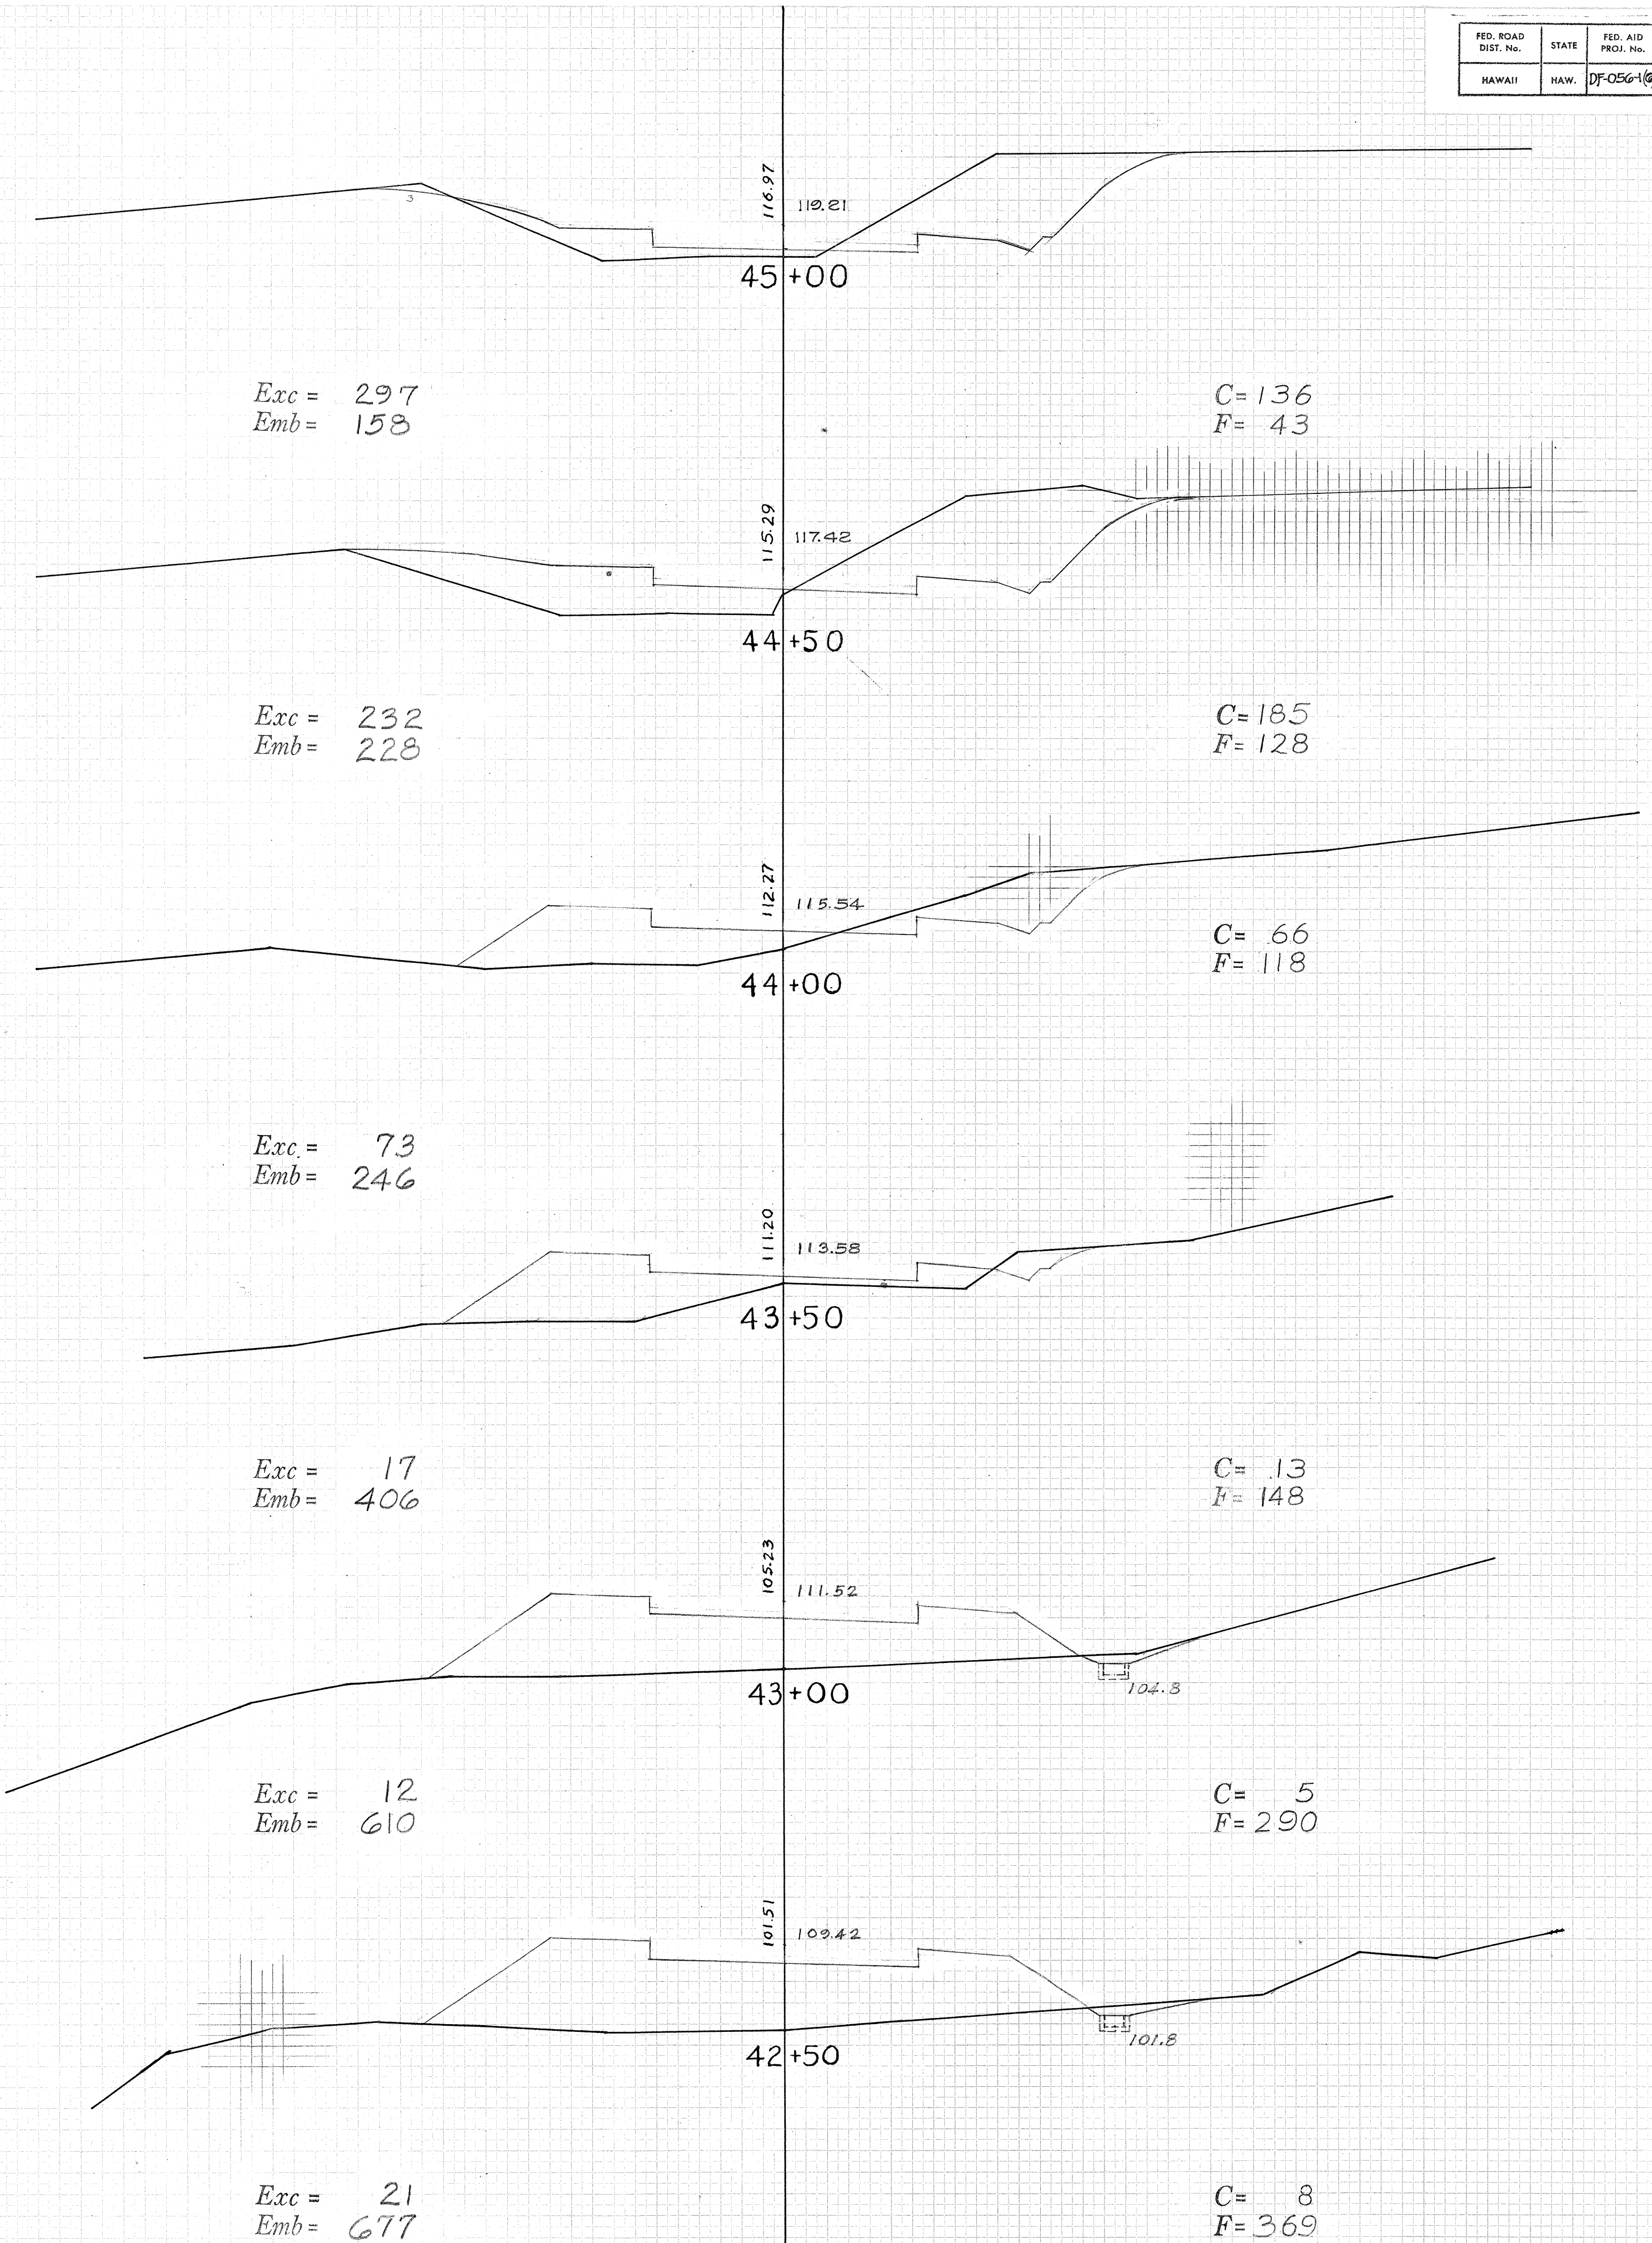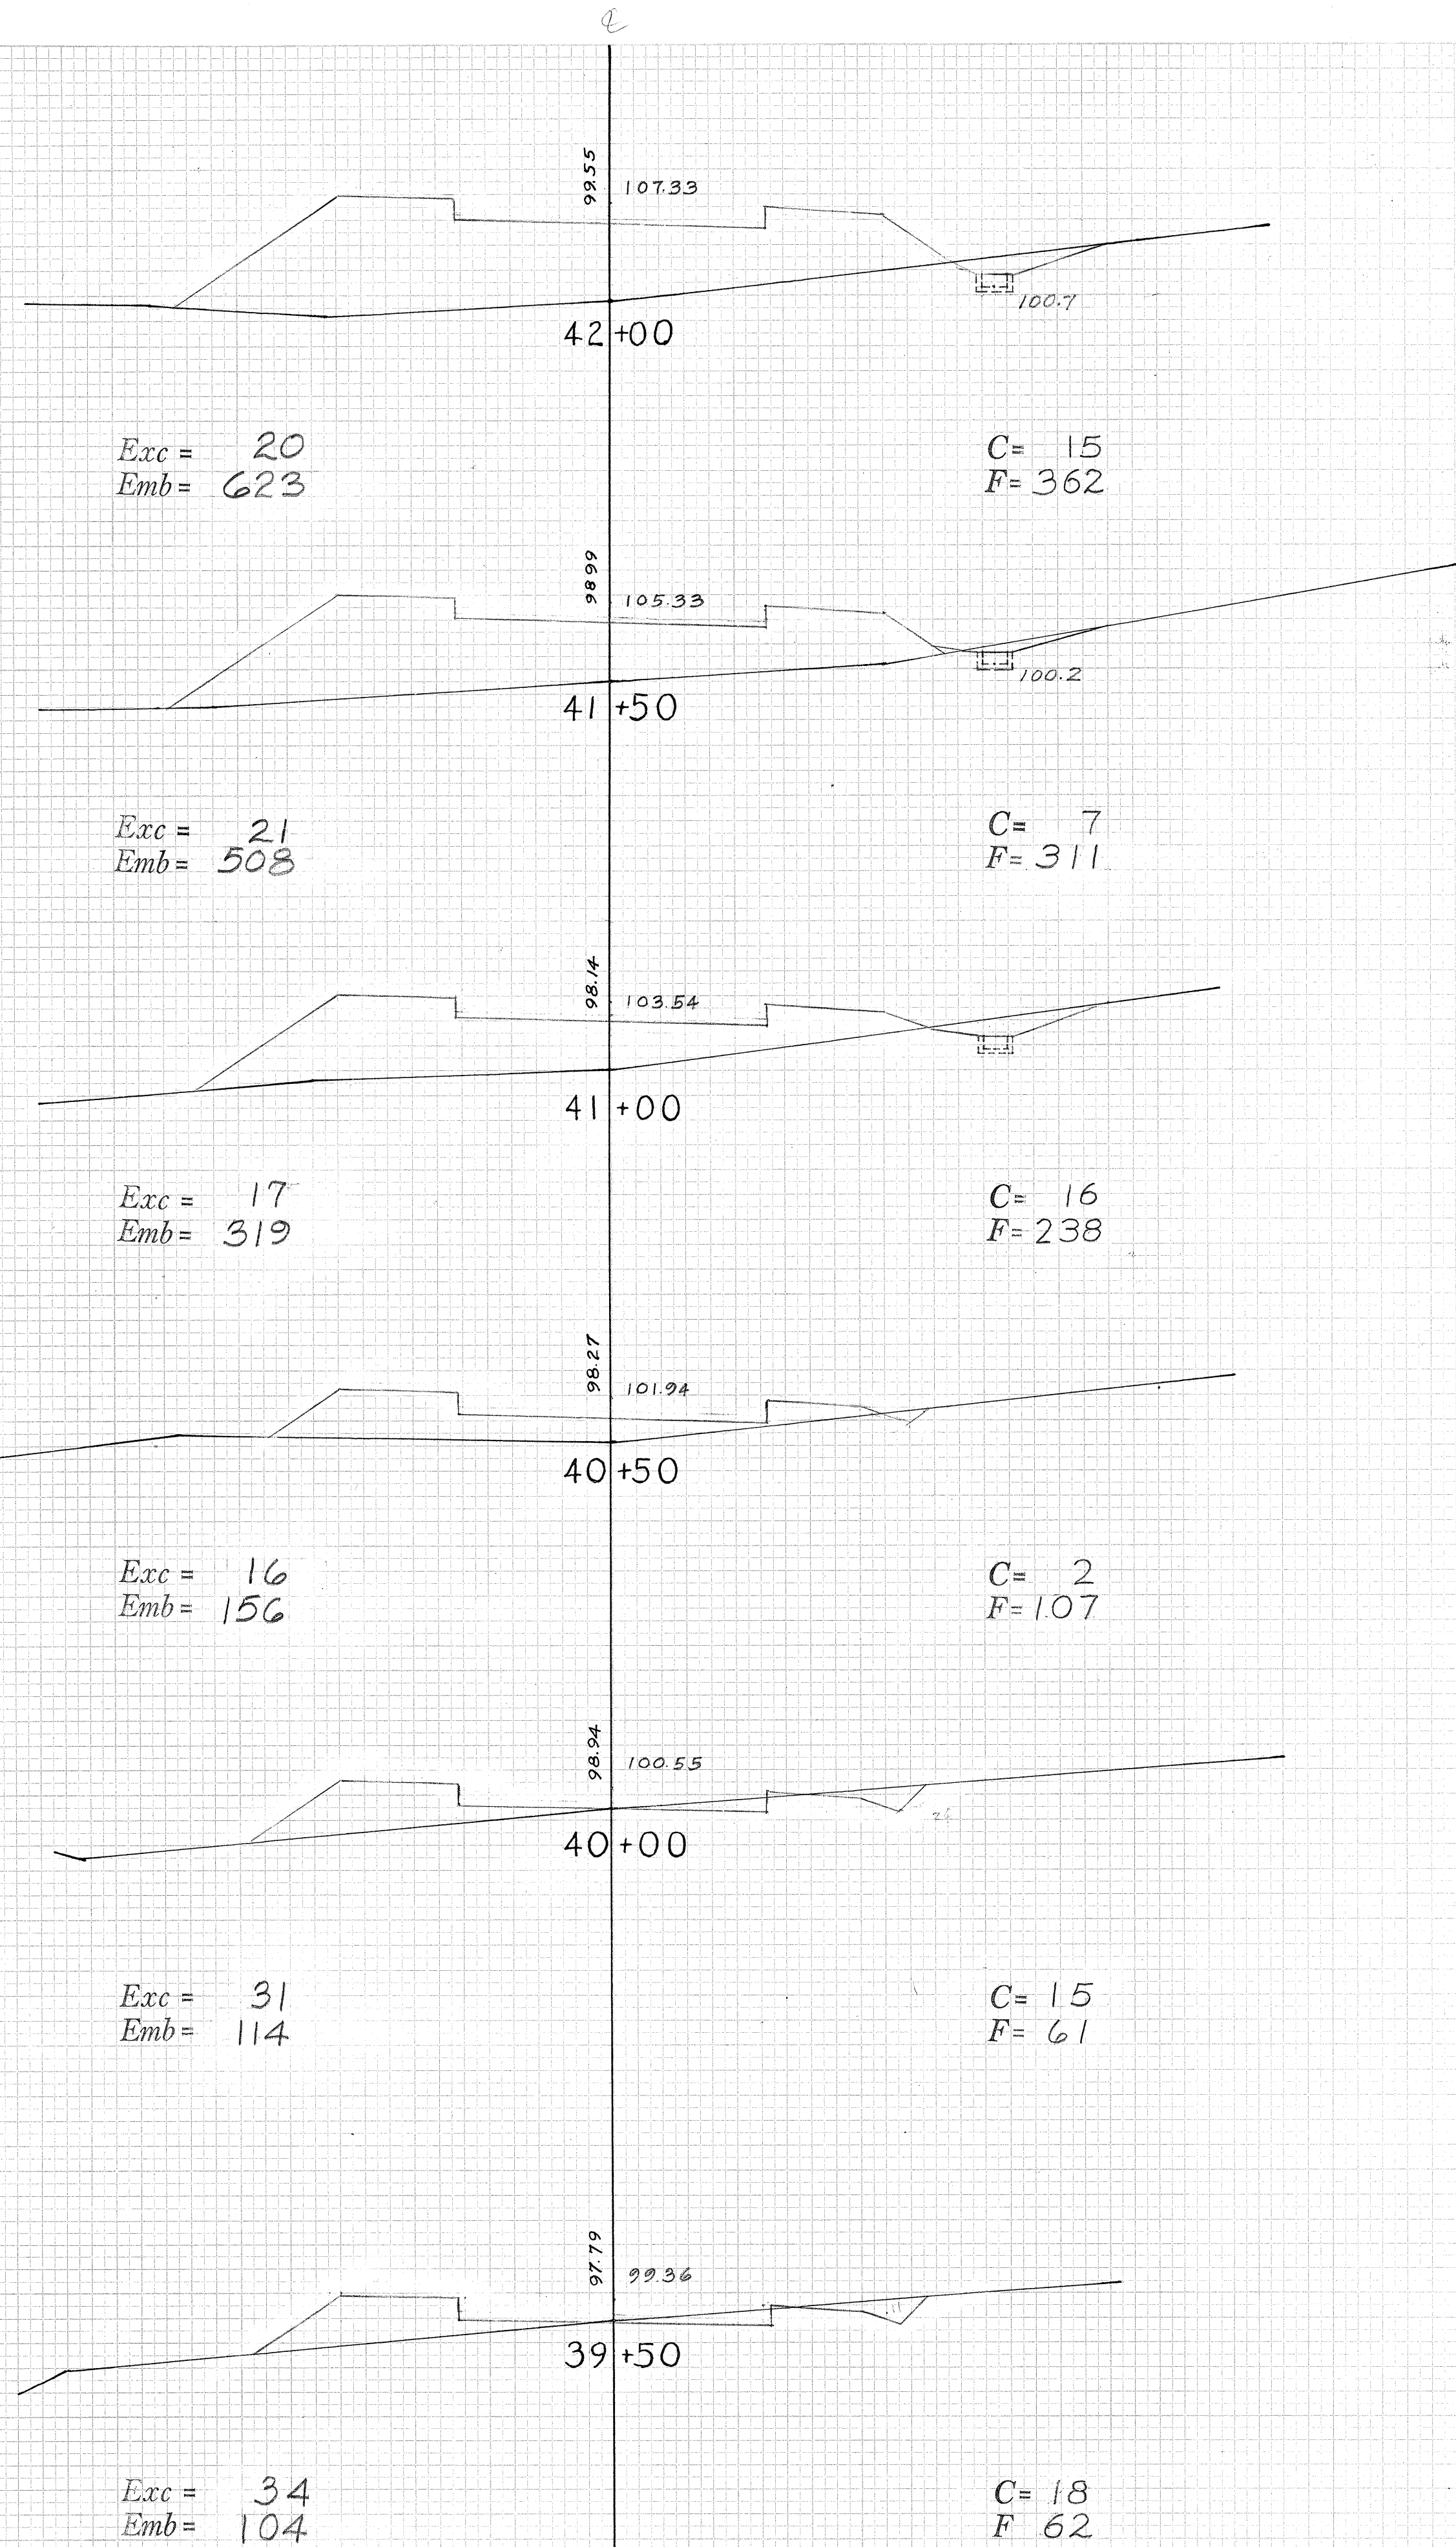

FED. ROAD DIST. NO.	STATE	FED. AID PROJ. NO.	FISCAL YEAR	SHEET NO.	TOTAL SHEETS
HAWAII	HAW.	07-086-16	1958	19	20

FINAL SURVEY	DATE	BY
SURVEYED		
NOTED		
NO.		



ORIGINAL SURVEY	DATE	BY
SURVEYED		
NOTED		
NO.		

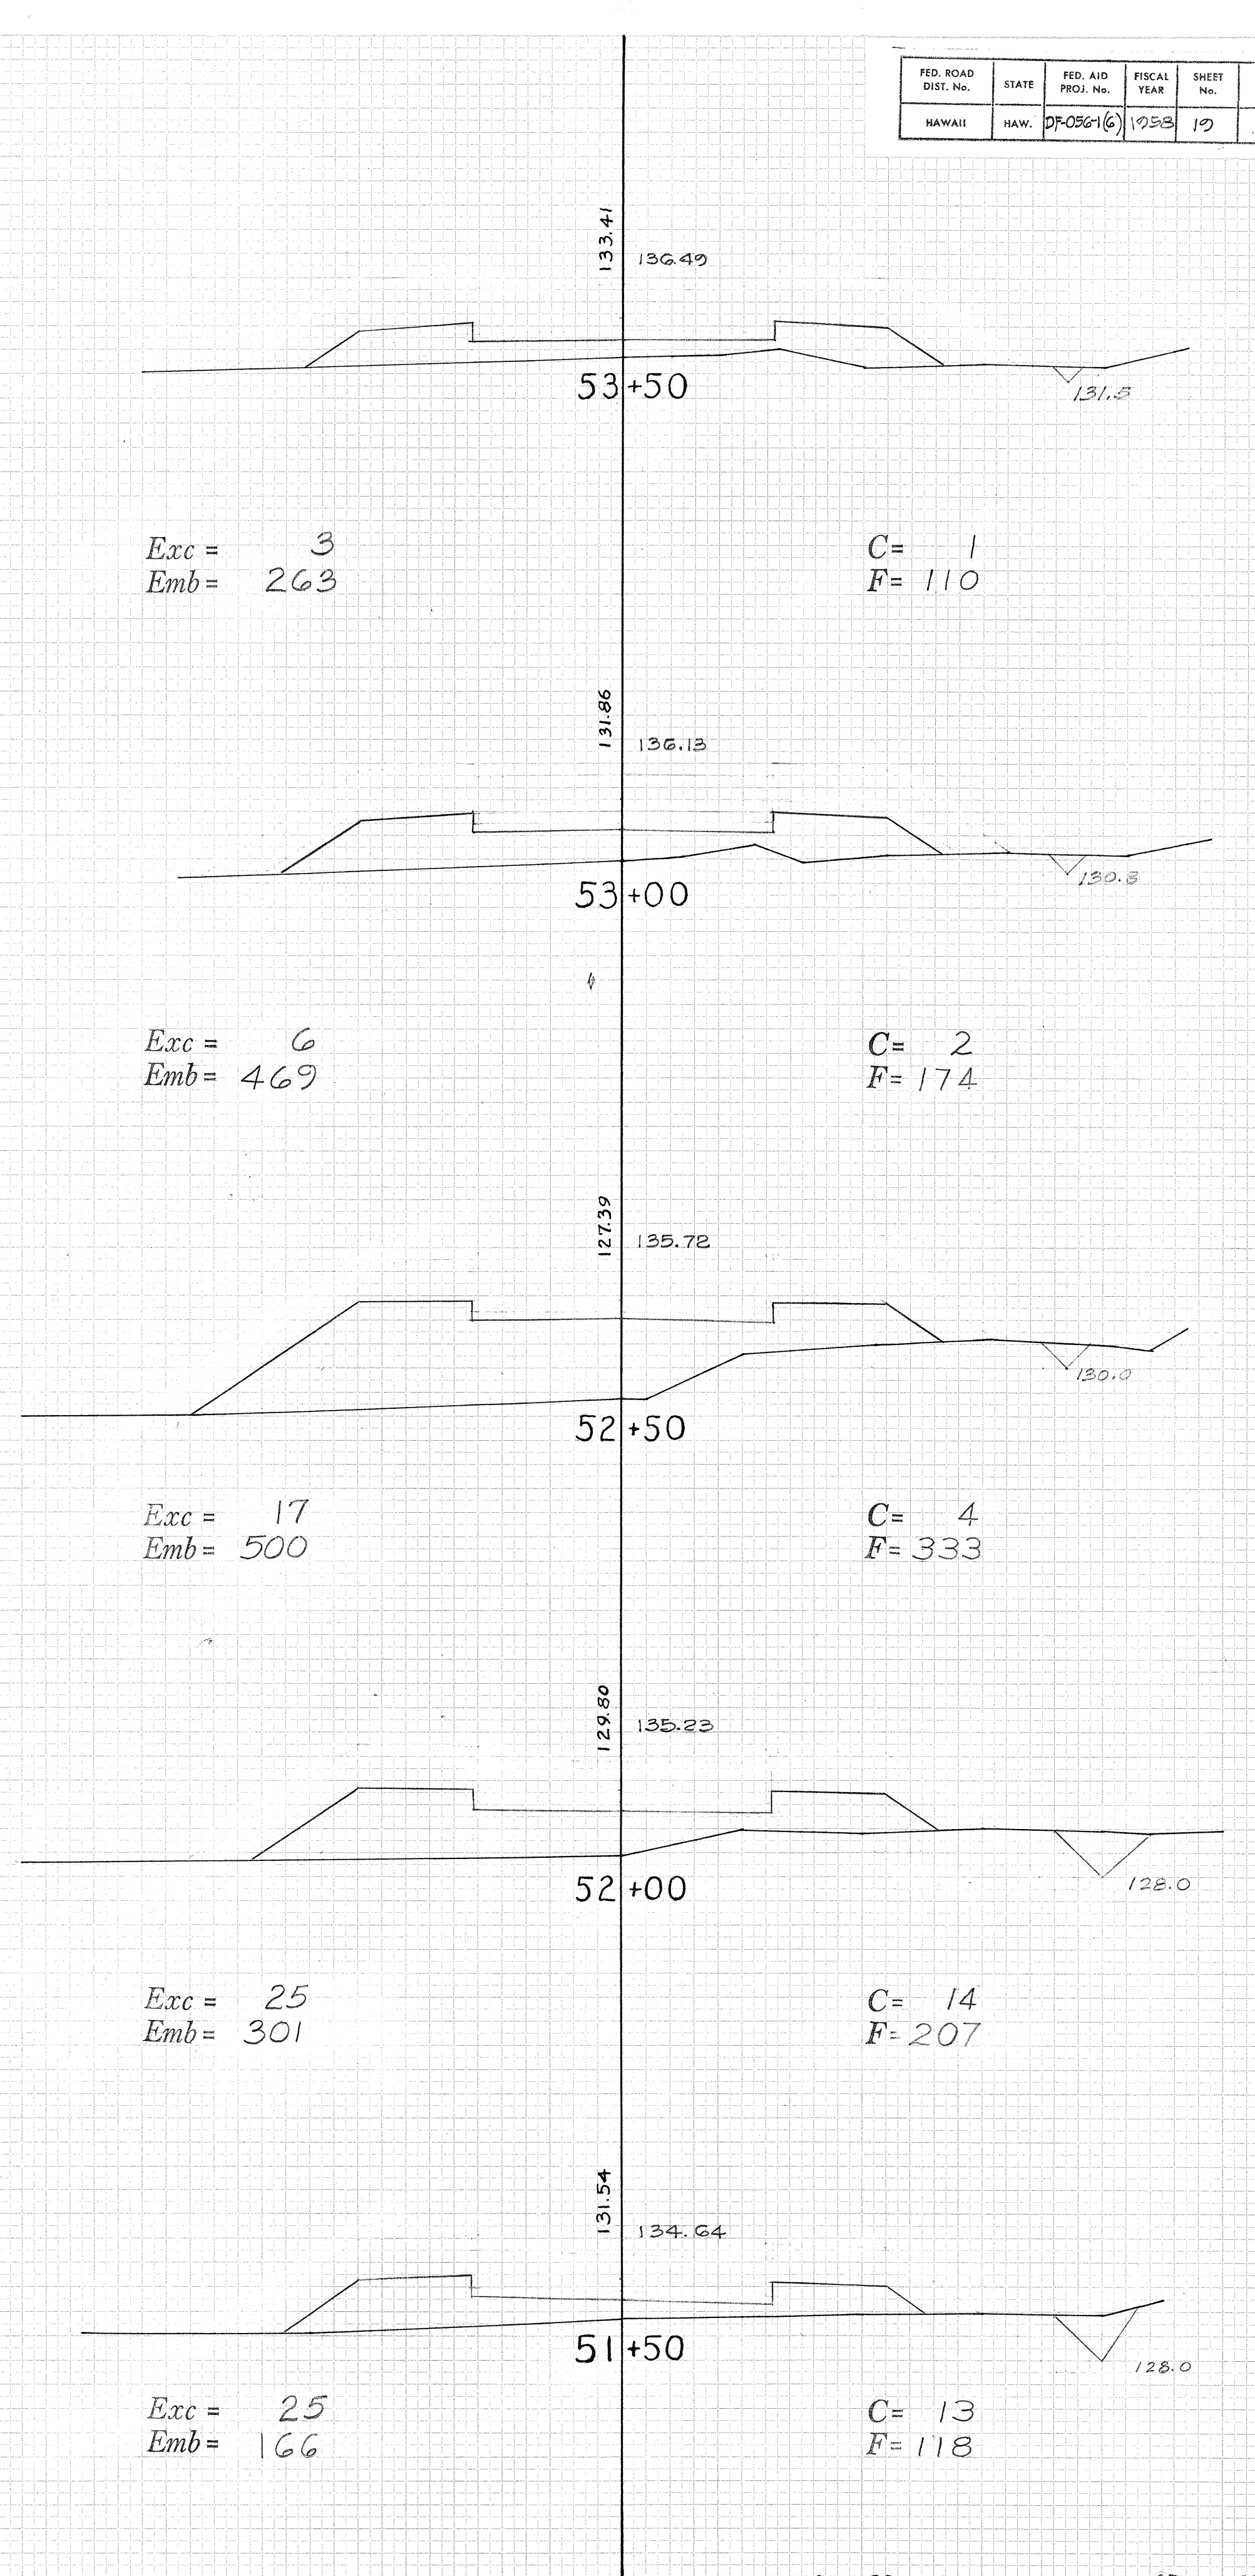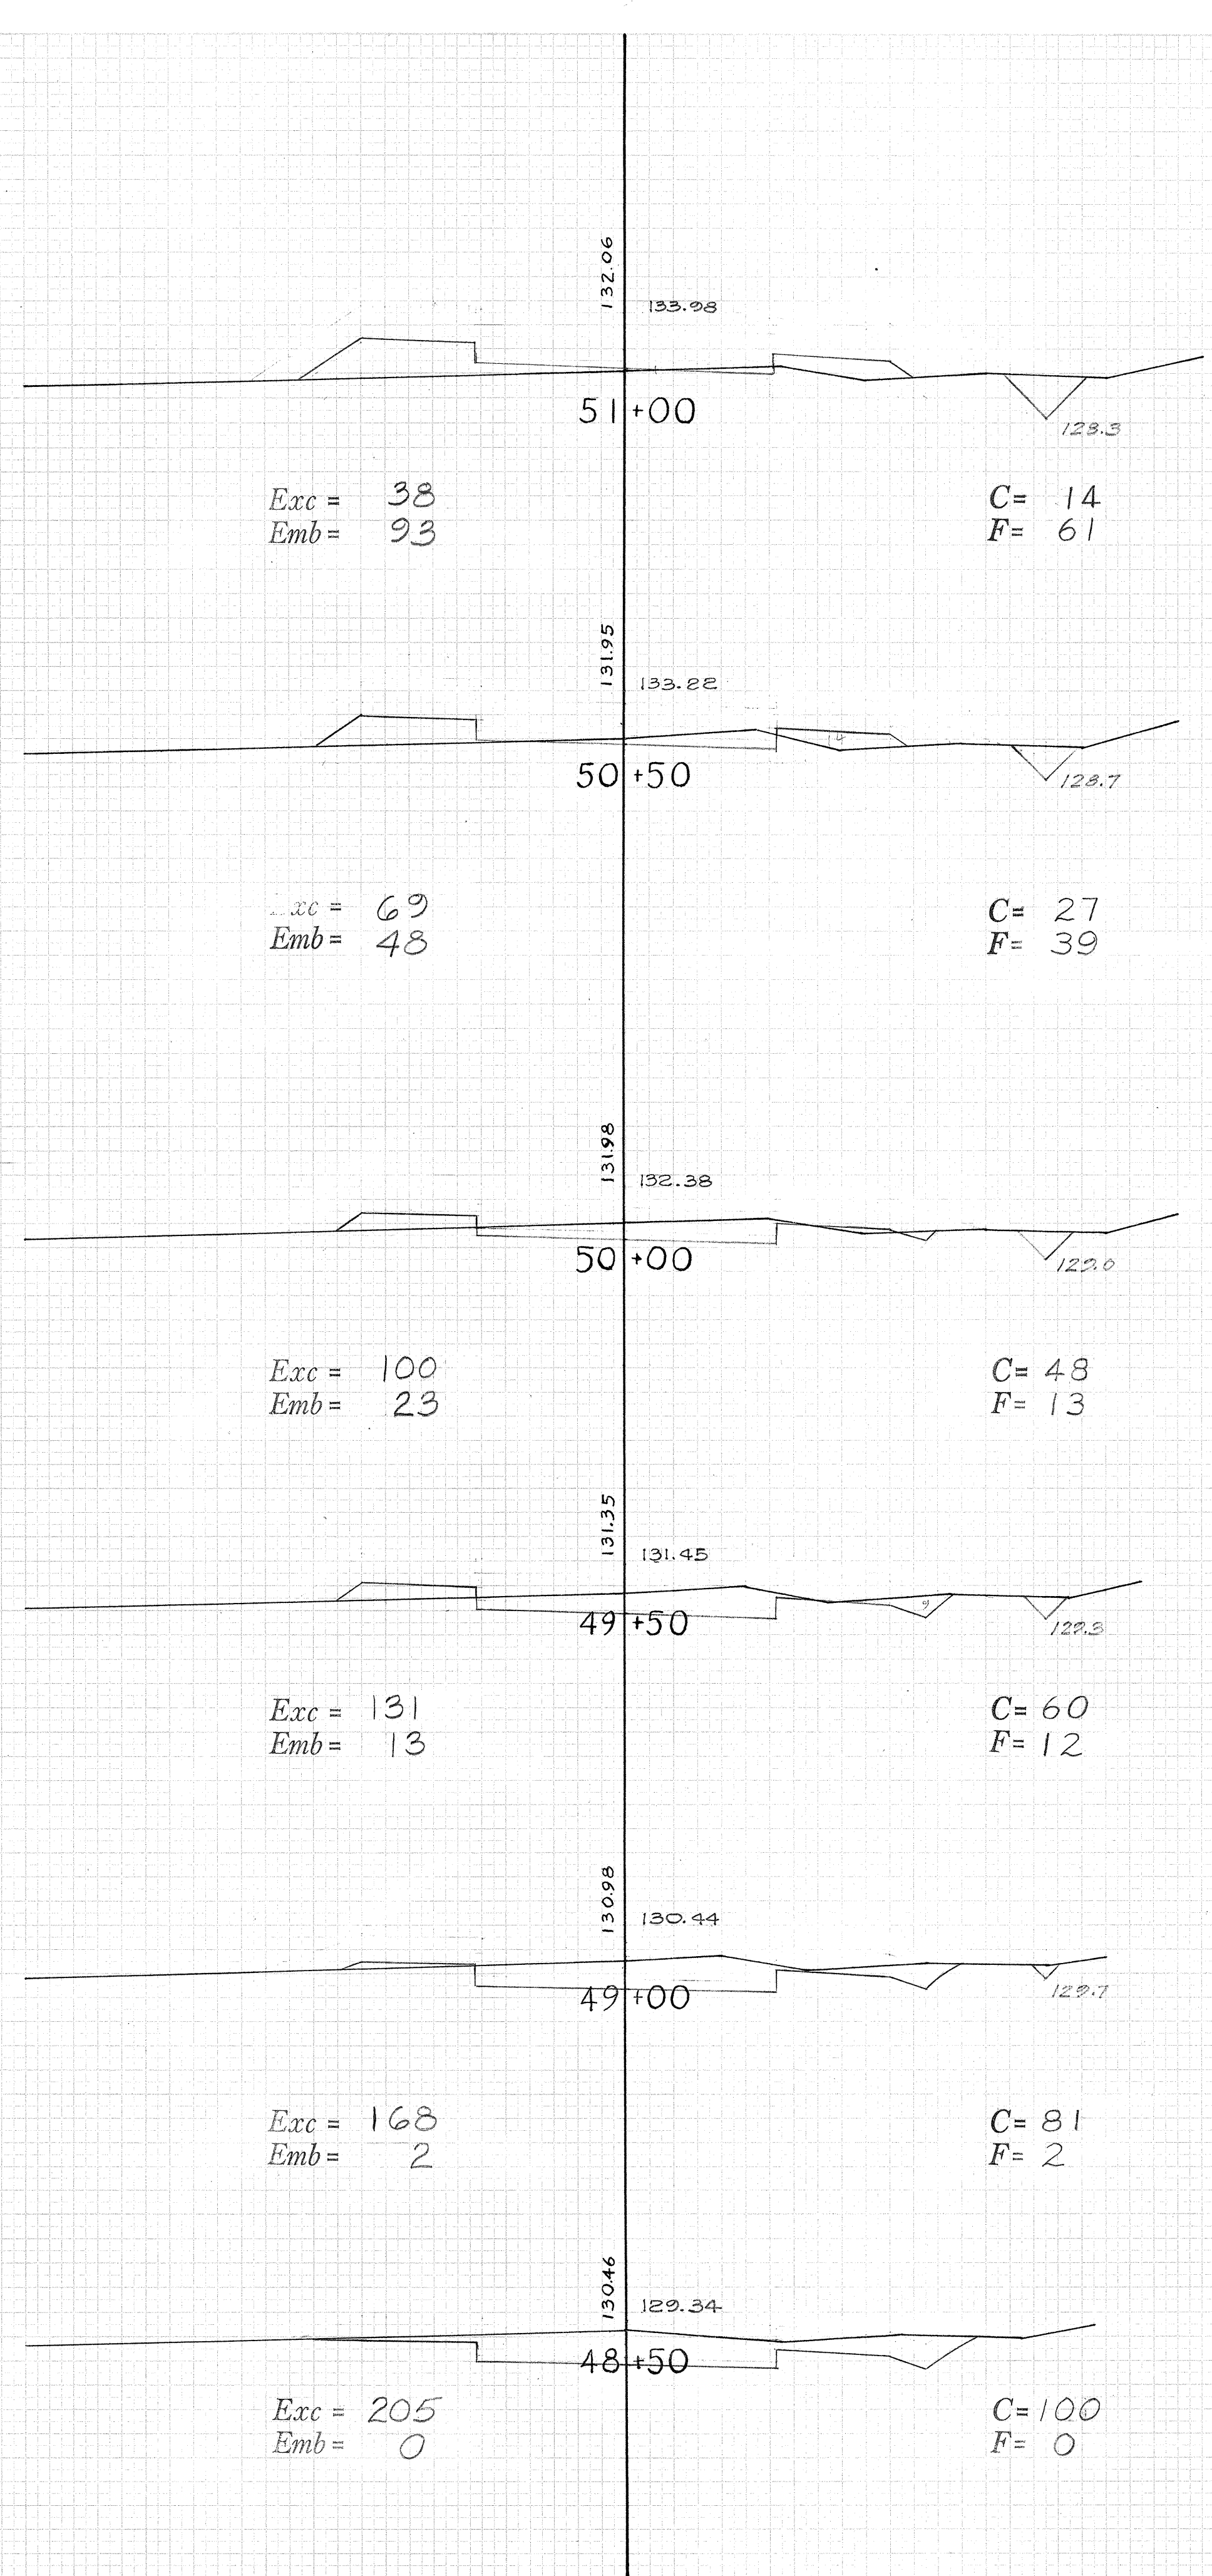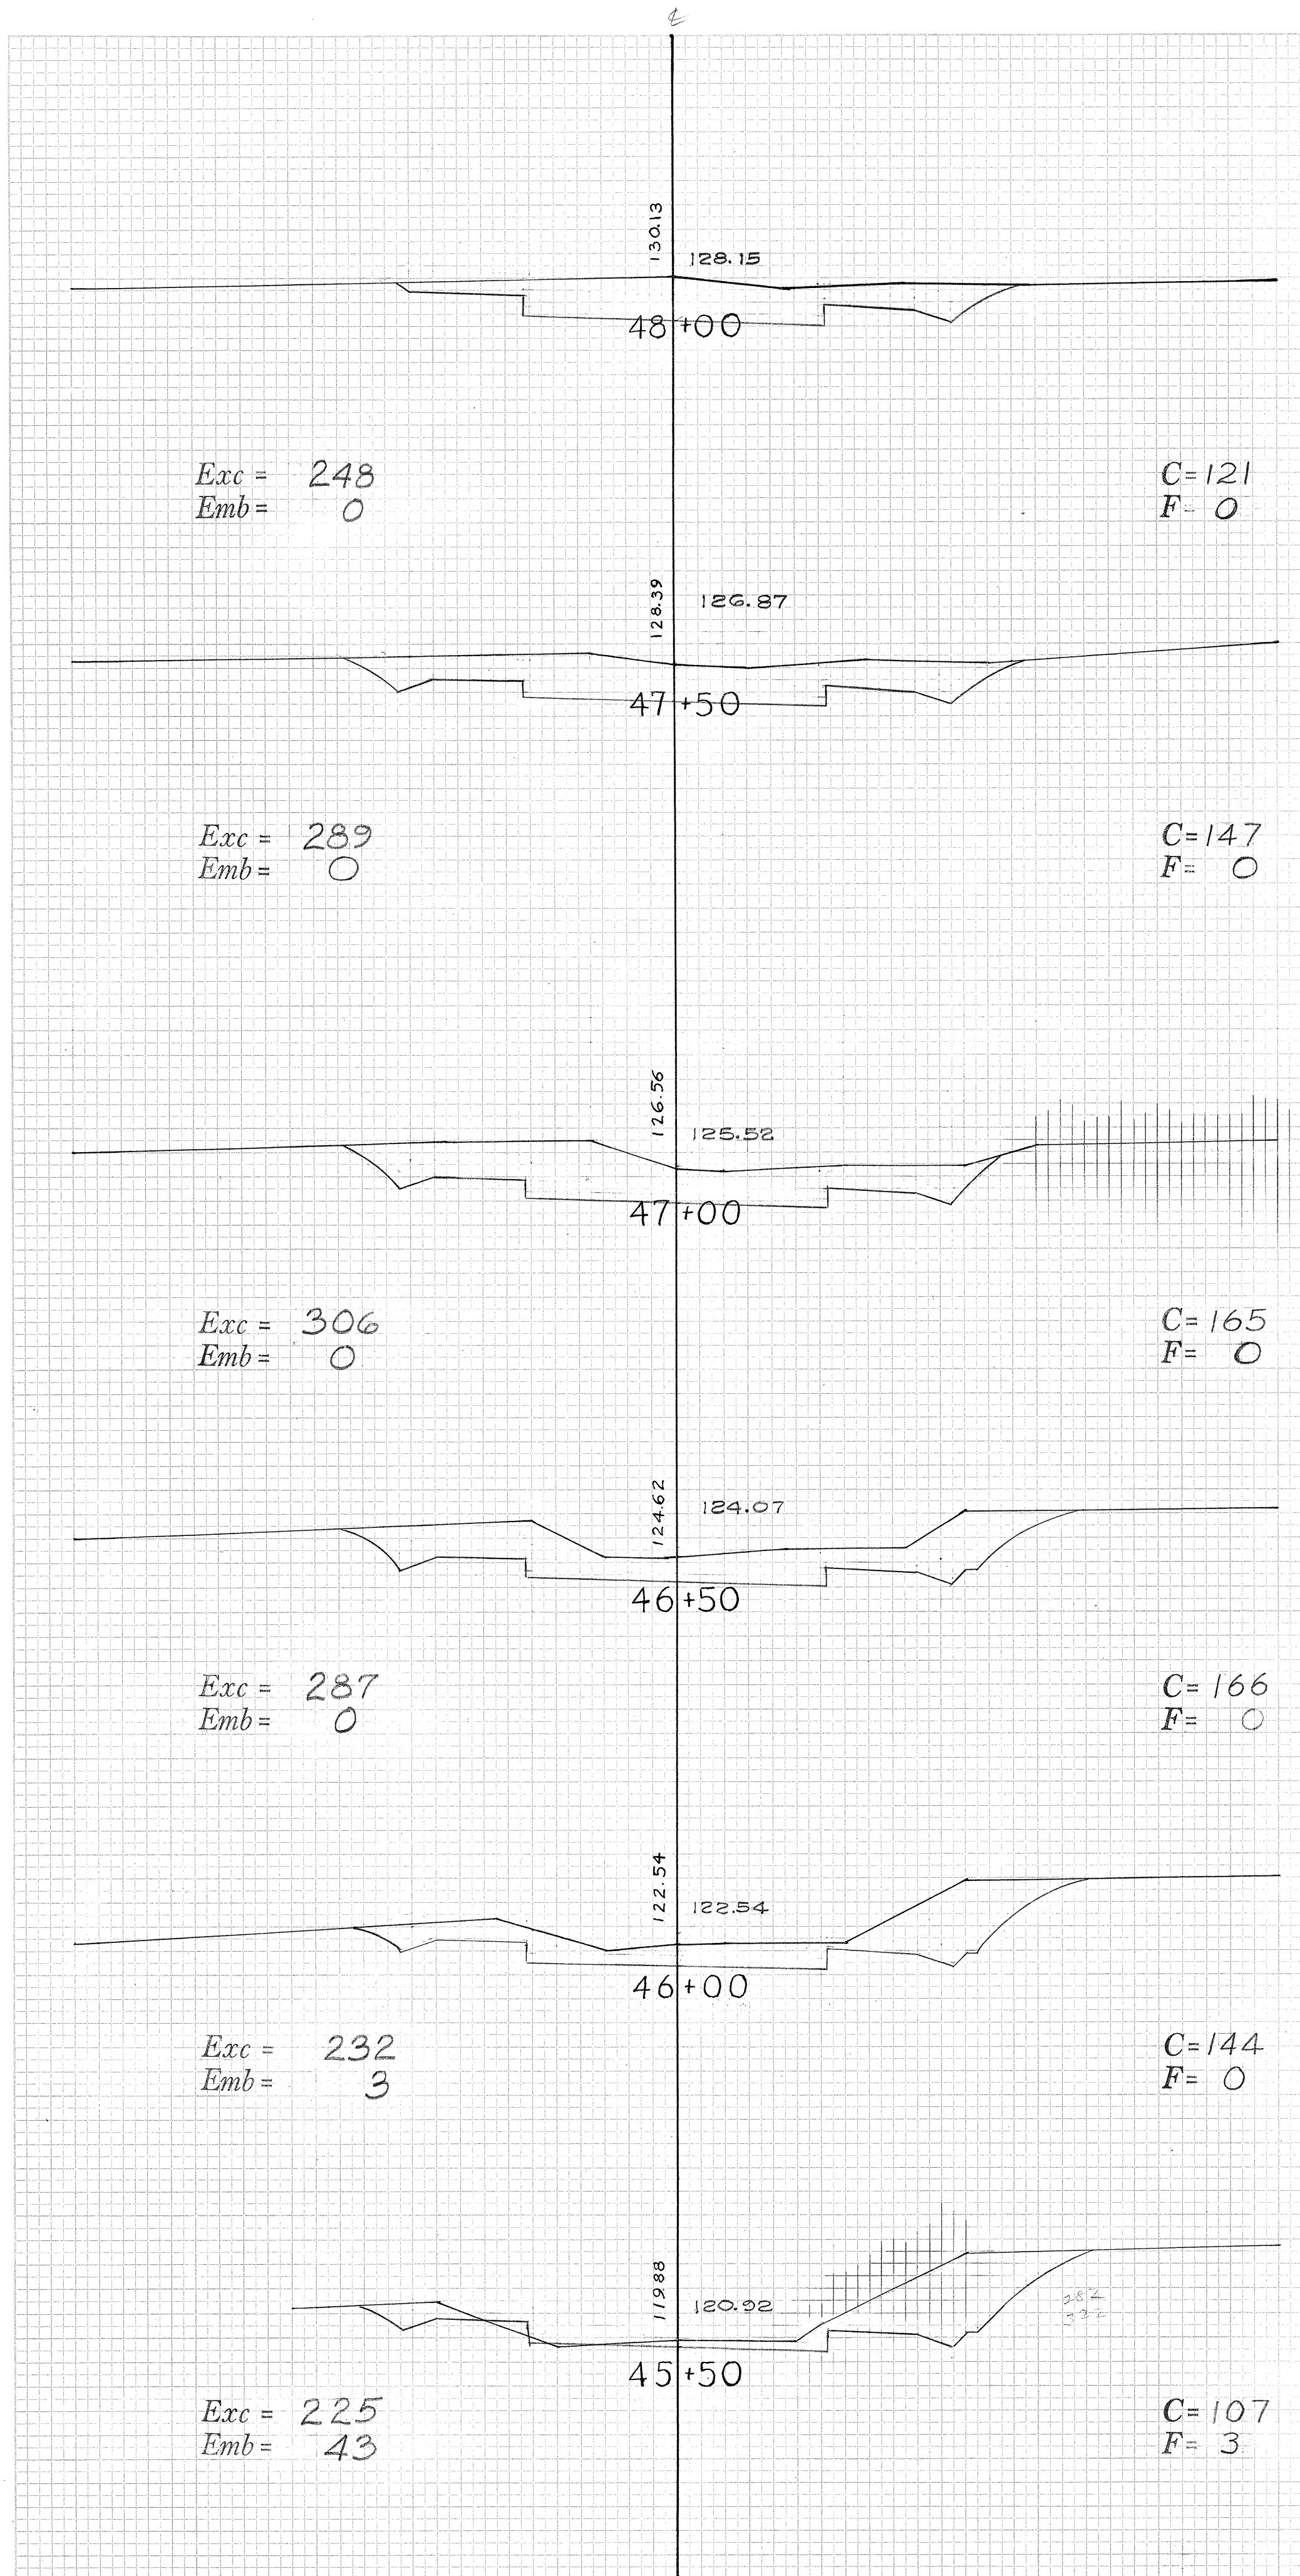

FED. ROAD DIST. No.	STATE	FED. AID PROJ. No.	FISCAL YEAR	SHEET No.	TOTAL SHEETS
HAWAII	HAW.	DF-056-1(6)	1958	20	20
HAWAII	HAW.	F-056-1(7)	1958	30	54

FINAL SURVEY	BY	DATE
NOTE BOOK		
NO.		

ORIGINAL SURVEY	BY	DATE
NOTE BOOK		
NO.		

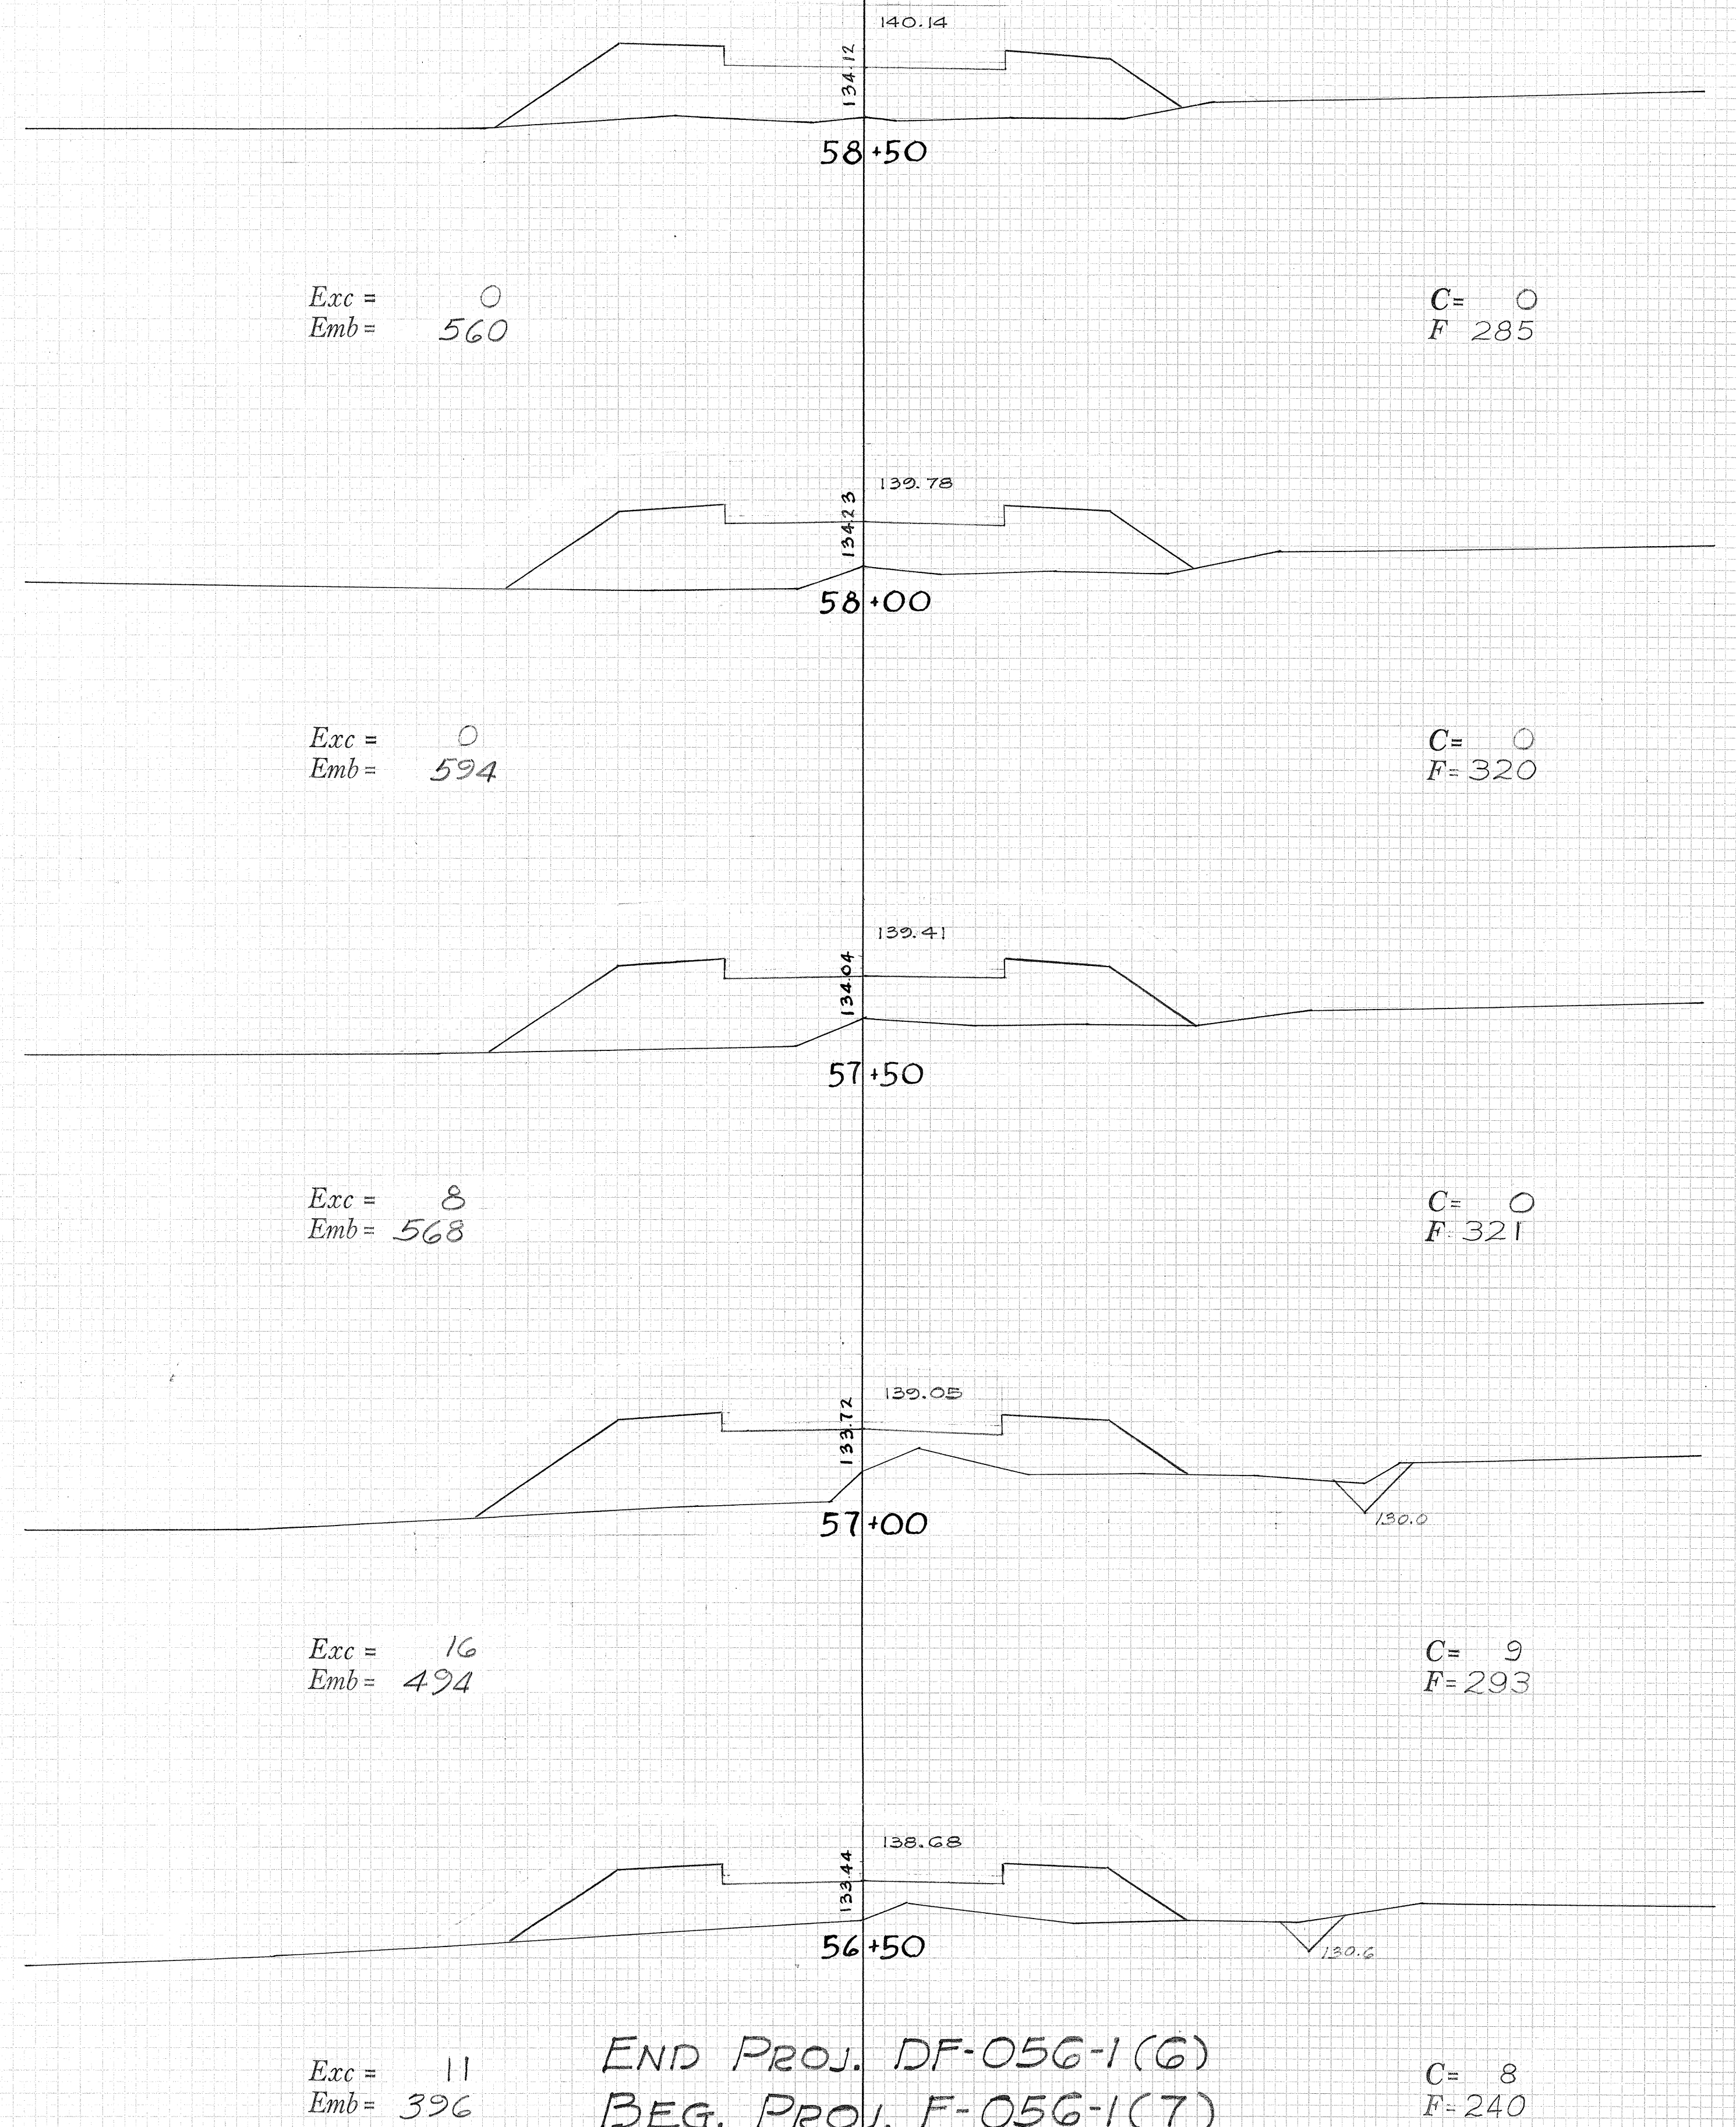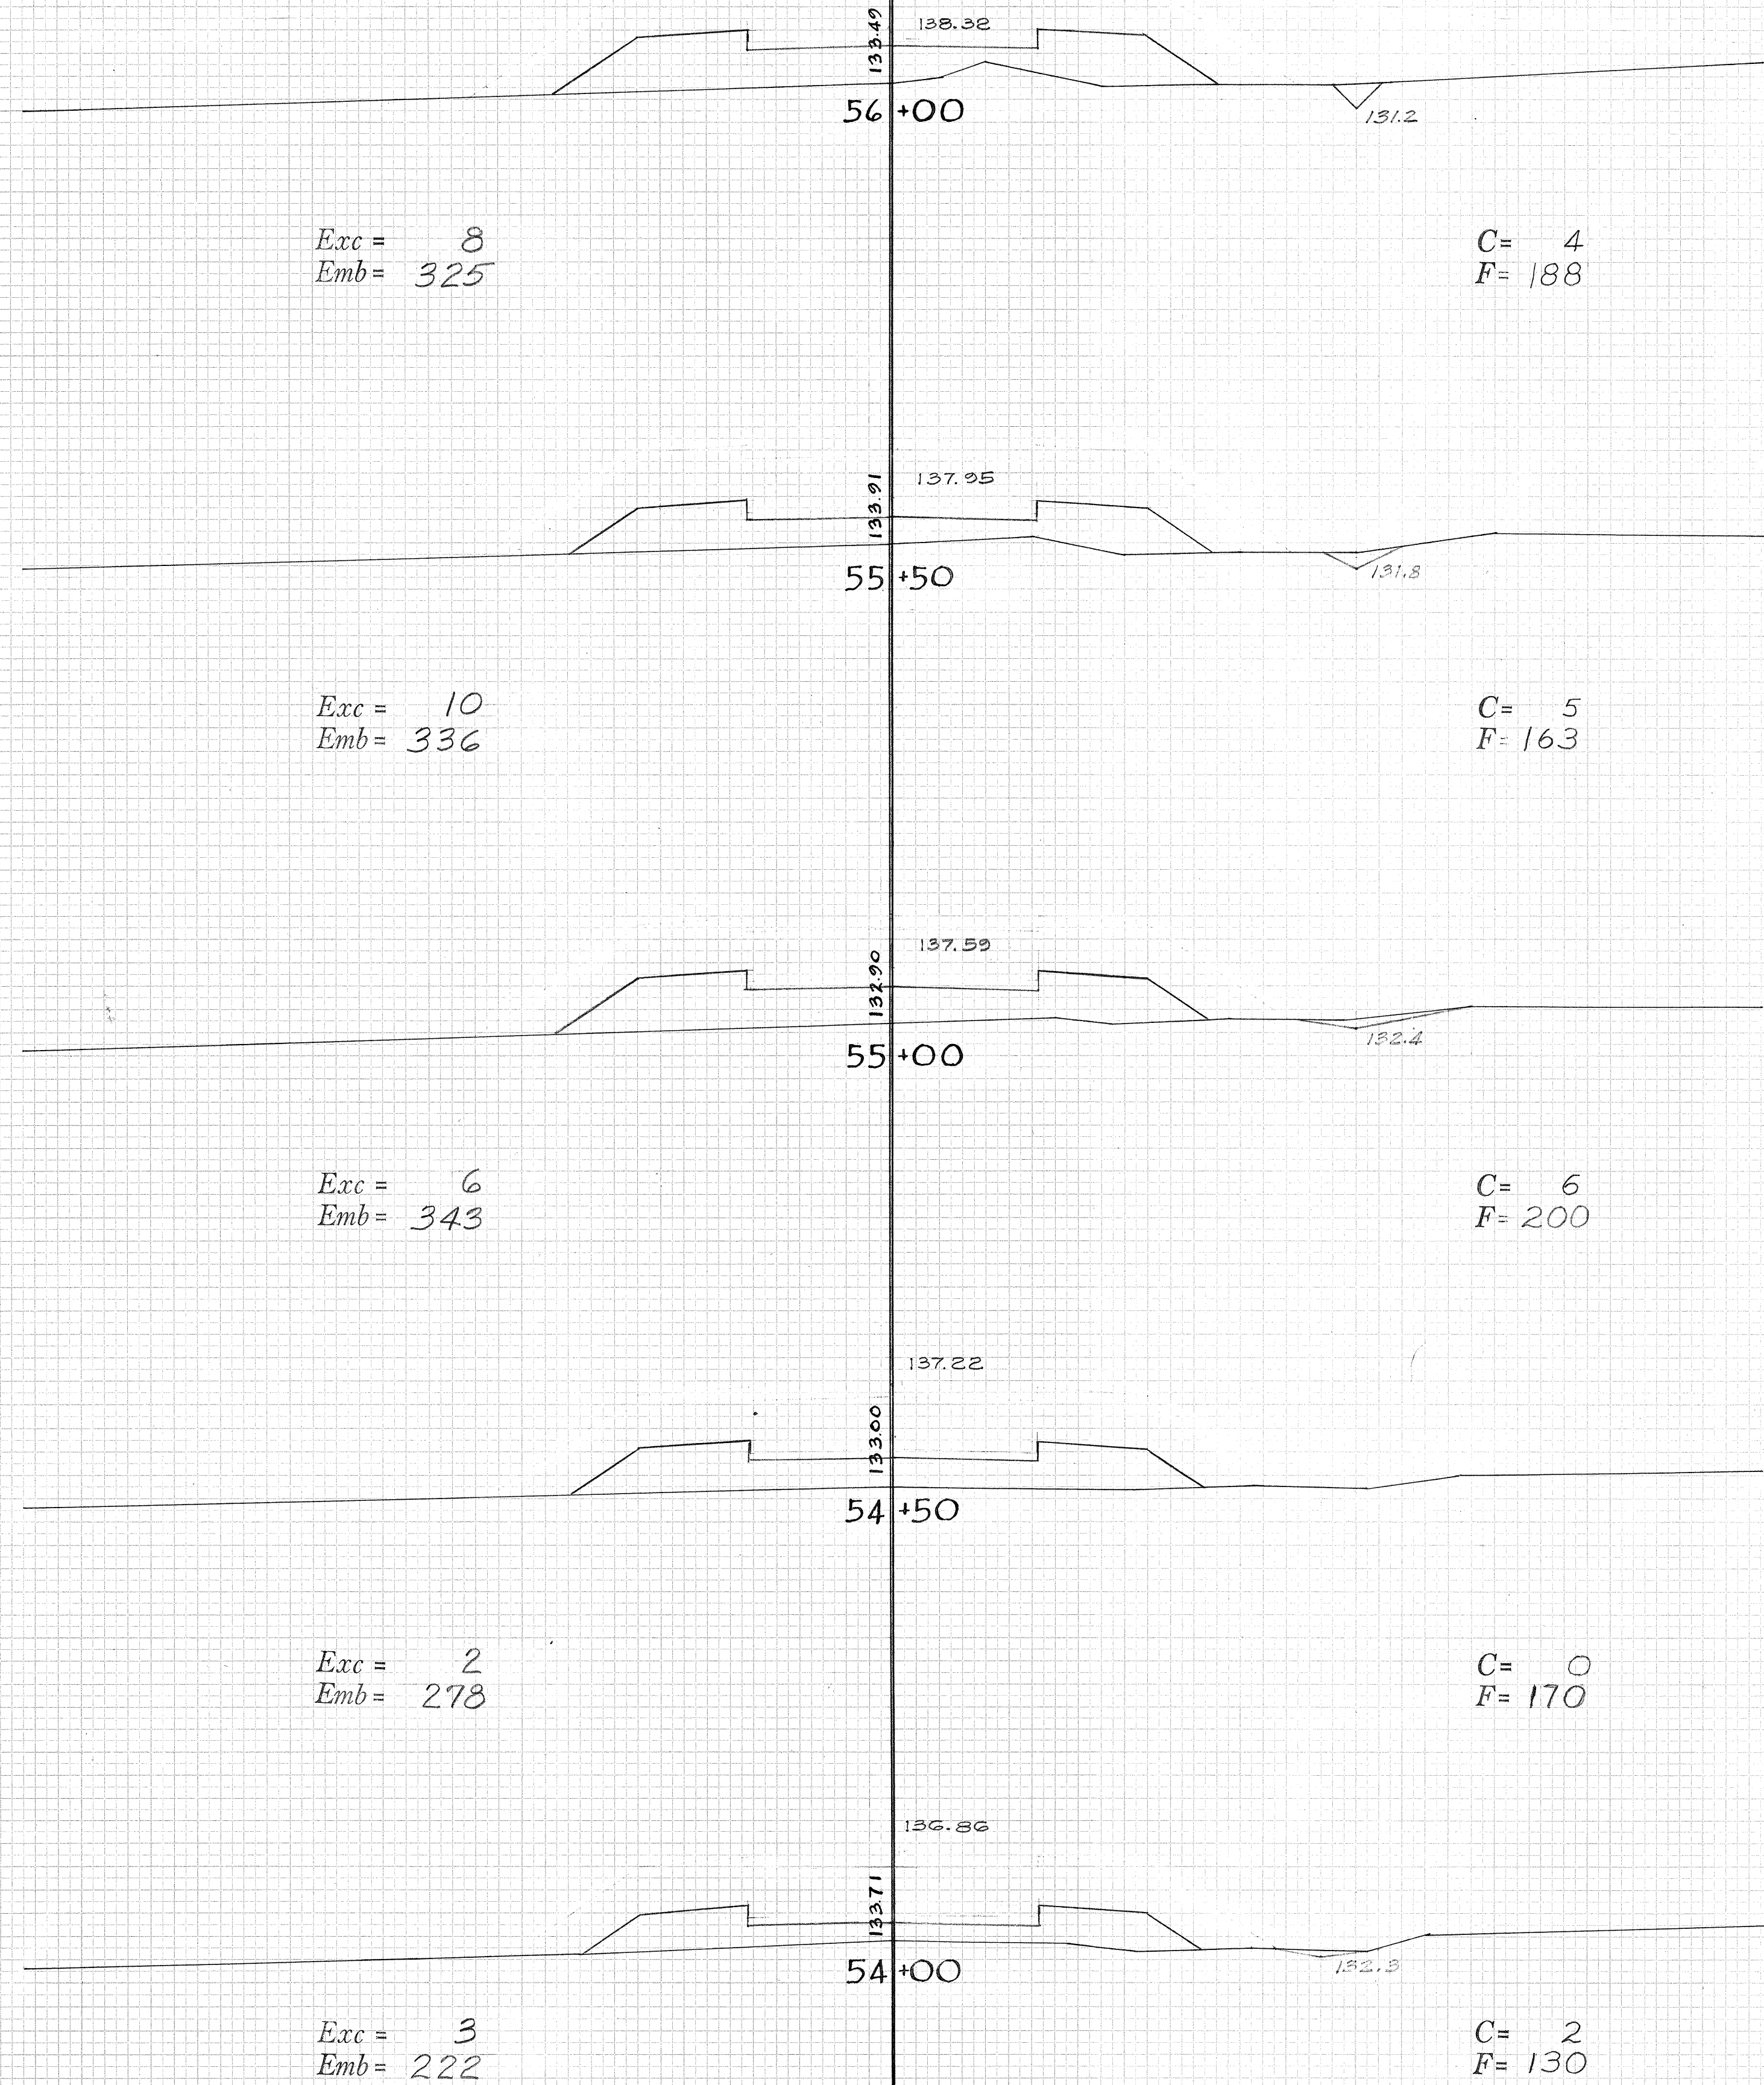

END PROJ. DF-056-1(6)
BEG. PROJ. F-056-1(7)

600 S. 39 5970.20