

INDEX TO DRAWINGS		
SHEET NO.	DESCRIPTION	COMB. NO.
1	TITLE SHEET	1
2	TYPICAL SECTION	3
3-4	PLAN & PROFILE	4-5
5-6	CONNECTION	8-9
7	TREE DETAILS	17
8	MISCELLANEOUS DETAILS	20
9-10	CONCRETE BOX CULVERTS	26-30
11-12	ALIOMANU BRIDGE	33-34
13-20	CROSS SECTIONS	47-54


FED. ROAD DIST. NO.	STATE	FED. AID PROJ. NO.	FISCAL YEAR	SHEET No.	TOTAL SHEETS
HAWAII	HAW.	DF-056-1(6)	1958	1	20

TERRITORY OF HAWAII
TERRITORIAL HIGHWAY DEPARTMENT
HONOLULU T. H.
AS BUILT
PLANS OF
KAUAI BELT ROAD
FEDERAL AID PROJECT NO. DF-056-1(6)

DISTRICT OF KAWAIHAU
ISLAND OF KAUAI

SCALES

PLAN ----- 1 INCH = 100 FT.
PROFILE ----- HOR. 1 INCH = 100 FT.
VER. 1 INCH = 10 FT.
CROSS SECTION ----- HOR. 1 INCH = 10 FT.
VER. 1 INCH = 10 FT.

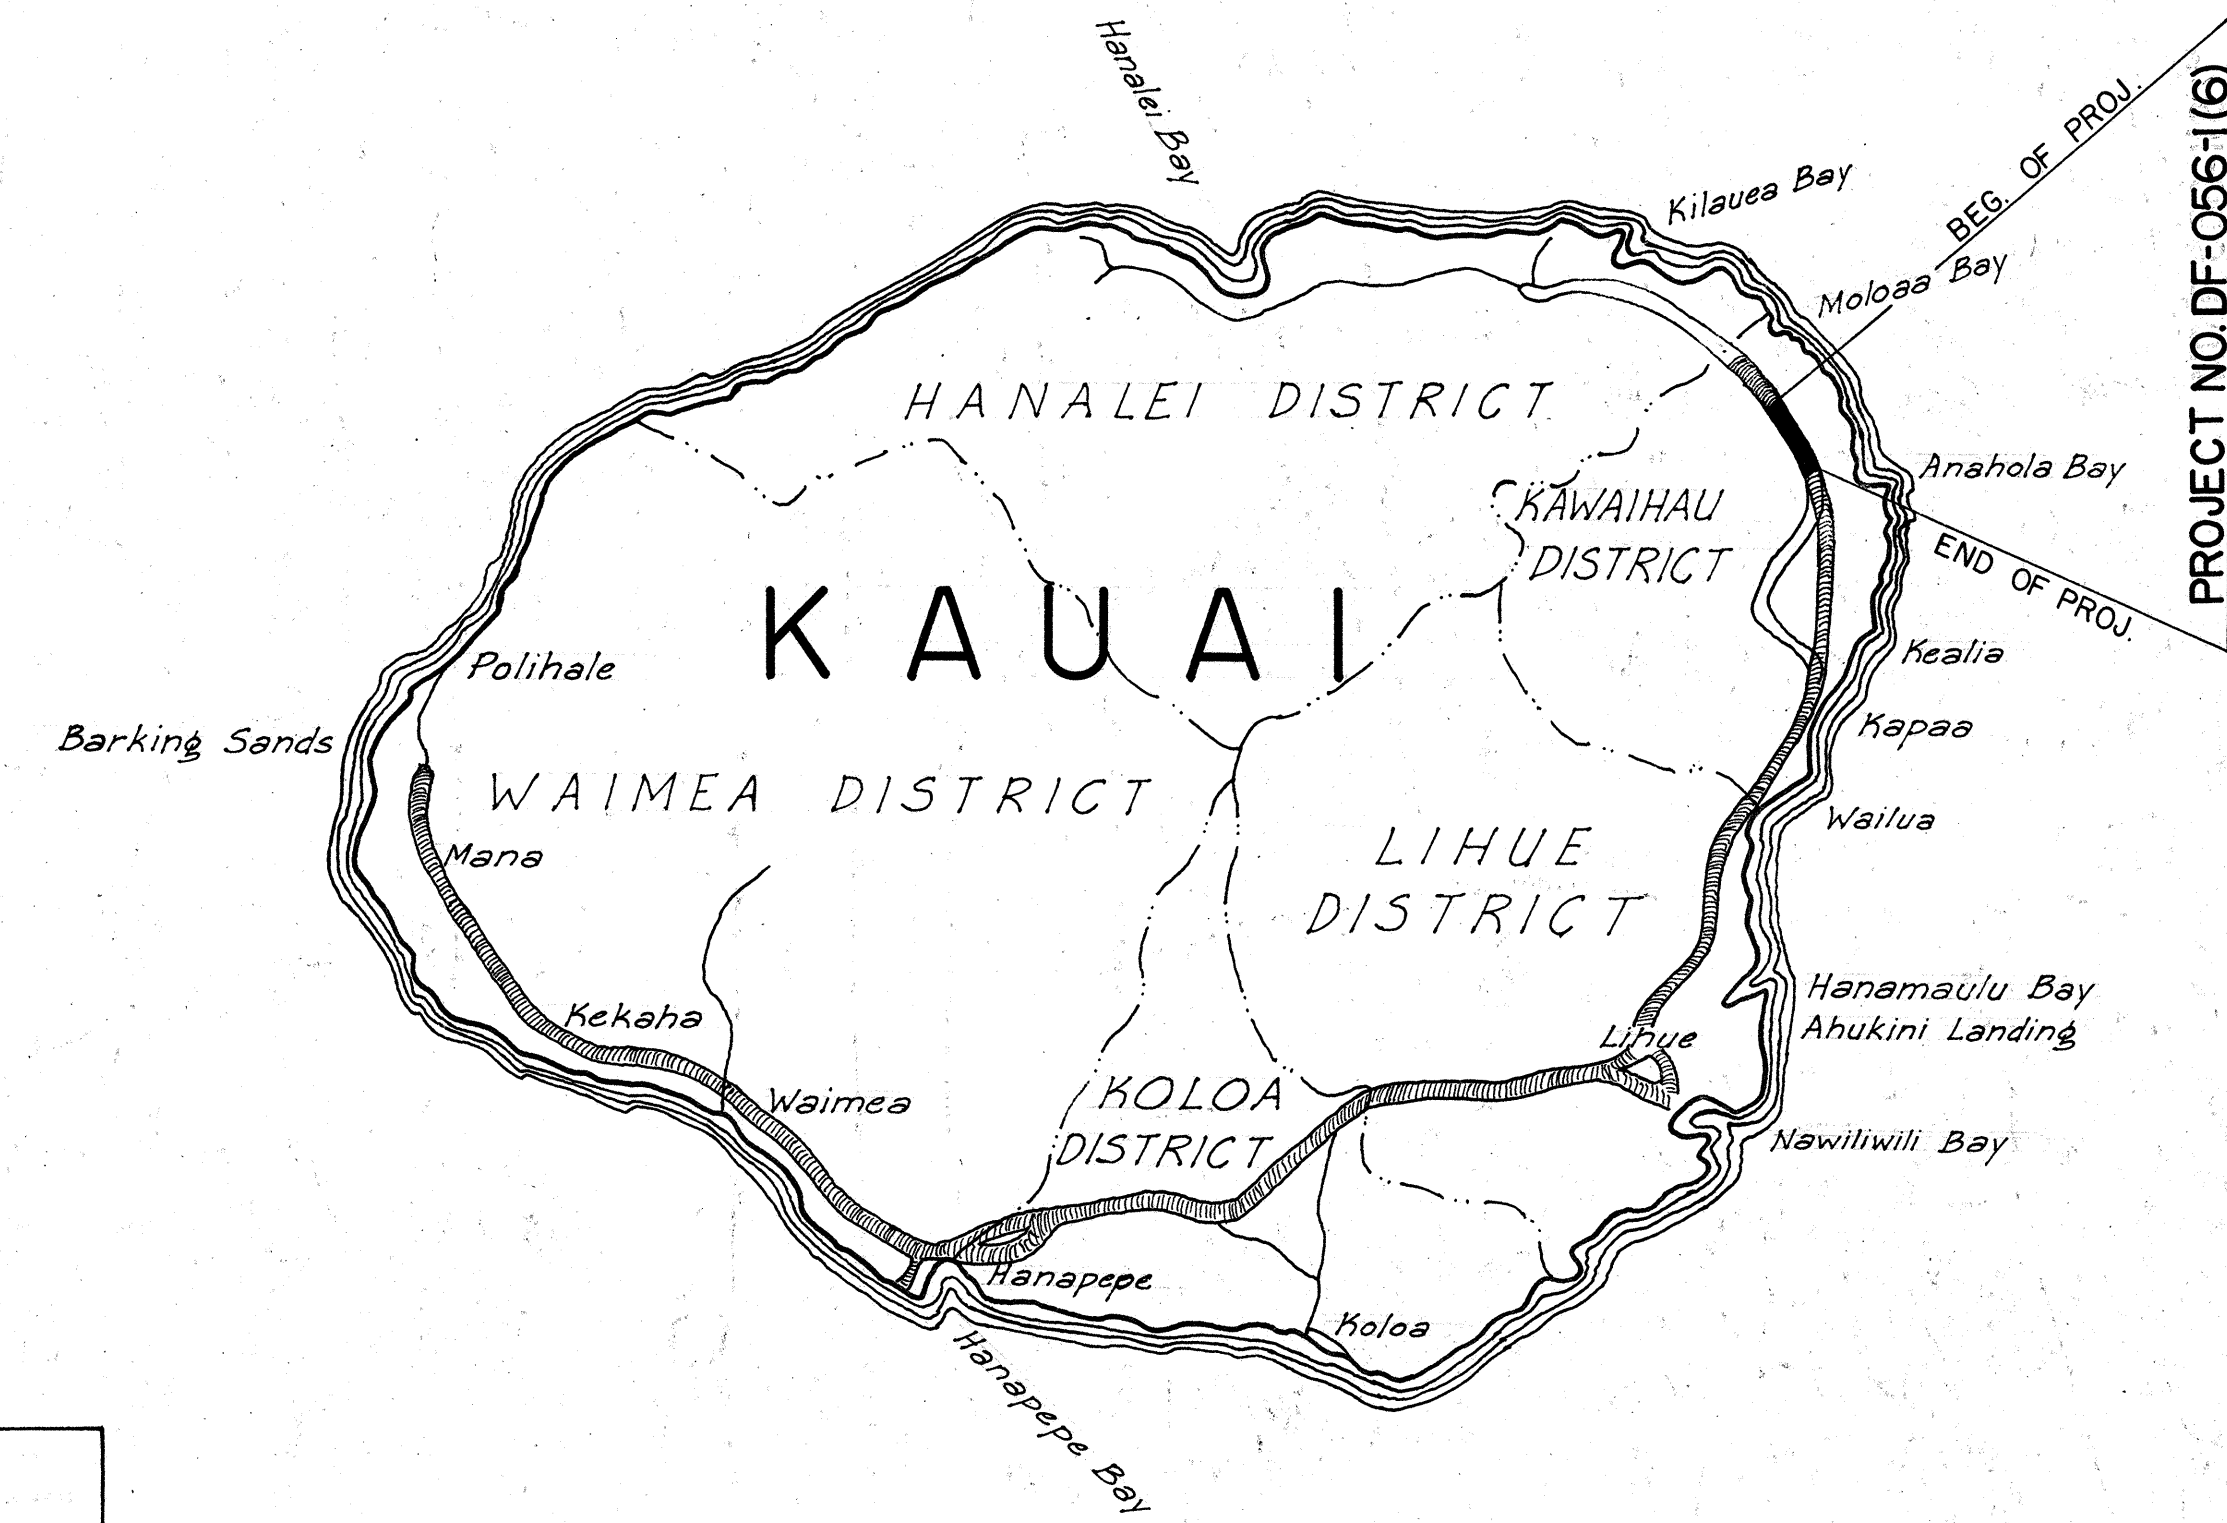


FEDERAL AID PROJECTS PREVIOUSLY CONSTRUCTED OR UNDER CONSTRUCTION

CONVENTIONAL SIGNS

Baseline	
Boundary Line	
Fences (Named)	
Existing Roadway	
Pipe Culvert	
Box Culvert	
Telephone Line & Pole	
Electric Line & Pole	
Water Main	

OCEAN

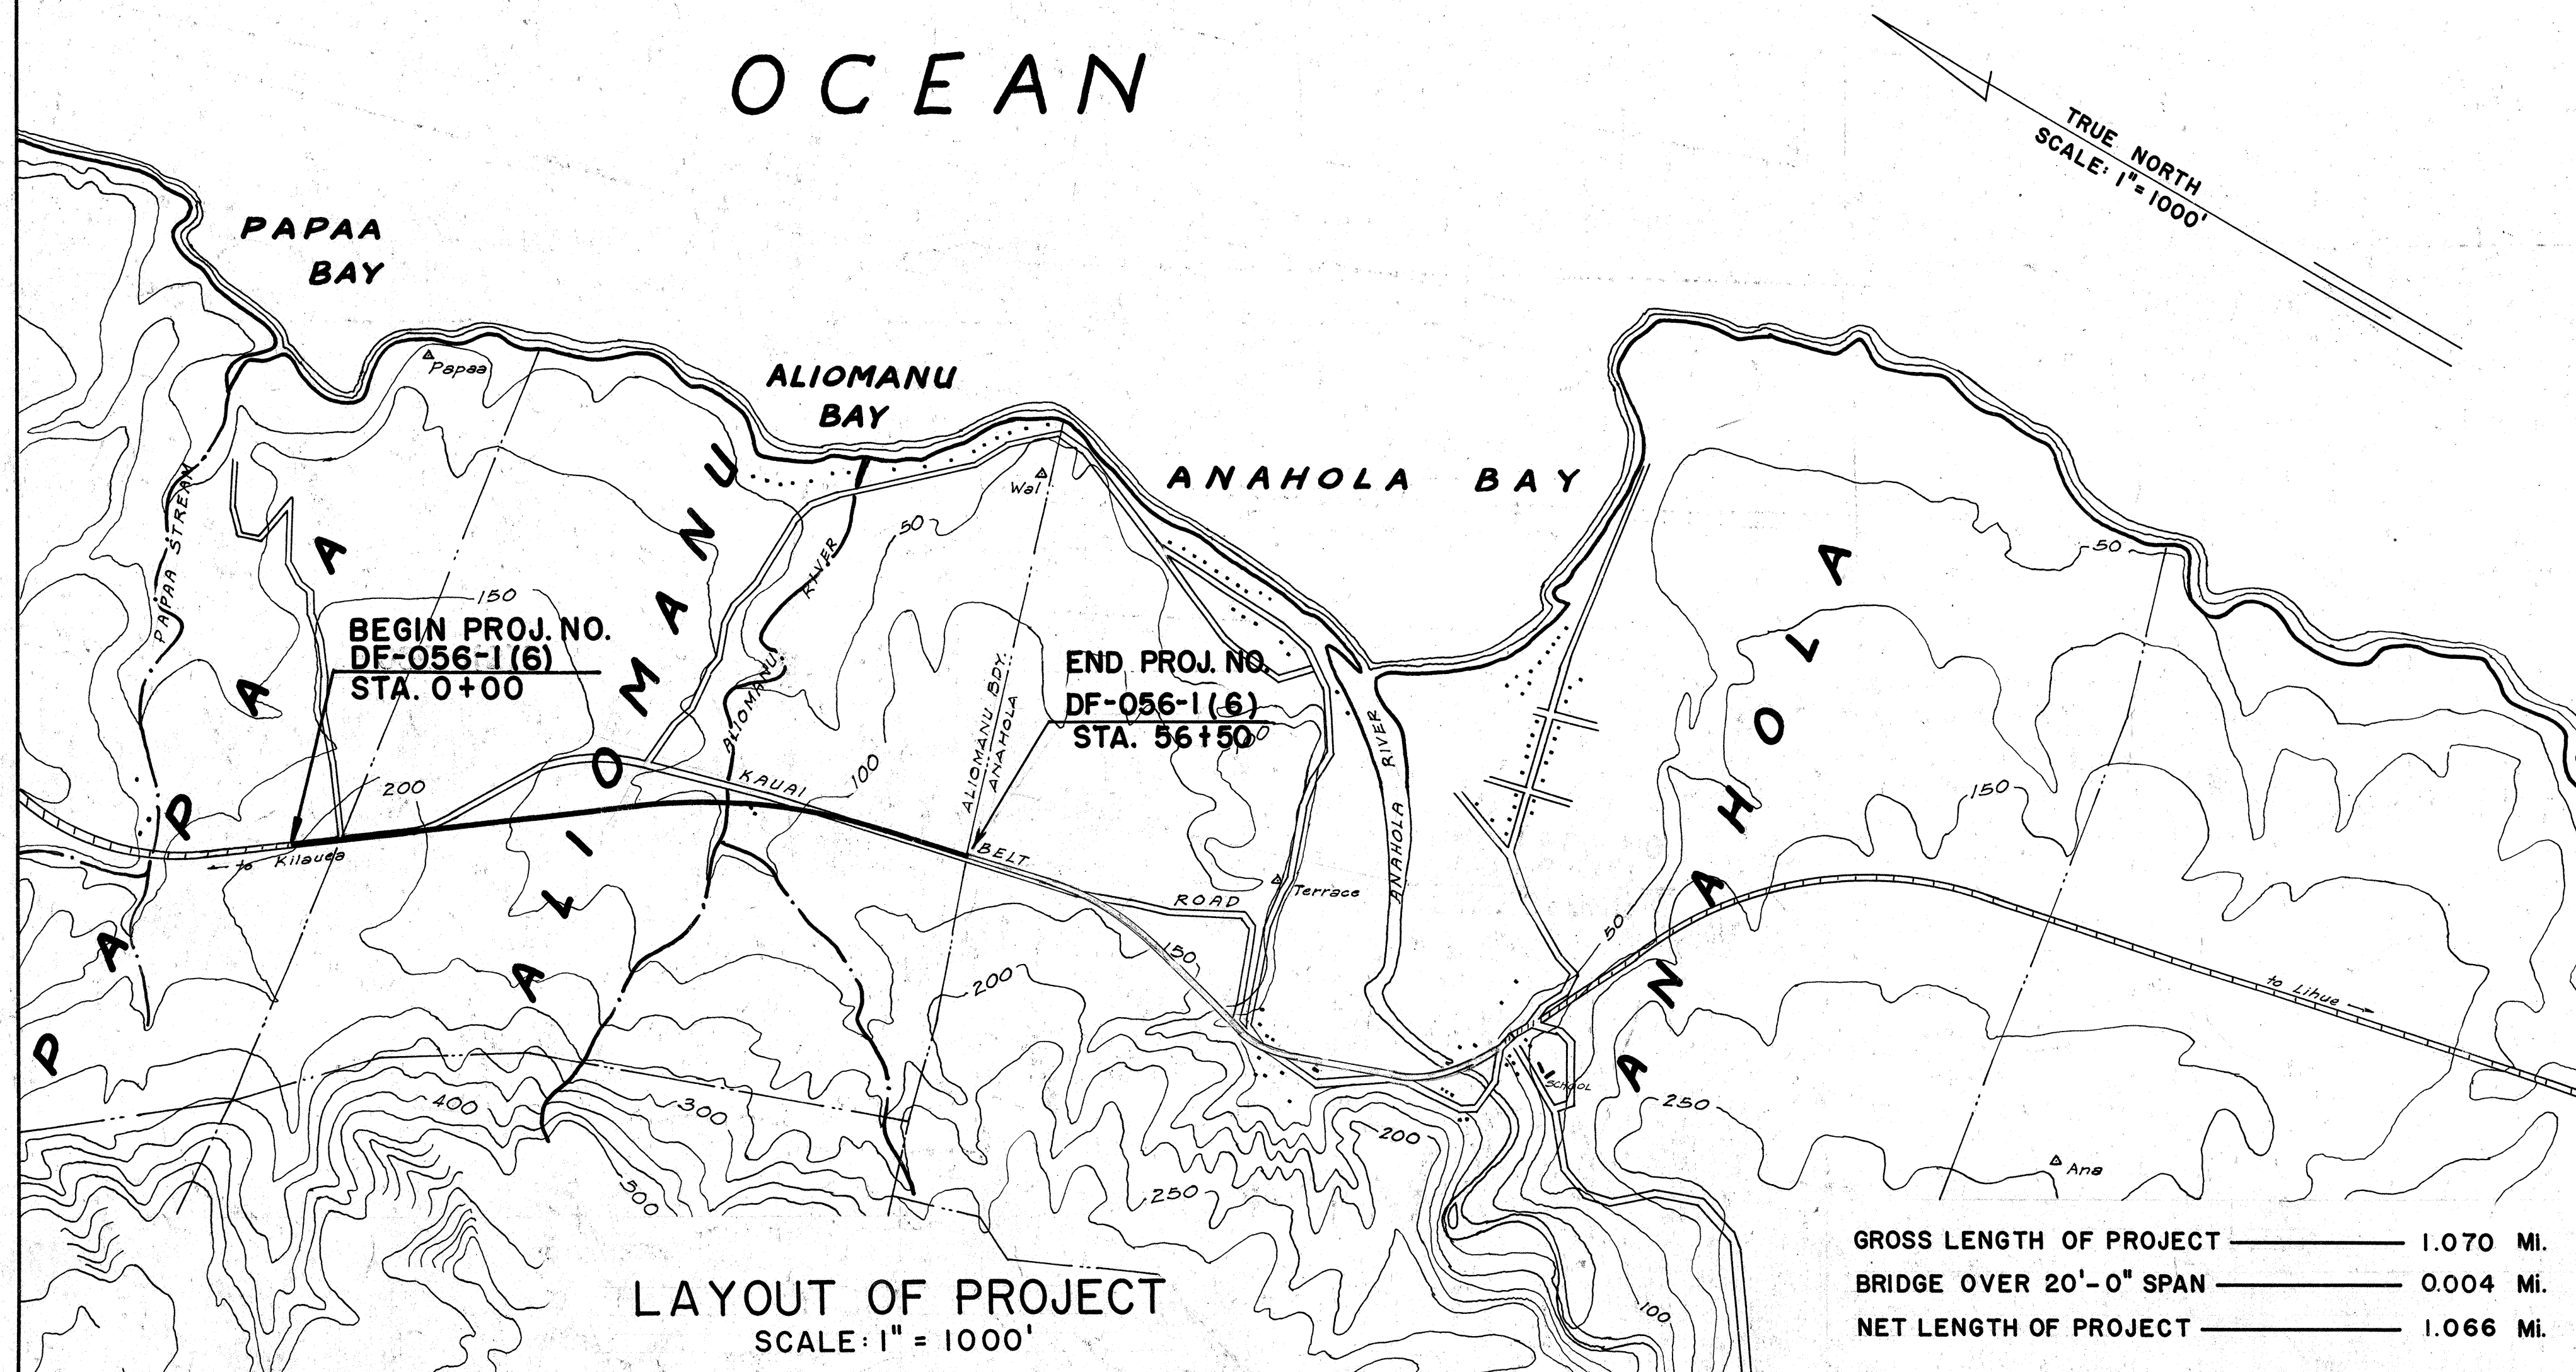

LAYOUT OF PROJECT
SCALE: 1" = 1000'

GROSS LENGTH OF PROJECT ----- 1.070 MI.
BRIDGE OVER 20'-0" SPAN ----- 0.004 MI.
NET LENGTH OF PROJECT ----- 1.066 MI.

NOTE:

ALL CHANGES MADE DURING CONSTRUCTION HAVE BEEN NOTED IN THESE TRACINGS IN RED AND CHECKED BY

Steve Gamack
RESIDENT ENGINEER

11-29-60
DATE

DESIGNED BY	DATE
DRAWN BY	
TRACED BY	
QUANTITIES CHECKED BY	
CHECKED BY	

APPROVED: _____ DATE 8/26/58
Wm. Wachtel
TERRITORIAL HIGHWAY ENGINEER

DEPARTMENT OF COMMERCE
BUREAU OF PUBLIC ROADS
APPROVED: _____
DIVISION ENGINEER DATE