


FINAL	SURVEY	DATE
NOTE BOOK	NO.	BY
SURVEY		DATE
PLOT		DATE
CHECKED		DATE

ORIGINAL	SURVEY	DATE
NOTE BOOK	NO.	BY
SURVEY		DATE
PLOT		DATE
CHECKED		DATE


FED. ROAD DIST. NO.	STATE	FED. AID PROJ. NO.	FISCAL YEAR	SHEET NO.	TOTAL SHEETS
HAWAII	HAW.	DF-056-1(6)	1958	20	20
HAWAII	HAW.	F-056-1(7)	1958	32	54

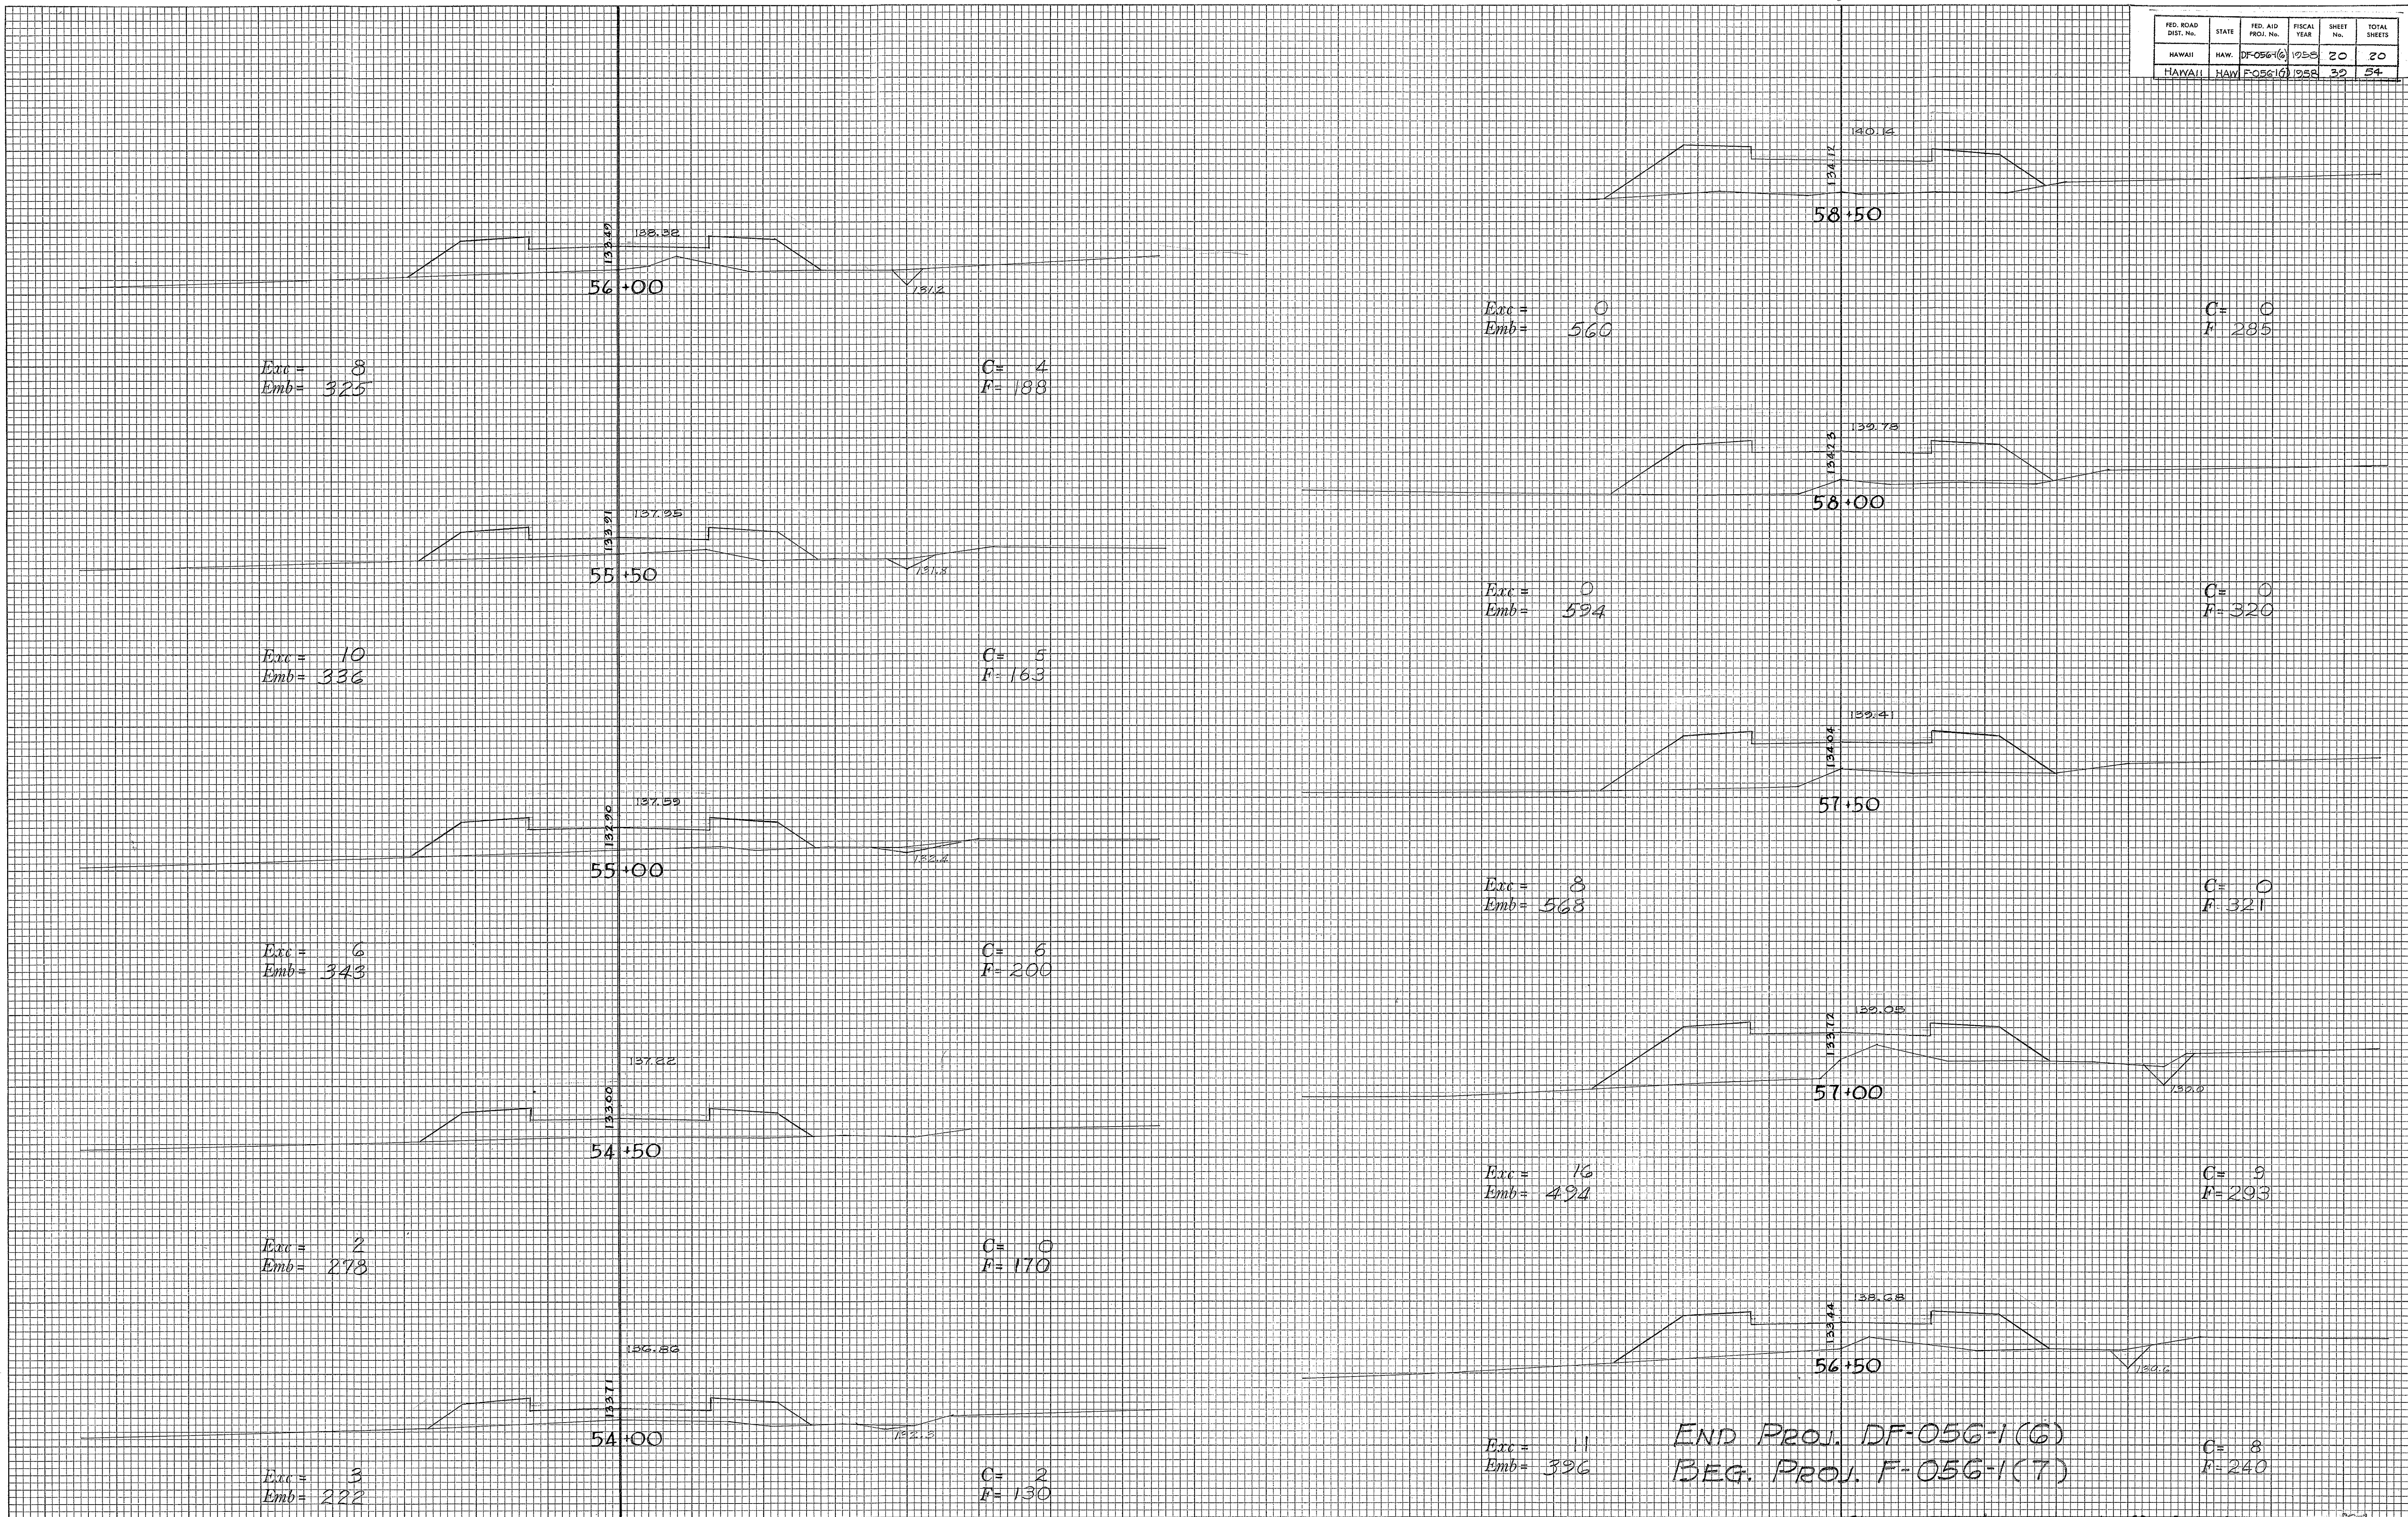

FINAL	SURVEY	DATE
NO.	BY	
NOTE BOOK	PLOTTED	
AREAS CHECKED	AREAS CHECKED	

ORIGINAL	SURVEY	DATE
NO.	BY	
NOTE BOOK	PLOTTED	
AREAS CHECKED	AREAS CHECKED	


FED. ROAD DIST. No.	STATE	FED. AID PROJ. No.	FISCAL YEAR	SHEET No.	TOTAL SHEETS
HAWAII	HAW.	F-05616	1958	40	54

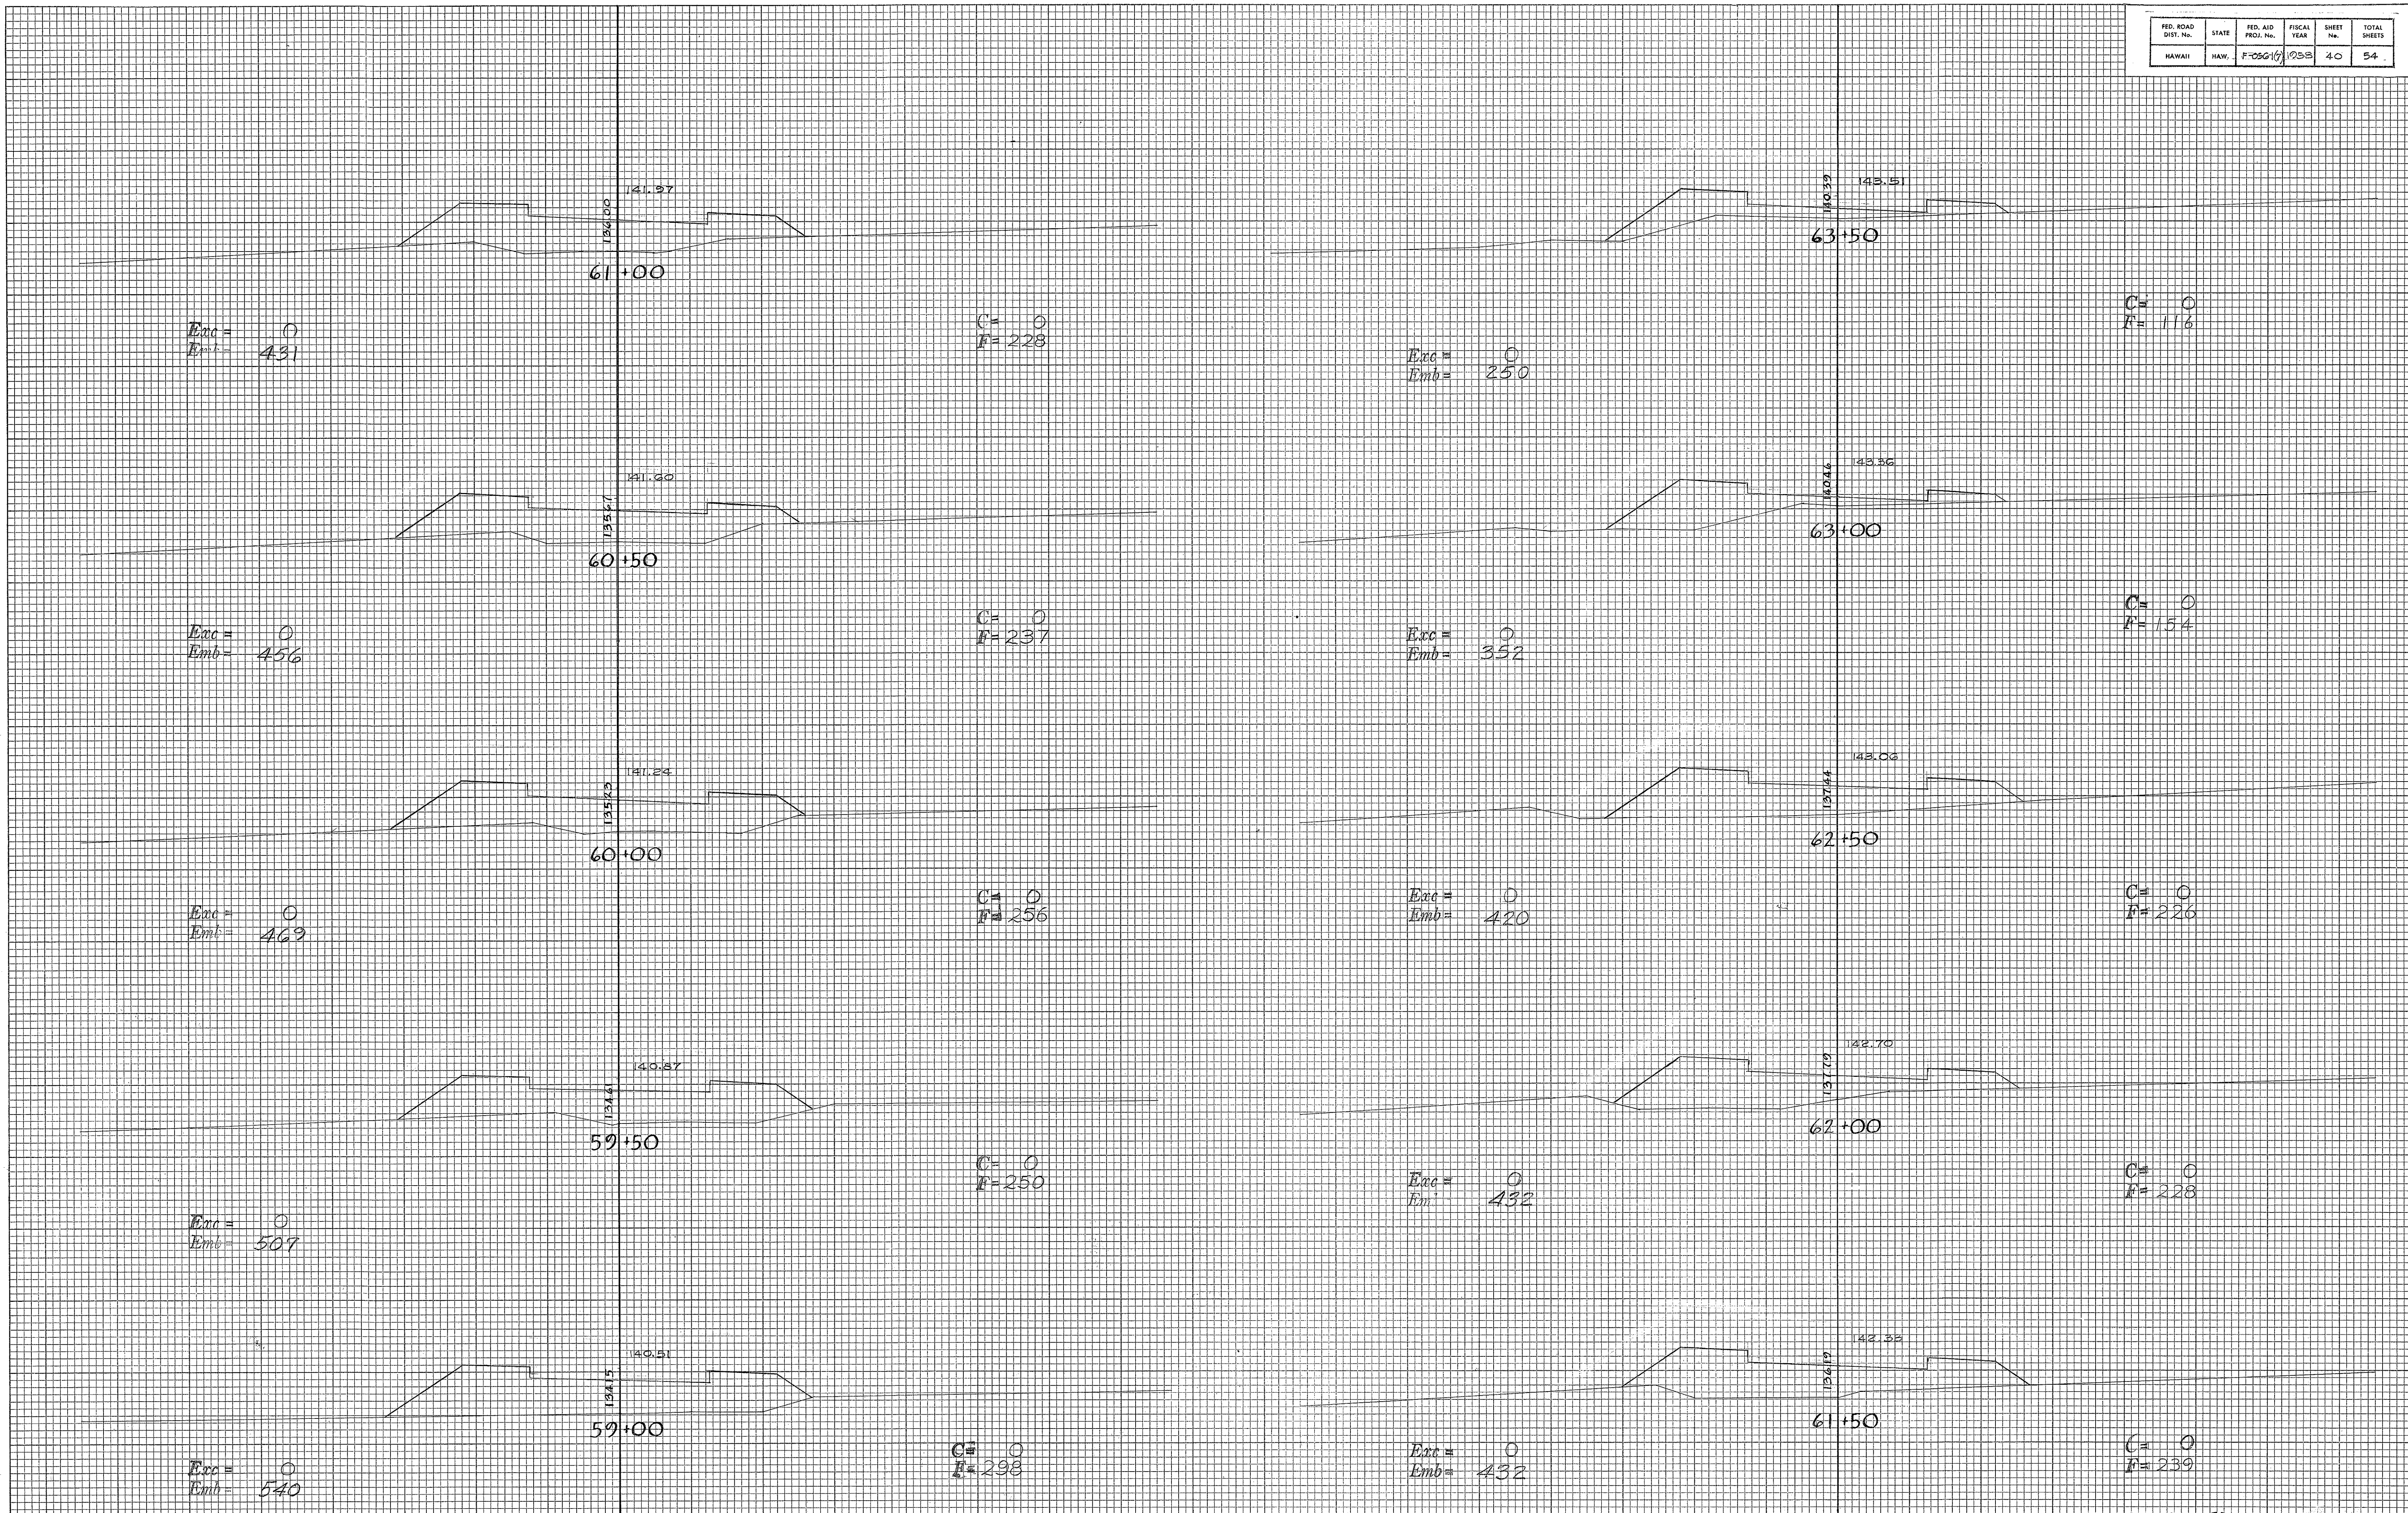

FED. ROAD DIST. No.	STATE	FED. AID PROJ. No.	FISCAL YEAR	SHEET No.	TOTAL SHEETS
HAWAII	HAW.	F-036(7)	1958	41	54

FINAL SURVEY	NO.	BY	DATE	SURVEYED
				PLOTTED
				NOTE BOOK
				AREAS CHECKED


ORIGINAL SURVEY	NO.	BY	DATE	SURVEYED
				PLOTTED
				NOTE BOOK
				AREAS CHECKED

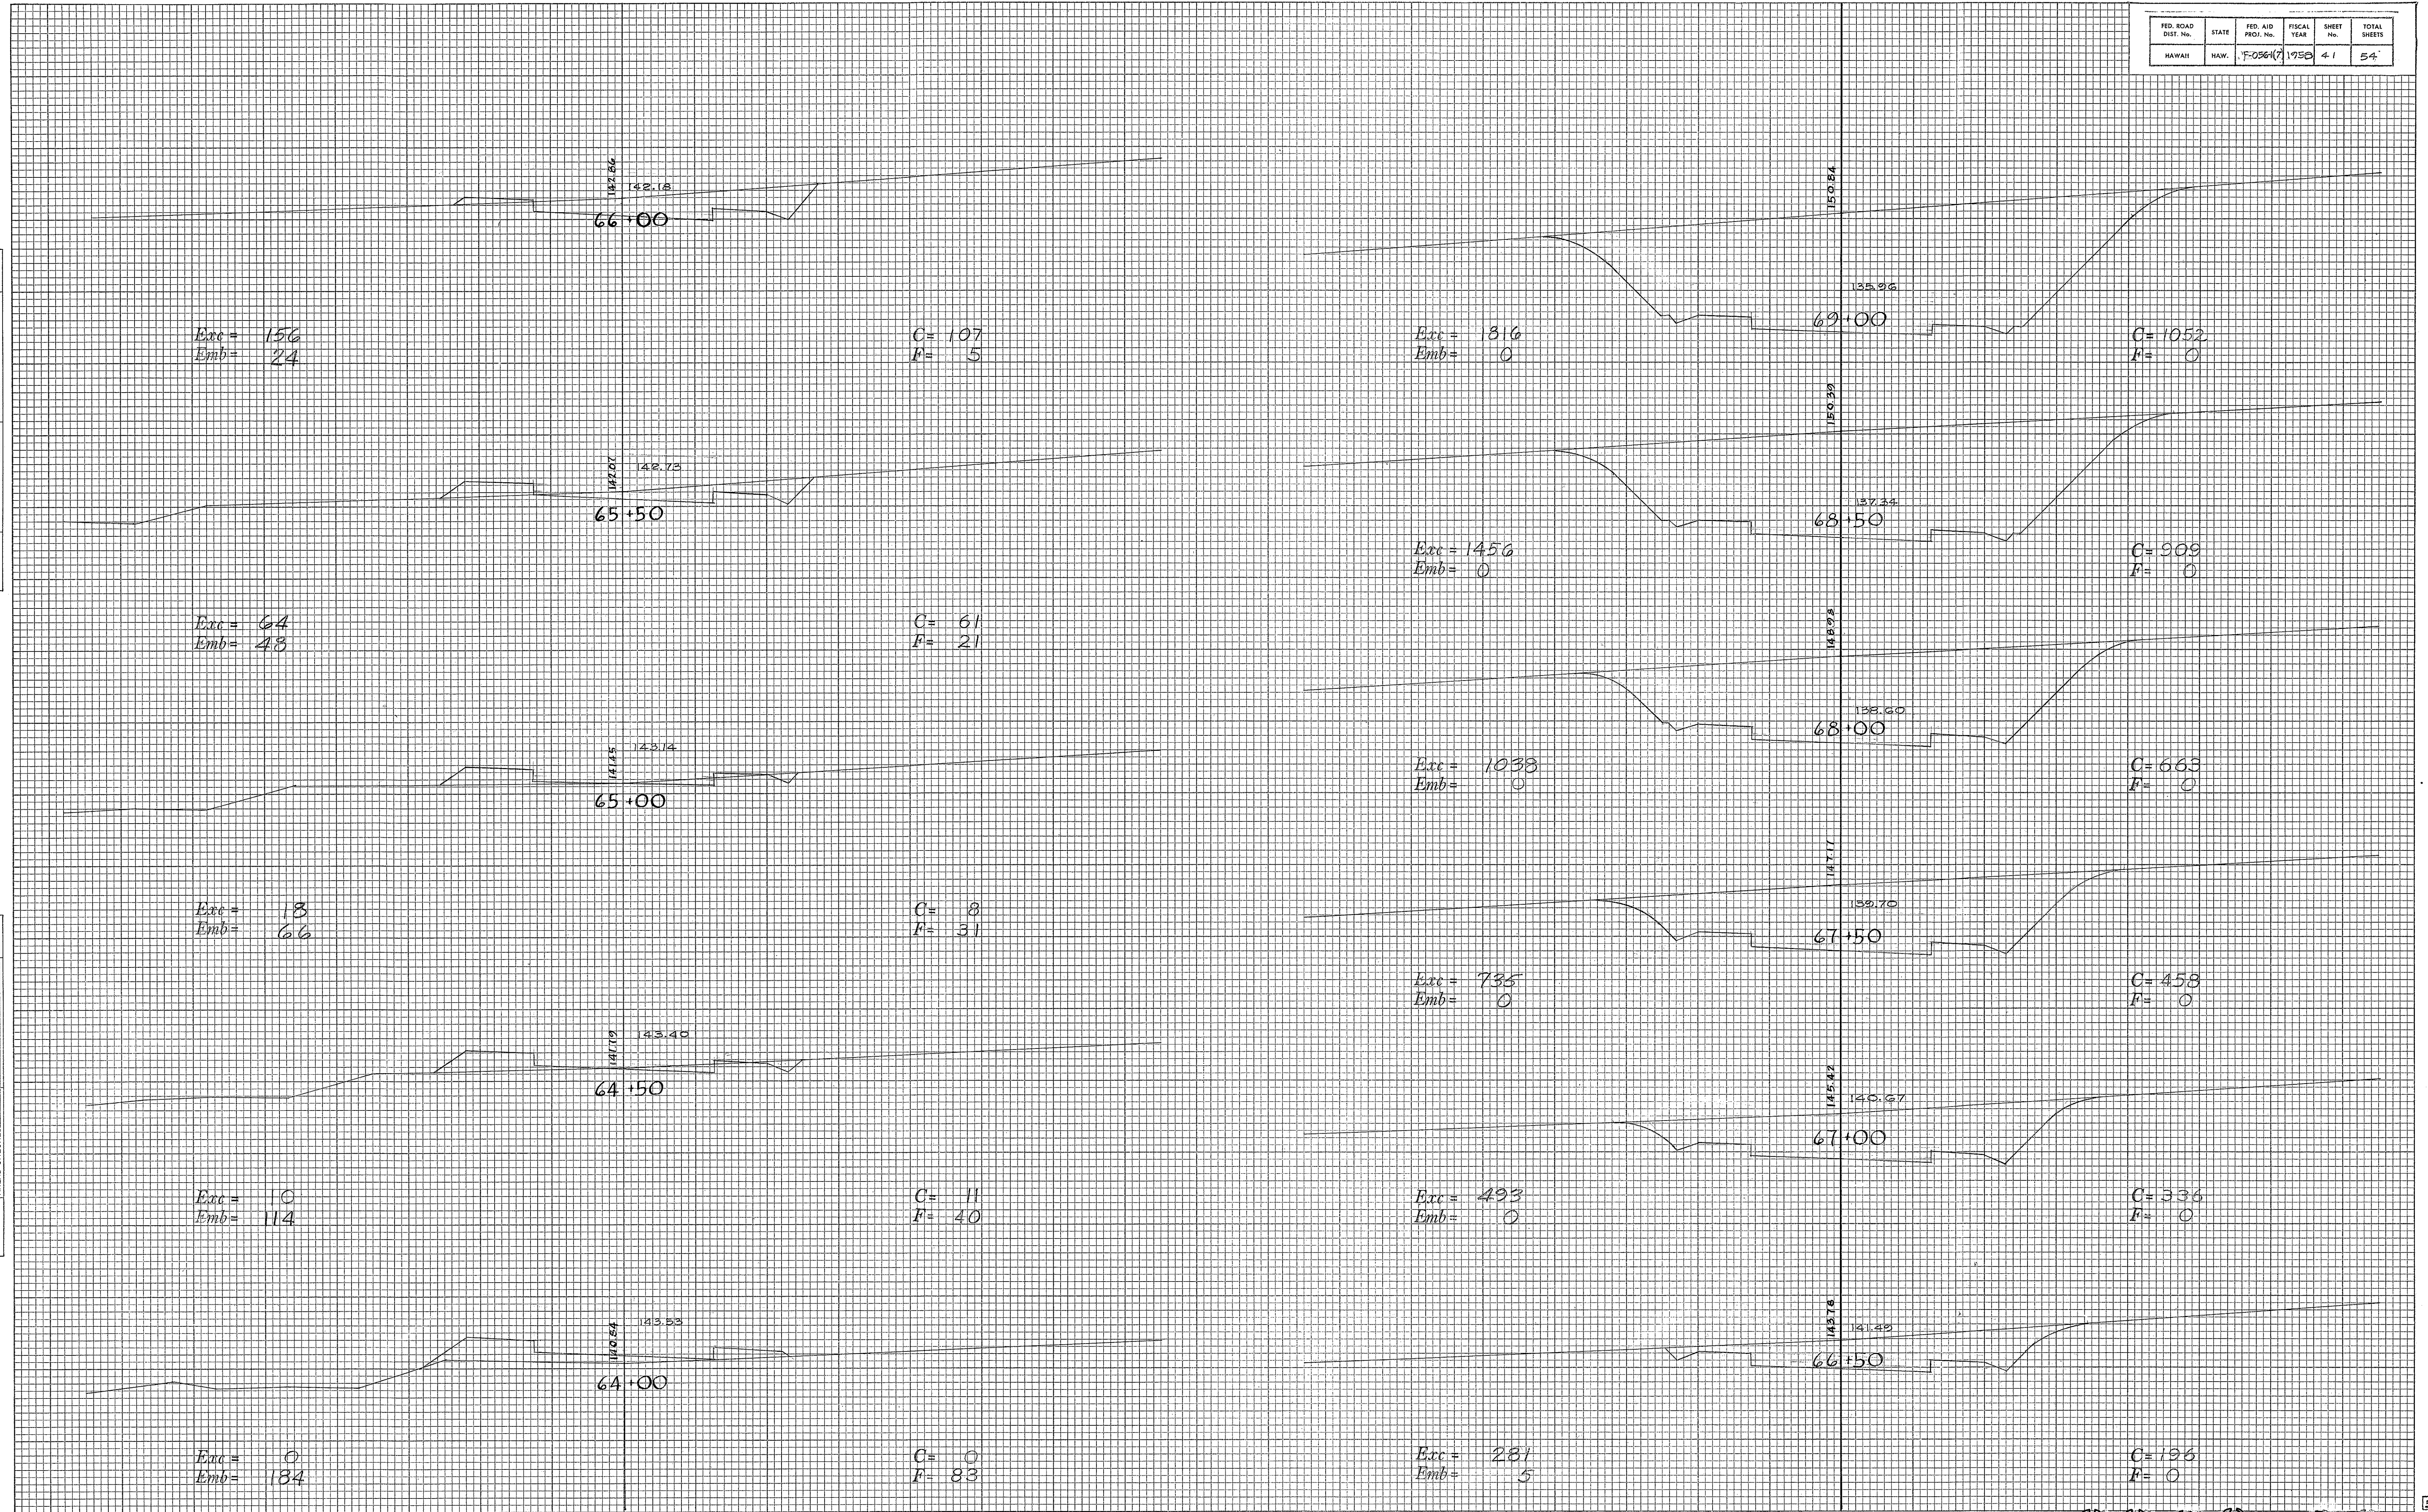

FINAL SURVEY	DATE	BY
	SURVEYED	BY
	NOTE BOOK	NO.
	AREAS CHECKED	AREAS CHECKED

ORIGINAL SURVEY	DATE	BY
	SURVEYED	BY
	NOTE BOOK	NO.
	AREAS CHECKED	AREAS CHECKED




FED. ROAD DIST. No.	STATE	FED. AID PROJ. No.	FISCAL YEAR	SHEET No.	TOTAL SHEETS
HAWAII	HAW.	5036(7)	1958	42	54

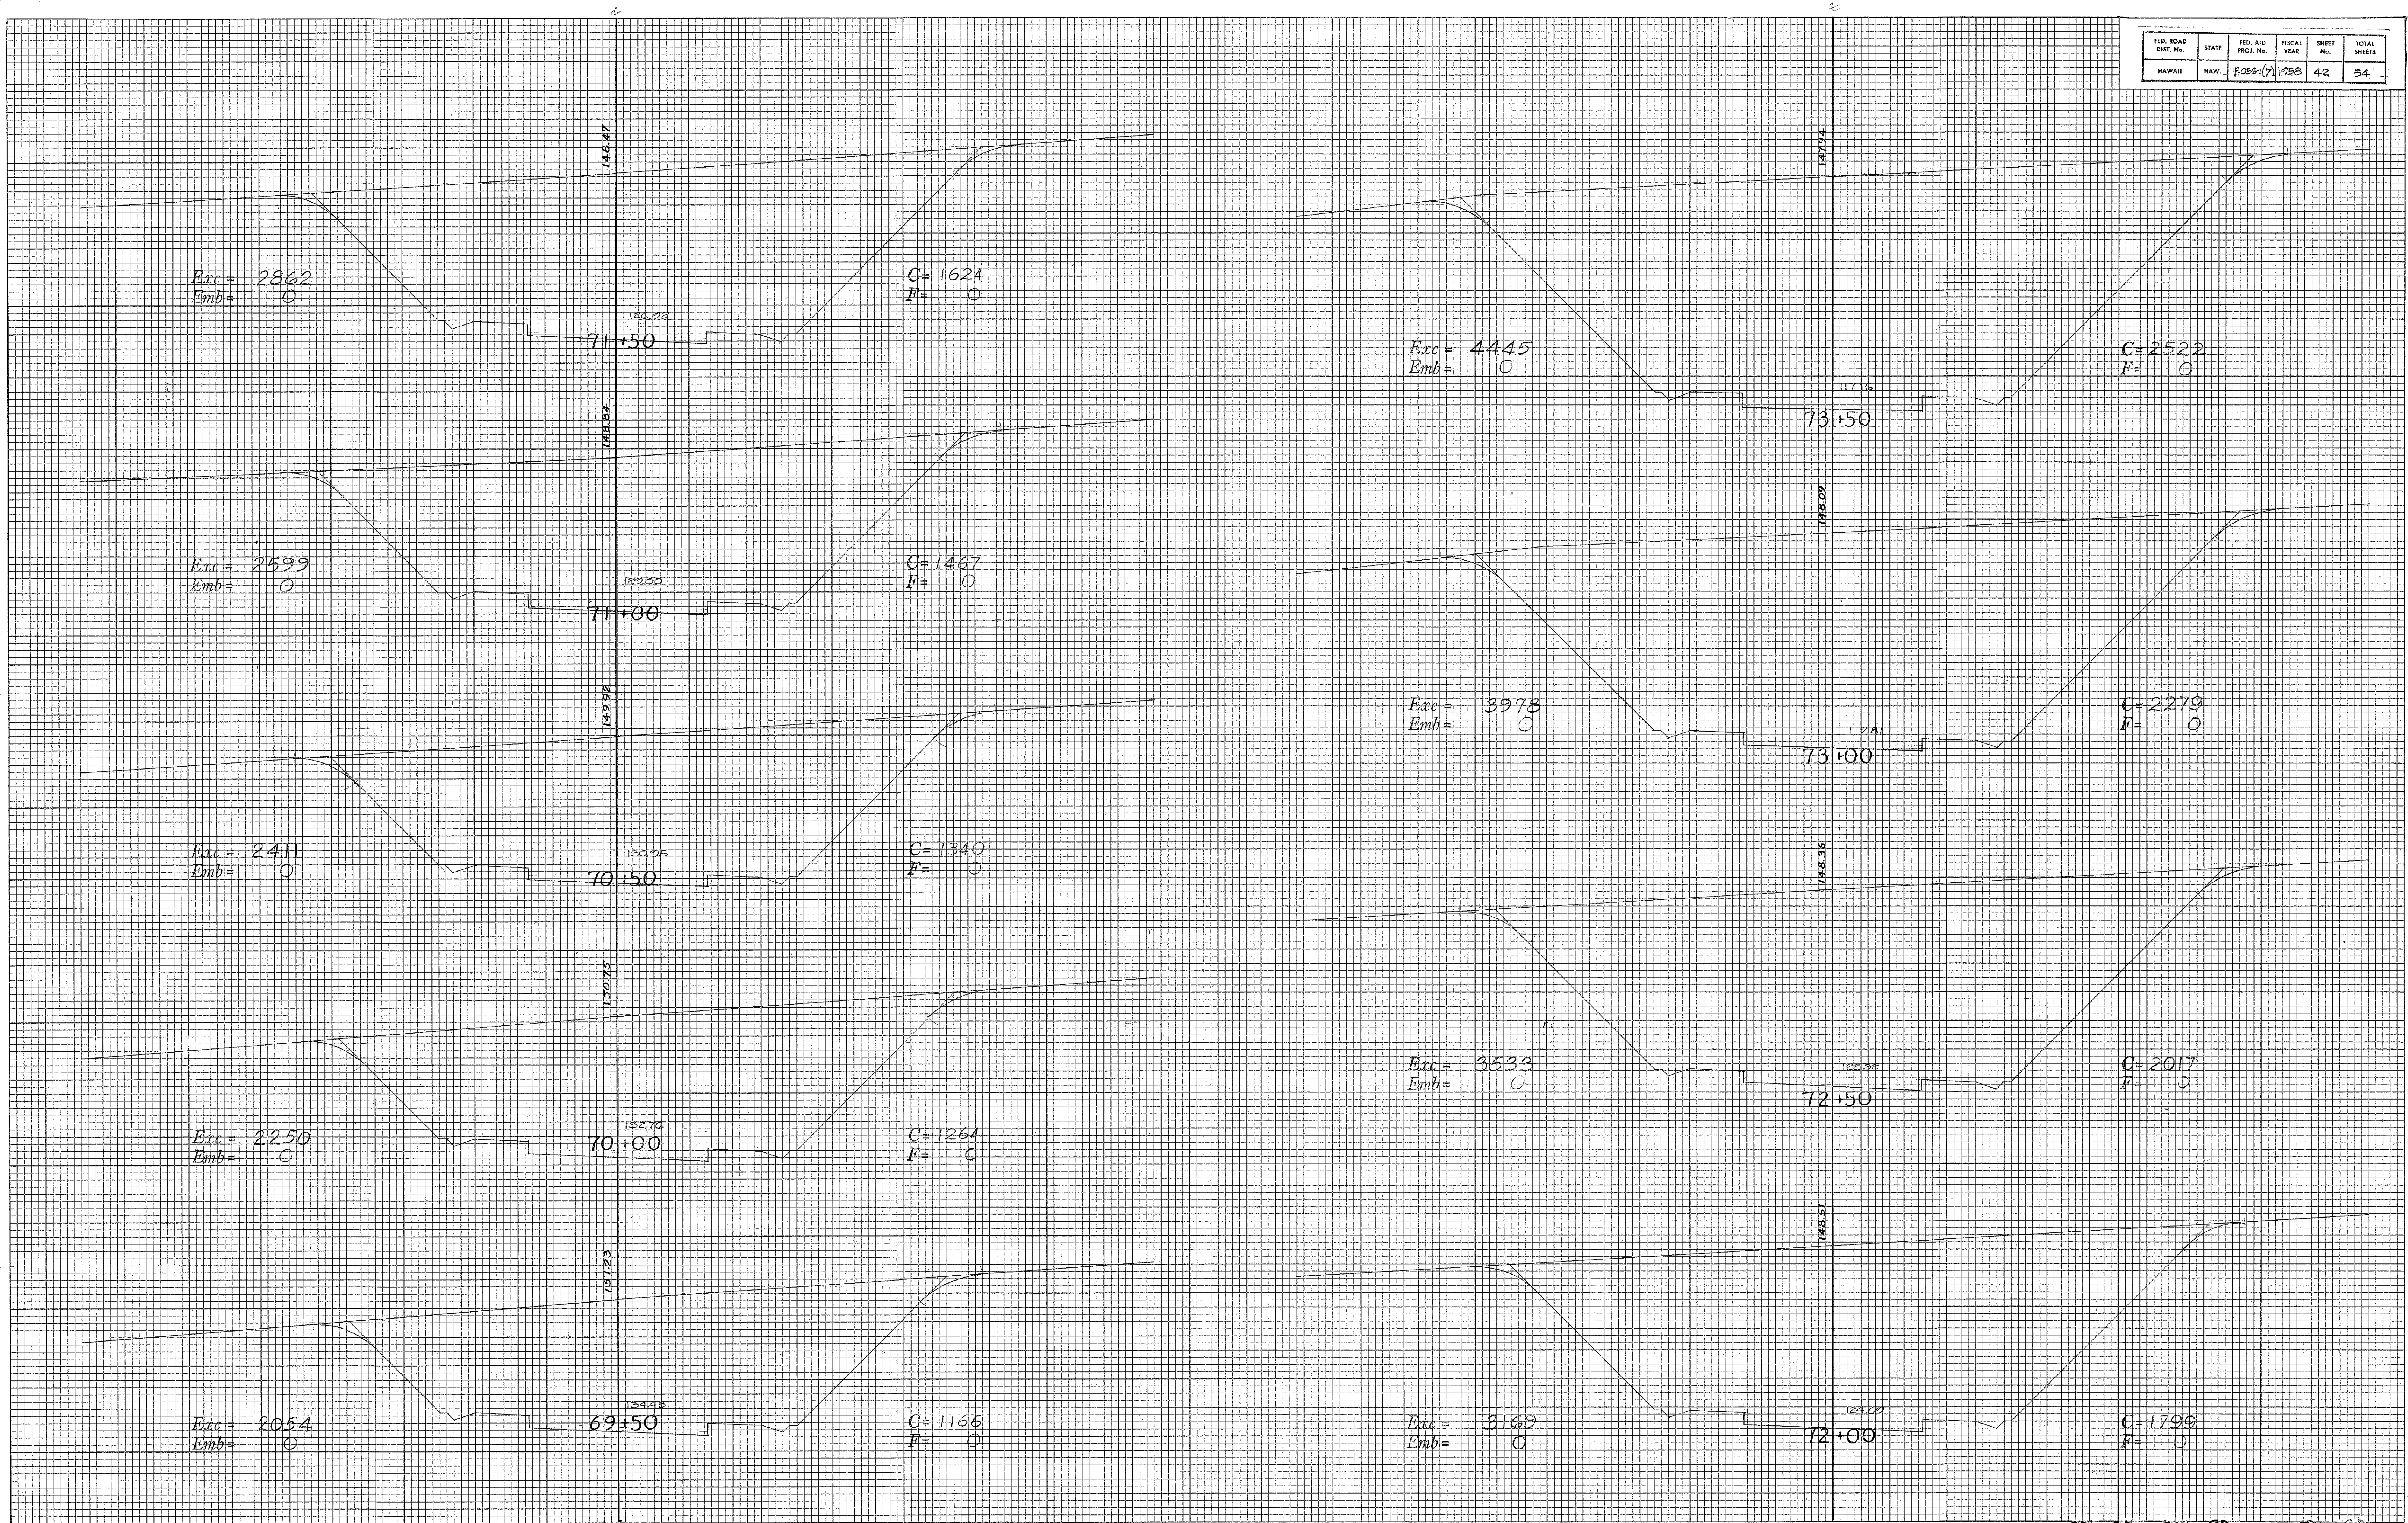

FINAL SURVEY	SURVEYED	DATE
	PLOTTED	BY
	NOTE BOOK	
	NO.	

ORIGINAL SURVEY	SURVEYED	DATE
	PLOTTED	BY
	NOTE BOOK	
	NO.	

FED. ROAD DIST. No.	STATE	FED. AID PROJ. No.	FISCAL YEAR	SHEET No.	TOTAL SHEETS
HAWAII	HAW.	F-056-17	1953	43	54

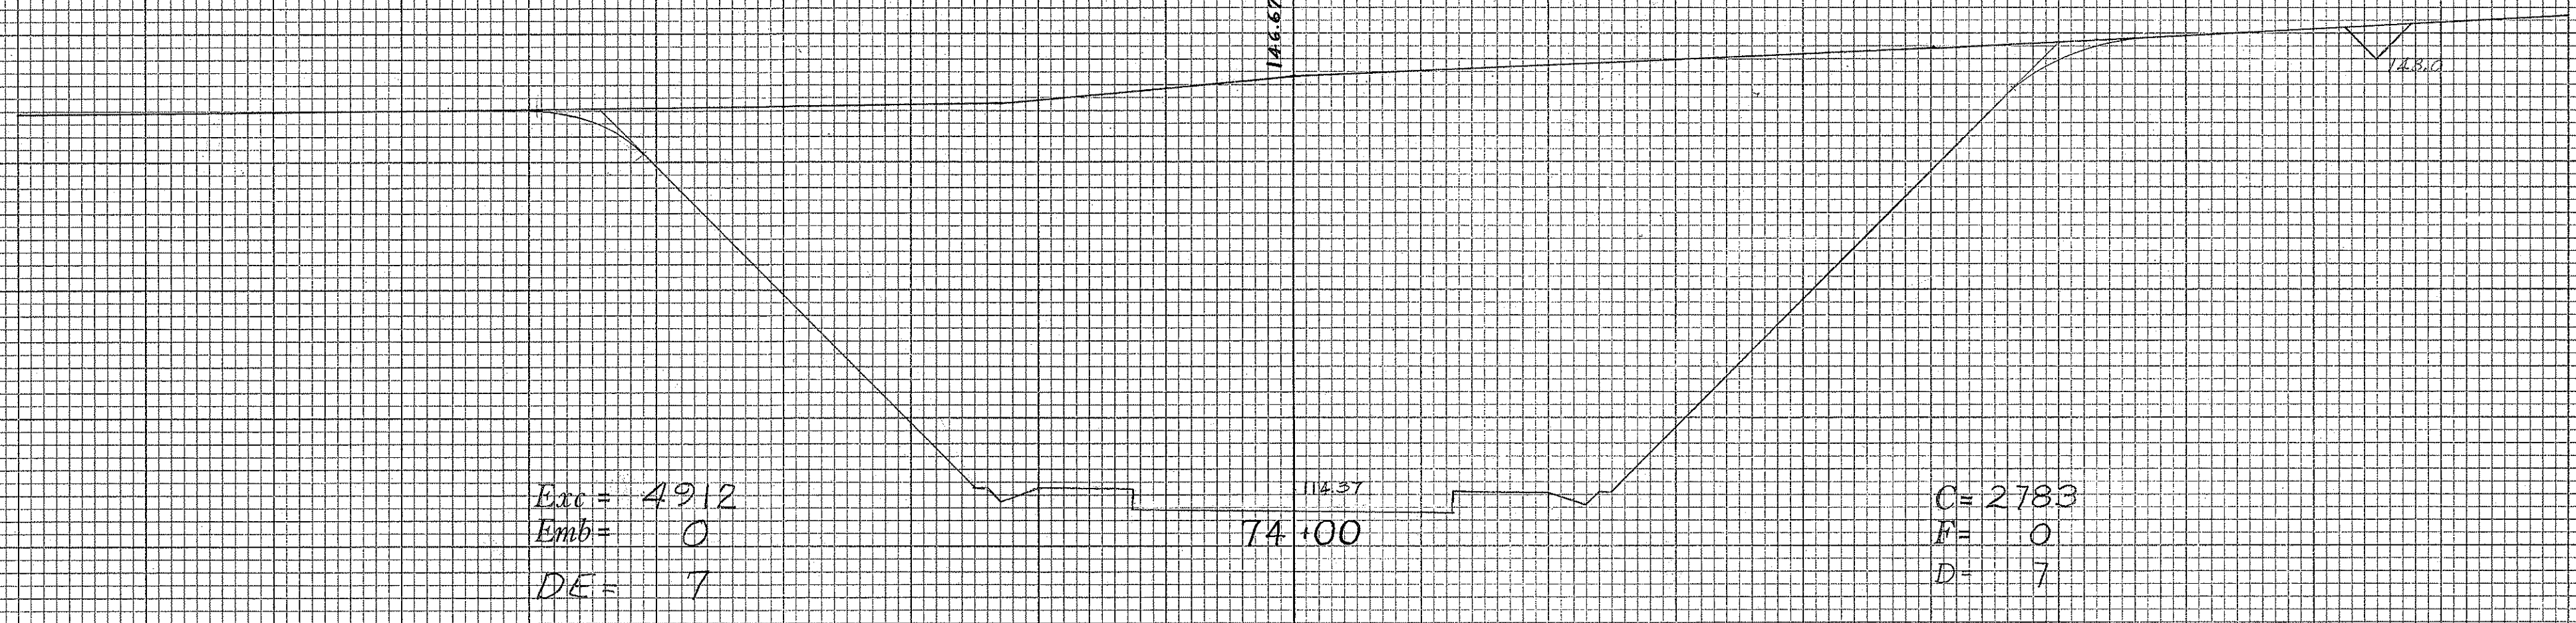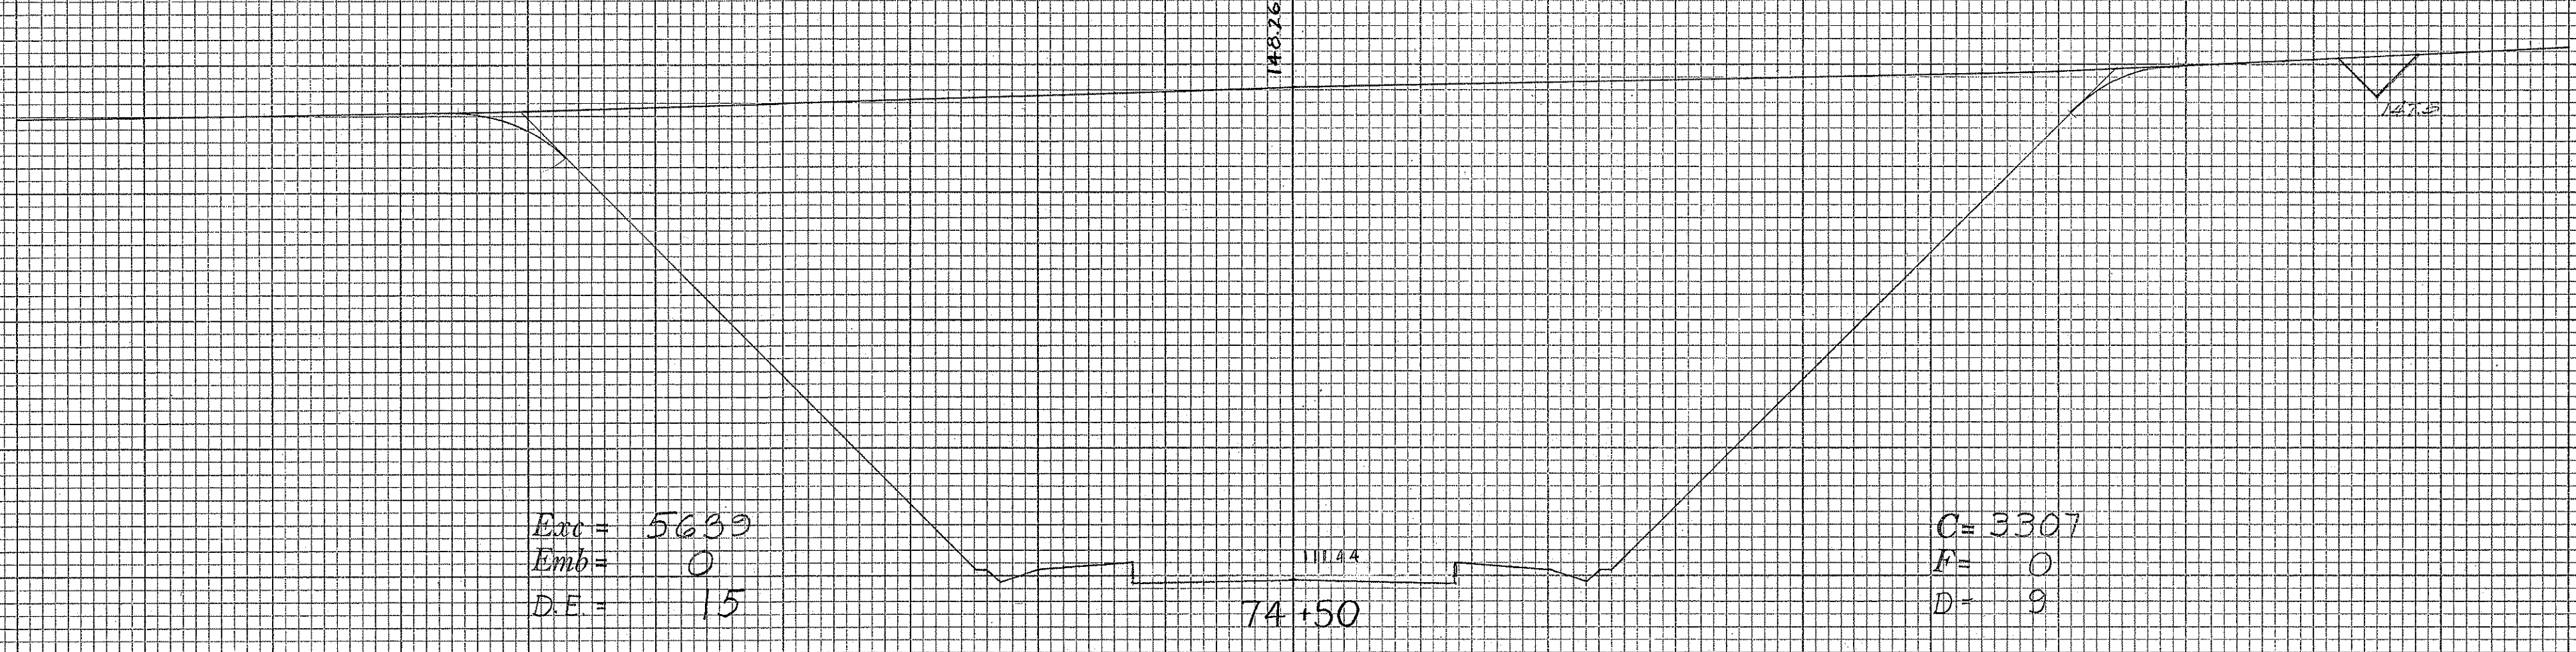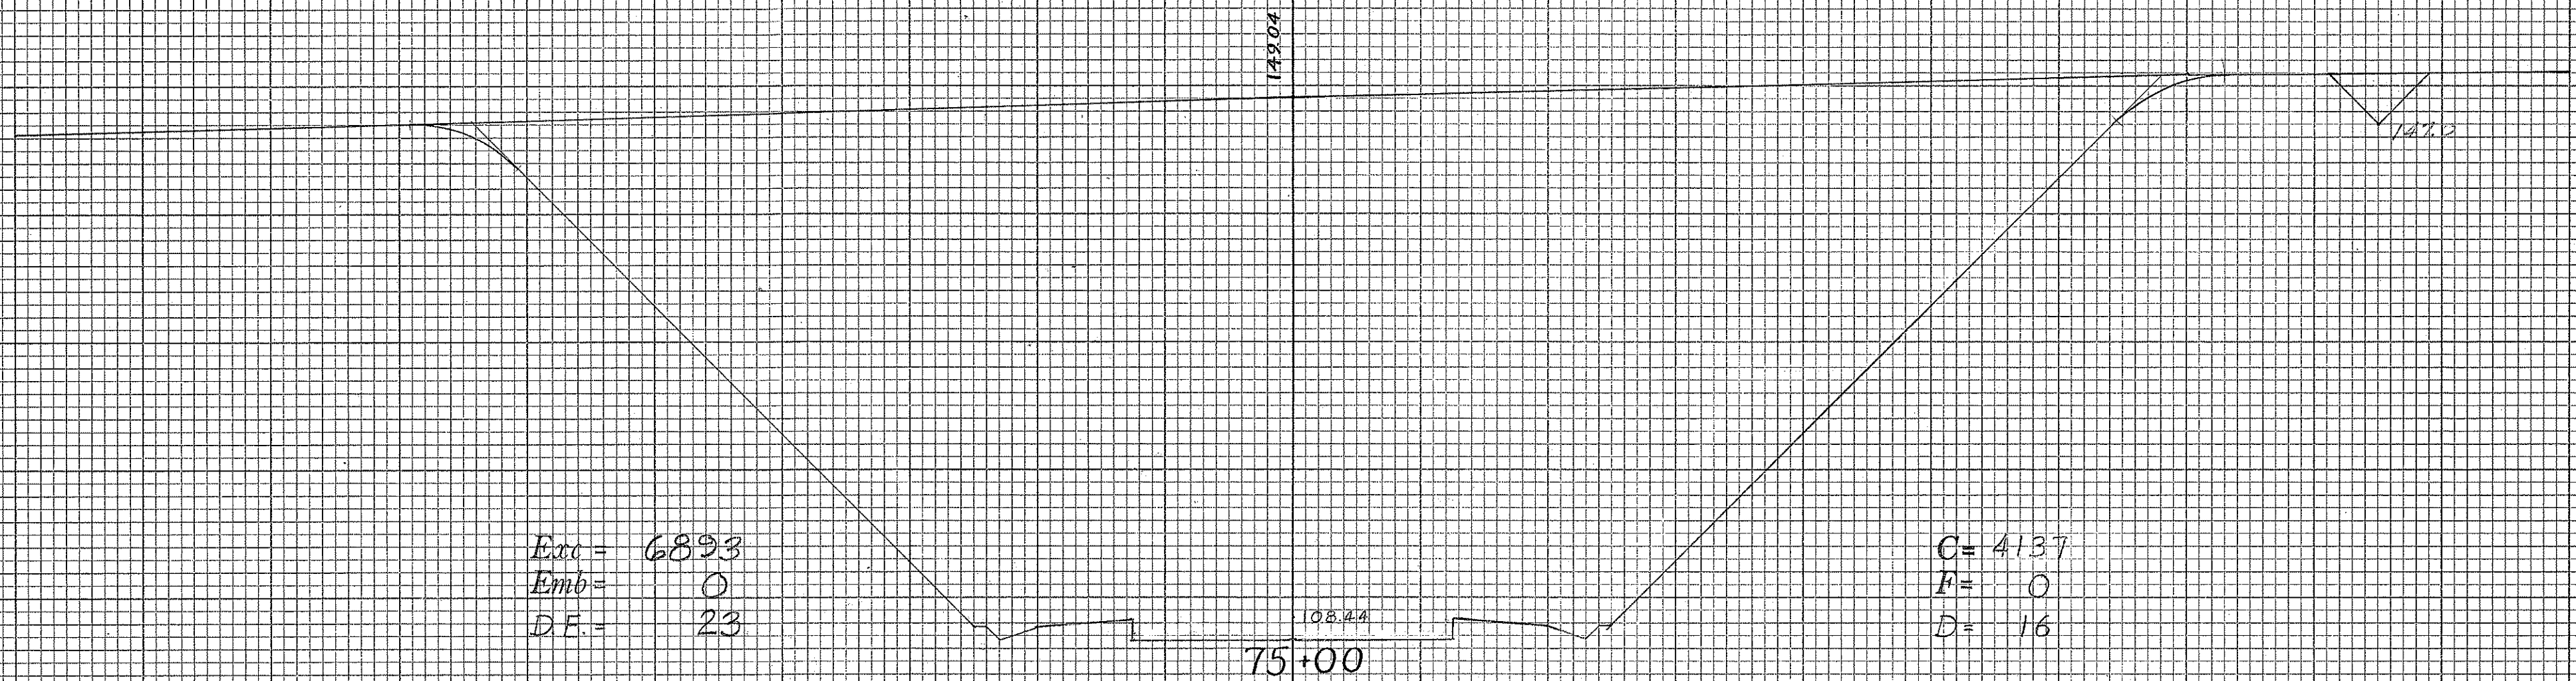

FINAL	DATE
SURVEY	BY
NOTE BOOK	
NO.	

ORIGINAL	DATE
SURVEY	BY
NOTE BOOK	
NO.	

FED. ROAD DIST. No.	STATE	FED. AID PROJ. No.	FISCAL YEAR	SHEET No.	TOTAL SHEETS
HAWAII	HAW.	F-056-17	1958	44	54

Exc = 6793
Emb = 0
D.E = 17

C = 3498
F = 0
D = 2

Exc = 7329
Emb = 0
D.E = 27

C = 3848
F = 0
D = 9

Exc = 7536
Emb = 0
D.E = 34

C = 4067
F = 0
D = 20

FINAL SURVEY	BY	DATE
		NO.
		NO.
		NO.

ORIGINAL SURVEY	BY	DATE
		NO.
		NO.
		NO.

FED. ROAD DIST. No.	STATE	FED. AID PROJ. No.	FISCAL YEAR	SHEET No.	TOTAL SHEETS
HAWAII	HAW.	7056(7)	1958	45	54

Exc = 5977
Emb = 0
DF = 17

C = 3087
F = 0
D = 9

Exc = 6358
Emb = 0
DF = 17

C = 3368
F = 0
D = 9

Exc = 6469
Emb = 0
DF = 17

C = 3490
F = 0
D = 9

FED. ROAD DIST. No.	STATE	FED. AID PROJ. No.	FISCAL YEAR	SHEET No.	TOTAL SHEETS
HAWAII	HAW.	F036-17	1958	46	54

FINAL SURVEY	SURVEYED	BY	DATE
NOTE BOOK NO.	PLOTTED DATE		
	AREAS CHECKED		

ORIGINAL SURVEY	SURVEYED	BY	DATE
NOTE BOOK NO.	PLOTTED DATE		
	AREAS CHECKED		

Exc = 5603
Emb = 0

C = 3141
F = 0

79+50

Exc = 4946
Emb = 0

C = 2910
F = 0

79+00

D.F. = 15

STA 78+80.0 - END DITCH

Exc = 5110
Emb = 0
D.F. = 17

C = 2432
F = 0
D = 9

78+50

FINAL SURVEY	SURVEYED	BY	DATE
	NOTE BOOK		
	AREAS		
	AREAS CHECKED		

ORIGINAL SURVEY	SURVEYED	BY	DATE
	NOTE BOOK		
	AREAS		
	AREAS CHECKED		

FED. ROAD DIST. No.	STATE	FED. AID PROJ. No.	FISCAL YEAR	SHEET No.	TOTAL SHEETS
HAWAII	HAW.	F086-1(7)	1958	47	54

Exc = 2477
Emb = 110

73.95
72.44
81+00

C = 612
F = 119

Exc = 5263
Emb = 0

95.14
75.44
80+50

C = 2063
F = 0

Exc = 6261
Emb = 0

117.08
78.44
80+00

C = 3621
F = 0

FED. ROAD DIST. No.	STATE	FED. AID PROJ. No.	FISCAL YEAR	SHEET No.	TOTAL SHEETS
HAWAII	HAW.	E056(7)	1958	48	54

FINAL SURVEY	SURVEYED _____	BY _____ DATE _____
NOTE BOOK	PLOTTED _____	
	TEMPLATE _____	
	AREAS _____	
NO. _____	AREAS CHECKED _____	

ORIGINAL		BY	DATE
SURVEYED			
PLOTTED			
TEMPLATE			
AREAS			
NO.	AREAS CHECKED		

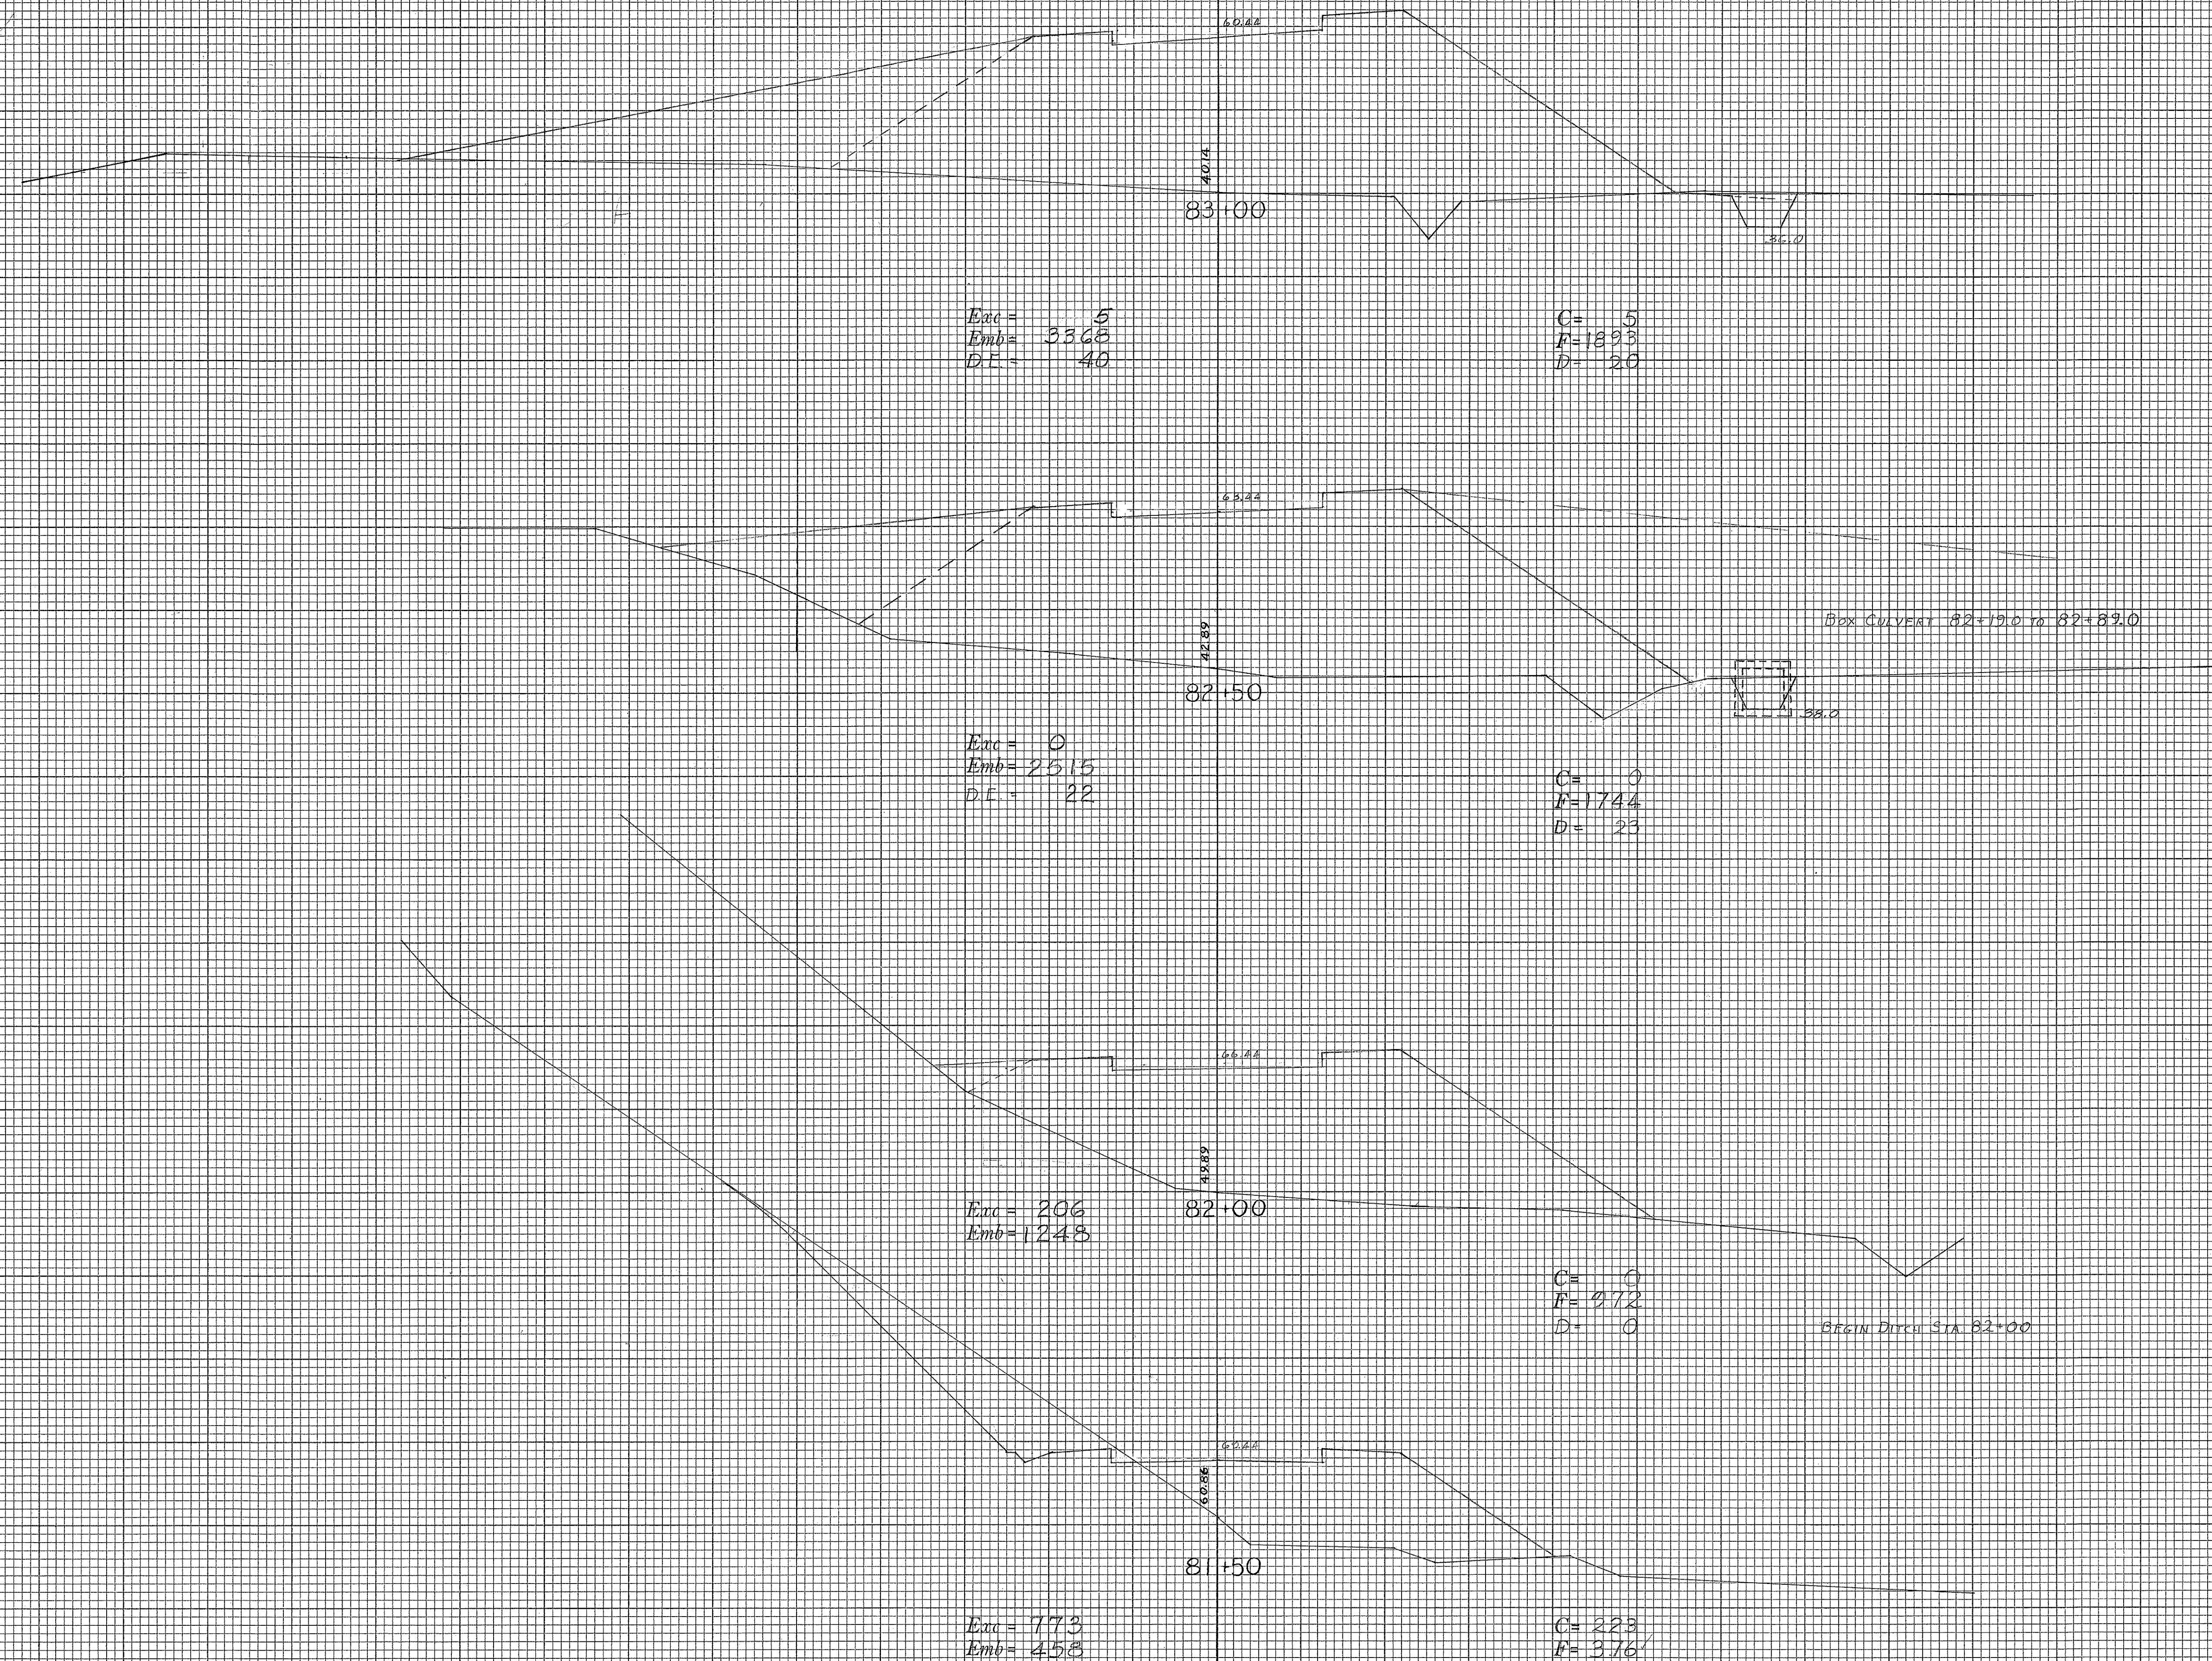


PLATE 3 - CROSS SECTION O. P. R. & R. E. STANDARD
KEUFFEL & ESSER CO., NEW YORK.


K & E CO. NO. 345-3 MADE IN U. S. A. 21076

G O O S . 4 B S

FINAL SURVEY	DATE	BY
SURVEYED		
PLOTTED		
NOTE BOOK		
NO.		
AREAS CHECKED		

ORIGINAL SURVEY	DATE	BY
SURVEYED		
PLOTTED		
NOTE BOOK		
NO.		
AREAS CHECKED		


FED. ROAD DIST. NO.	STATE	FED. AID PROJ. NO.	FISCAL YEAR	SHEET NO.	TOTAL SHEETS
HAWAII	HAW.	F-056-1(7)	1958	40	54

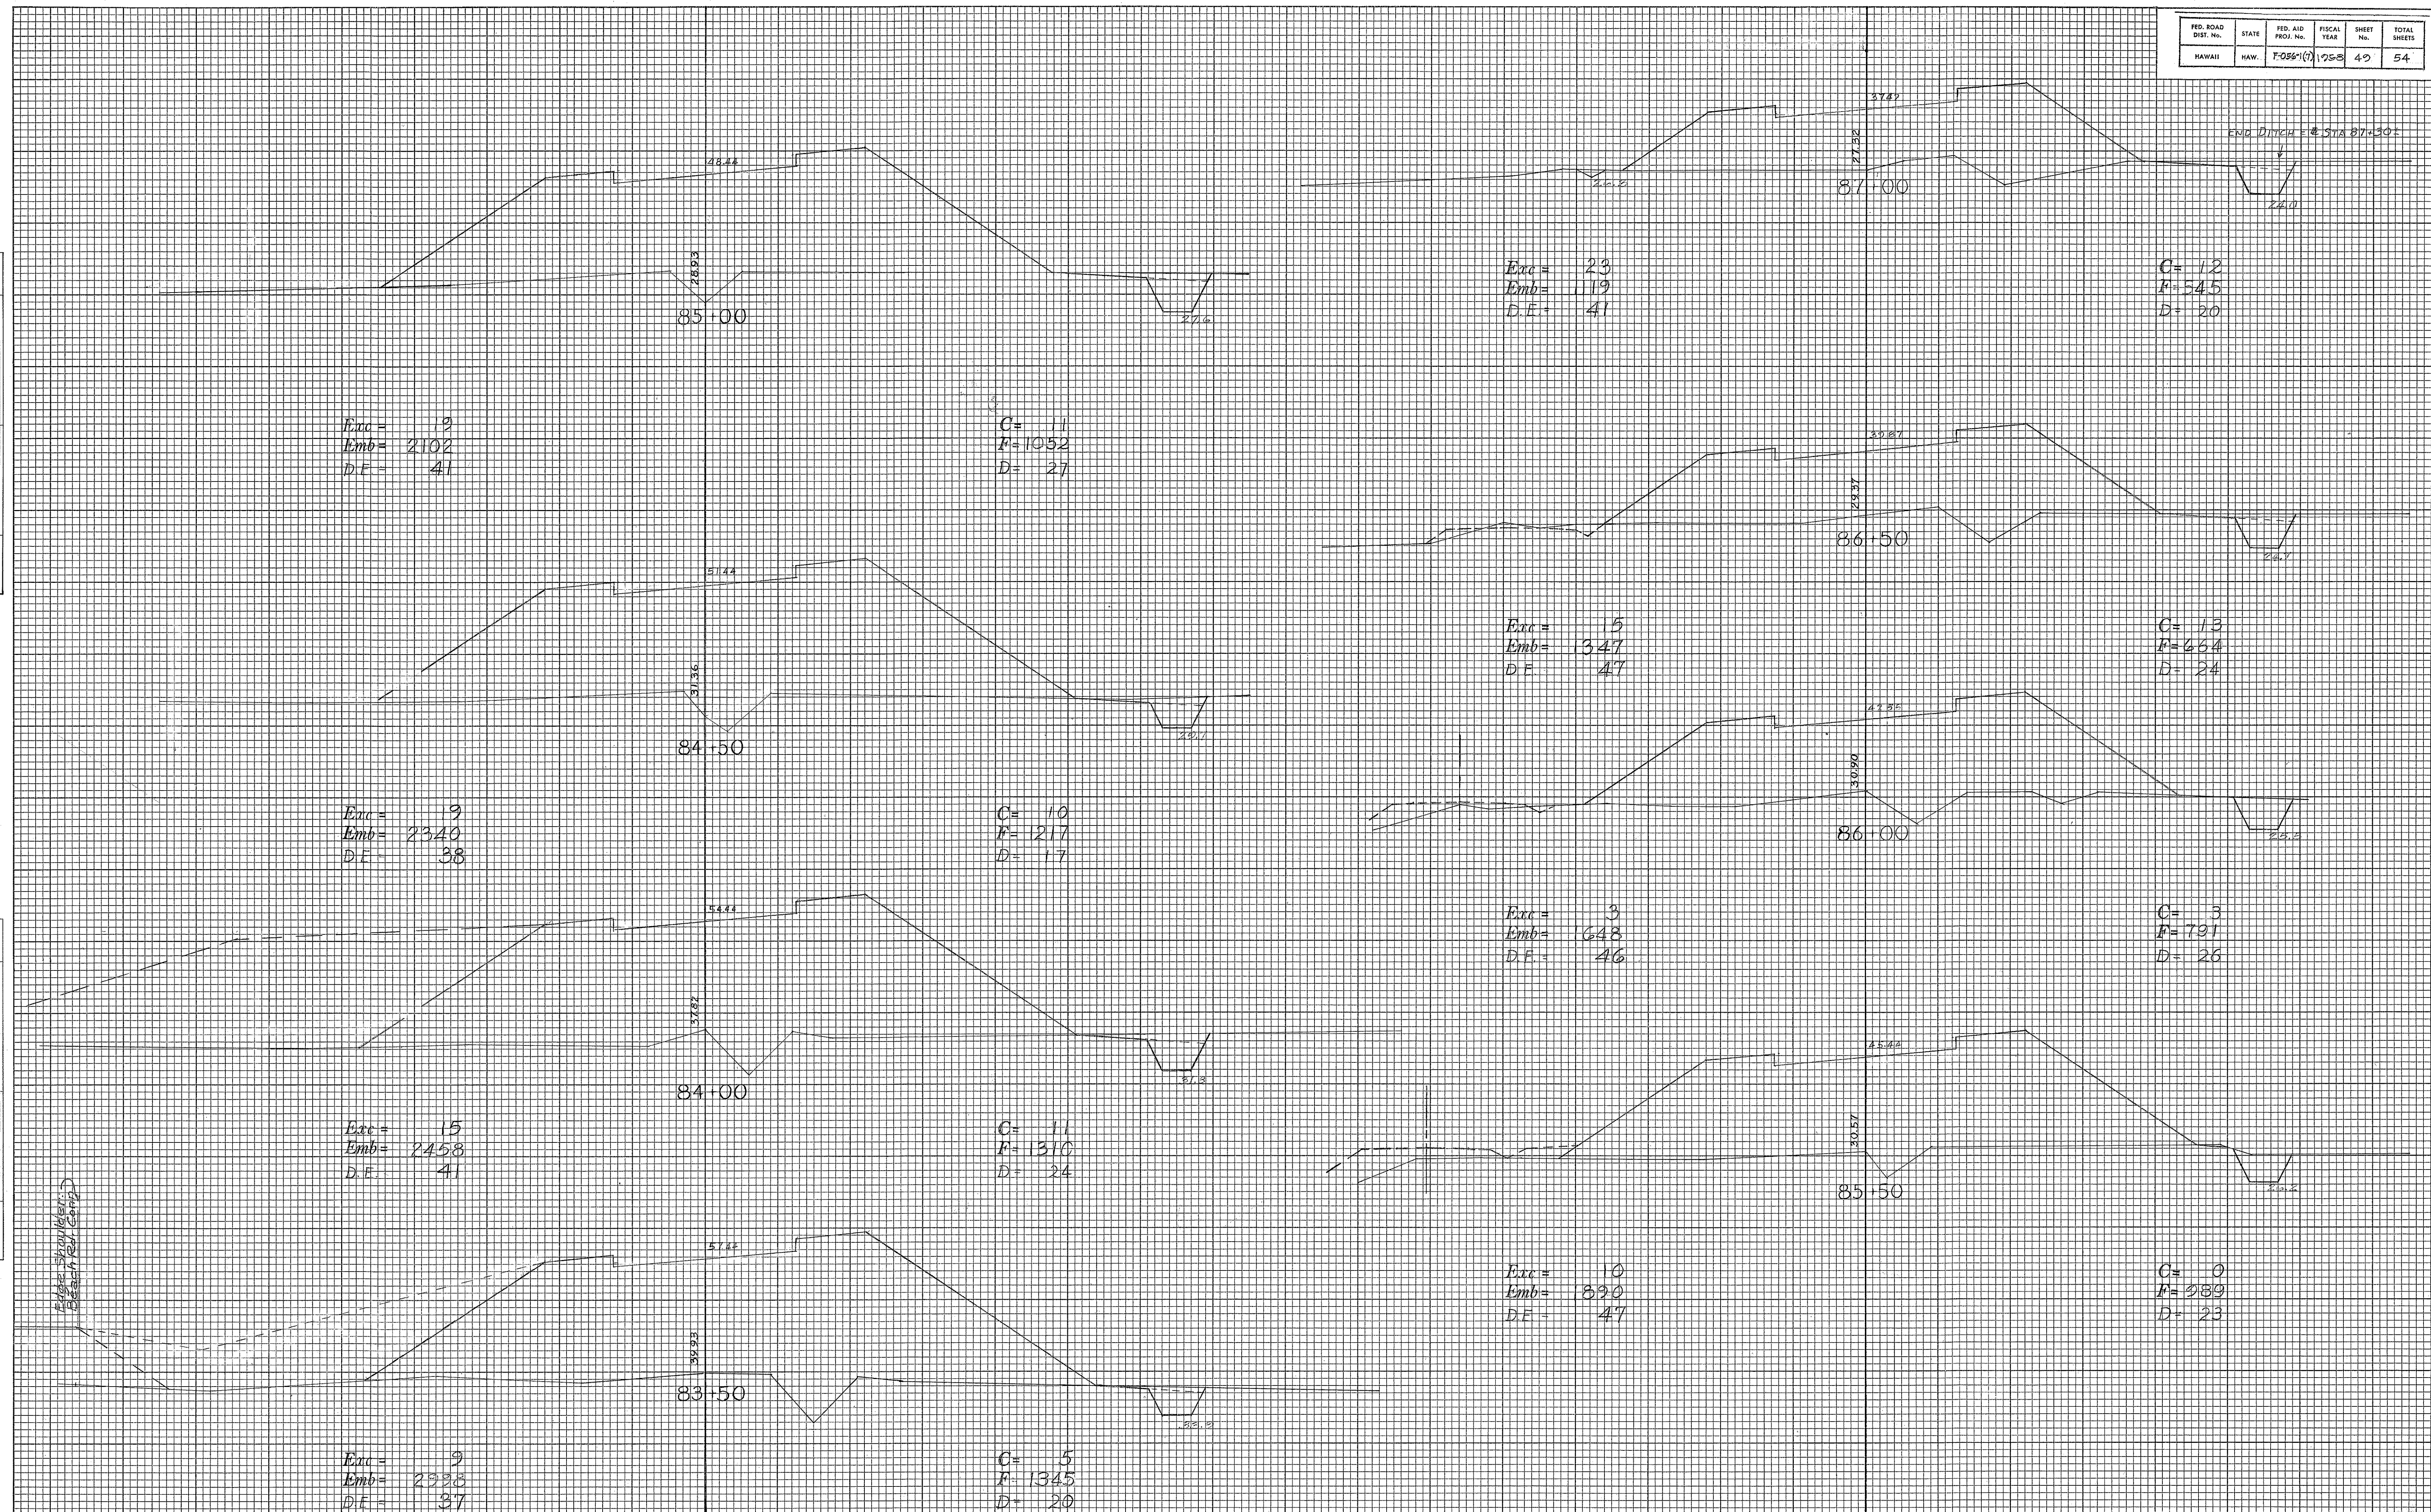

6005.189

FINAL SURVEY	SURVEYED PLOTTED TEMPLATE AREAS	BY	DATE
NOTE BOOK			
NO.	AREAS CHECKED		


ORIGINAL SURVEY		BY	DATE
SURVEYED			
PLOTTED			
TEMPLATE			
AREAS			
AREAS CHECKED			

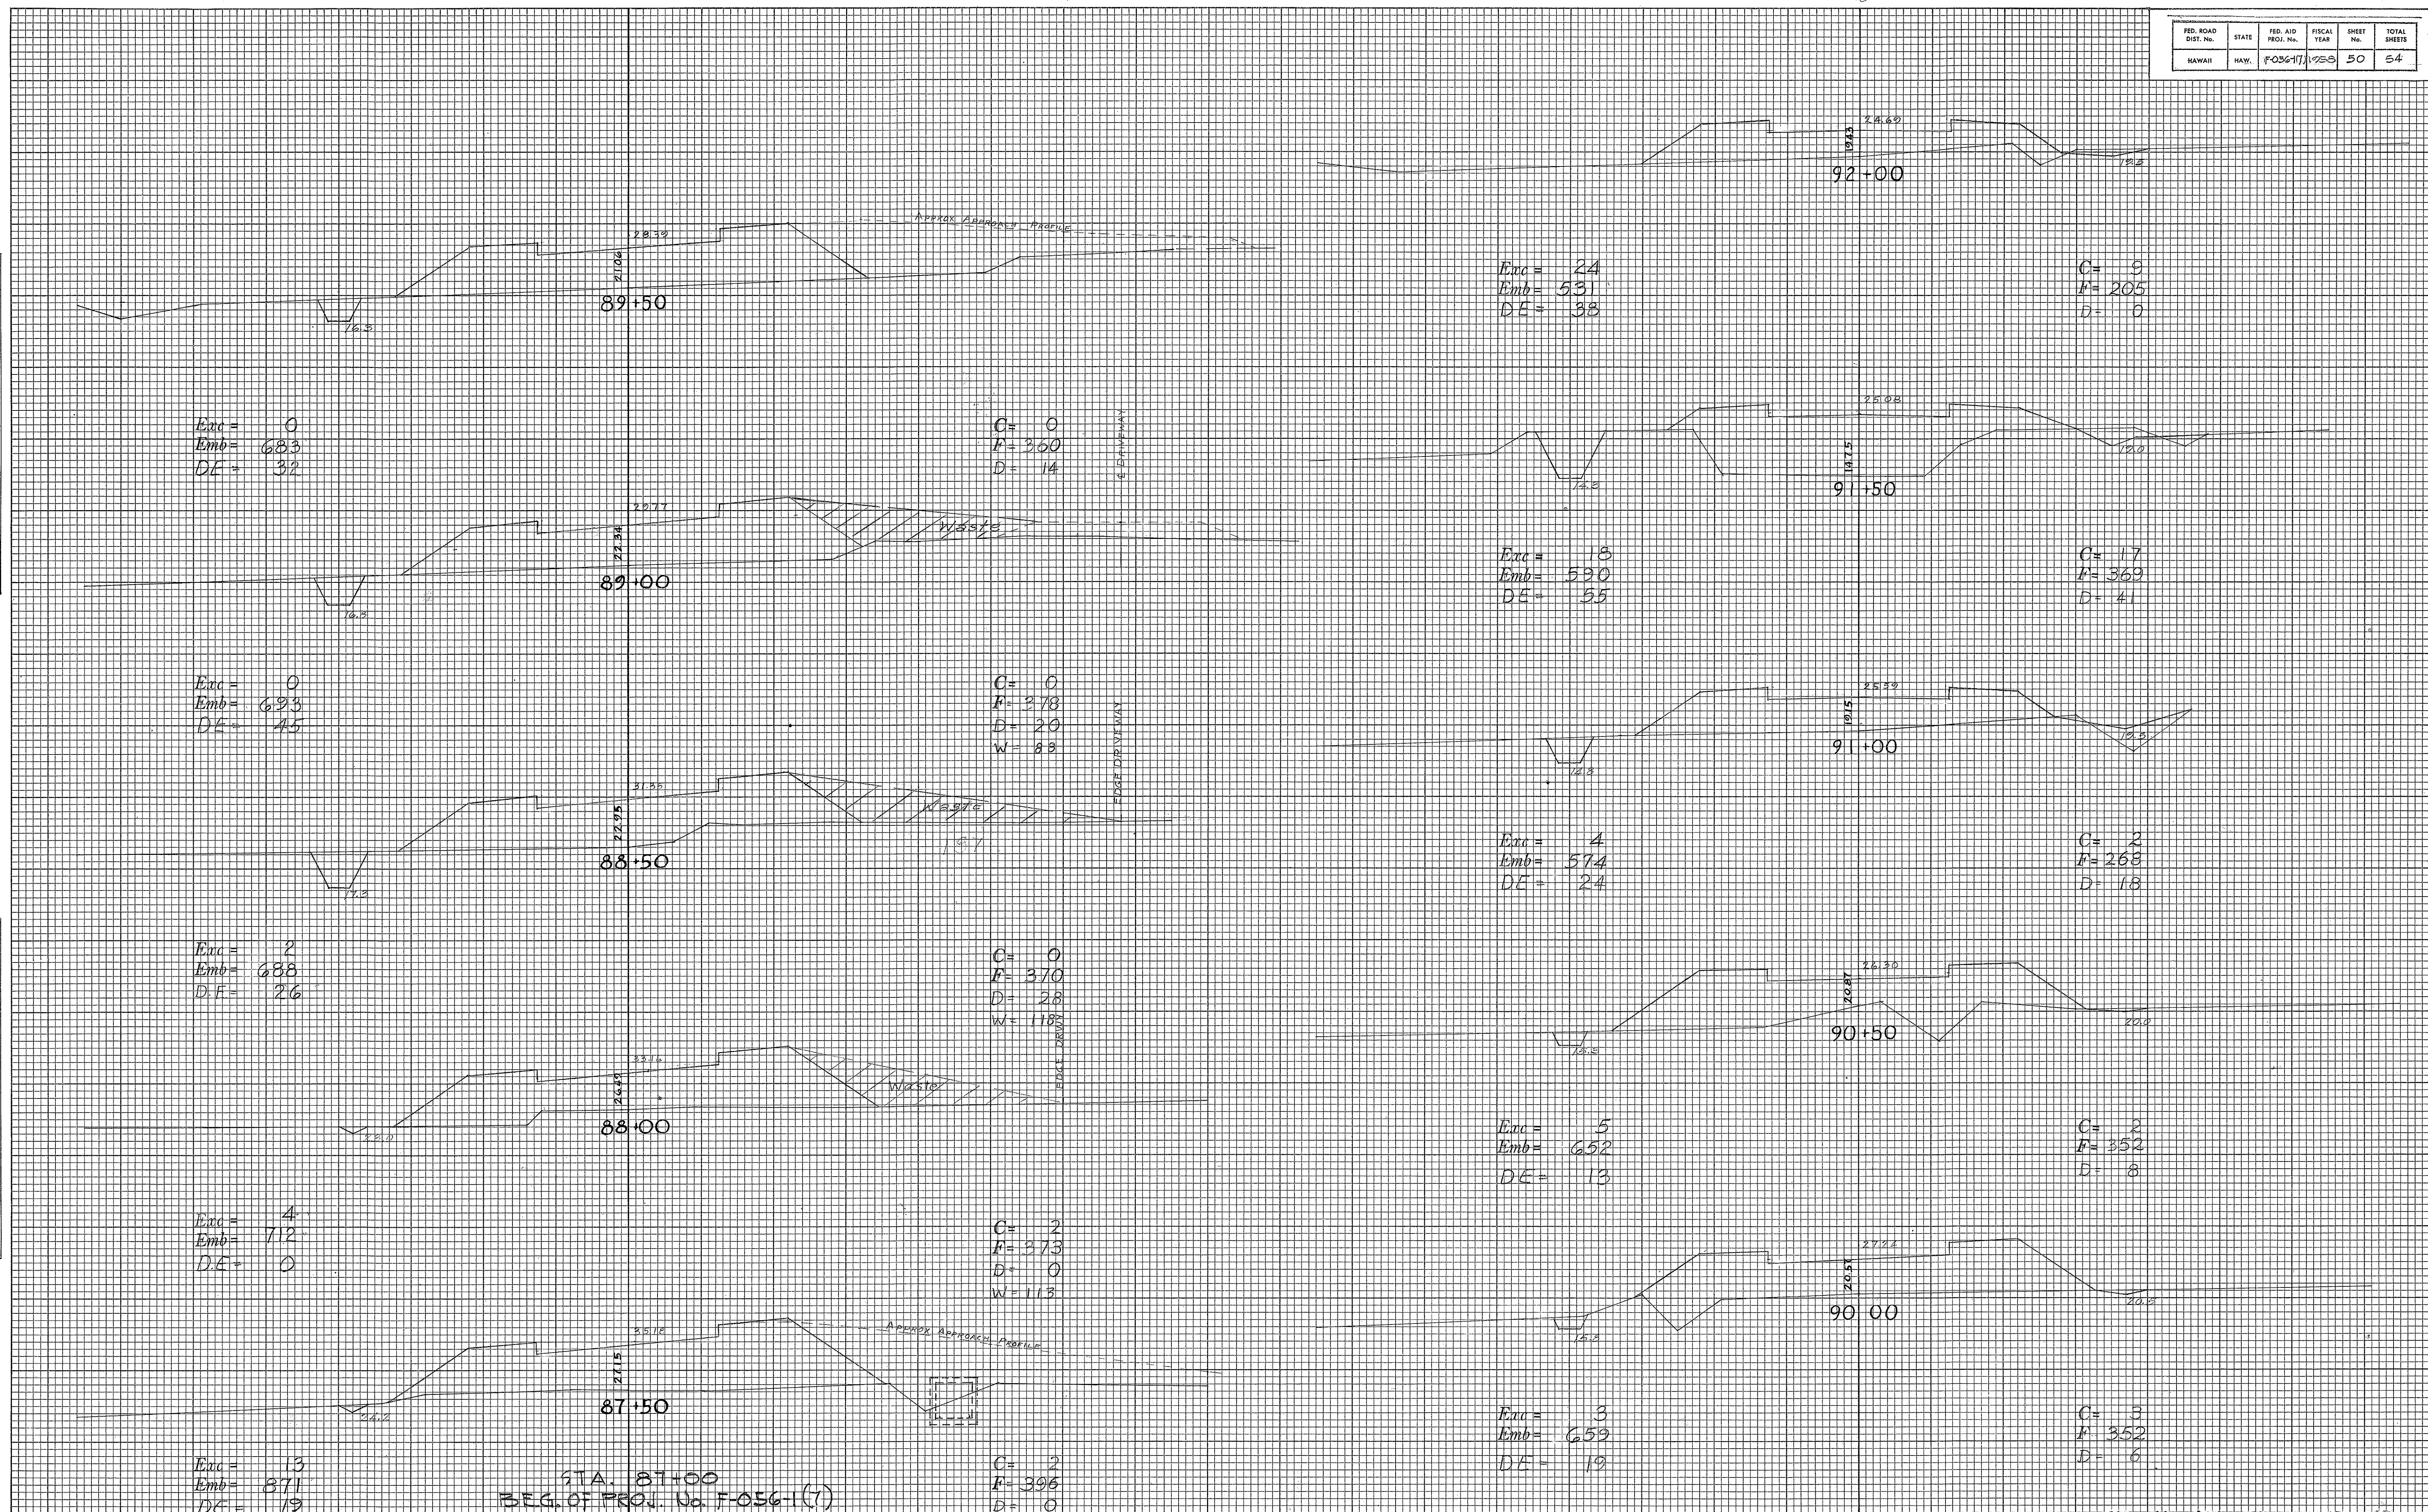

FED. ROAD DIST. No.	STATE	FED. AID PROJ. No.	FISCAL YEAR	SHEET No.	TOTAL SHEETS
HAWAII	HAW.	1006-1(7)	1953	51	54

FINAL SURVEY	BY	DATE
SURVEYED		
PLOTTED		
NOTE BOOK		
AREAS CHECKED		
NO.		


ORIGINAL SURVEY	BY	DATE
SURVEYED		
PLOTTED		
NOTE BOOK		
AREAS CHECKED		
NO.		

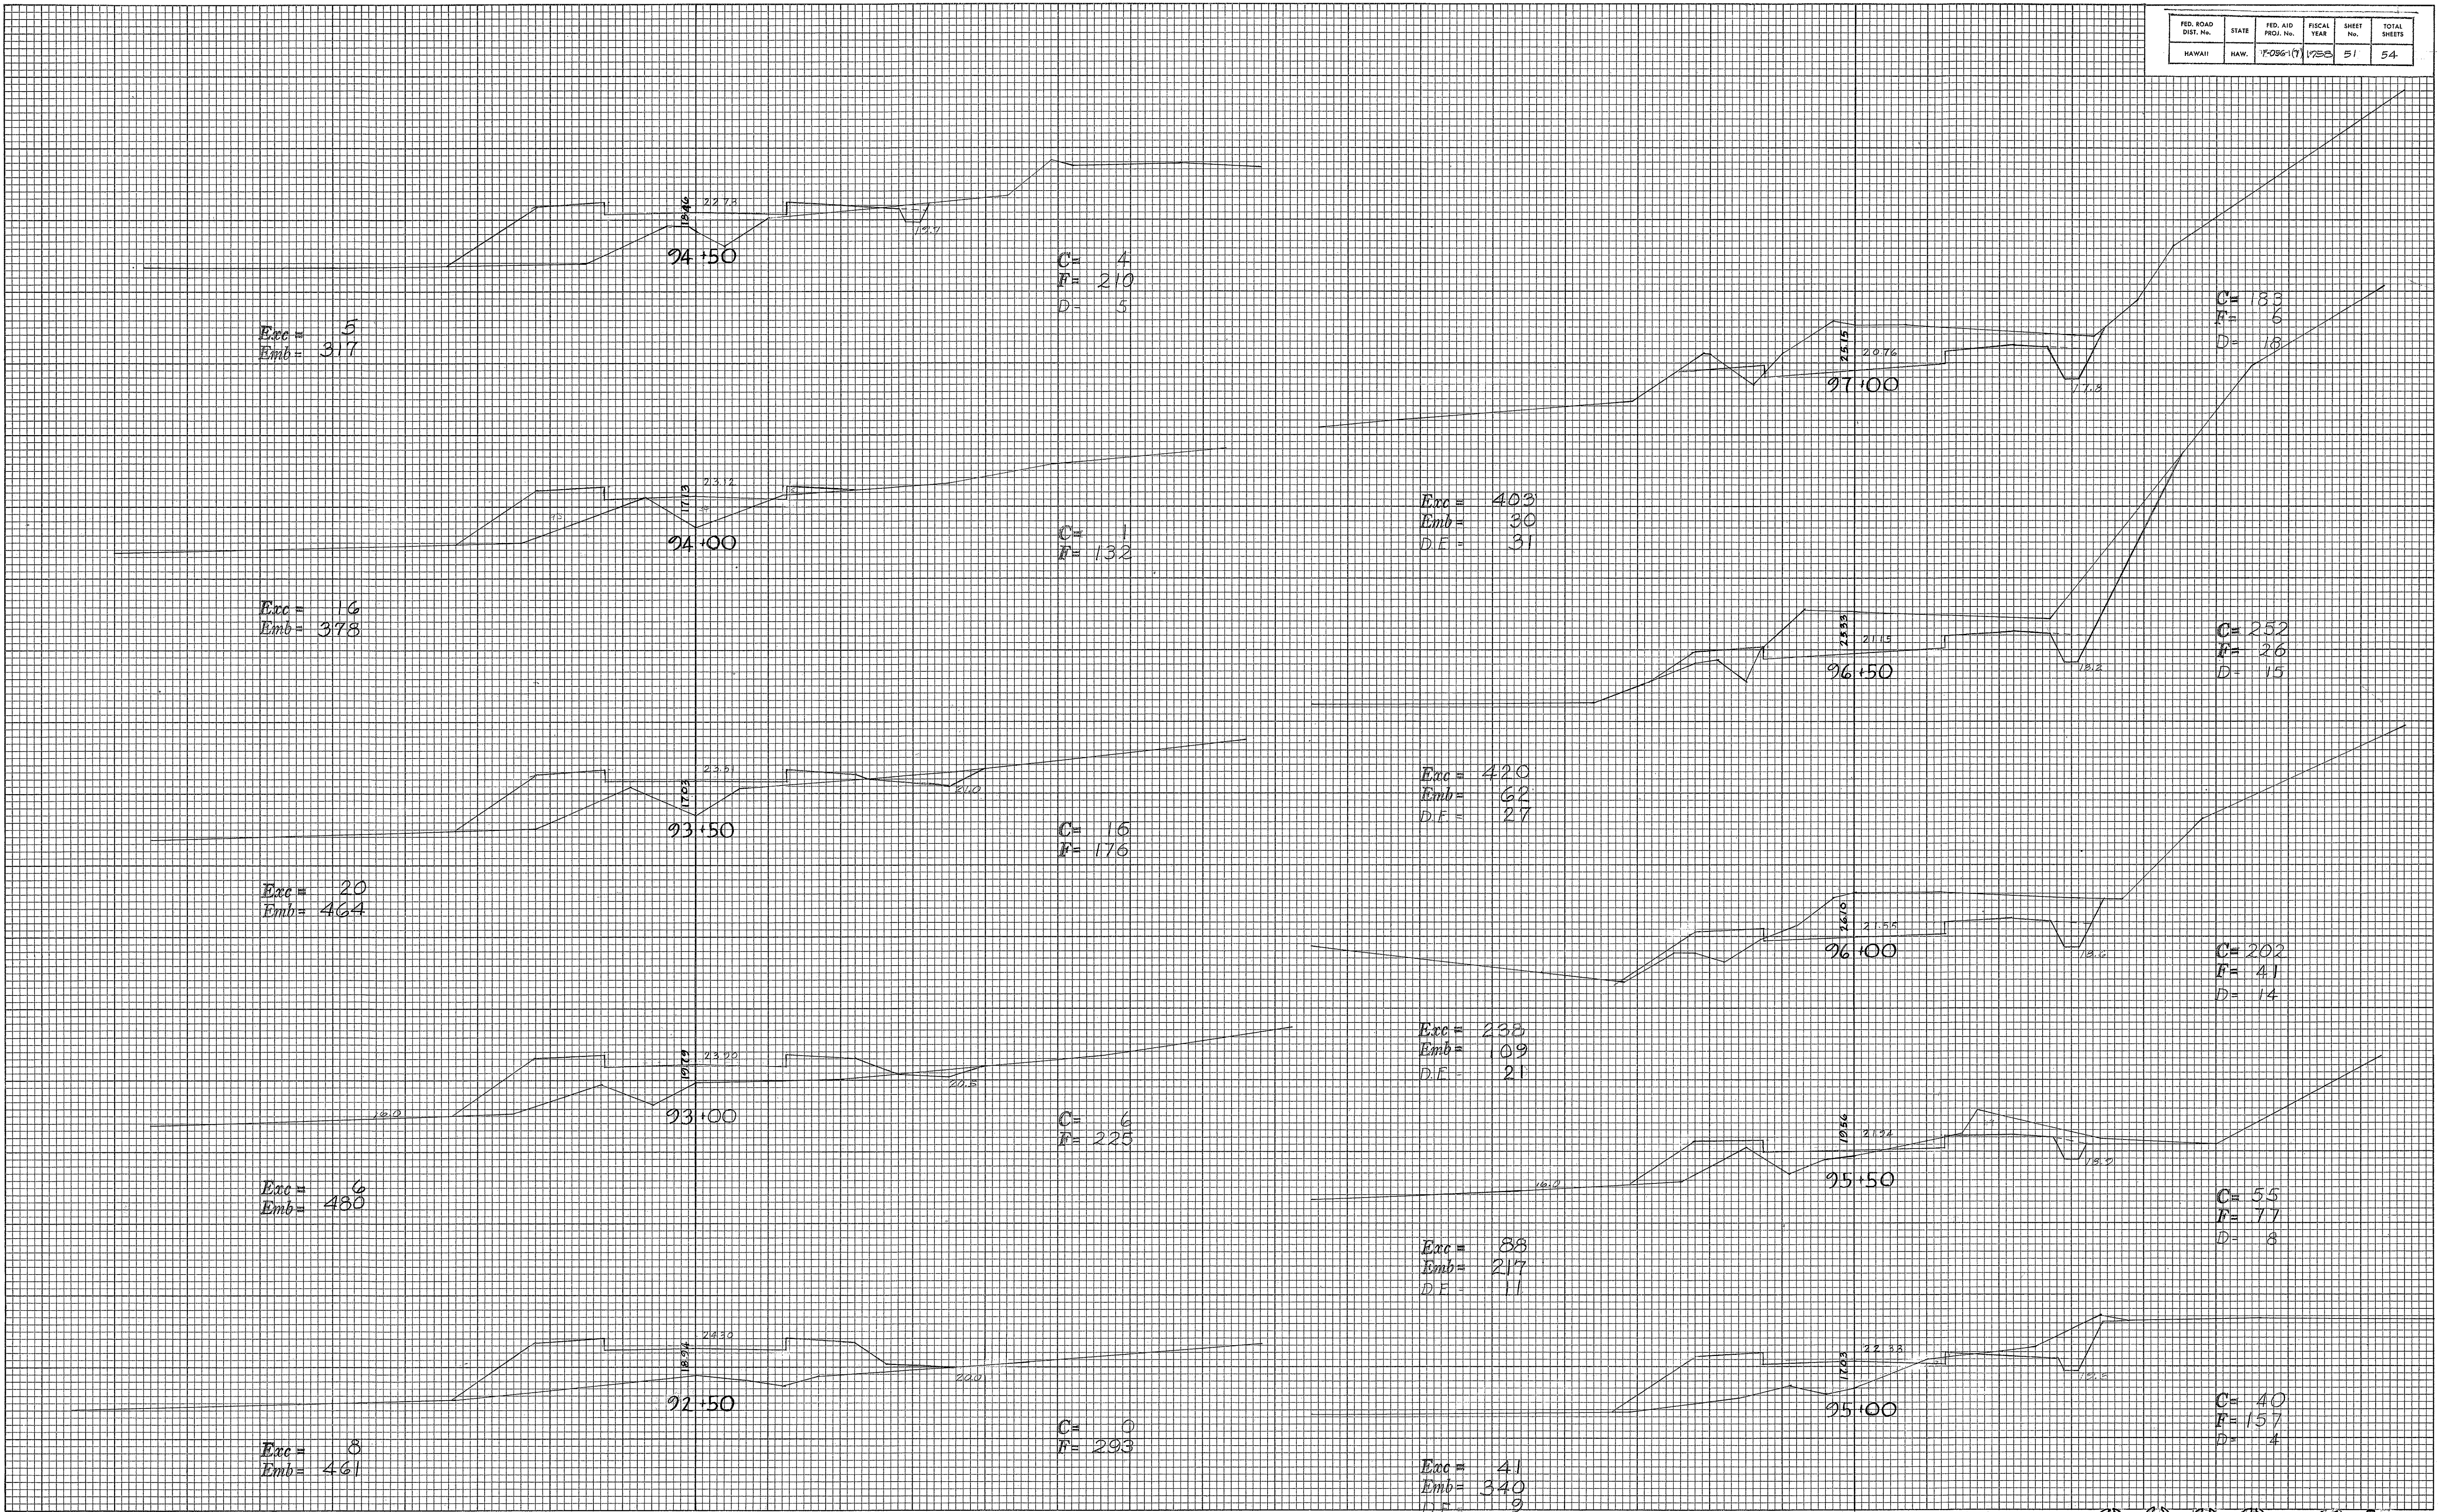

FINAL SURVEY NOTE BOOK NO.	BY	DATE

ORIGINAL SURVEY NOTE BOOK NO.	BY	DATE

FED. ROAD DIST. No.	STATE	FED. AID PROJ. No.	FISCAL YEAR	SHEET No.	TOTAL SHEETS
HAWAII	HAW.	7-056-1(7)	1958	52	54

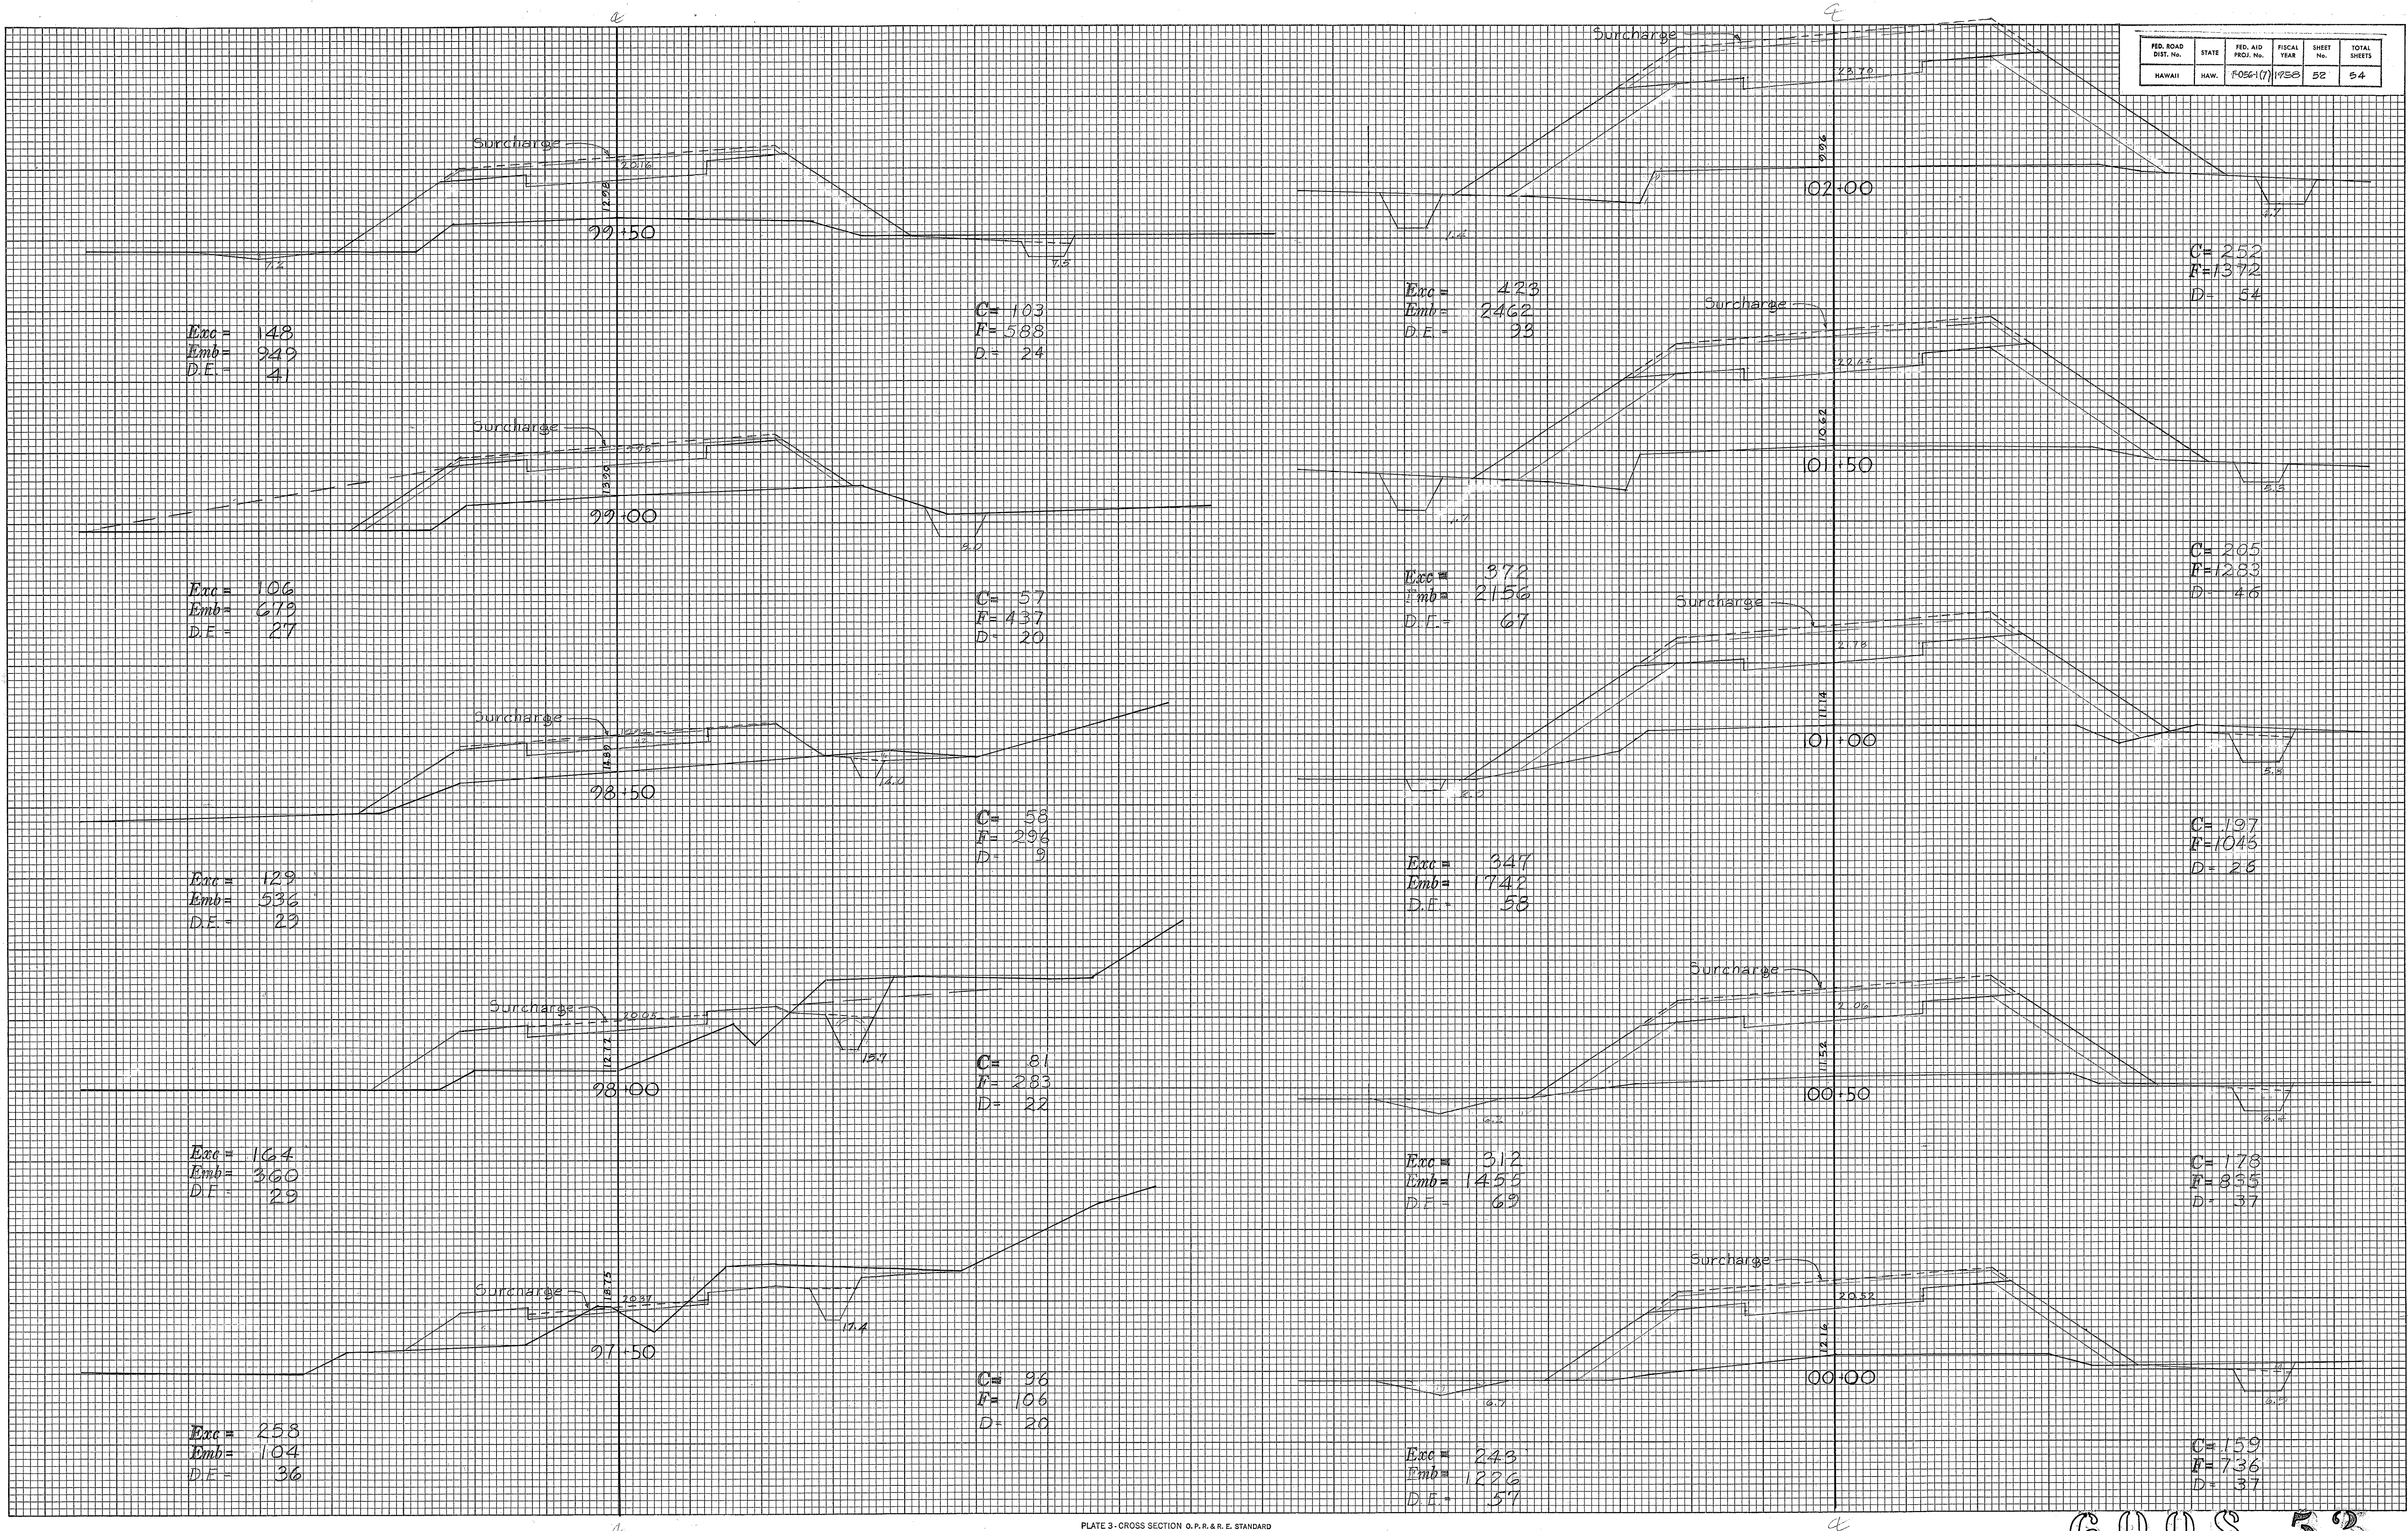

PROJ. ROAD DIST. No.	STATE	FED. AID PROJ. No.	FISCAL YEAR	SHEET No.	TOTAL SHEETS
HAWAII	HAW.	F-056-1(7)	1958	54	54

FINAL SURVEY	DATE	BY
	NO. 1	
	NO. 2	
	NO. 3	

ORIGINAL SURVEY	DATE	BY
	NO. 1	
	NO. 2	
	NO. 3	

