
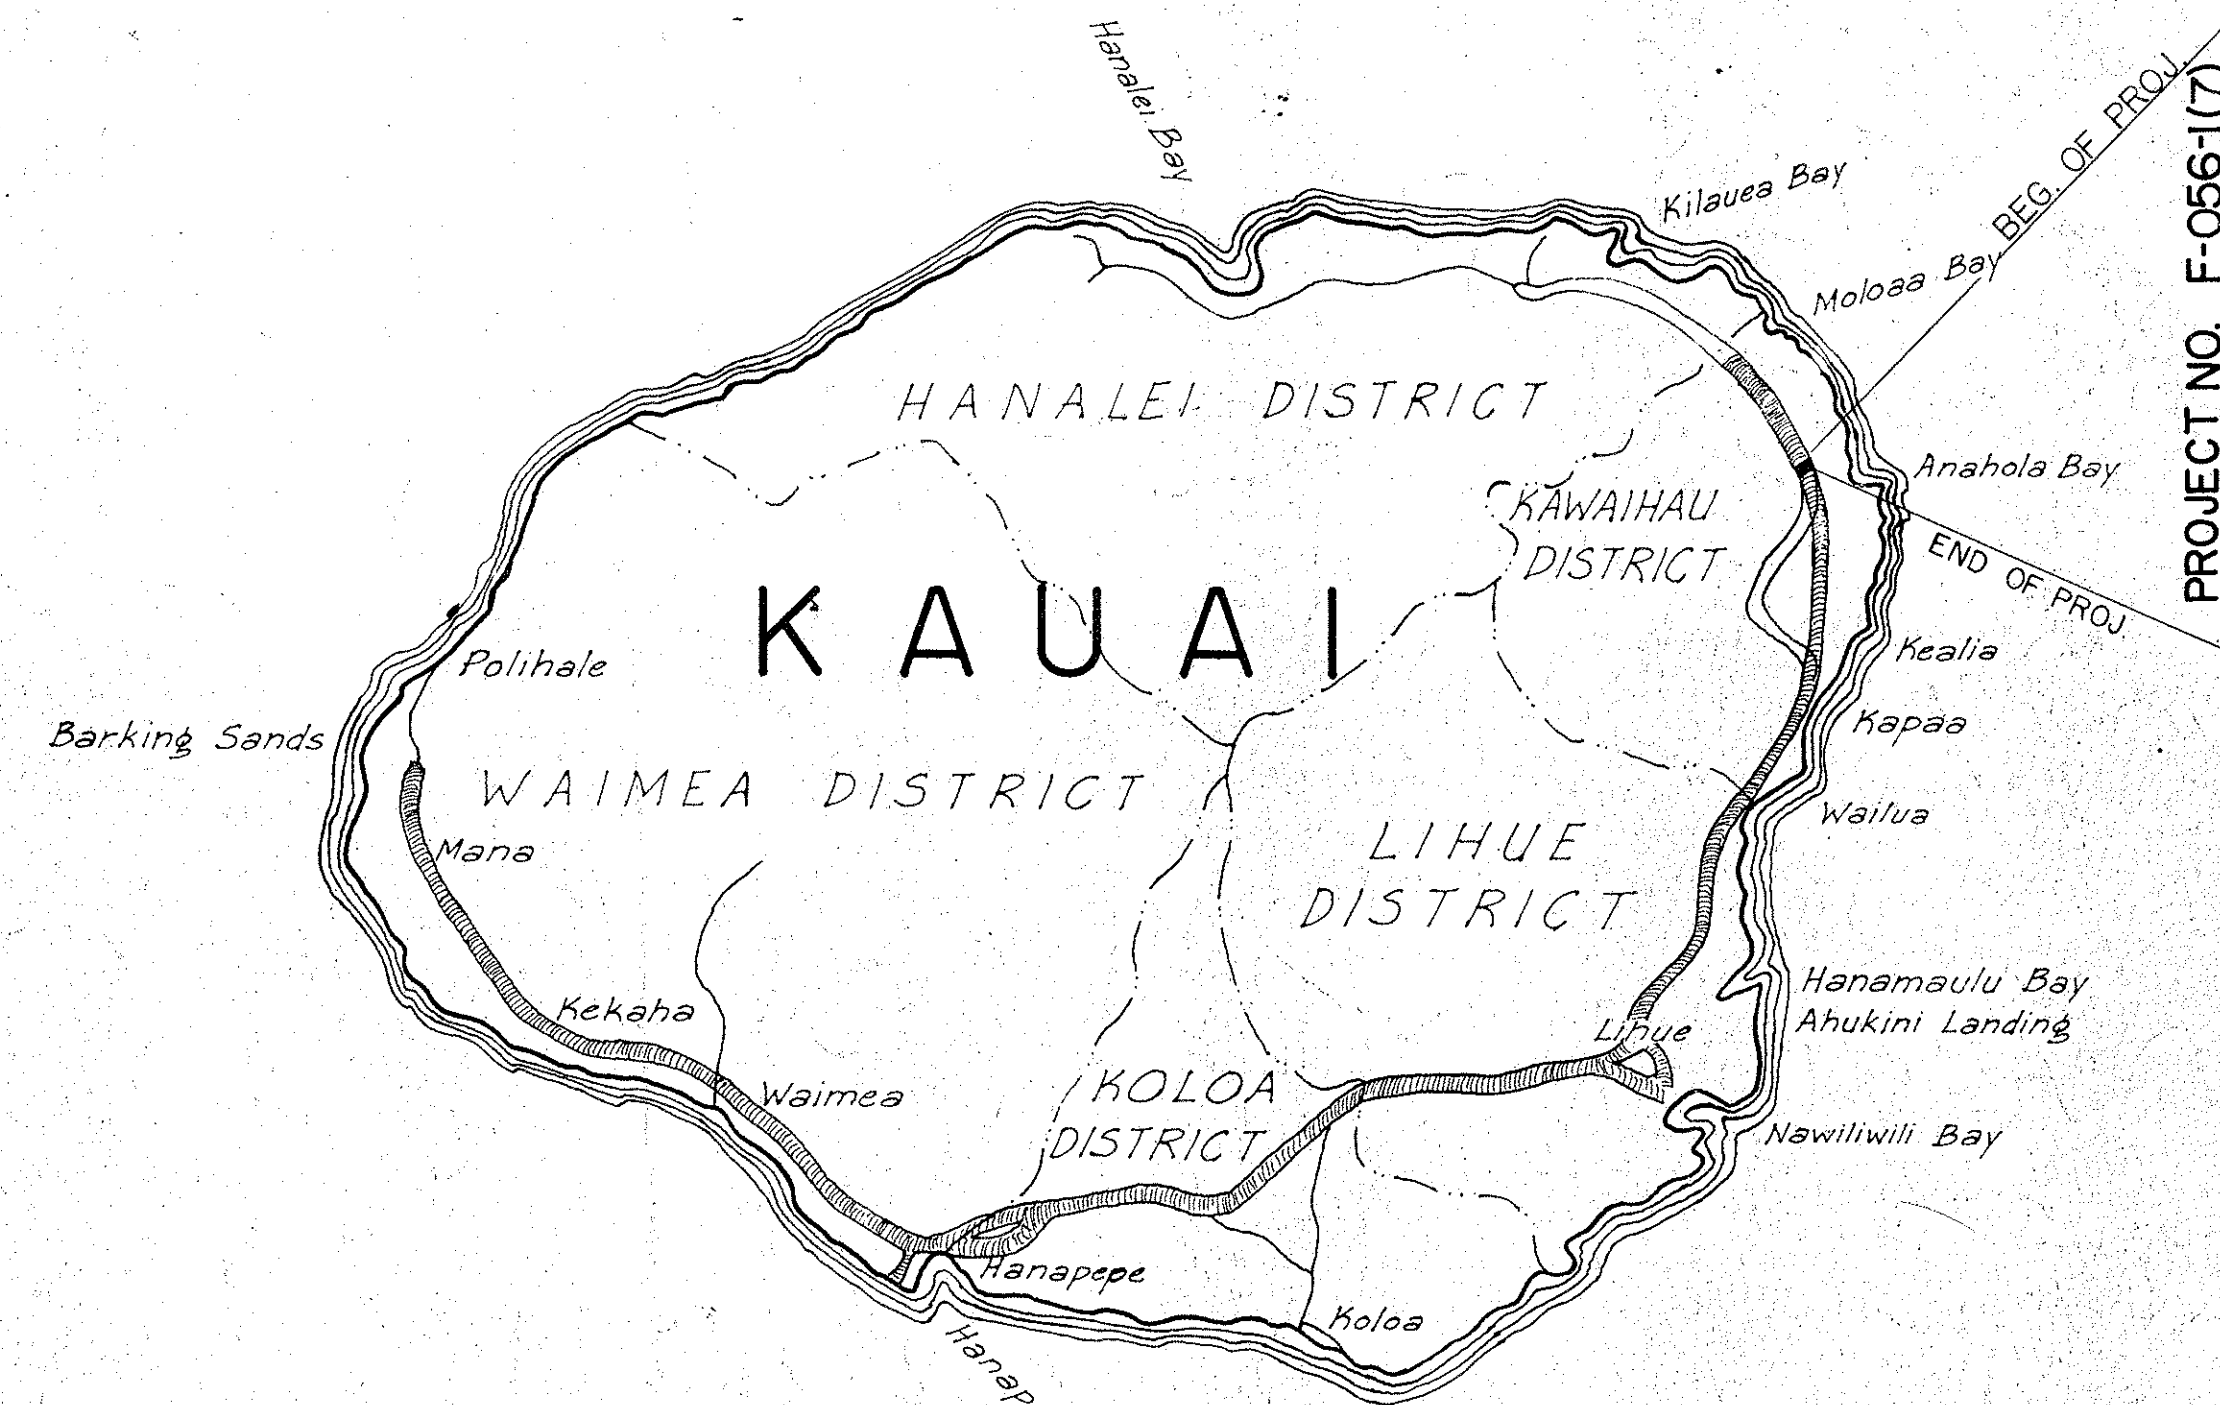


INDEX TO DRAWINGS		
SHEET NO.	DESCRIPTION	COMB. No.
1	TITLE SHEET	2
2	TYPICAL SECTION	3
3-5	PLAN & PROFILE	9-7
6-11	CONNECTIONS	10-19
12	WATER LINE RELOCATION	16
13-15	TREE DETAILS	17-19
16	MISCELLANEOUS DETAILS	20
17-21	HOUSE RELOCATION	21-25
22-26	CONCRETE BOX CULVERTS	27-32
27-38	ANAHOLA STREAM BRIDGE	31-46
39-54	CROSS-SECTIONS	54-60

CONVENTIONAL SIGNS	
Baseline	
Boundary Line	
Fences (Named)	
Existing Roadway	
Pipe Culvert	
Box Culvert	
Telephone Line & Pole	
Electric Line & Pole	
Water Main	

TERRITORY OF HAWAII
TERRITORIAL HIGHWAY DEPARTMENT
HONOLULU T. H.
AS BUILT
PLANS OF
KAUAI BELT ROAD
FEDERAL AID PROJECT NO. F-056-1(7)
DISTRICT OF KAWAIHAU
ISLAND OF KAUAI

SCALES	
PLAN	1 INCH = 100 FT.
PROFILE	HOR. 1 INCH = 100 FT.
	VER. 1 INCH = 10 FT.
CROSS SECTION	HOR. 1 INCH = 10 FT.
	VER. 1 INCH = 10 FT.

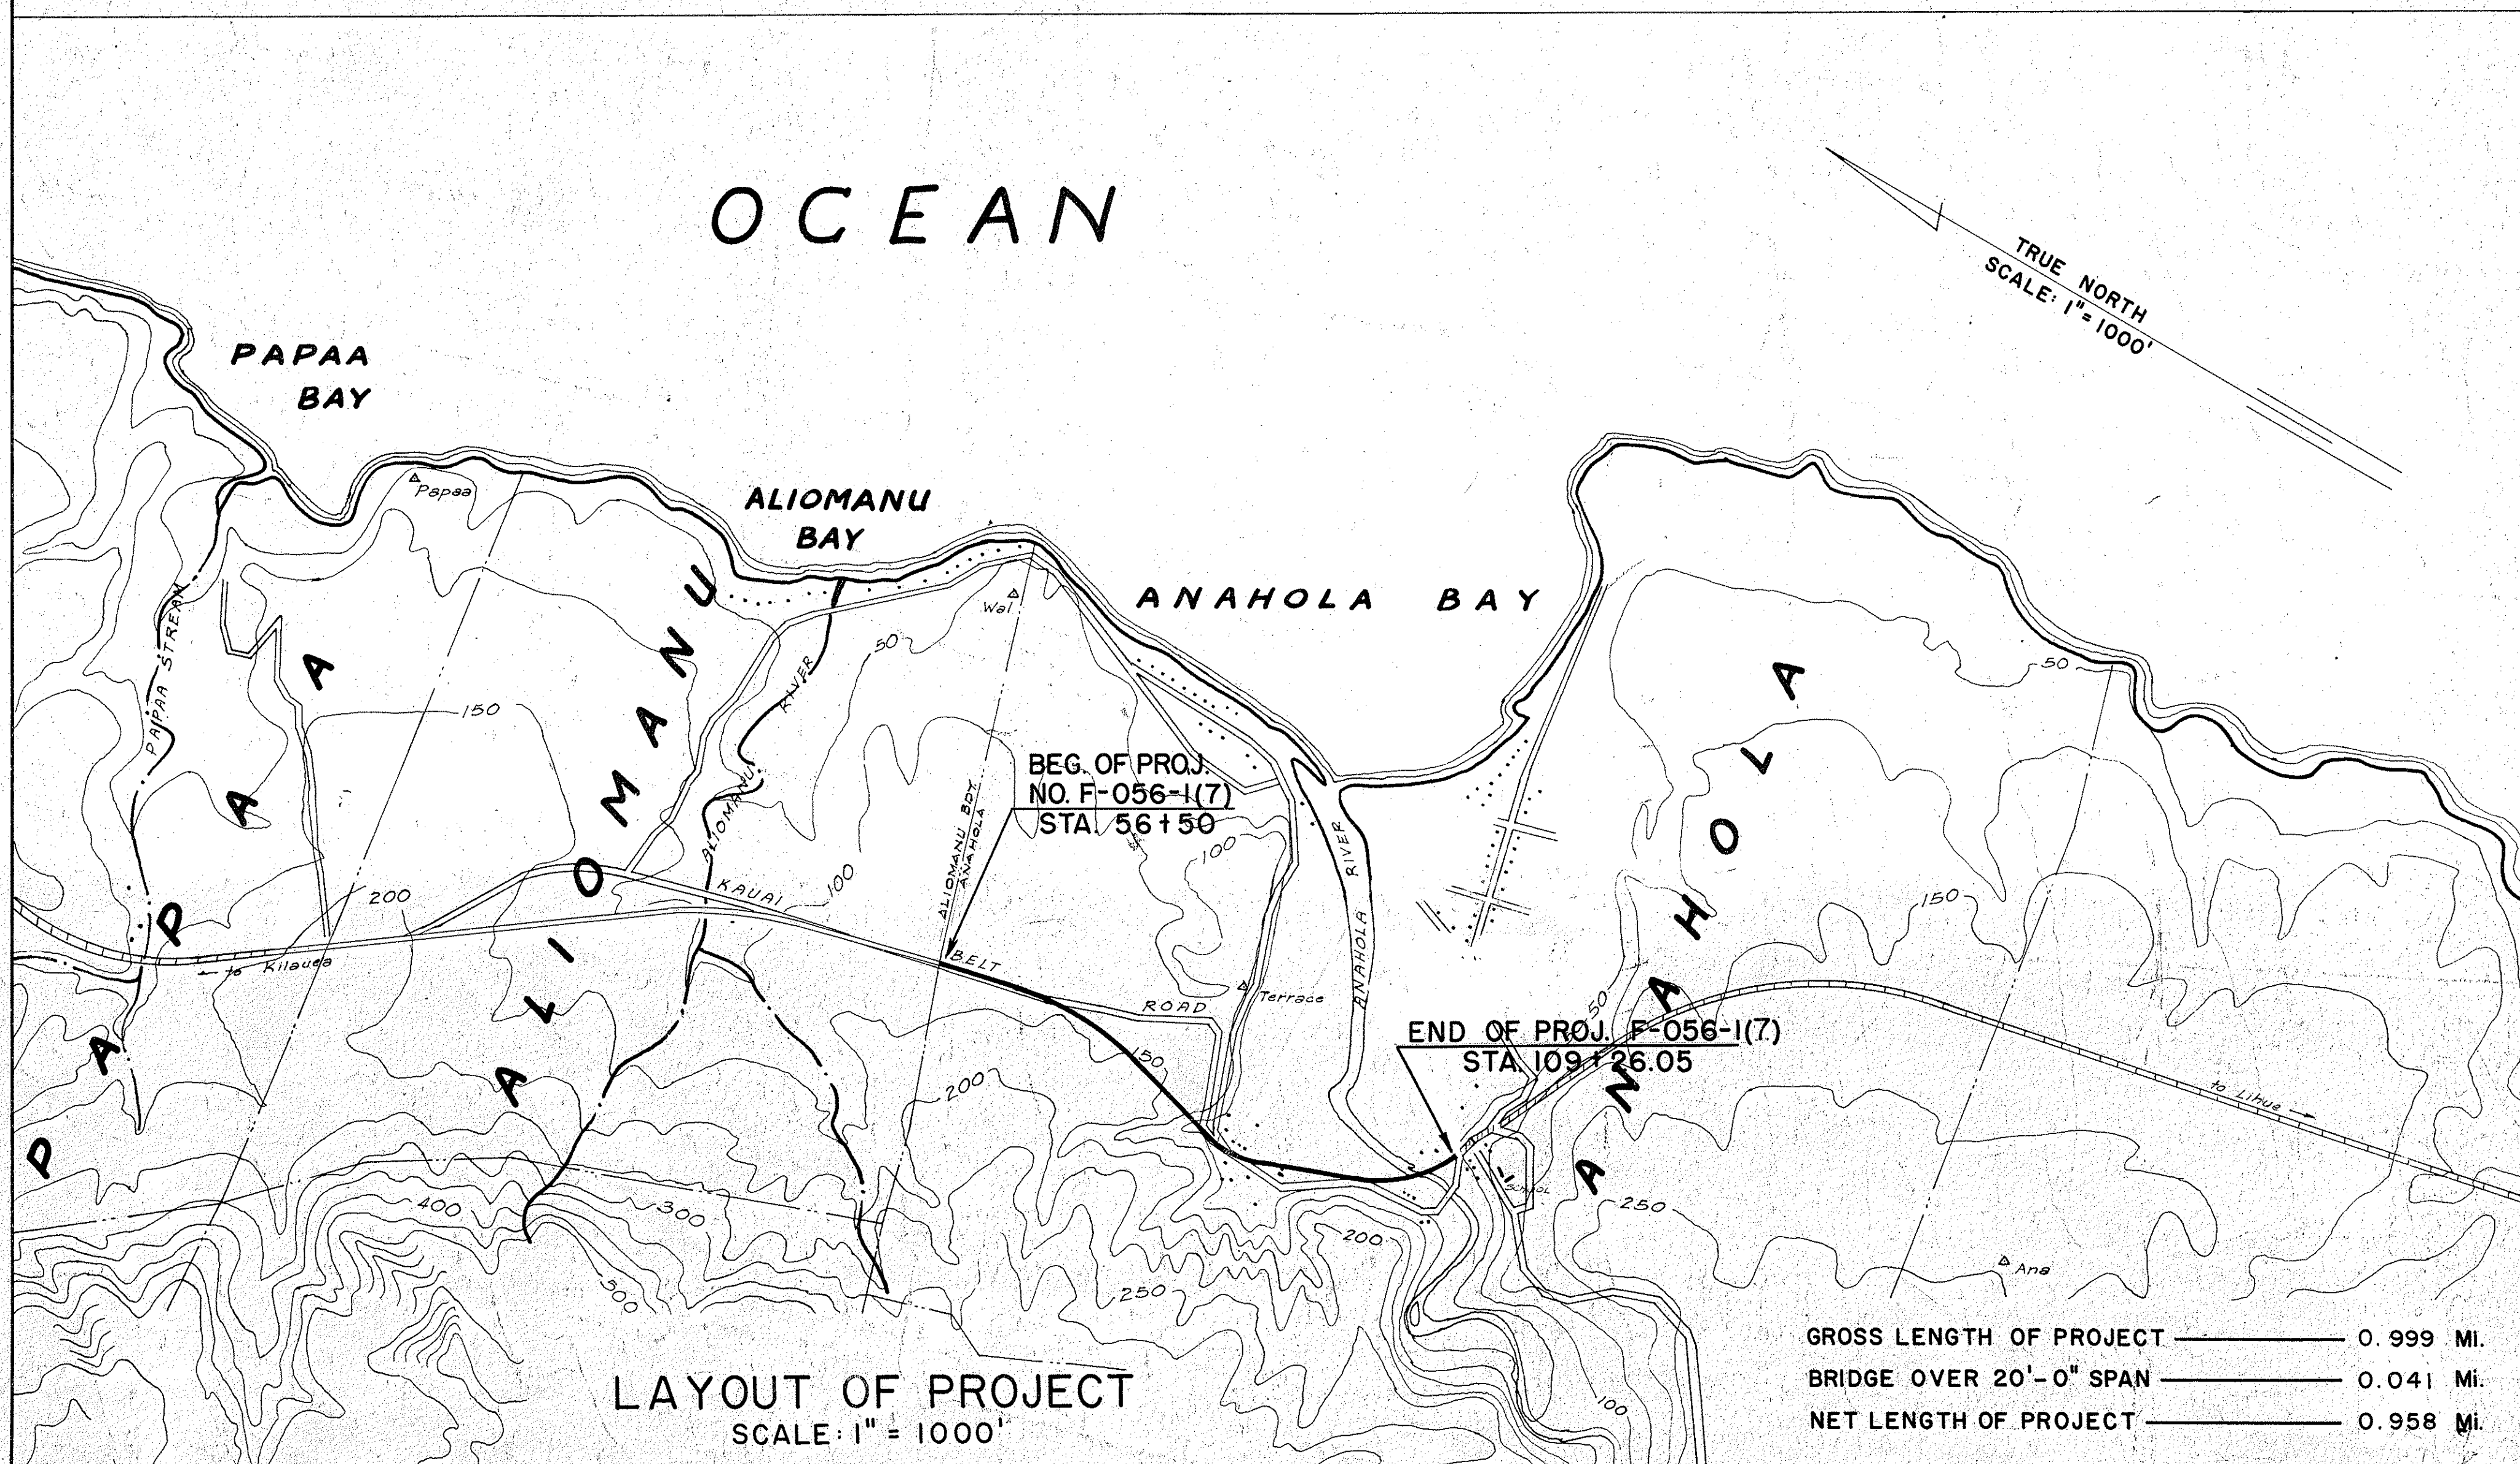

FEDERAL AID PROJECTS PREVIOUSLY CONSTRUCTED OR UNDER CONSTRUCTION

NOTE:
ALL CHANGES MADE DURING
CONSTRUCTION HAVE BEEN
NOTED IN THESE TRACINGS
IN RED AND CHECKED BY

Resident Engineer
RESIDENT ENGINEER
11-29-60
DATE

APPROVED: DATE 8/26/58
Territorial Highway Engineer
TERRITORIAL HIGHWAY ENGINEER

DEPARTMENT OF COMMERCE
BUREAU OF PUBLIC ROADS
APPROVED:
DIVISION ENGINEER DATE

GROSS LENGTH OF PROJECT 0.999 MI.
BRIDGE OVER 20'-0" SPAN 0.041 MI.
NET LENGTH OF PROJECT 0.958 MI.