



FED. ROAD DIST. NO.	STATE	FED. AID PROJ. NO.	FISCAL YEAR	SHEET No.	TOTAL SHEETS
HAWAII	HAW	ER 7(1) UNIT 2	1967	8	77

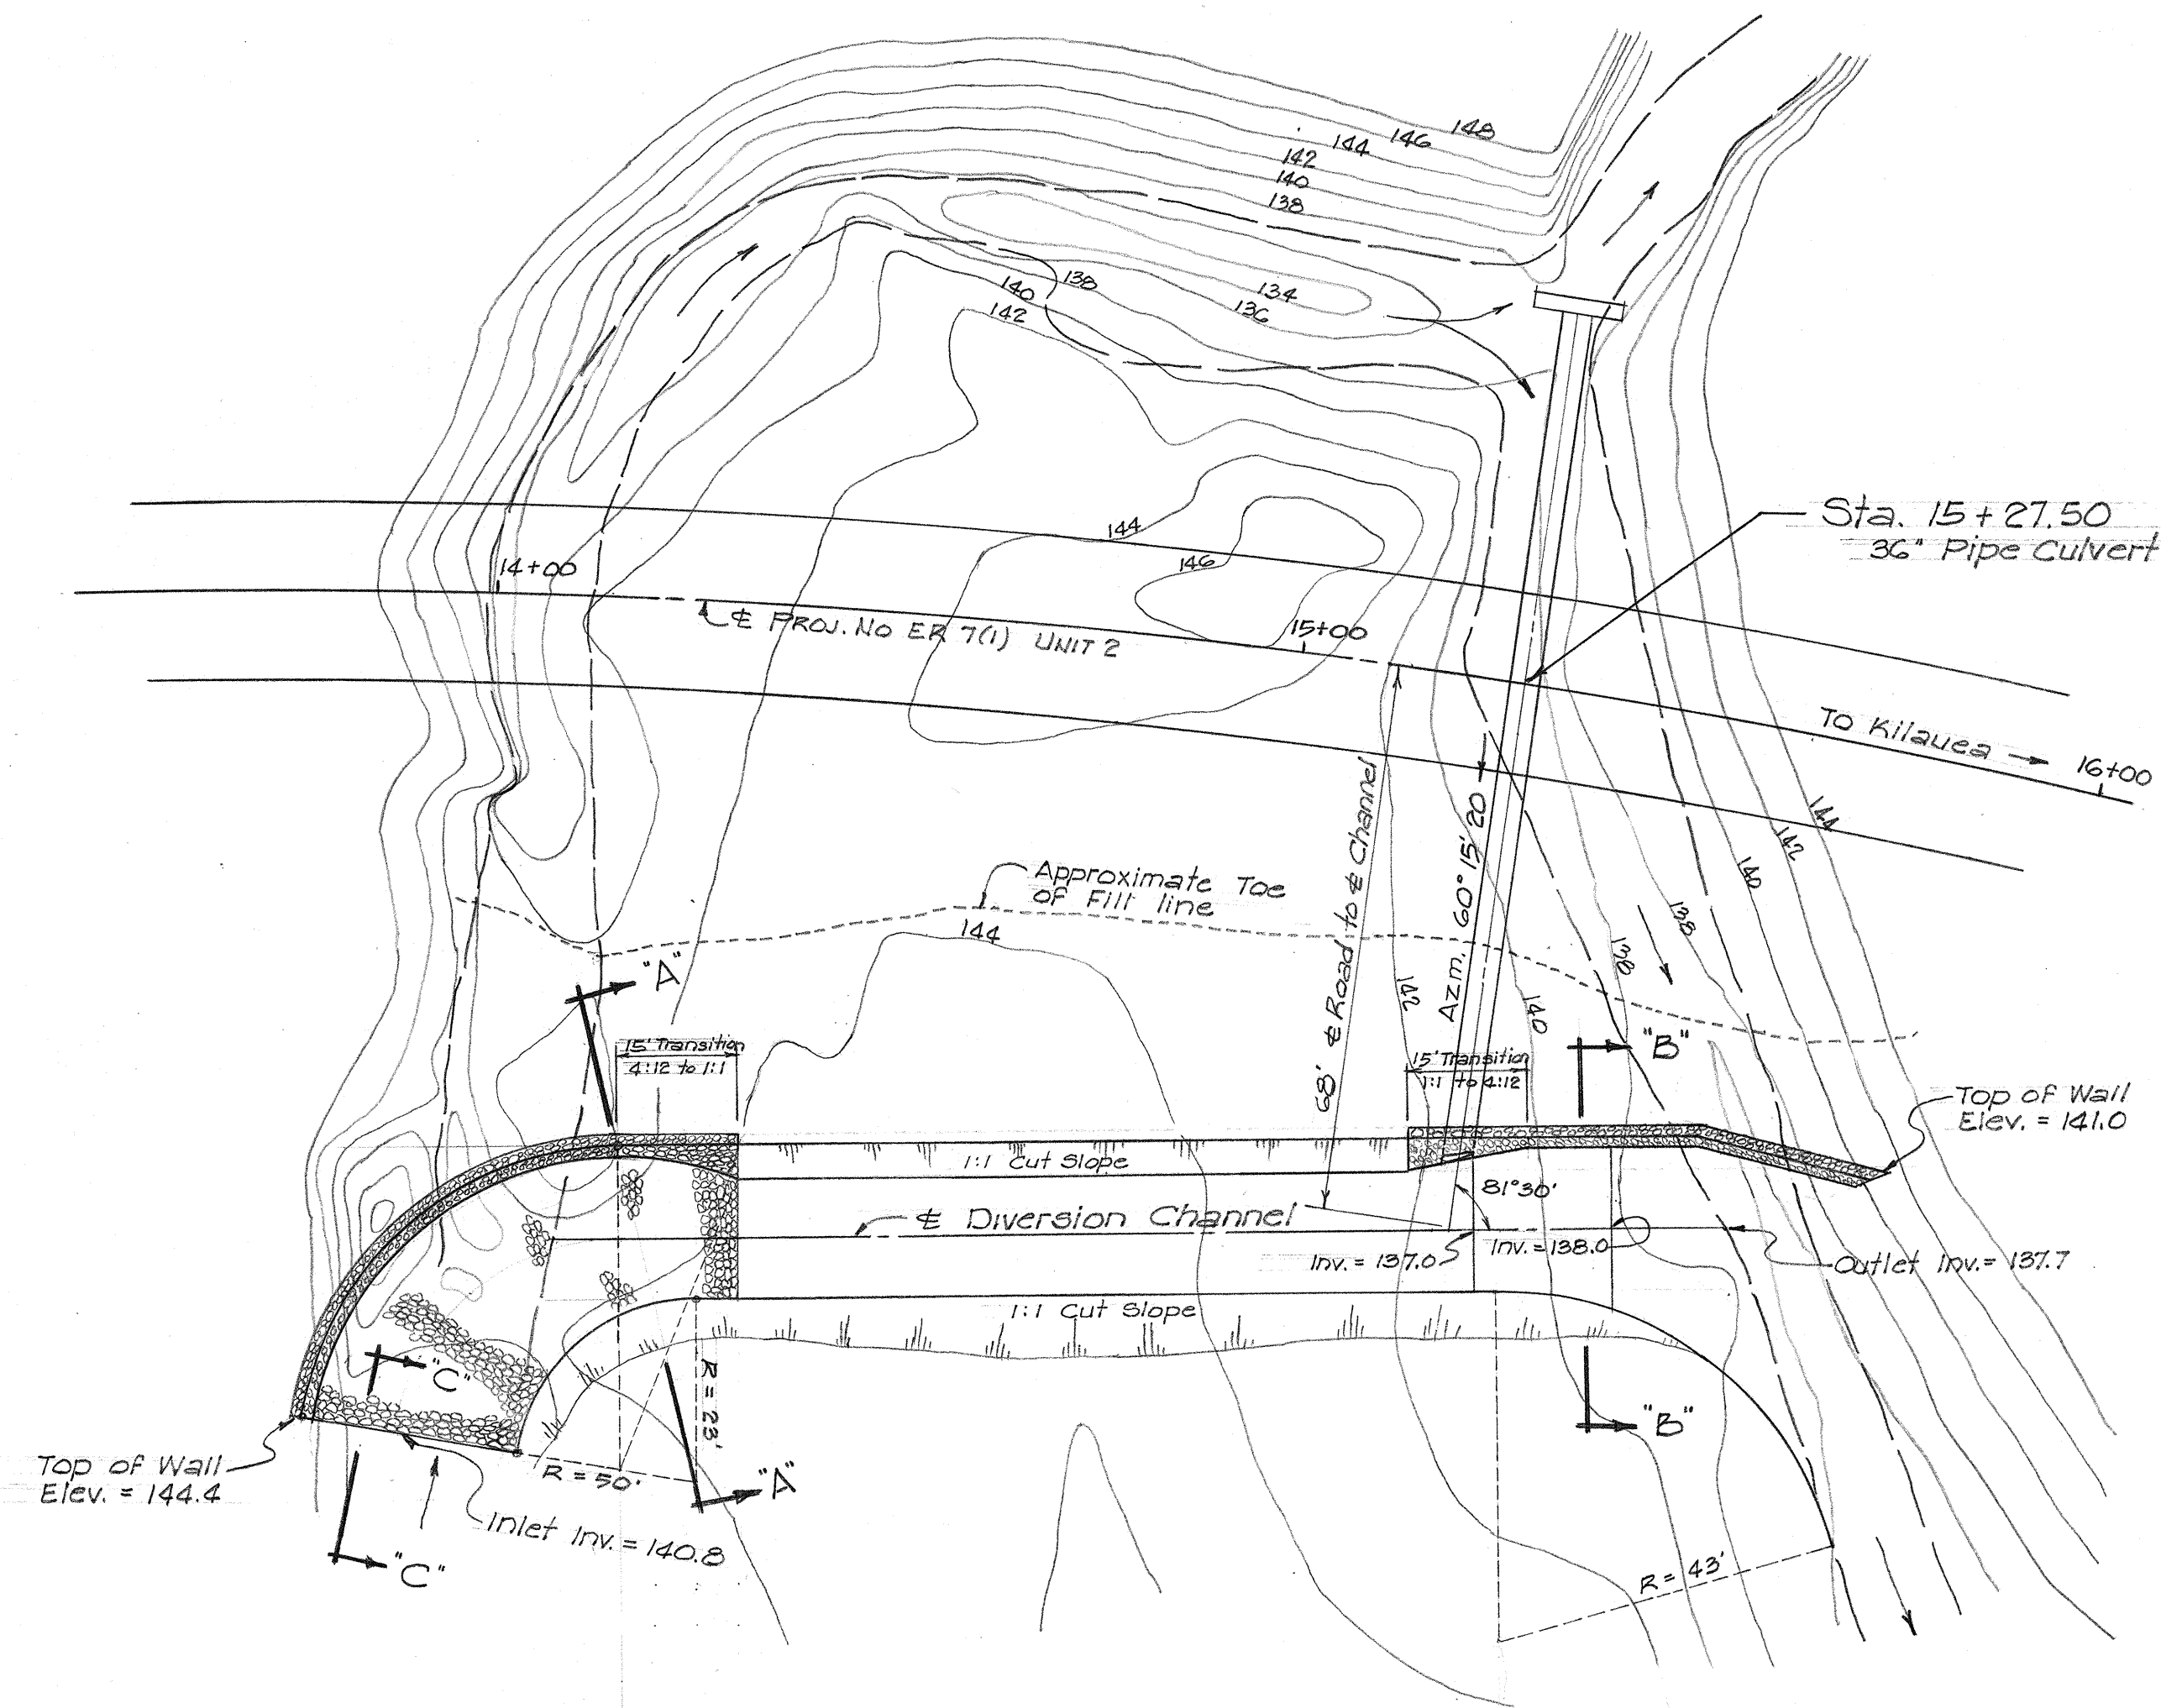


PLAN SHOWING STREAM DIVERSION CHANNEL AT STATION 14+85± RIGHT

Scale: 1" = 20'

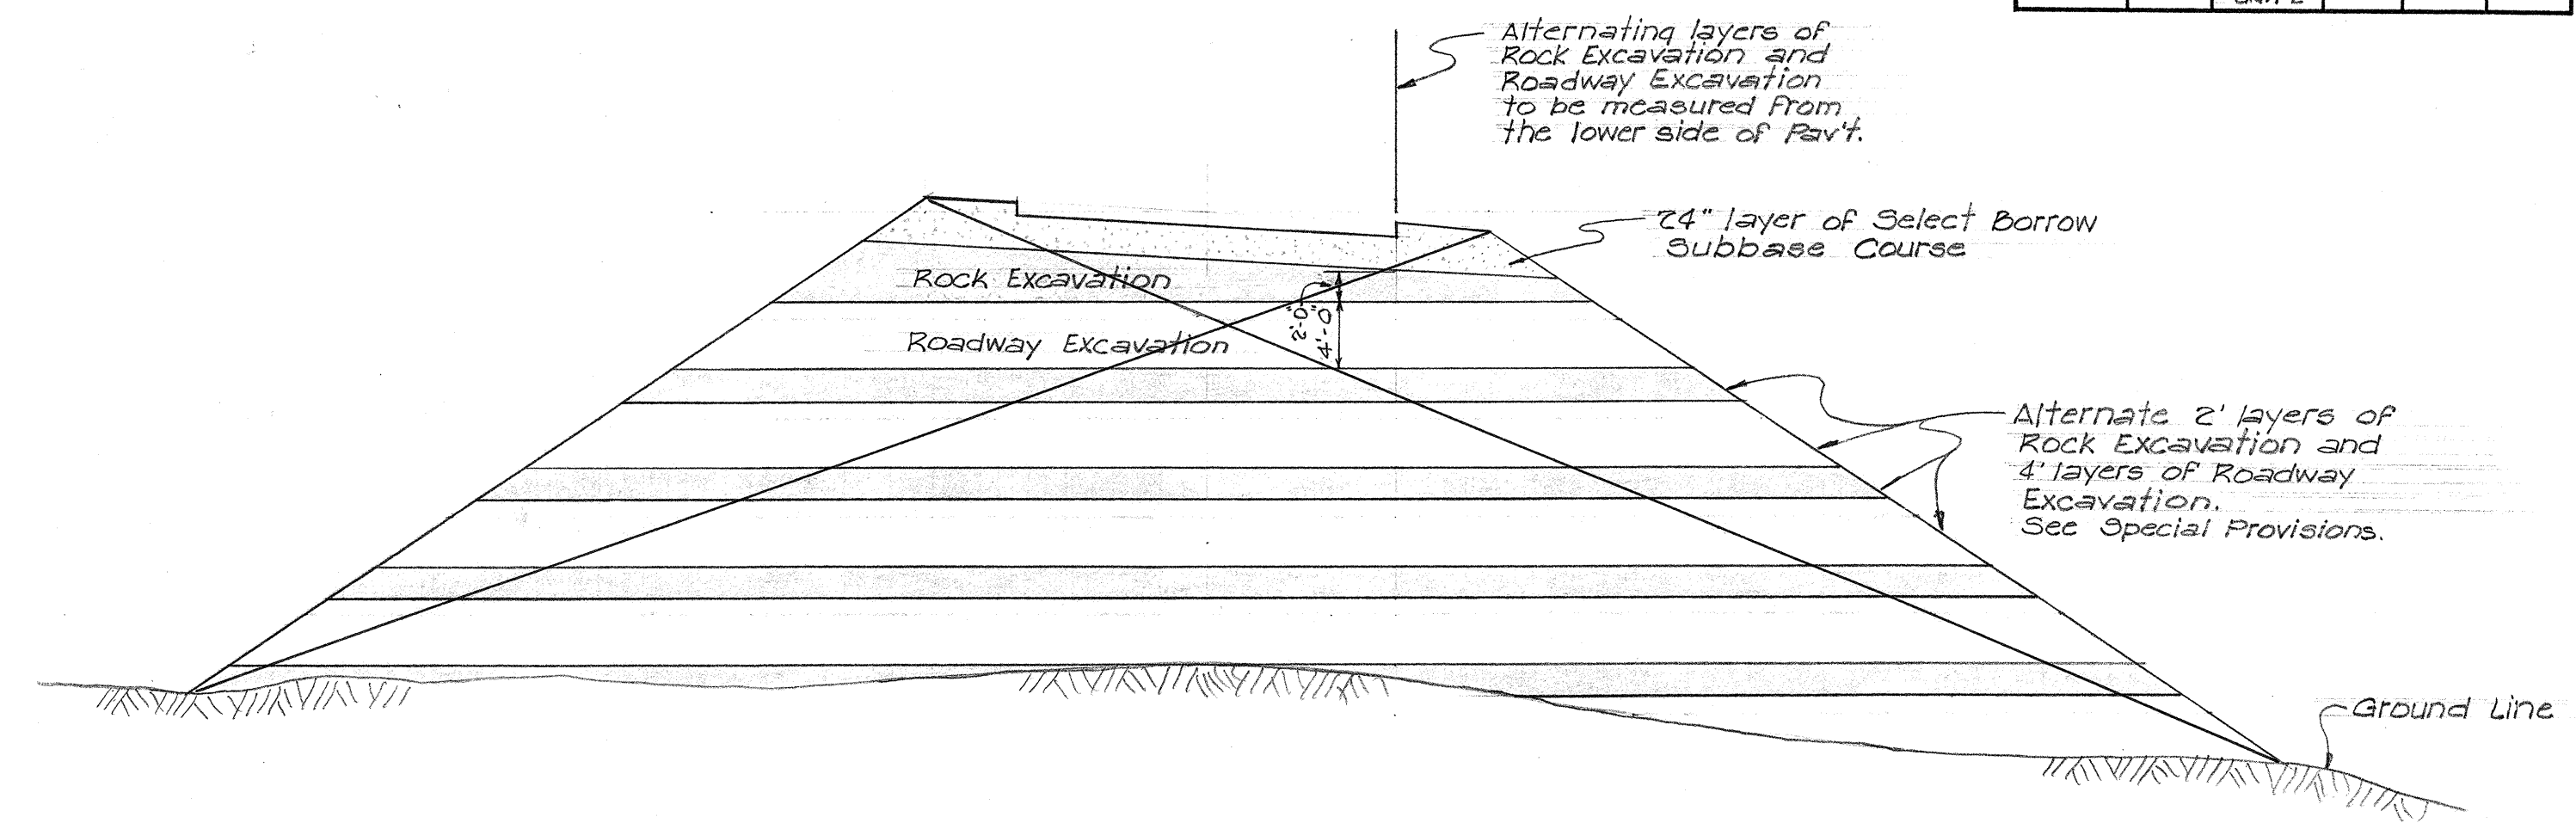


TYPICAL SECTION SHOWING EMBANKMENT CONSTRUCTION BETWEEN STATION 34+57.12 TO END OF PROJECT

Scale: 1" = 10'

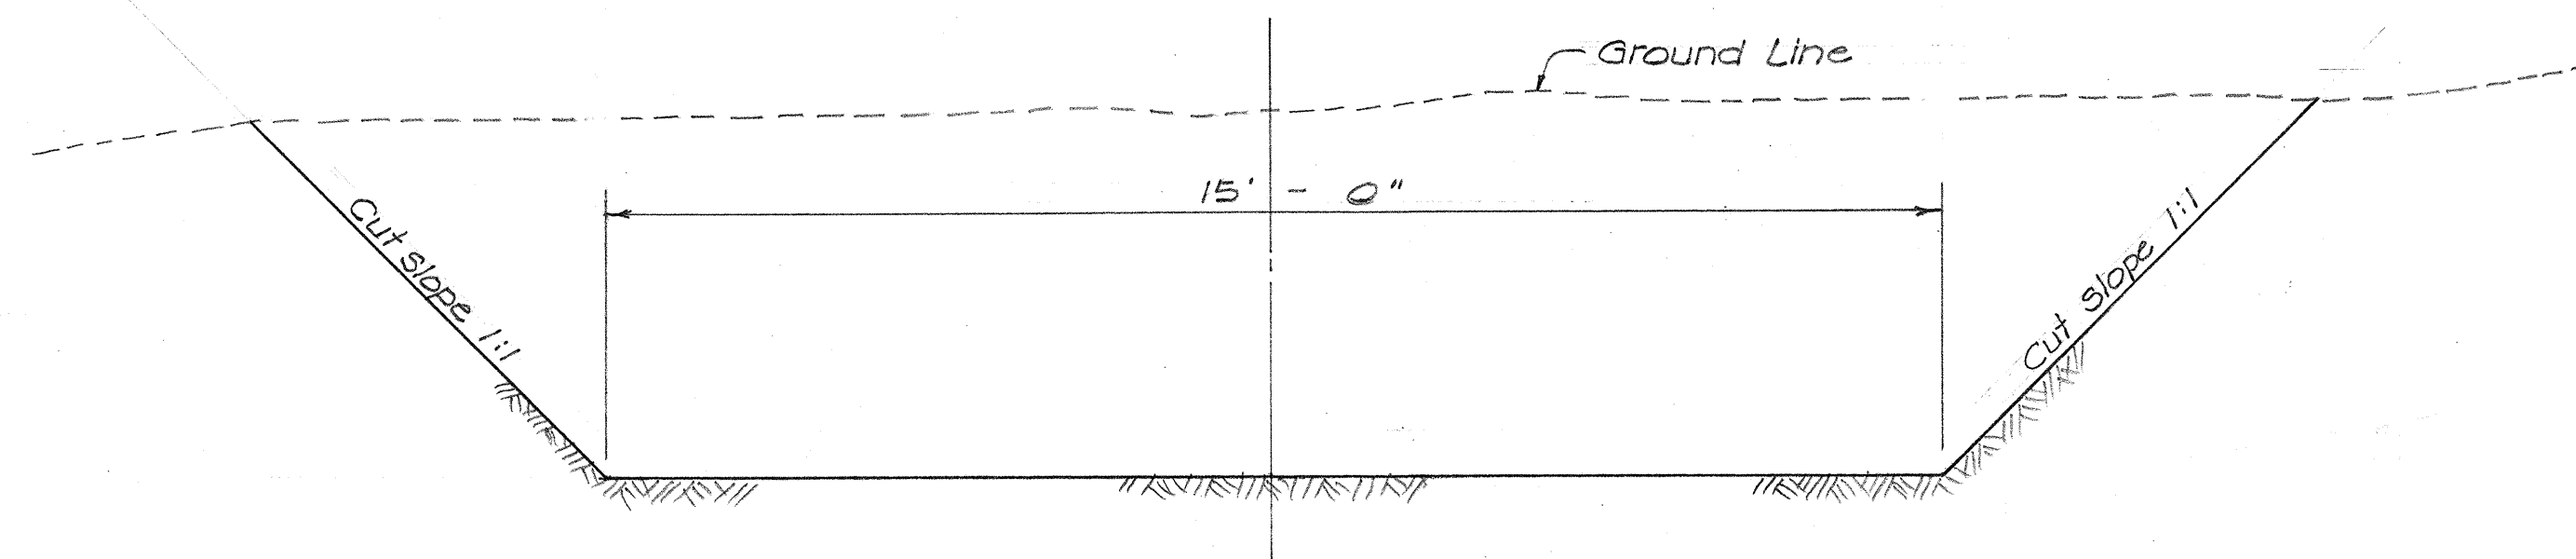


TYPICAL SECTION DIVERSION CHANNEL

Scale: 1/2" = 1'-0"

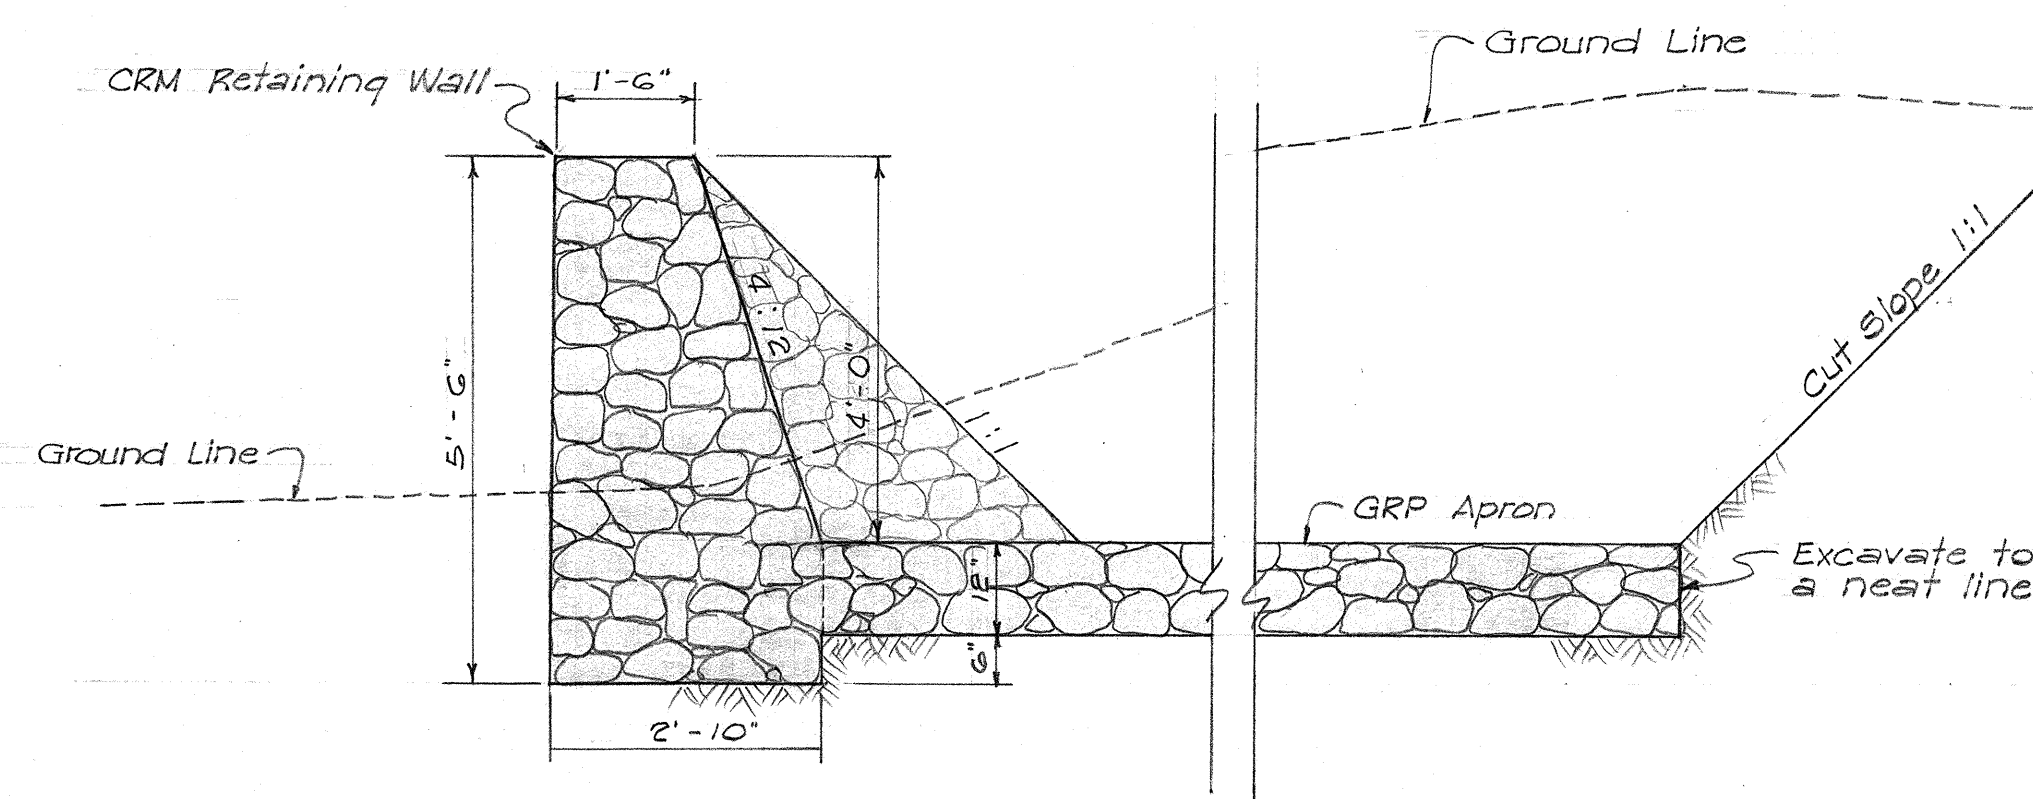


SECTION "A"-A

Scale: 1/2" = 1'-0"

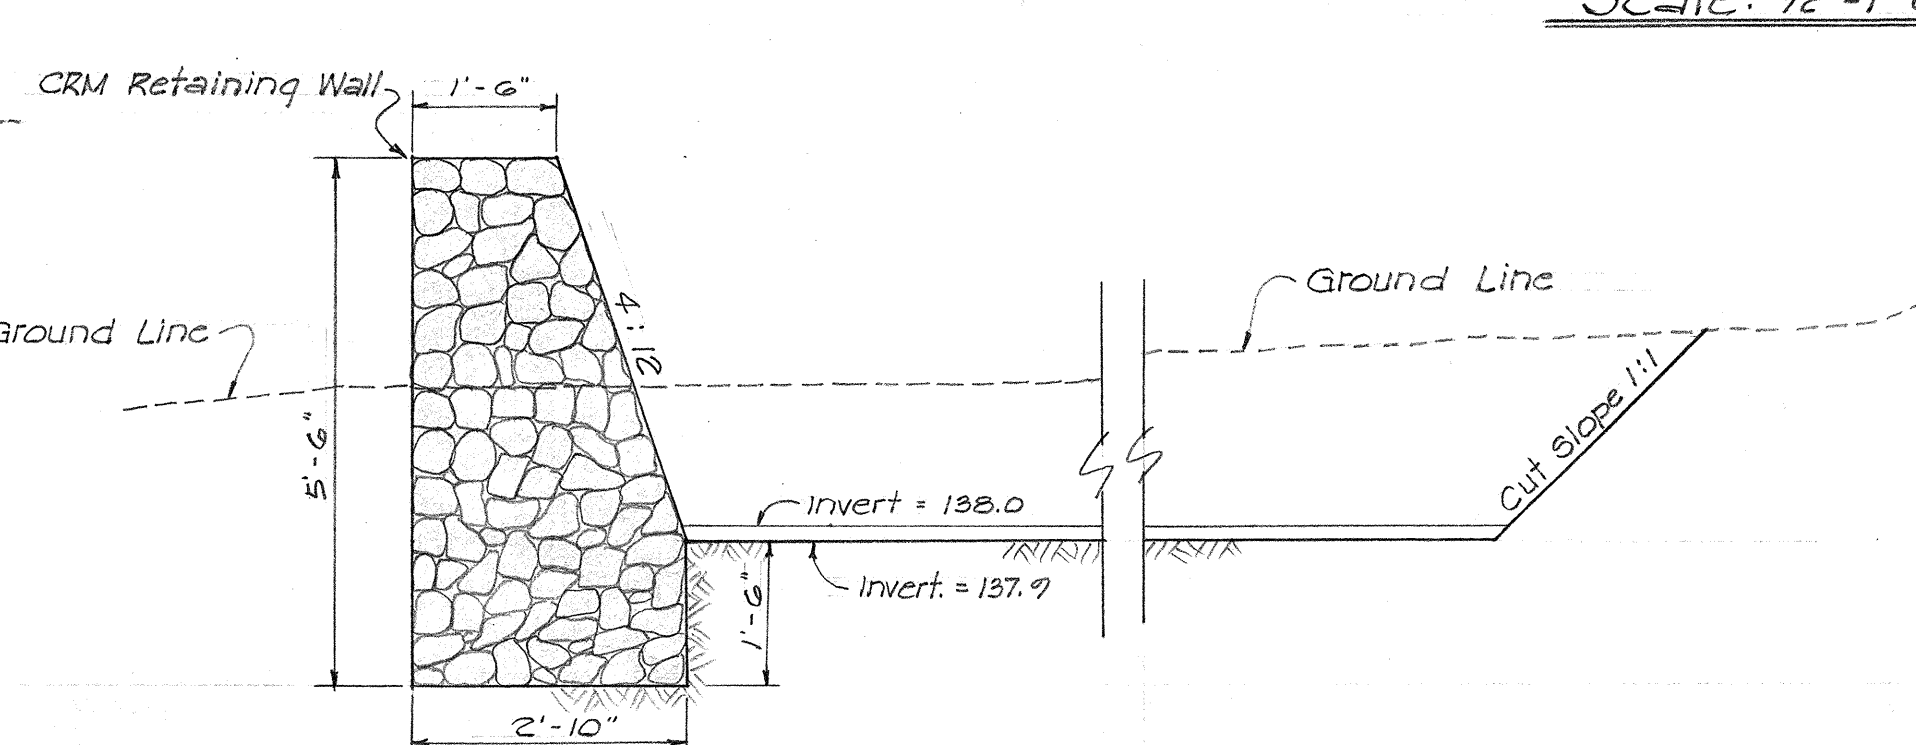

SECTION "B"-B

Scale: 1/2" = 1'-0"

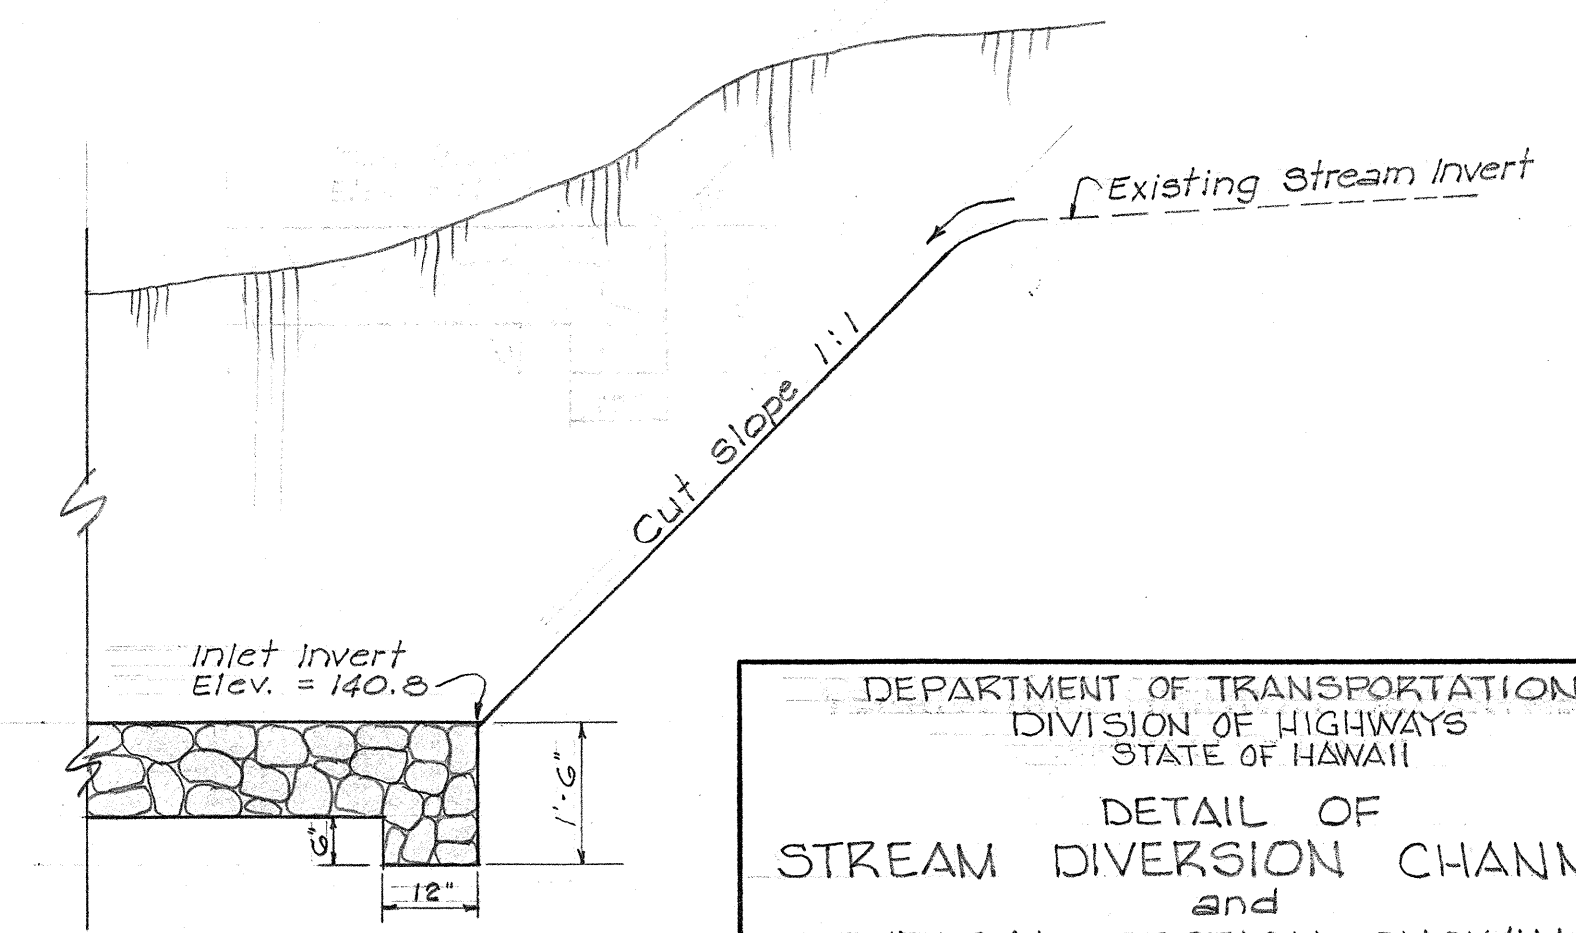

SECTION "C"-C

Scale: 1/2" = 1'-0"

DEPARTMENT OF TRANSPORTATION
DIVISION OF HIGHWAYS
STATE OF HAWAII
DETAIL OF
STREAM DIVERSION CHANNEL
and
TYPICAL SECTION SHOWING
EMBANKMENT CONSTRUCTION
KAUAI BELT RD. ~ PROJ. NO. ER 7(1) UNIT 2
Scale: As Shown

SURVEY PLOTTED BY	DATE
DESIGNED BY	
DRAWN BY	
TRACED BY	
QUANTITIES CHECKED BY	
CHECKED BY	
ORIGINAL PLAN	
NOTE BOOK	
No.	