



FED. AID DIST. NO.	STATE	FED. AID PROJ. NO.	FISCAL YEAR	HEET NO.	TOTAL SHEETS
HAWAII	ER-703	Unit 2	1961	34	77

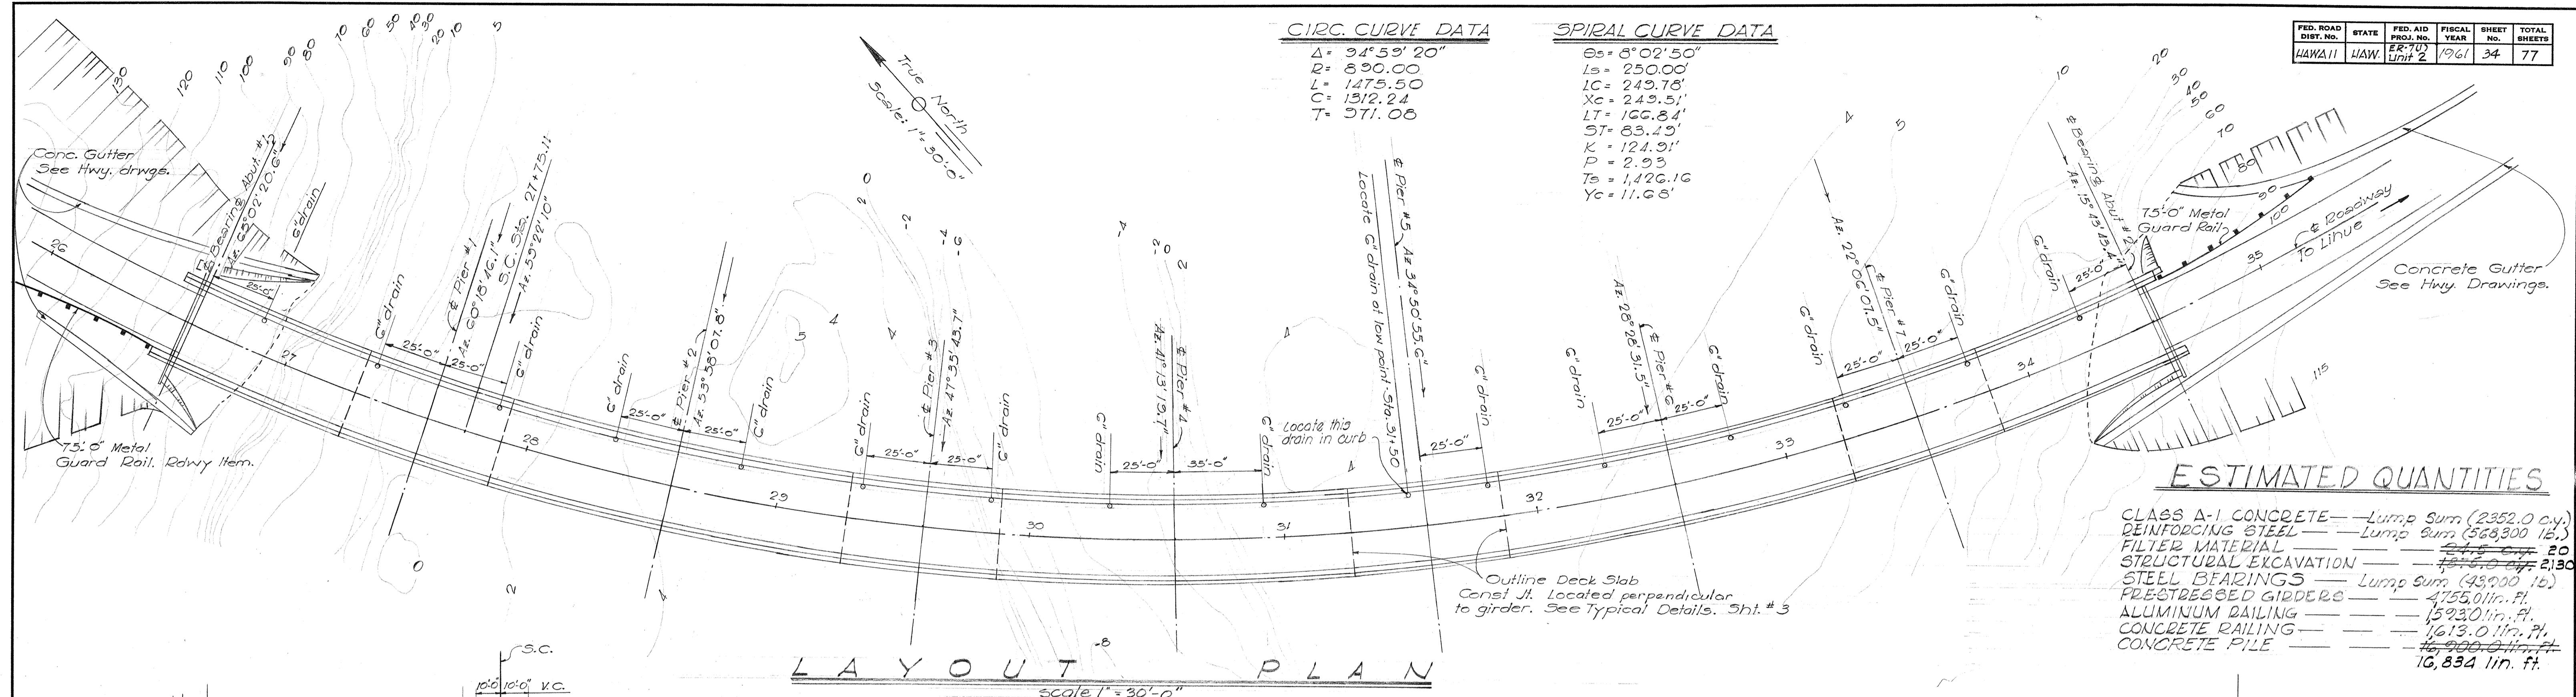

LA Y O U T P L A N
scale 1" = 30'-0"

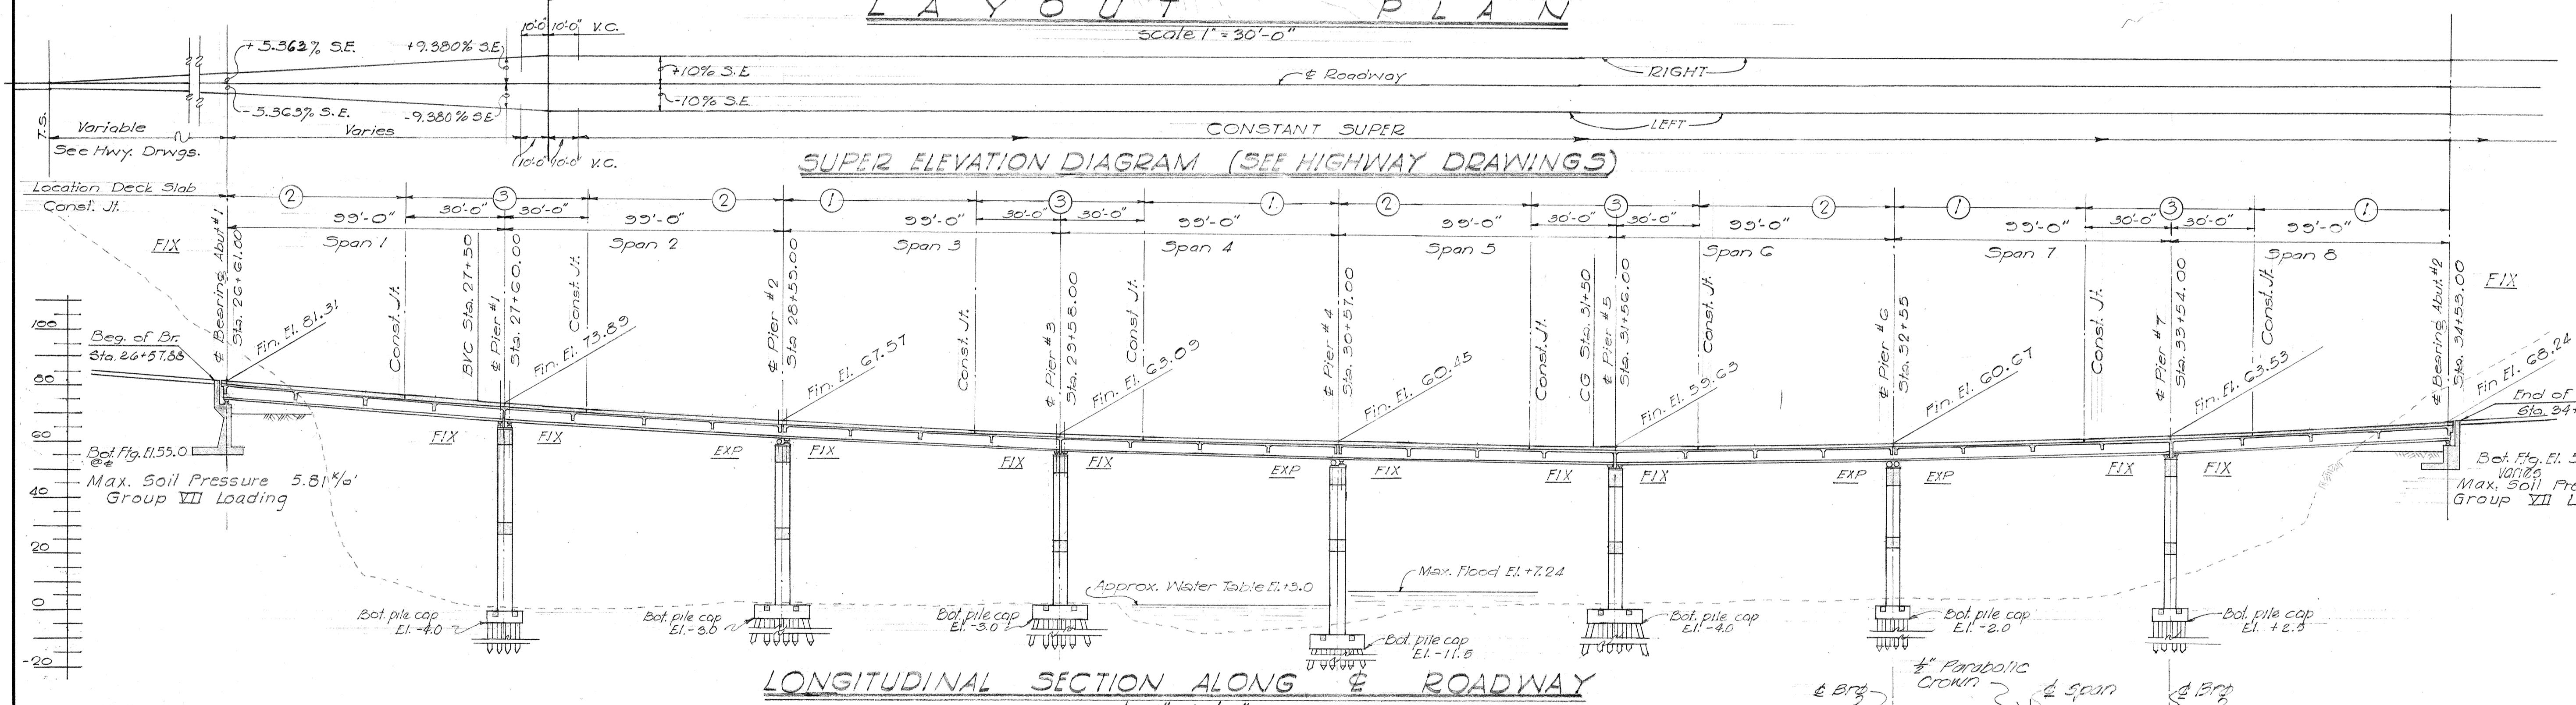

LONGITUDINAL SECTION ALONG \$ ROADWAY

scale: 1" = 30'-0"

GENERAL NOTES

MATERIALS

All concrete class A-I except for prestressed concrete girders & piles & precast concrete piles. See Special Provisions for class of concrete for prestressed concrete girders & piles. Concrete for precast concrete piles shall be F-1; See Standard Specifications.

CONSTRUCTION METHODS

Sequence of Pour: Deck pour ① & ② shall be poured before ③.

All backfill behind abutments shall be completed in place before placing prestressed girders.

Abut. fts. shall be excavated & poured to neat lines. In case of over excavation, space between footing & ground shall be filled with concrete at the Contractor's expense. This concrete shall have a minimum of Class D-I.

Bridge to be constructed on curve, except as otherwise noted.


SEAL FOR FOOTING
In depositing concrete for footings below water table, it shall be the contractor's responsibility to provide crushed rock or seal concrete at his expense so that concrete can be deposited under dry conditions. Excavation necessary to place crushed rock or seal concrete shall be incidental to excavation and will not be paid for separately.

GENERAL
Top of concrete deck to follow Roadway grade. Deck slab cambered.

SYMBOLS

Section Letter:

Bridge Sheet No. _____ of _____ detail is drawn on.

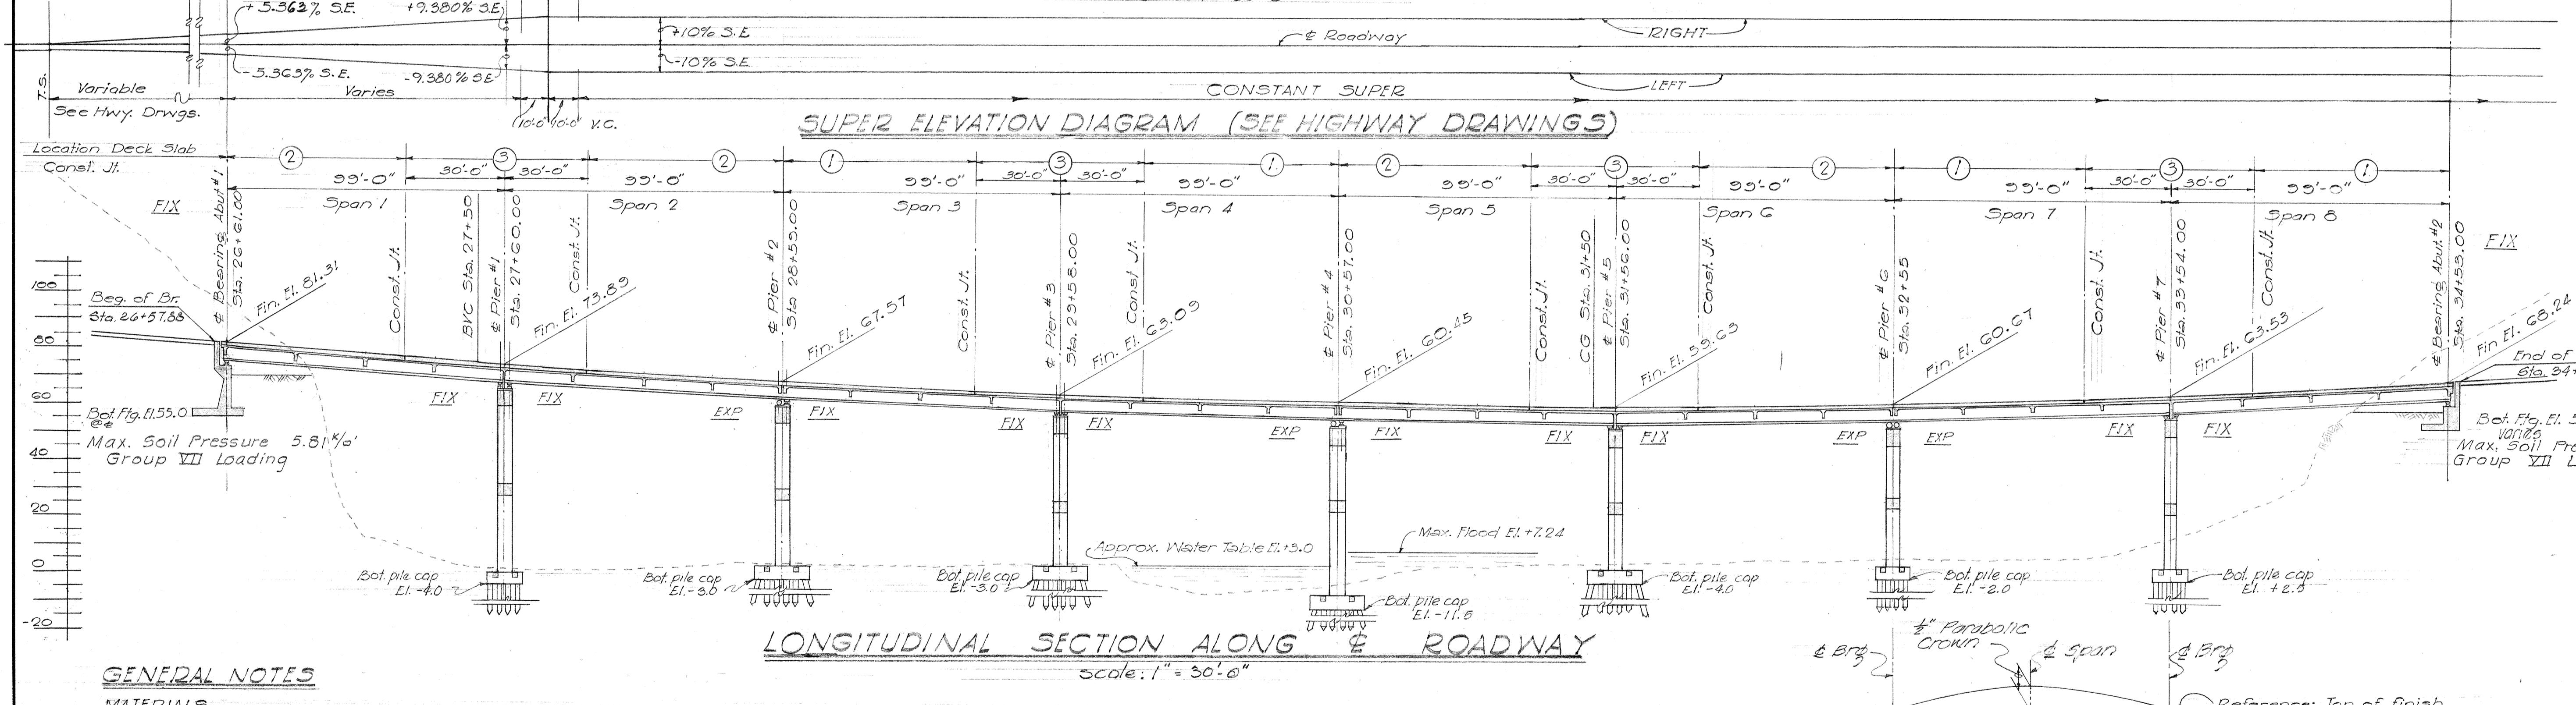


CAMBER DIAGRAM FOR CONC. DECK - EACH SPAN
NO SCALE

ALTERNATE "B"

DEPARTMENT OF TRANSPORTATION
DIVISION OF HIGHWAYS
STATE OF HAWAII

STRUCTURE N° 5
KALIHIWAI BRIDGE
STA. 26+57.88 TO STA. 34+56.12
KAUAI BELT ROAD PROV. N° ER-7(1)
FEBRUARY 1961 - UNIT 2


FED. ROAD DIST. NO.	STATE	FED. AID PROJ. NO.	FISCAL YEAR	SHEET NO.	TOTAL SHEETS
HAWAII	HAW.	ER-7(1)	1961	36	77

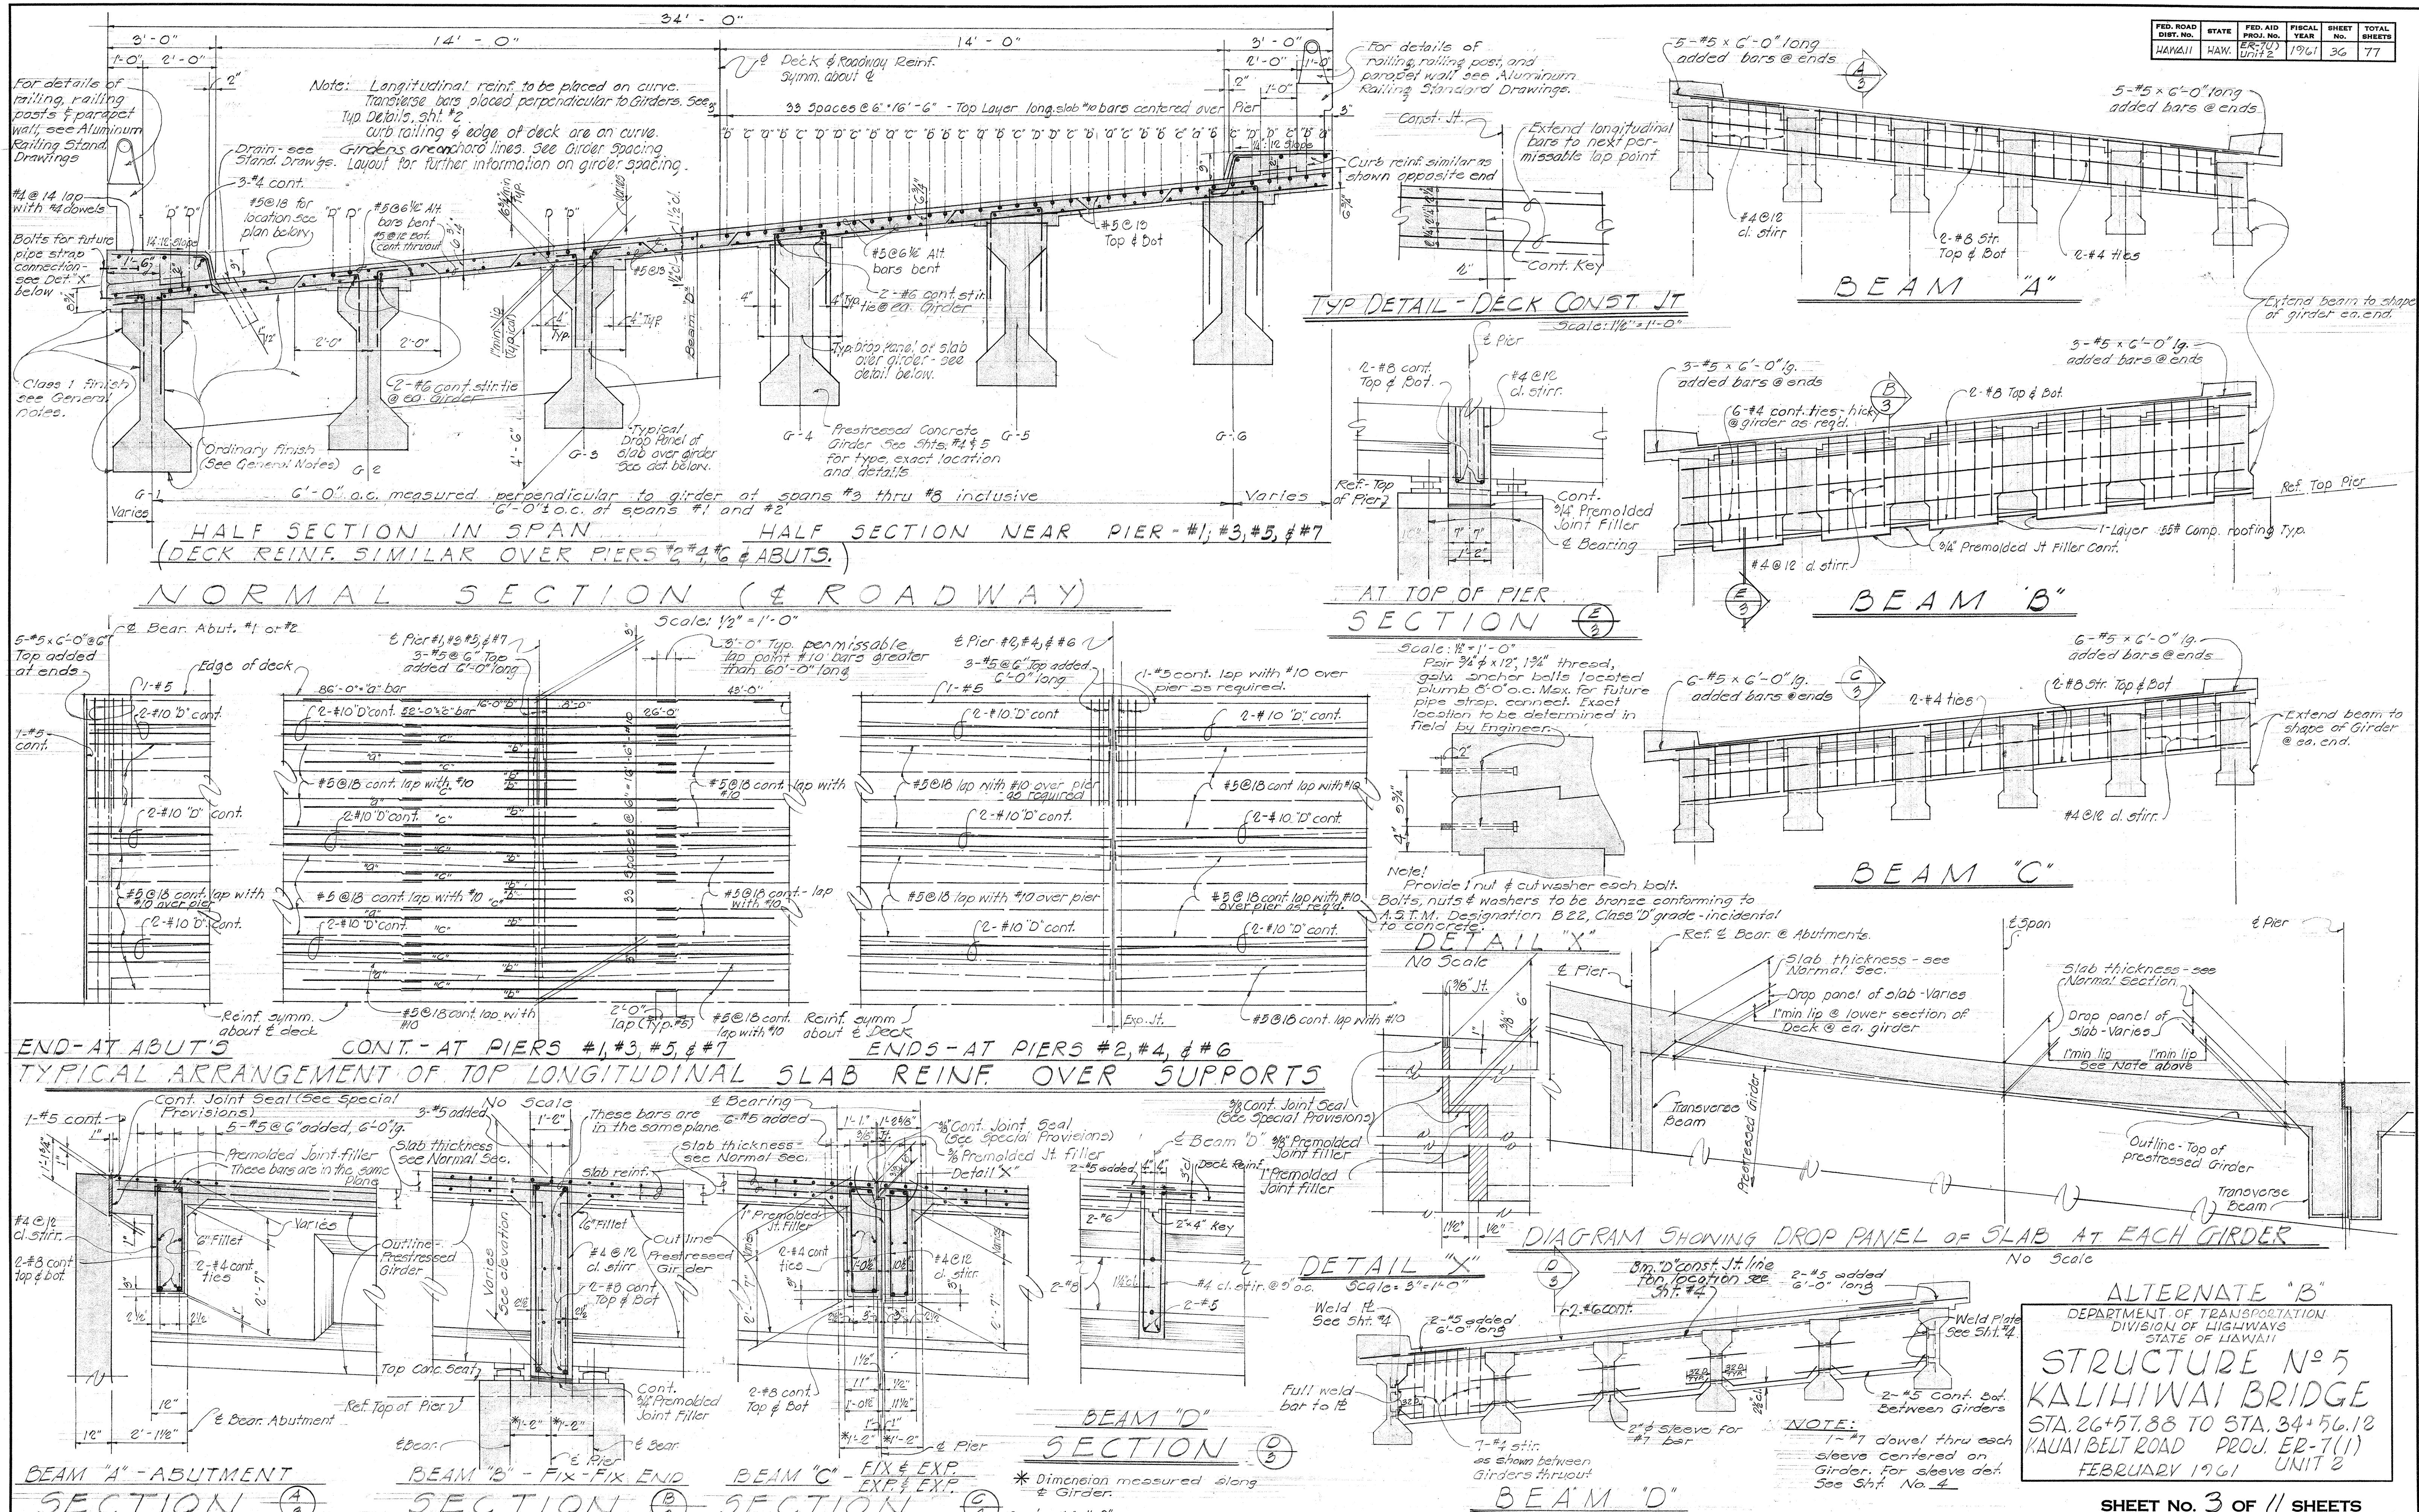


ORIGINAL SURVEY PLOTTED BY	DATE
PLAN DRAWN BY	TRACED BY
NOTE BOOK NO.	QUANTITIES CHECKED BY

FED. ROAD DIST. NO.	STATE	FED. AID PROJ. NO.	FISCAL YEAR	SHEET NO.	TOTAL SHEETS
HAWAII	HAW.	ER-7(1) Unit 2	1961	37	77

DE PIER N°5

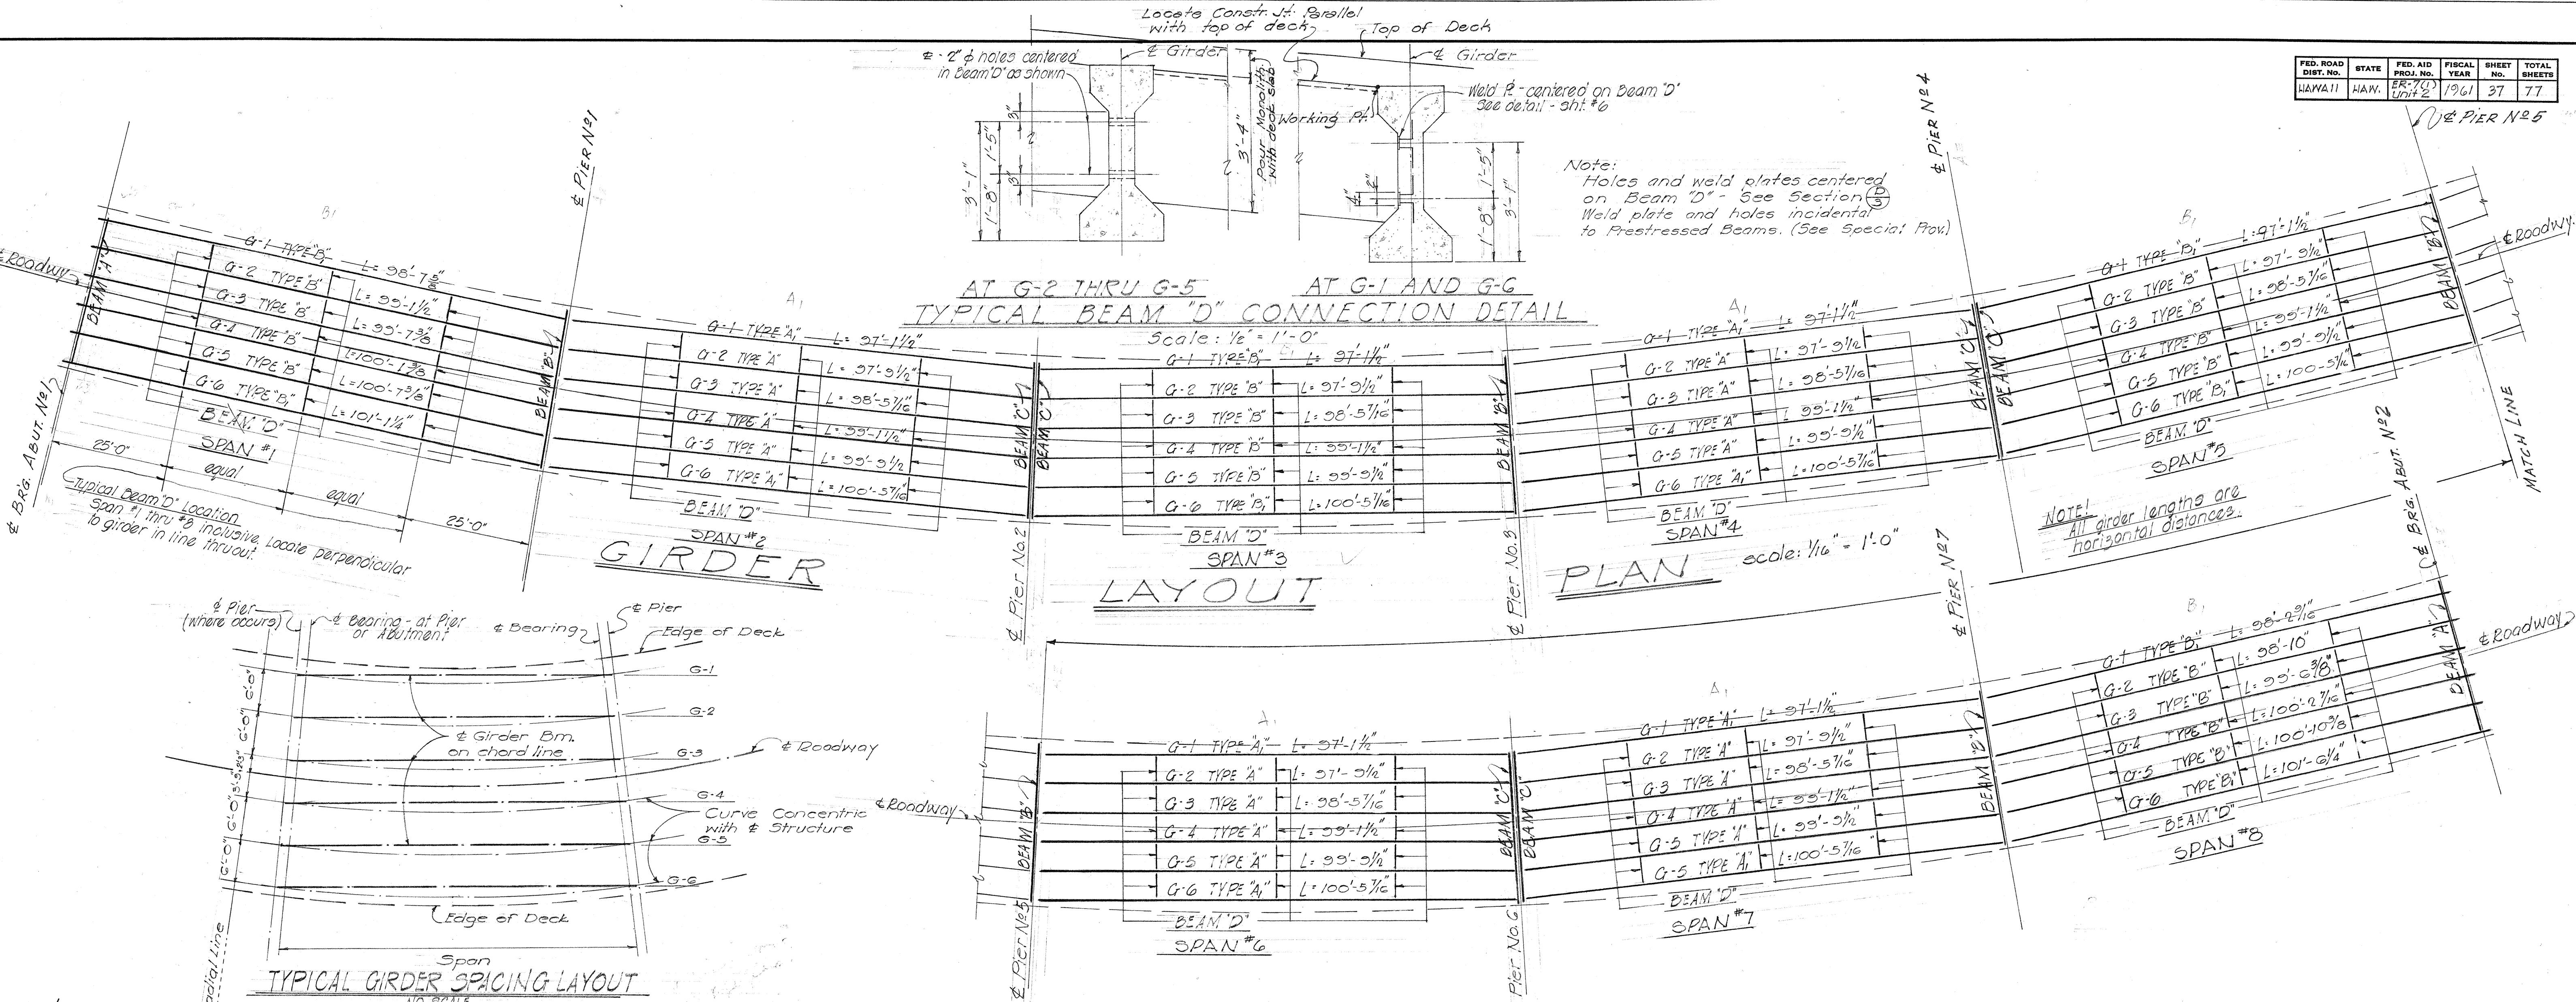


NOTE!
1. For girder details & restraint, see corresponding details, shft. 5.
2. All girder dimensions are horizontal distances.

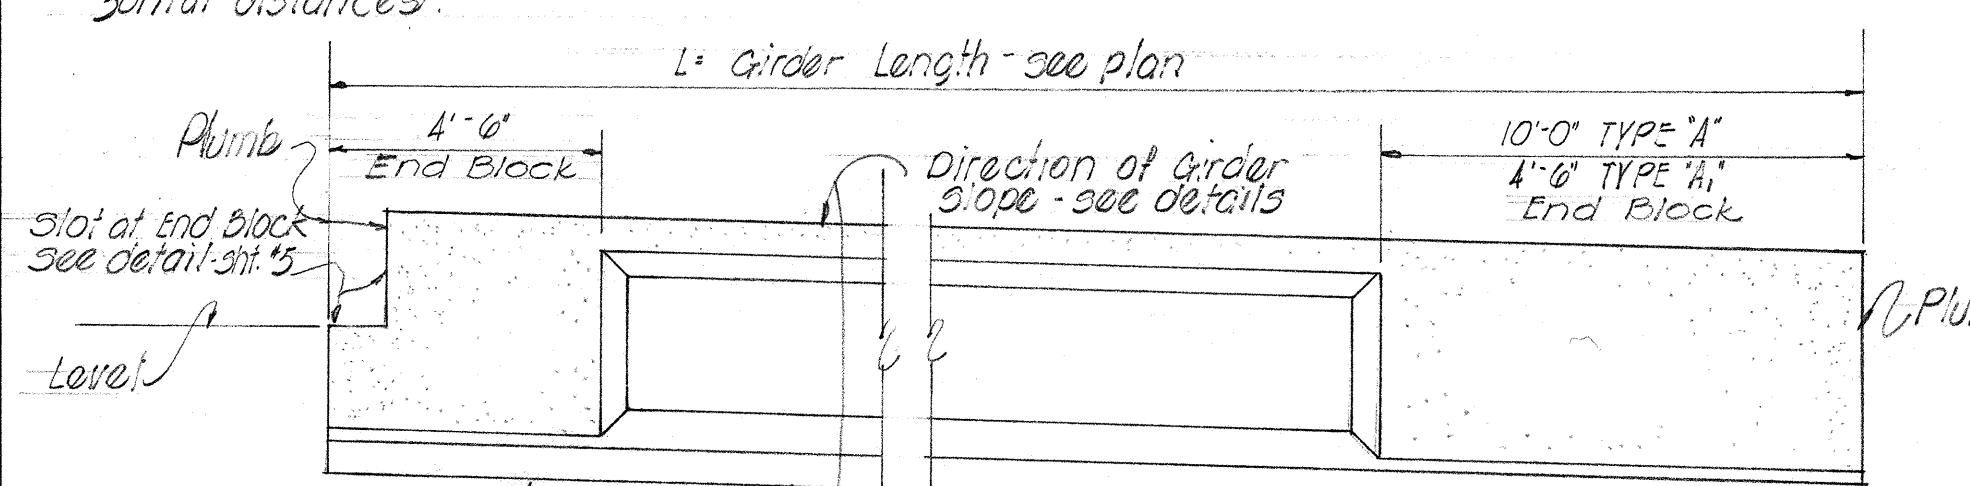

TYPICAL GIRDER SPACING LAYOUT

NO SCALE

ORIGINAL SURVEY PLOTTED BY
DESIGNED BY
DRAWN BY
TRACED BY
QUANTITIES CHECKED BY
NOTE BOOK NO.

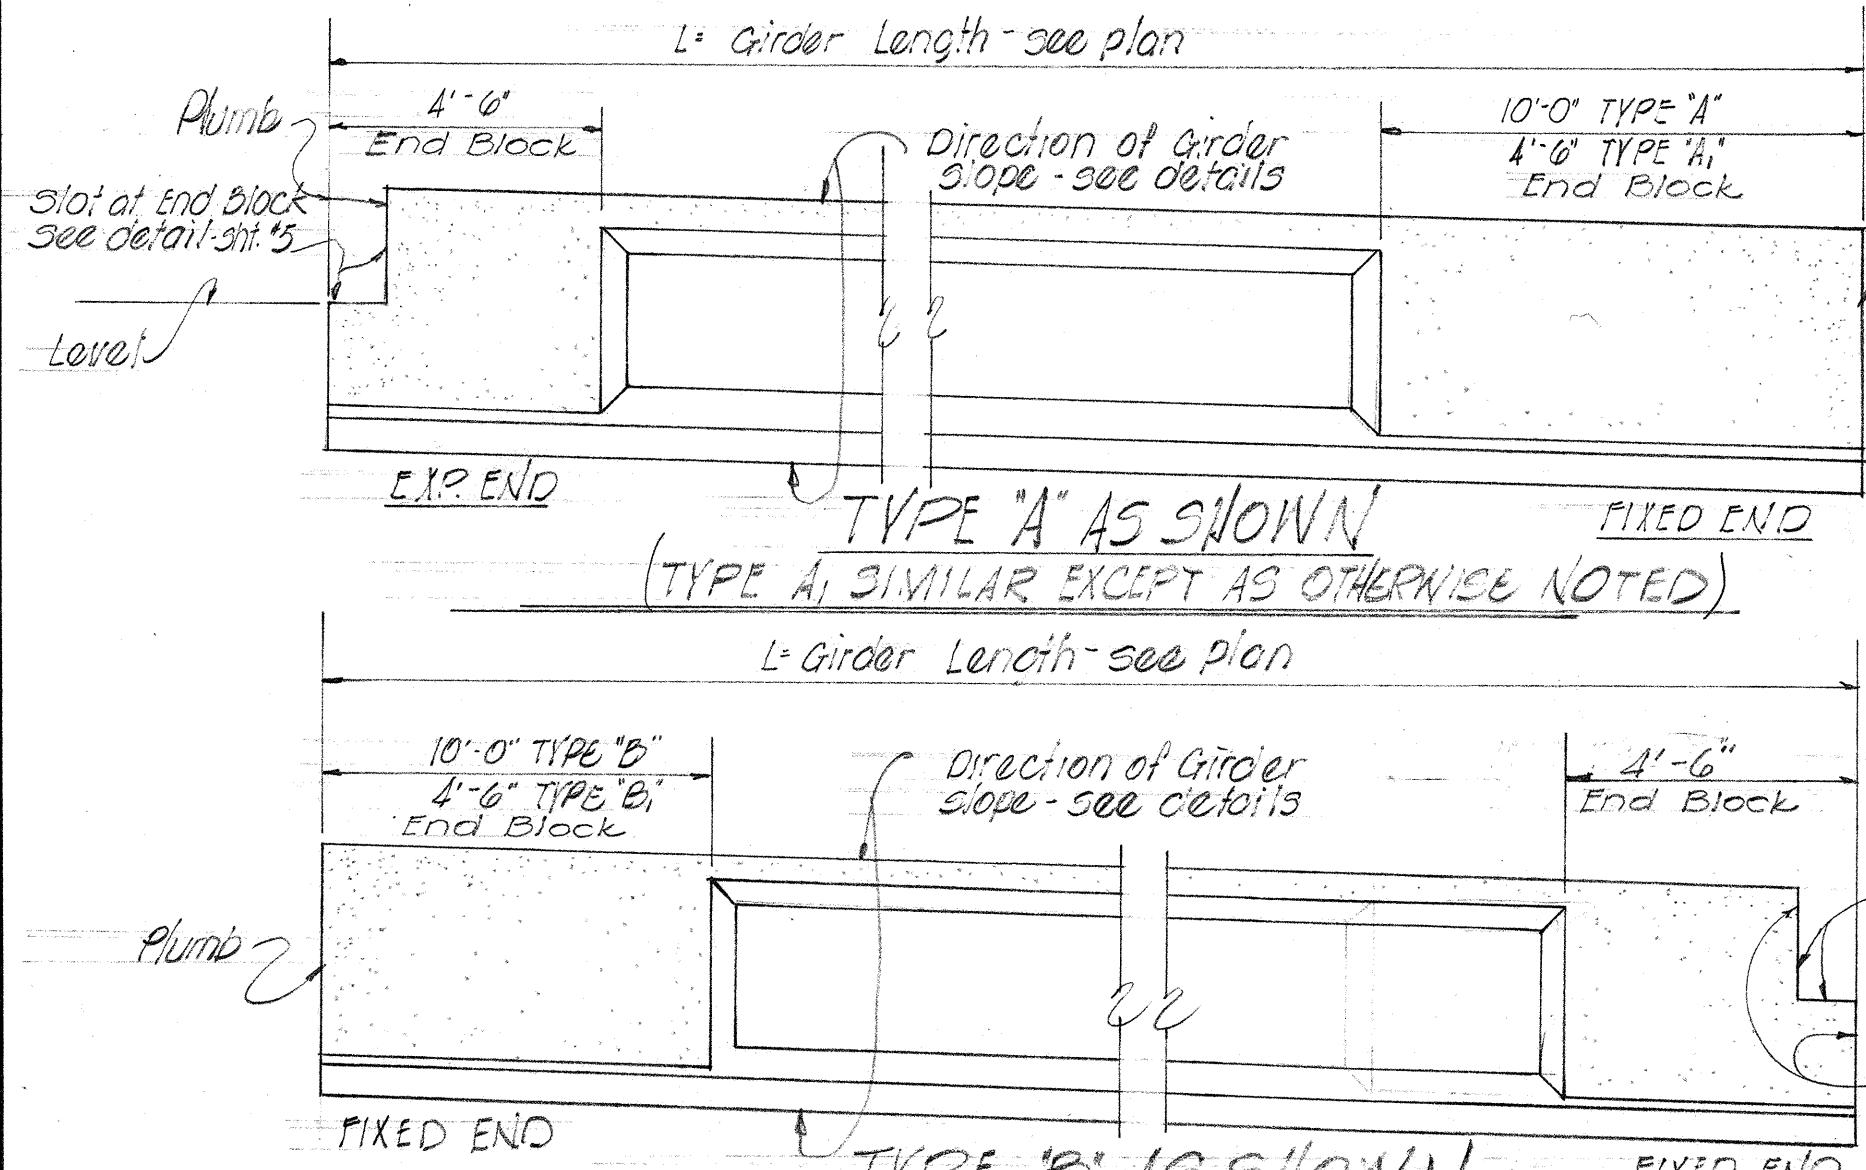


TYPICAL PRESTRESS GIRDER DETAIL

DEPARTMENT OF TRANSPORTATION
DIVISION OF HIGHWAYS
STATE OF HAWAII
STRUCTURE N°5
KALIHIWAI BRIDGE
STA. 26+57.88 TO STA. 34+56.12
KAUAI BELT ROAD PROJ. ER-7(1)
FEBRUARY 1961 UNIT 2

FED. ROAD DIST. No.	STATE	FED. AID PROJ. No.	FISCAL YEAR	SHEET No.	TOTAL SHEETS
HAWAII	HAW.	ER-7(1) Unit 2	1966	38	77

L=Length of Girder (See Lay Out Plan sht. #4)

IMPORTANT!!! All Girders
cut all strands 6" from end of girder on
FIX-FIX support side to anchor into beam.
cut all strands flush to end of girder on FIX-EXPANSION
side and paint with three coats of red lead.

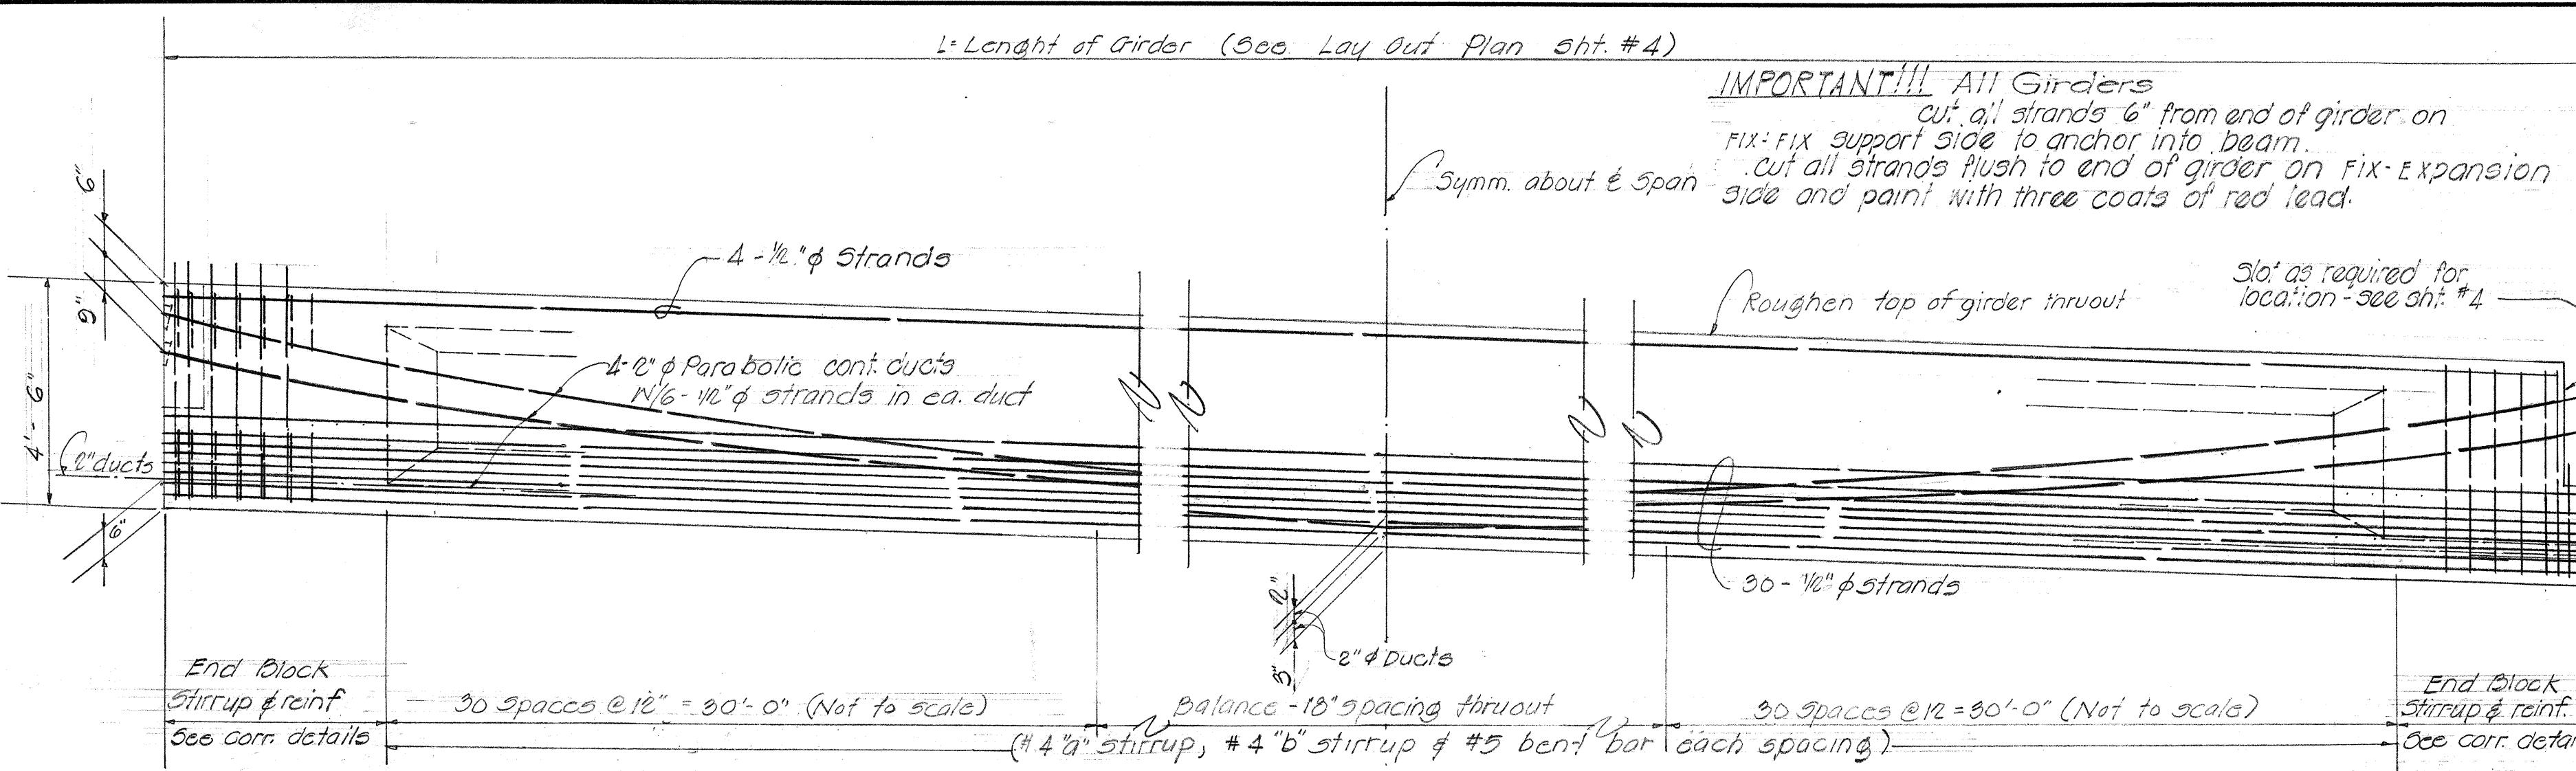

TYPICAL INTERIOR GIRDER S G-2, G-3, G-4, G-5 INCL

Scale: $\frac{3}{8}'' = 1'-0''$

(TYPE A & B)

FIX AND EXP ENDS
PIER #2, #4, & #6
ABUT'S #1 & #2

NOTE!
For typical prestress Girder
details - See sht. # 4.

FIX - FIX ENDS
PIER #1, 3, 5 & 7

ELEVATION-TYP END BLOCK SECTION-PRESTRESSED GIRDER

L = Length of Girder (See Lay Out Plan Sht.#4)

6 - $\frac{1}{2}$ " ϕ strands

2" ϕ Parabolic cont. duct
W/ 6 - $\frac{1}{2}$ " ϕ strands in ea. duct

End Block
Stirrup & reinf.
See corr. details

18" spacing thruout
(#4 "a" stirr., #4 "b" stirr., & #5 "c" bent bars each spacing)

4' - 6"

6"

2" ϕ Ducts

18"

Sym. about $\frac{L}{2}$ span

Roughen top of girder thruout

30 - $\frac{1}{2}$ " ϕ strands

End Block
Stirrup & reinf.
See corr. details

slot as required
location See Sht#4

TYPICAL EXTERIOR GIRDER G-16 G-6

TYR SECTION - INTERIOR
GIRDER G-2 thru G-5

Scale: 1" = 1'-0"

TYPE SECTION EXTERIOR
GIRDER G-1 & G-6 TYPE A, OR B

Scale: 1" = 1' - 0"

TYP. PRESTRESSED GIRDER END BLOCK

SHEET NO. 5 OF 12 SHEETS

ALTERNATE "B"

DEPARTMENT OF TRANSPORTATION
DIVISION OF HIGHWAYS
STATE OF HAWAII

STRUCTURE N° 5
ALIHIWAI BRIDGE
A.26 + 57.88 TO STA. 34 + 56.12
UAI BELT ROAD PROJ. N° ER-7L
FEBRUARY 1961 UNIT 2

ALTERNATE D
DEPARTMENT OF TRANSPORTATION
DIVISION OF HIGHWAYS
STATE OF WISCONSIN

STATE OF HAWAII
STRUCTURE NO. 5




STRUCTURE N° 3 A LUMINAIS BRIDGE

ALIHAWAI BRIDGE

A. 26 + 57.88 TO STA. 34 + 56.12

UAI BELT ROAD PROJ. N° ER-7C


FEBRUARY 1961 UNIT 2

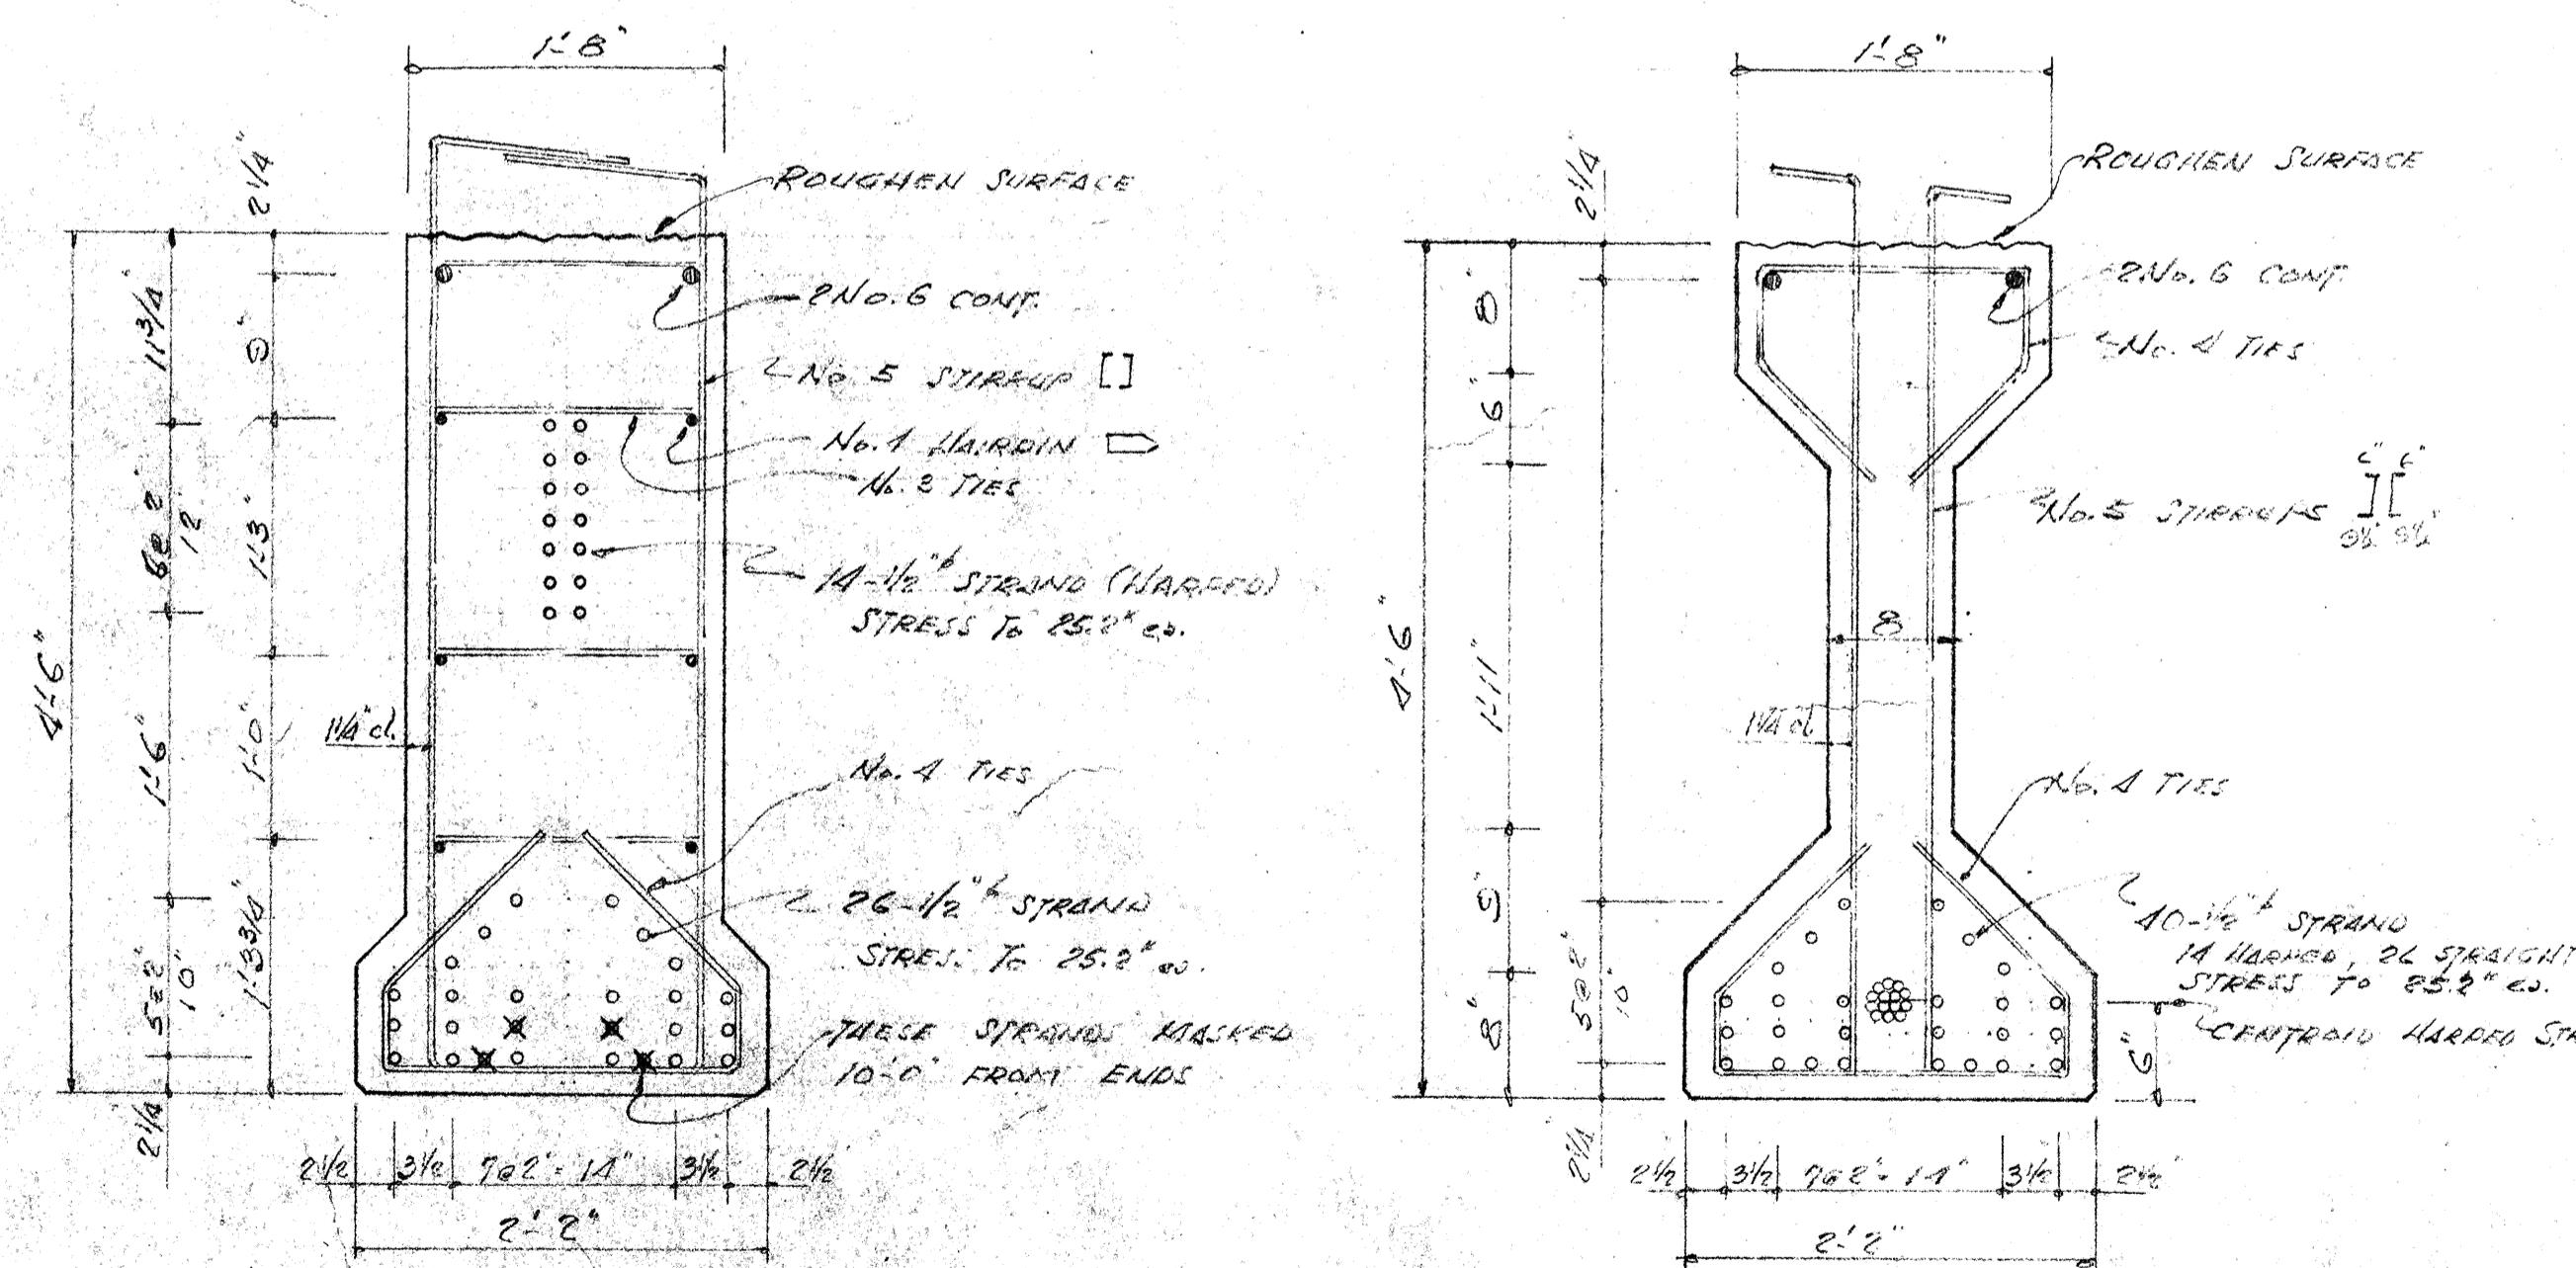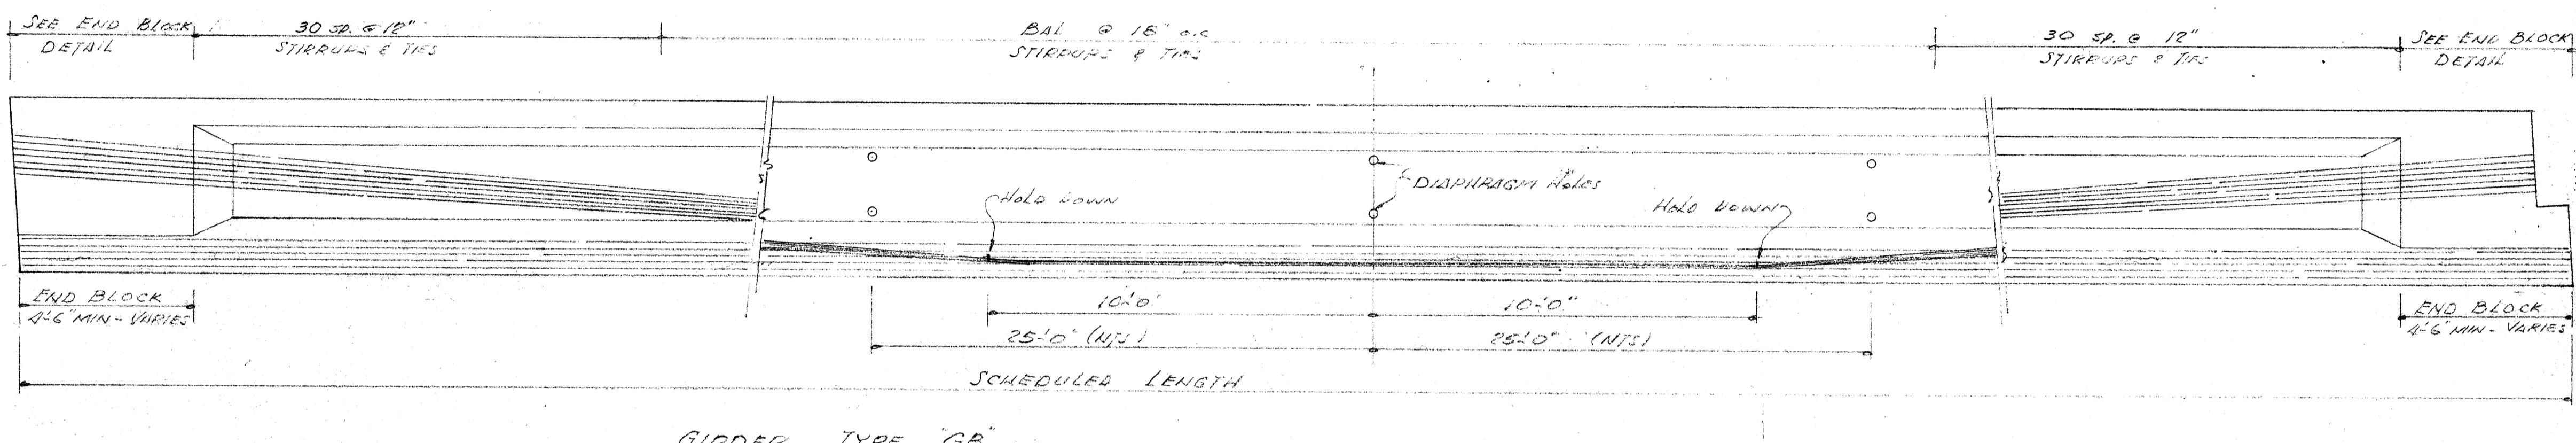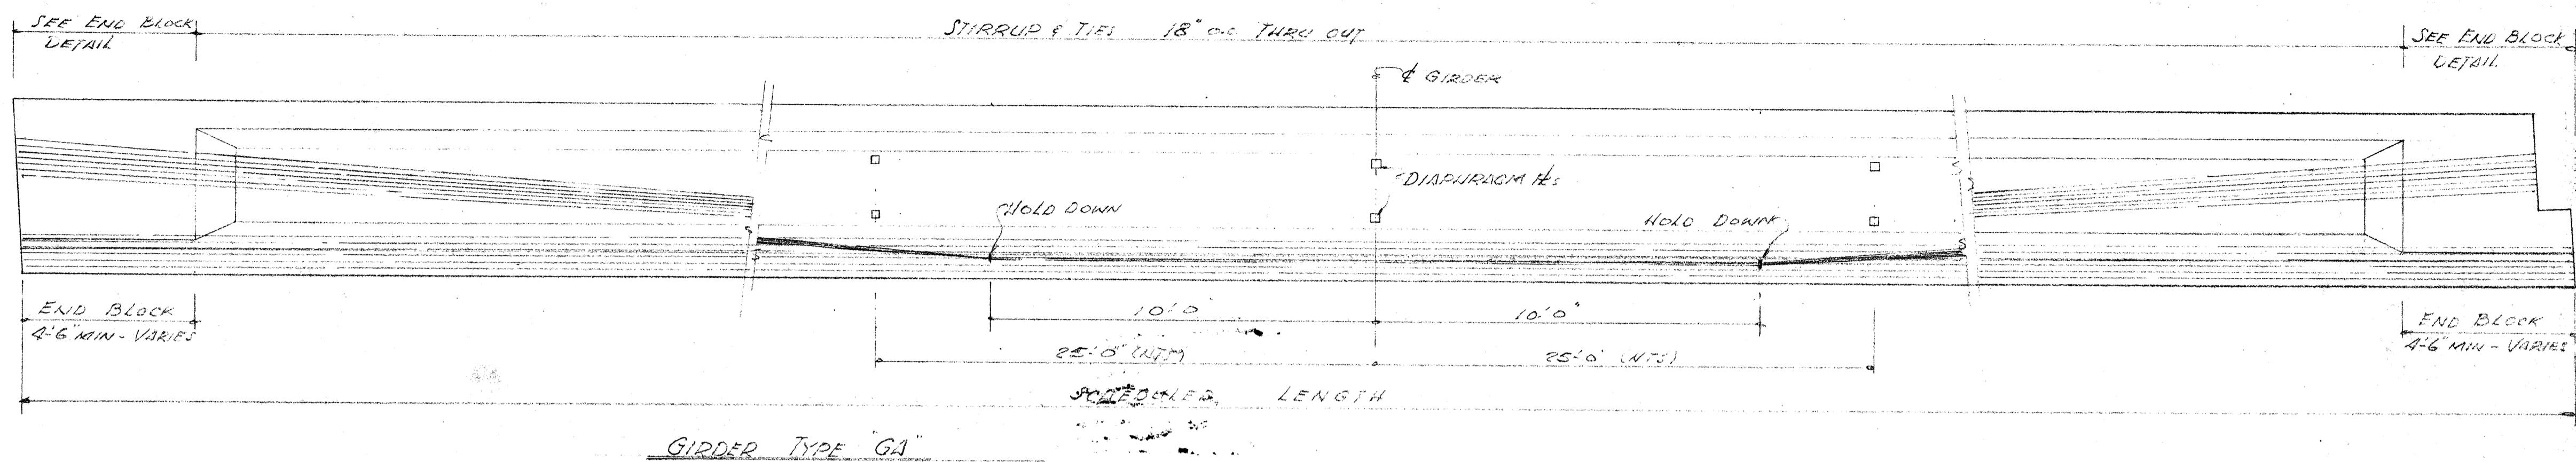

END SECTION


GIRDER TYPE "GA"
1" = 1'-0"

CENTER SECTION

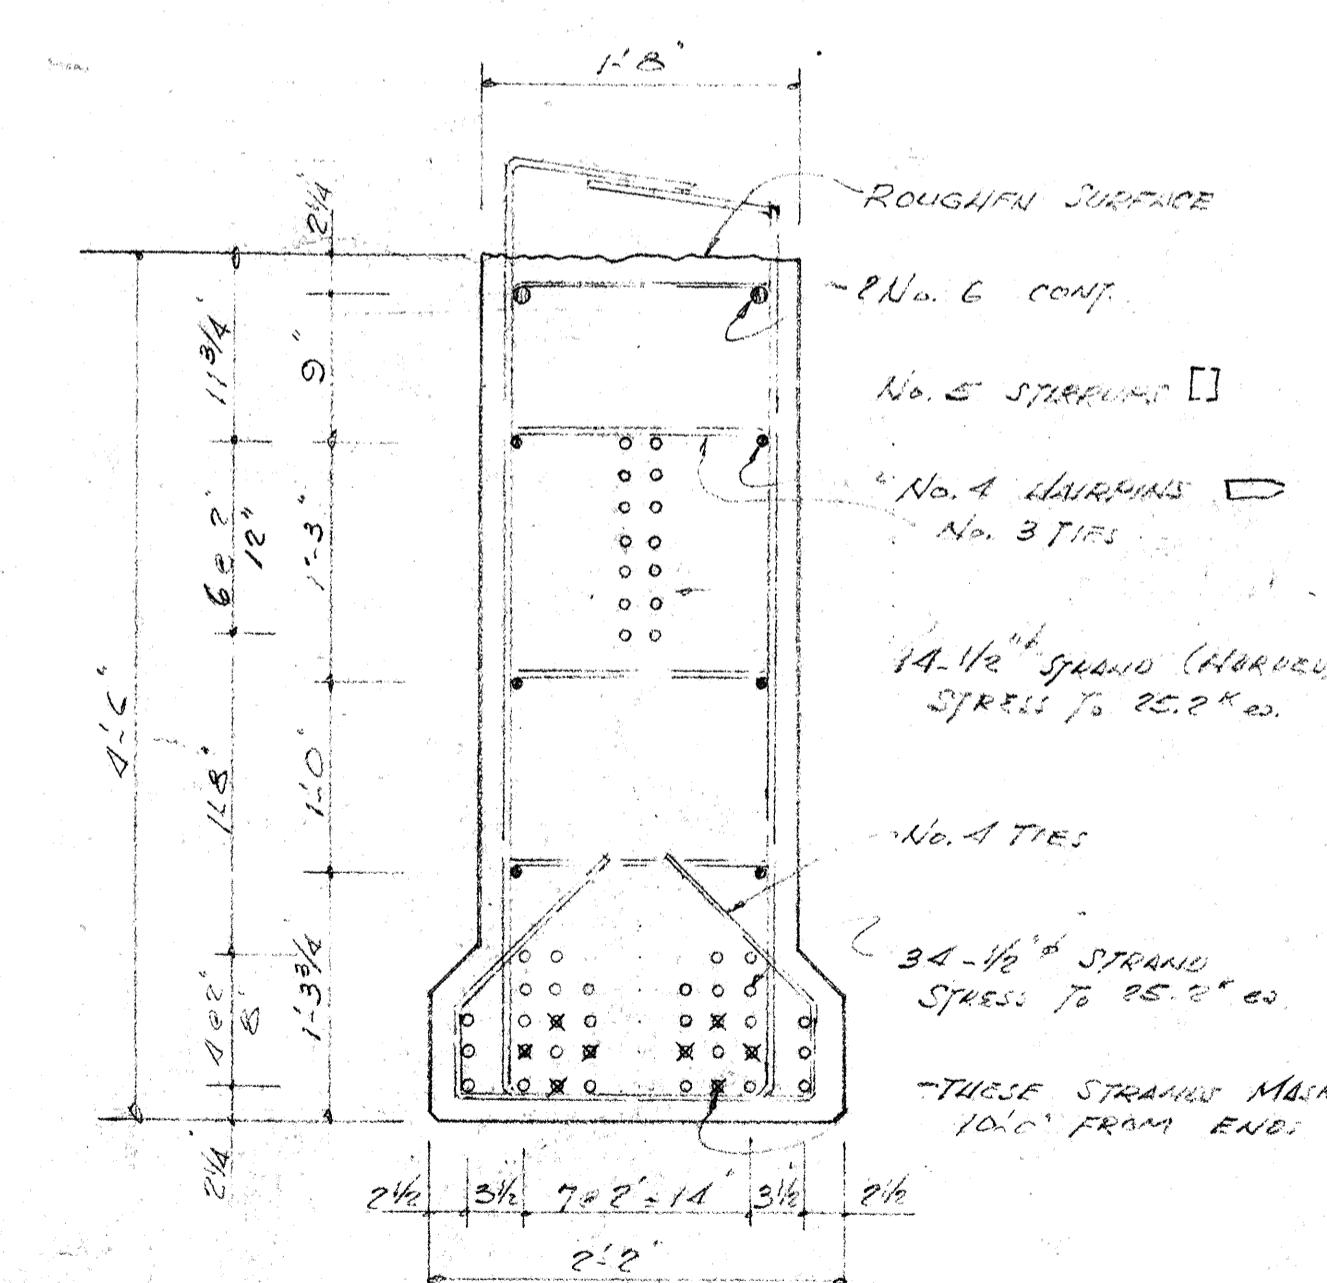


END SECTION

GIRDER TYPE "GB"
1" = 1'-0"

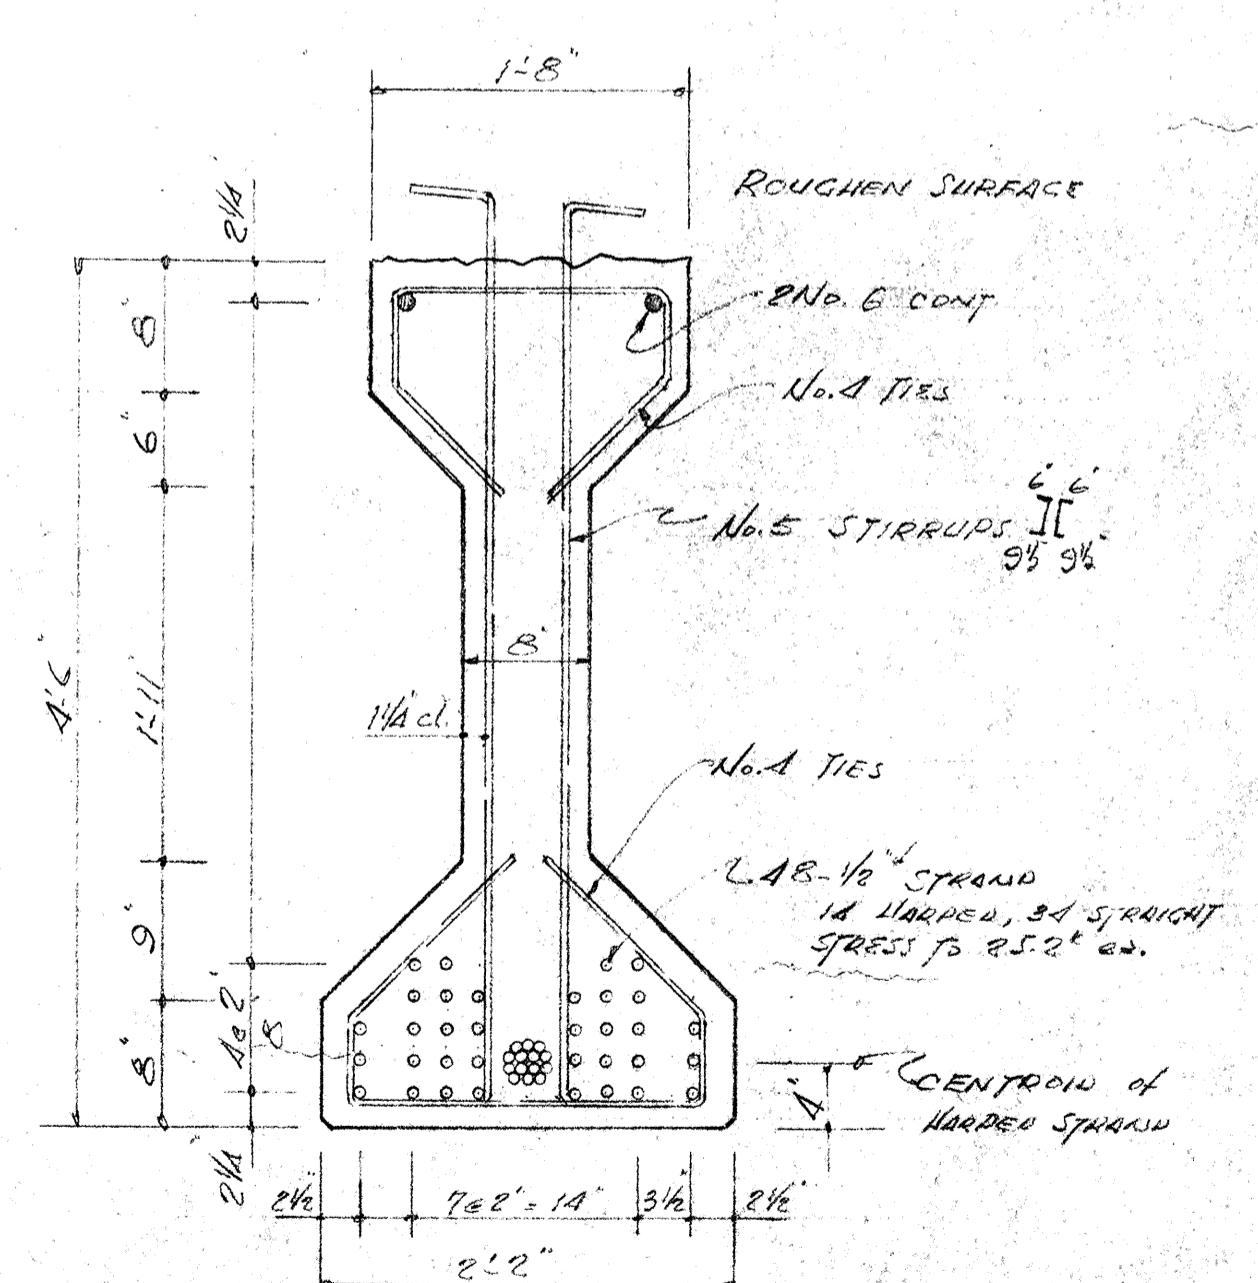


CENTER SECTION

A Revised 10-9-61 SAW
CONCRETE ENGINEERING CO.
GIRDER STRAND PROFILE & DETAILS
KALIWAHI BRIDGE
JAH Scale 1:25 SAW 9-16-61 215

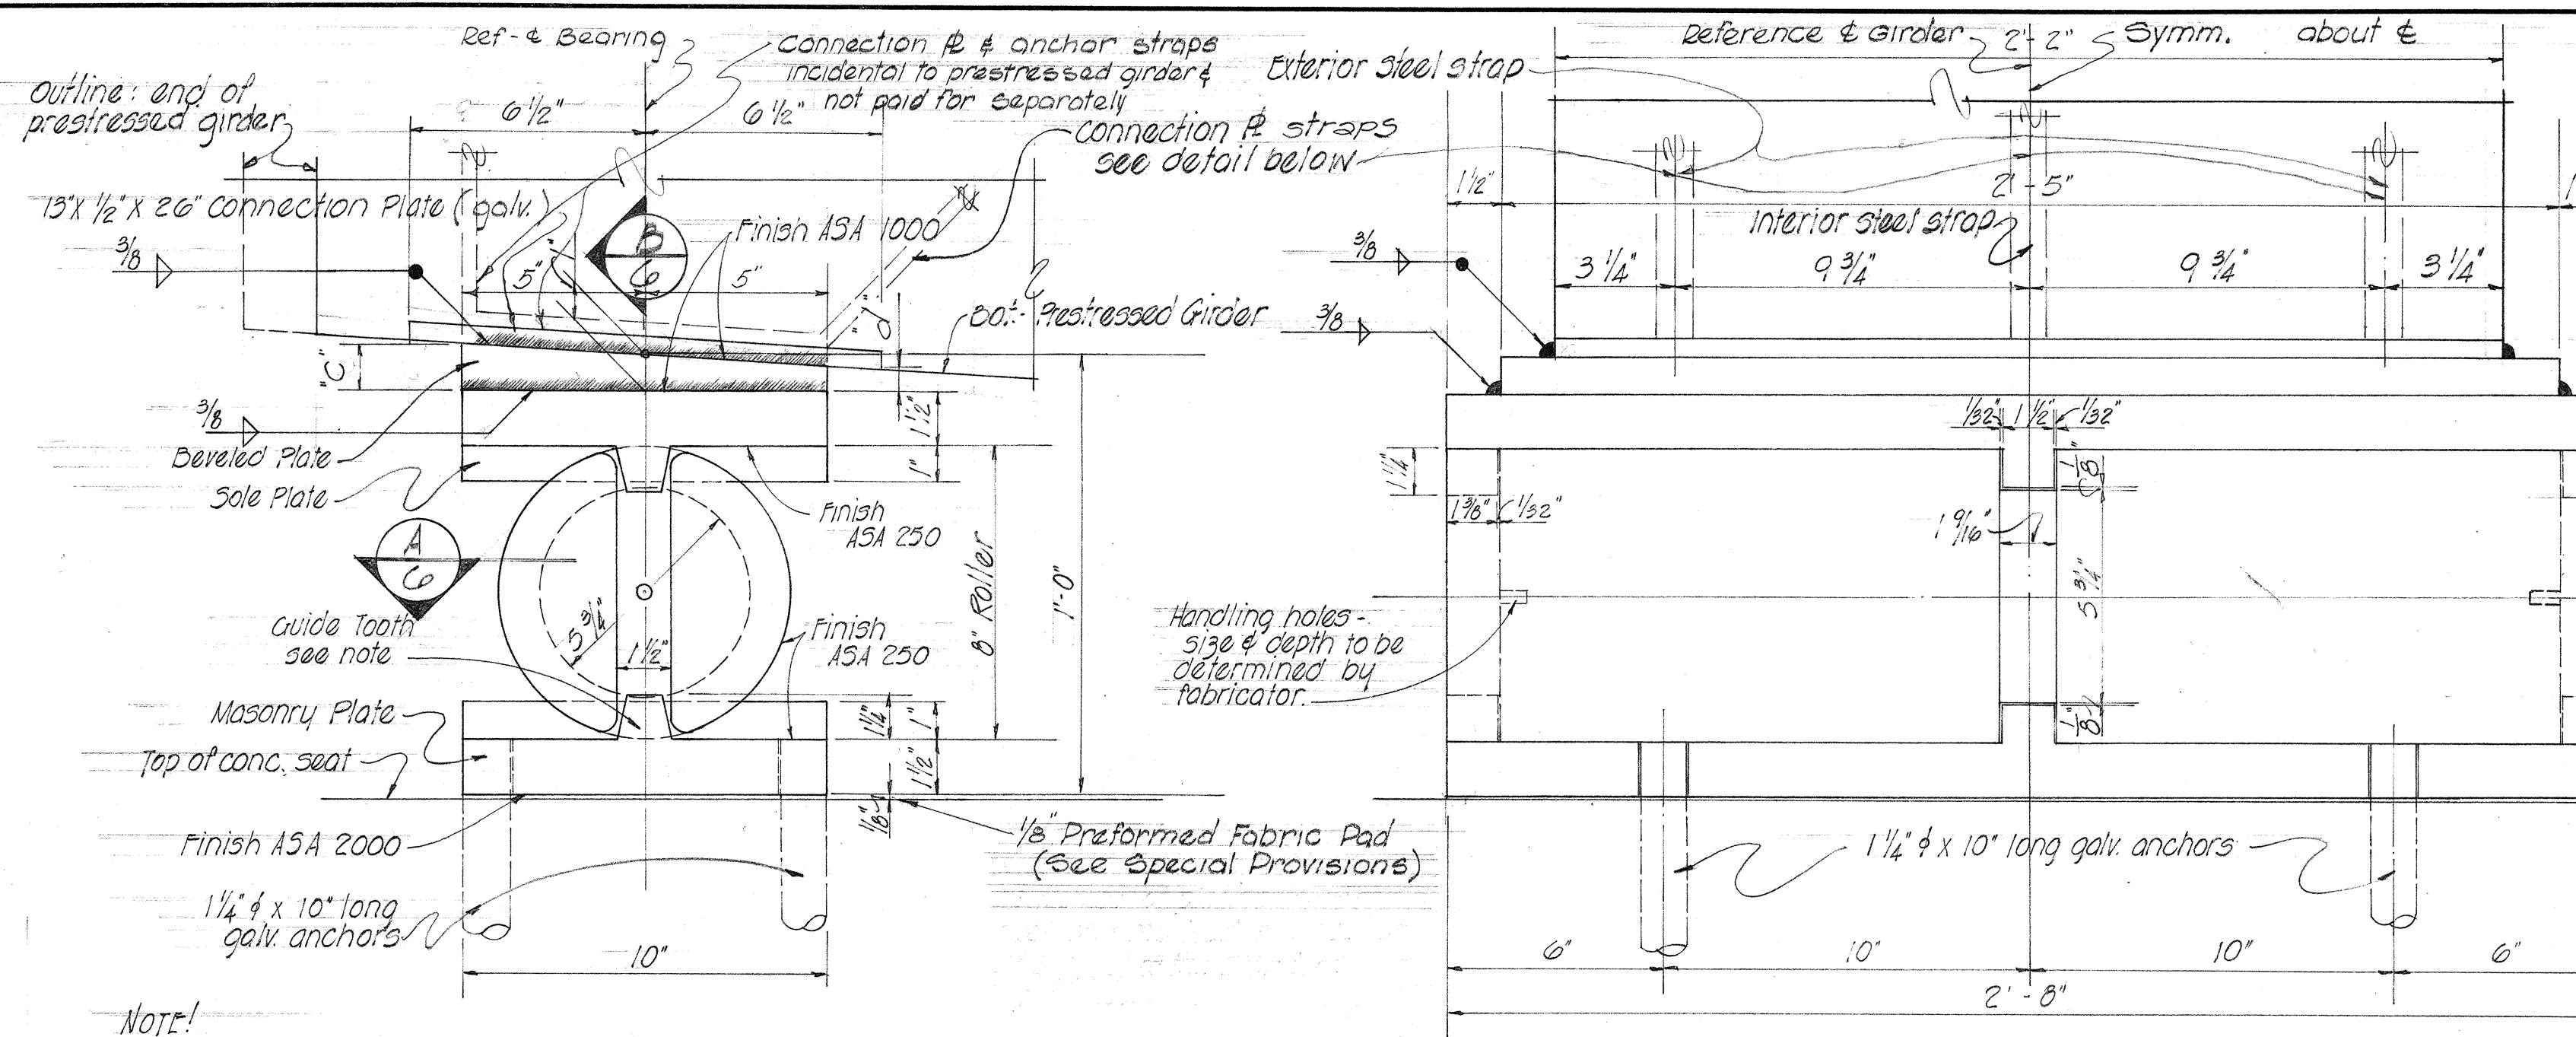


SIDE ELEVATION
SCALE: 3'-0"

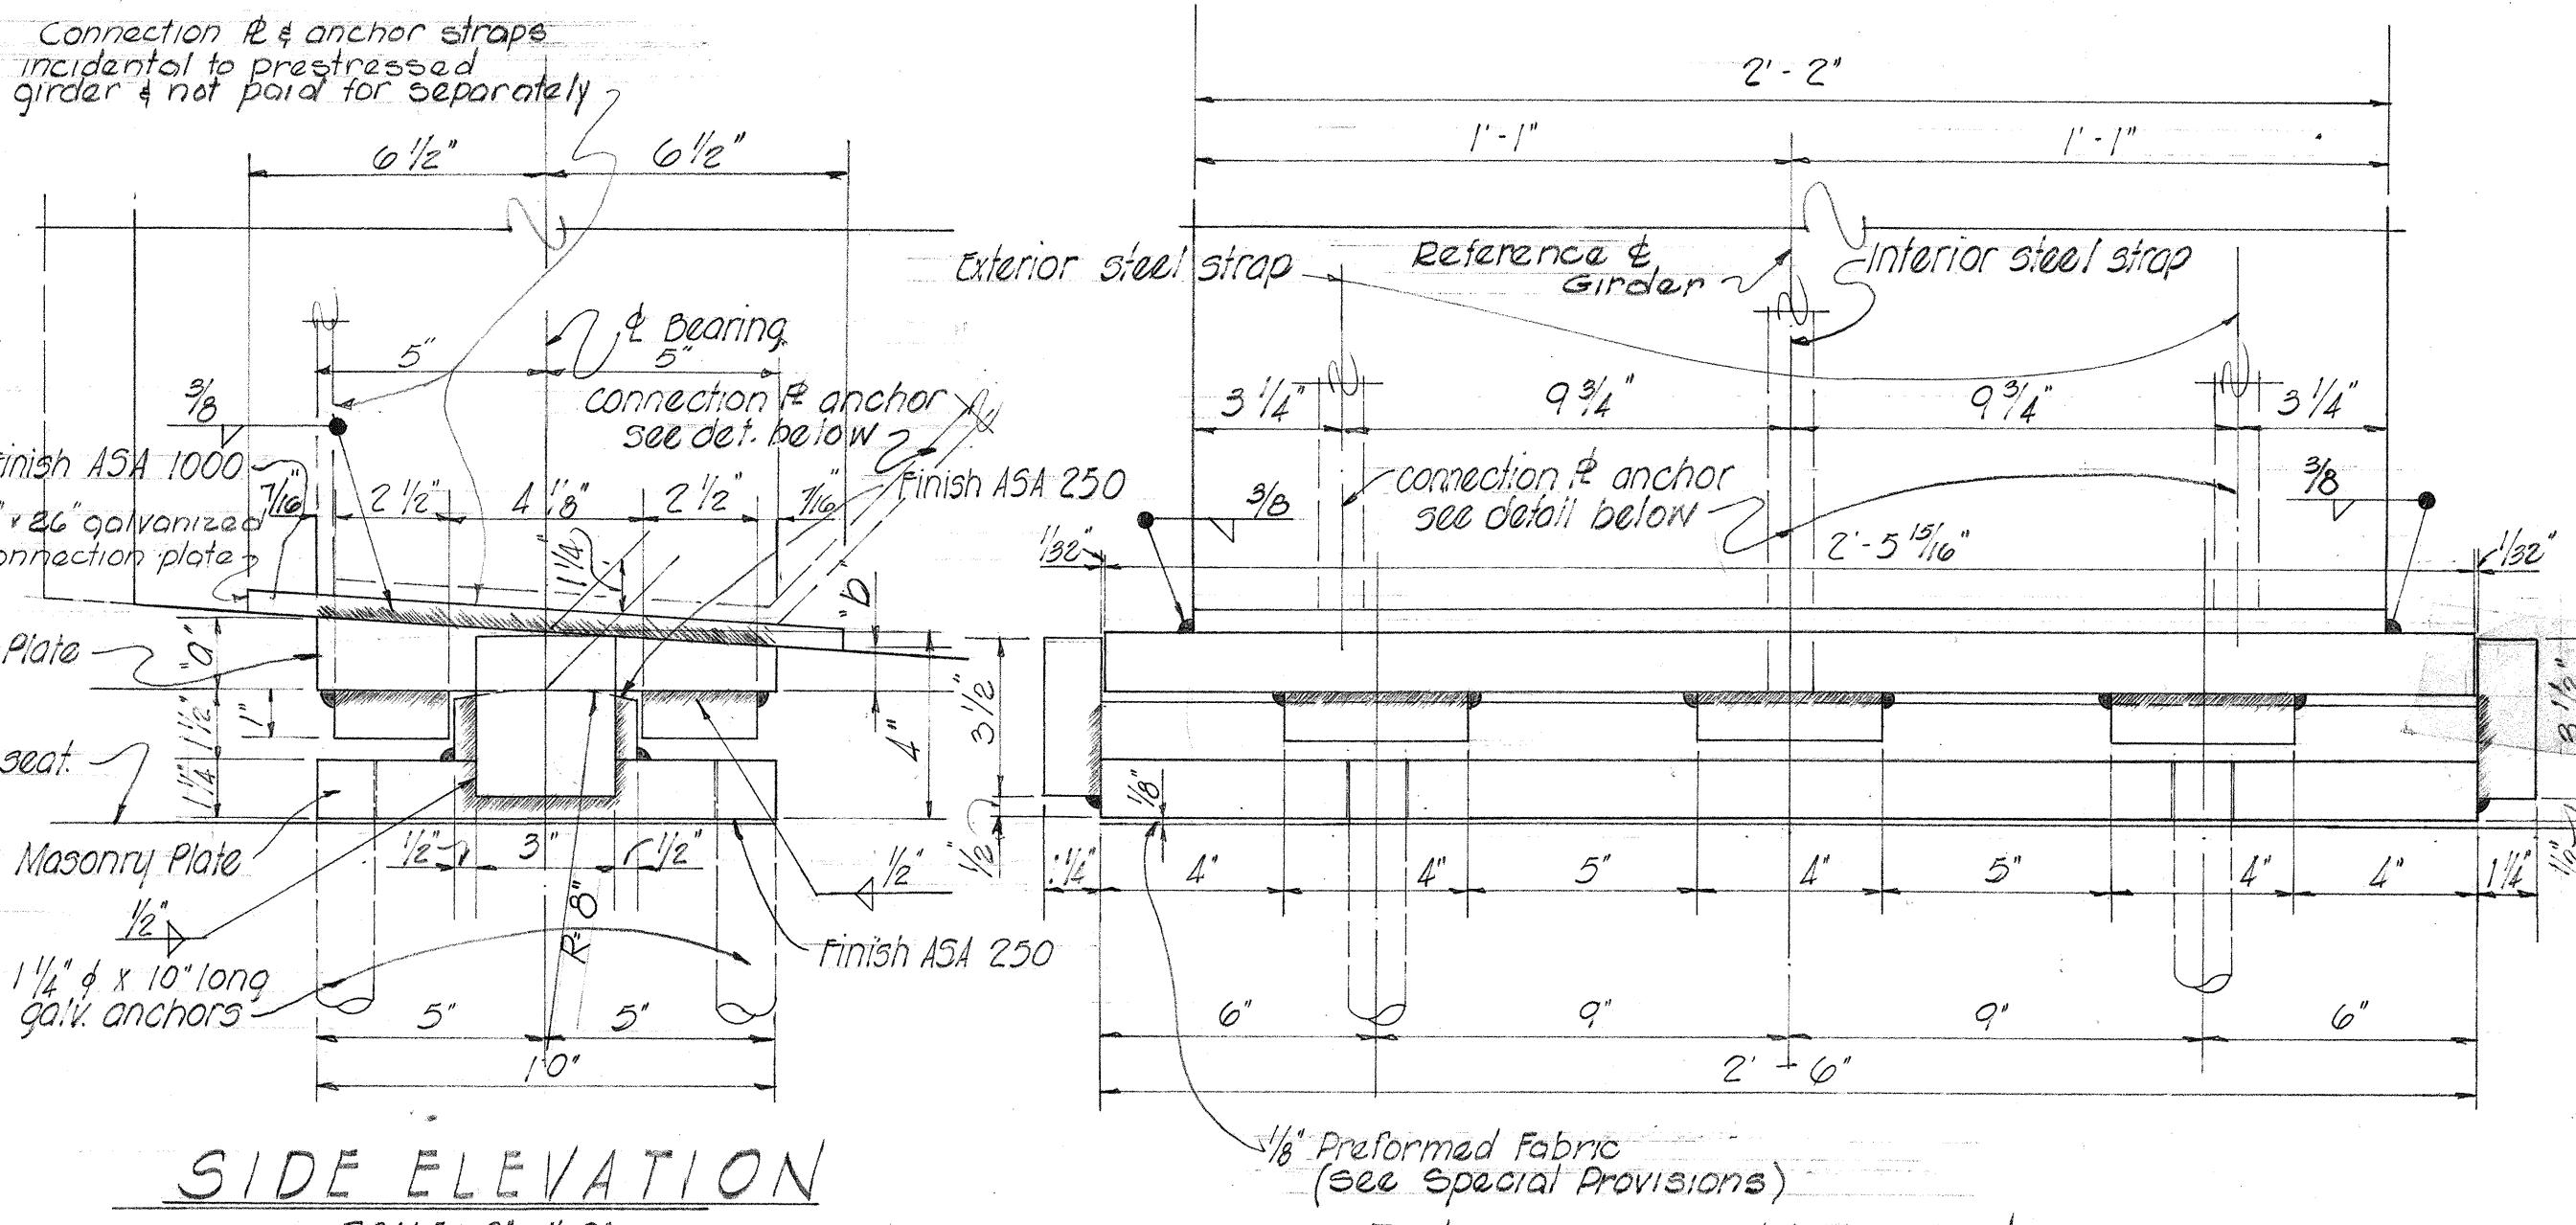


SIDE ELEVATION
SCALE: 3'-0"

END ELEVATION
SCALE: 3'-0"


END ELEVATION
SCALE: 3'-0"

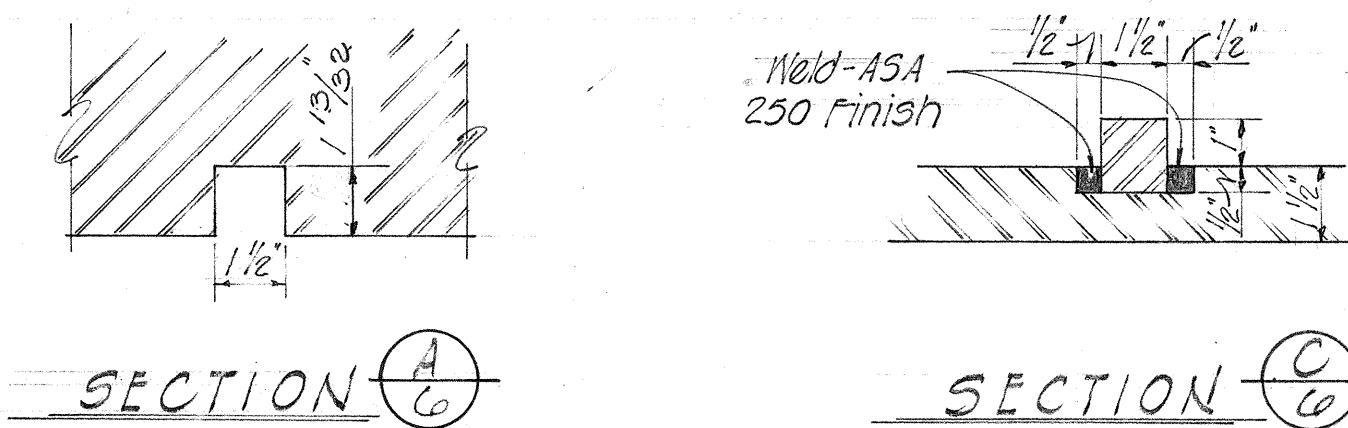

SECTION A-A

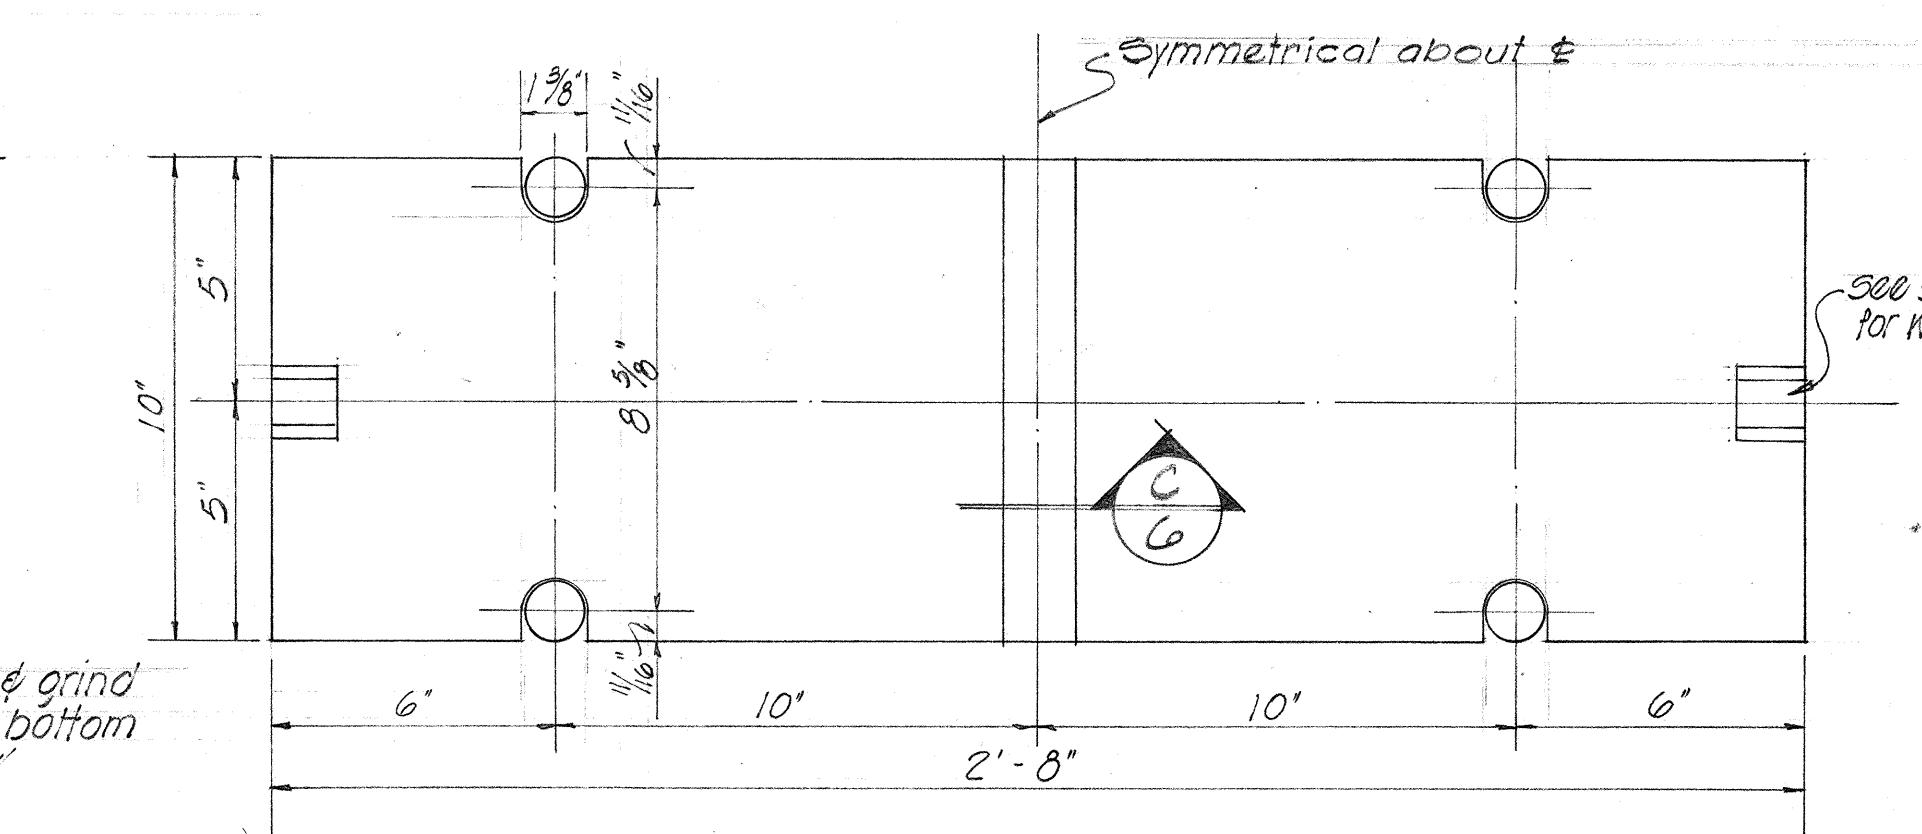

SECTION C-C

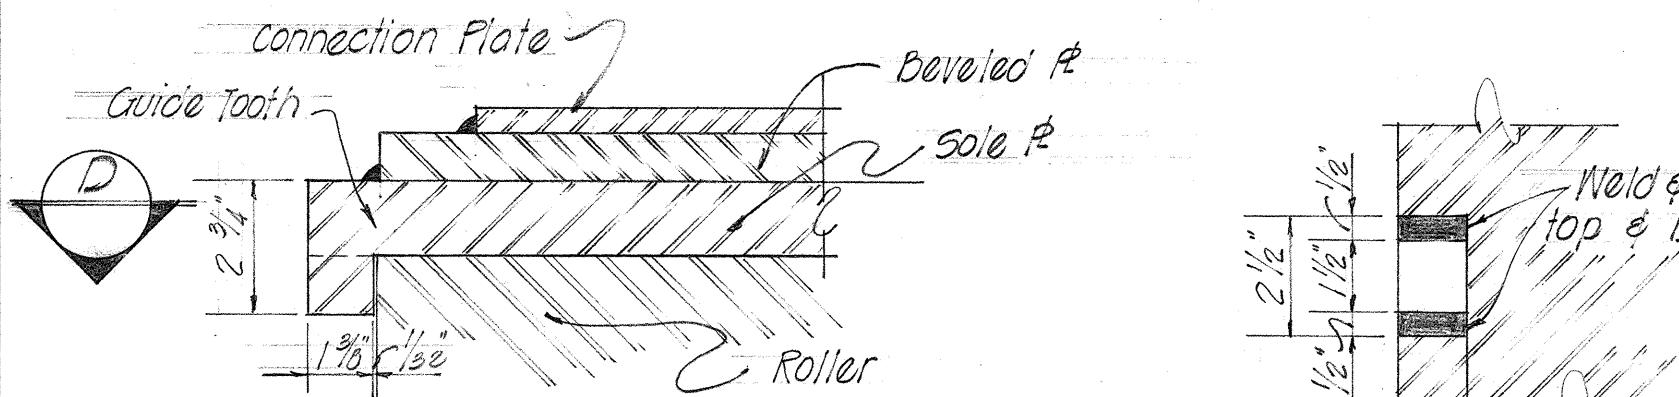

SECTION D-D



DETAILS OF EXPANSION BEARINGS
SCALE: 3'-0"

BEVELED PLATE SCHEDULE

SPAN	GIRDER "G-1"	GIRDER "G-2"	GIRDER G-3	GIRDER G-4	GIRDER G-5	GIRDER G-6
1	a 1 1/32" c					
	b 27/32" d					
2	a 1 1/32" c 1 1/32" d					
	b 27/32" d 27/32" d					
3	a 1 1/32" c					
	b 1 1/32" d					
4	a 1 1/32" c 1 1/32" d					
	b 1 1/32" d 1 1/32" d					
5	a 1 1/32" c					
	b 1 1/32" d					
6	a 1 1/32" c 1 1/32" d					
	b 1 1/32" d 1 1/32" d					
7	a 1 1/32" c 1 1/32" d					
	b 1 1/32" d 1 1/32" d					
8	a 1 1/32" c					
	b 1" d					

Typical Detail
CONNECTION & ANCHOR TO PRESTRESSED GIRDER
Scale: 1/2" = 1'0"

ORIGINAL PLAN
DRAWN BY: J. E. COULIN
CHECKED BY:
NOTE BOOK QUANTITIES CHECKED BY
No. _____

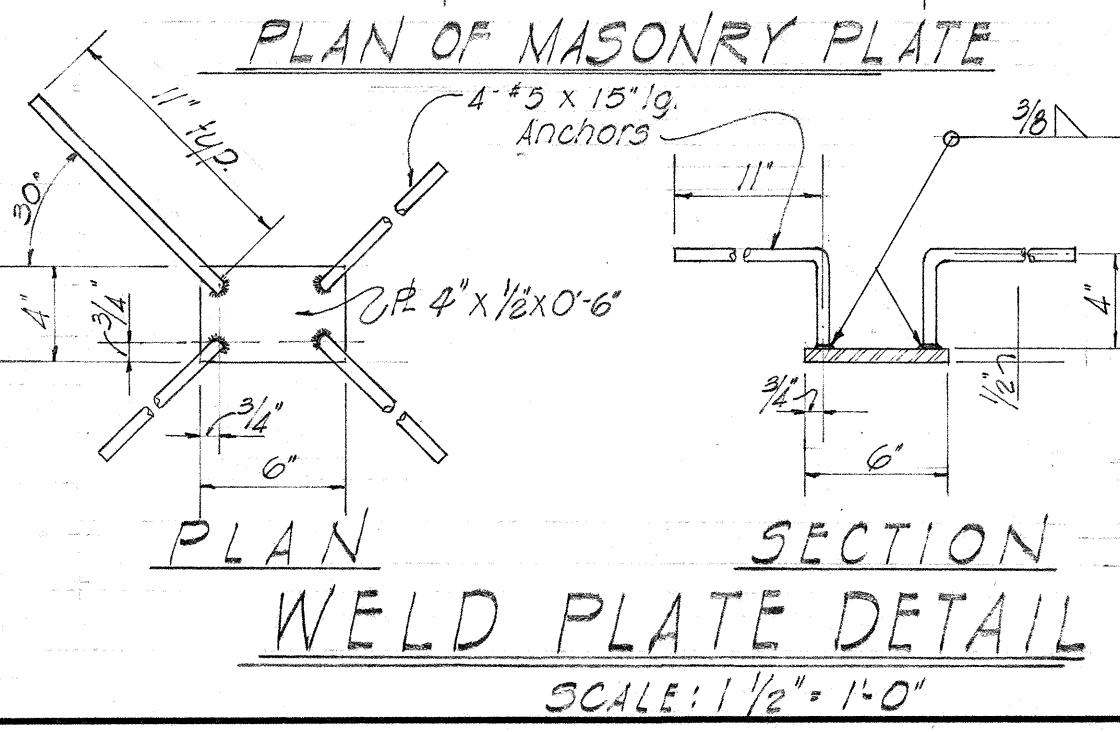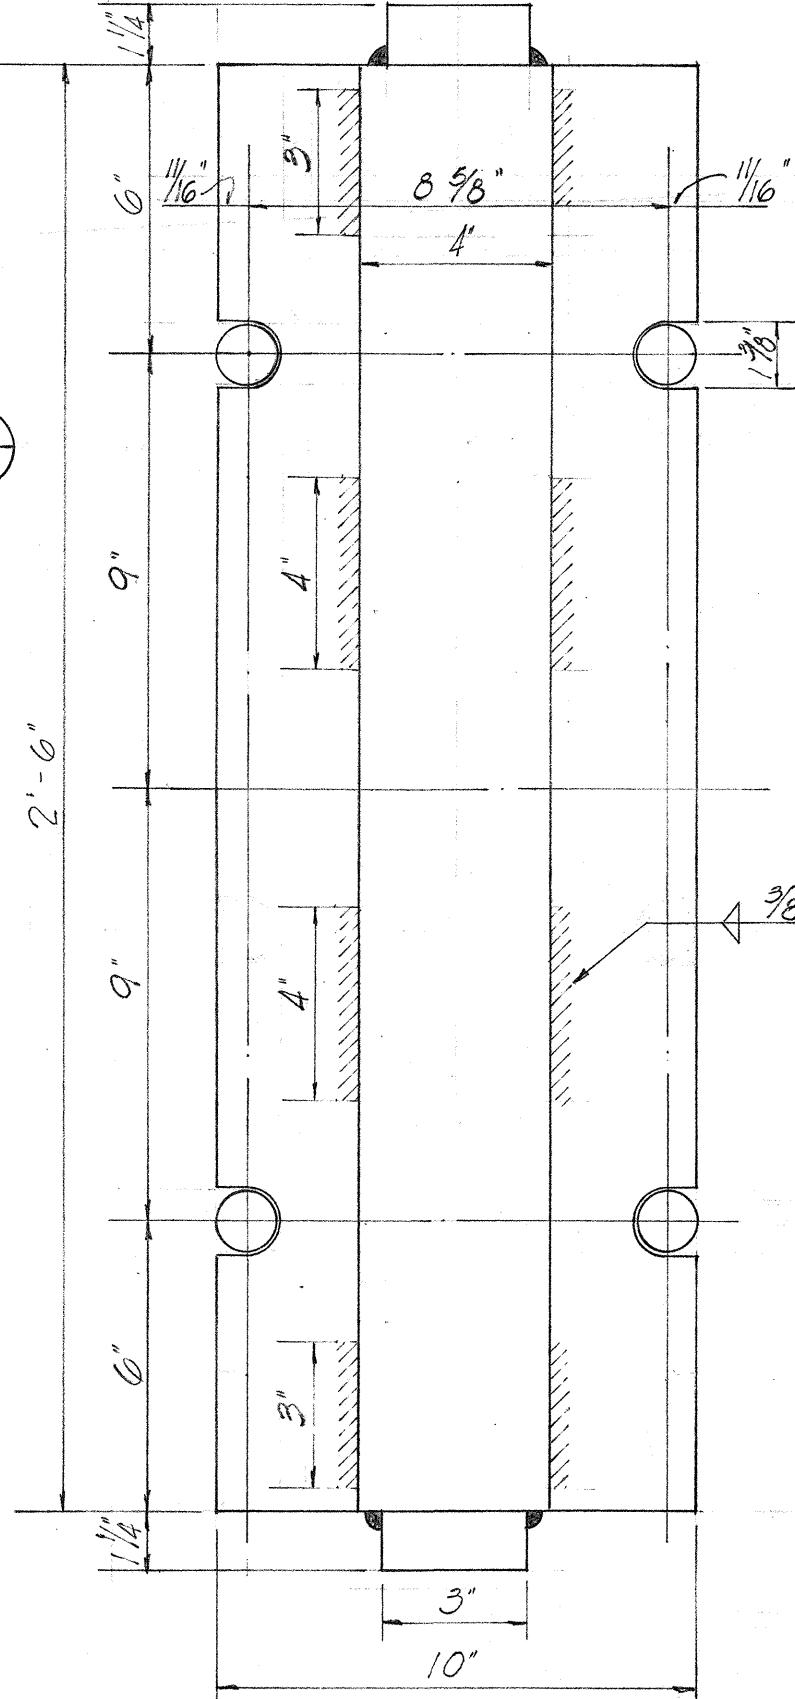

WELD PLATE DETAIL

SCALE: 1/2" = 1'0"

DETAILS OF FIXED BEARINGS

SCALE: 3'-0"

GENERAL NOTES

MATERIALS: All plates to be of structural carbon steel A.S.T.M. Designation A-7. Rollers shall be structural carbon steel A.S.T.M. Designation A-235 (Class C-1).

WORKMANSHIP: Rollers shall be forged & annealed prior to machining. They shall be accurately turned to the dimensions shown and shall be straight, smooth, & free from flaws. The contractor shall order forgings that are straight & of sufficient size so they can be turned to the dimensions given without showing any forge marks. Any roller showing forge marks shall be rejected.

WELDS: All welds to be $\frac{1}{8}$ " fillets unless noted otherwise.

GALVANIZING: For galvanizing of bearing assemblage - see Special Provisions. For repairing of damaged galvanized coatings for bearings, see Article 44.3 of Special Provision.

PAINTING: The galvanized bearing assembly shall be painted with two field coats of red lead and one finish coat of aluminum. Painting shall be in accordance with the Standard Specifications.












ALTERNATE "B"

DEPARTMENT OF TRANSPORTATION
DIVISION OF HIGHWAYS
STATE OF HAWAII

STRUCTURE N° 5
KALIHIWAI BRIDGE
STA. 26+57.88 TO STA. 34+56.12
KAUAI BELT ROAD PROJ. ER-7(1) UNIT 2
FEBRUARY 1961

SHEET NO. 6 OF 12 SHEETS

FED. ROAD DIST. NO.	STATE	FED. AID PROJ. NO.	FISCAL YEAR	SHEET NO.	TOTAL SHEETS
HAWAII	HAW.	ER-700 Unit 2	1961	40	77

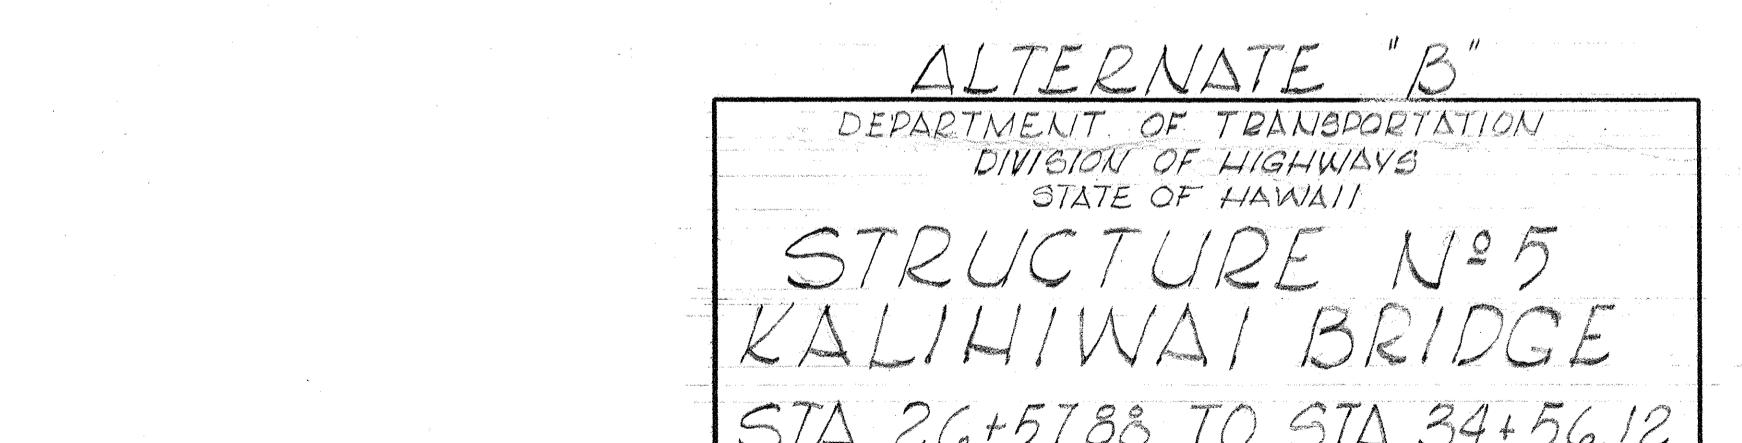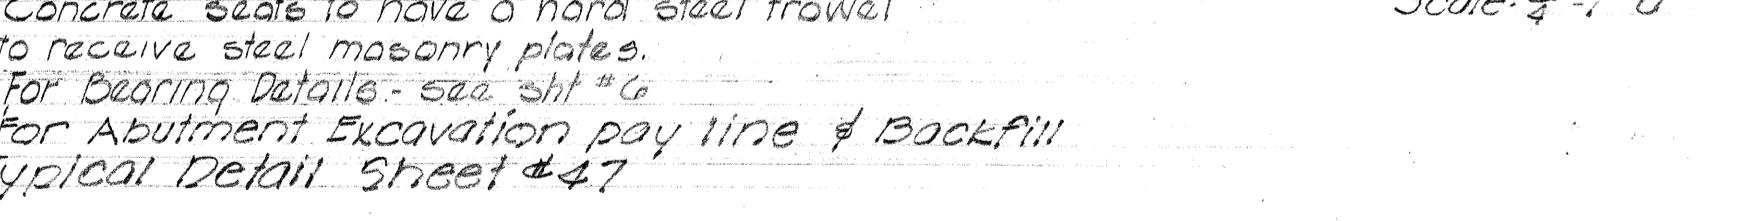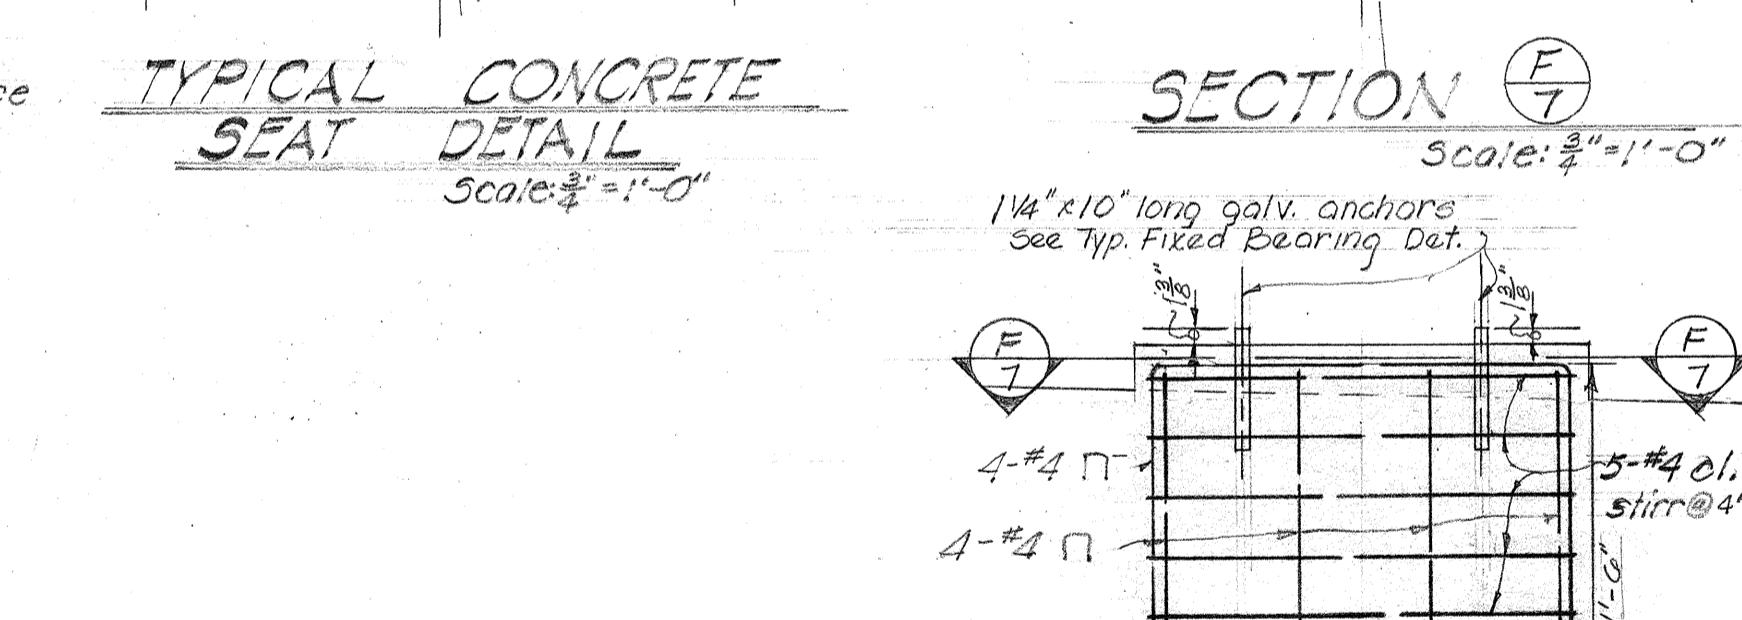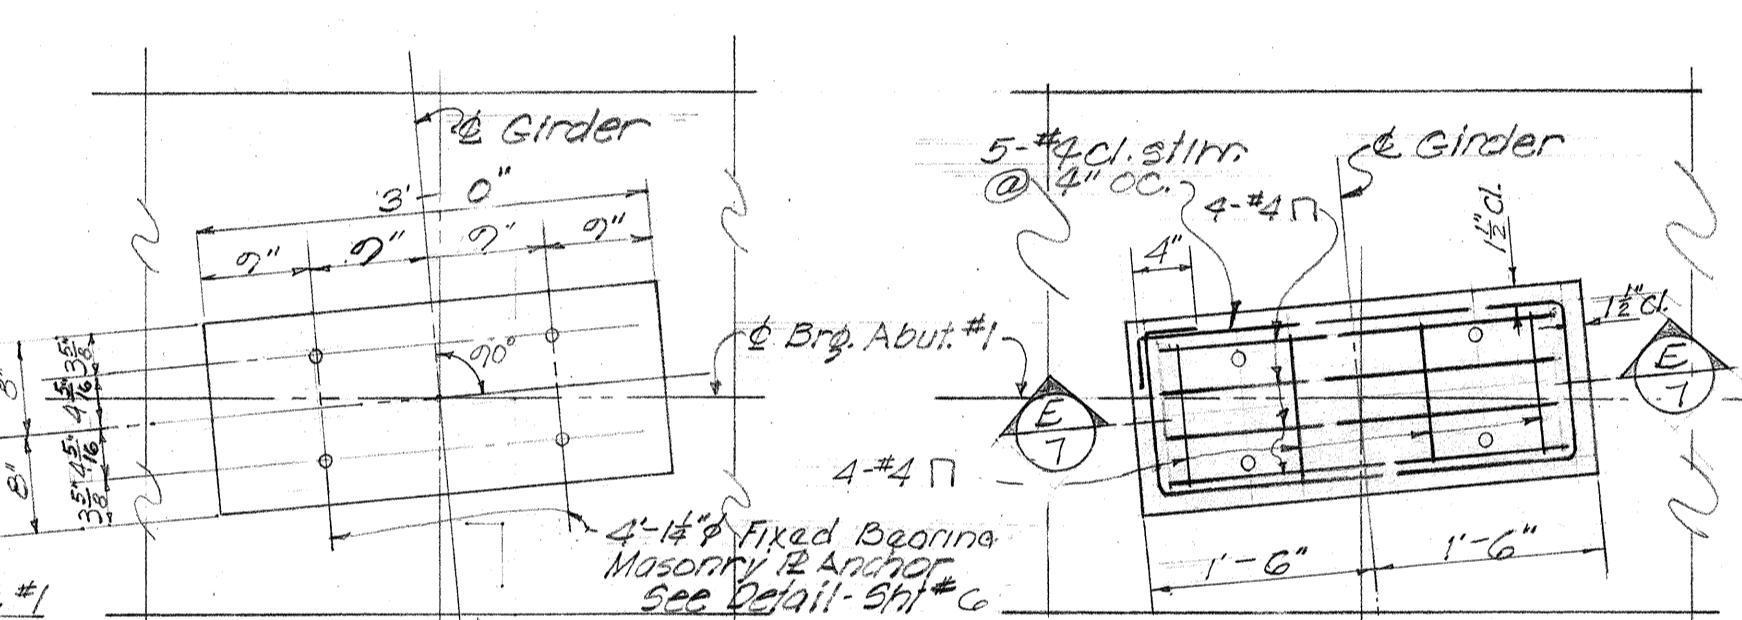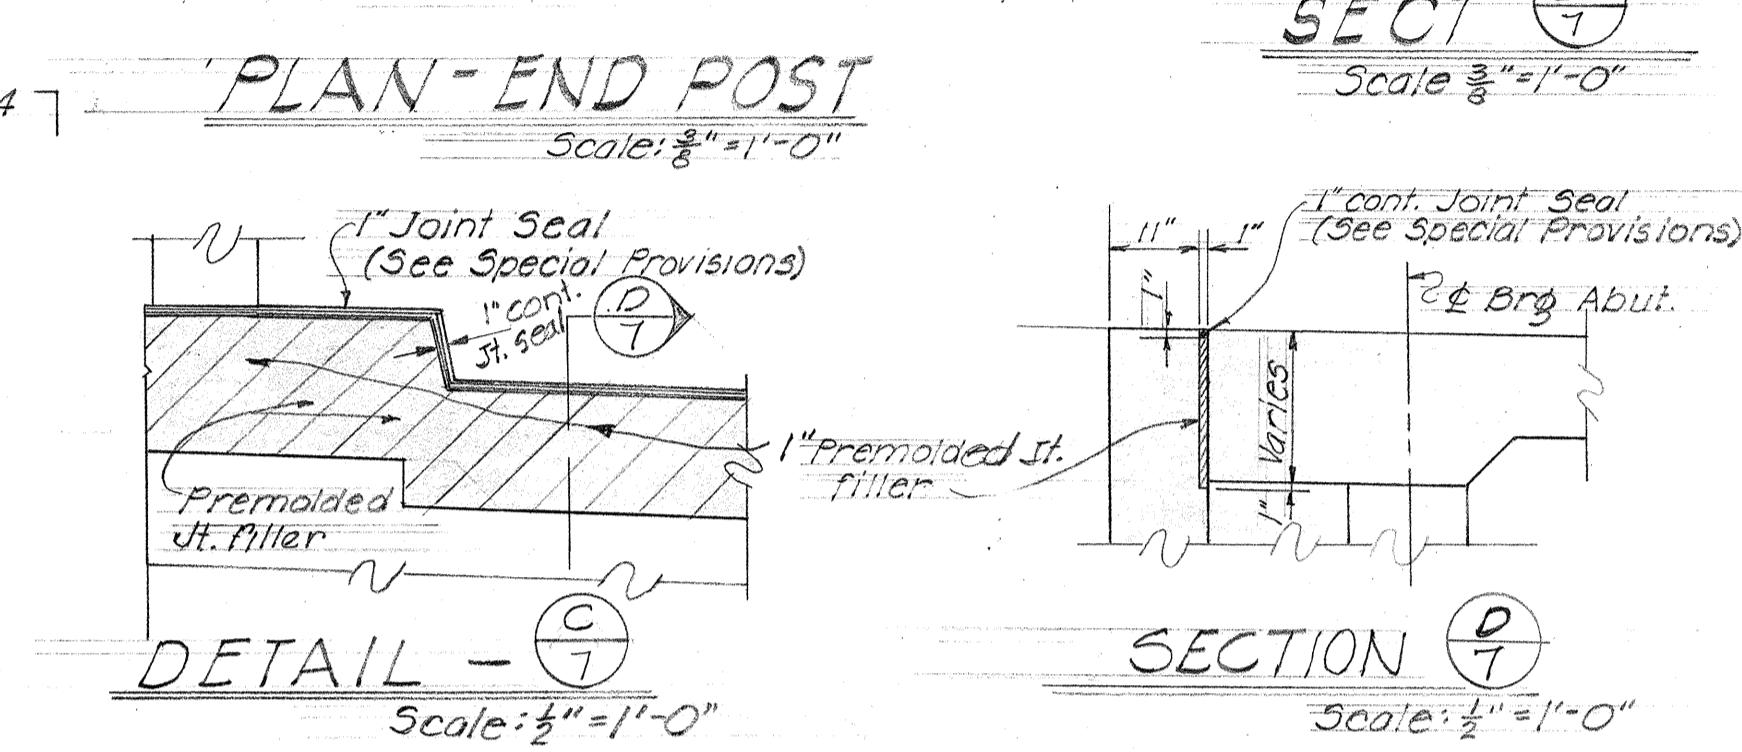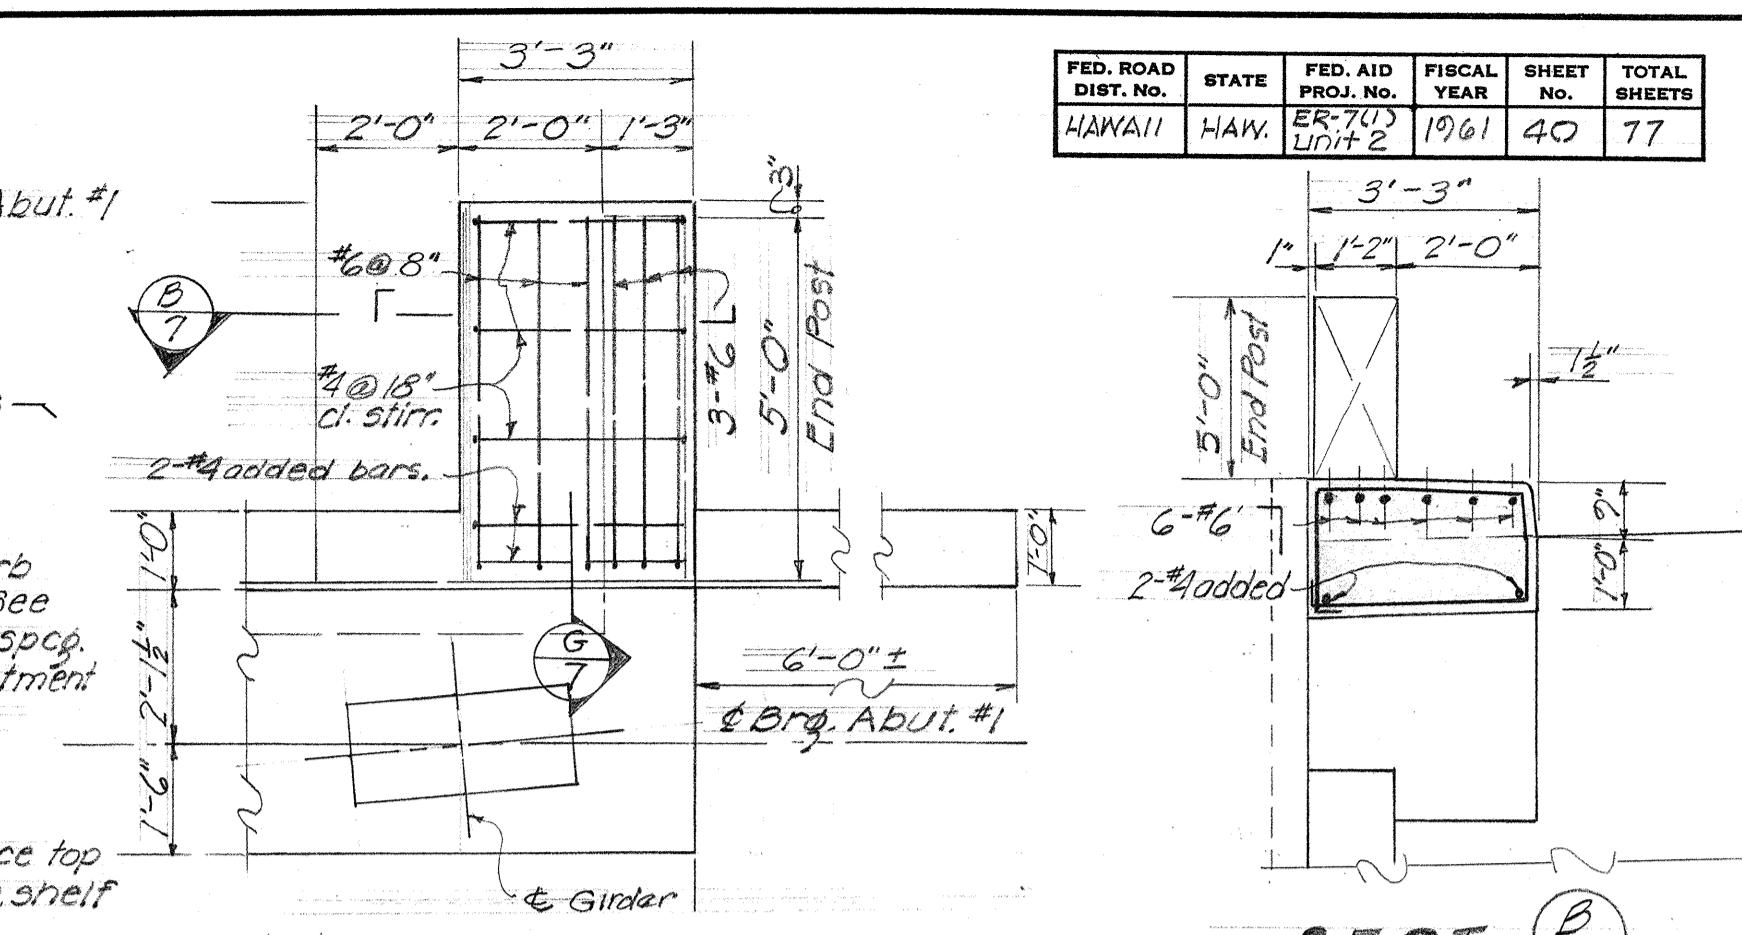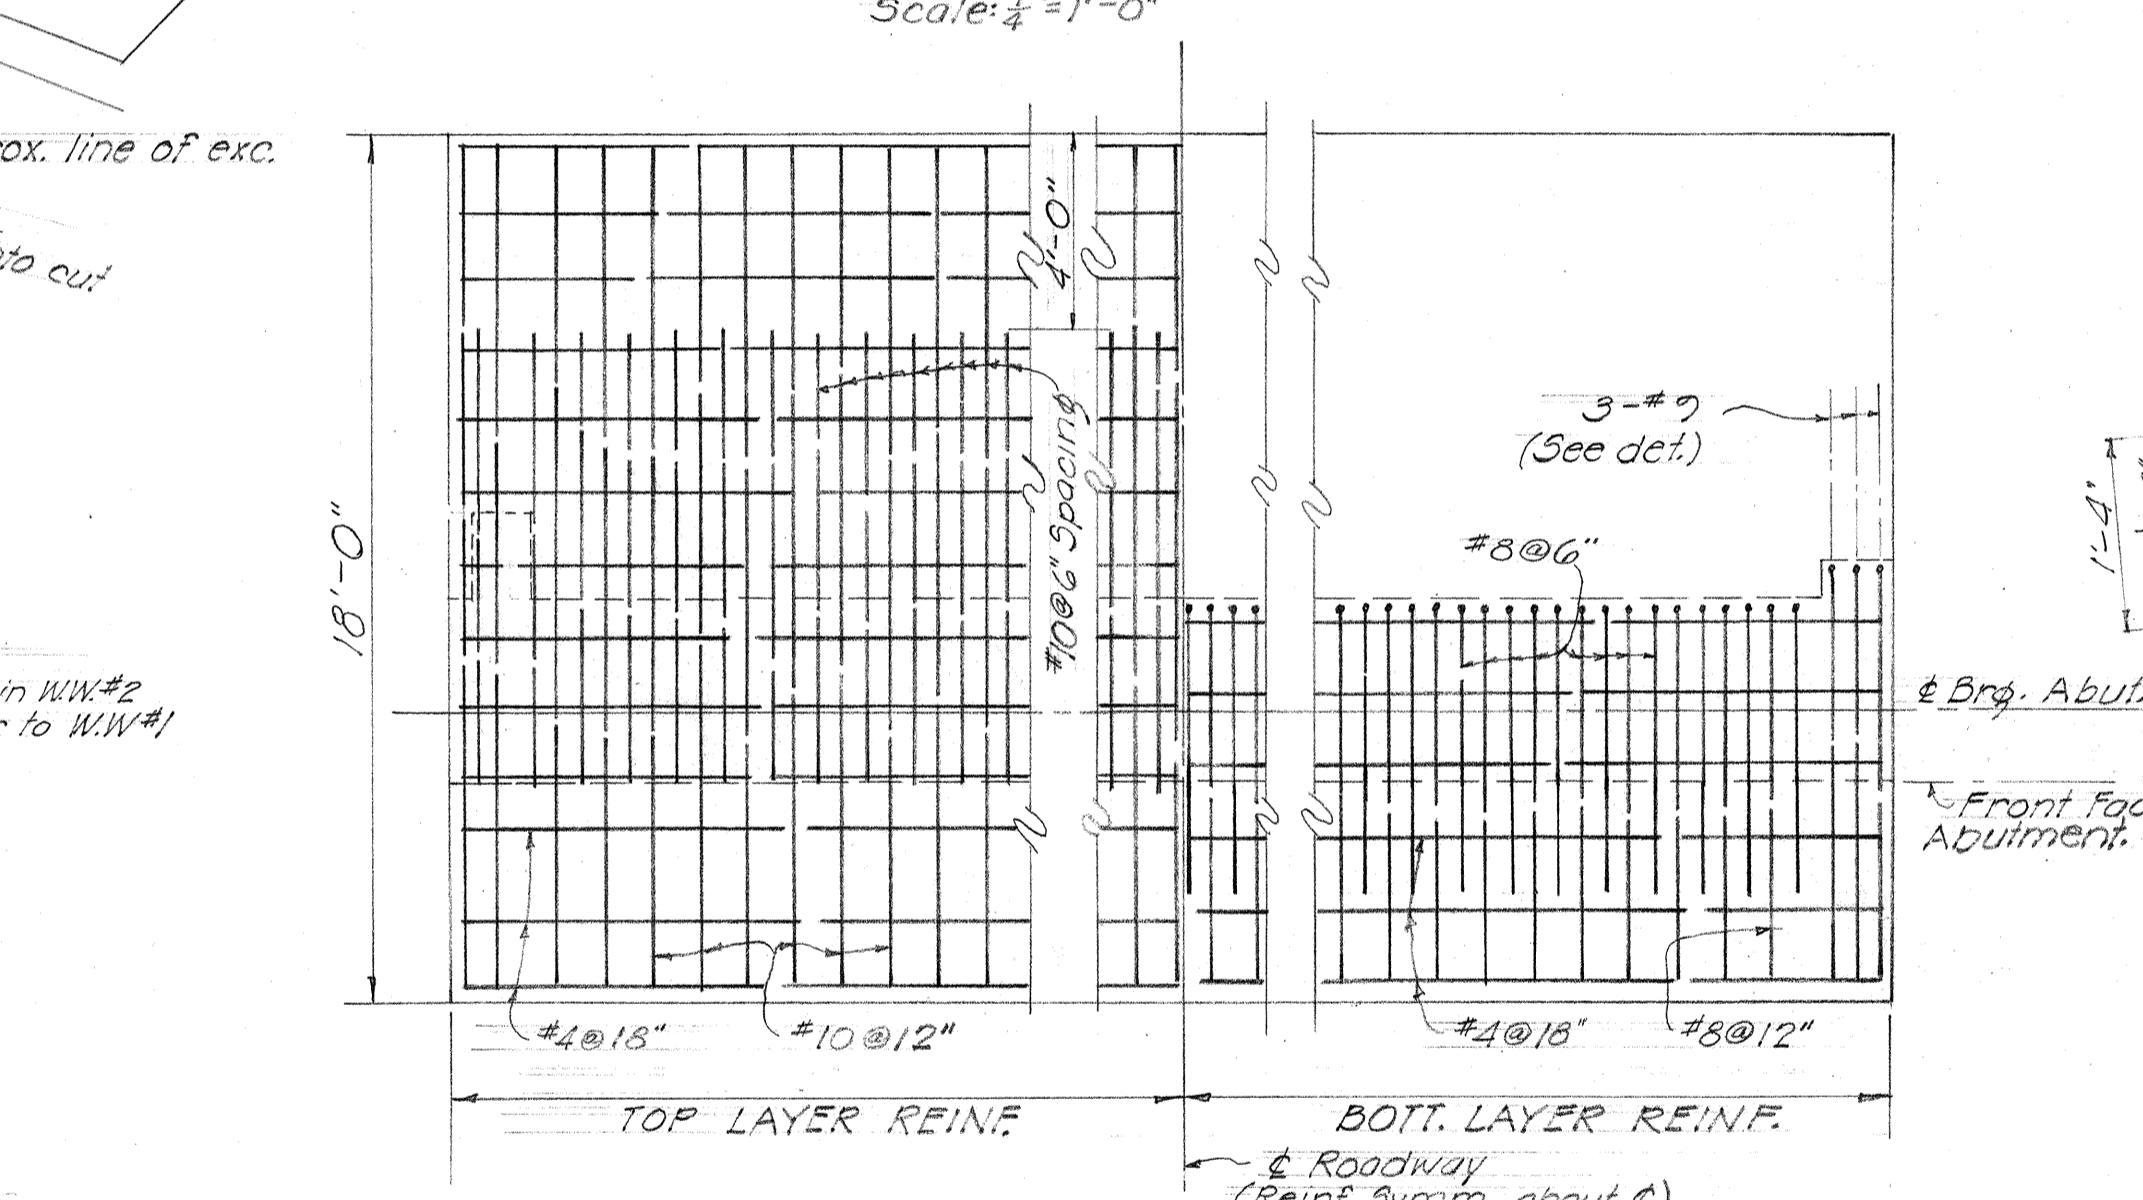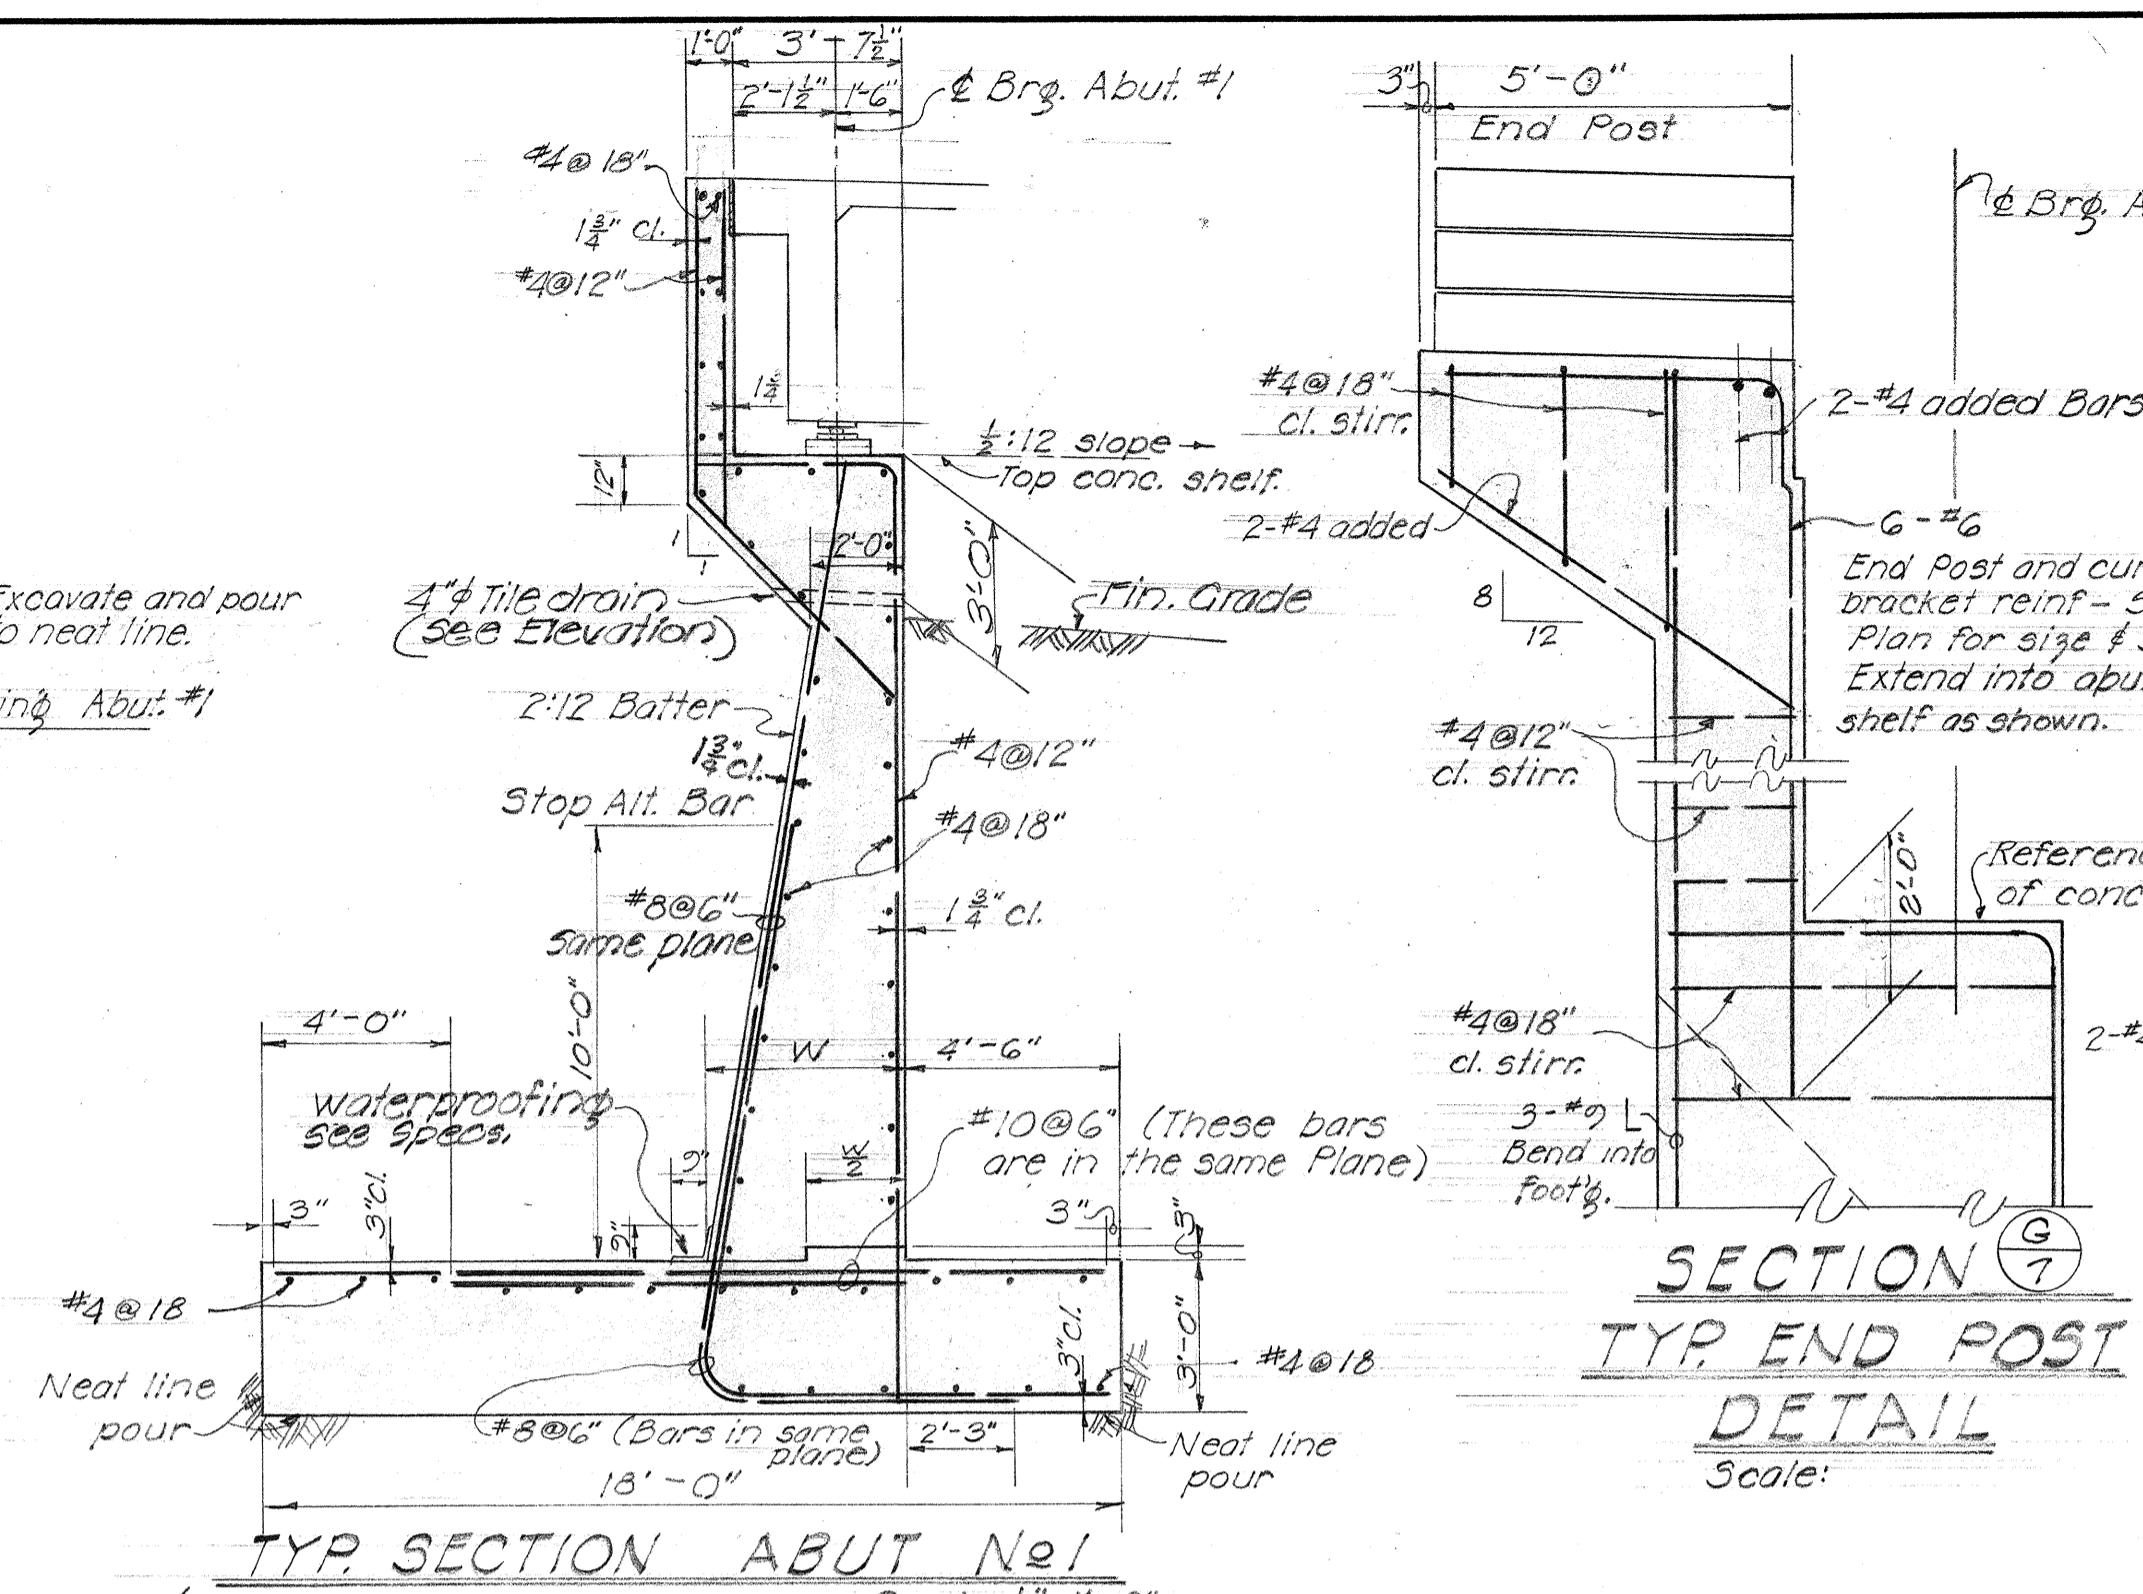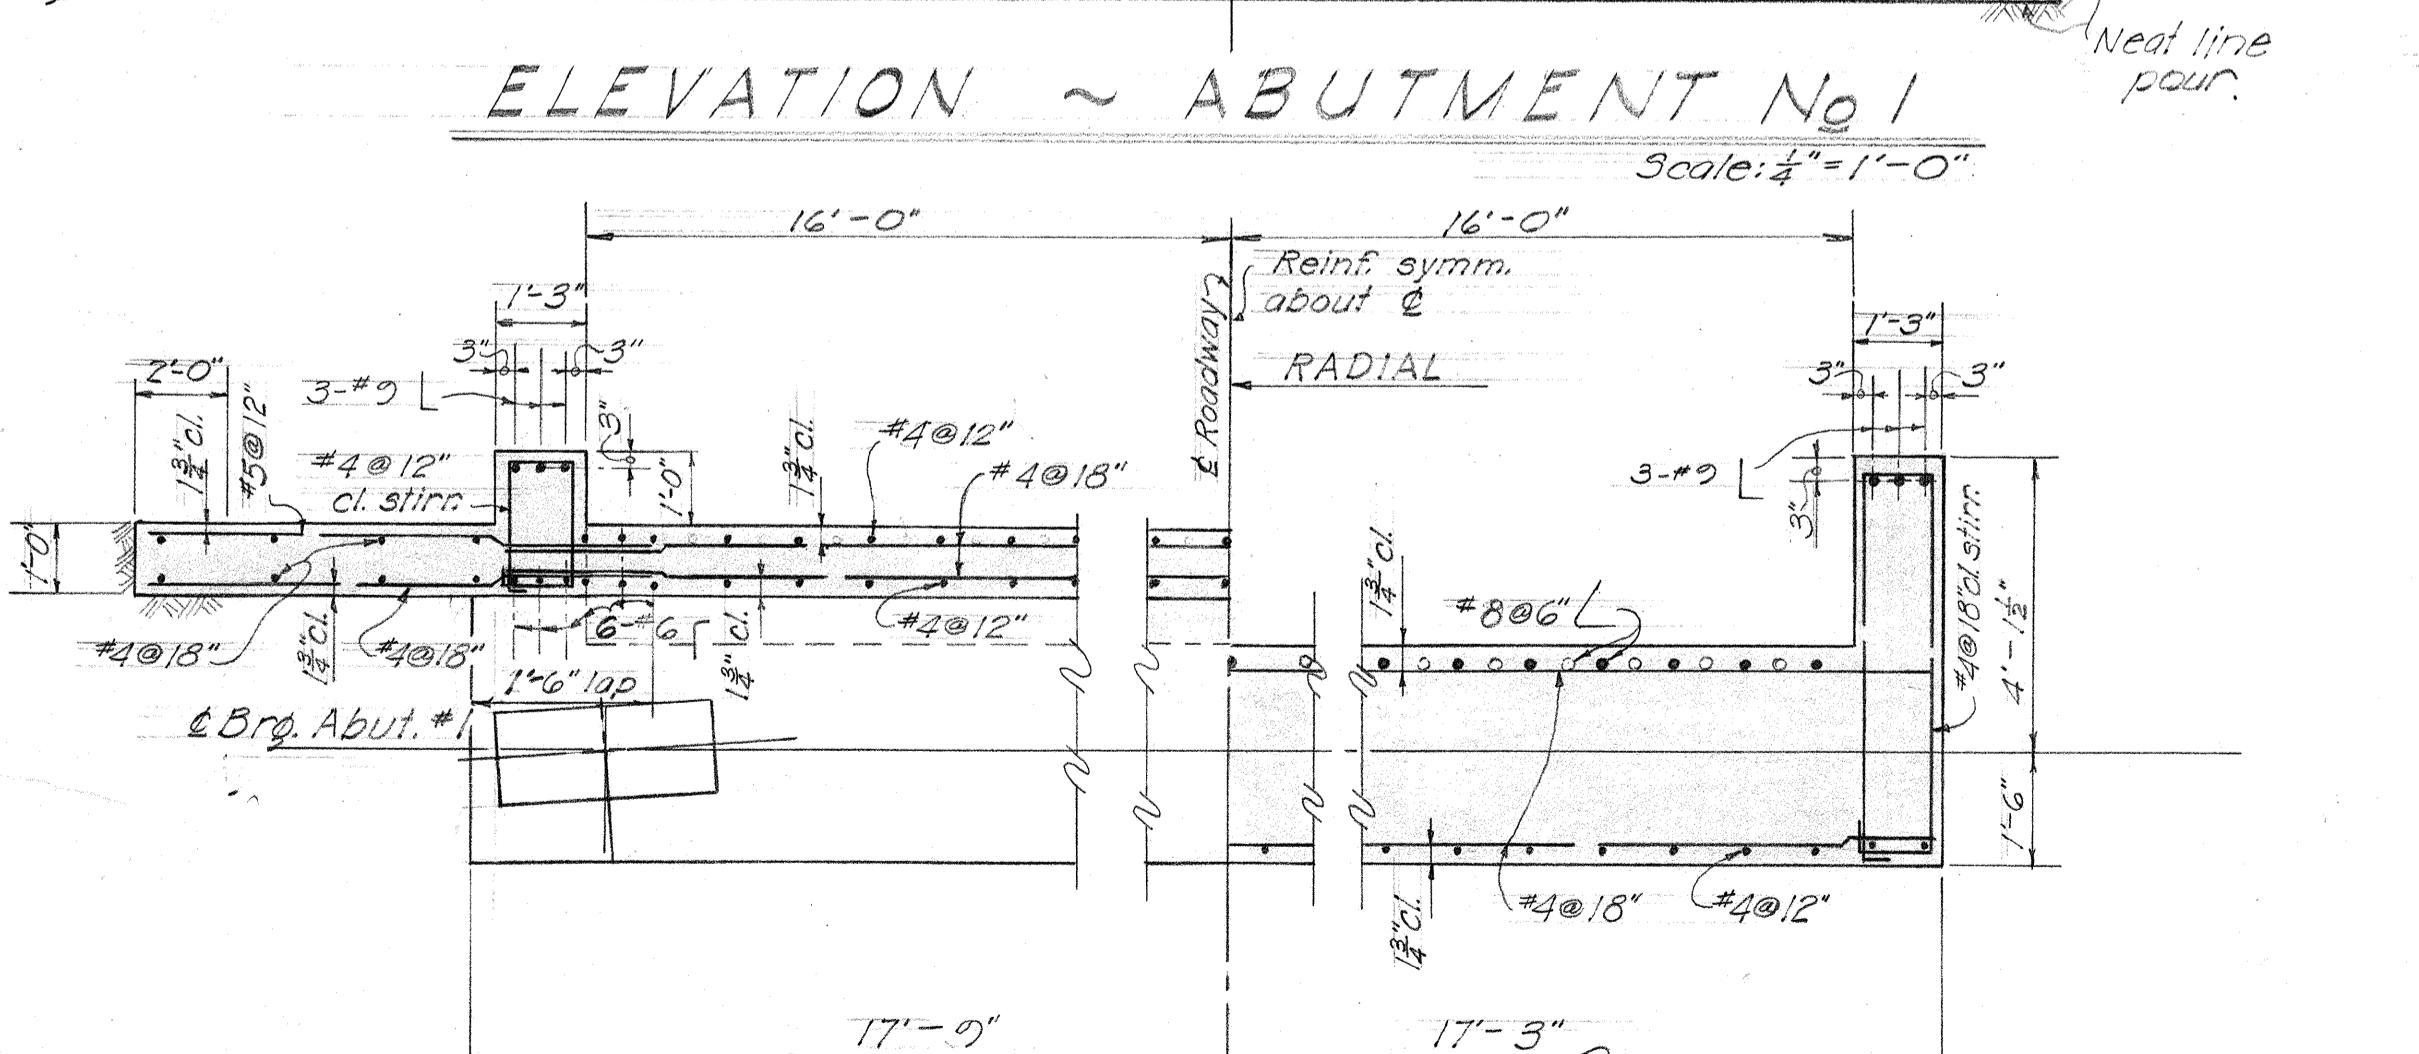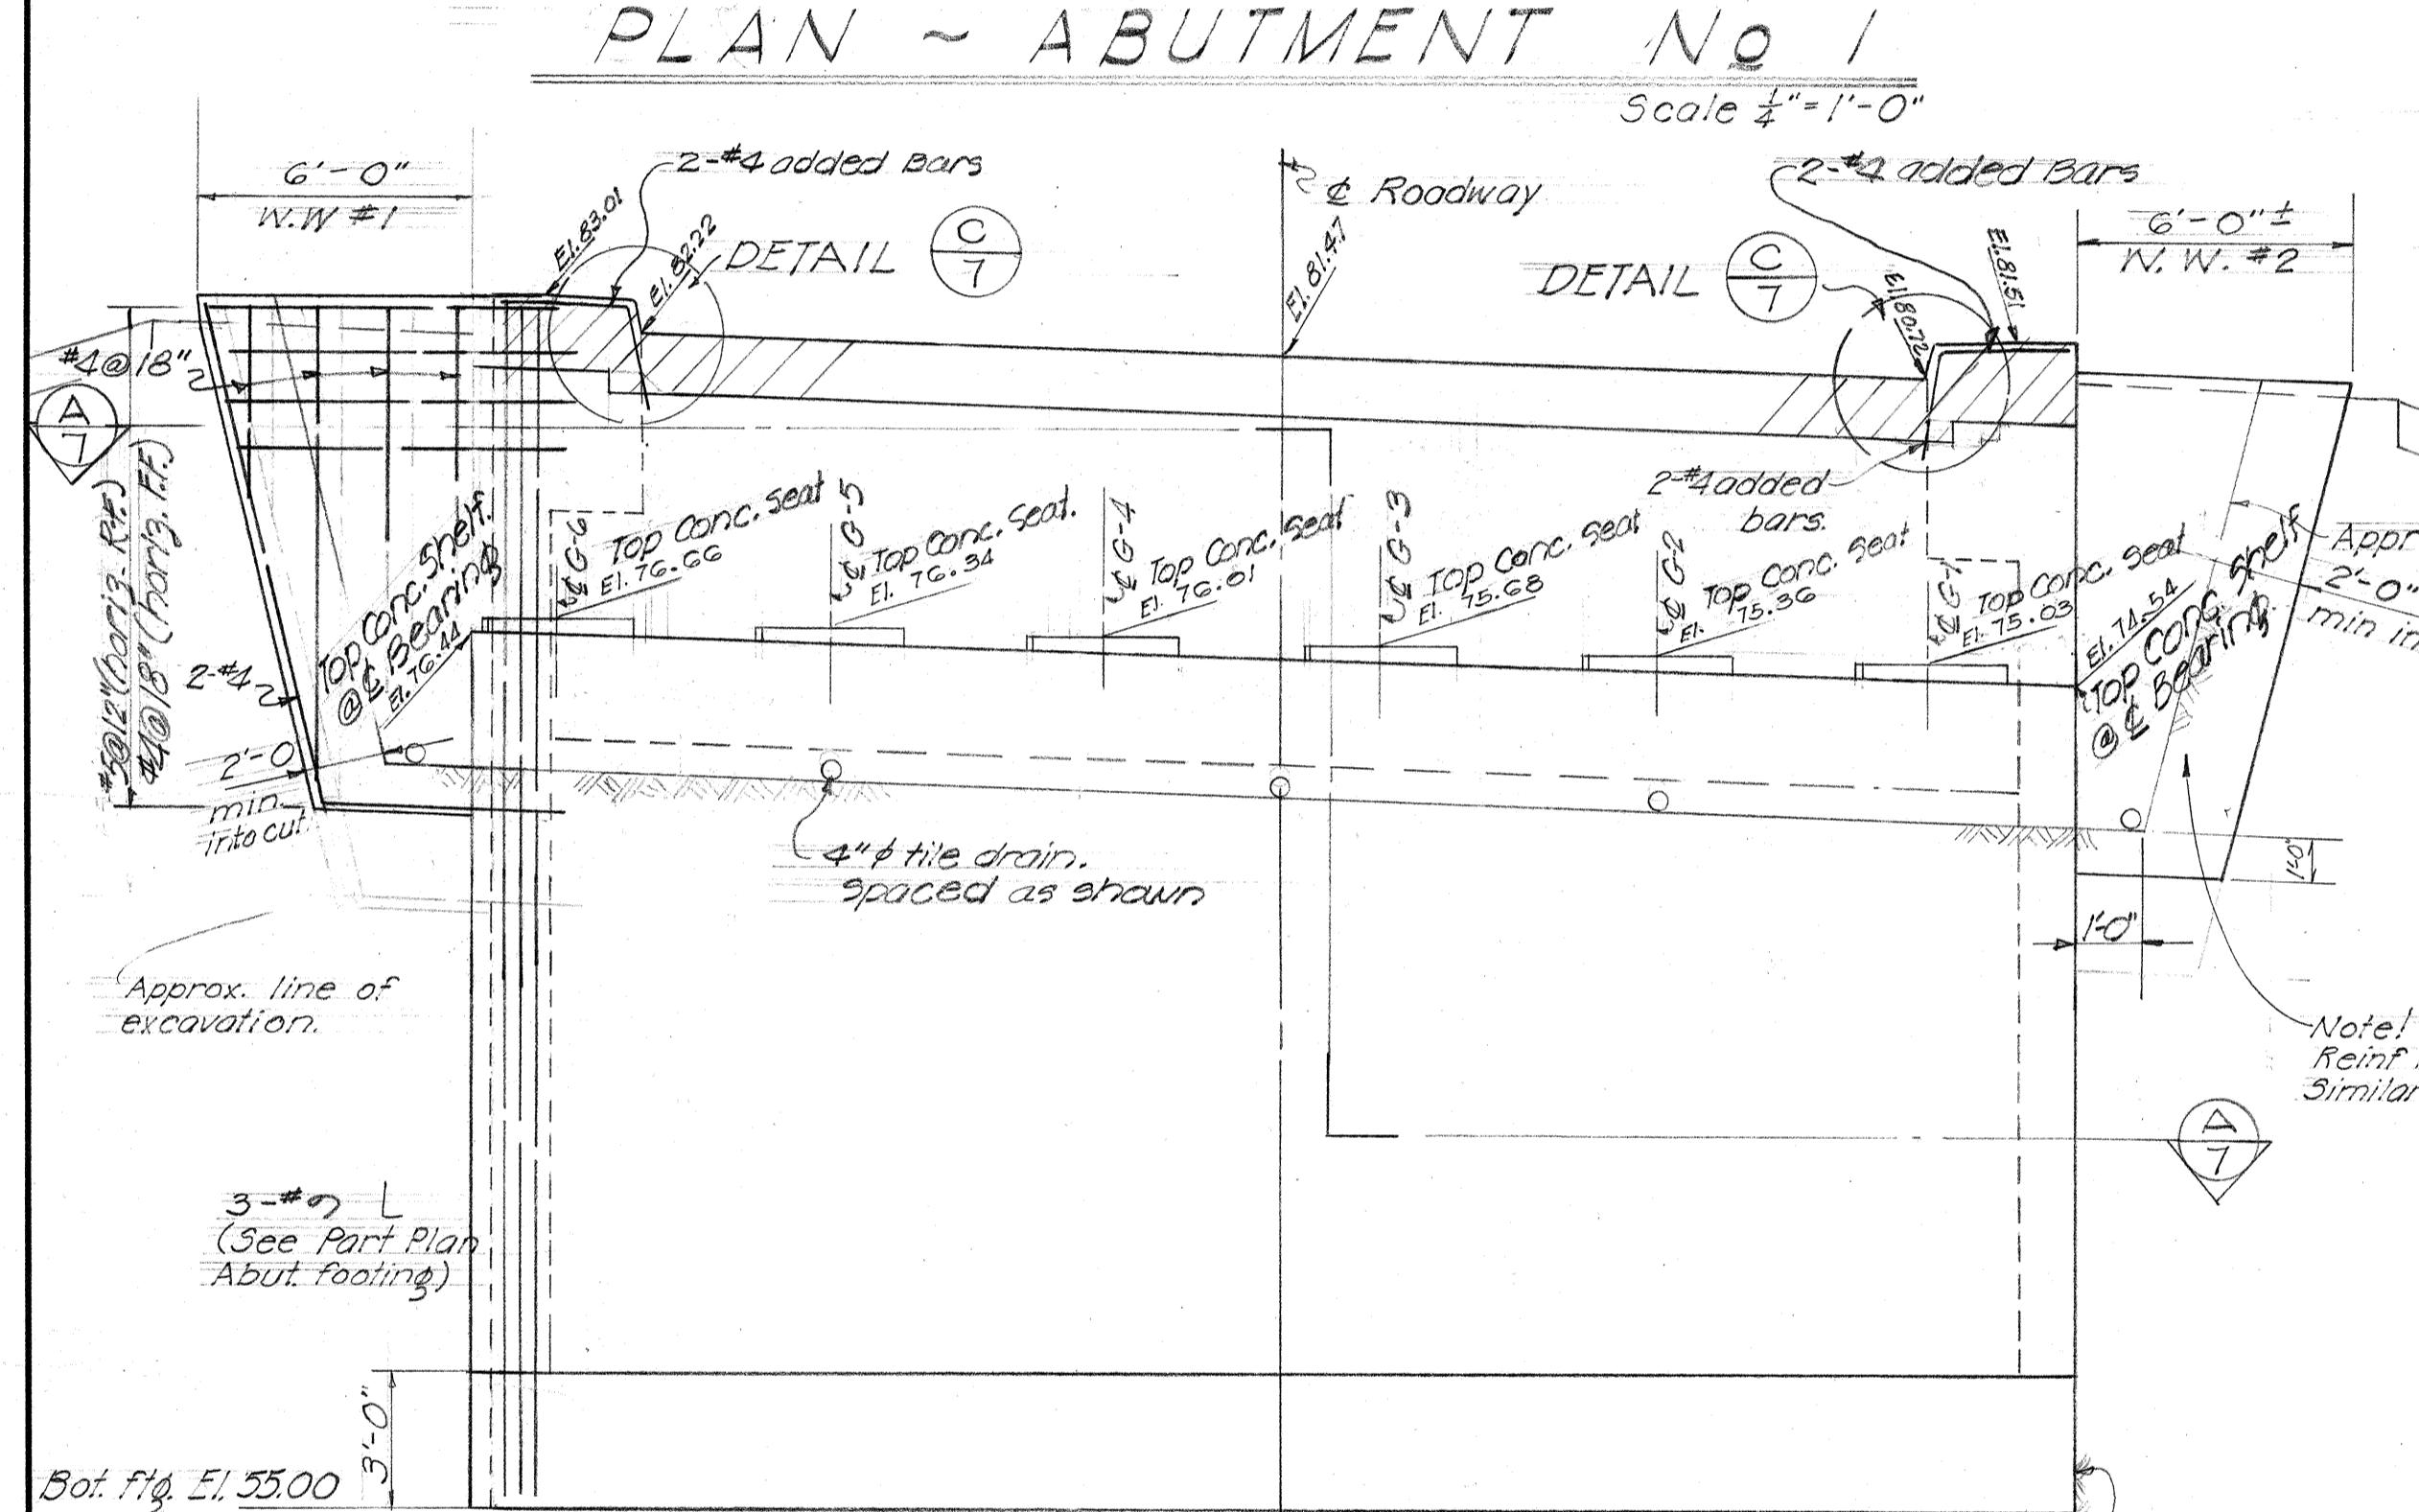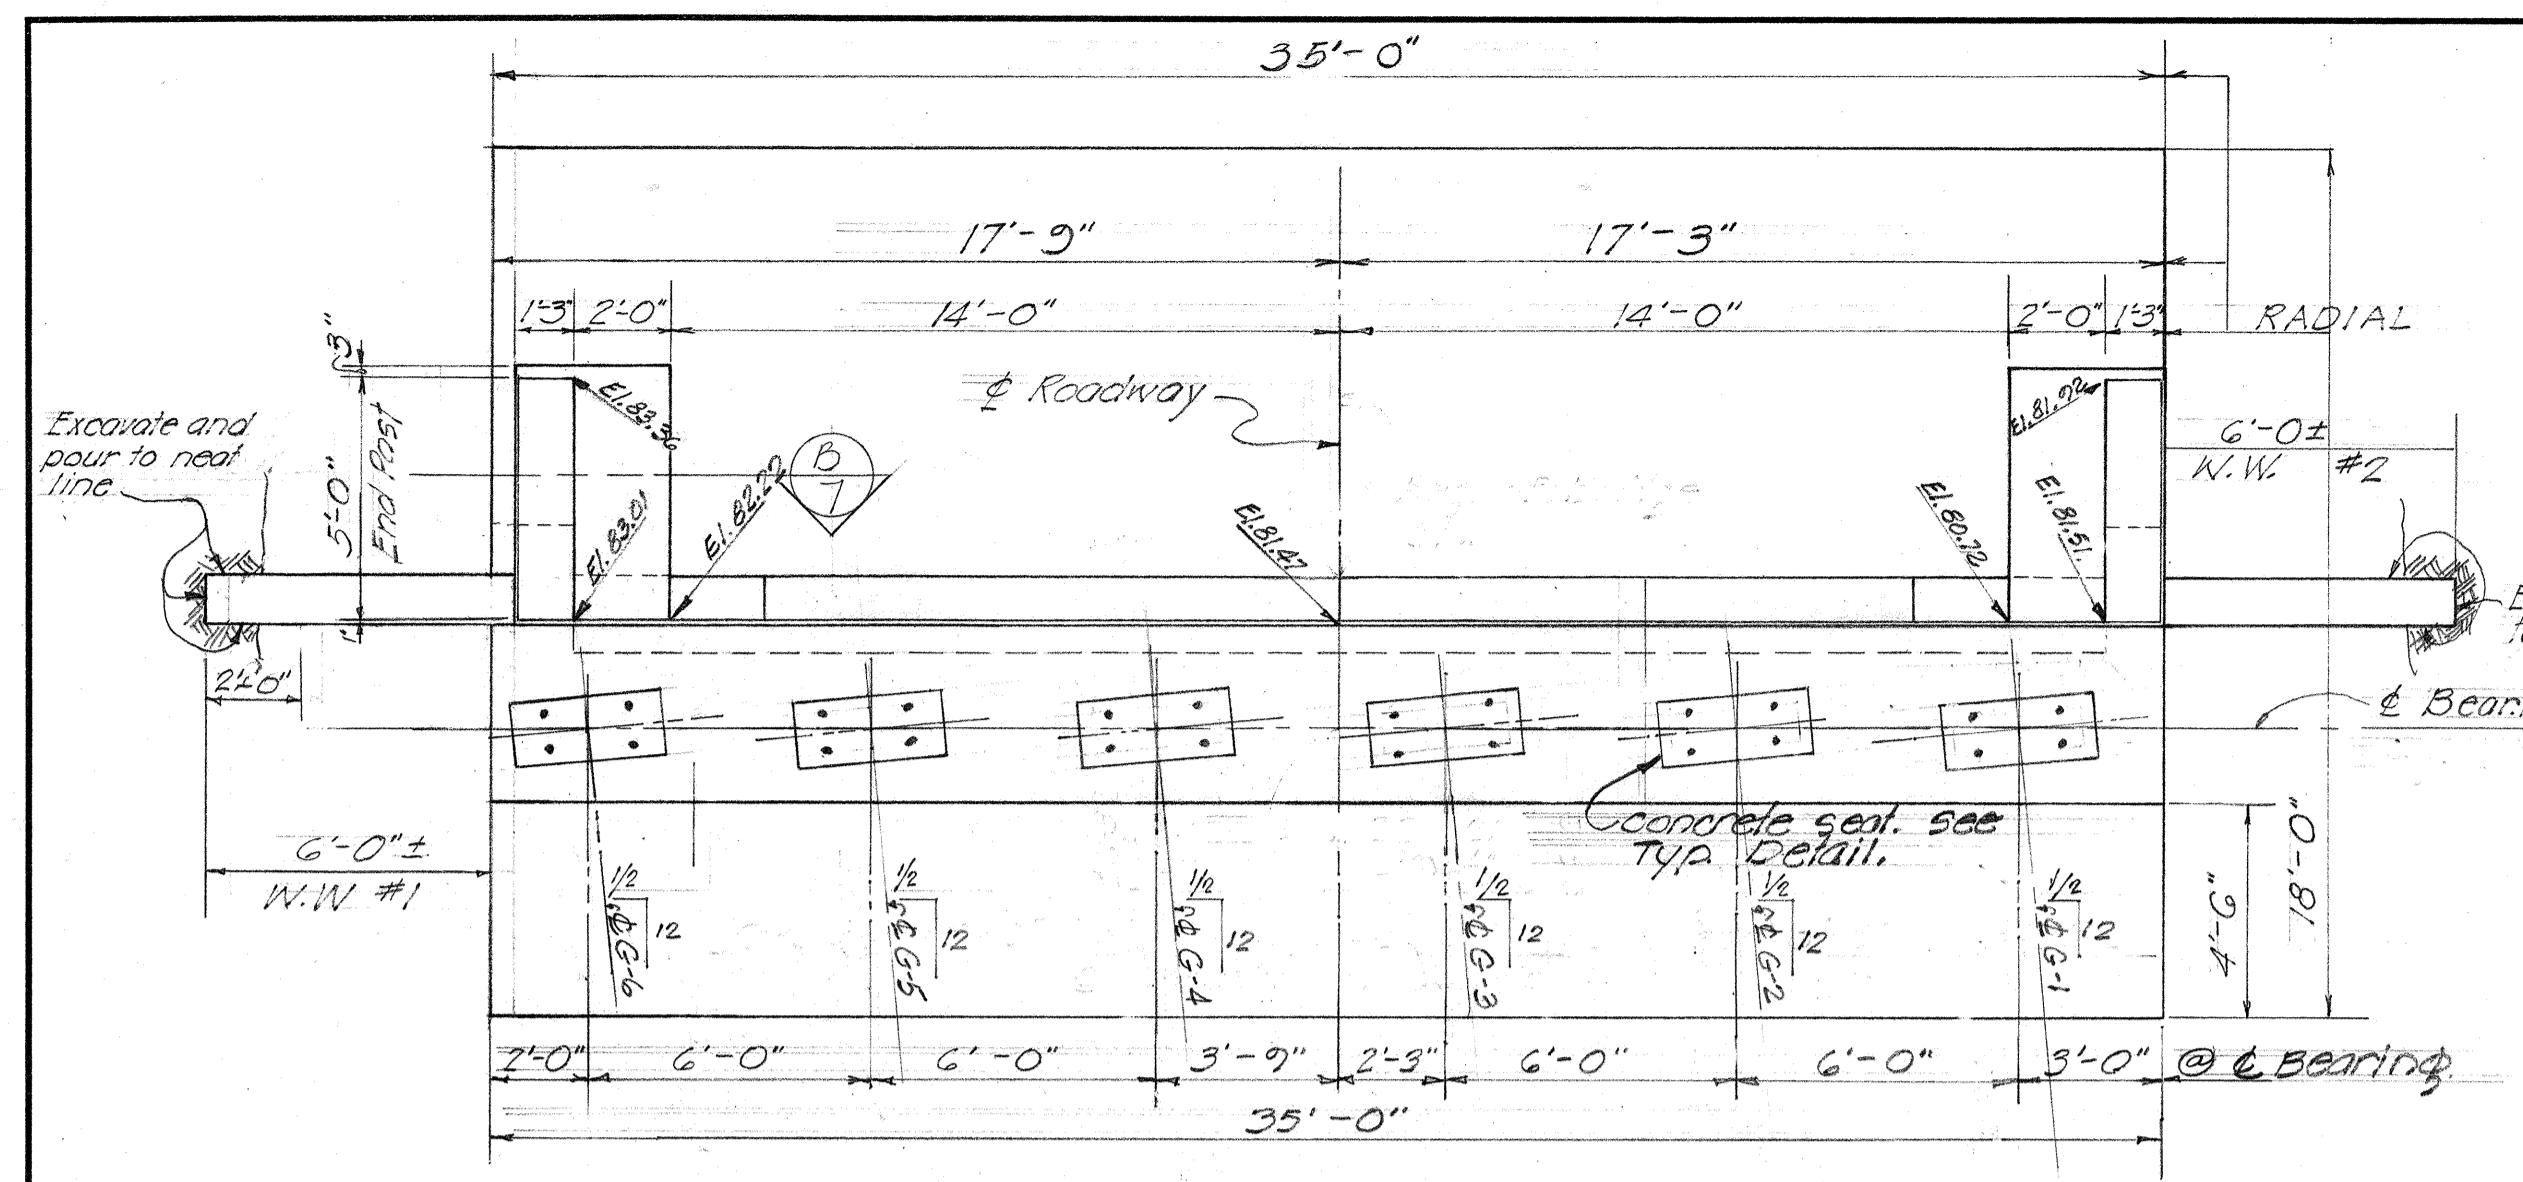








NOTE:
Concrete seats to have a hard steel trowel finish to receive steel masonry plates.
For Bearing Details - see Shft #6
For Abutment Excavation pay line & backfill
see Typical Detail Sheet #47

ALTERNATE "B"
DEPARTMENT OF TRANSPORTATION
DIVISION OF HIGHWAYS
STATE OF HAWAII
STRUCTURE N° 5
KALIHIWAI BRIDGE
STA. 26+57.88 TO STA. 34+56.12
KAUAI BELT ROAD PROJ. ER-7(1) UNIT 2
FEBRUARY 1961



SHEET NO. 17 OF 12 SHEETS

ORIGINAL	SURVEY PLOTTED BY	DATE:
PLAN		
DRAWN BY		
TRACED BY		
QUANTITIES CHECKED BY		
NOTE BOOK		
No.		

FED. ROAD DIST. NO.	STATE HAWAII	FED. AID UNIT 2	FISCAL YEAR 1961	SHEET NO. 41	TOTAL SHEETS 77
------------------------	-----------------	--------------------	------------------------	-----------------	--------------------

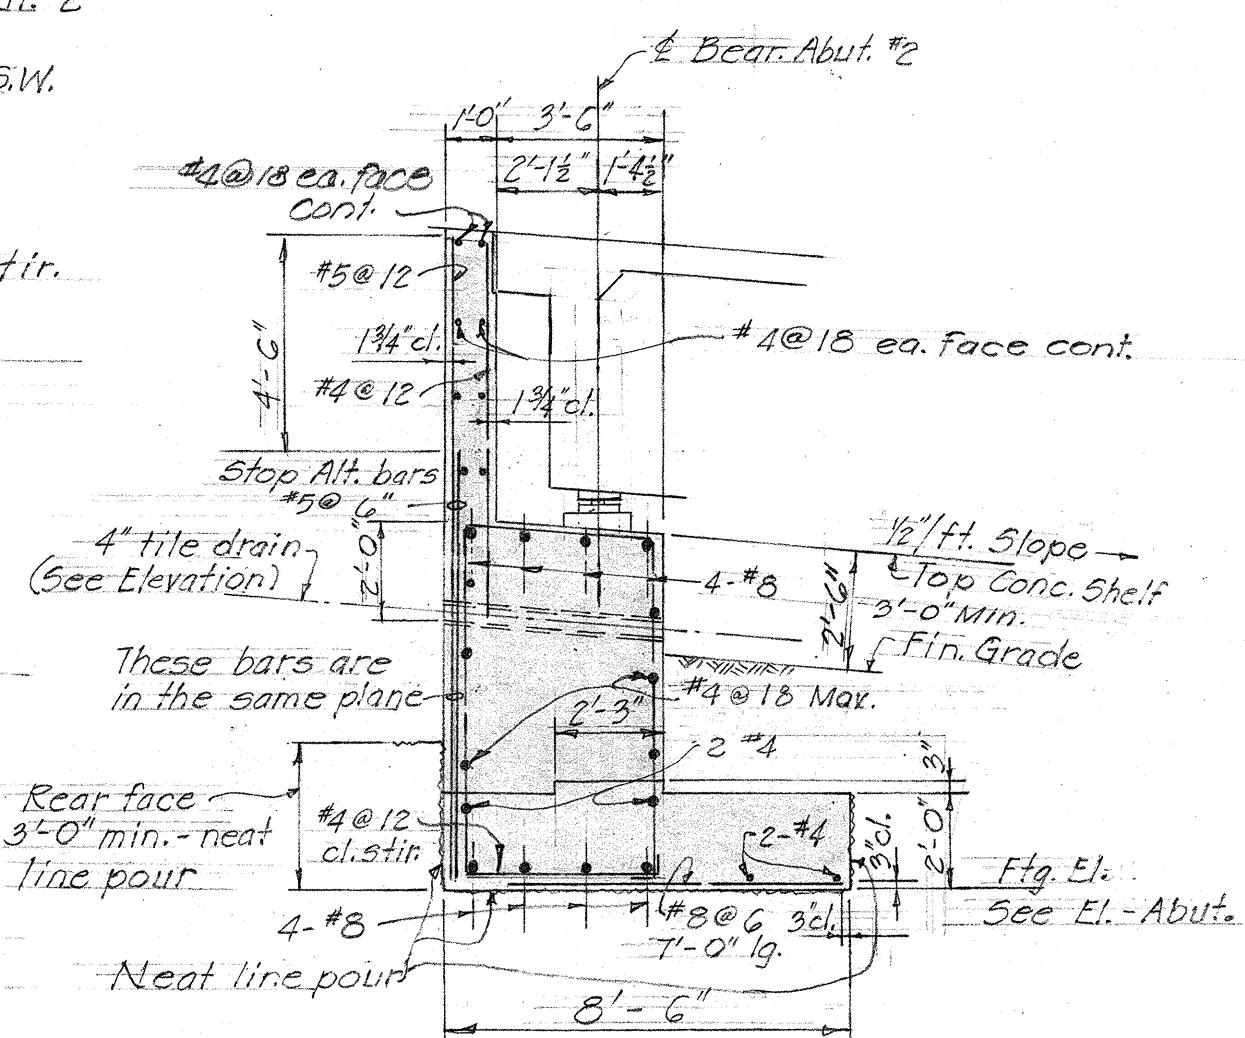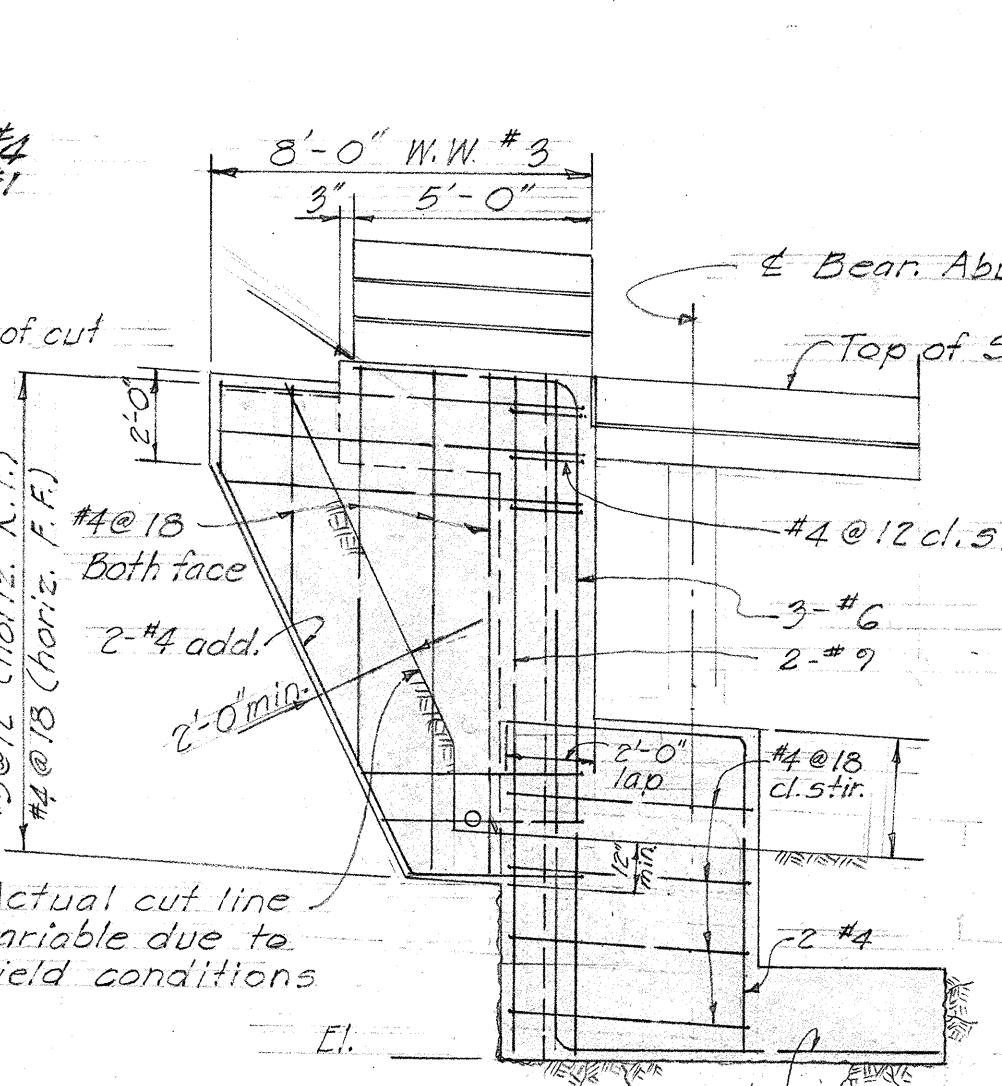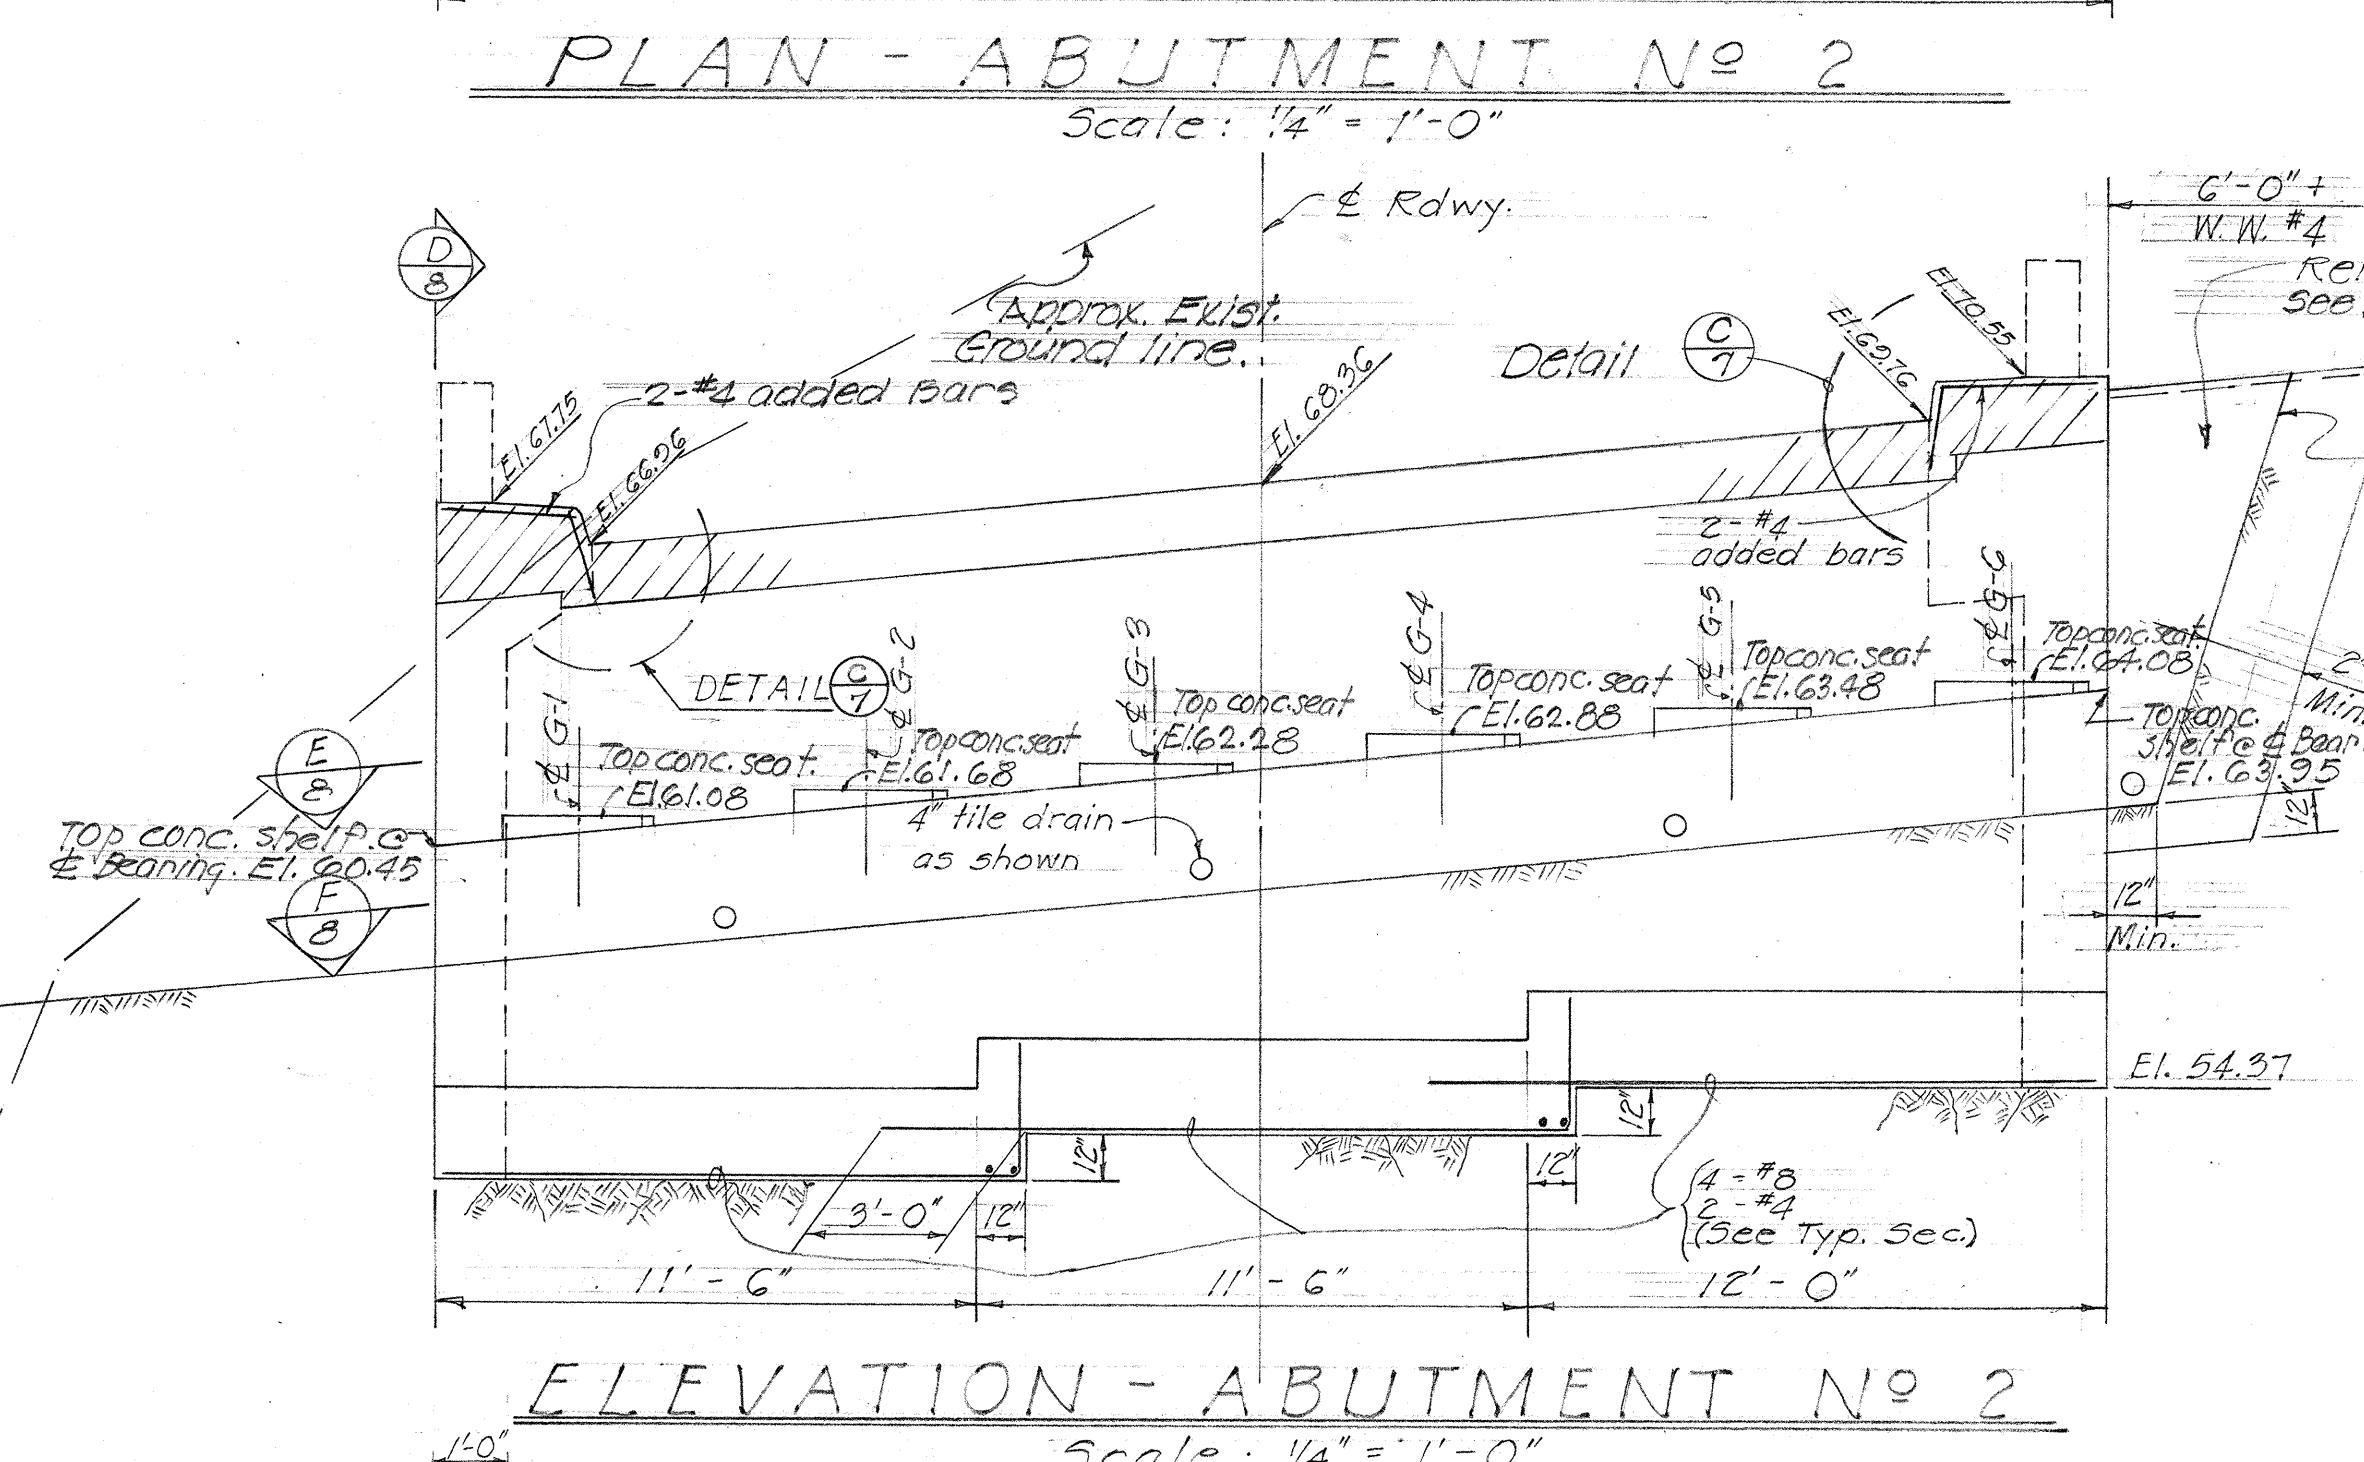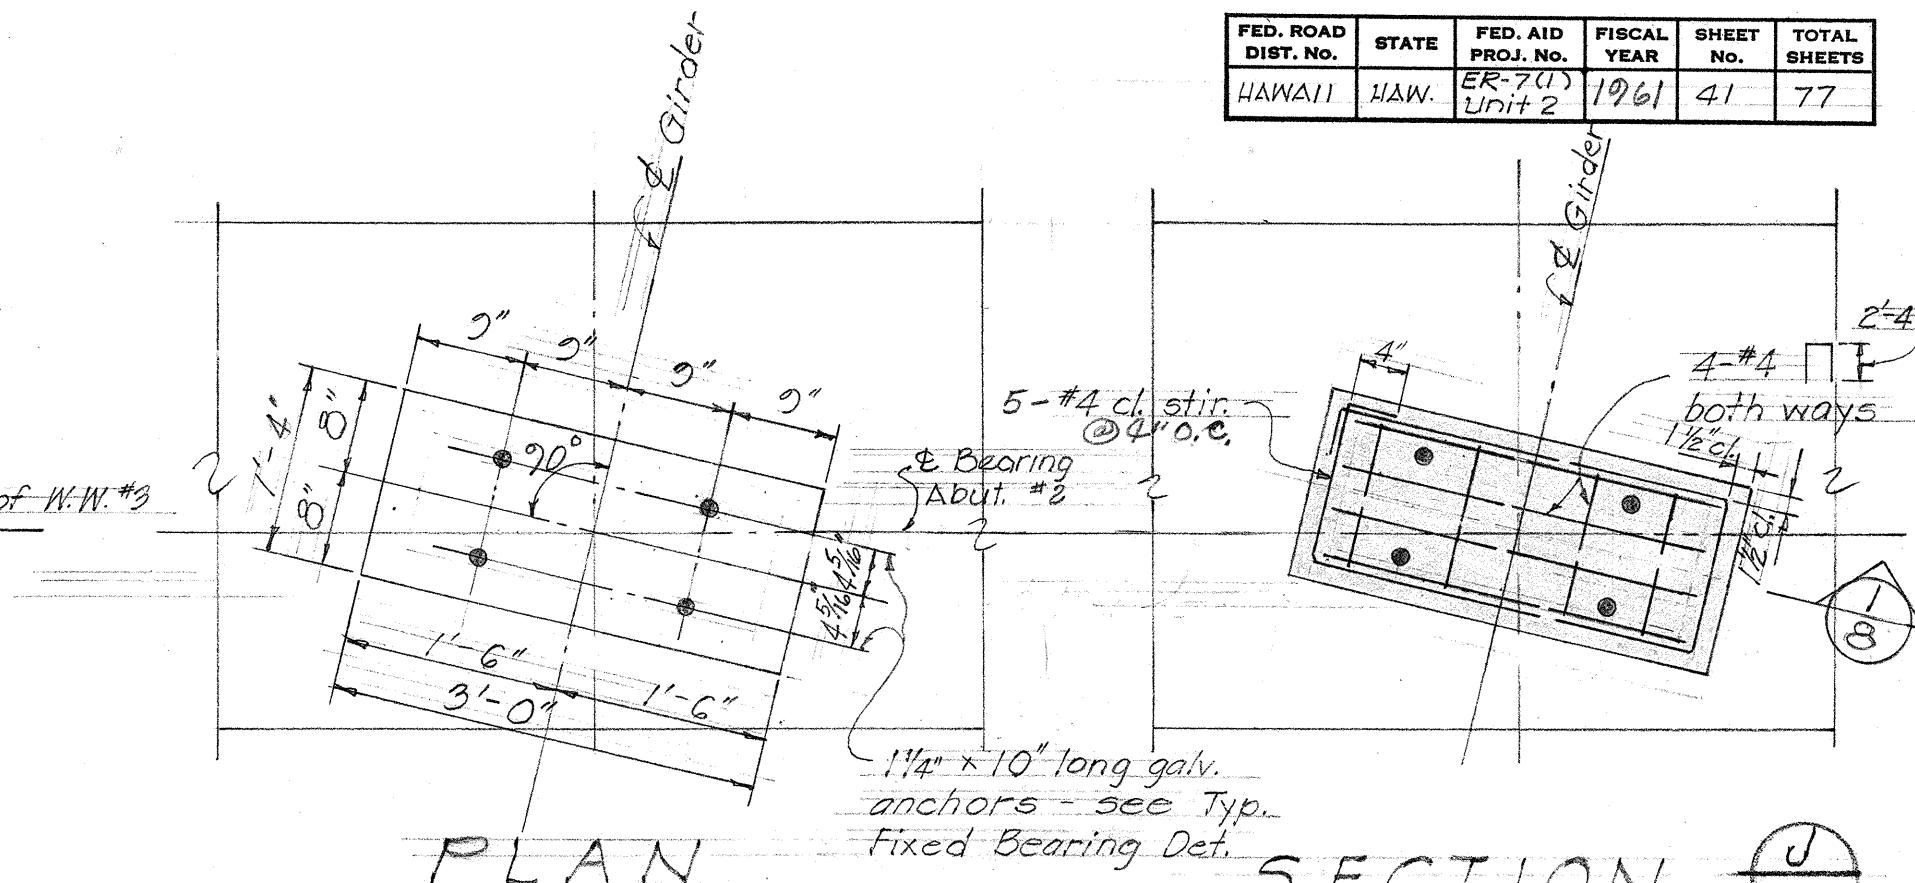
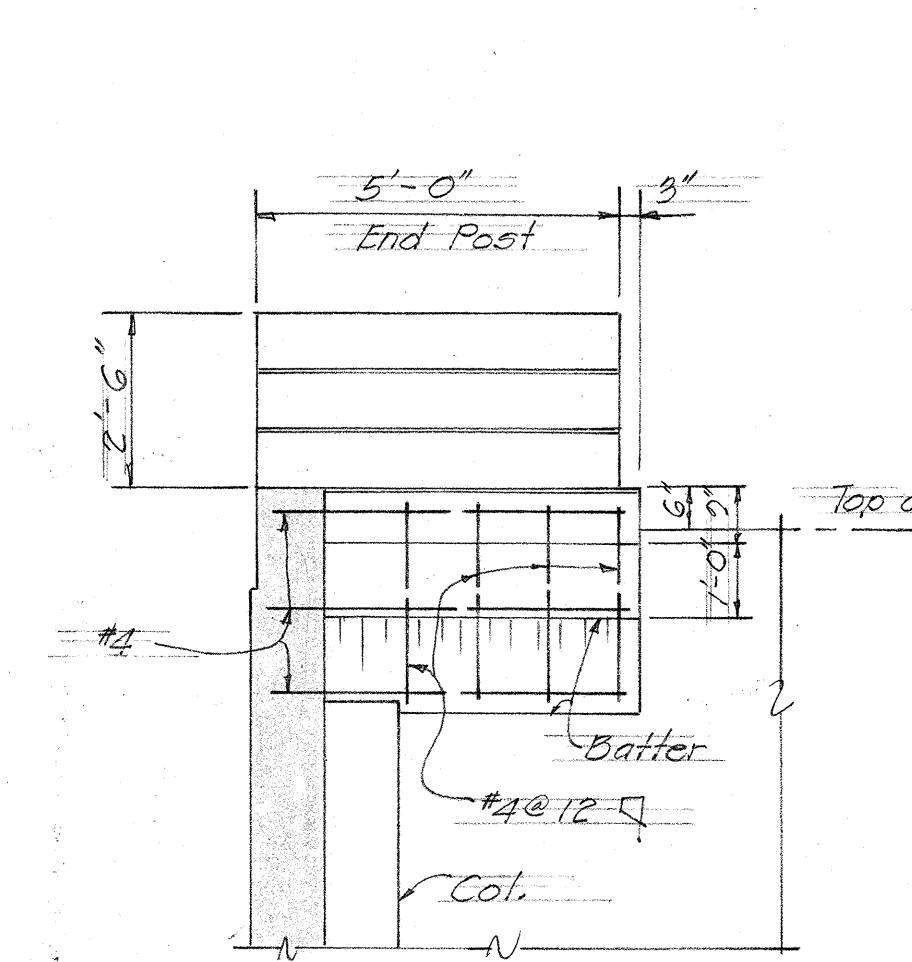
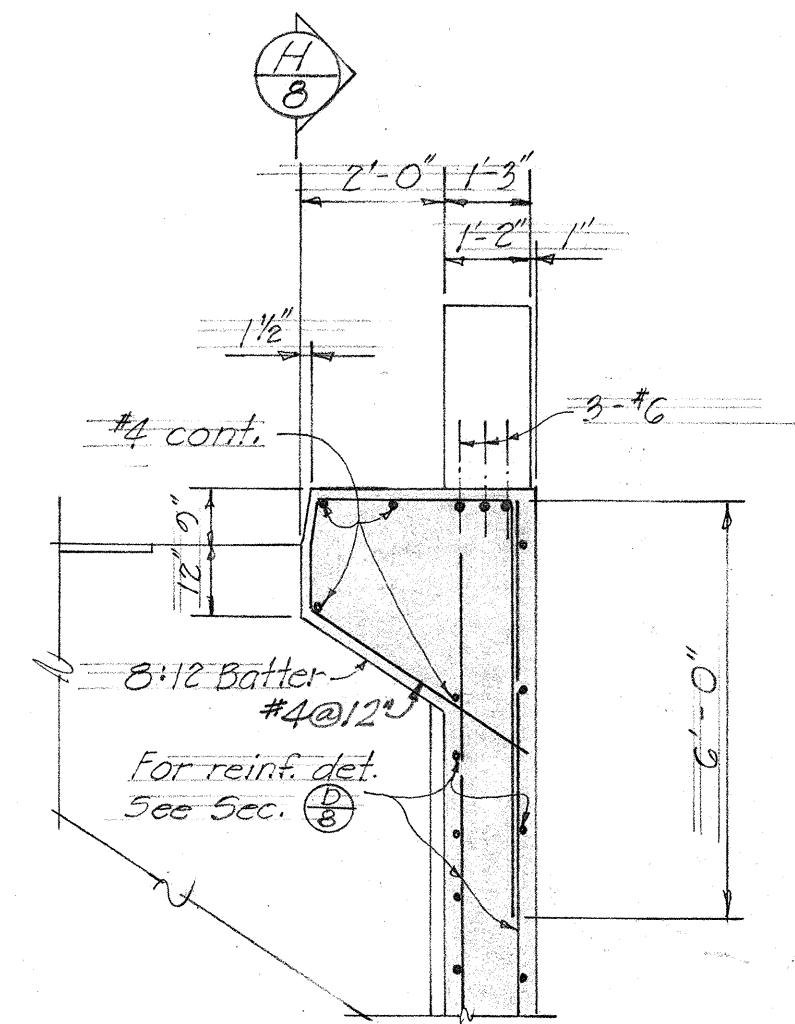
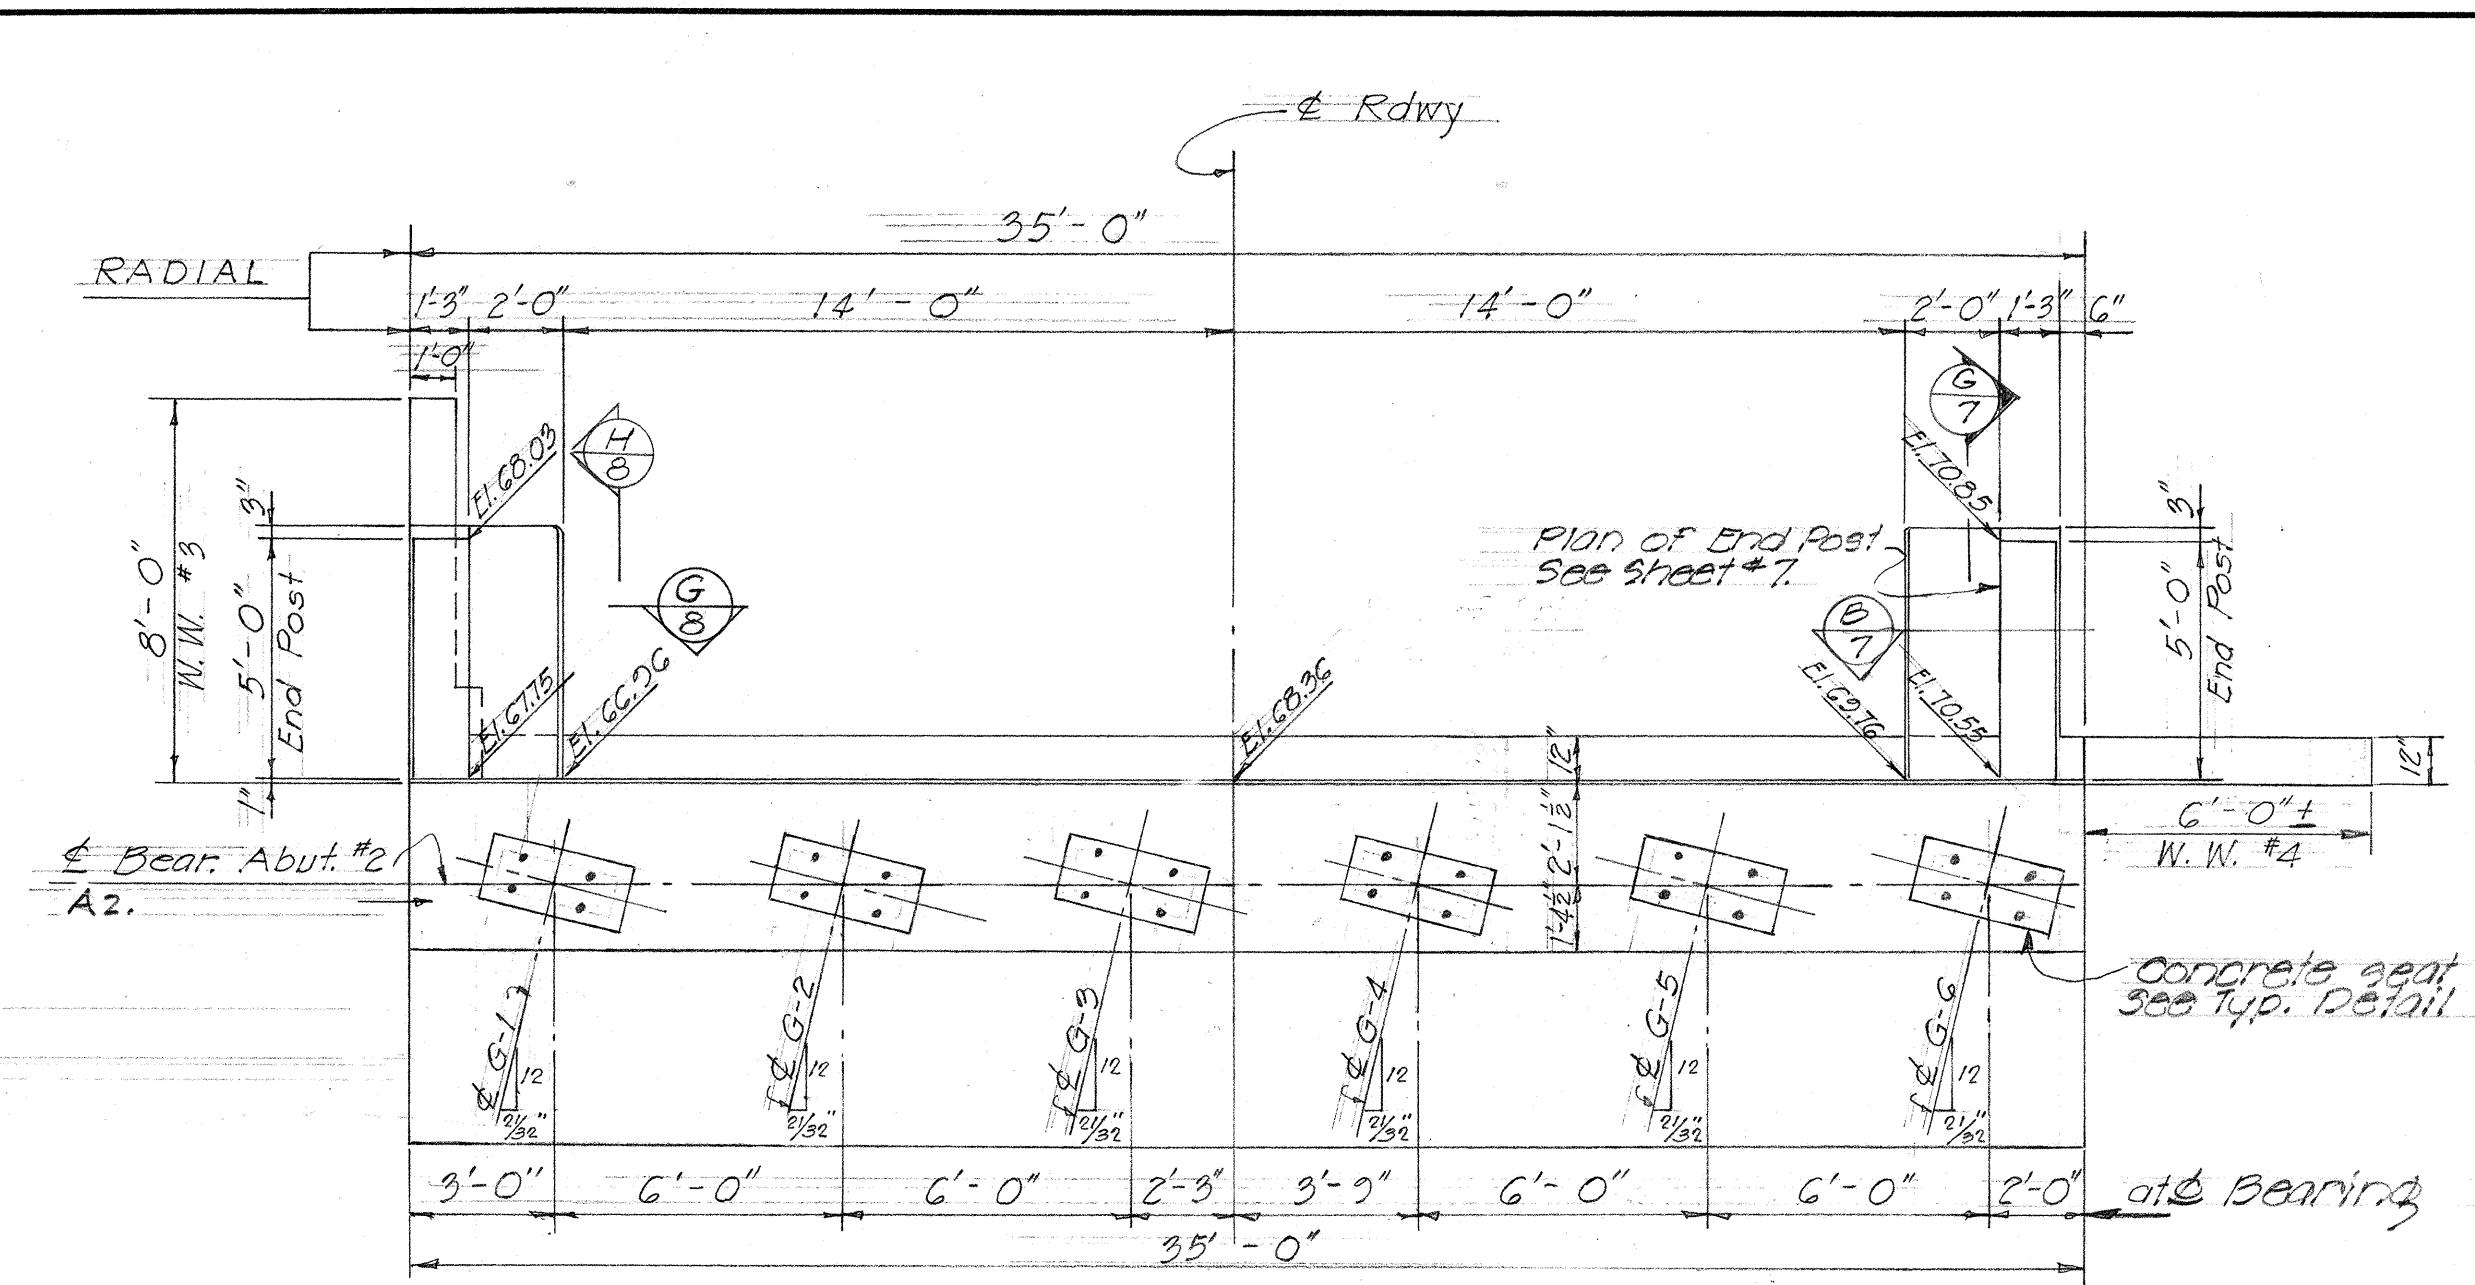


NOTE:
Concrete seats to have hard steel trowel finish to receive steel masonry plates.
For bearing details - see sh. #6
For Abutment Excavation pay line
#3 backfill, see typical detail sheet #47.

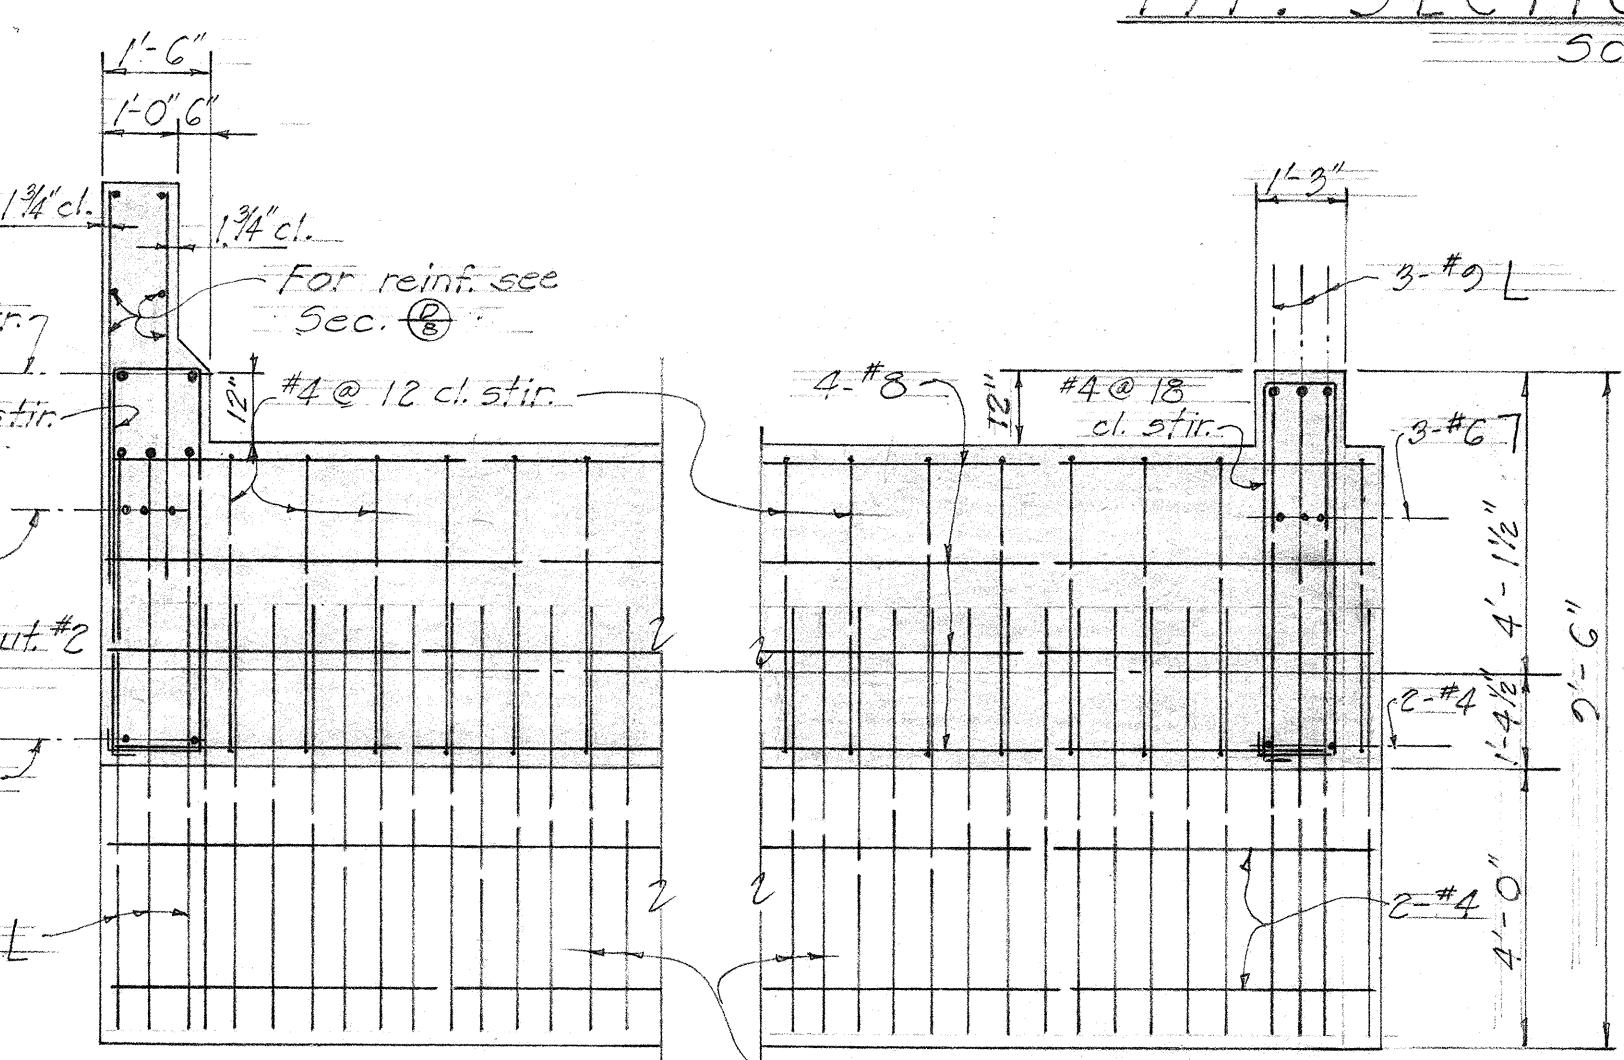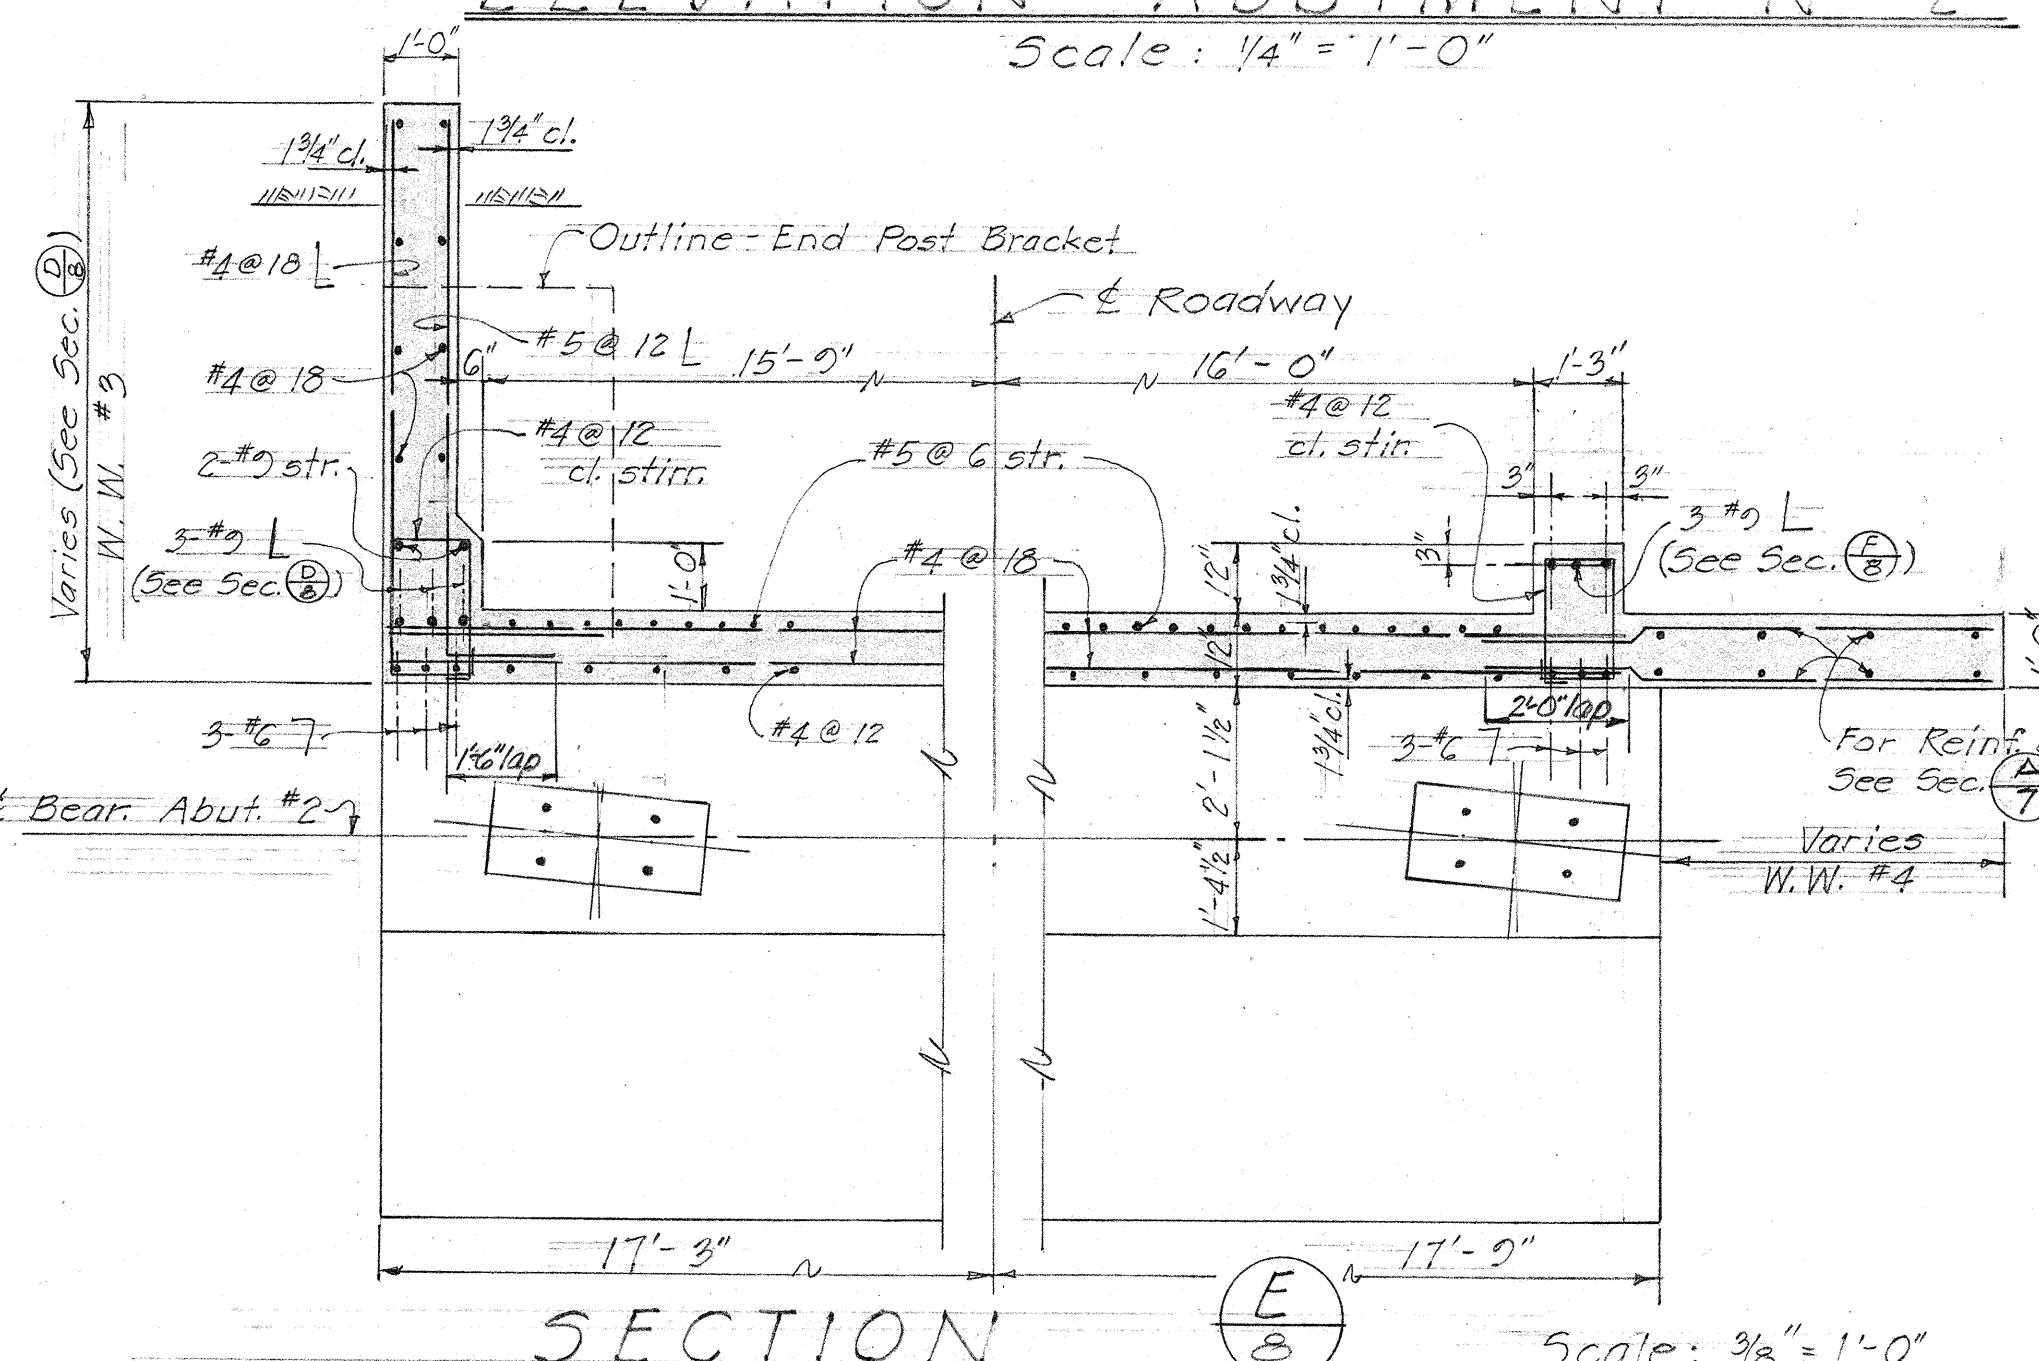



ALTERATE "B"
DEPARTMENT OF TRANSPORTATION
DIVISION OF HIGHWAYS
STATE OF HAWAII
STRUCTURE N° 5
KALIHWAI BRIDGE
STA. 26+57.88 TO STA. 34+56.12
KAUAI BELTROAD PROJ. ER-7(1)
FEBRUARY 1961 UNIT 2

FED. ROAD
DIST. NO. STATE FED. AID FISCAL SHEET
HAWAII HAW. ER-7(1) 1961 42 77

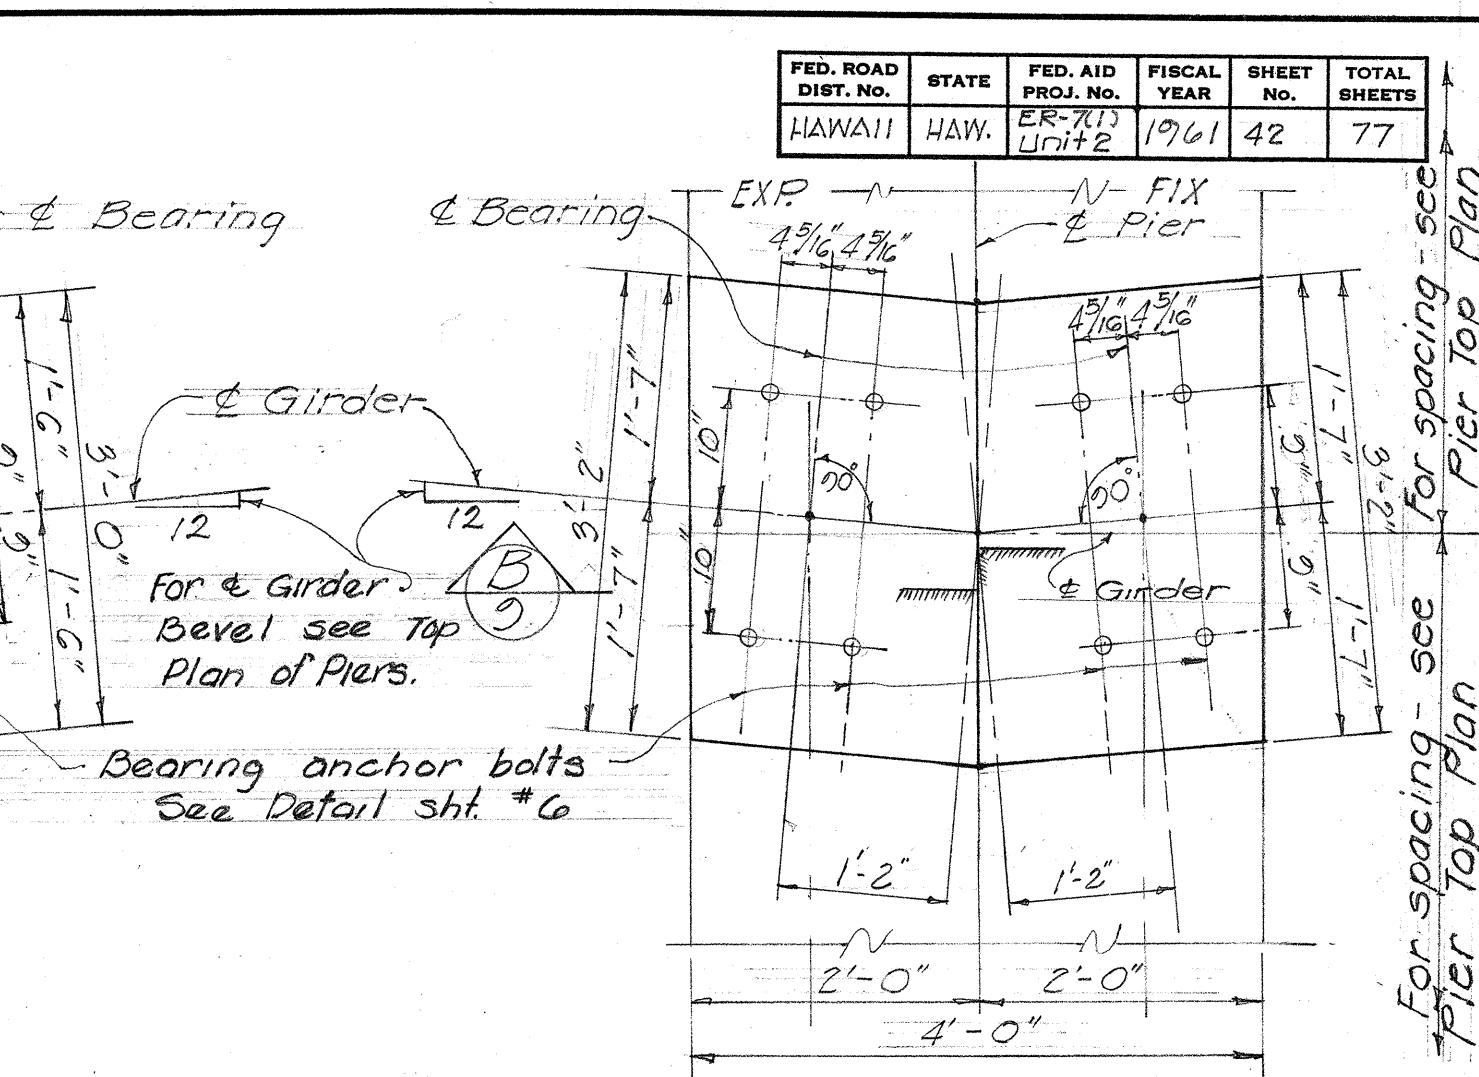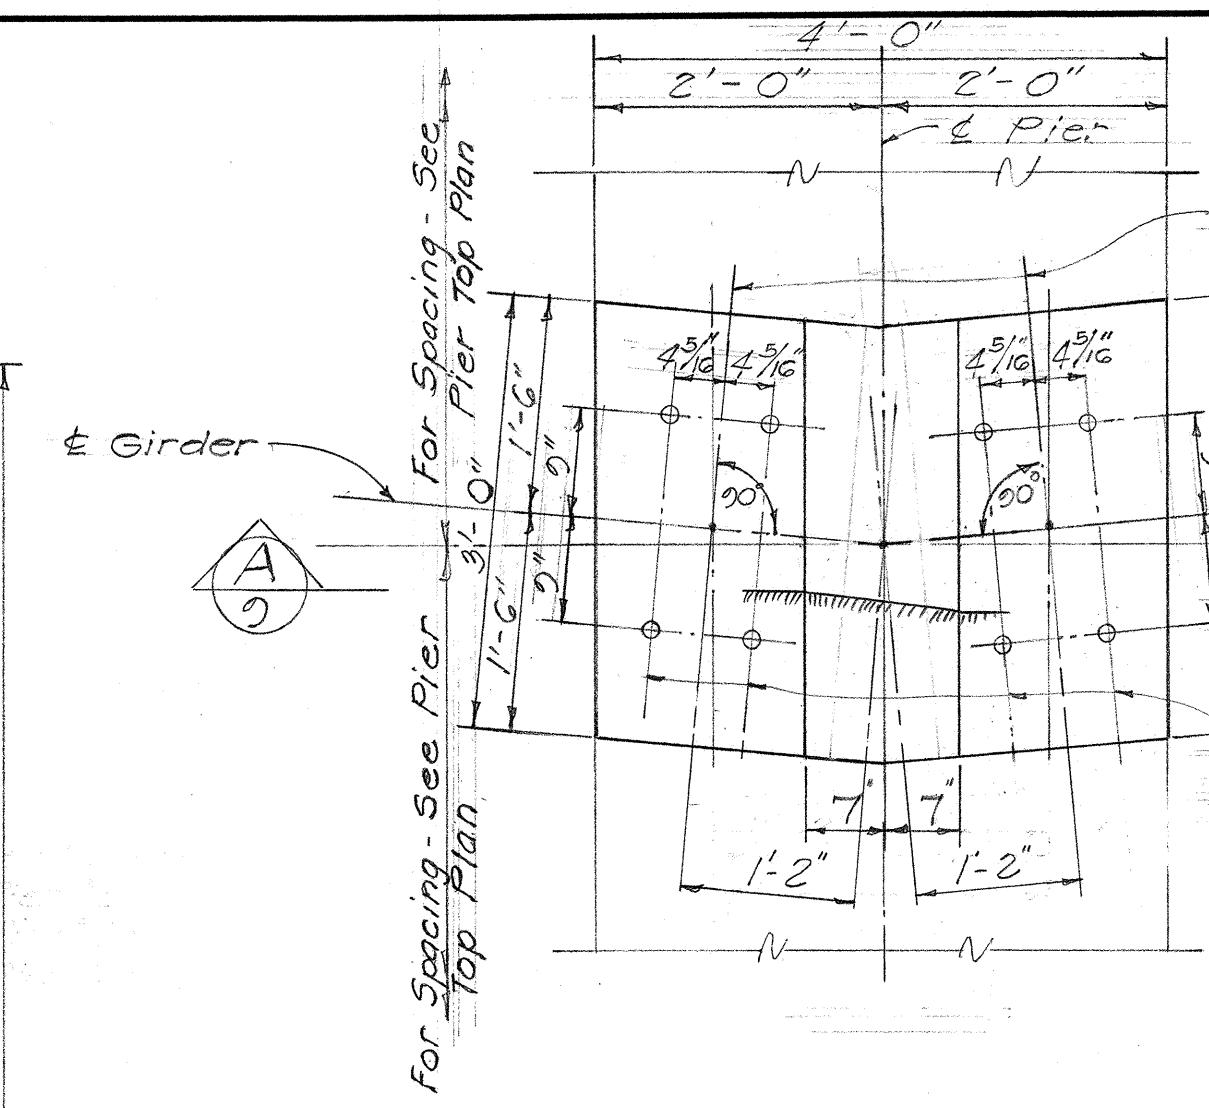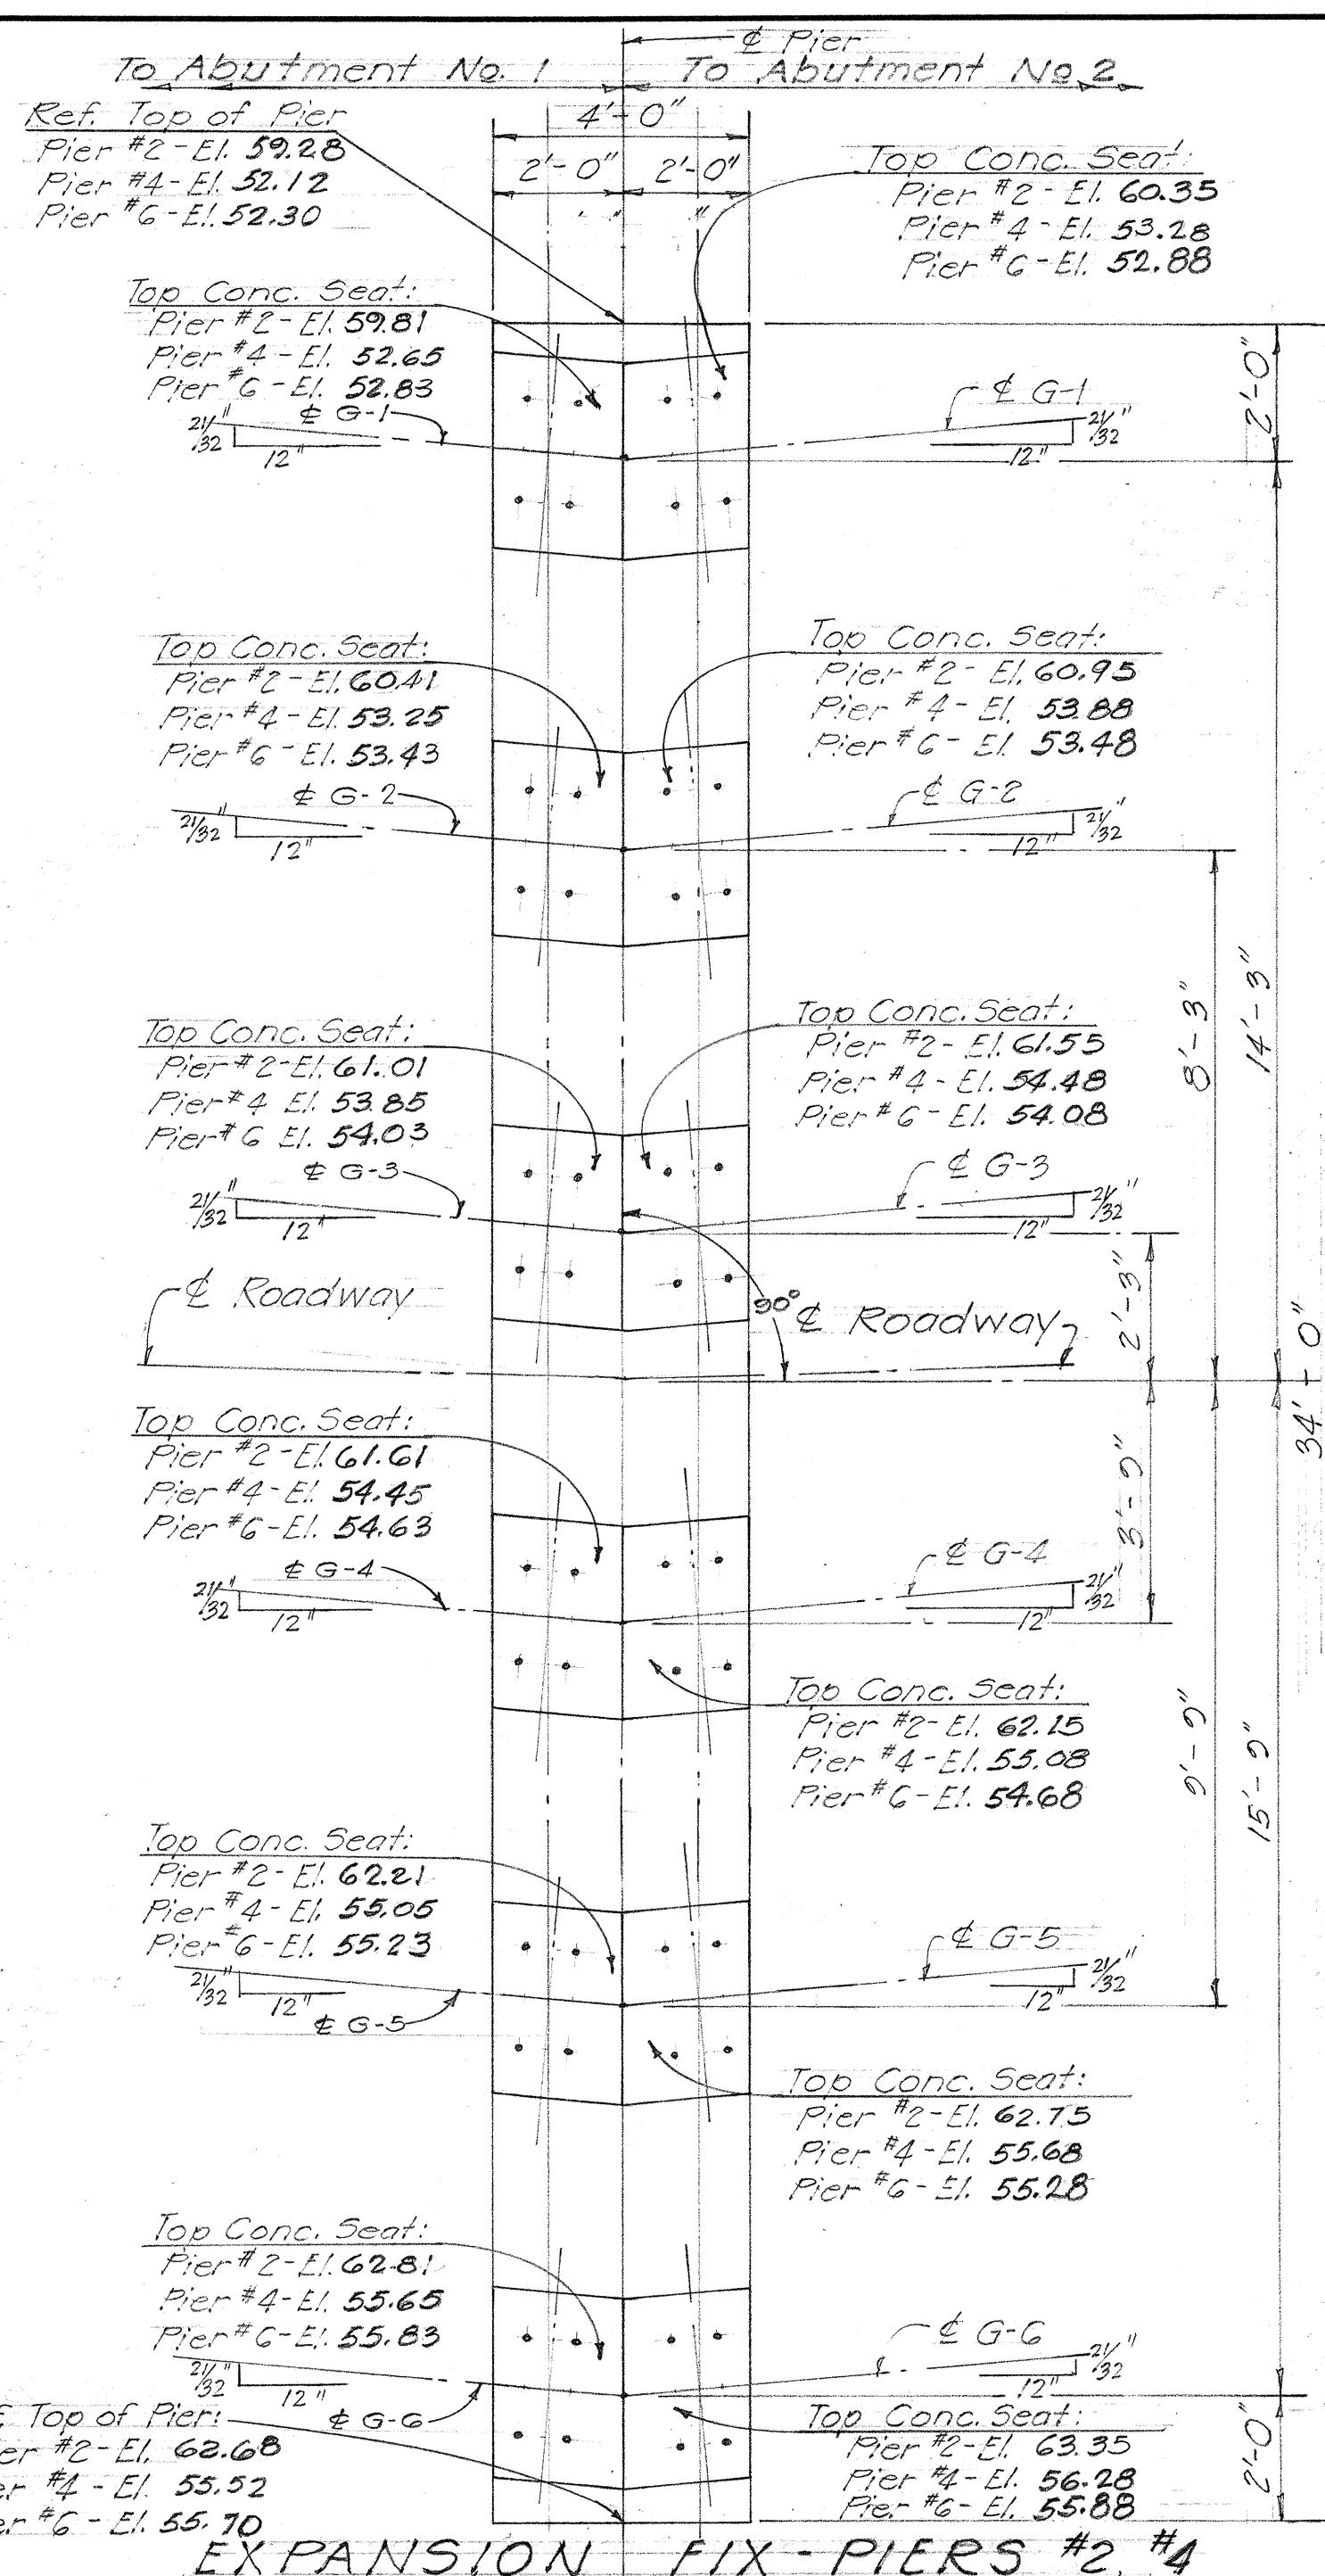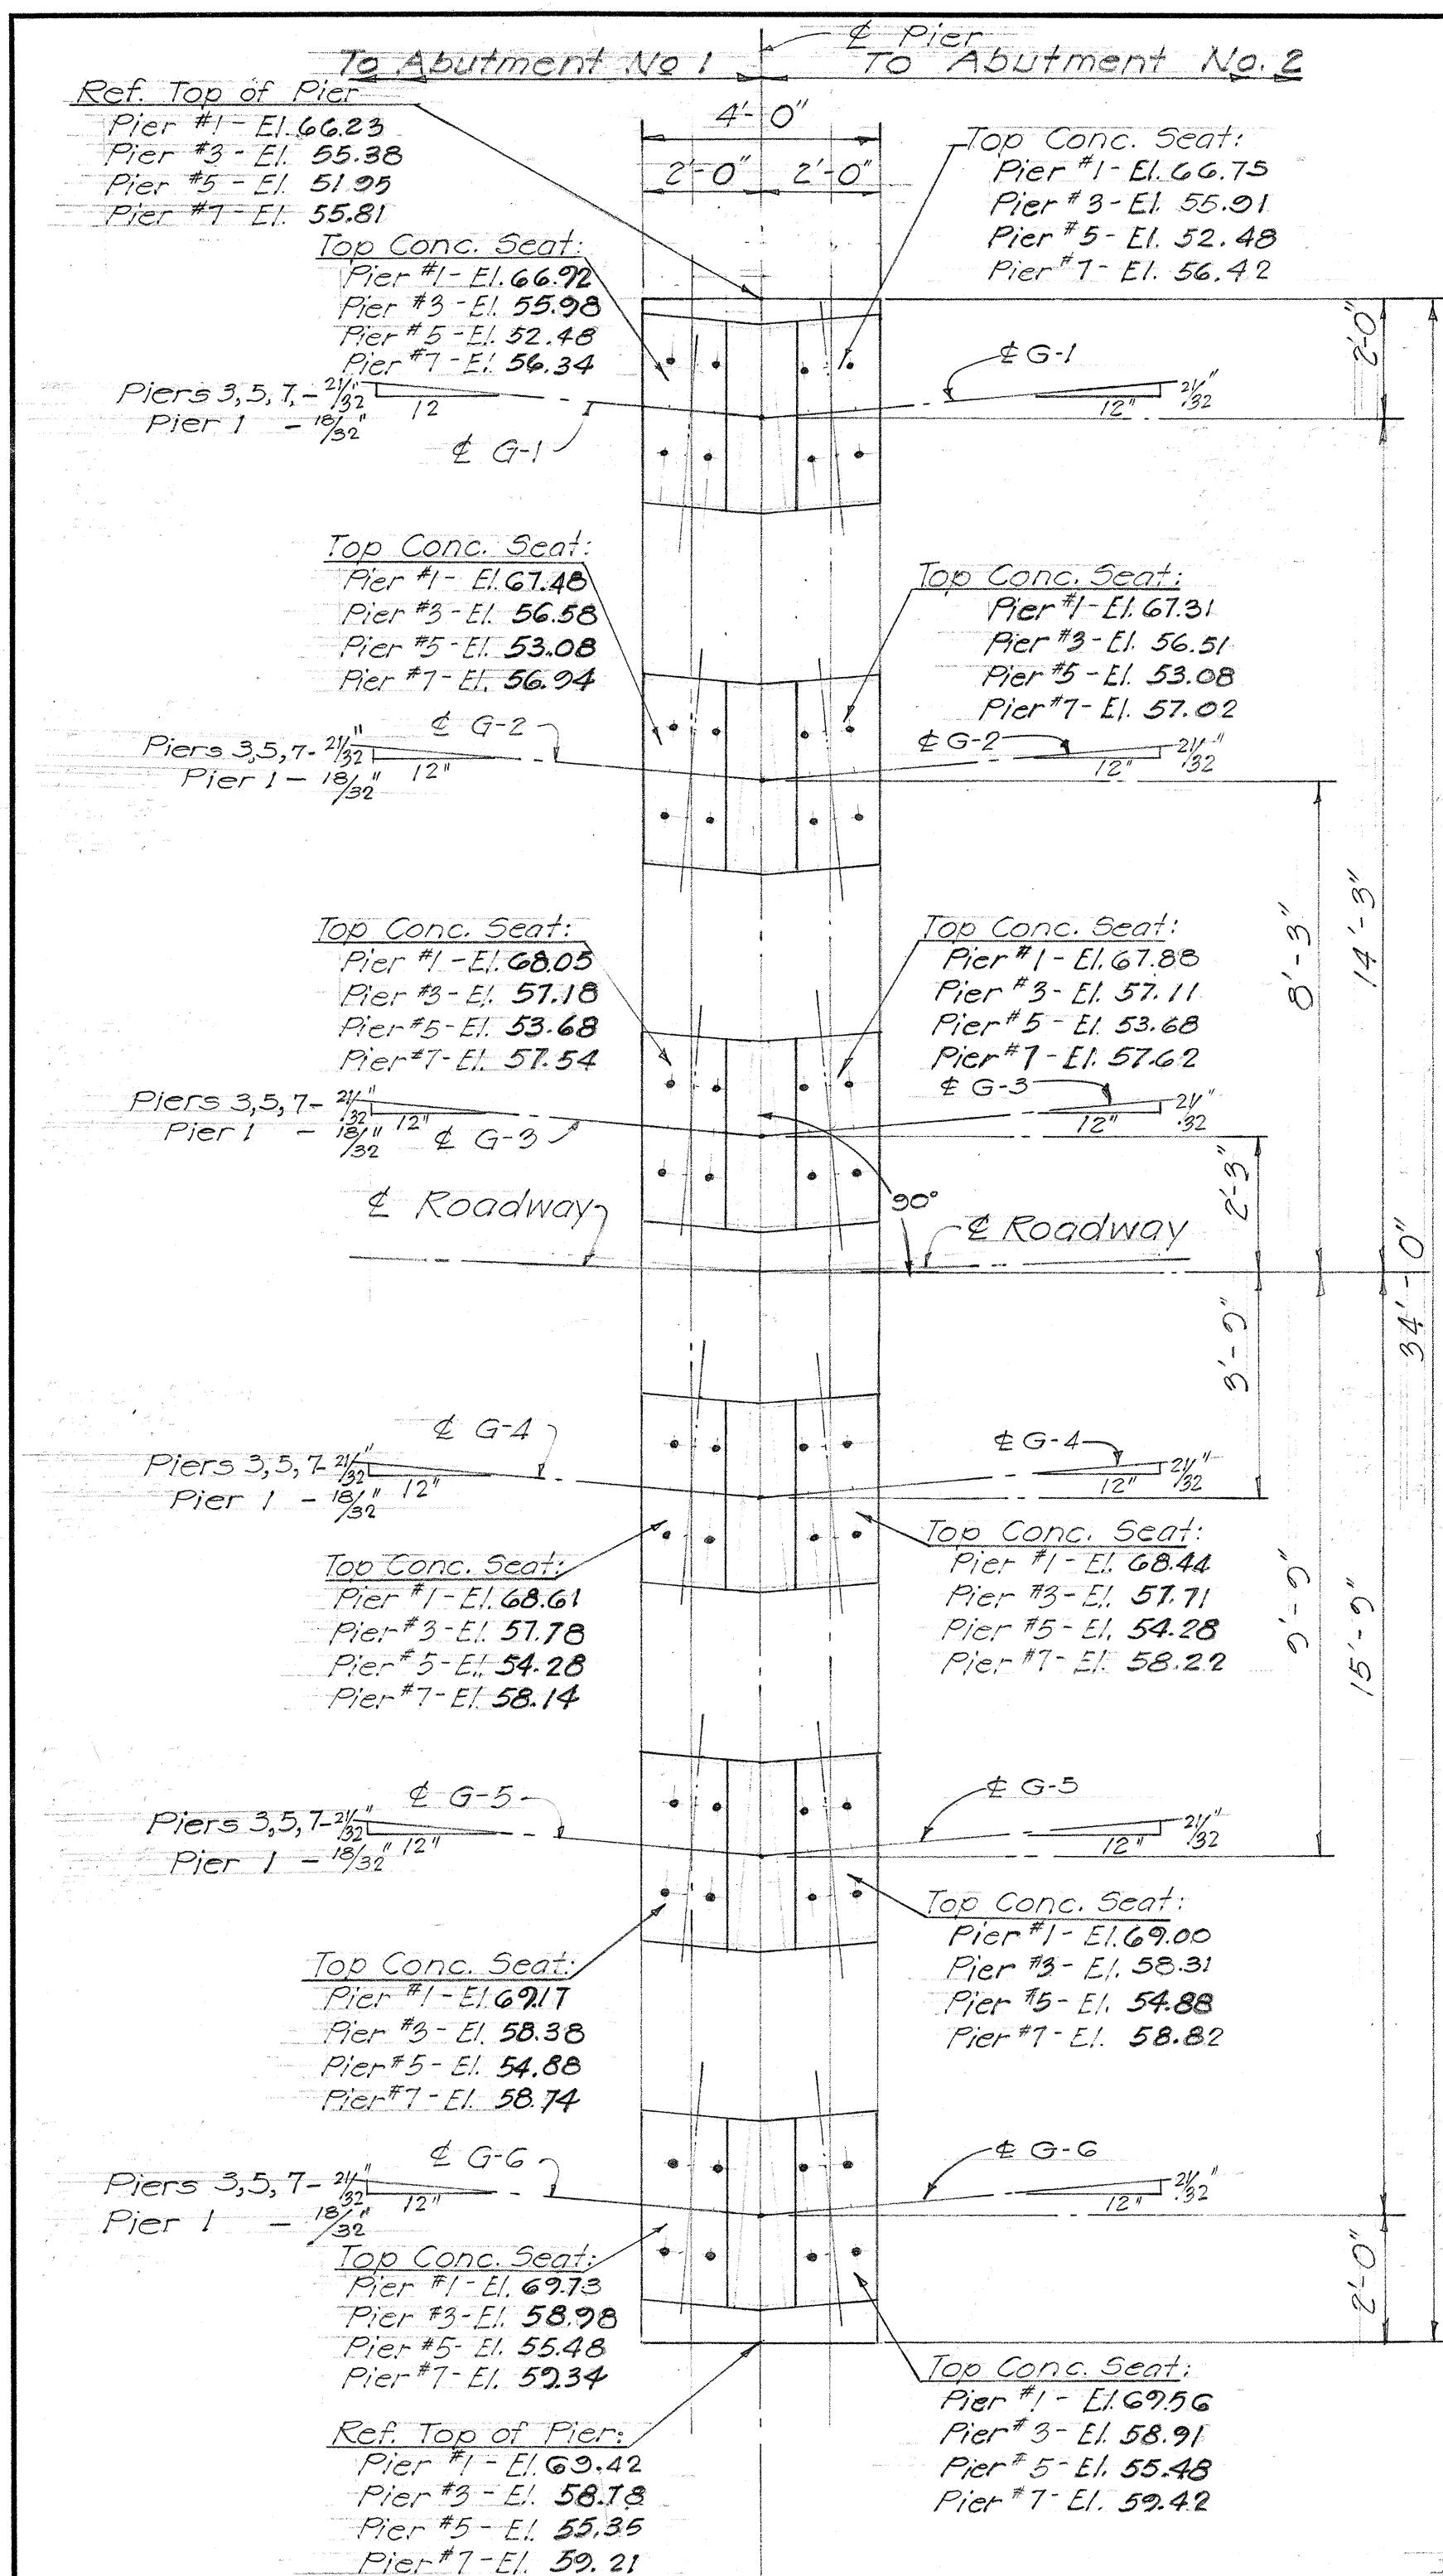

TOP PLAN


TOP PLAN

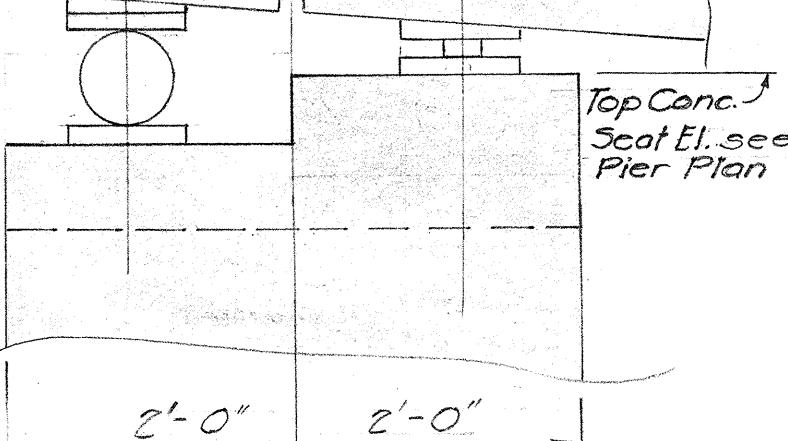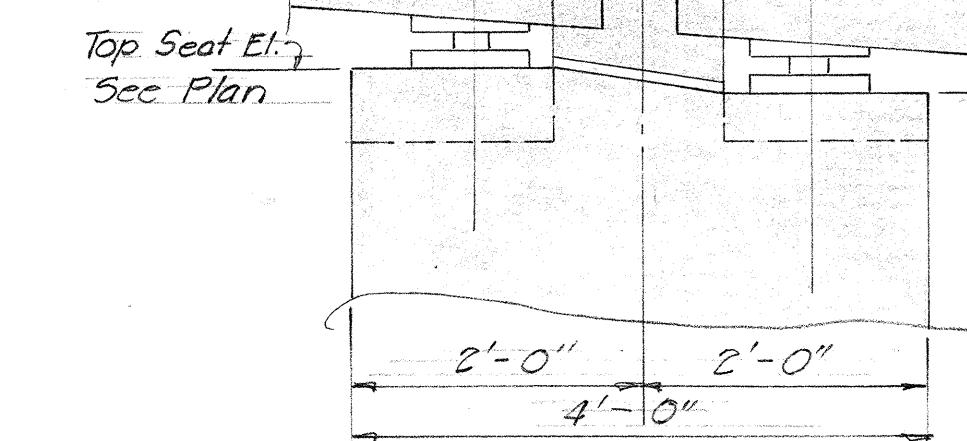

SECTION


TYPICAL CONCRETE SEAT
DETAIL - PIERS N° 1, 3, 5, 7

Scale: $\frac{3}{4}'' = 1'-0''$

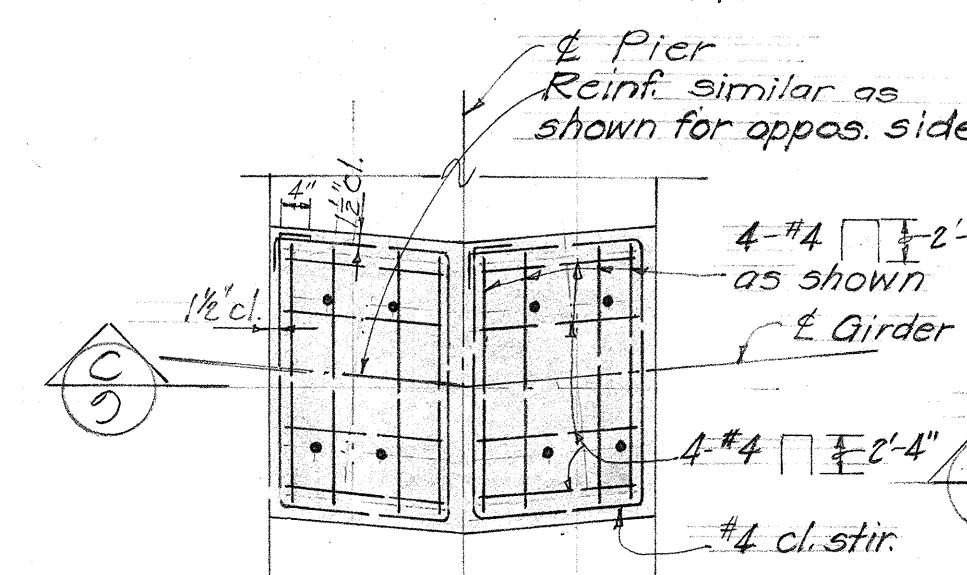

TYP. CONCRETE SEAT
DETAIL - PIERS N° 2, 4


Scale: $\frac{3}{4}'' = 1'-0''$

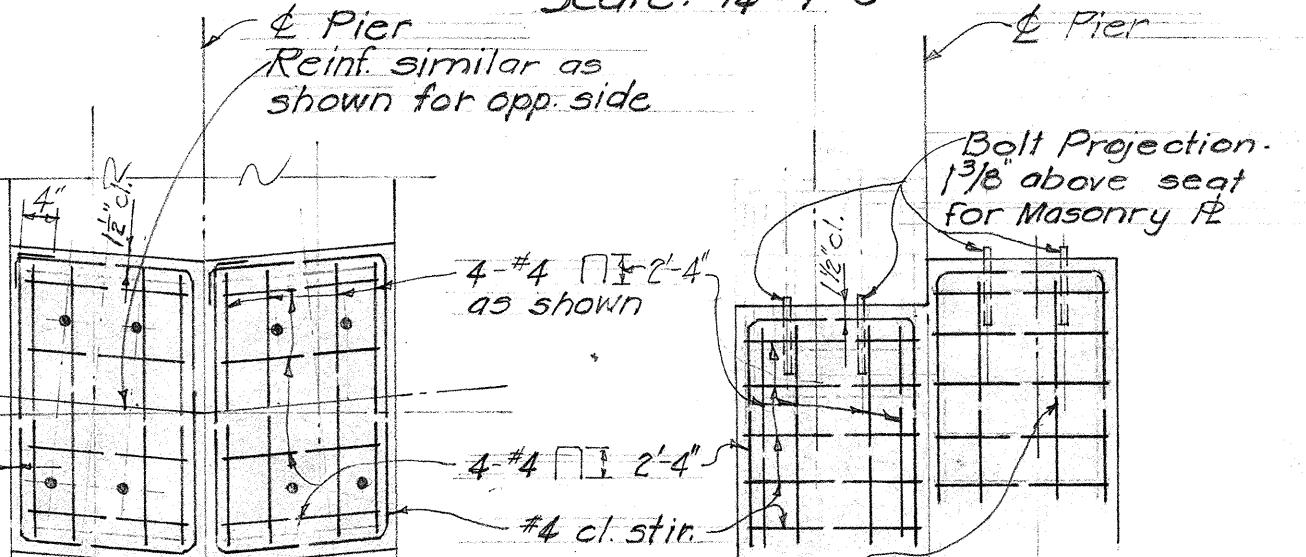

SECTION

TYPICAL CONCRETE SEAT
REINFORCING - PIERS N° 2, 4

Scale: $\frac{1}{2}'' = 1'-0''$

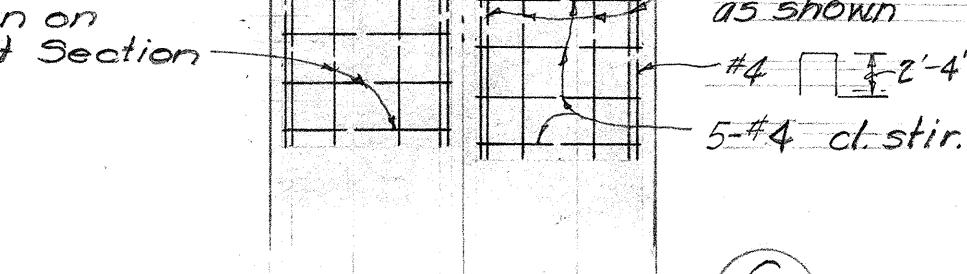

ALTERNATE "B"

DEPARTMENT OF TRANSPORTATION
DIVISION OF HIGHWAYS
STATE OF HAWAII

STRUCTURE N° 5
KALIHIWAY BRIDGE
STA. 2G+57.88 TO STA. 34+56.12
KAUAI BELT ROAD PROJ. ER-7(1)
FEBRUARY 1961 - UNIT 2



SHEET NO. 9 OF 11 SHEETS

ORIGINAL	PIOTTED BY
PLAN	DRAWN BY
TRACED BY	QUANTITIES CHECKED BY
NOTE BOOK NO.	CHECKED BY

Notes:
Important! Top of all concrete seats to have hard steel trowel finish to receive steel bearings.

TOP PLAN
PIERS N° 1, 3, 5, 7

Scale: $\frac{3}{8}'' = 1'-0''$

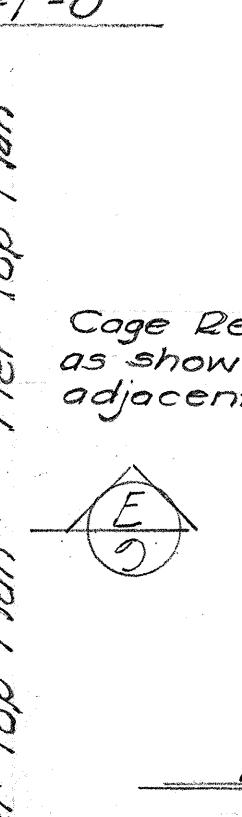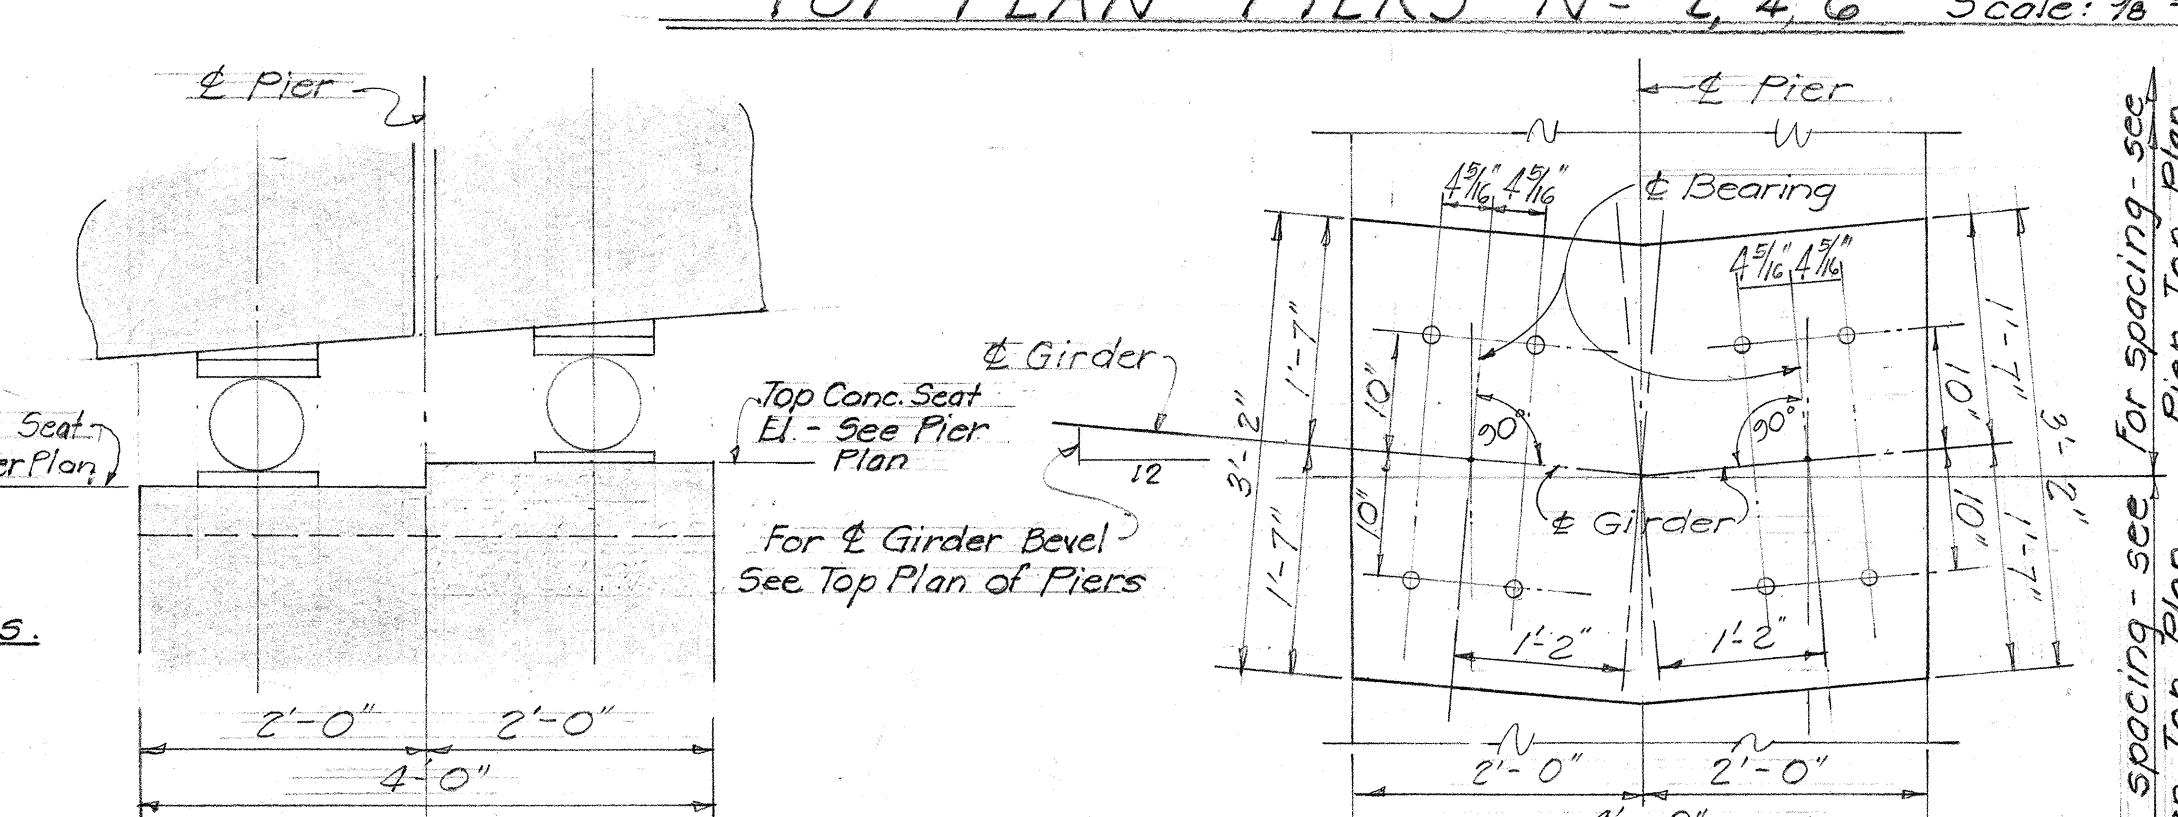


SECTION

TYPICAL CONCRETE SEAT
REINFORCING - PIERS N° 1, 3, 5, 6

Scale: $\frac{3}{4}'' = 1'-0''$


TYPICAL CONCRETE SEAT DETAIL - PIER N° 6 scale: $\frac{3}{4}'' = 1'-0''$

FED. ROAD DIST. NO.	STATE	FED. AID PROJ. No.	FISCAL YEAR	SHEET NO.	TOTAL SHEETS
HAWAII	HAW.	ER-7(1) Unit 2	1961	43	77

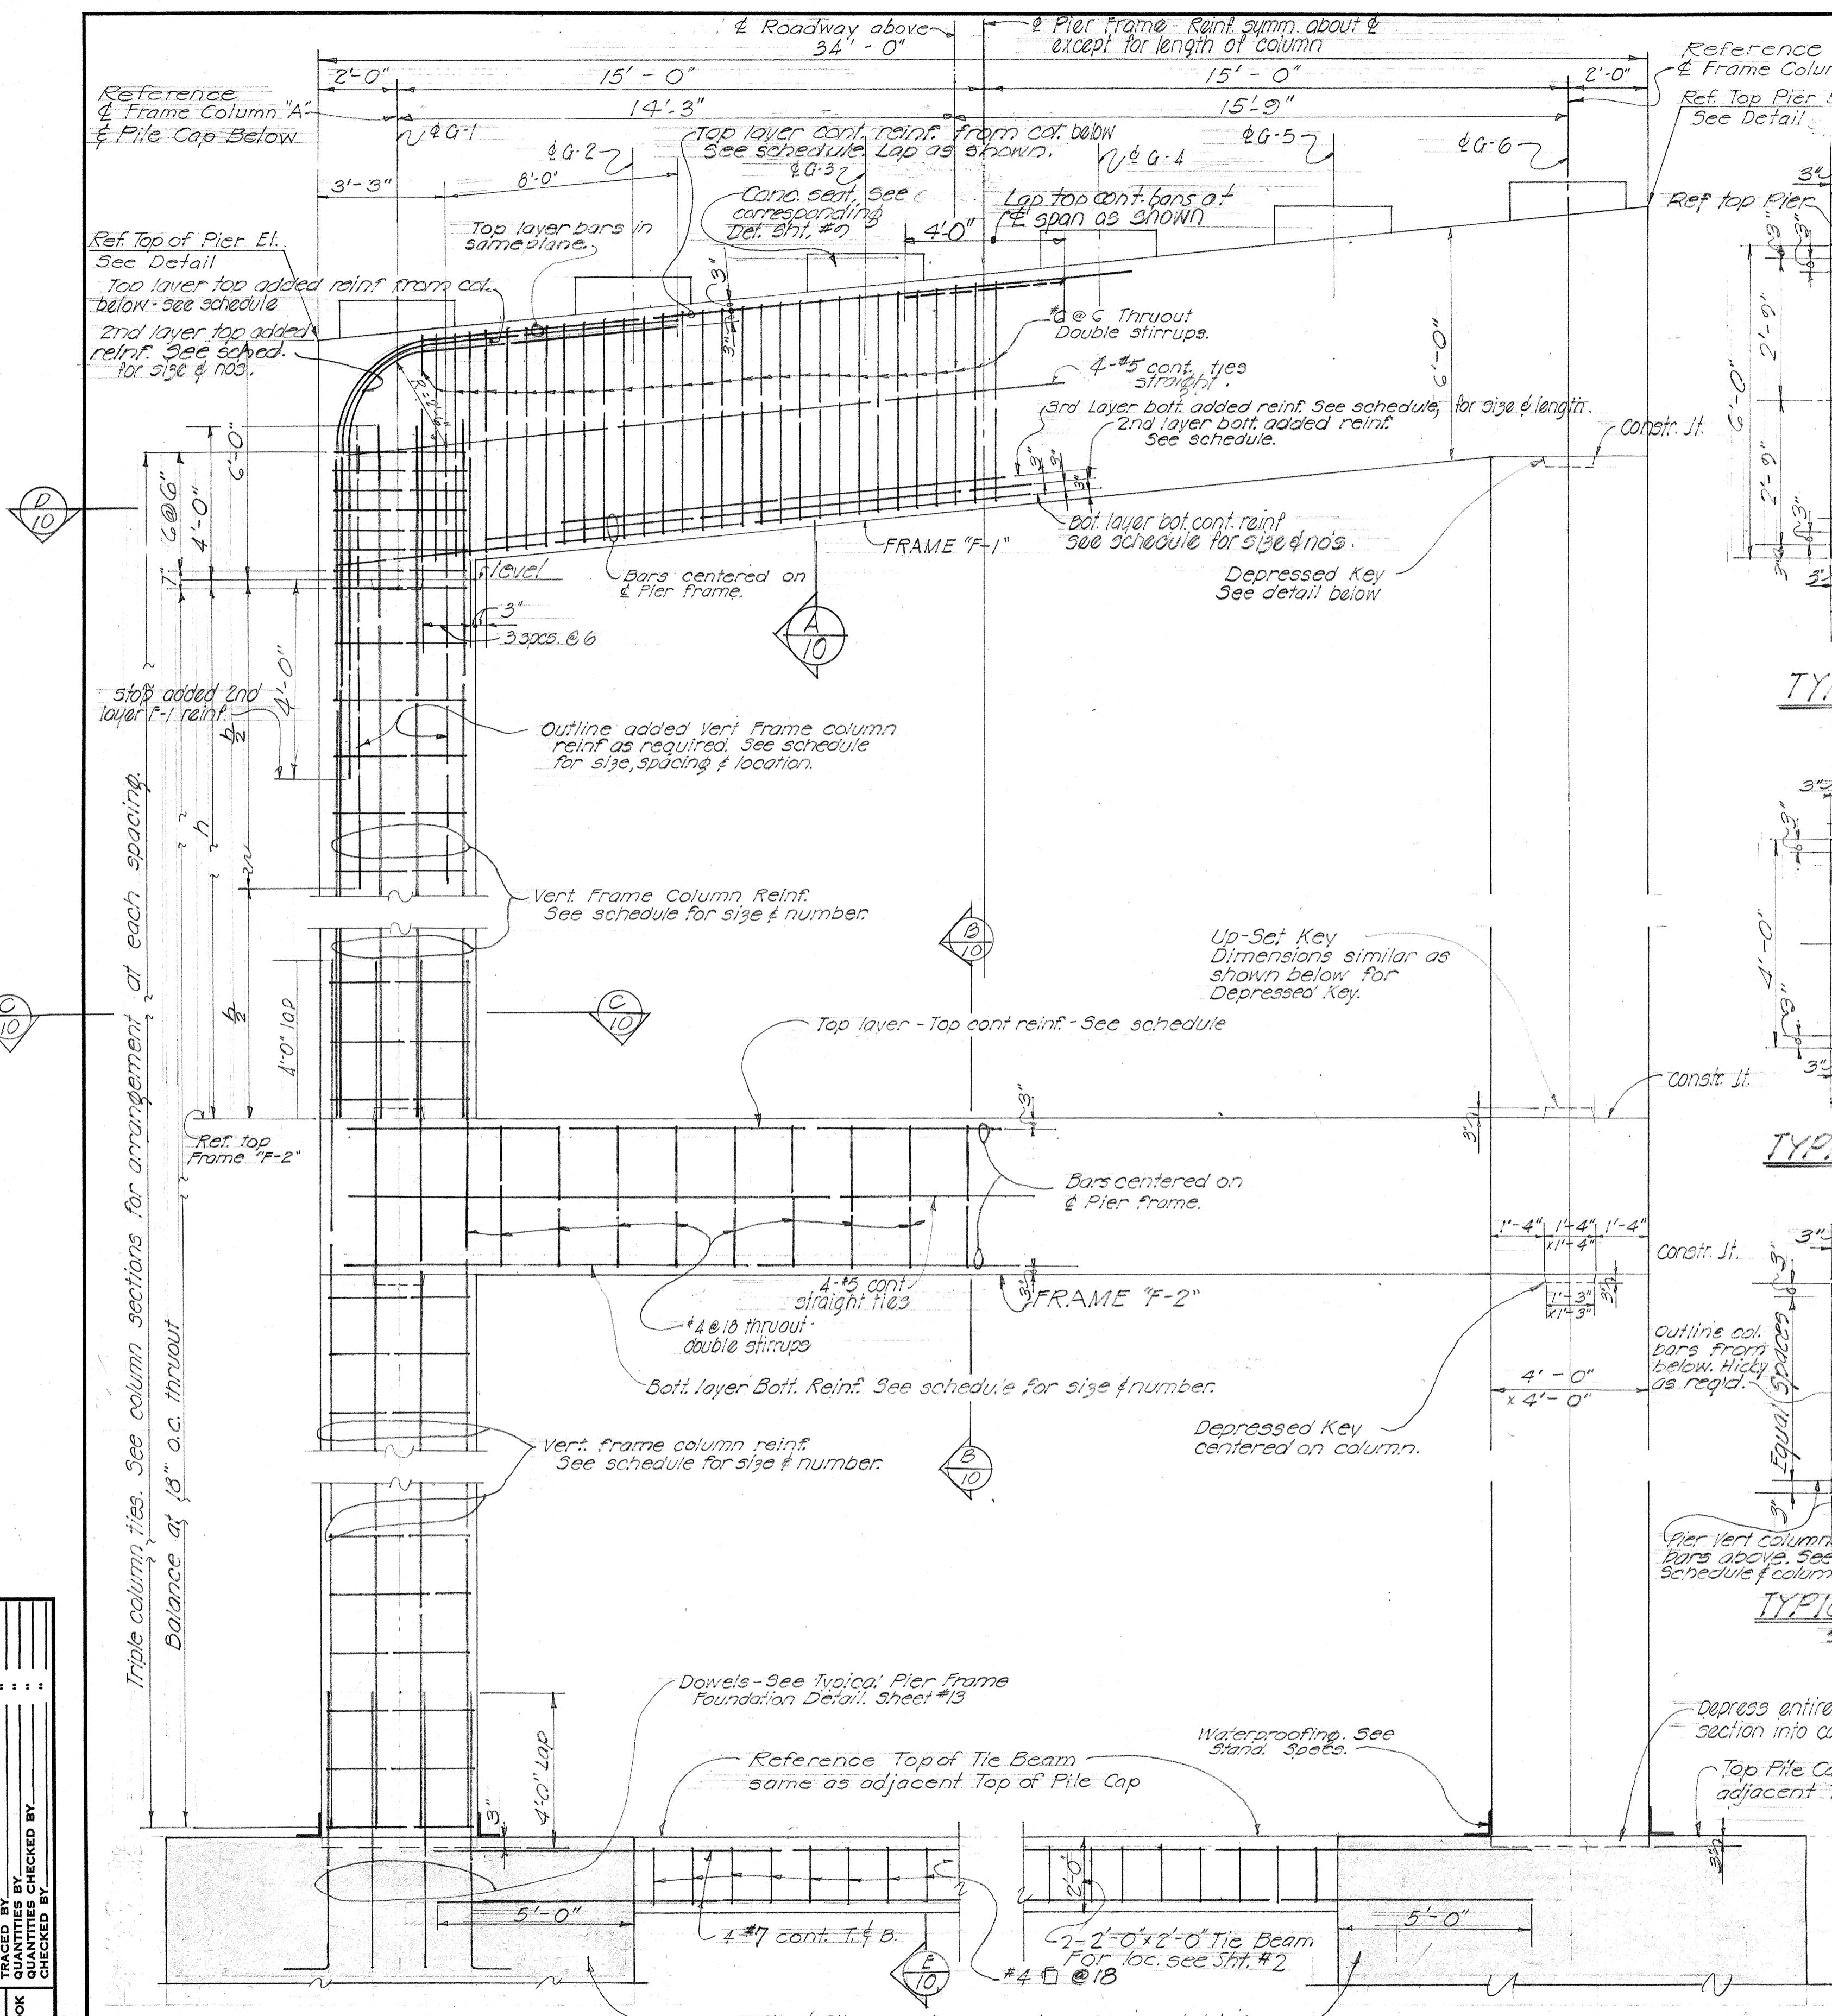

SHOWING HALF FRAME REIN. SHOWING HALF
TYPICAL PIER #1 THRU #7 FRAME DETAIL


Note: See sheet #11 pier frame and pier frame column schedule

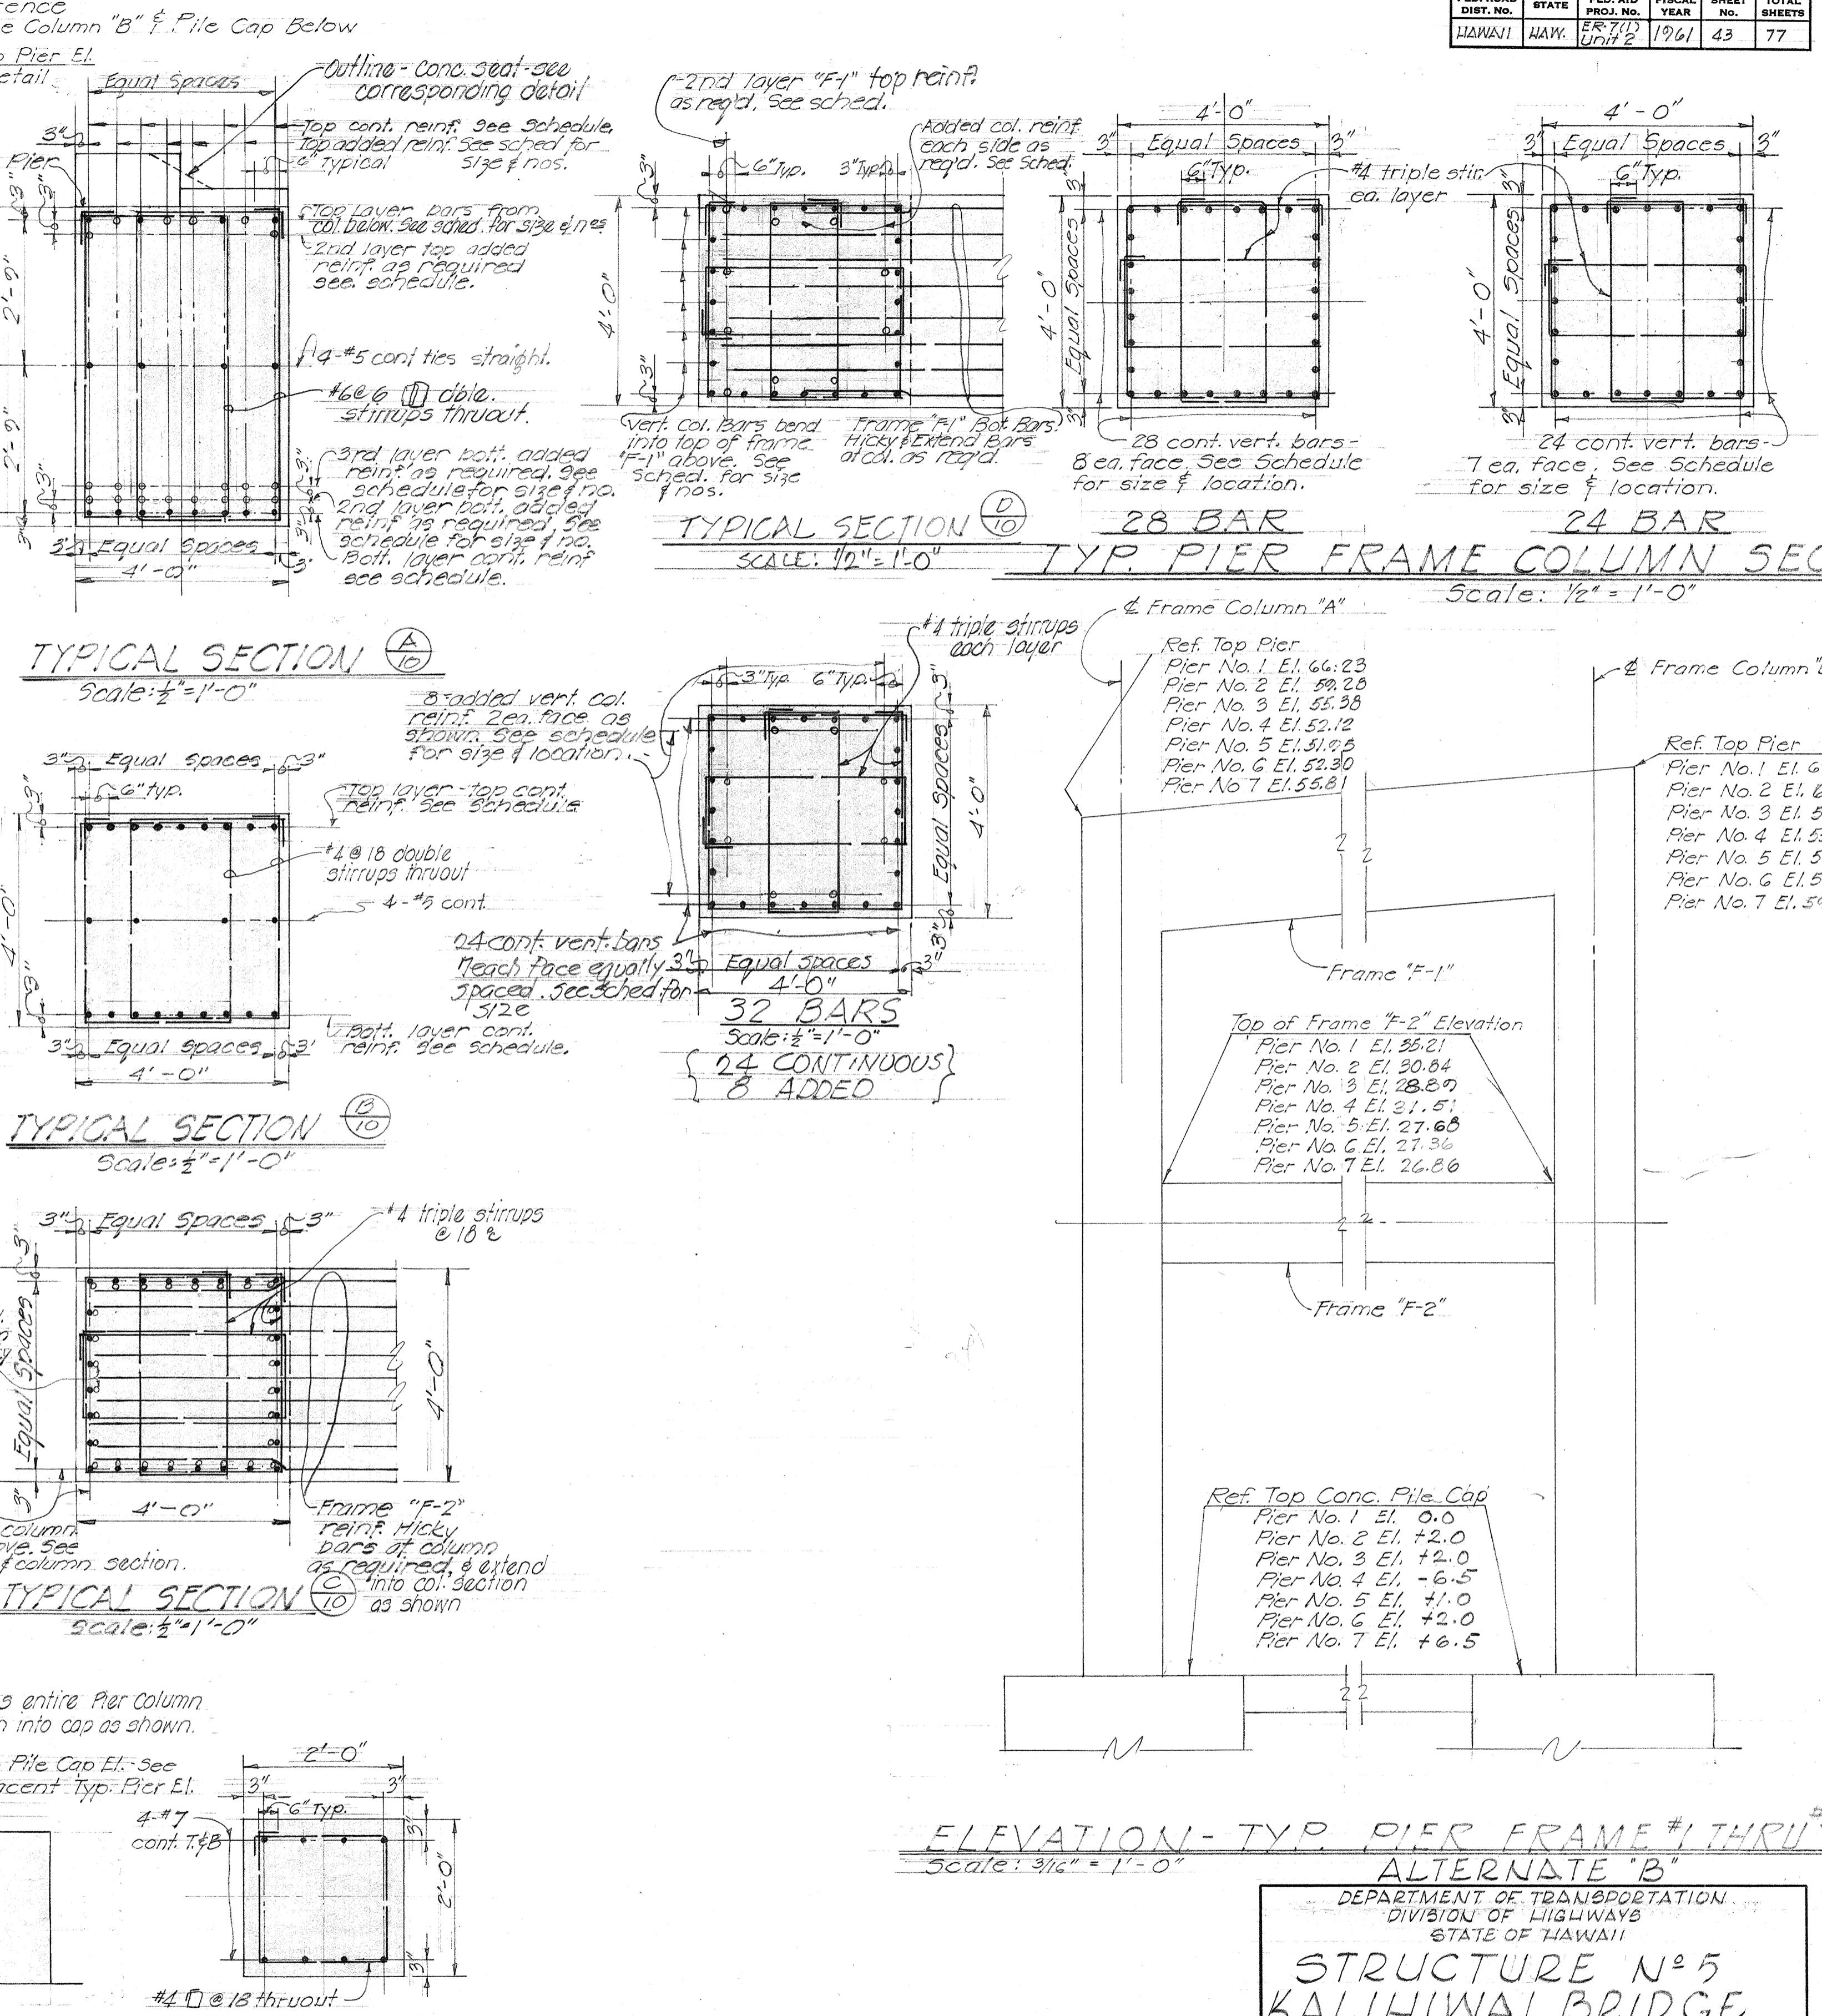


EL E V A T I O N - T Y P. P I E R F R A M E #1 T H R U #

ALTERNATE B
DEPARTMENT OF TRANSPORTATION
DIVISION OF HIGHWAYS
STATE OF HAWAII
STRUCTURE N° 5
LIHIWAI BRIDGE
26+57.88 TO STA. 34+56.12
AI BELT ROAD PROJ. ER-7(1)
FEBRUARY 1961
UNIT 2

SHEET No. 10 OF 12 SHEETS


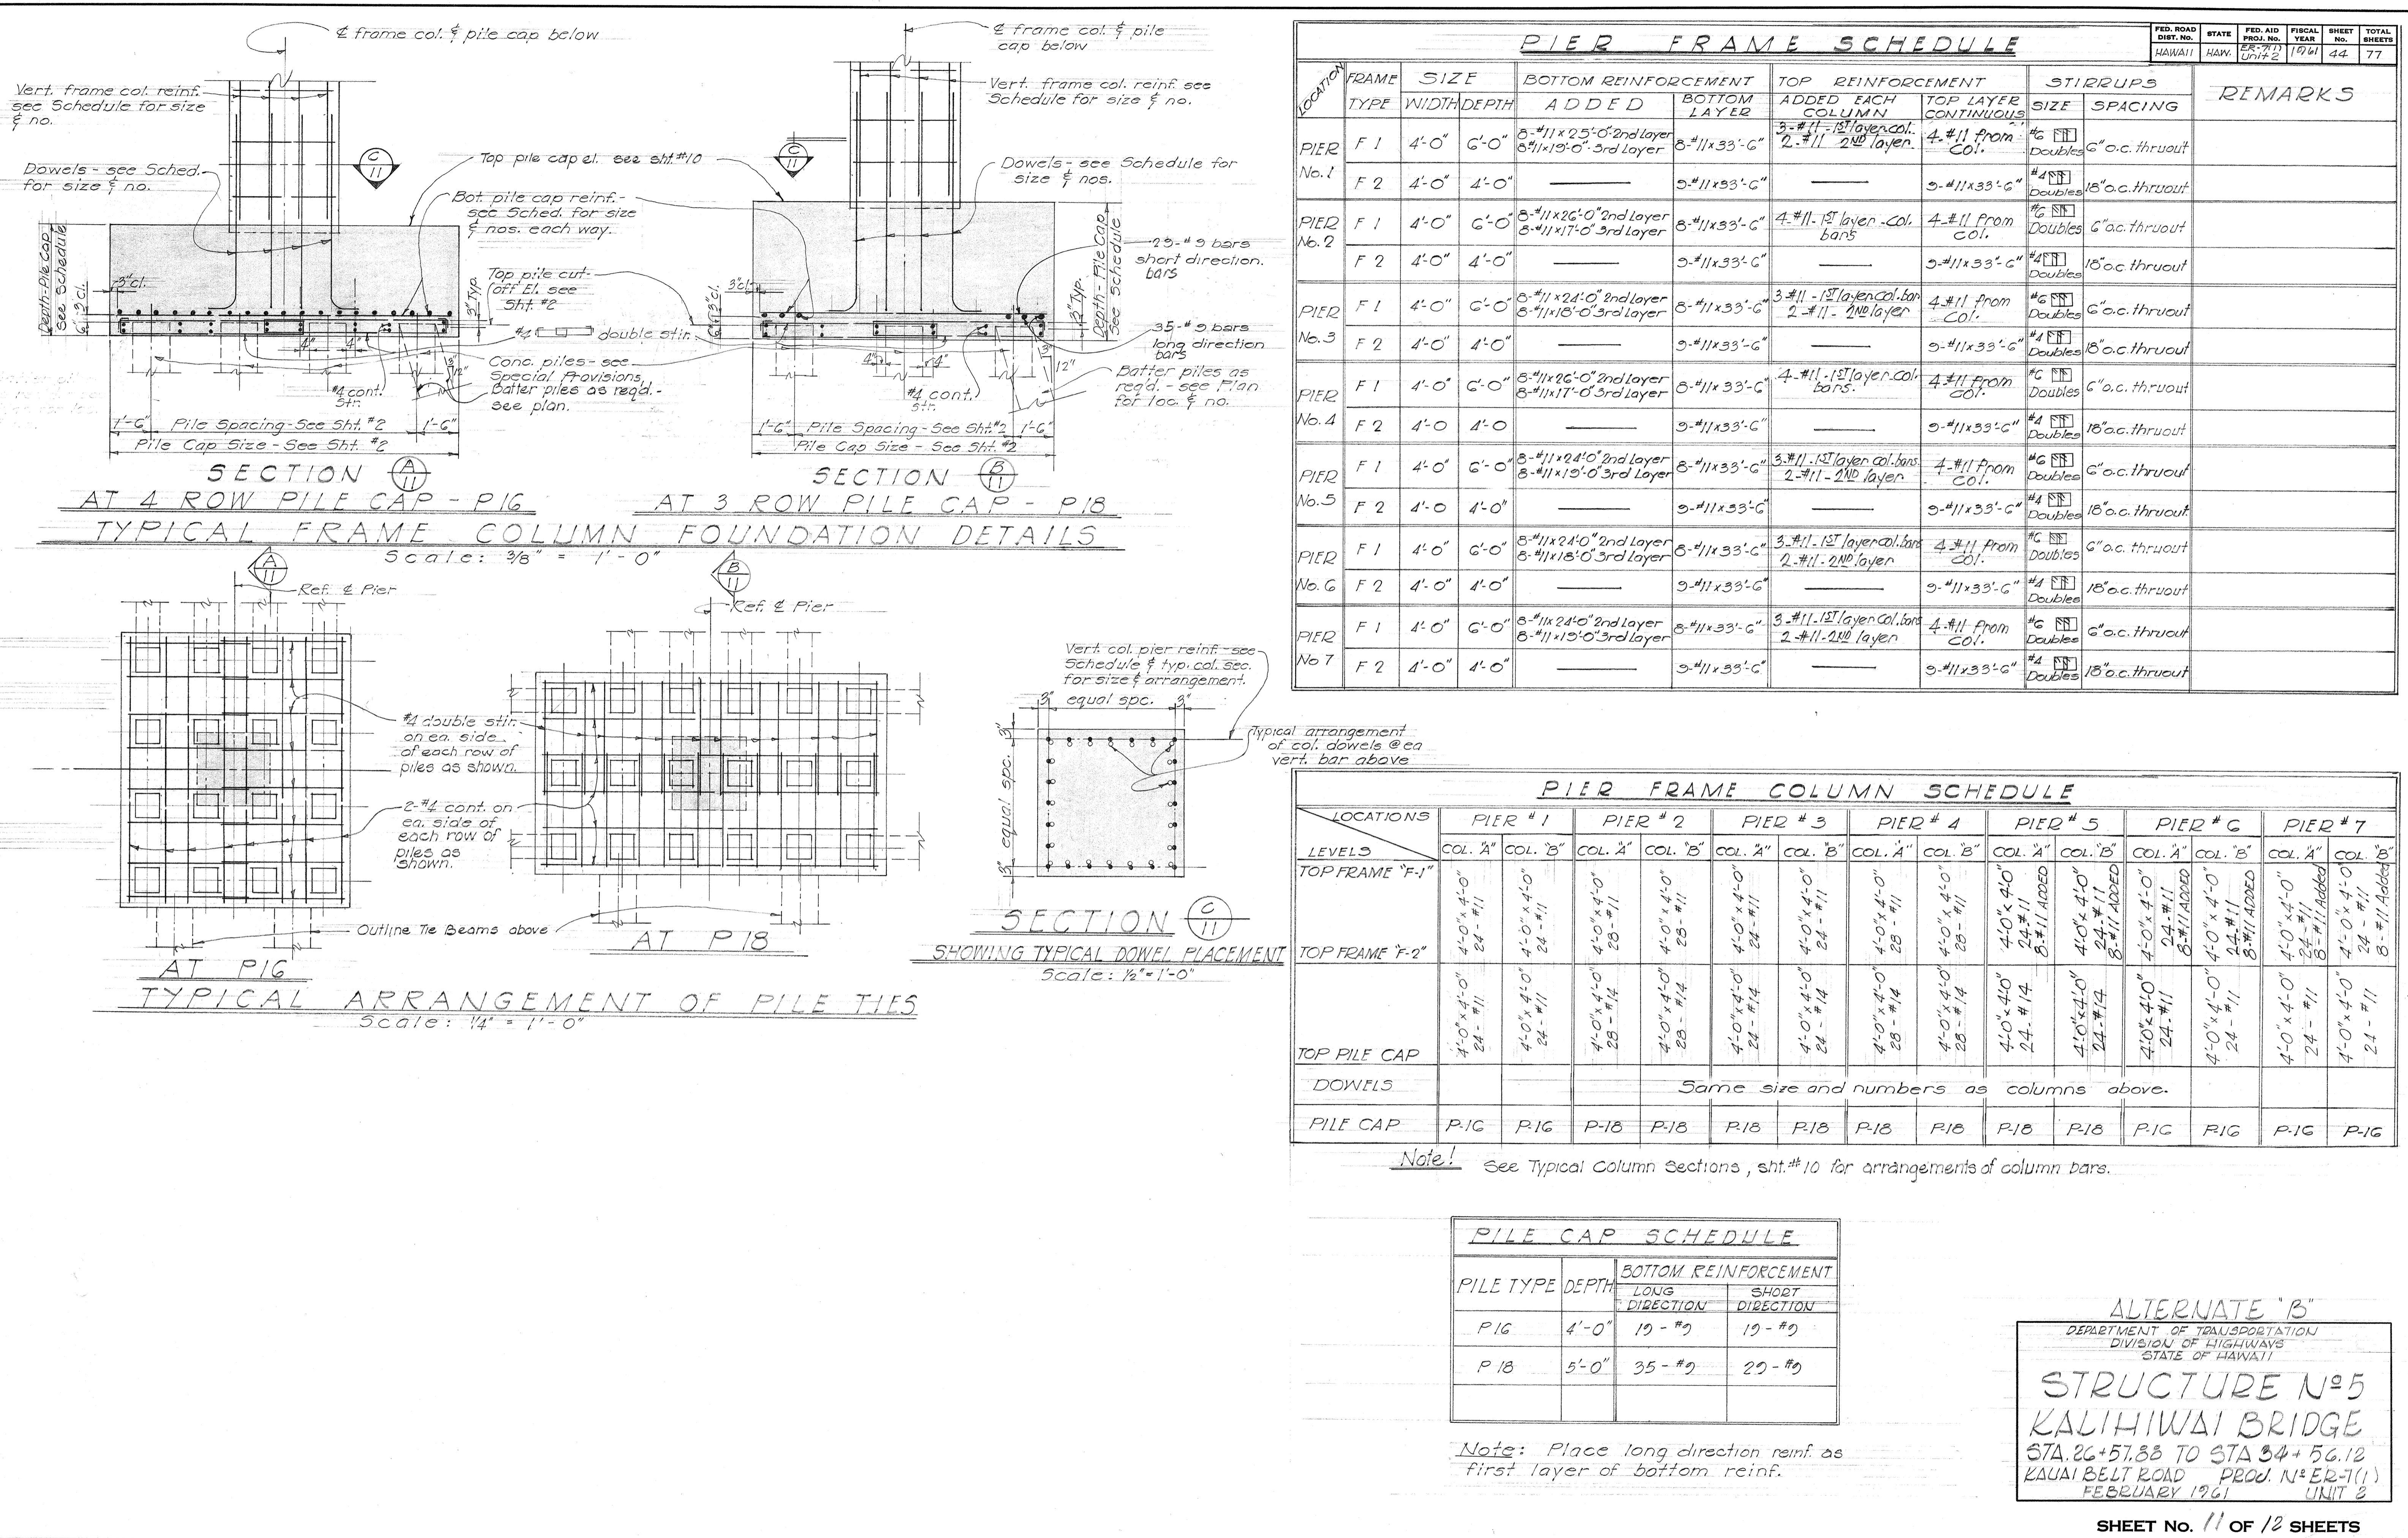


ORIGINAL PLAN
SURVEY PLOTTED BY _____
DESIGNED BY _____
DRAWN BY _____
TRACED BY _____
QUANTITIES CHECKED BY _____
CHECKED BY _____
NOTE BOOK NO. _____

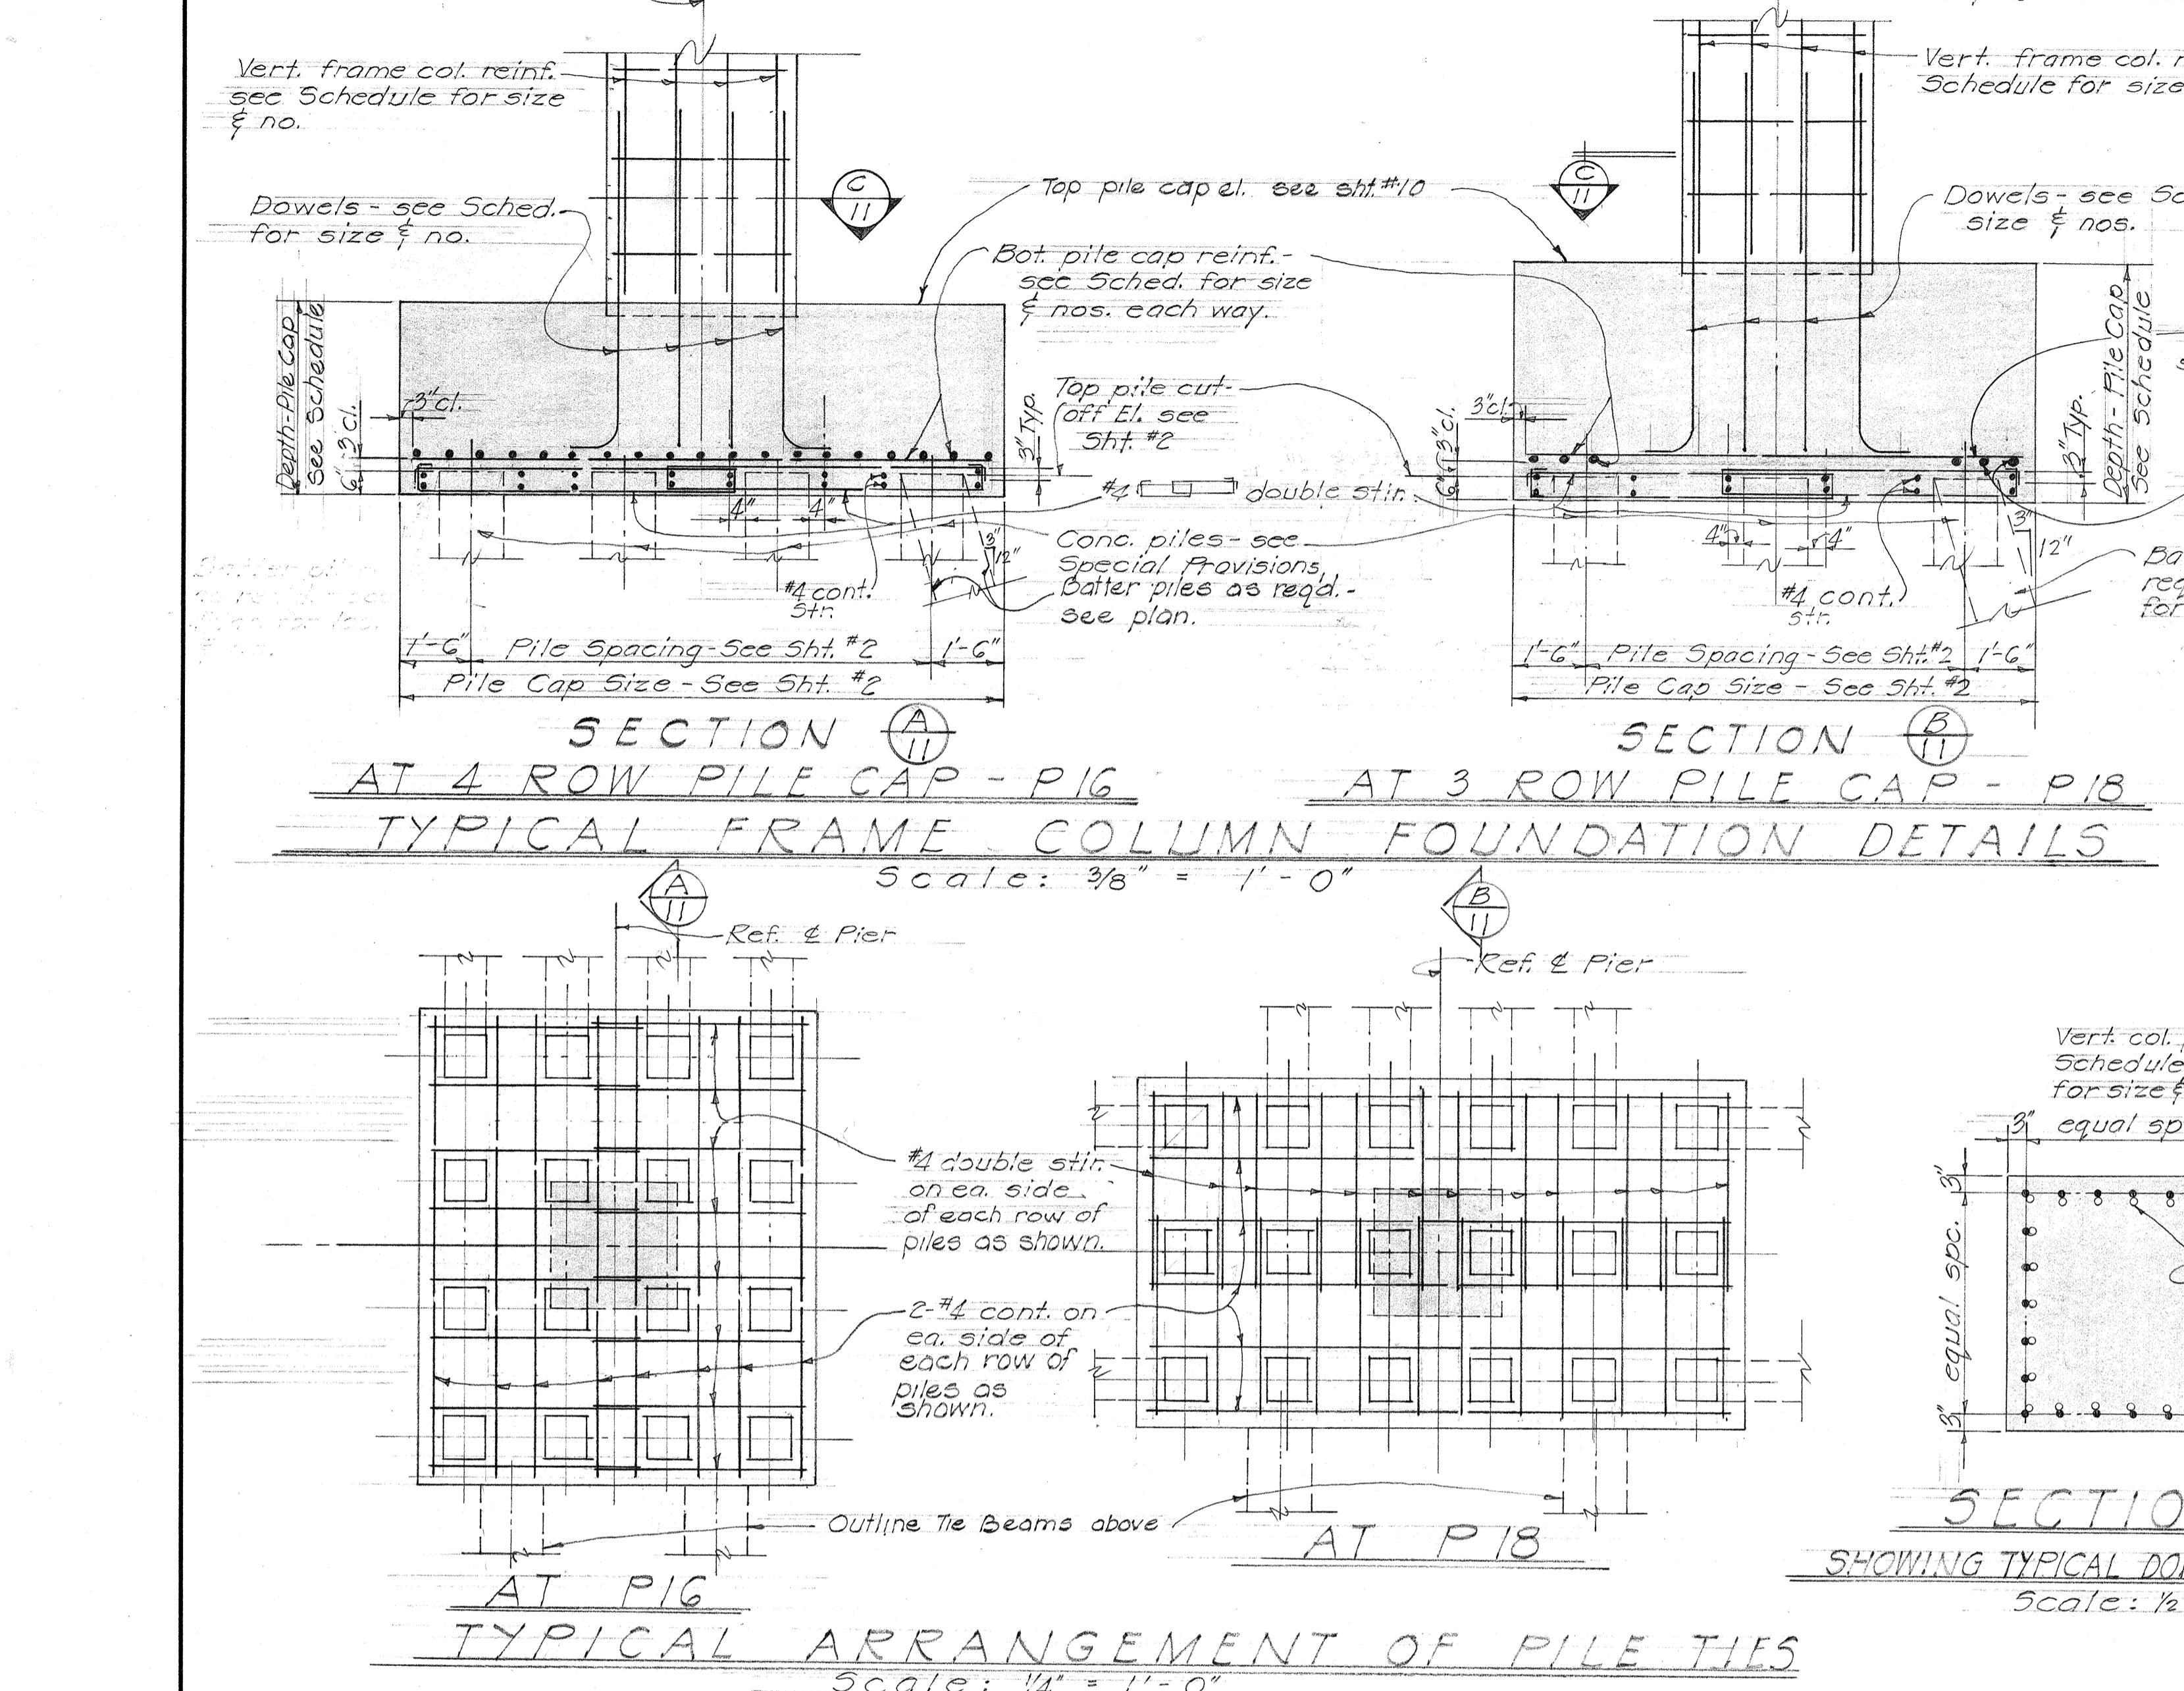

Note! See Typical Column Sections, shft #10 for arrangements of column bars.


FED. ROAD DIST. NO.	STATE	FED. AID PROJ. NO.	FISCAL YEAR	SHEET NO.	TOTAL SHEETS
HAWAII	HAW.	ER-7(1) Unit 2	1961	45	77

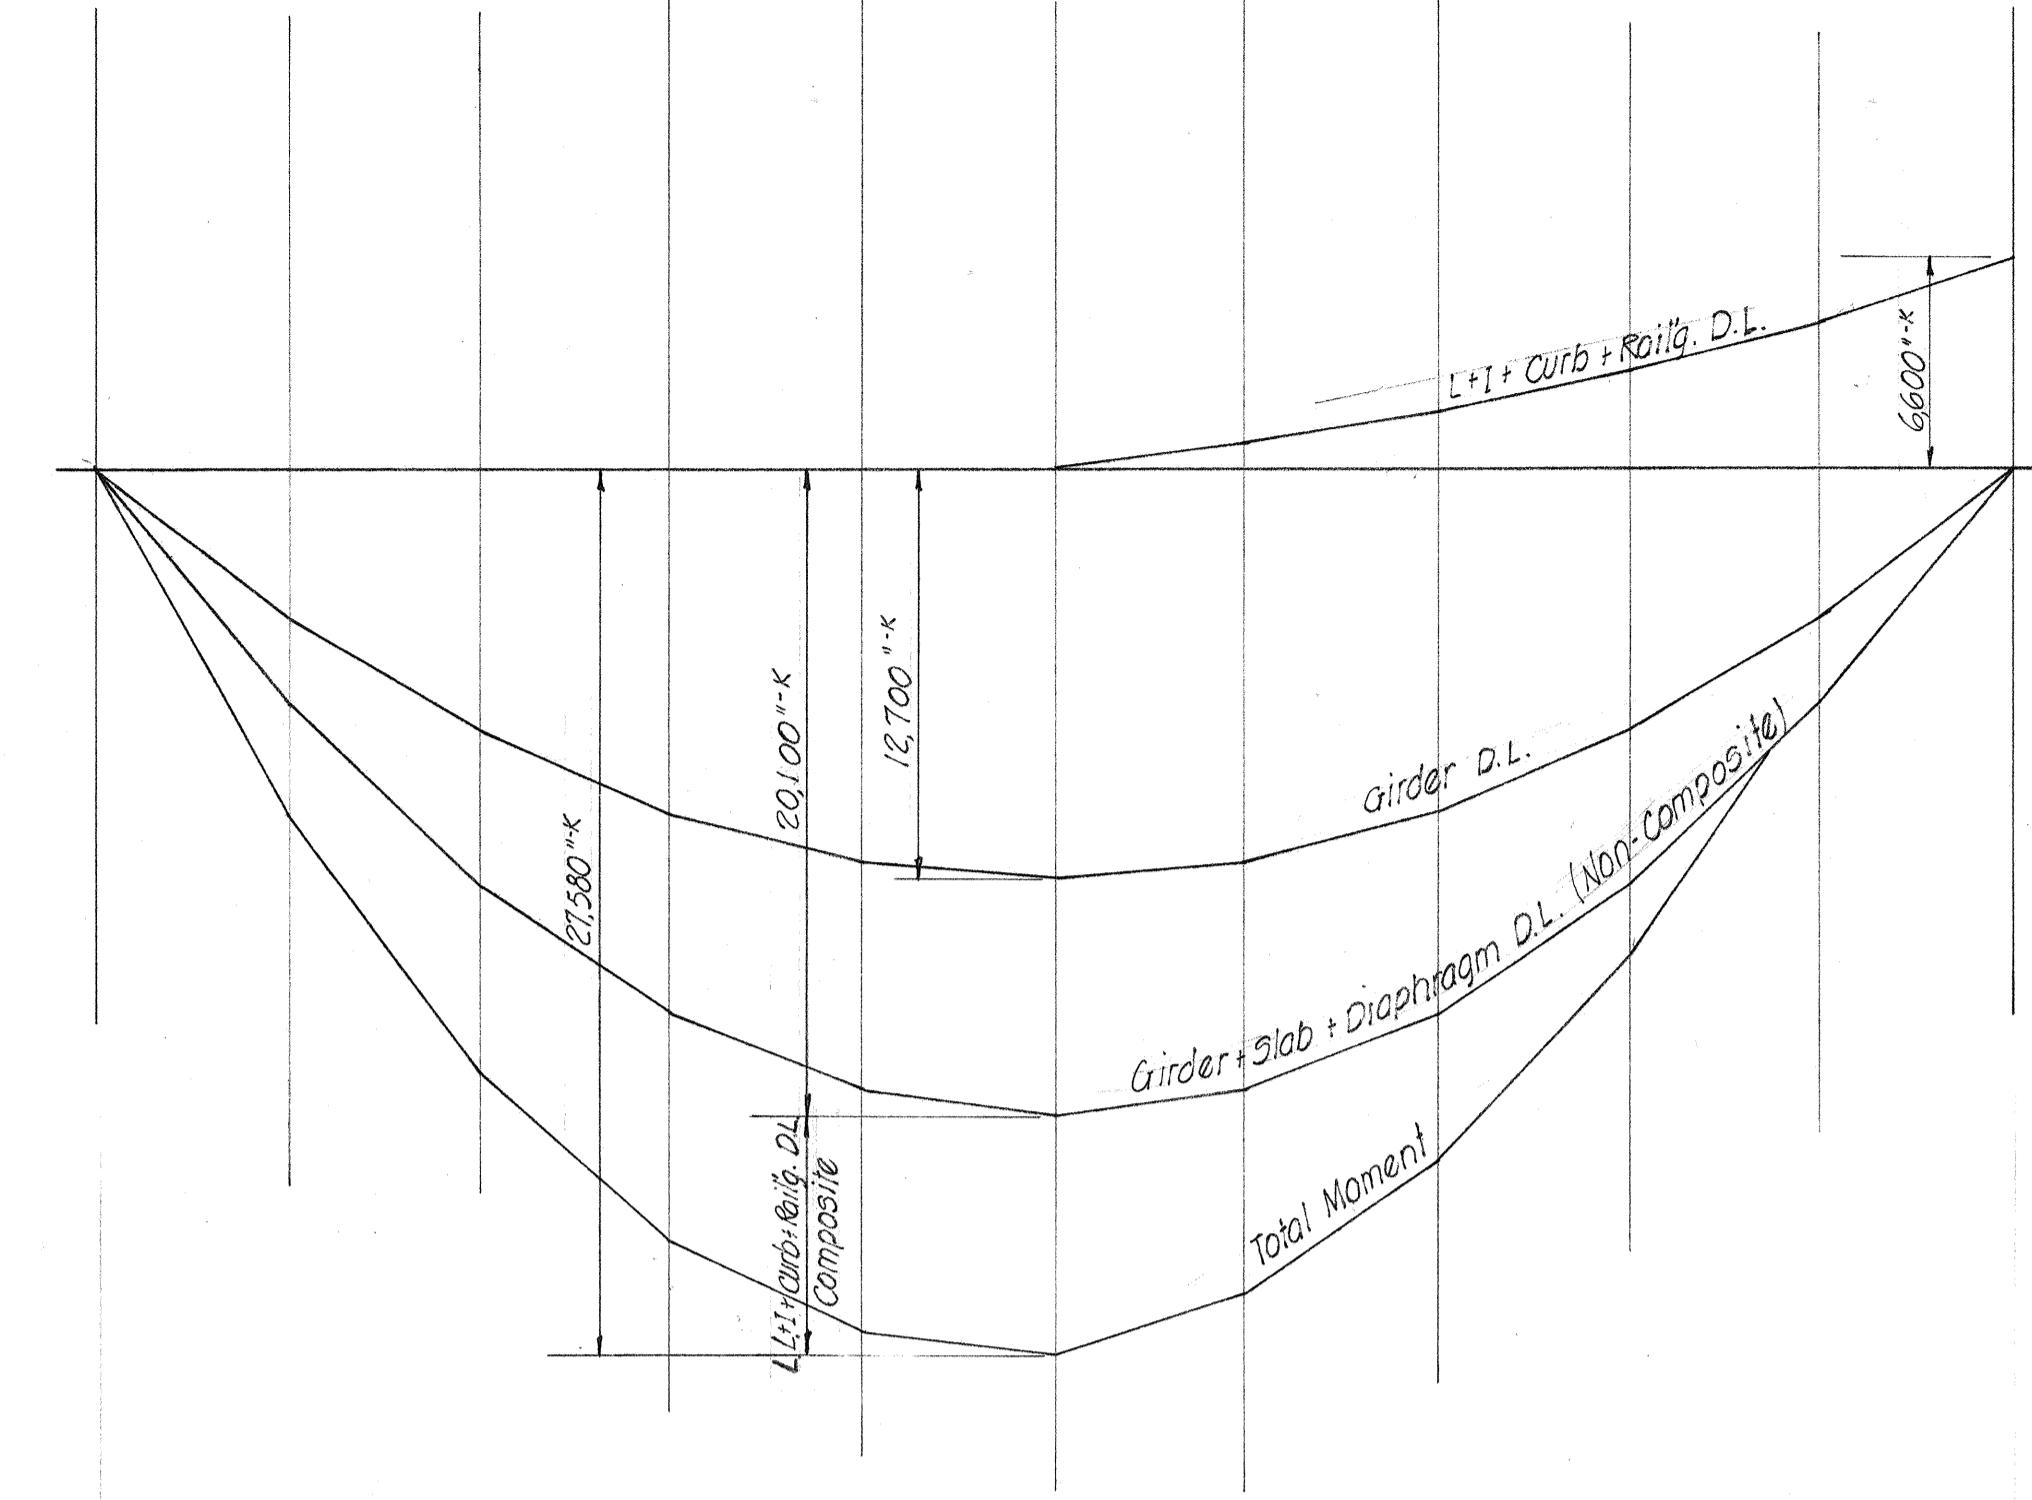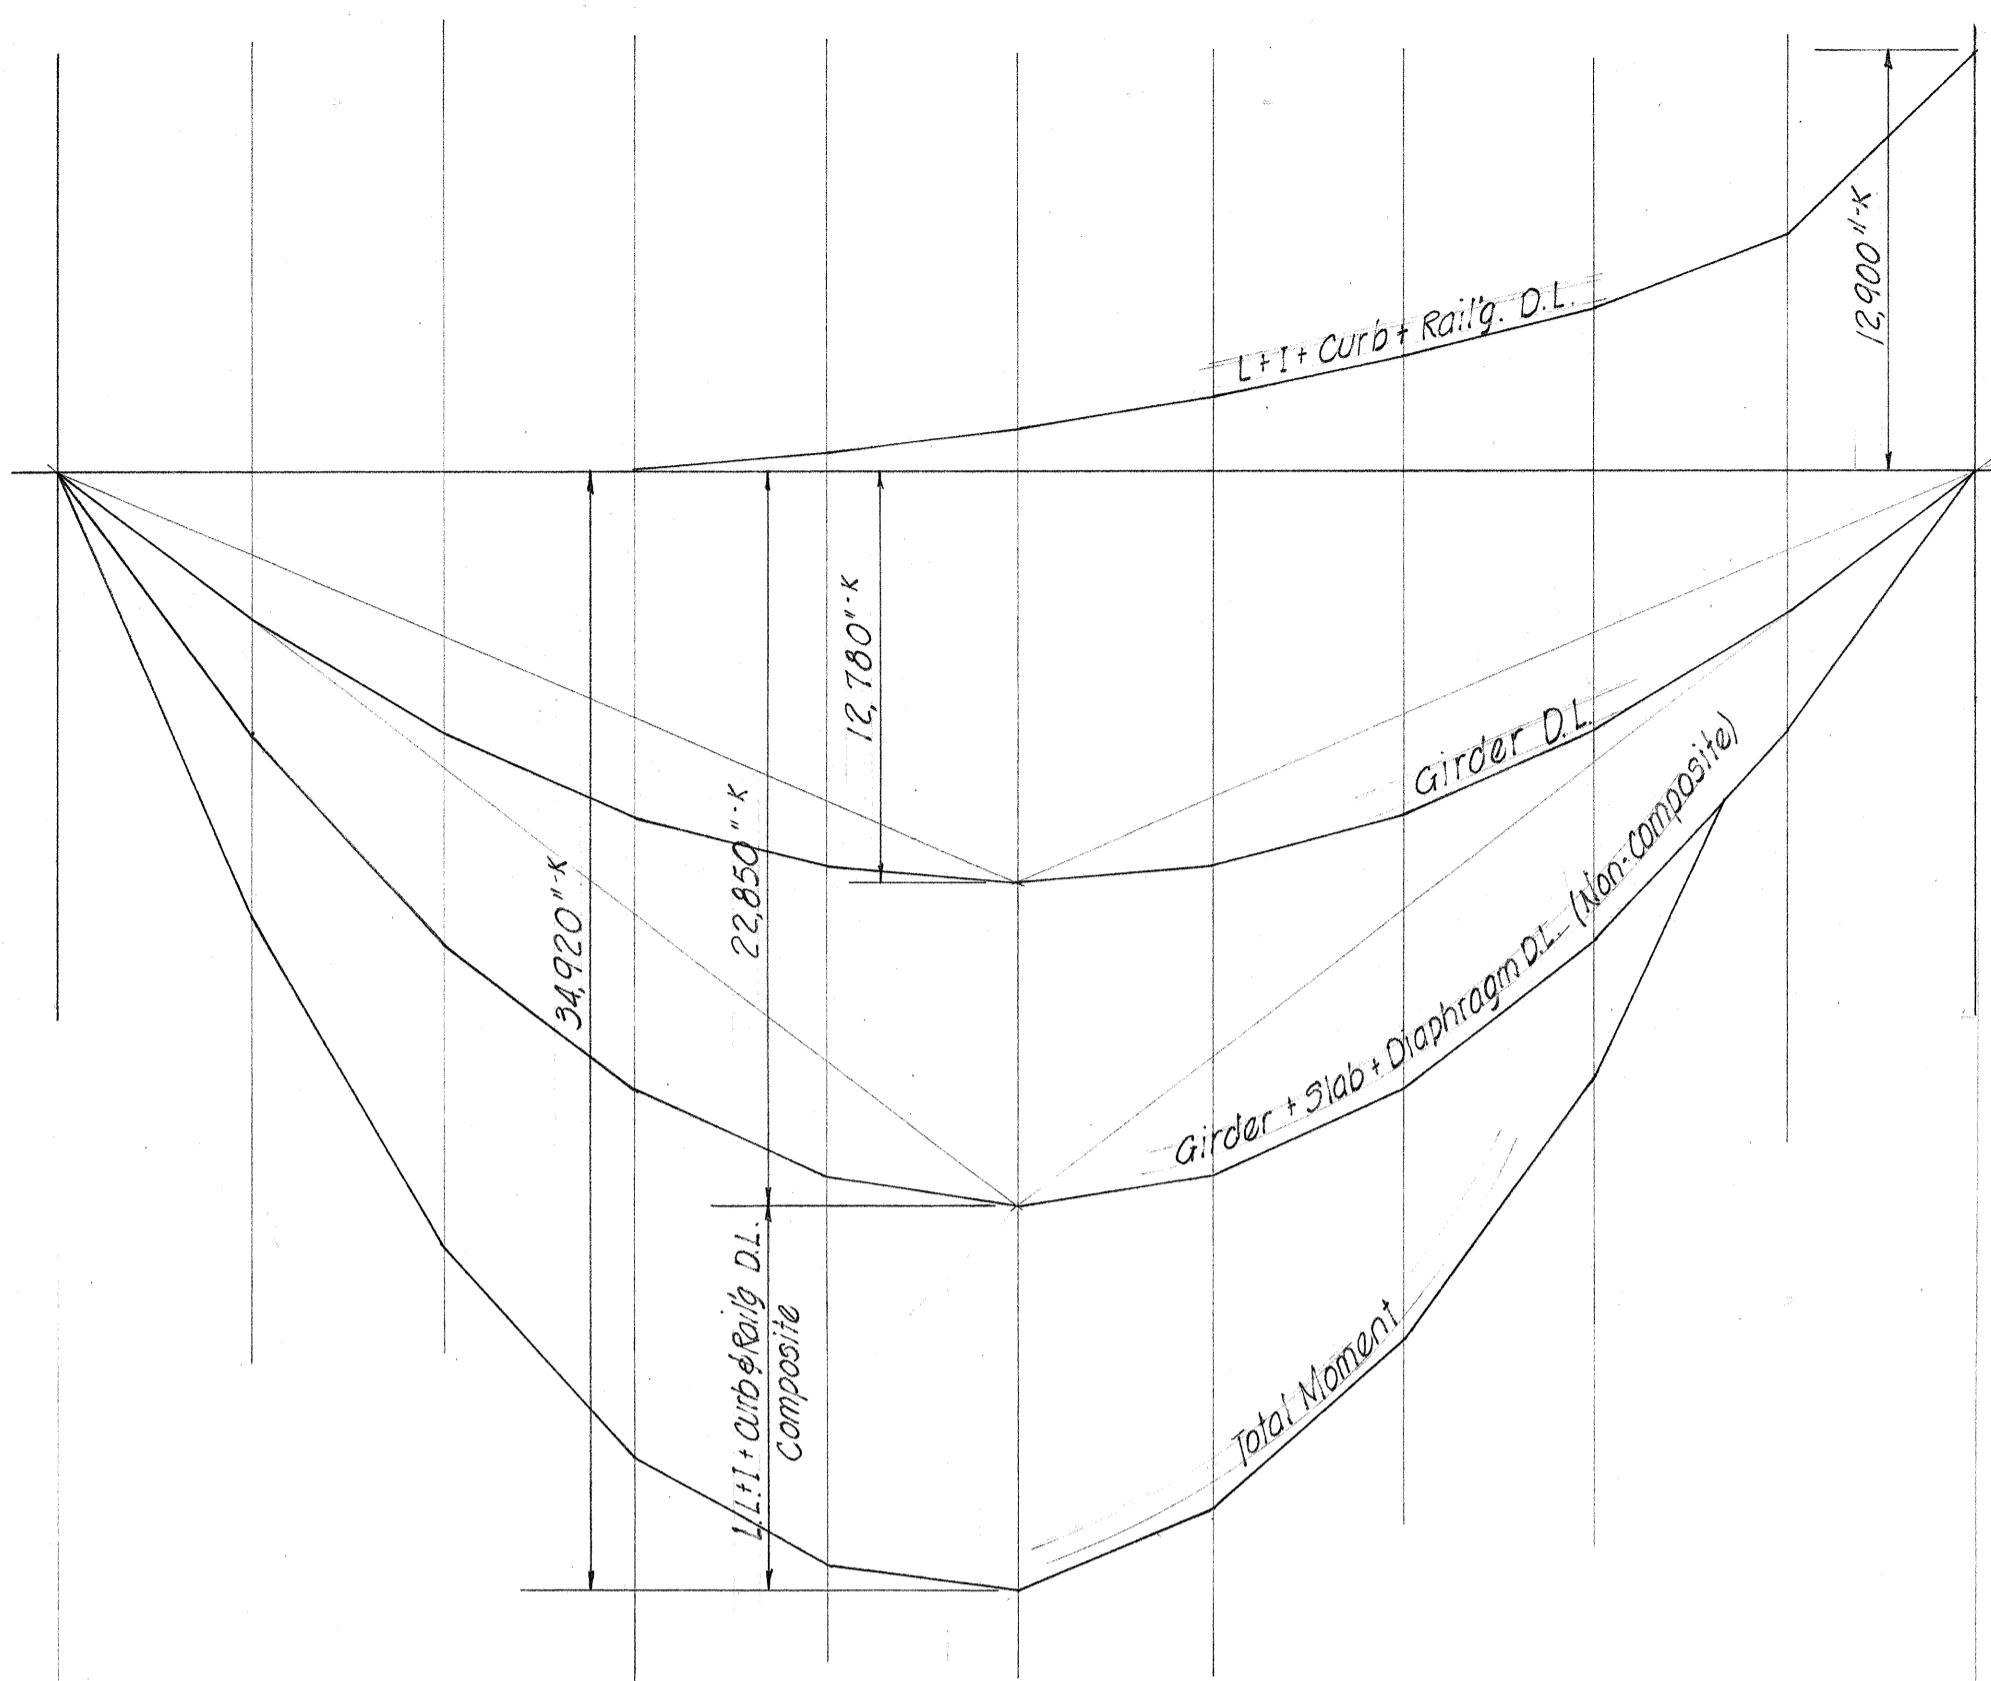

MOMENT DIAGRAM
SCALE: HORIZ.: 1"=10'-0" VERT.: 1"= 6000' KIPS

MOMENT DIAGRAM


SCALE: HORIZ.: 1"=10'-0" VERT.: 1"= 6000' KIPS

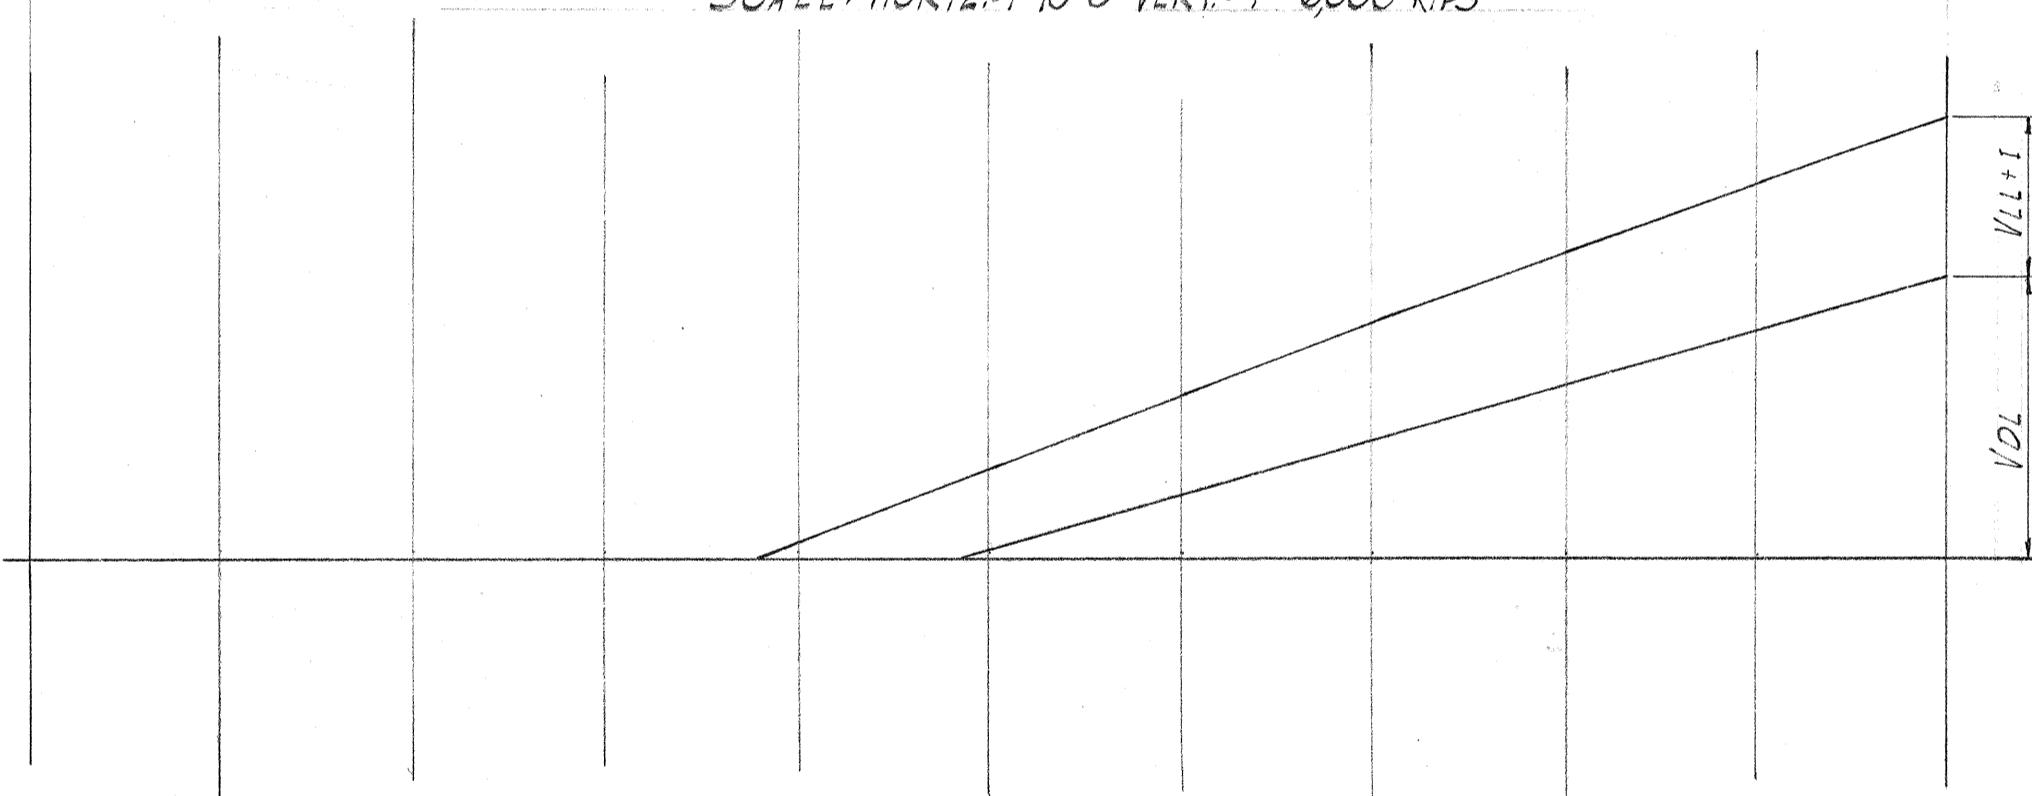

SHEAR DIAGRAM

SCALE: HORIZ.: 1"=10'-0" VERT.: 1"= 60 KIPS

INTERIOR GIRDERS

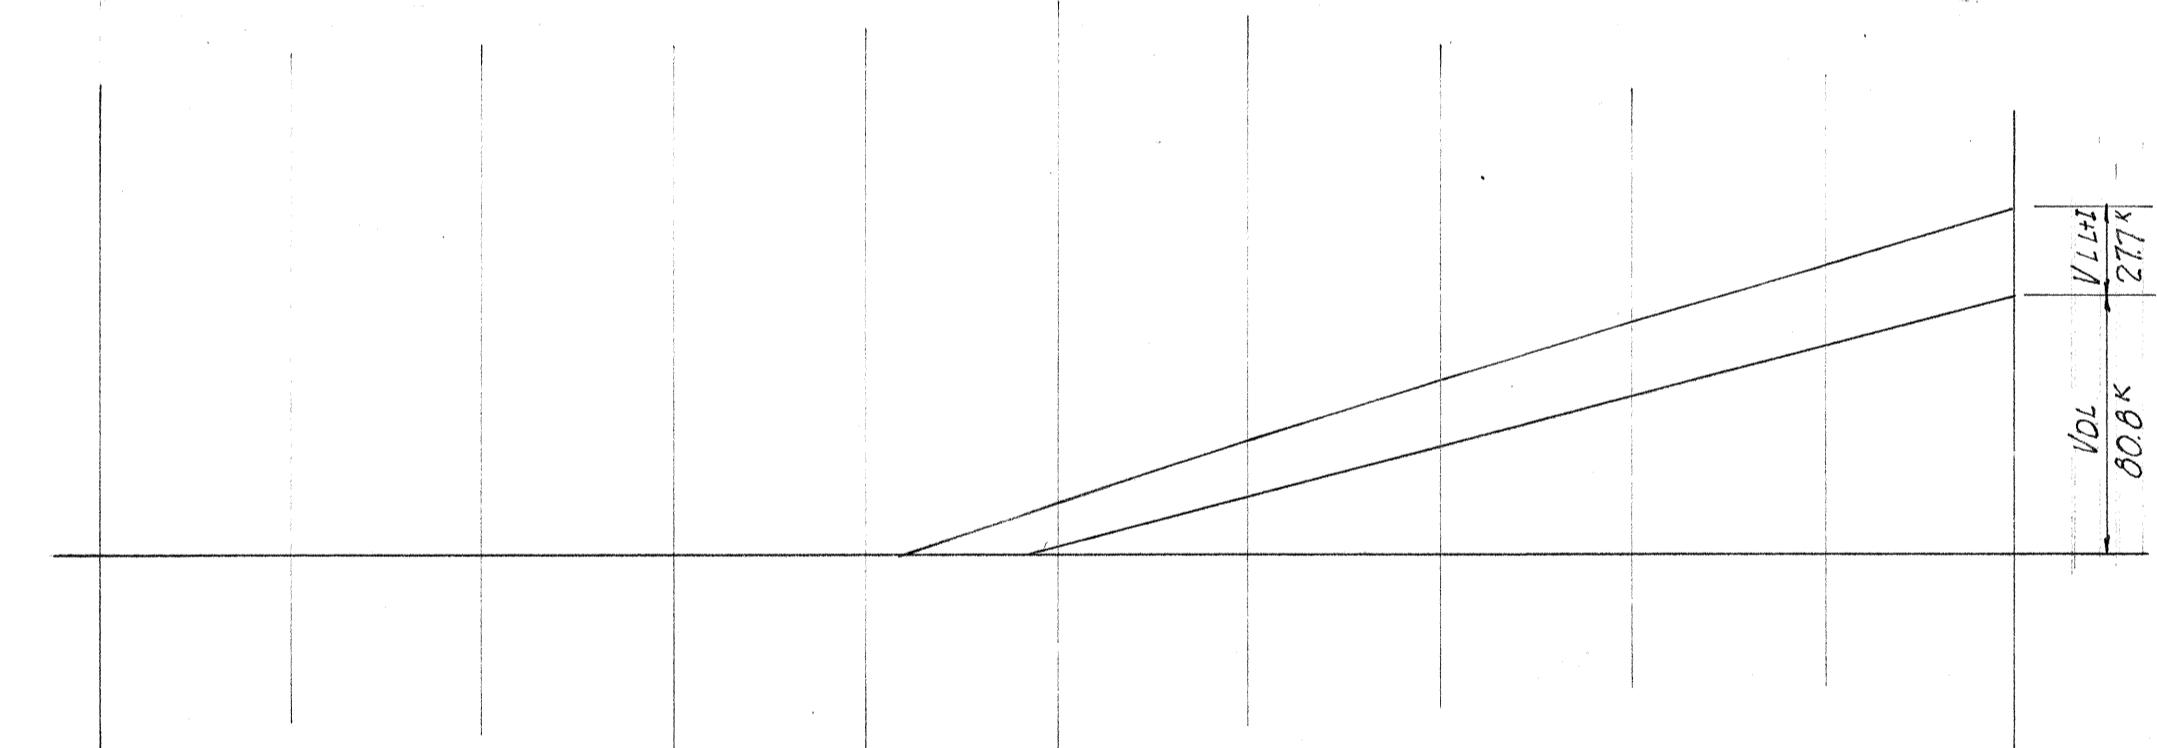

SHEAR DIAGRAM

SCALE: HORIZ.: 1"=10'-0" VERT.: 1"= 60 KIPS

EXTERIOR GIRDERS

ORIGINAL	SURVEY PLOTTED BY
PLAN	DESIGNED BY
NOTE BOOK No.	DRAWN BY
	TRACED BY
	QUADRATICS BY
	CHECKED BY

ALTERNATE "B"
DEPARTMENT OF TRANSPORTATION
DIVISION OF HIGHWAYS
STATE OF HAWAII

STRUCTURE N°5
KALIHIWAI BRIDGE
STA. 26+57.88 TO STA. 34+56.12
KAUAI BELT ROAD PROJ. ER-7(1)
FEBRUARY 1961 UNIT 2