



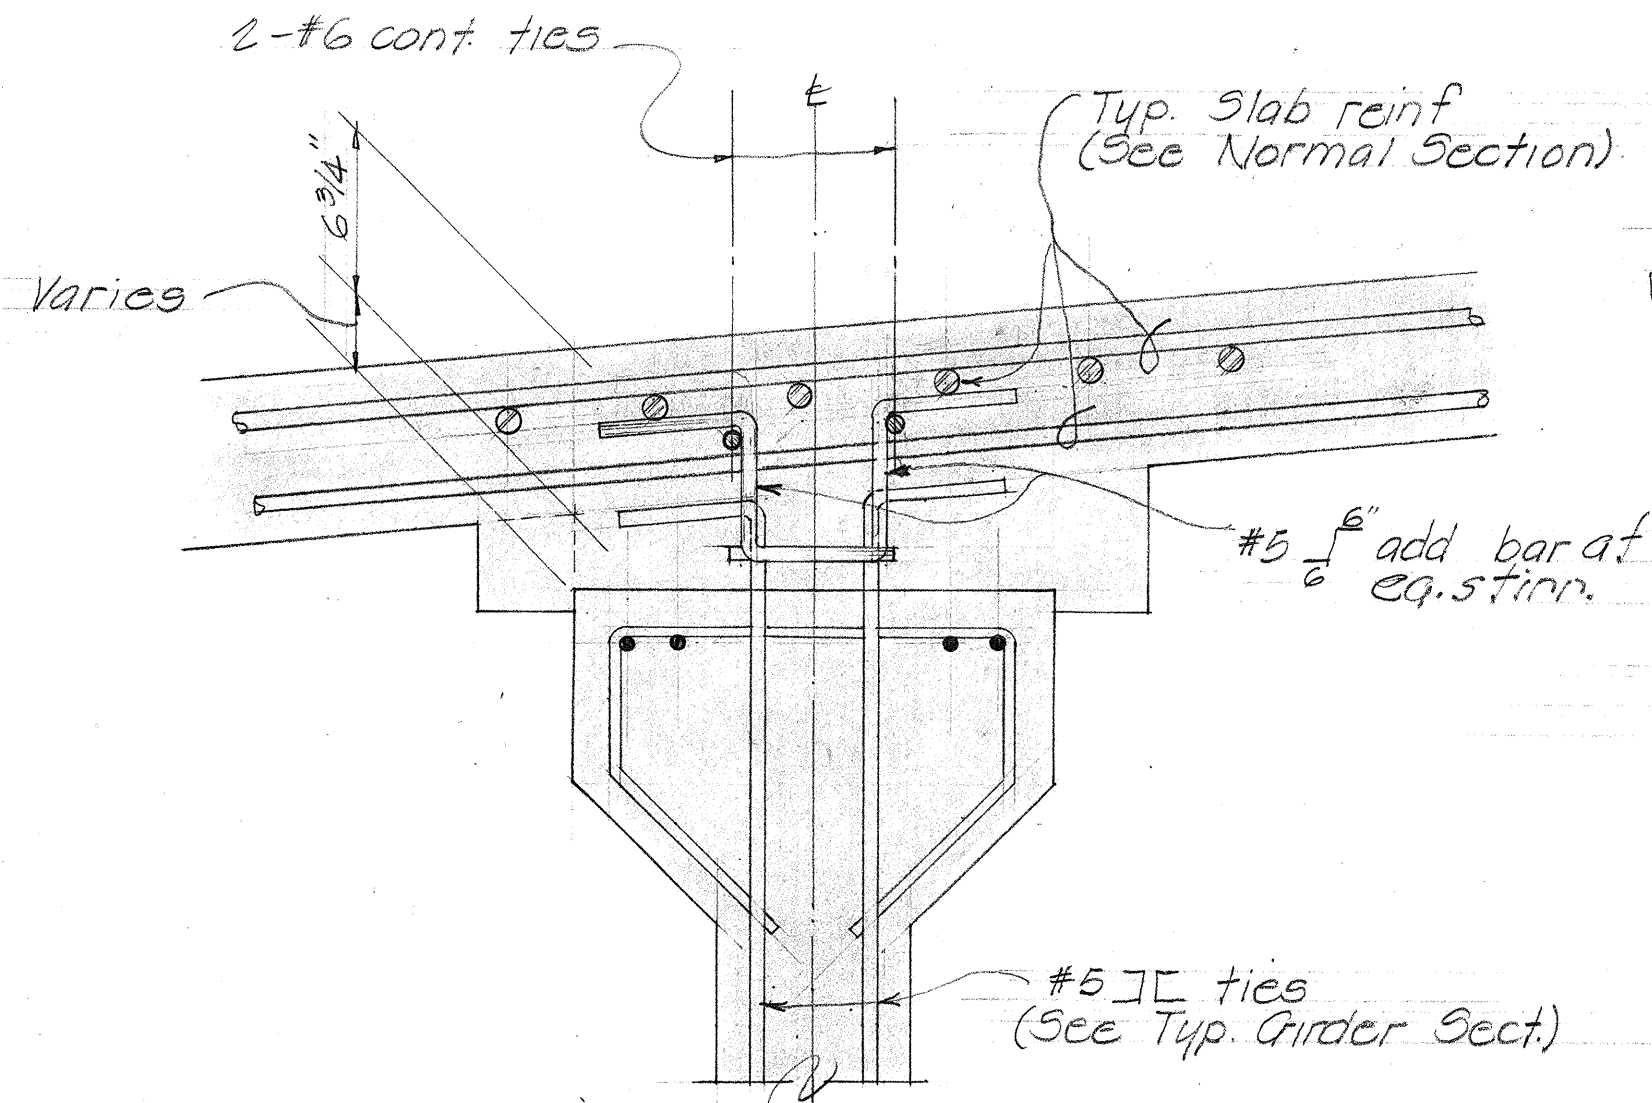

PRESTRESSED GIRDER SECT.
@ INTERMEDIATE SPAN

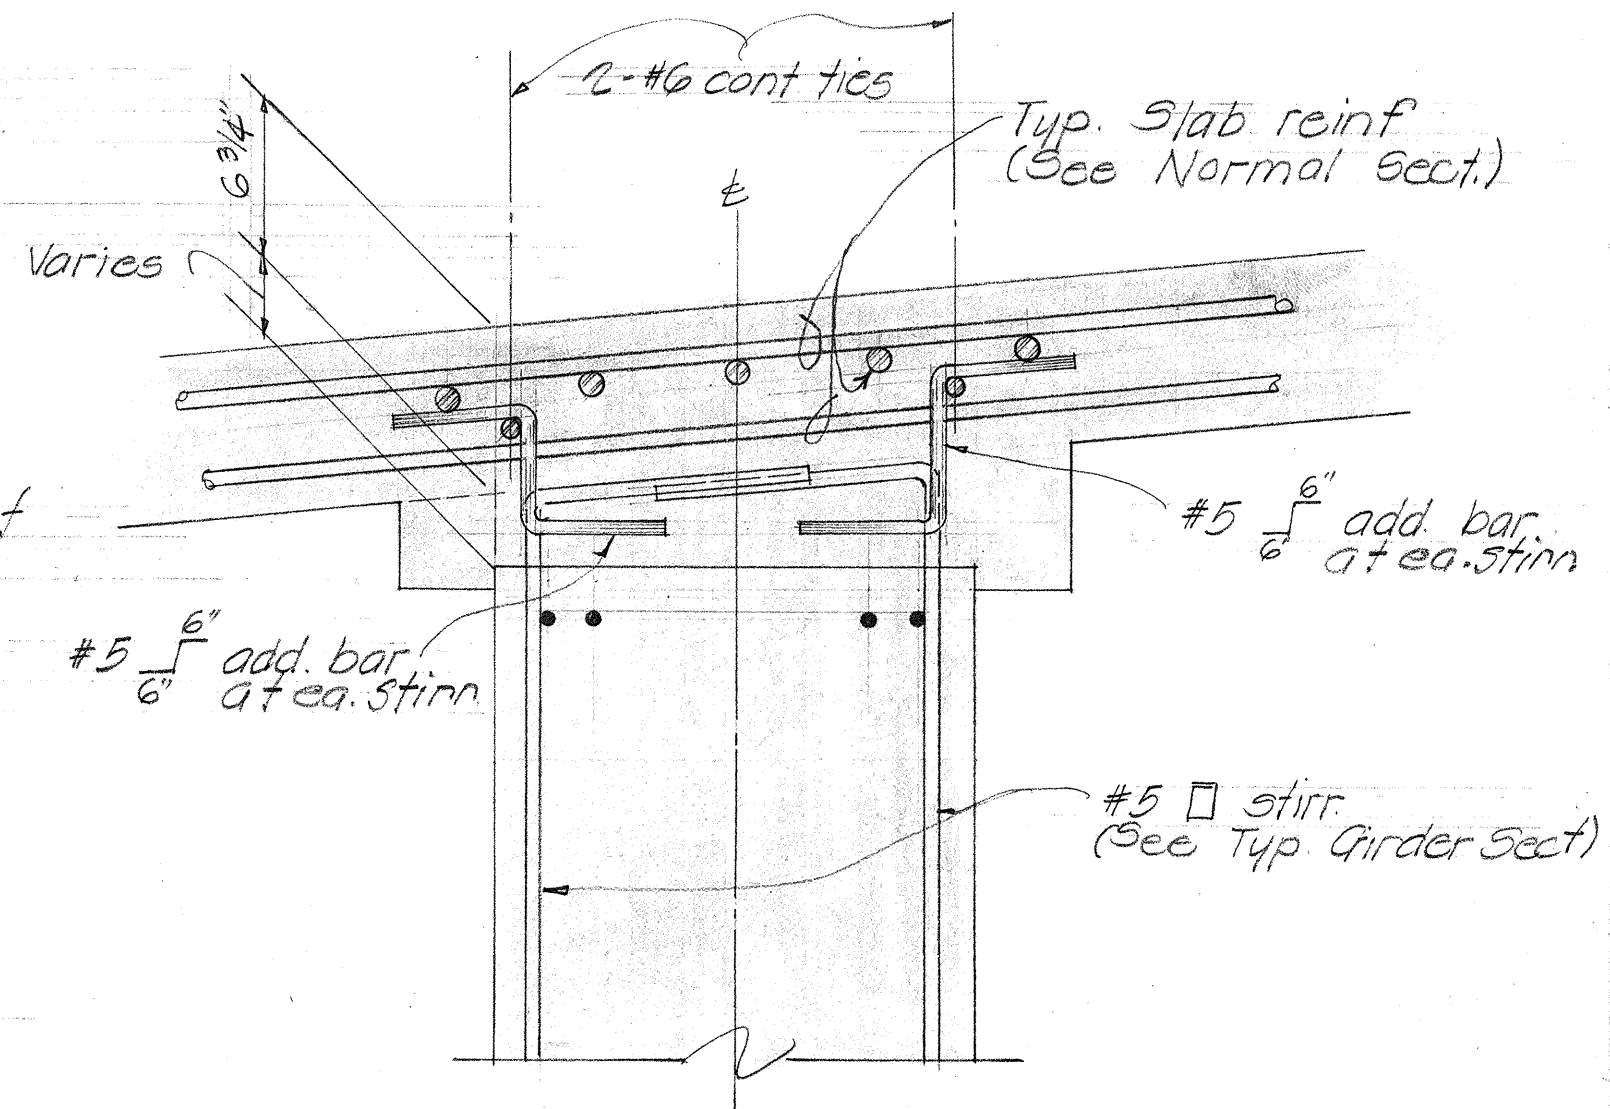

PRESTRESSED GIRDER SECT.
@ END BLOCK

STATE OF HAWAII
DEPARTMENT OF TRANSPORTATION
HIGHWAYS DIVISION

STRUCTURE #5
KALIHUAI BRIDGE
REVISED GIRDER STIRRUP
ANCHORAGE IN DECK SLAB
KAUAI BELT RD. PROJ. NO. ER-7(1)
NOV. 1961 UNIT 2