


FED. ROAD DIST. No.	STATE	FED. AID PROJ. No.	FISCAL YEAR	SHEET No.	TOTAL SHEETS
HAWAII	HAW.	ER-7(1) UNIT 2	1961	7	77

NOTE TO CONTRACTORS:

The data shown on this soil profile sheet is for design purposes only and is intended for the convenience of the Engineer in the control of earthwork. The borings were carefully made and are believed to be reliable but the Engineer does not guarantee the accuracy of same. The contractor is hereby advised and will be presumed to have made his own investigation on the site prior to submission of his bid. The State will not be responsible for the data shown on these sheets.

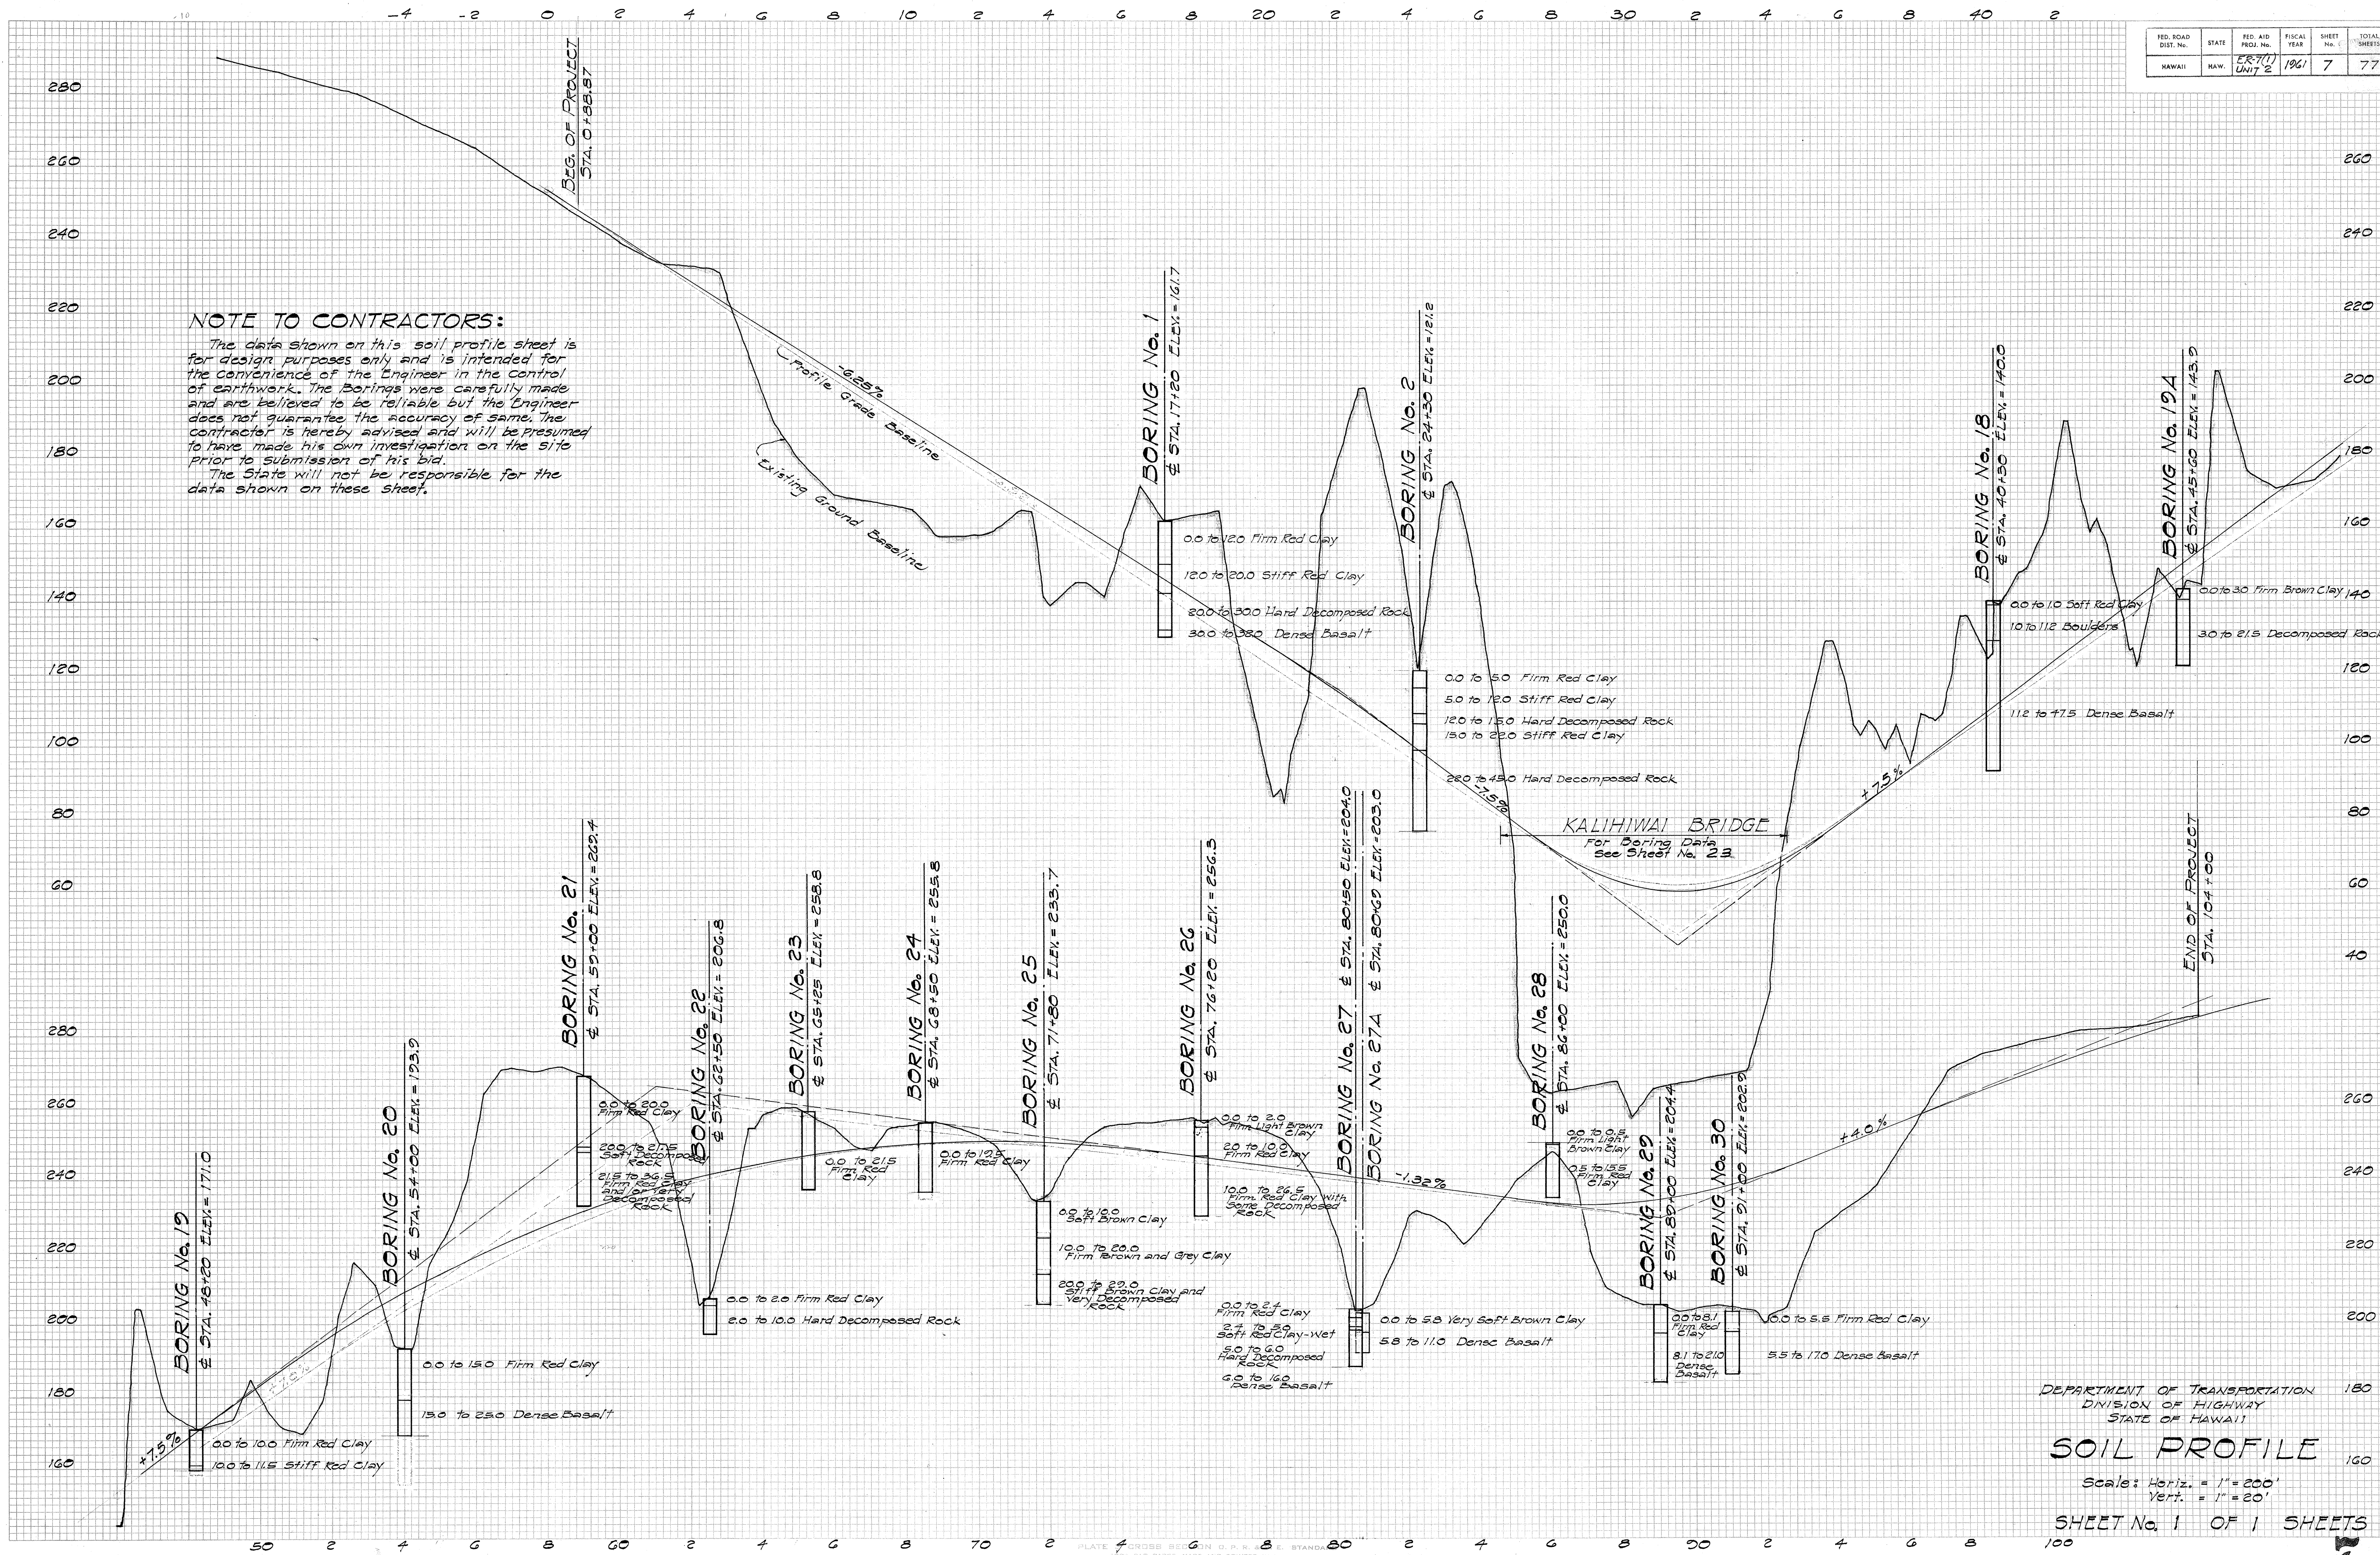

DEPARTMENT OF TRANSPORTATION
 DIVISION OF HIGHWAY
 STATE OF HAWAII
SOIL PROFILE
 Scale: Horiz. = 1" = 200'
 Vert. = 1" = 20'
 SHEET No. 1 OF 1 SHEETS