

ESTIMATED QUANTITIES (For Rt Conn. Only)

Roadway Exc.	1,667	500	CY
Embankment		650	CY
Base Course Area	116	131	SY
AC Pavement Area	114	127	SY
Select Borrow	560	386	tons

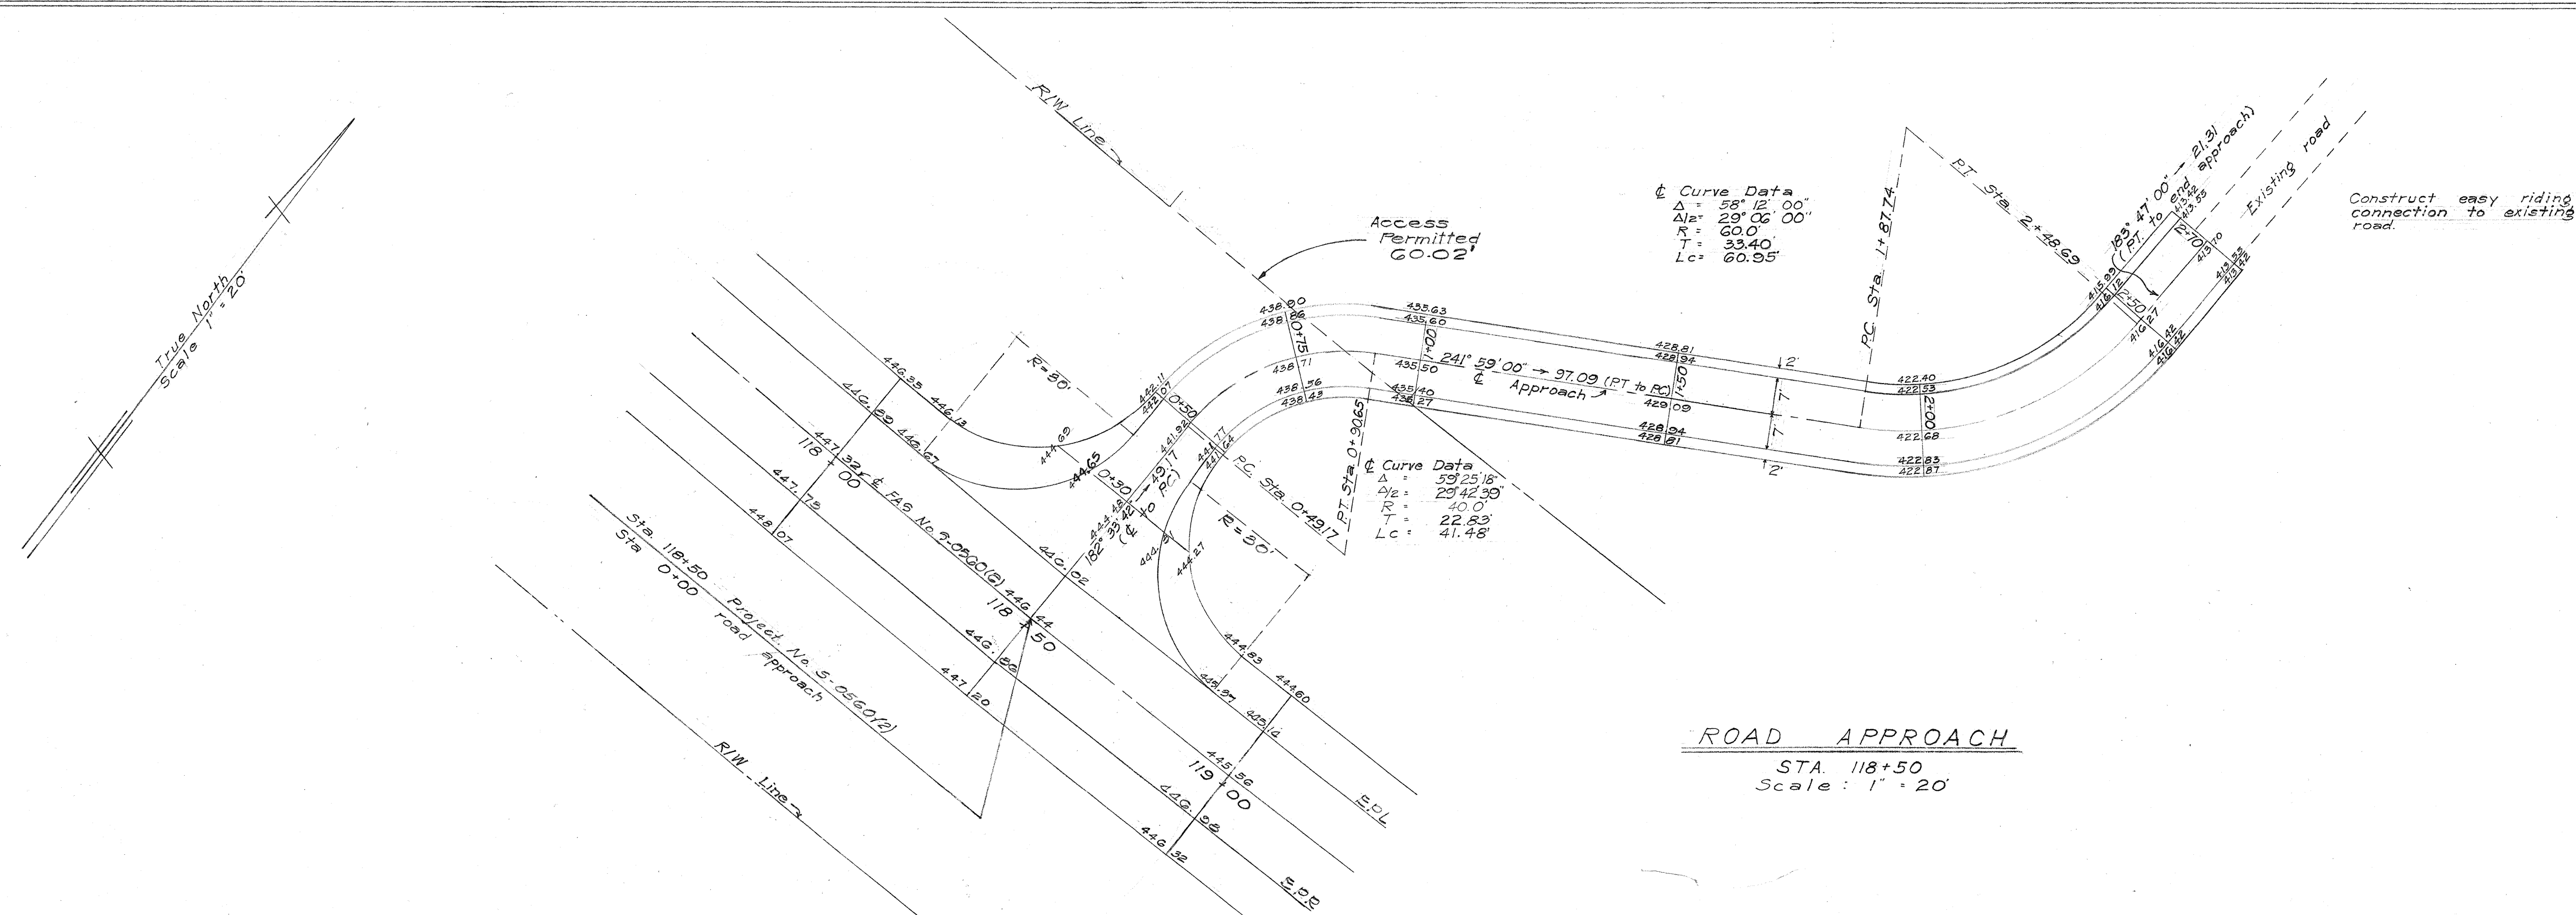
ESTIMATED QUANTITIES (For R.T.)

ITEM	QUANTITY	UNIT
Roadway Exc.	1,667	500
Embankment	650	
Base Course Area	116	434
AC Pavement Area	116	434
Select Borrow	260	500

FIELD ROAD CONNECTION
STA. 75+00
Scale: 1" = 20'

FIELD ROAD CONNECTION

STA. 75+00
Scale: 1" = 20'

ROAD APPROACH

STA. 118+50
Scale: 1" = 20'

ESTIMATED QUANTITIES

ESTIMATED	QUANTITIES
Roadway Exc.	1180 C.Y.
Embankment	543 C.Y.
Base Course area	161 S.Y.
A.C. Pavement area	155 S.Y.
Select Borrow	170 tons

For typical section of field road connection see sheet No. 2.

Construct easy riding
connection to existing
road.

DEPARTMENT OF TRANSPORTATION
DIVISION OF HIGHWAYS
STATE OF HAWAII
DETAILS OF
APPROACHES & CONNECTIONS
KAUAI BELT ROAD
PROJ. No. S-0560(2) UNIT 2
MOLOAA, KAUAI

Scale: As Shown Date: Feb 1961

SHEET No. OF SHEETS

11

ORIGINAL PLAN	SURVEY PLOTTED BY _____ DATE _____	
	DESIGNED BY _____	_____
NOTE BOOK No. _____	DRAWN BY _____	_____
	TRACED BY _____	_____
	QUANTITIES BY _____	_____
	QUANTITIES CHECKED BY _____	_____
	CHECKED BY _____	_____