

INDEX TO DRAWINGS	
SHEET NO.	DESCRIPTION
1	TITLE SHEET
2	TYPICAL SECTIONS
3-10	PLAN & PROFILE
11	DETAILS OF APPROACHES & CONNECTIONS
12	MISCELLANEOUS DETAILS
13	REALIGNED CHANNEL & IRRIGATION SYSTEM
14	SECONDARY SYSTEM PROJECT SIGN
15-19	SIPHON DETAILS
20-28	STANDARD DETAILS
29	BOX CULVERT & SECTIONAL PIPE
30-41	MOLOAA BRIDGE ALTERNATE "A"
42-53	MOLOAA BRIDGE ALTERNATE "B"
54-57	TYPICAL BRIDGE DETAILS ALTERNATE "A" & "B"
58-60	STANDARD DETAILS
61-105	CROSS SECTIONS

CONVENTIONAL SIGNS	
Baseline	75
Boundary Line	---
Fences (Named)	---x---
Existing Roadway	---
Pipe Culvert	---
Box Culvert	---
Telephone Line & Pole	T---T
Electric Line & Pole	E---E
Water Main	W---W

STATE OF HAWAII

DEPARTMENT OF TRANSPORTATION

HIGHWAYS DIVISION

"AS BUILT" PLANS OF


KAUAI BELT ROAD

FEDERAL AID SECONDARY PROJECT NO. S-0560(2) UNIT 2

DISTRICTS OF KAWAIHAU & HANAIEI

ISLAND OF KAUAI

SCALES	
PLAN	1 INCH = 100 FT.
PROFILE	HOR. 1 INCH = 100 FT.
	VER. 1 INCH = 10 FT.
CROSS SECTION	HOR. 1 INCH = 10 FT.
	VER. 1 INCH = 10 FT.

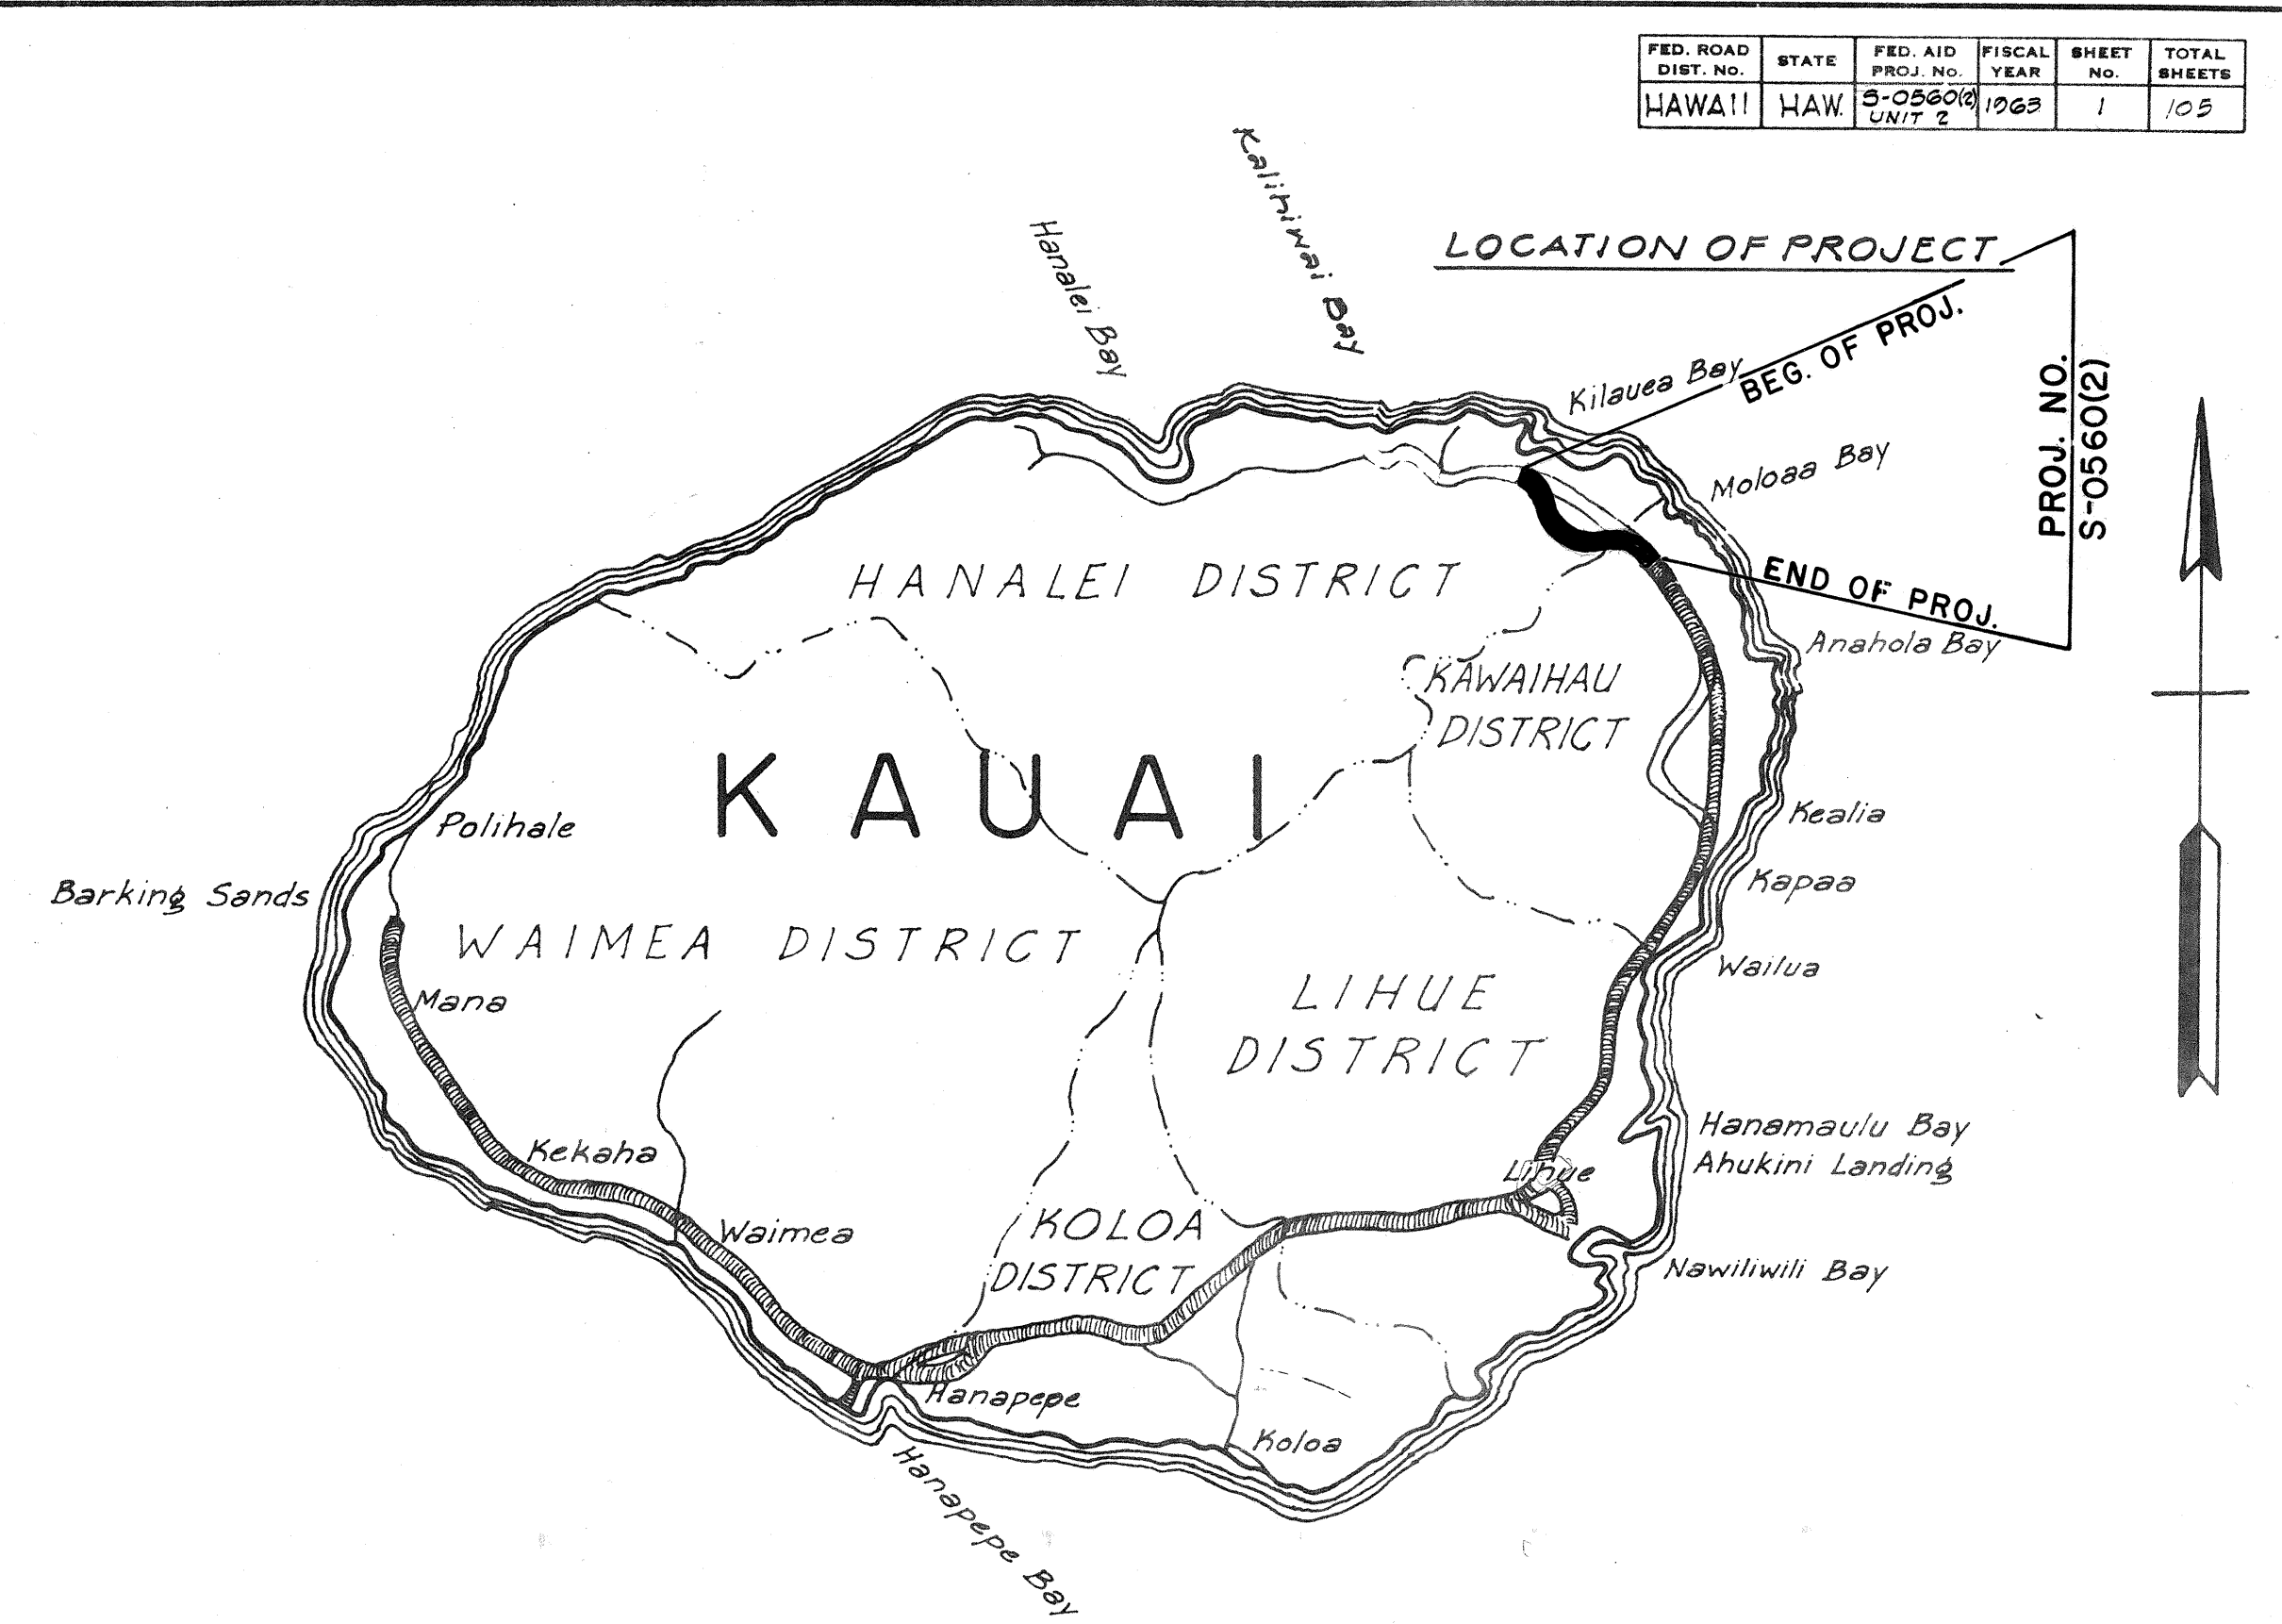


FEDERAL AID PROJECTS PREVIOUSLY CONSTRUCTED OR UNDER CONSTRUCTION

DESIGN	DESIGNATION
ADT (1960)	430
ADT (1980)	850
DHV	12%
D	60/40
T	15%
V	60 MPH

NOTE:
ALL CHANGES MADE DURING CONSTRUCTION HAVE BEEN NOTED IN RED ON THESE TRACINGS AND CHECKED BY:

Robert J. Yarnall
PROJECT ENGINEER
April 19, 1967
DATE

SURVEY PLOTTED BY	DATE
DESIGNED BY	
DRAWN BY	
TRACED BY	
QUANTITIES CHECKED BY	
CHECKED BY	
NOTE BOOK	
No.	

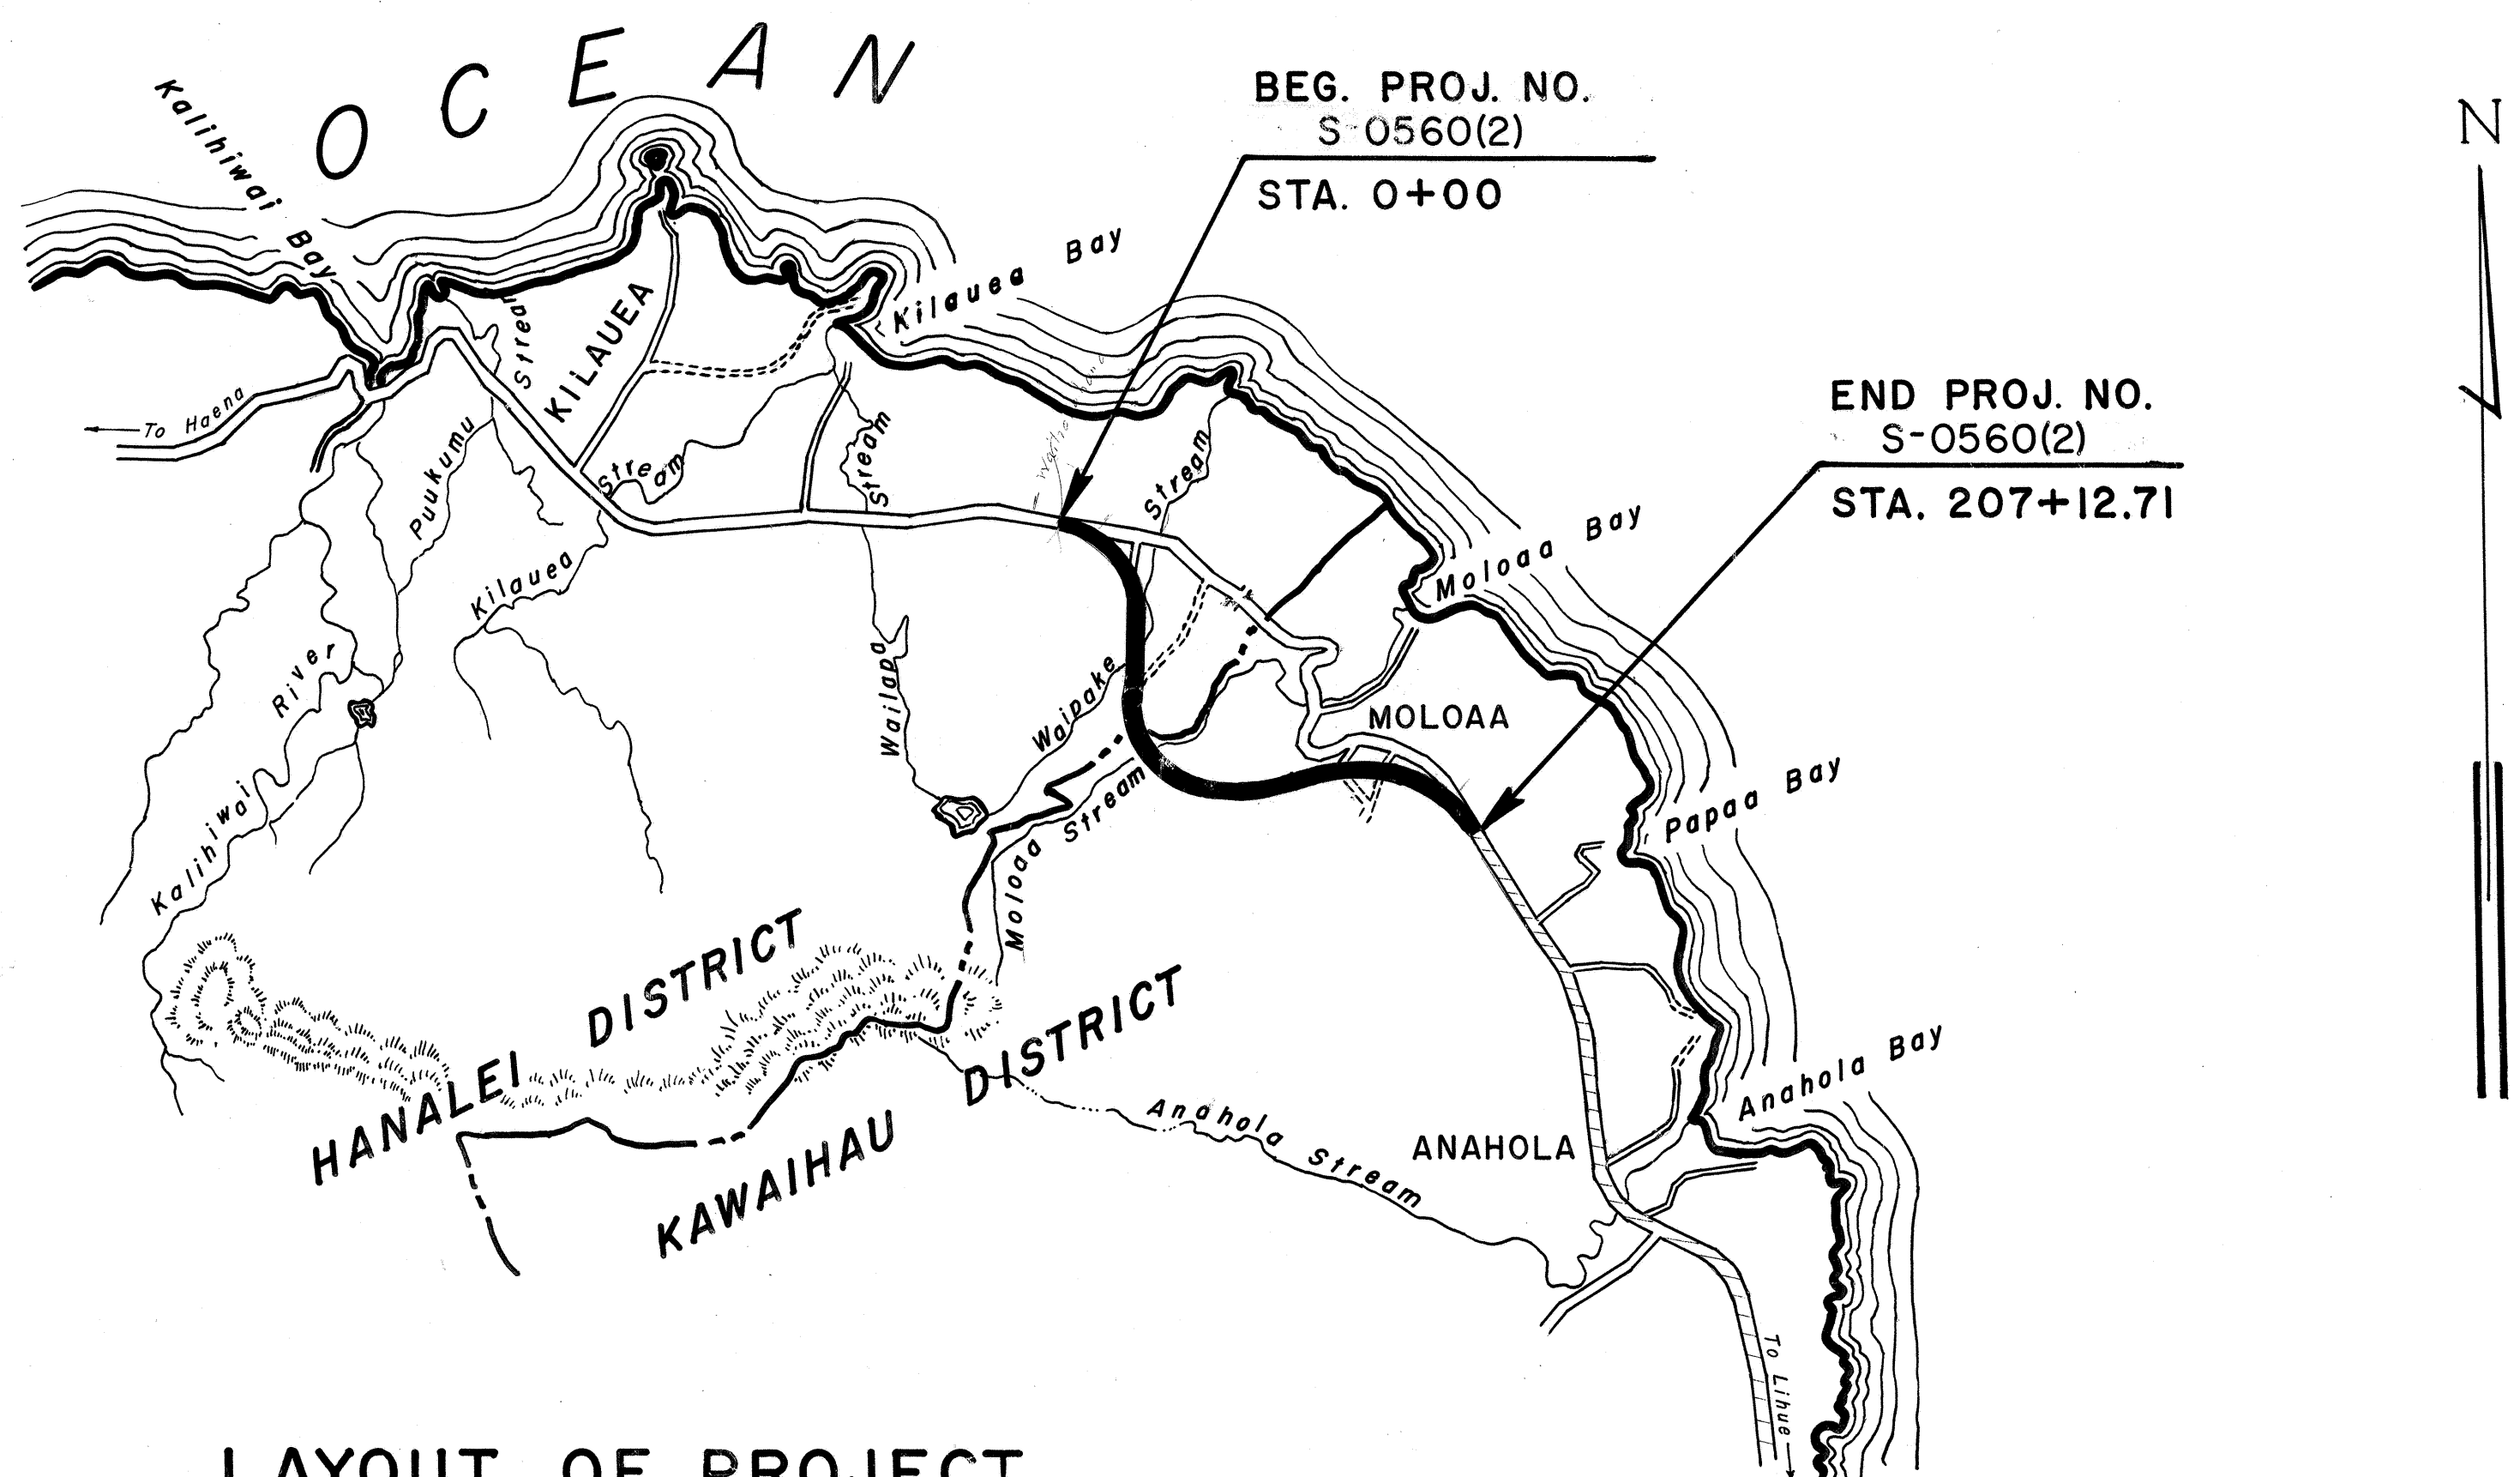

LAYOUT OF PROJECT
SCALE: 1" = 5280'

GROSS LENGTH OF PROJECT	3.923 Mi.
BRIDGE OVER 20'-0" SPAN	0.047 Mi.
NET LENGTH OF PROJECT	3.876 Mi.

APPROVED: *James H. ...* DATE 17 June '63
DIRECTOR OF TRANSPORTATION

DEPARTMENT OF COMMERCE
BUREAU OF PUBLIC ROADS
APPROVED: _____
DIVISION ENGINEER DATE