

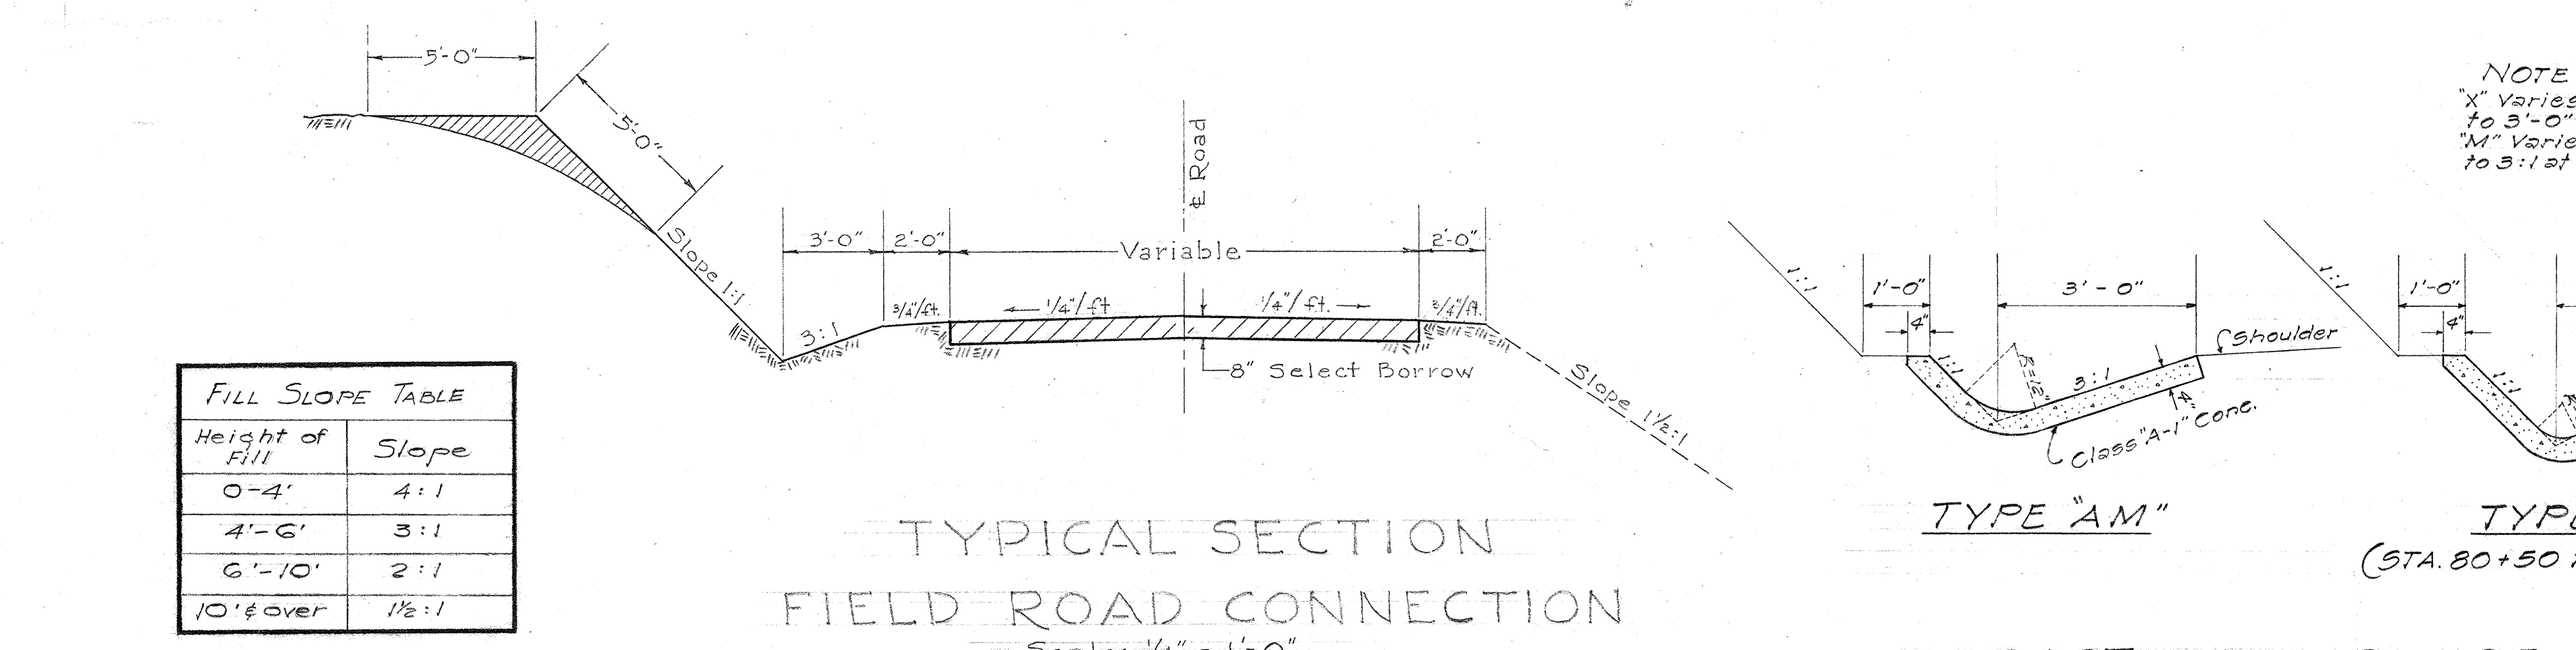
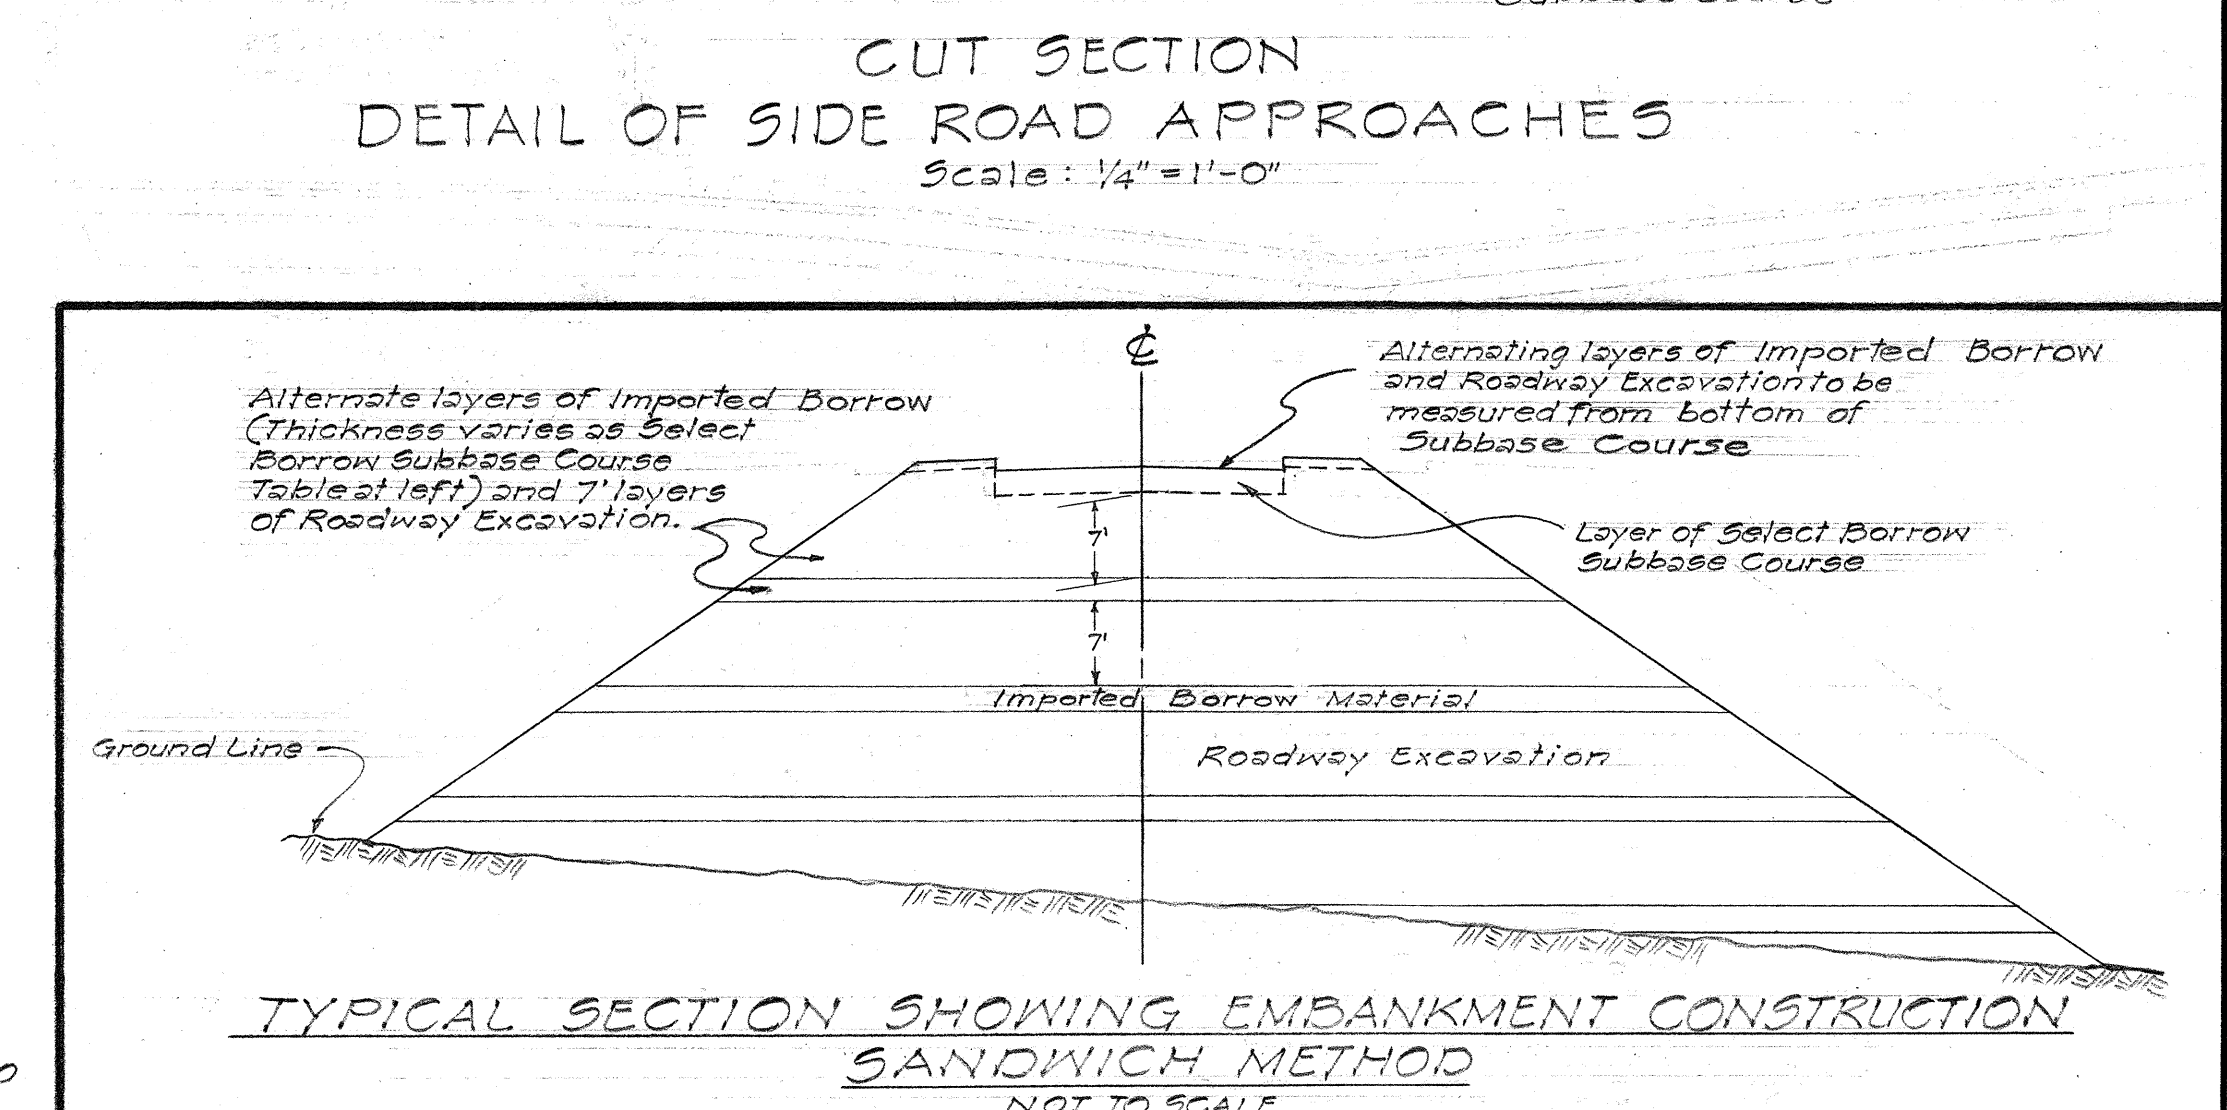
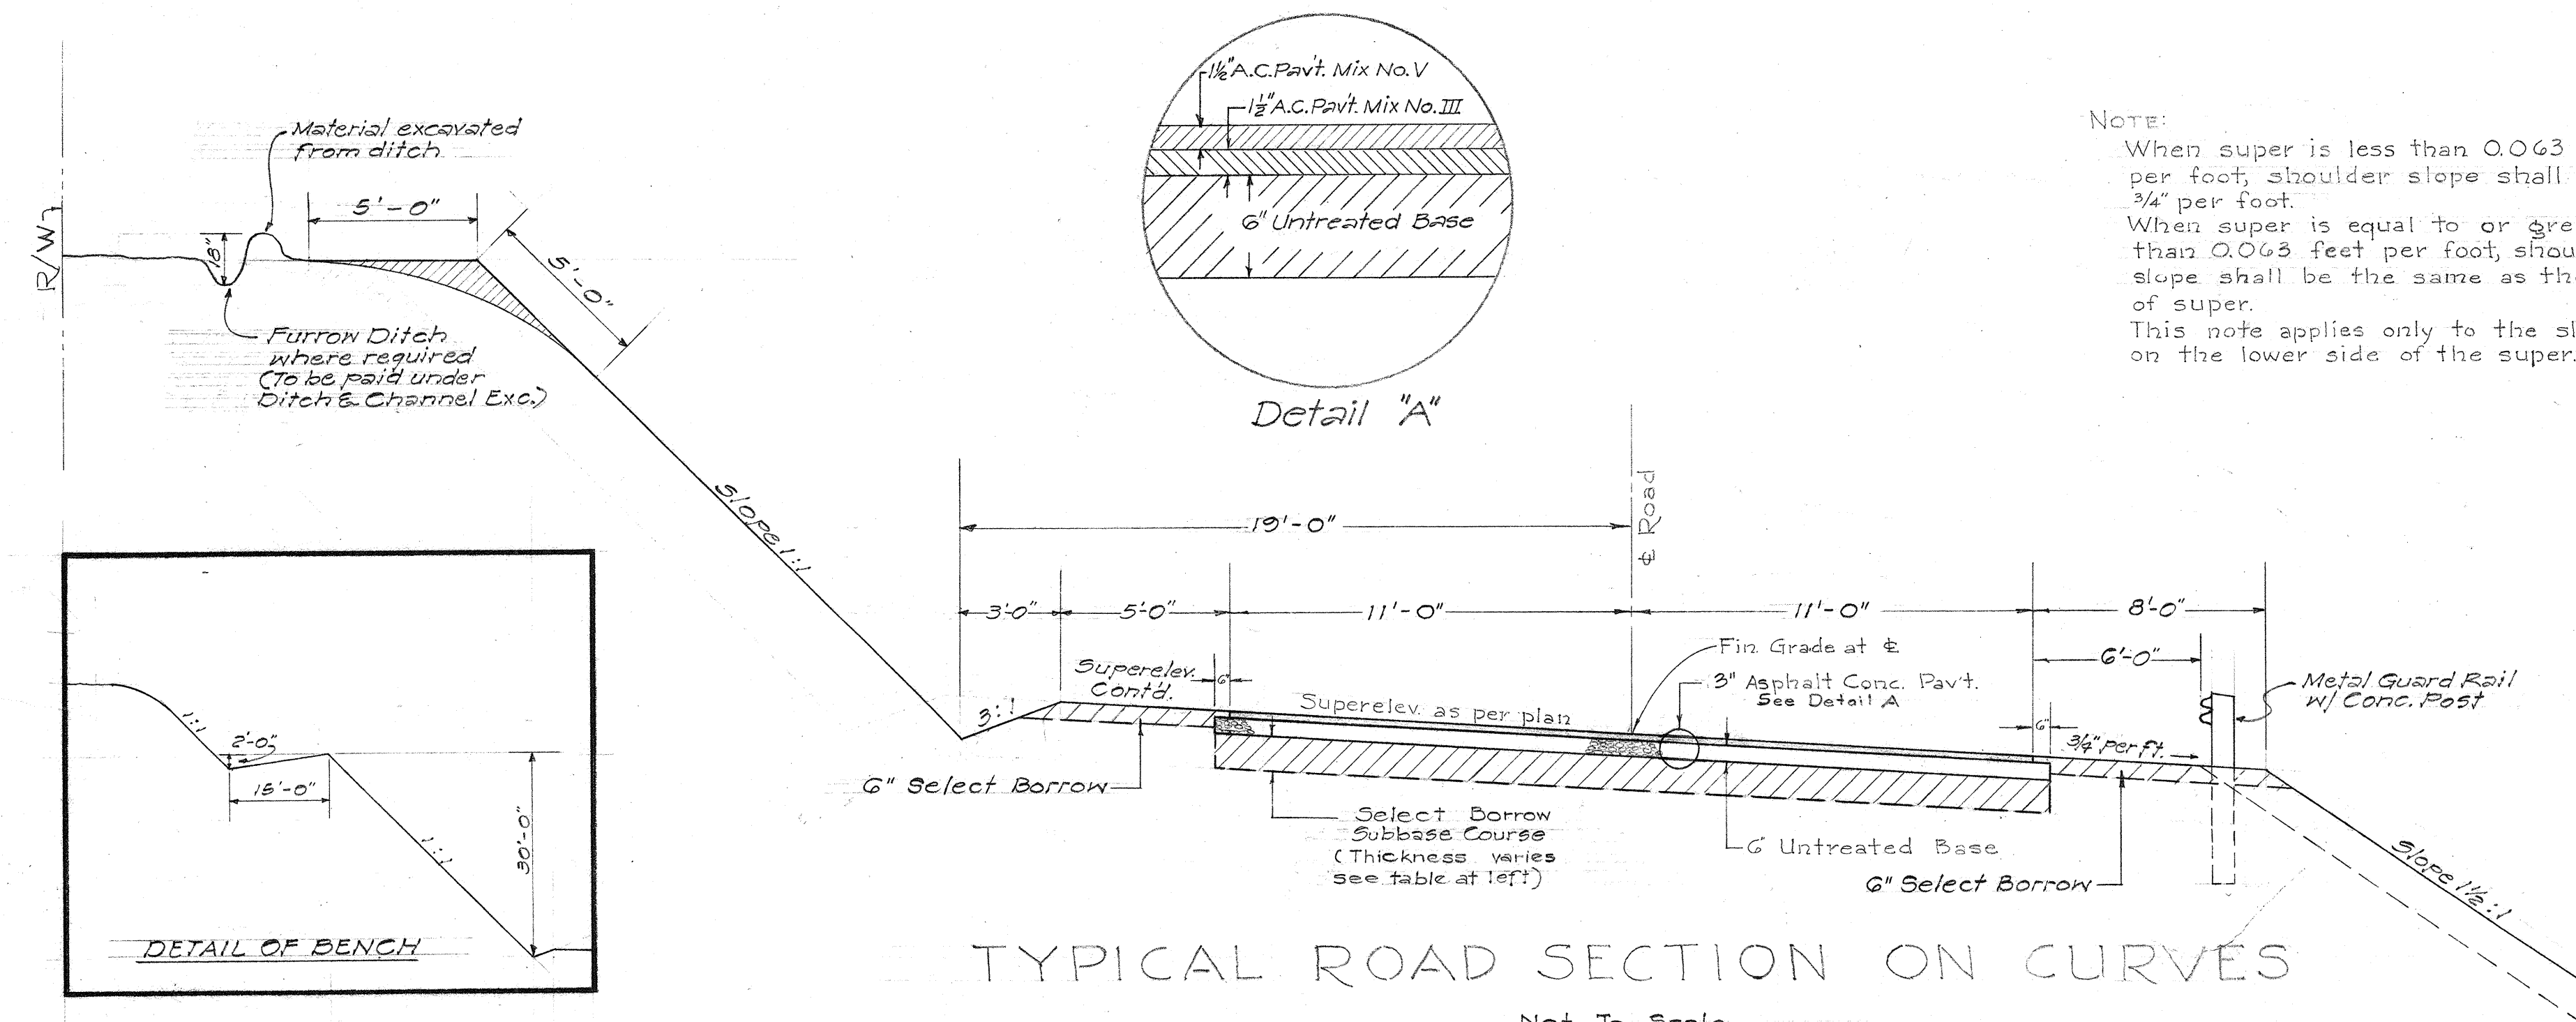
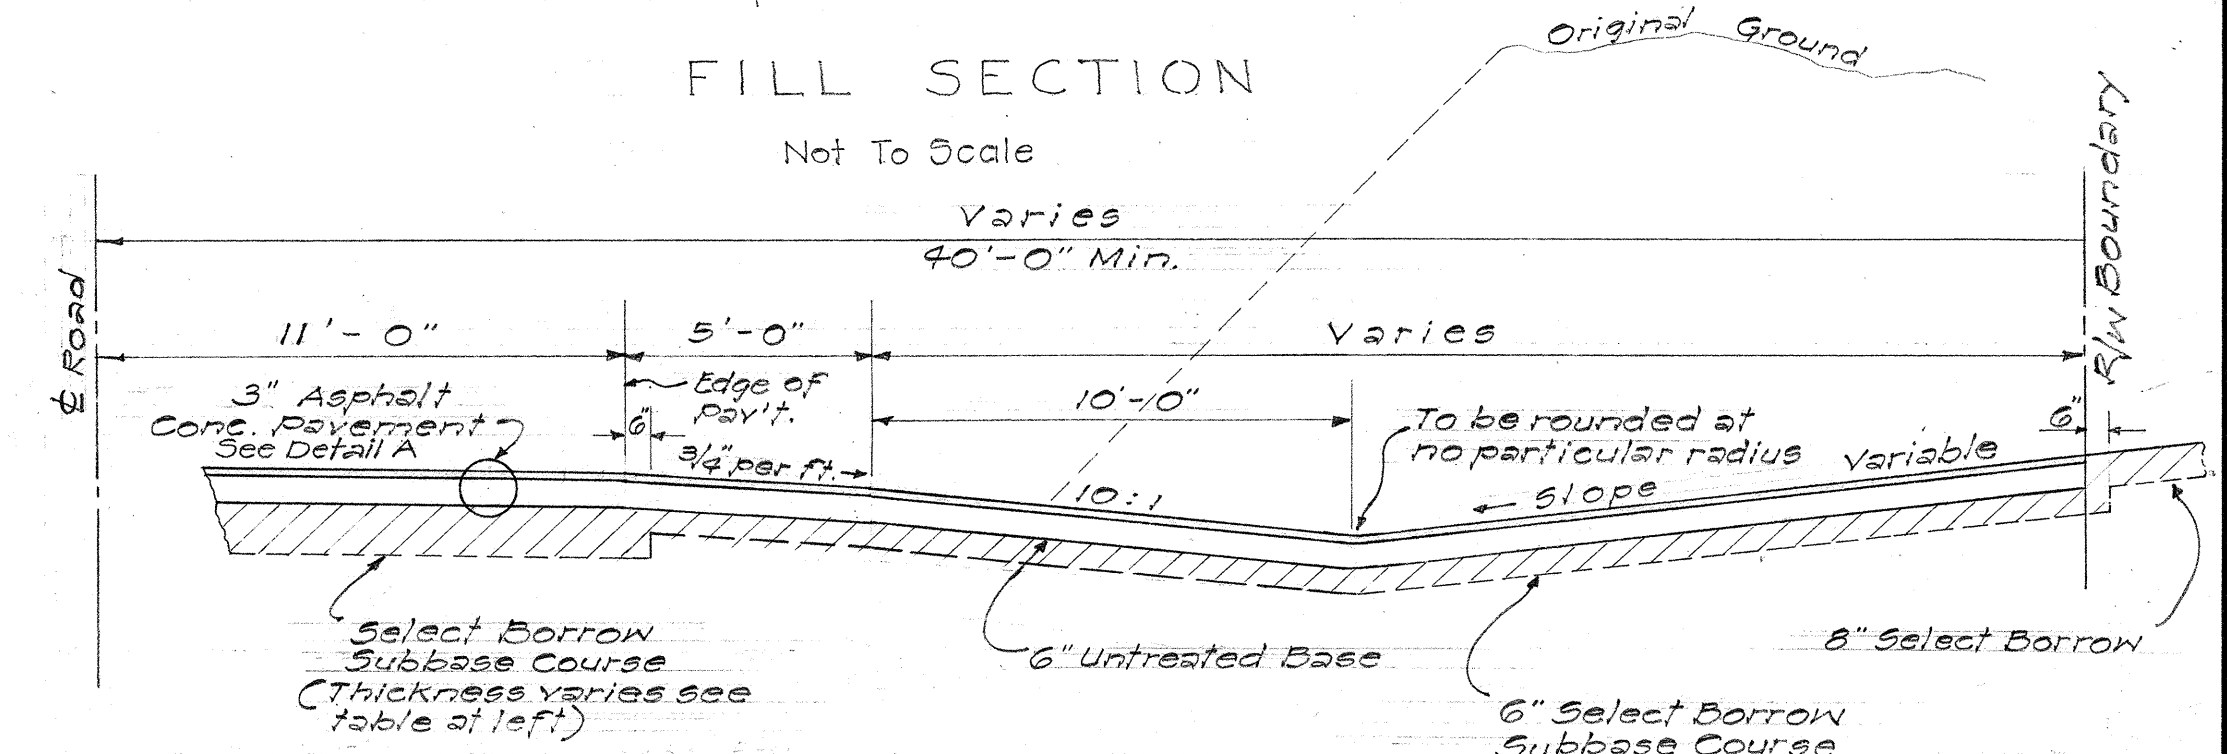
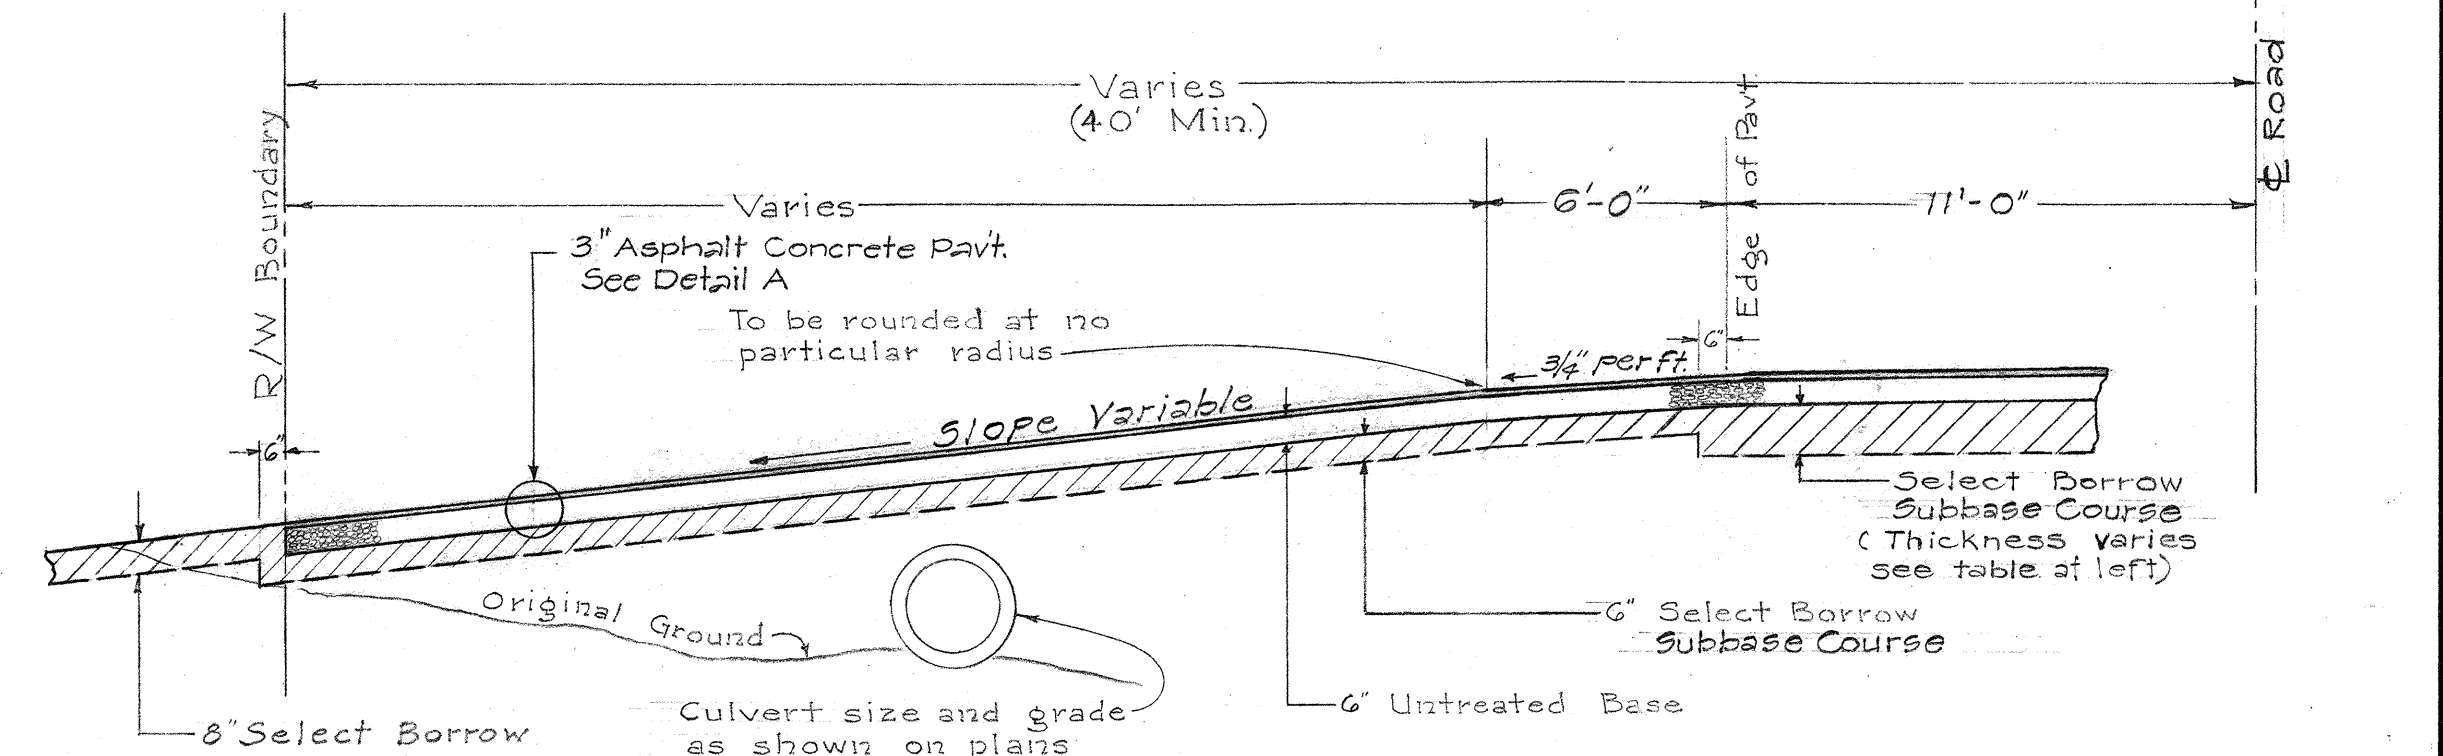


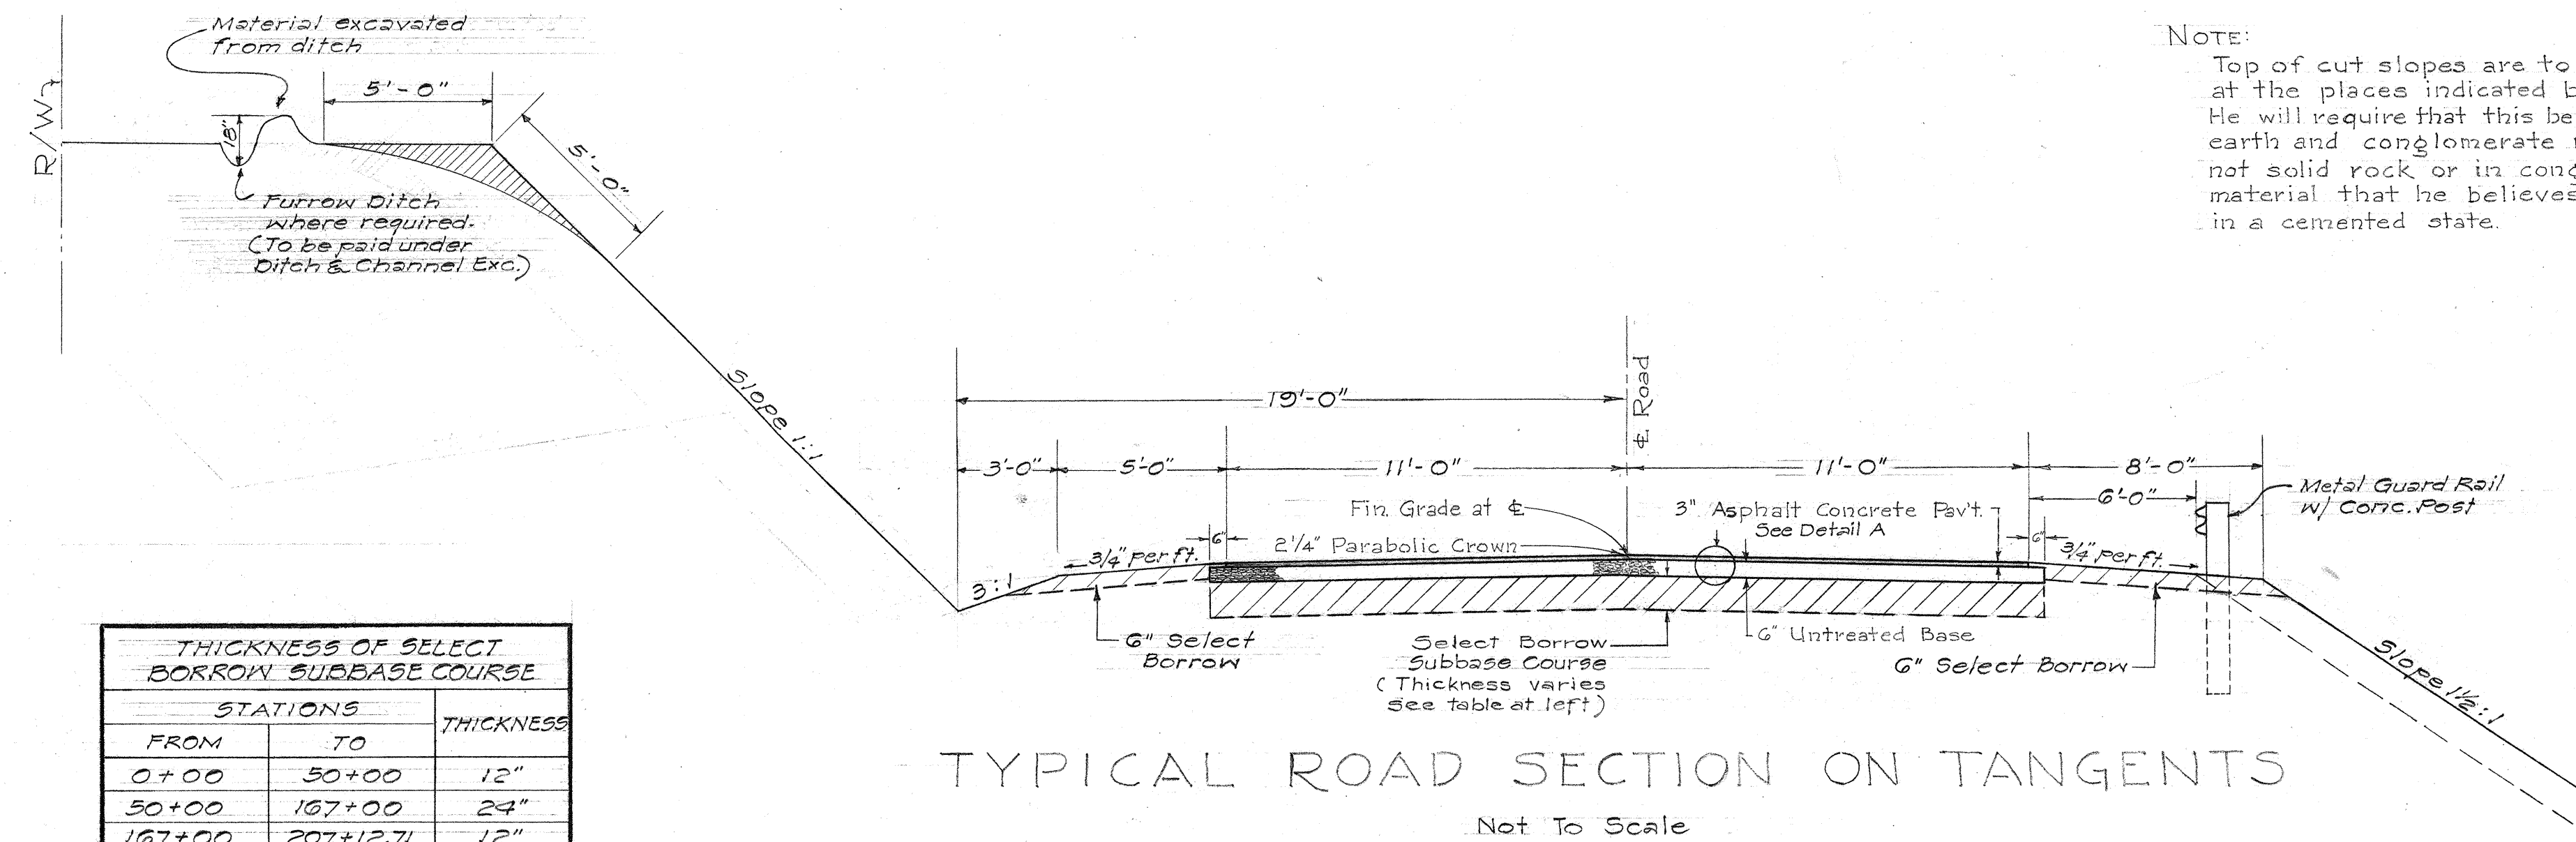

NOTE:
 "X" Varies from 2'-8" at Sta. 80+50 to 3'-0" at 81+00
 "M" Varies from 2'-1 at Sta. 80+50 to 3'-1 at Sta. 81+00

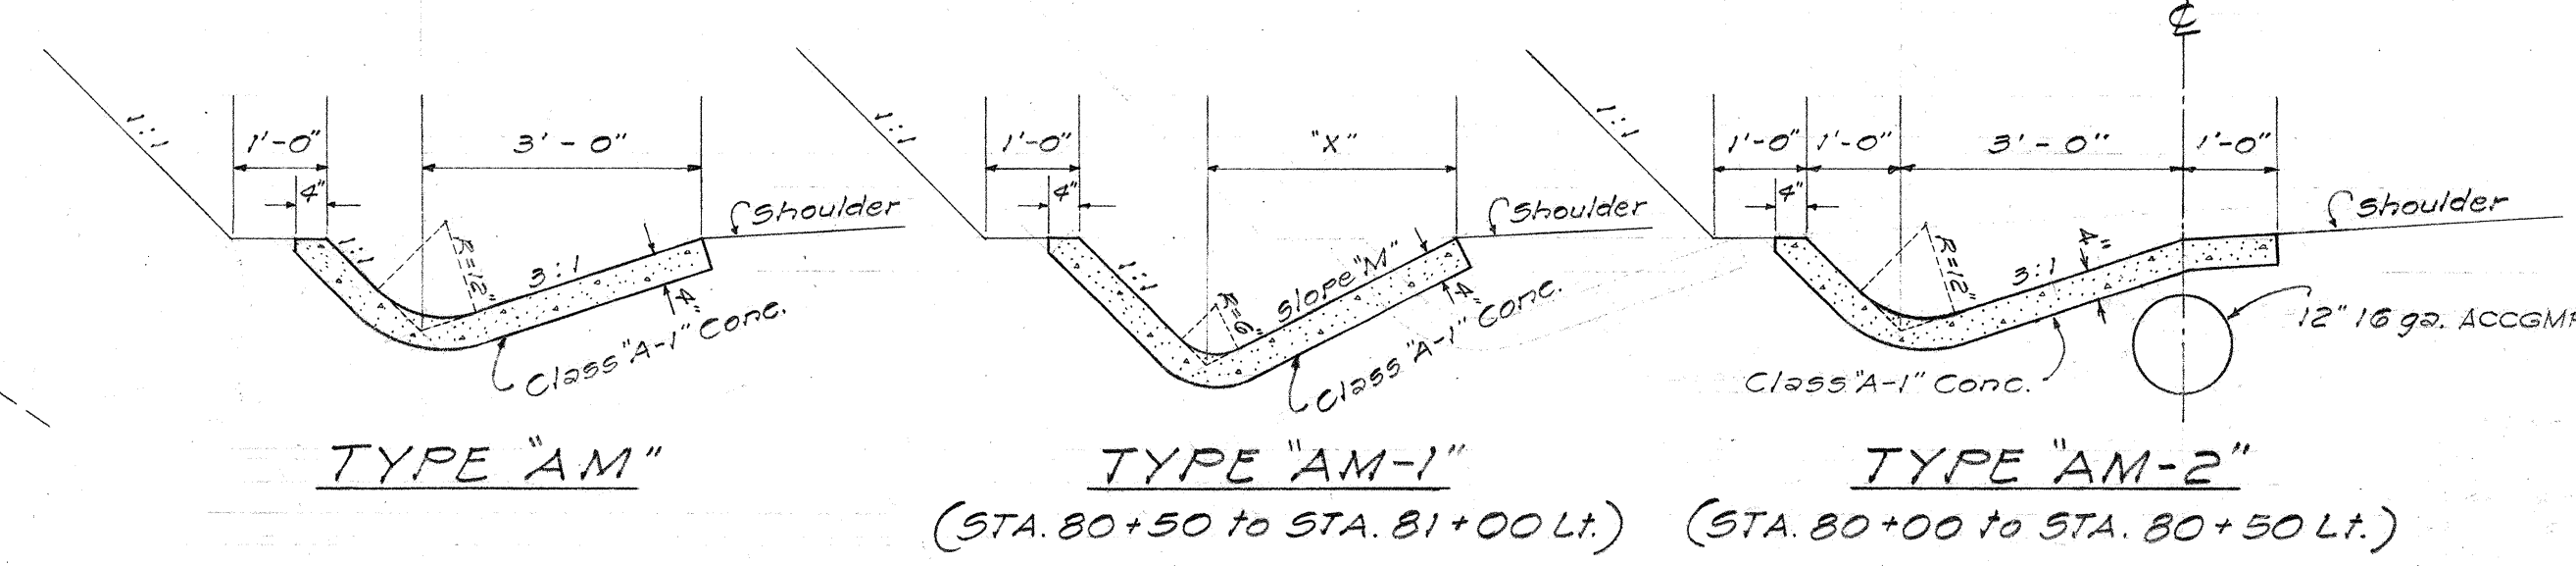

DEPARTMENT OF TRANSPORTATION
 DIVISION OF HIGHWAYS
 STATE OF HAWAII
 TYPICAL SECTION
 PROJ. NO. 5-0560(2) UNIT 2
 KAUAI BELT ROAD
 Scale: As Noted Date: Feb. 1961