

STATE	PROJ. NO.	FISCAL YEAR	SHEET NO.	TOTAL SHEETS
HAW.	A3601-64	1964	3	6

GENERAL NOTES

- Leveling of the pavement surfaces prior to laying of A.C. pavement will be done by State Maintenance Forces. This does not include areas immediately adjacent to newly constructed tractor crossings.
- Trimming and dressing of shoulders after laying of A.C. pavement will be done by State Maintenance Forces.
- In general, existing paved sections adjacent to the edge of pavement and within the highway rights-of-way including approach roads, driveways, bus stops and other previously paved areas requiring resurfacing, as determined by the Engineer, shall be resurfaced.
- Basecourse sections to receive initial application of pavement shall be leveled to the existing surface with a leveling course of Asphalt Concrete, Mix No. 2, to permit full width overlay of the 1/4 inch minimum wearing course.

SUMMARY OF ADDITIONAL RESURFACING AT E/R

STA.	DESCRIPTION	EST. QUANT.
140+50-Lt.	Approach	30 S.Y.
145+00-Rt.	Approach	62 S.Y.
145+74 to 146+71-Rt.	Approach	120 S.Y.
146+04 to 153+37-Lt.	Approaches & Driveways	1241 S.Y.
148+00-Rt.	Approach	80 S.Y.
148+91 to 150+93-Rt.	Approaches & Bus Stop	268 S.Y.
151+70-Rt.	Approach	44 S.Y.
153+40-Rt.	Approach	38 S.Y.
155+62 to 157+20-B.S.	Extra width - Bridge	53 S.Y.
158+00 to 161+40-Rt.	Approach & Bus Stop	586 S.Y.
157+87 to 159+47-Lt.	Driveway & Bus Stop	180 S.Y.
170+45-Rt.	Approach	34 S.Y.
170+90-Rt.	Approach	64 S.Y.
171+50-Rt.	Driveway	33 S.Y.
172+75-Rt.	Driveway	30 S.Y.
174+25-Rt.	Approach	75 S.Y.
180+25-Rt.	Approach	115 S.Y.
183+40-Rt.	Bus Stop	39 S.Y.
188+50-Lt.	Bus Stop	133 S.Y.
194+50 to 196+50-Rt.	Approach & Bus Stop	375 S.Y.
198+80 to 199+00-Lt.	Approach & Bus Stop	180 S.Y.
199+50 to 203+10-Lt.	Approaches	644 S.Y.
200+50 to 203+50-Rt.	Approaches & Bus Stop	471 S.Y.
205+60-Lt.	Approach	115 S.Y.
208+00-Lt.	Bus Stop	133 S.Y.

Cont'd. Sheet No. 4

PLAN	SURVEYED	BY	DATE
NOTE BOOK	PLOTTED		
NO.	ALIGNMENT CHECKED		
	FT. OF WAY CHECKED		

SUMMARY OF ADDITIONAL RESURFACING AT E/R


STA.	DESCRIPTION	EST. QUANT.
209+35-Rt	Bus Stop	133 sy
210+15-Lt	Approach	40 sy
217+65-Lt	Approach	30 sy
232+70-Lt	Approach	30 sy
239+50-Lt	Approach	50 sy
289+00-Rt	Approach	24 sy
312+05-Lt	Approach	20 sy
321+90-Lt	Approach	40 sy
397+94 to 402+10-Bs	Extra Width - Bridge	199 sy
180+25-Lt	Approach	202 sy
195+90-Lt	Approach	54 sy
196+90 to 199+50	Approach	240 sy

LIHUE PLANTATION CO. LTD.


Sta. 202+03 to Sta. 203+16 - Lt.
Provide new widening
for est. quant and plan
of area, see sheet no. 6

STATE	PROJ. NO.	FISCAL YEAR	SHEET NO.	TOTAL SHEETS
HAW.	A-56-01-64	1964	4	6

DATE	BY	DATE	BY
PLAN		SURVEYED	
NOTE BOOK		ALIGNED CHECKED	
NO.		BY, OF WAY CHECKED	

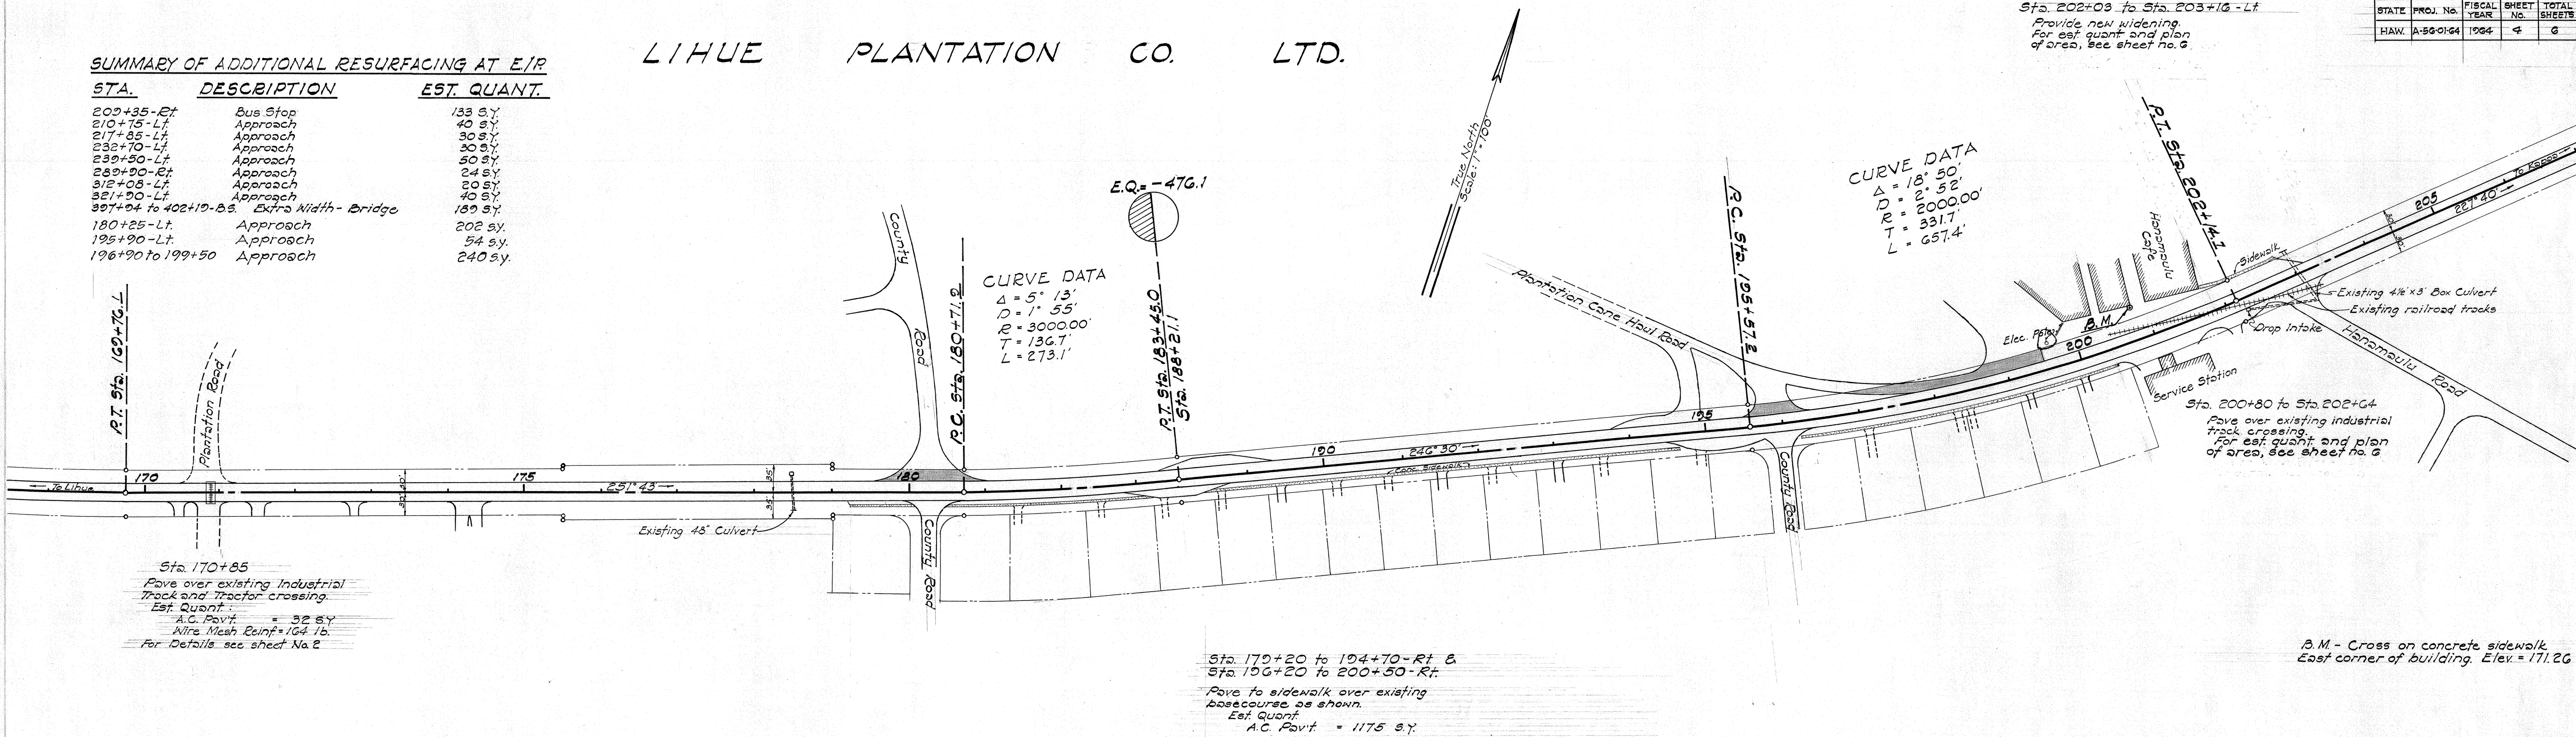


DATE	BY	DATE	BY
PROFILE		SURVEYED	
NOTE BOOK		CHANGES CHECKED	
NO.		CONTRACTOR'S REVIEW	


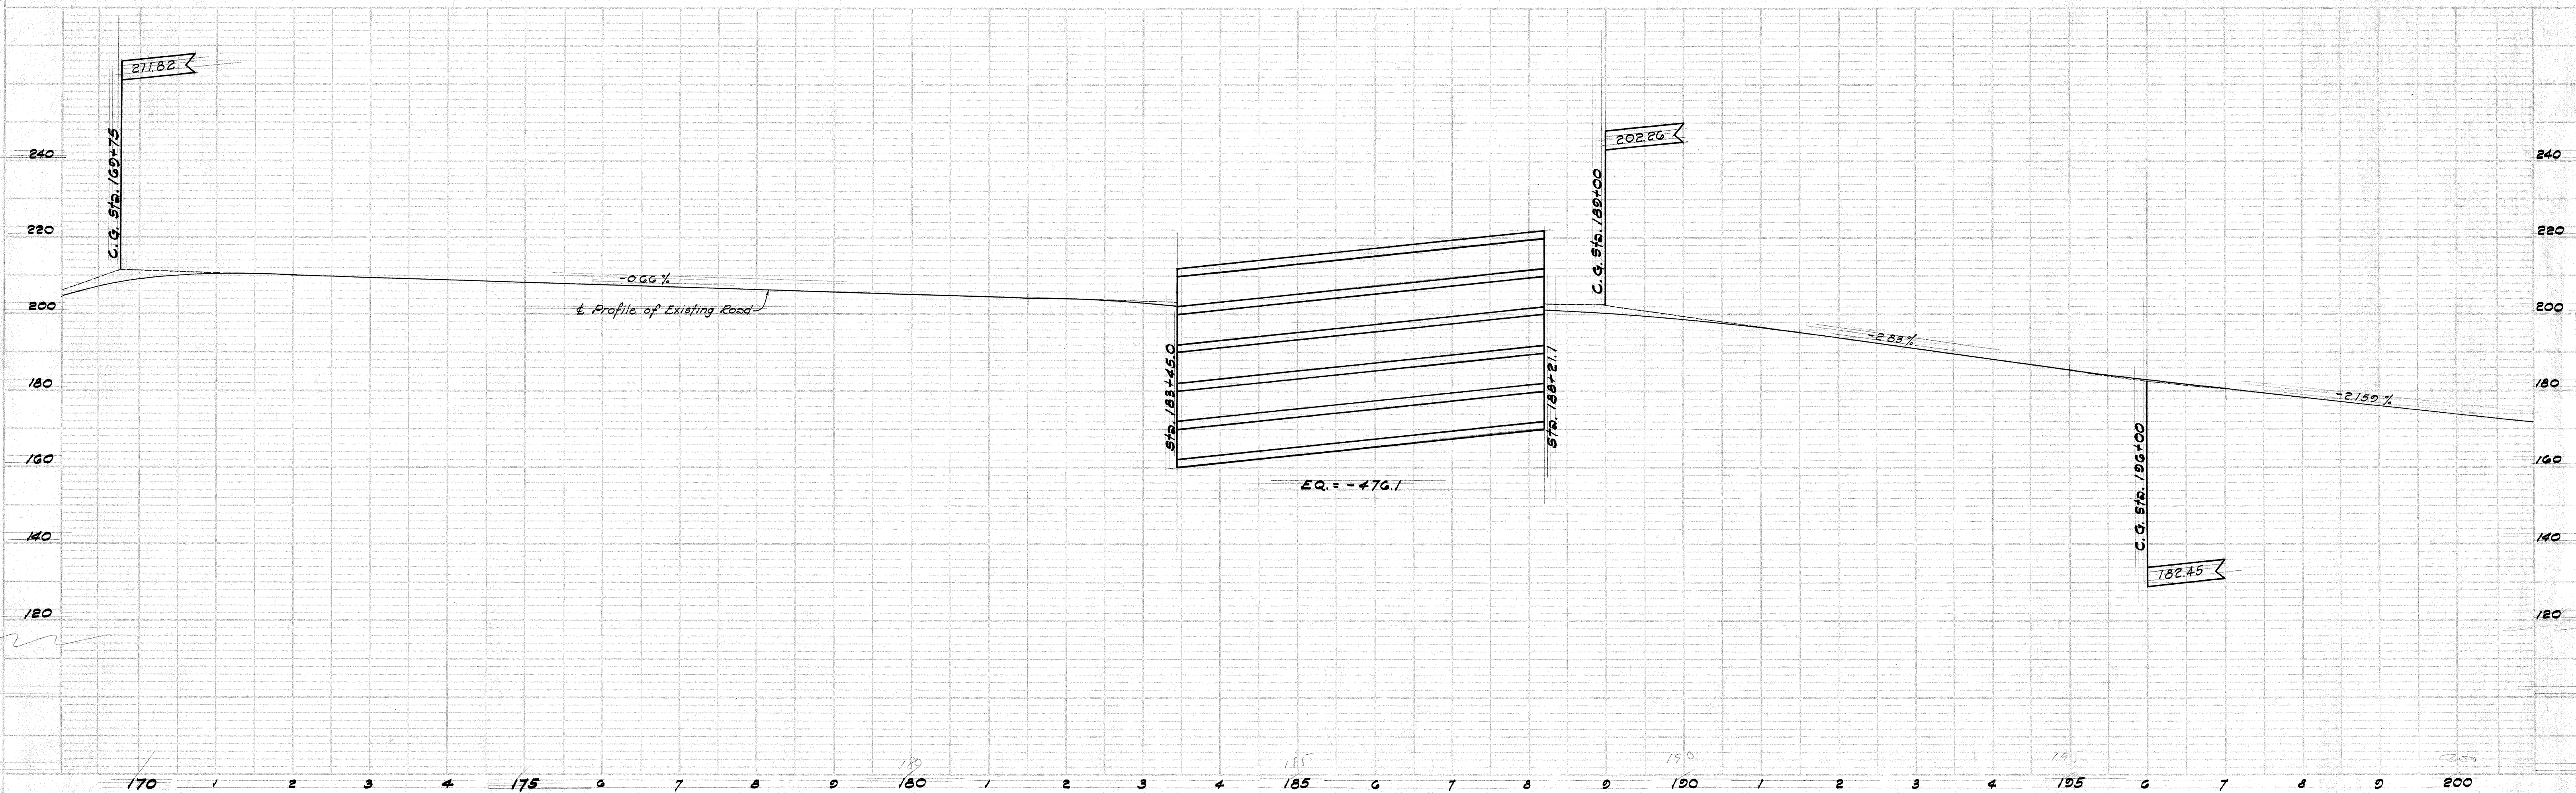


STATE	PROJ. No.	FISCAL YEAR	SHEET No.	TOTAL SHEETS
HAW.	A36-01-04	1964	5	6

PLAN	DATE	BY
SURVEYED		
NOTE BOOK		
NO.		

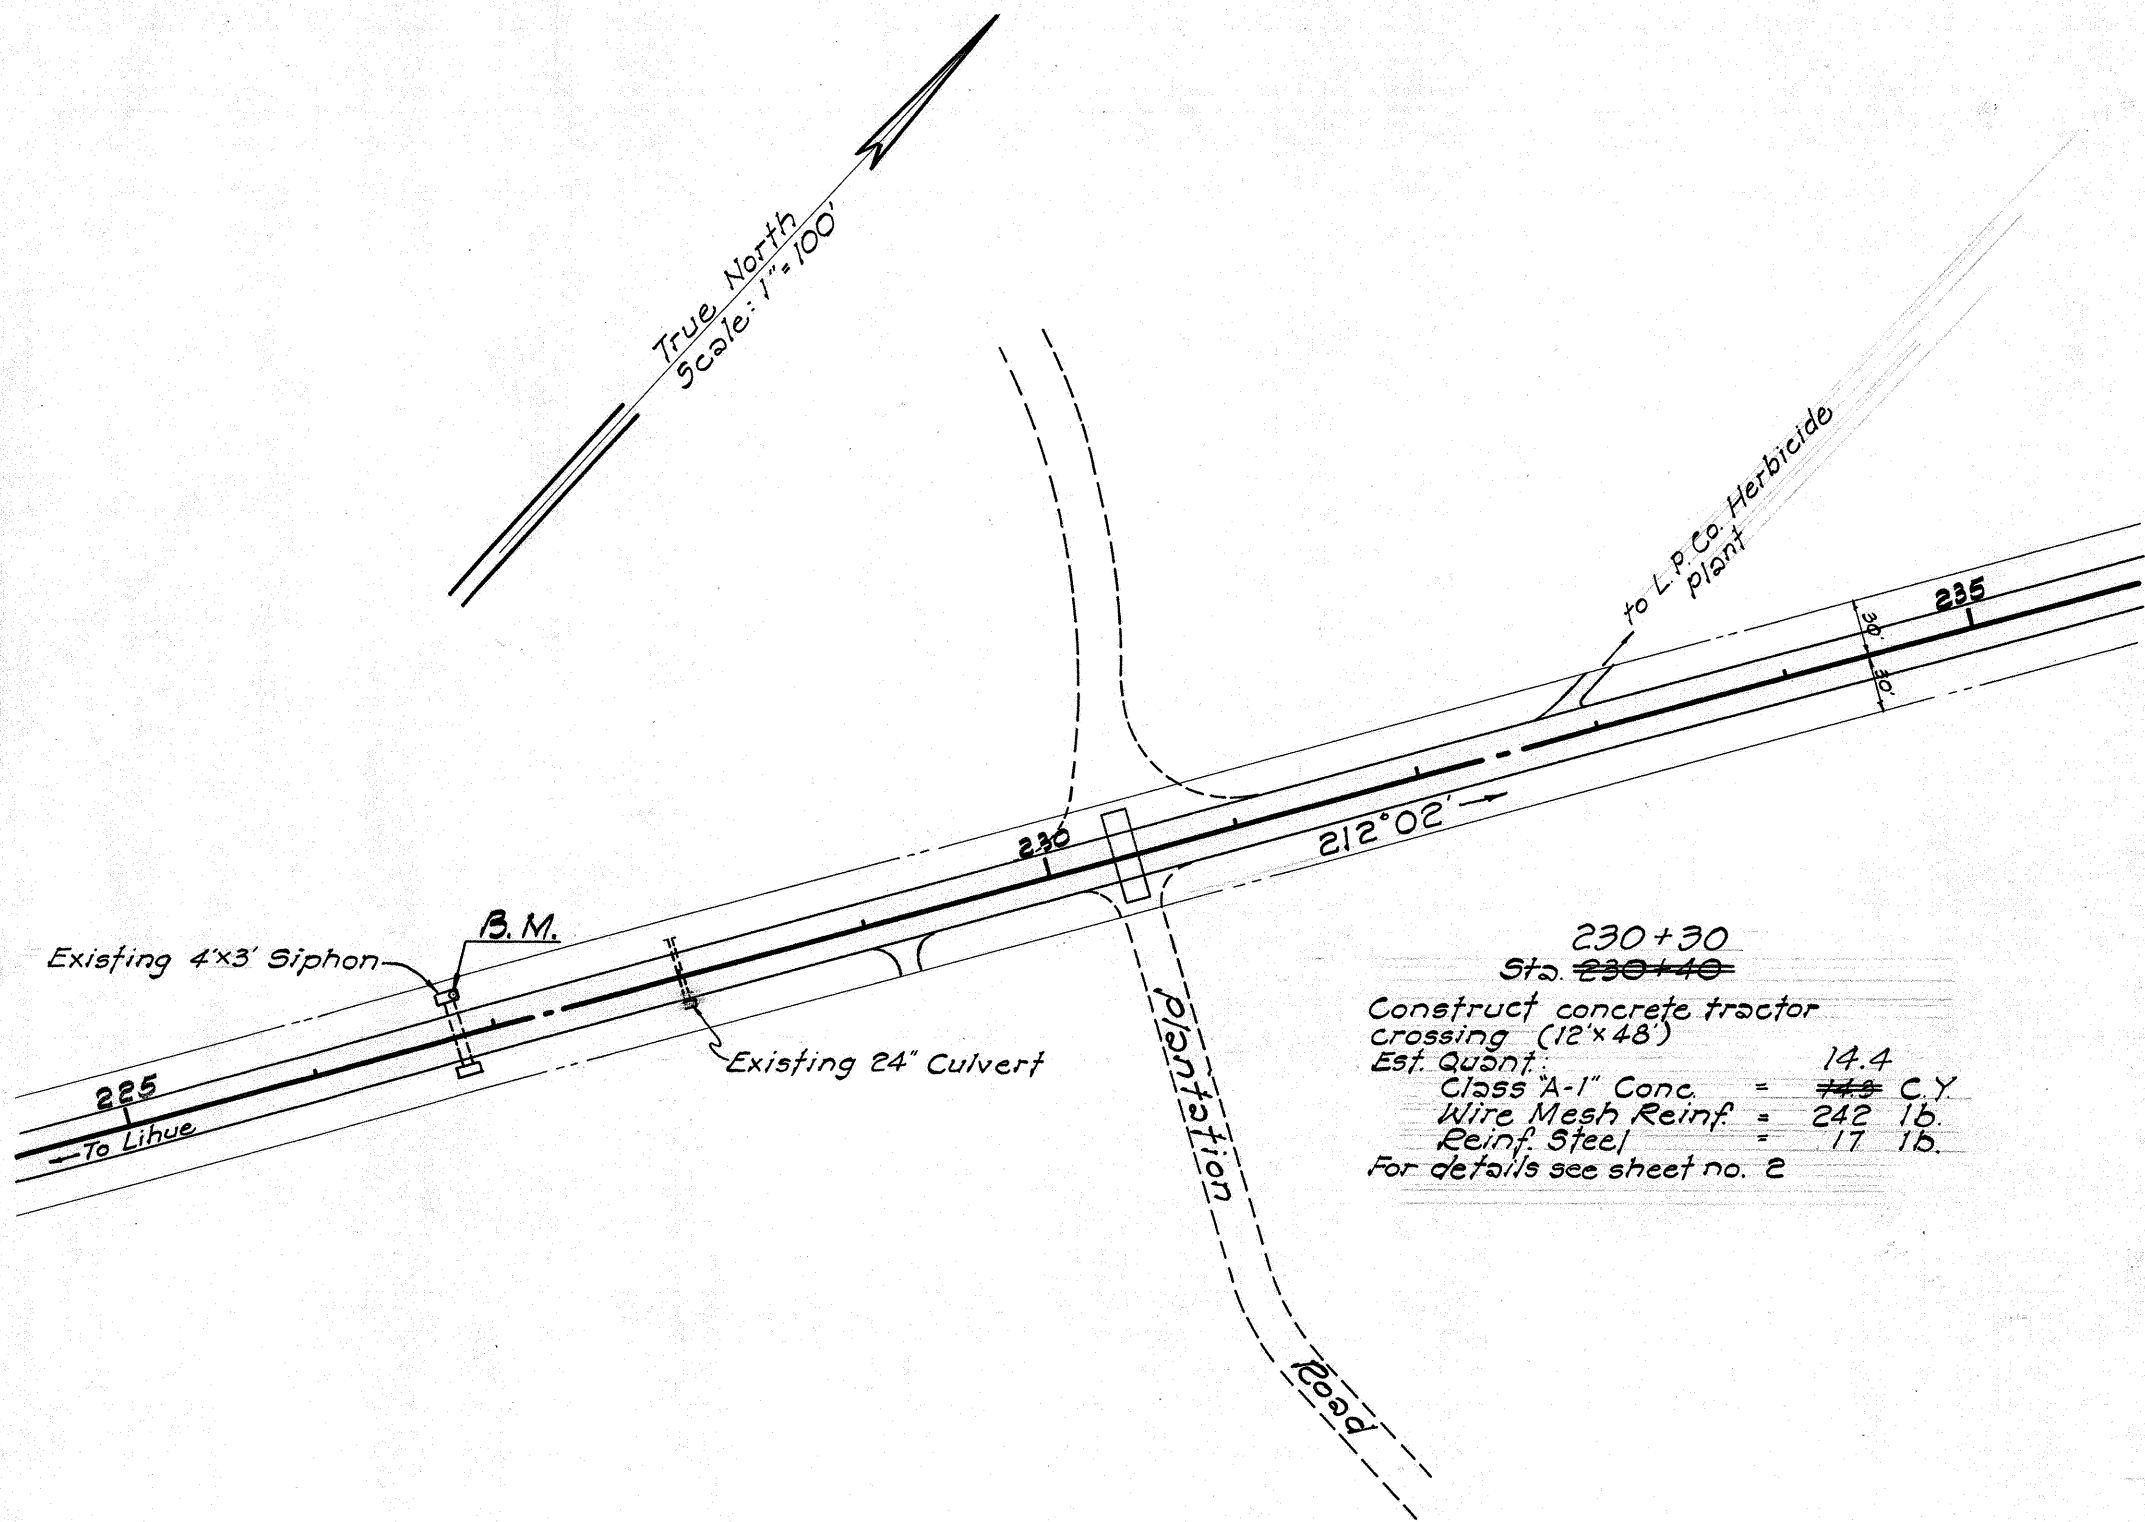

B.M. = "T" on concrete headwall 21' West of Sta. 226+80. Elev. = 91.53

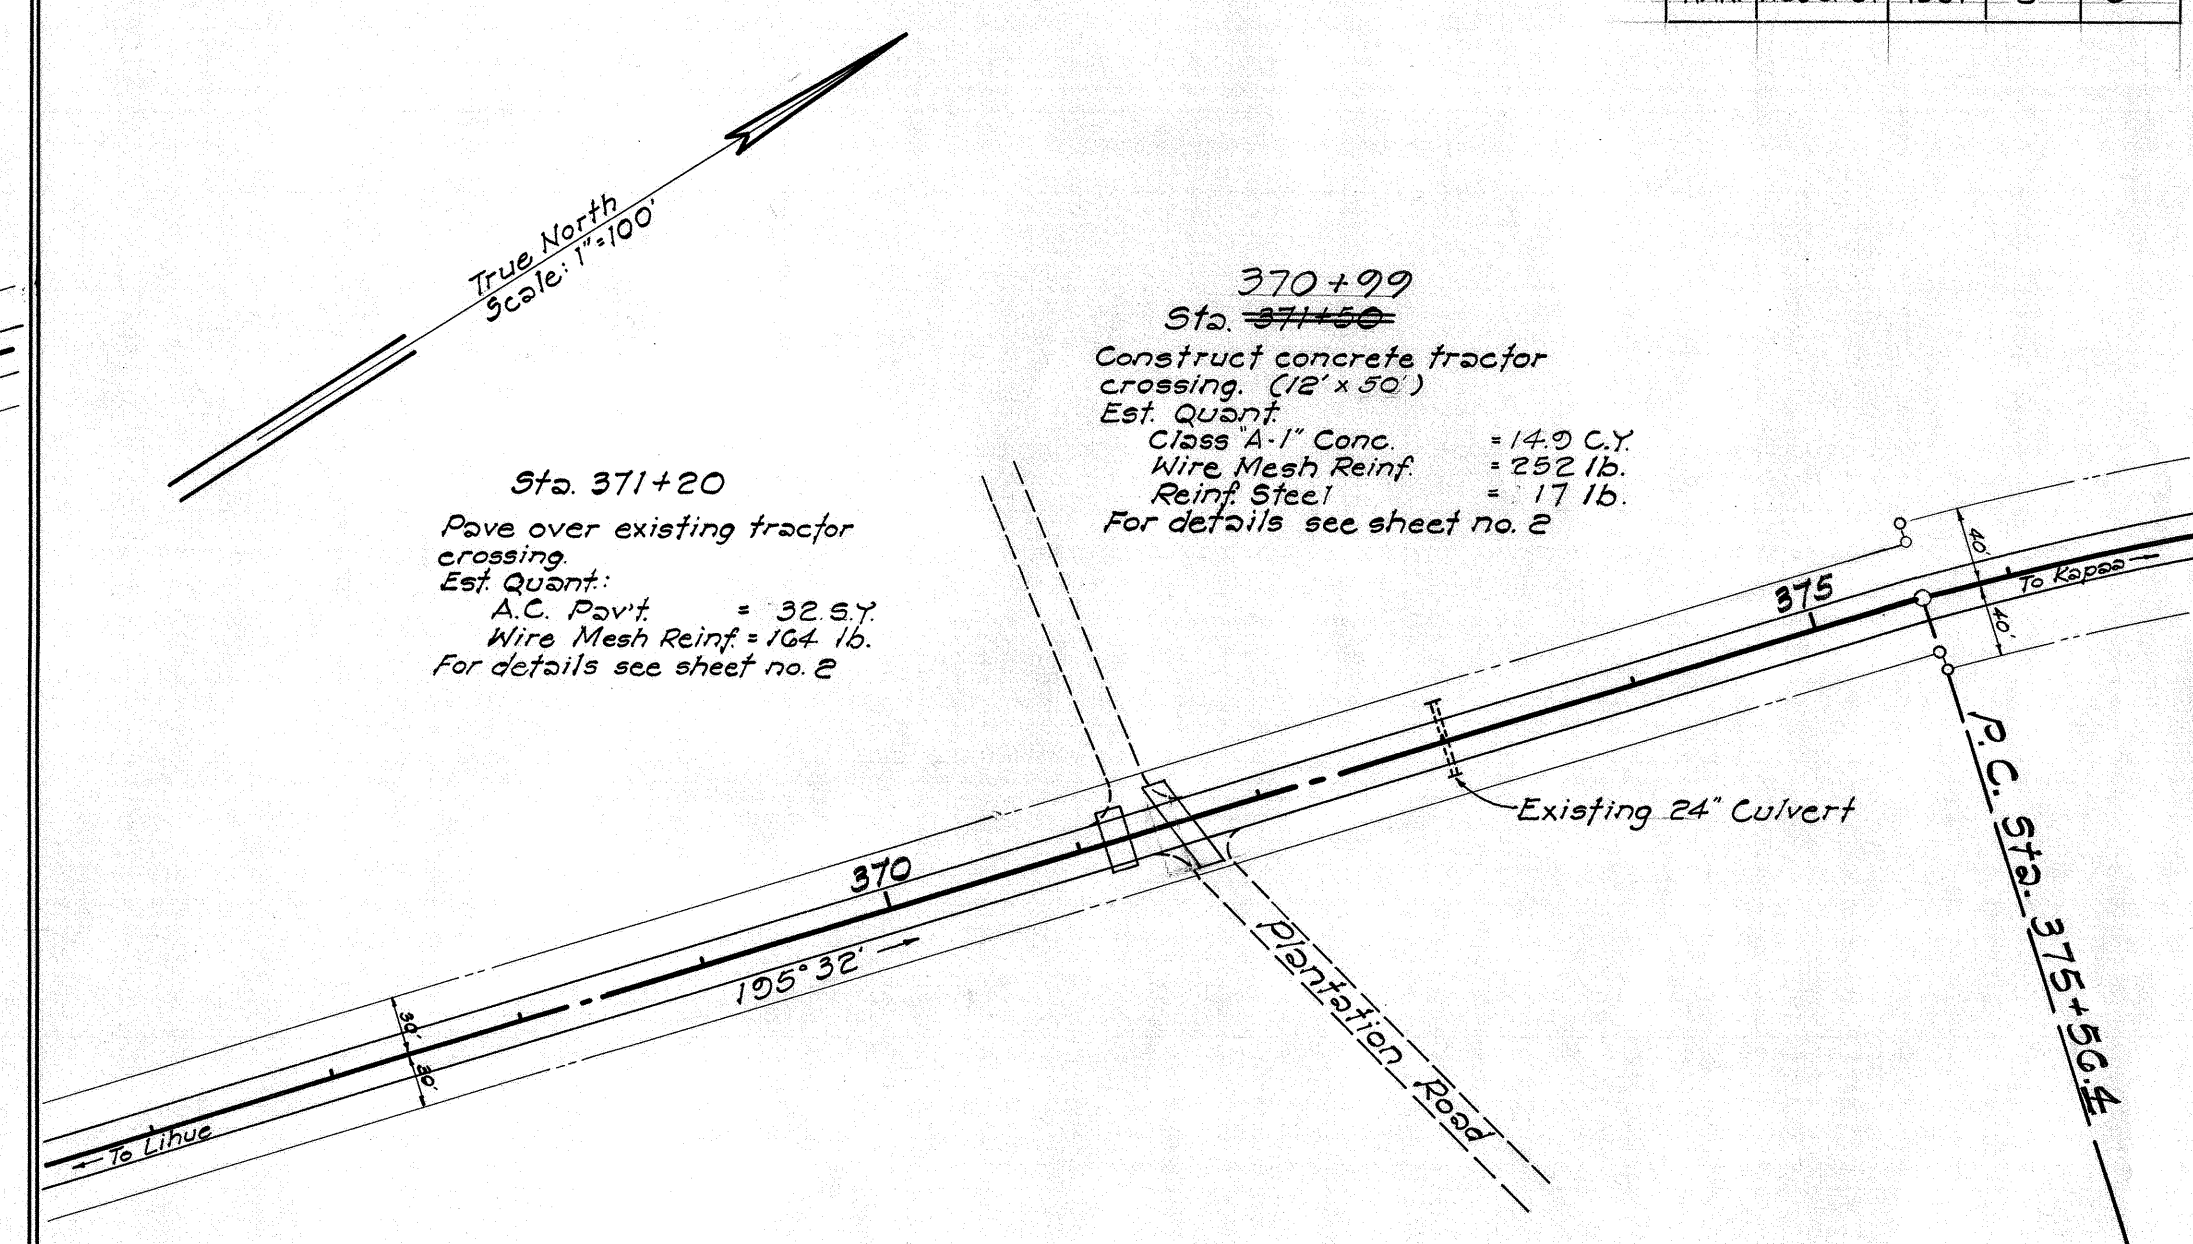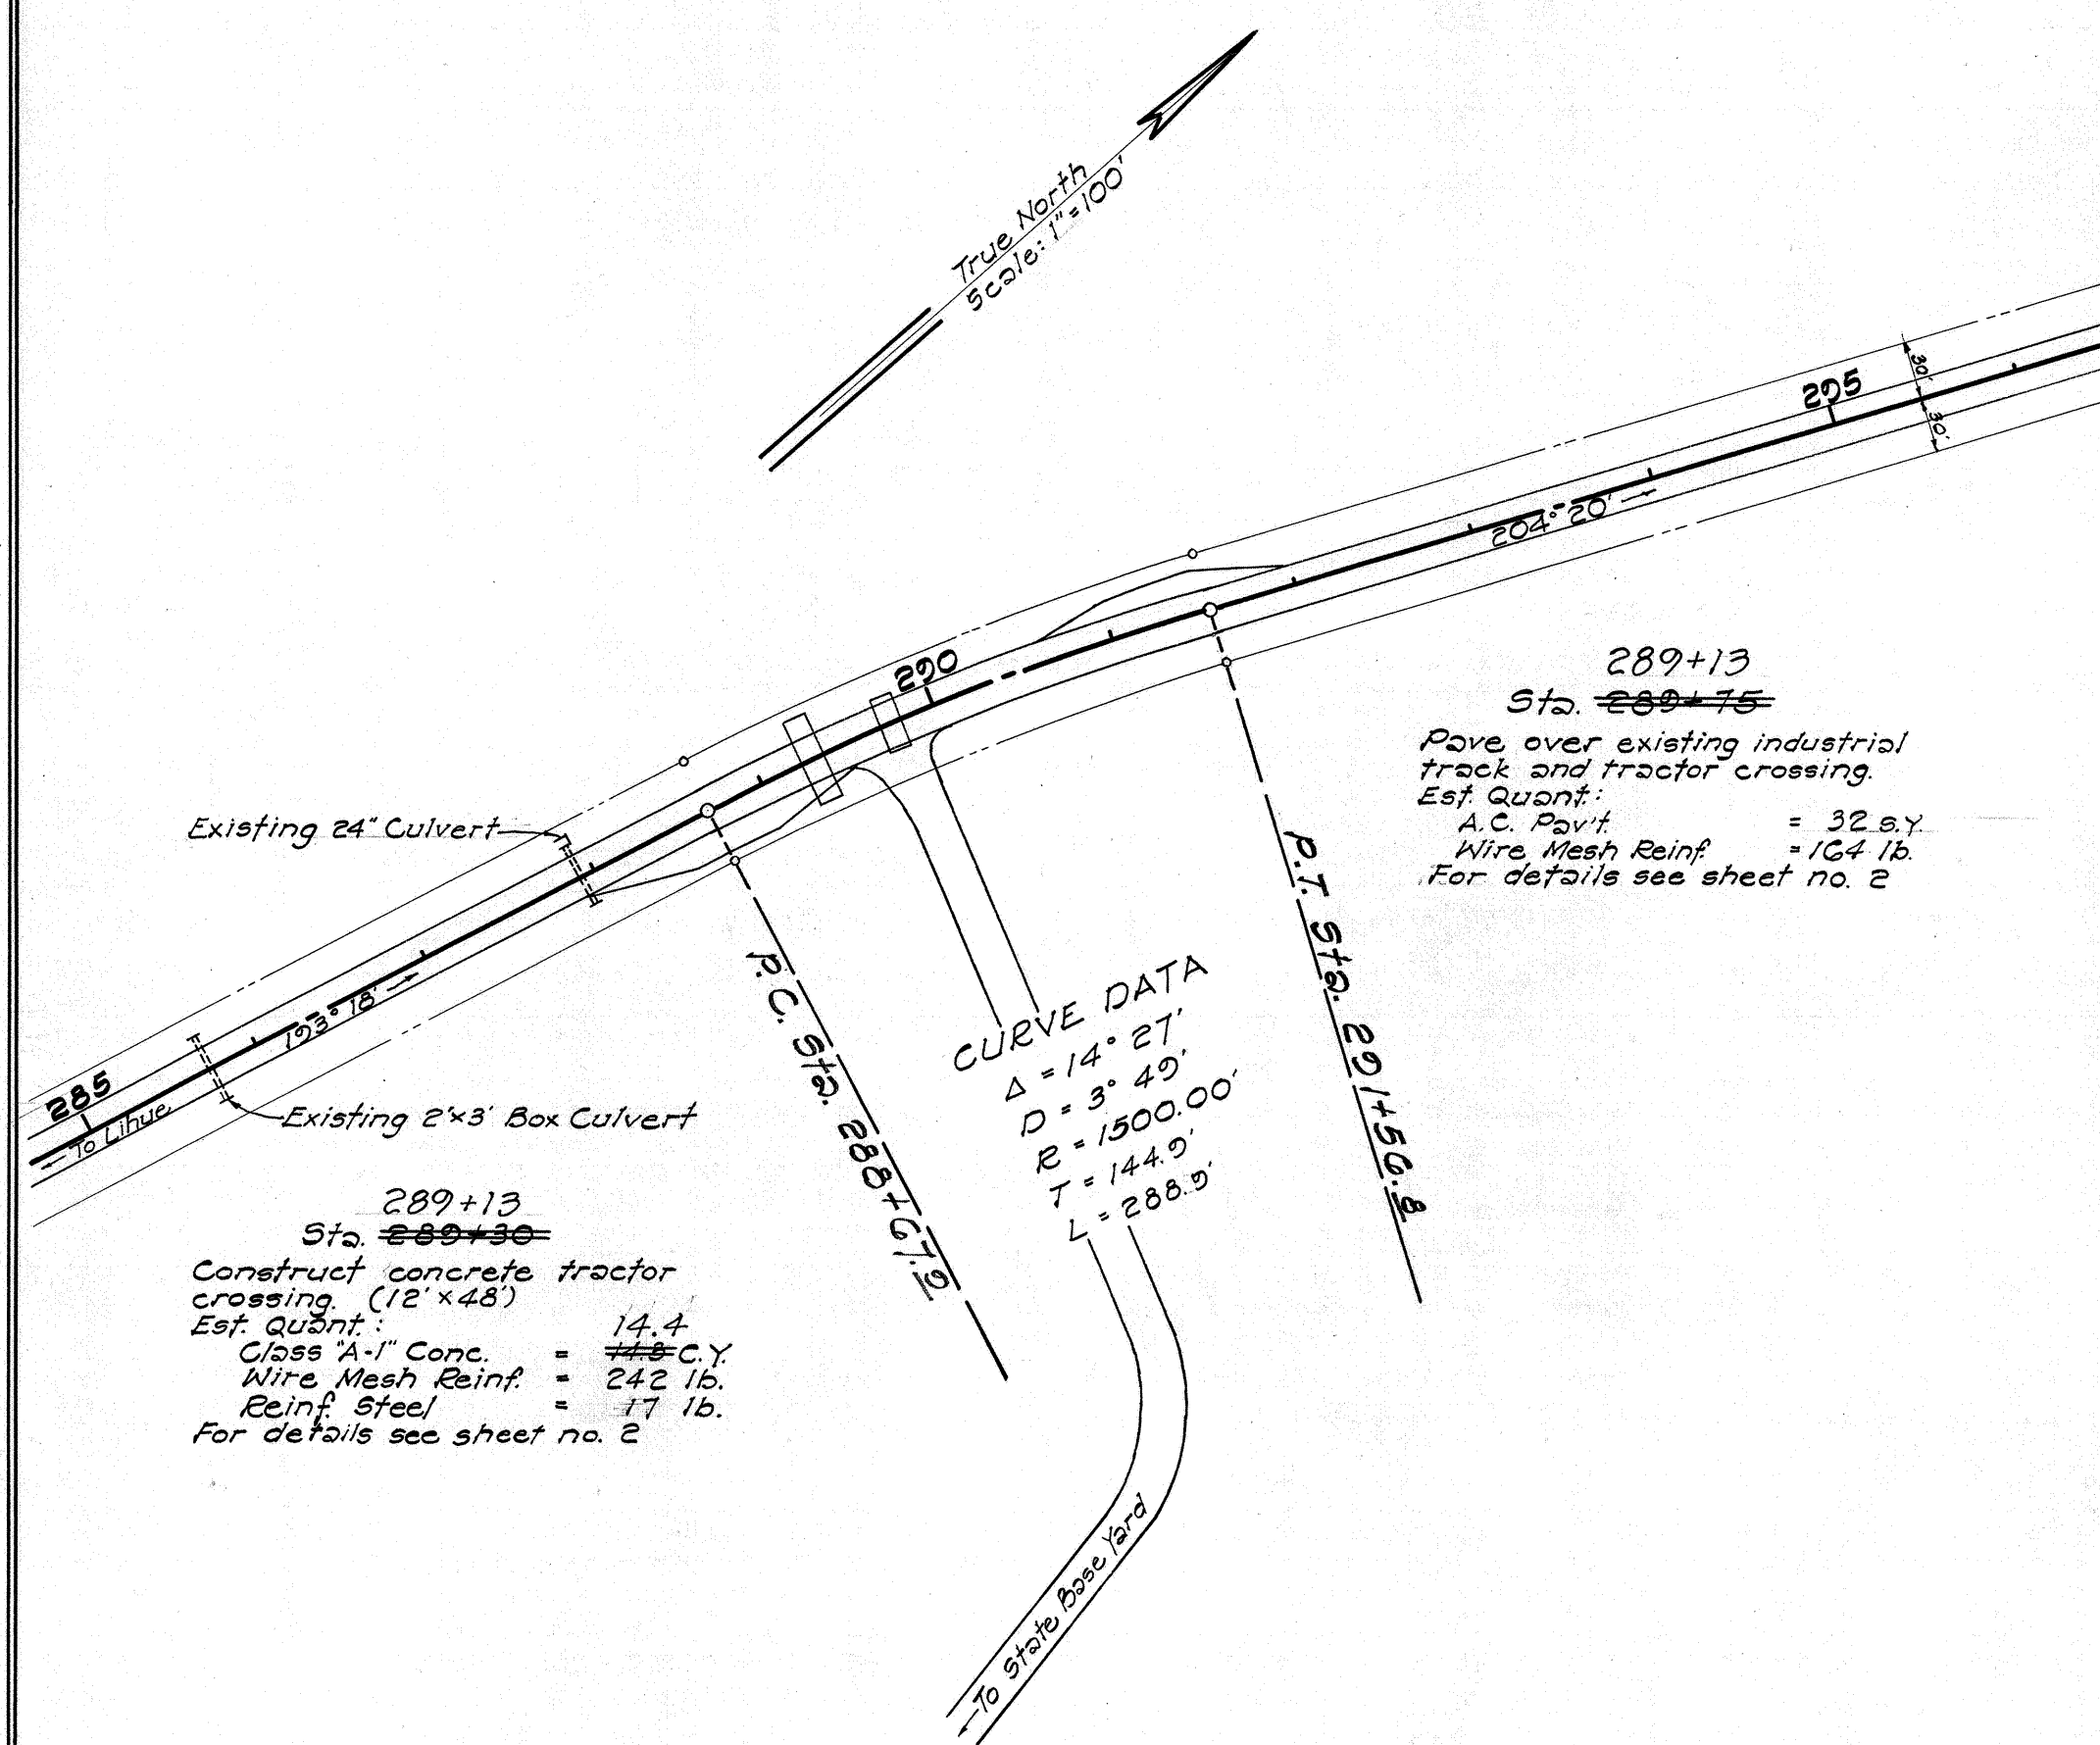

PROFILE	DATE	BY
SURVEYED		
NOTE BOOK		
NO.		

