

INDEX TO DRAWINGS	
SHEET NO.	DESCRIPTION
1	TITLE SHEET
2	TYPICAL SECTION
3-6	PLAN AND PROFILE

STATE OF HAWAII

DEPARTMENT OF TRANSPORTATION

HIGHWAYS DIVISION

"AS BUILT" PLANS FOR

RESURFACING OF A PORTION OF


KAUAI BELT ROAD

F.A.P. PROJECT NO. F 12 (18)

PROJECT NO. A-56-01-64

DISTRICT OF LIHUE


ISLAND OF KAUAI

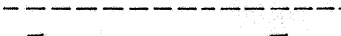CONVENTIONAL SIGNS	
Baseline	
Boundary Line	
Fences (Named)	
Existing Roadway	
Pipe Culvert	
Box Culvert	
Telephone Line & Pole	
Electric Line & Pole	
Water Main	

SCALES	
PLAN	1 INCH = 100 FT.
PROFILE	HOR. 1 INCH = 100 FT.
	VER. 1 INCH = 20 FT.

GROSS LENGTH OF PROJECT.....4.998 MI.

NET LENGTH OF RESURFACING.....4.767 MI.

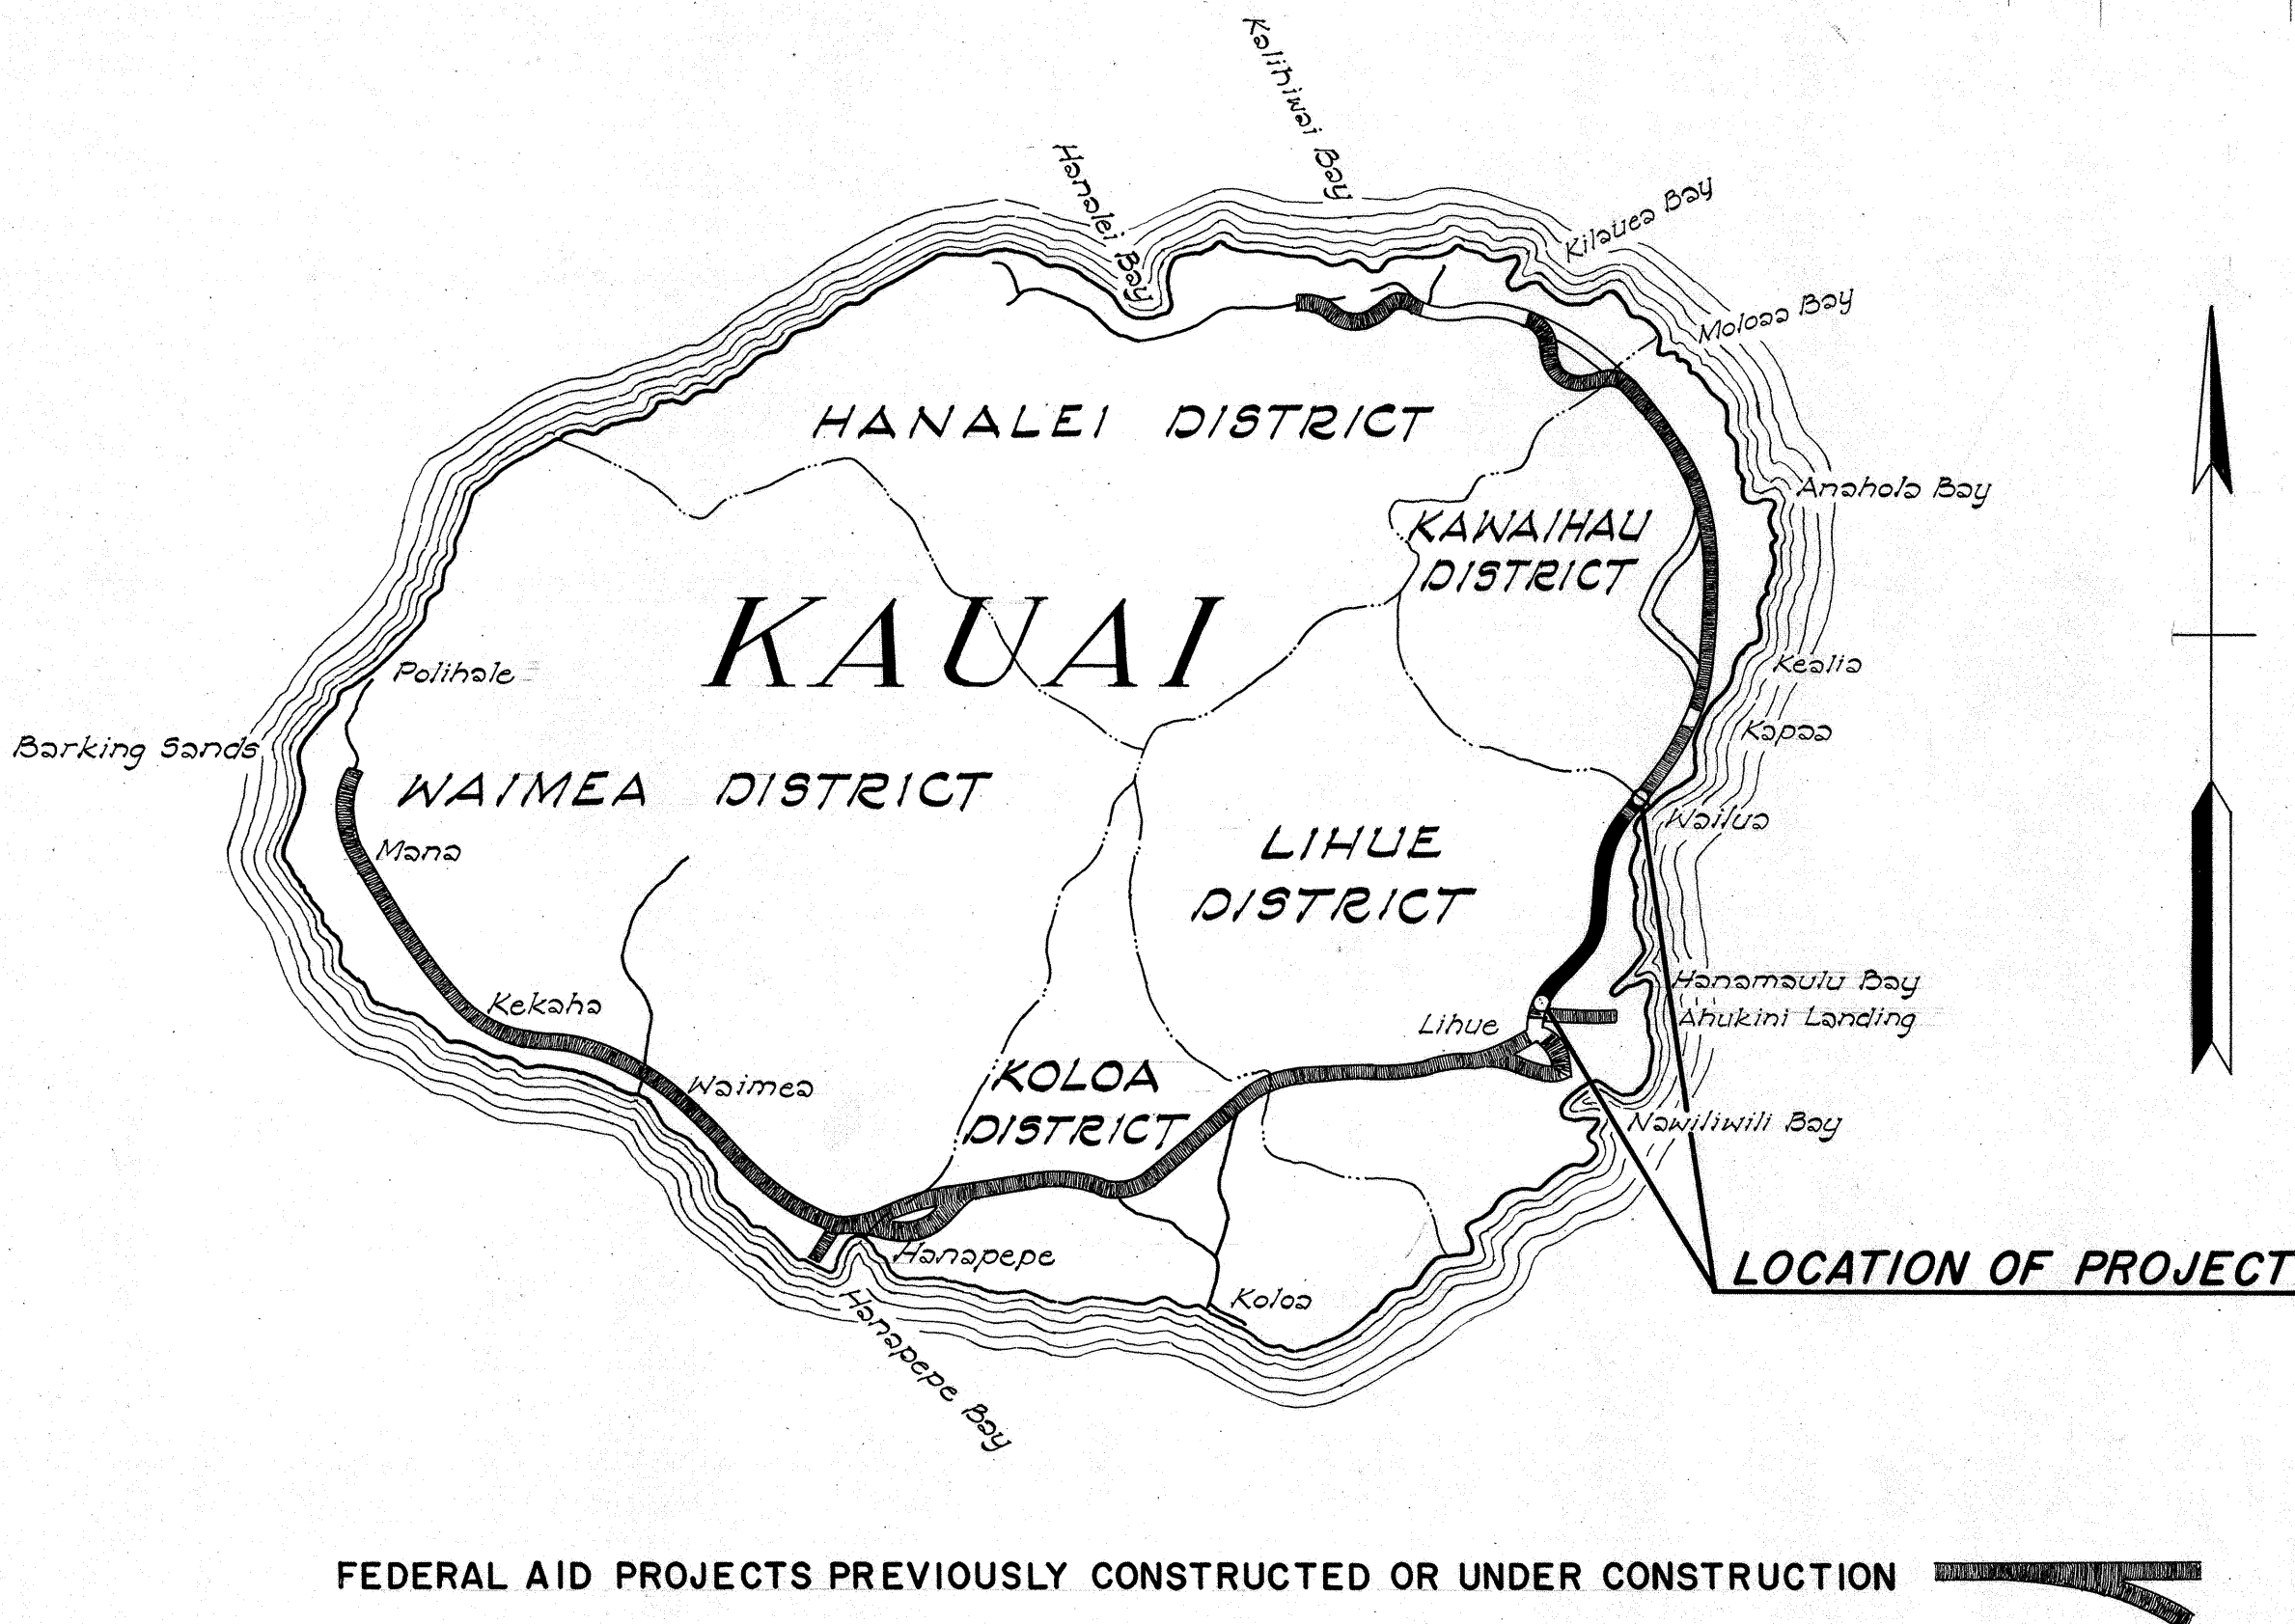

NOTE:


ALL CHANGES MADE DURING CONSTRUCTION HAVE BEEN NOTED IN RED ON THESE TRACINGS AND CHECKED BY:

Masumi Murakami

PROJECT ENGINEER

9 Mar 67

DATE

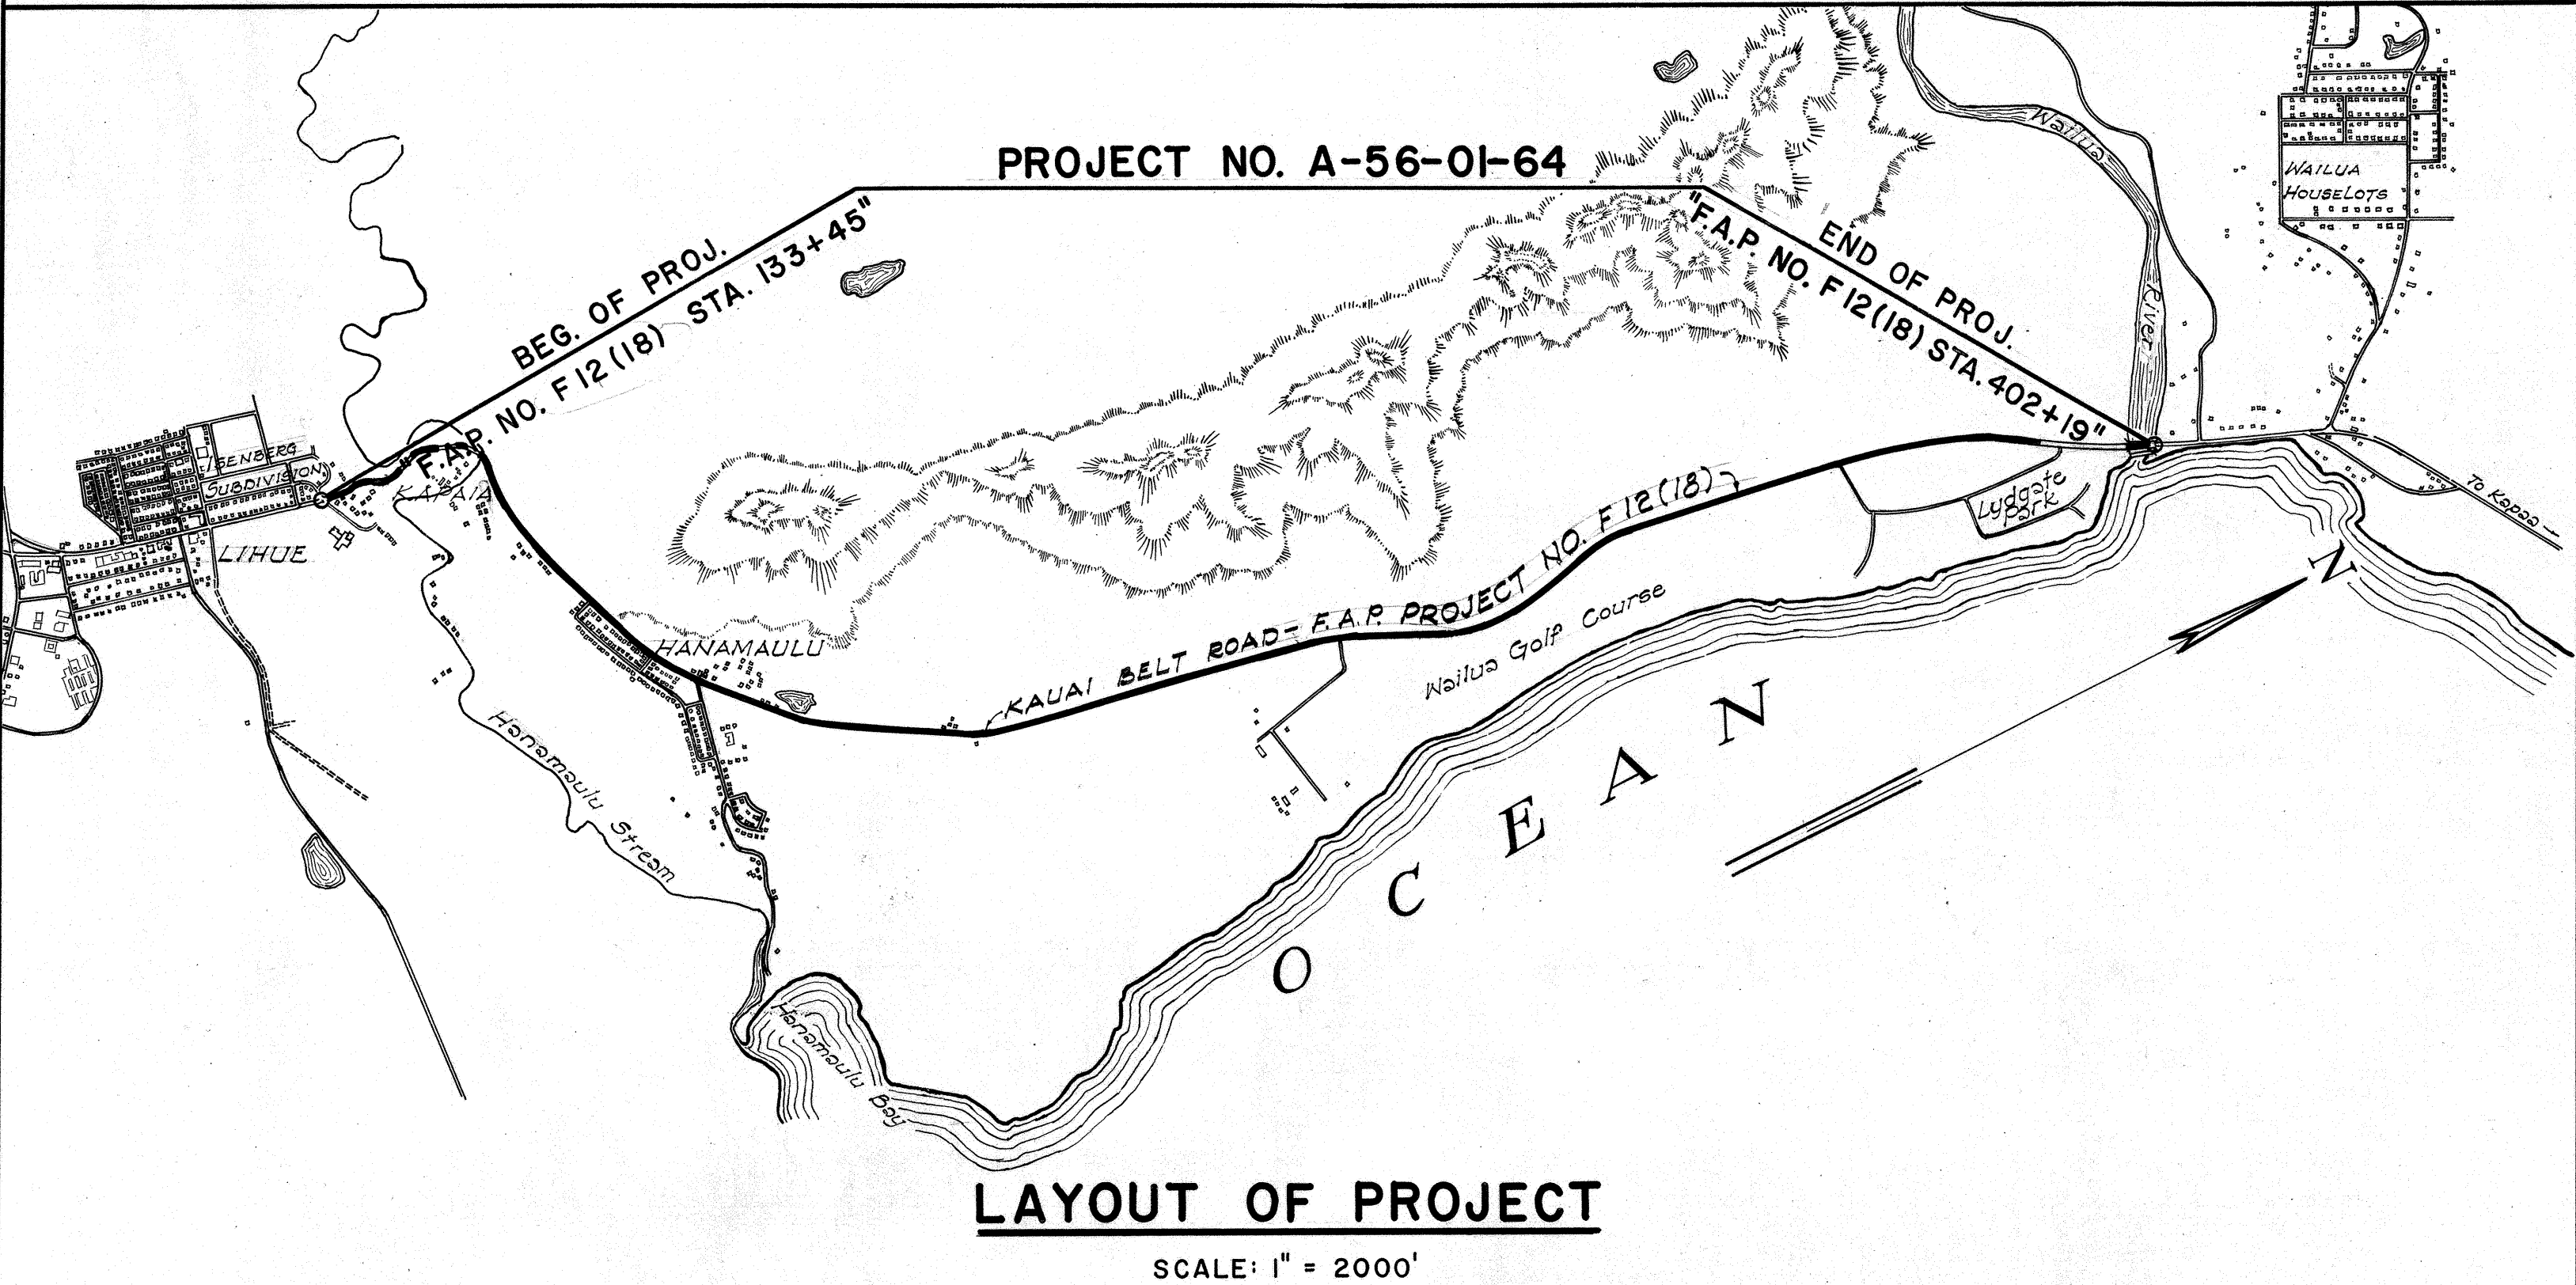

APPROVED:

DATE: 16 Nov 64

Juicio Matsuda

DIRECTOR OF TRANSPORTATION