

INDEX TO DRAWINGS	
SHEET NO.	DESCRIPTION
1	TITLE SHEET
2	CONSTRUCTION DETAILS

STATE OF HAWAII

DEPARTMENT OF TRANSPORTATION

HIGHWAYS DIVISION

HONOLULU, HAWAII

"AS BUILT"


PLANS OF

REHABILITATION OF WAILUA BRIDGE


KAUAI BELT ROAD - PROJ. NO. A-56-02-64

LIHUE DISTRICT

ISLAND OF KAUAI

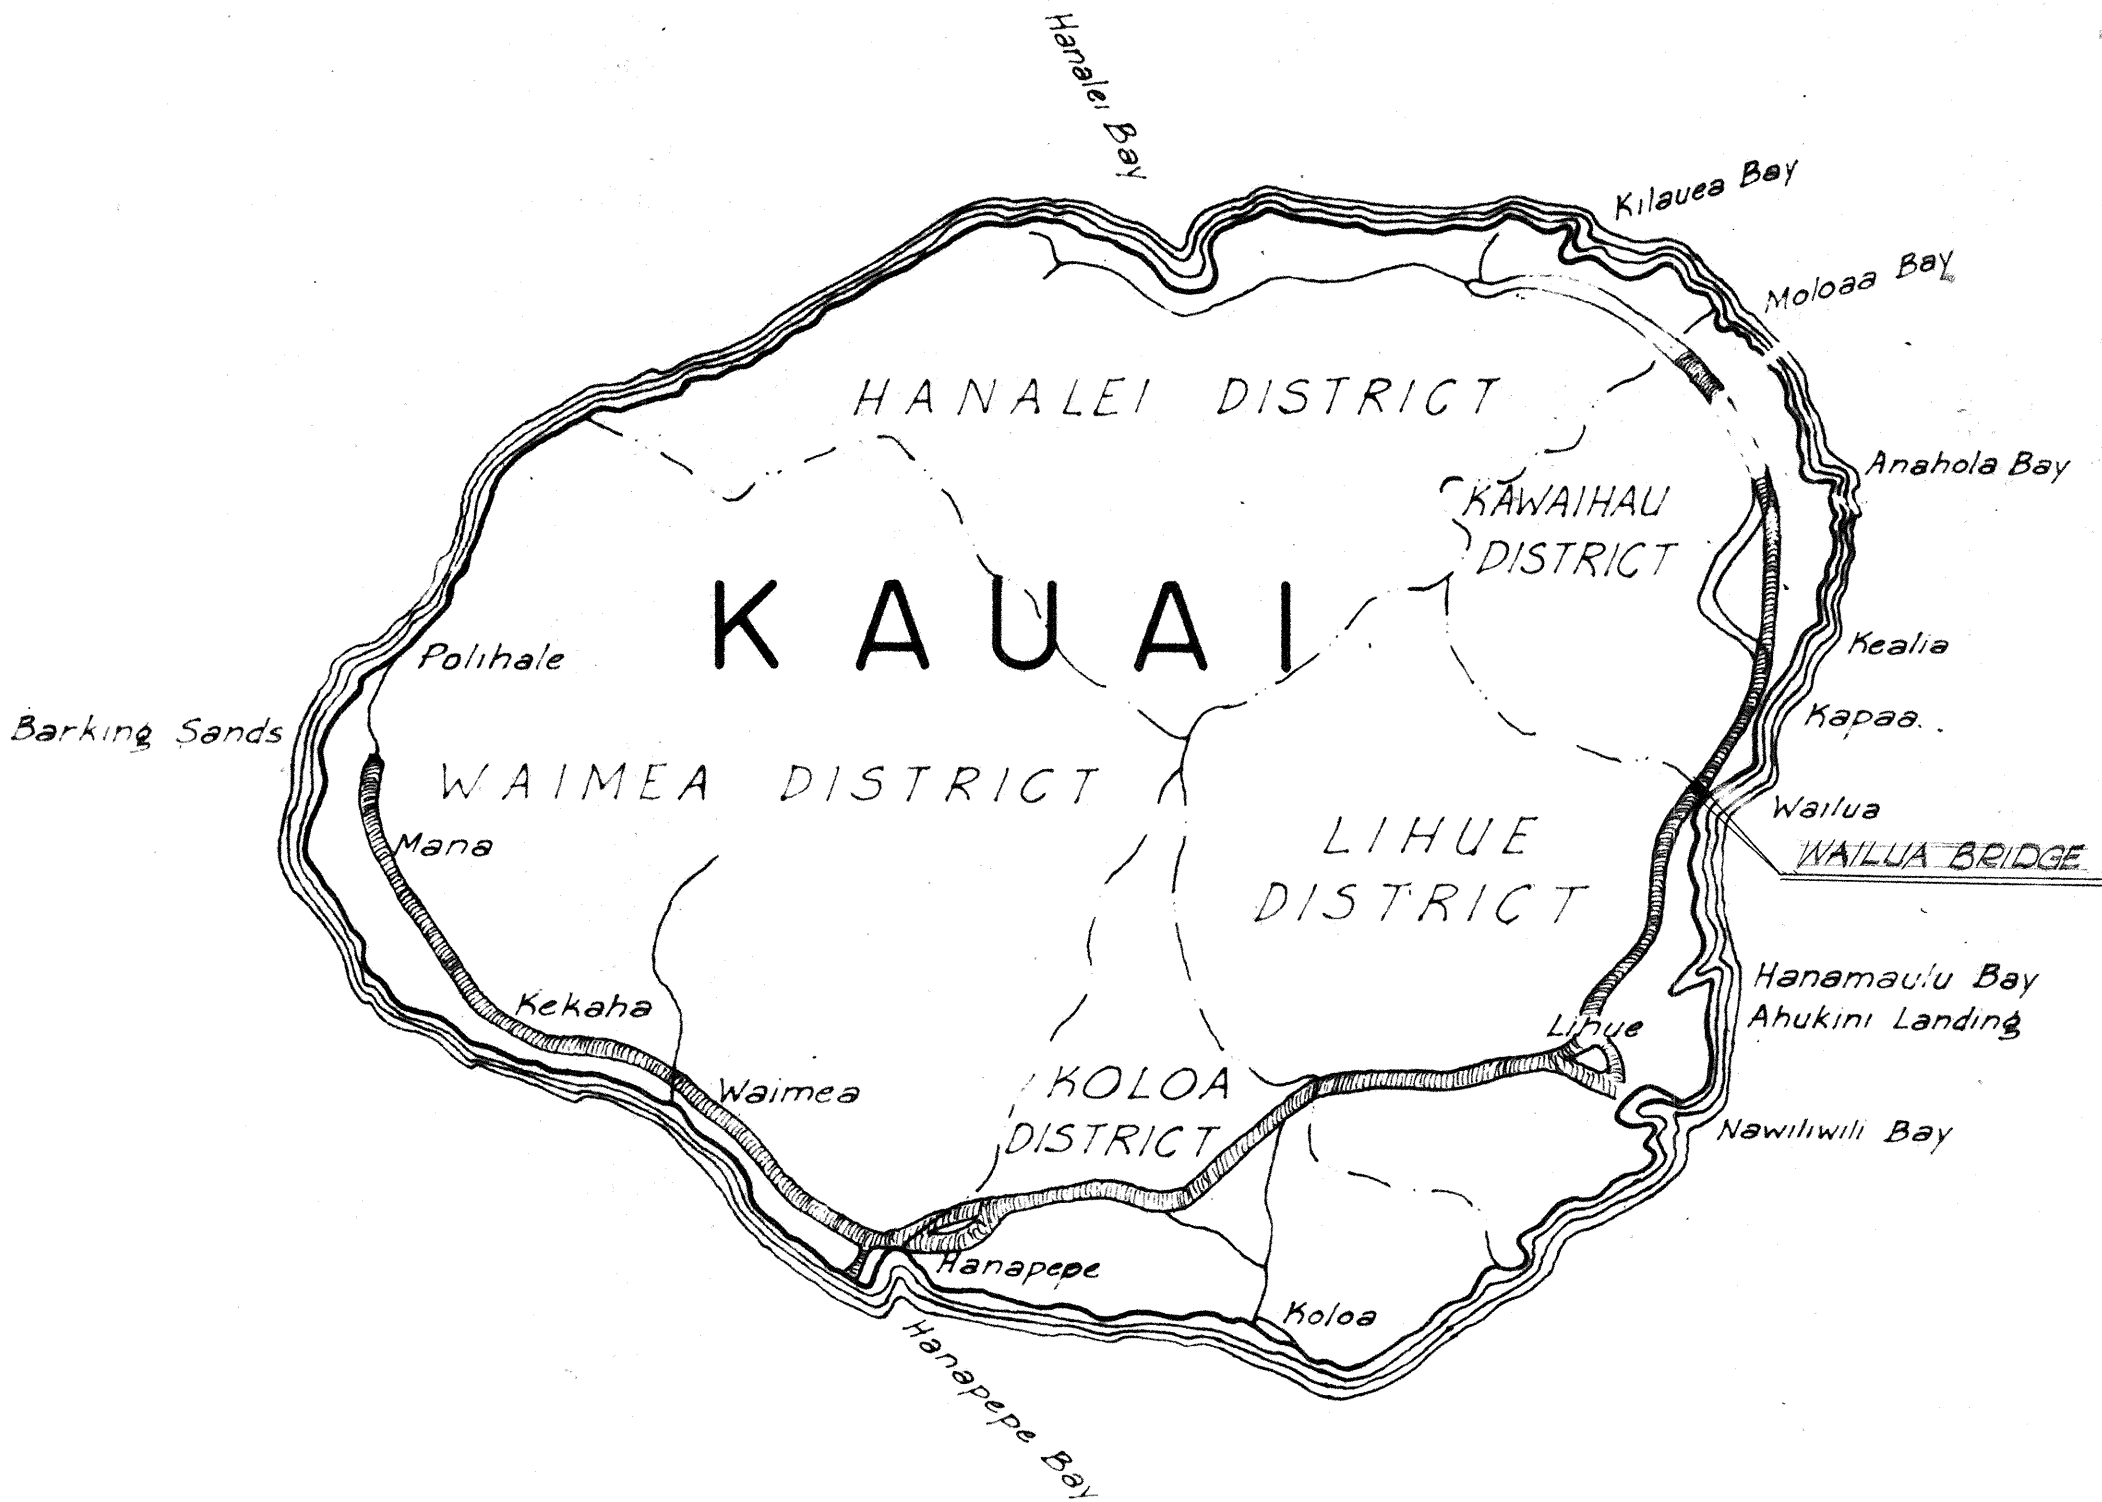

FEDERAL AID PROJECTS PREVIOUSLY CONSTRUCTED OR UNDER CONSTRUCTION

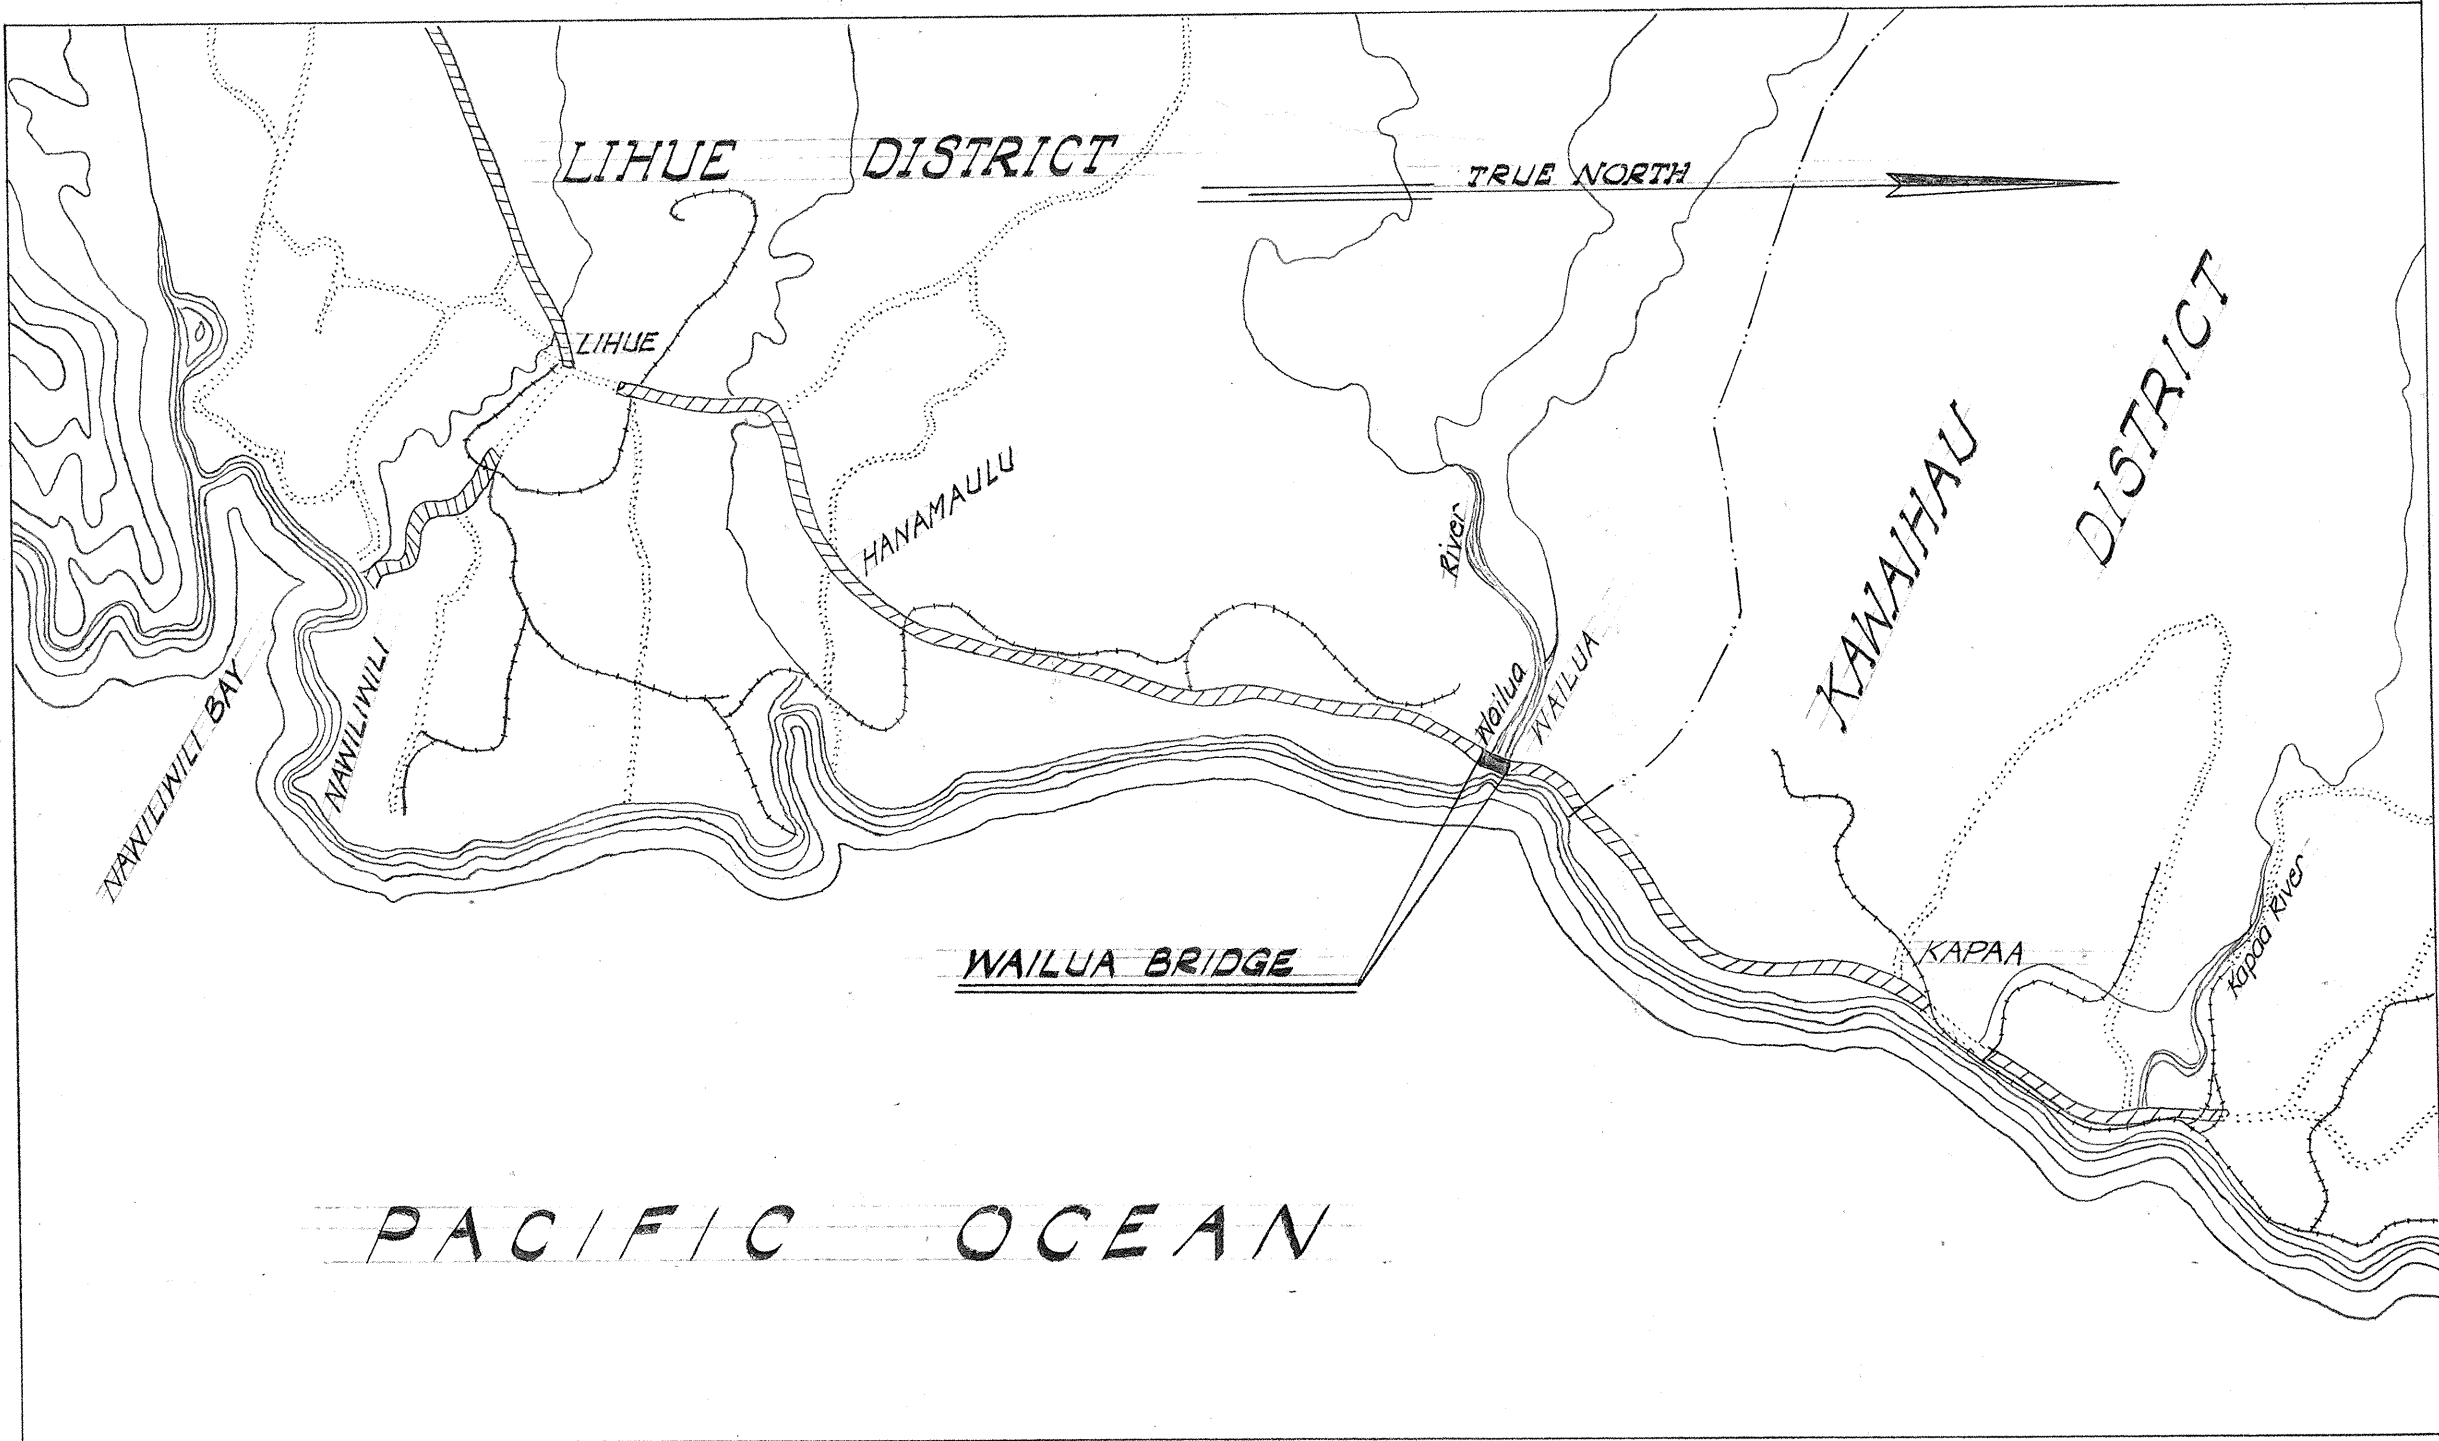

NOTE: ALL CHANGES MADE DURING CONSTRUCTION ARE SHOWN IN RED ON THESE TRACINGS AND CHECKED BY:

Shigeto Yamashita
PROJECT ENGINEER

5/14/68
DATE

APPROVED: *Lejio Matsuda* DATE *6 May 68*
DIRECTOR OF TRANSPORTATION

S I T E P L A N