



INDEX TO DRAWINGS	
SHEET NO.	DESCRIPTION
1	TITLE SHEET
2	TYPICAL SECTIONS
3 & 4	PLAN AND PROFILE

STATE OF HAWAII
DEPARTMENT OF TRANSPORTATION
HIGHWAYS DIVISION
PLANS FOR
RESURFACING OF A PORTION OF
"AS BUILT"KAUAI BELT ROAD
(WAILUA TOWARDS KAPAA)
(F.A.P. PROJECT NO. F 12(18))
PROJECT NO. A-56-02-65
DISTRICT OF KAWAIHAU
ISLAND OF KAUAI

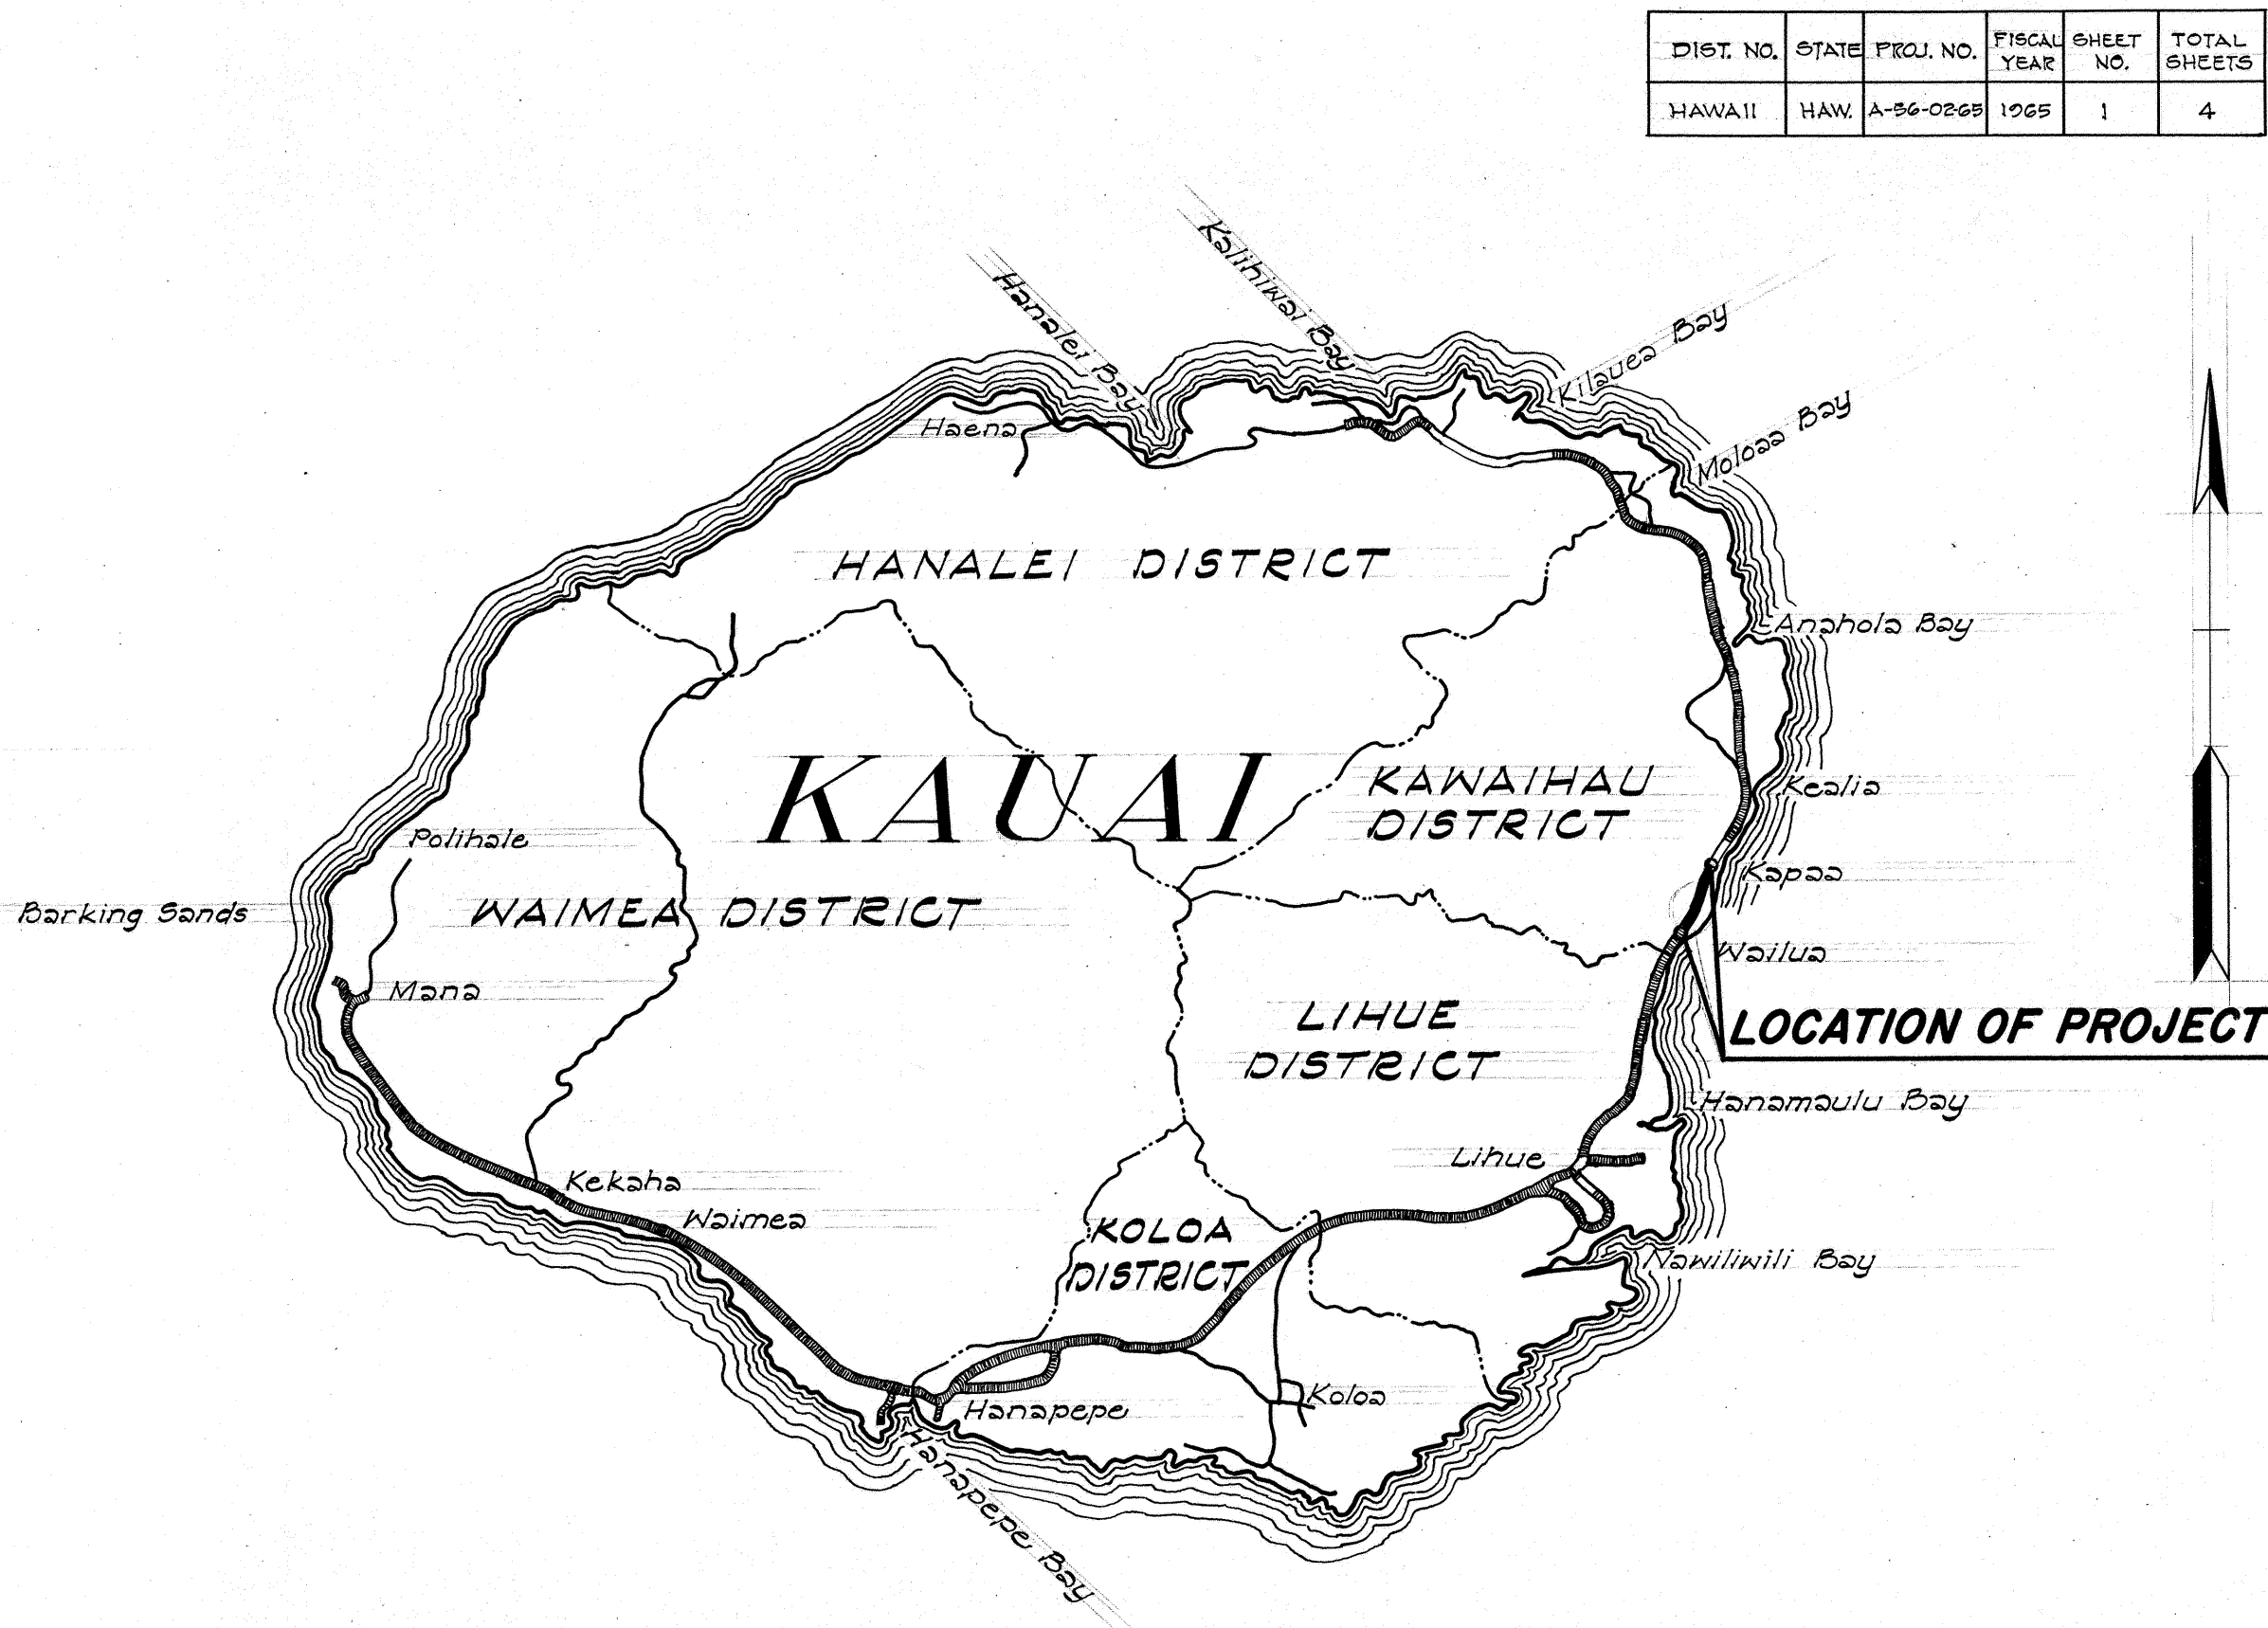

CONVENTIONAL	SIGNS
Baseline	7.5
Boundary Line	
Fences (Named)	
Existing Roadway	
Pipe Culvert	
Box Culvert	
Telephone Line & Pole	
Electric Line & Pole	
Water Main	

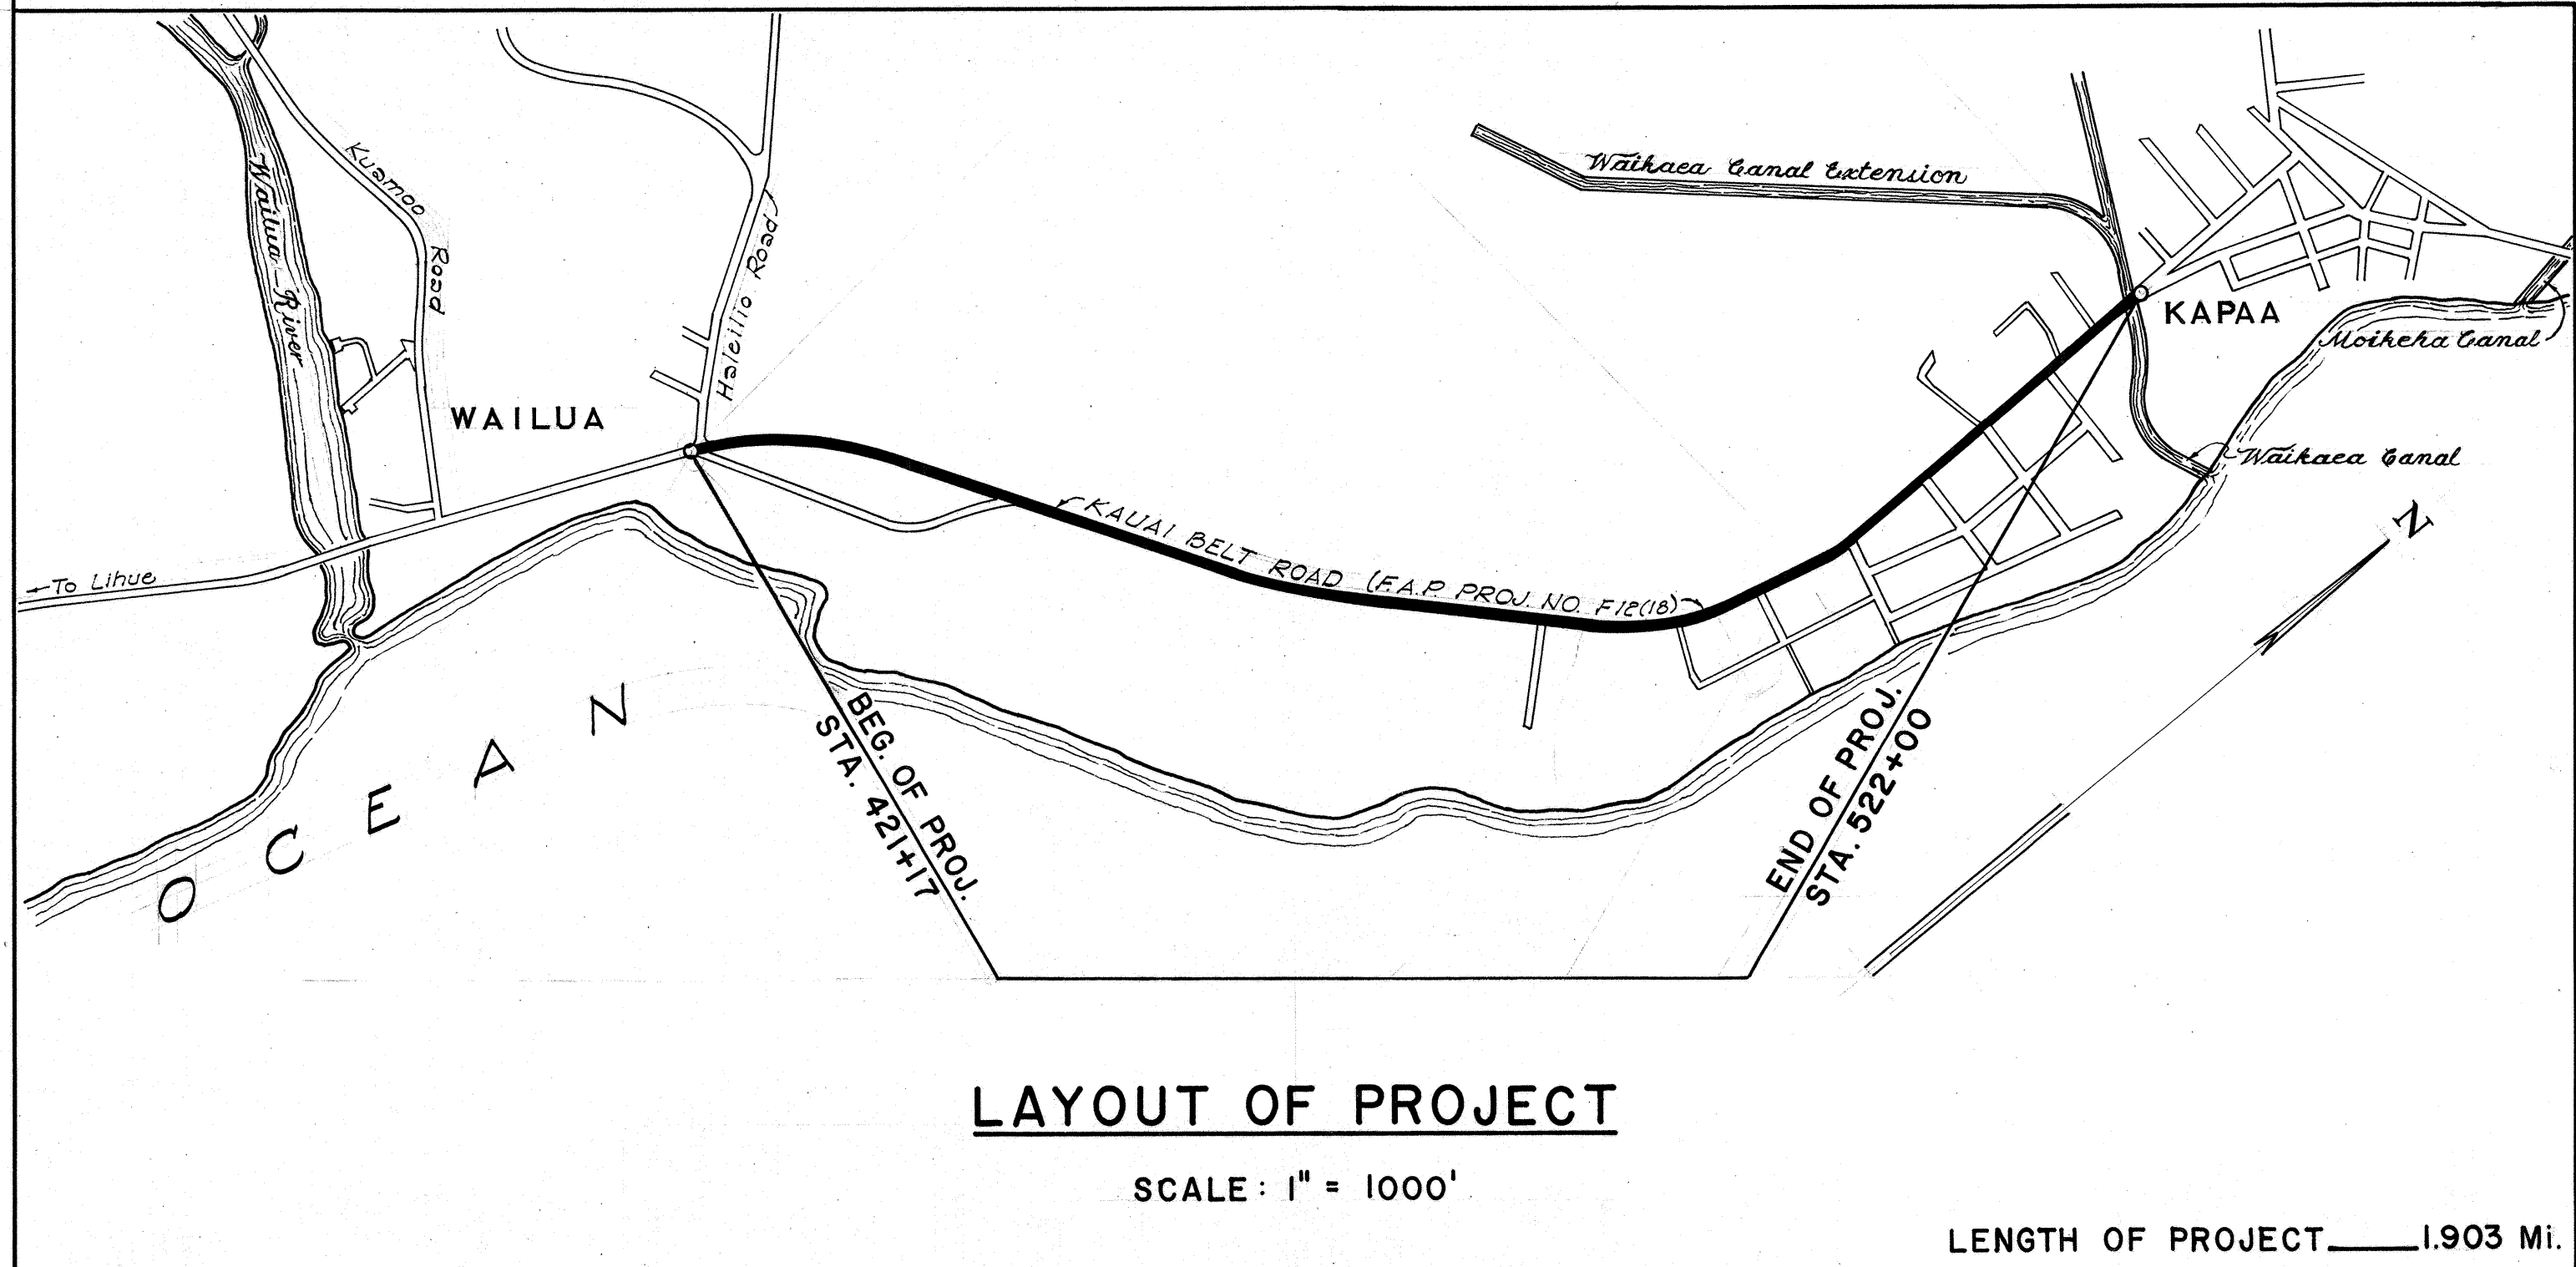

NOTE:
ALL CHANGES MADE DURING CONSTRUCTION HAVE BEEN NOTED IN RED ON THESE TRACINGS AND CHECKED BY:

Mariam M. M. M.
PROJECT ENGINEER
9 Mar 67
DATE

APPROVED DATE 4 June 65
Luis V. V.
DIRECTOR OF TRANSPORTATION