

INDEX TO DRAWINGS	
SHEET NO.	DESCRIPTION
1	Title Sheet
2-3	Typical Sections and Plan & Profile
4-7	Drainage Details

STATE OF HAWAII

DEPARTMENT OF TRANSPORTATION

HIGHWAYS DIVISION

AS BUILT PLANS FOR

STORM DRAIN SYSTEM AT ISENBERG TRACT

ALONG


KAUAI BELT ROAD

(F.A.P. PROJECT NO. F 12 (18))


PROJECT NO. A-56-01-65

DISTRICT OF LIHUE

ISLAND OF KAUAI

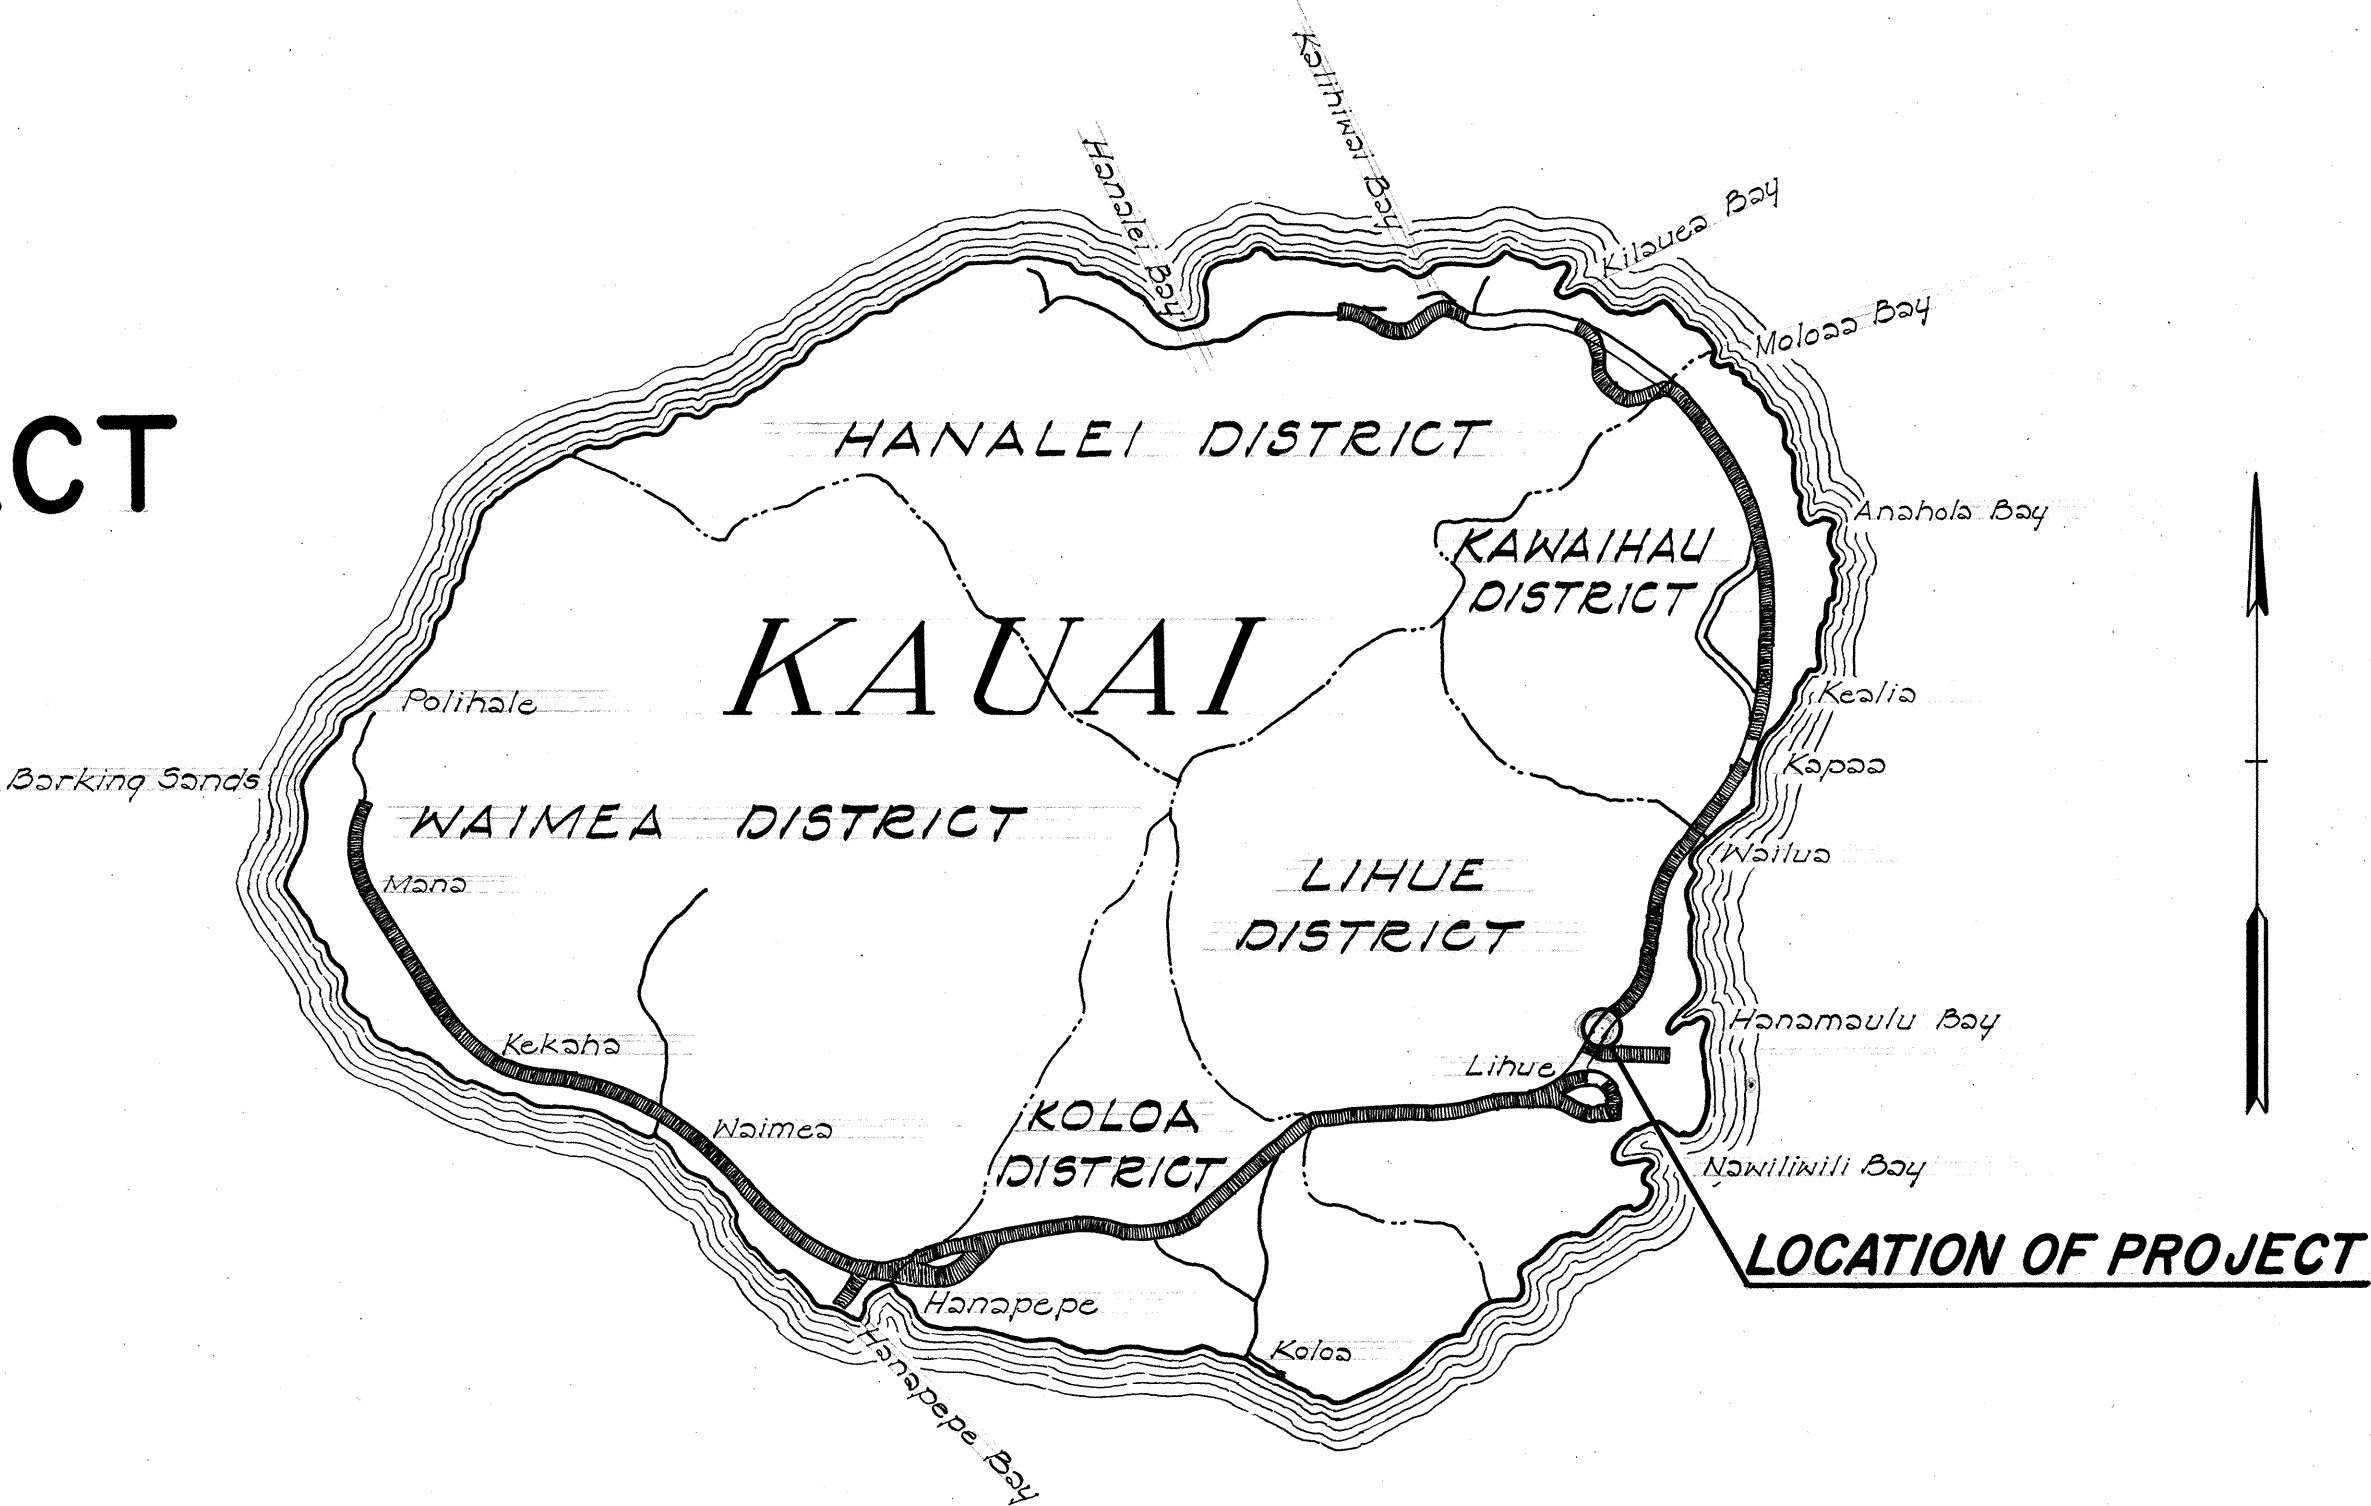

CONVENTIONAL	SIGNS
Baseline	75
Boundary Line	
Fences (Named)	
Existing Roadway	
Pipe Culvert	
Box Culvert	
Telephone Line & Pole	
Electric Line & Pole	
Water Main	

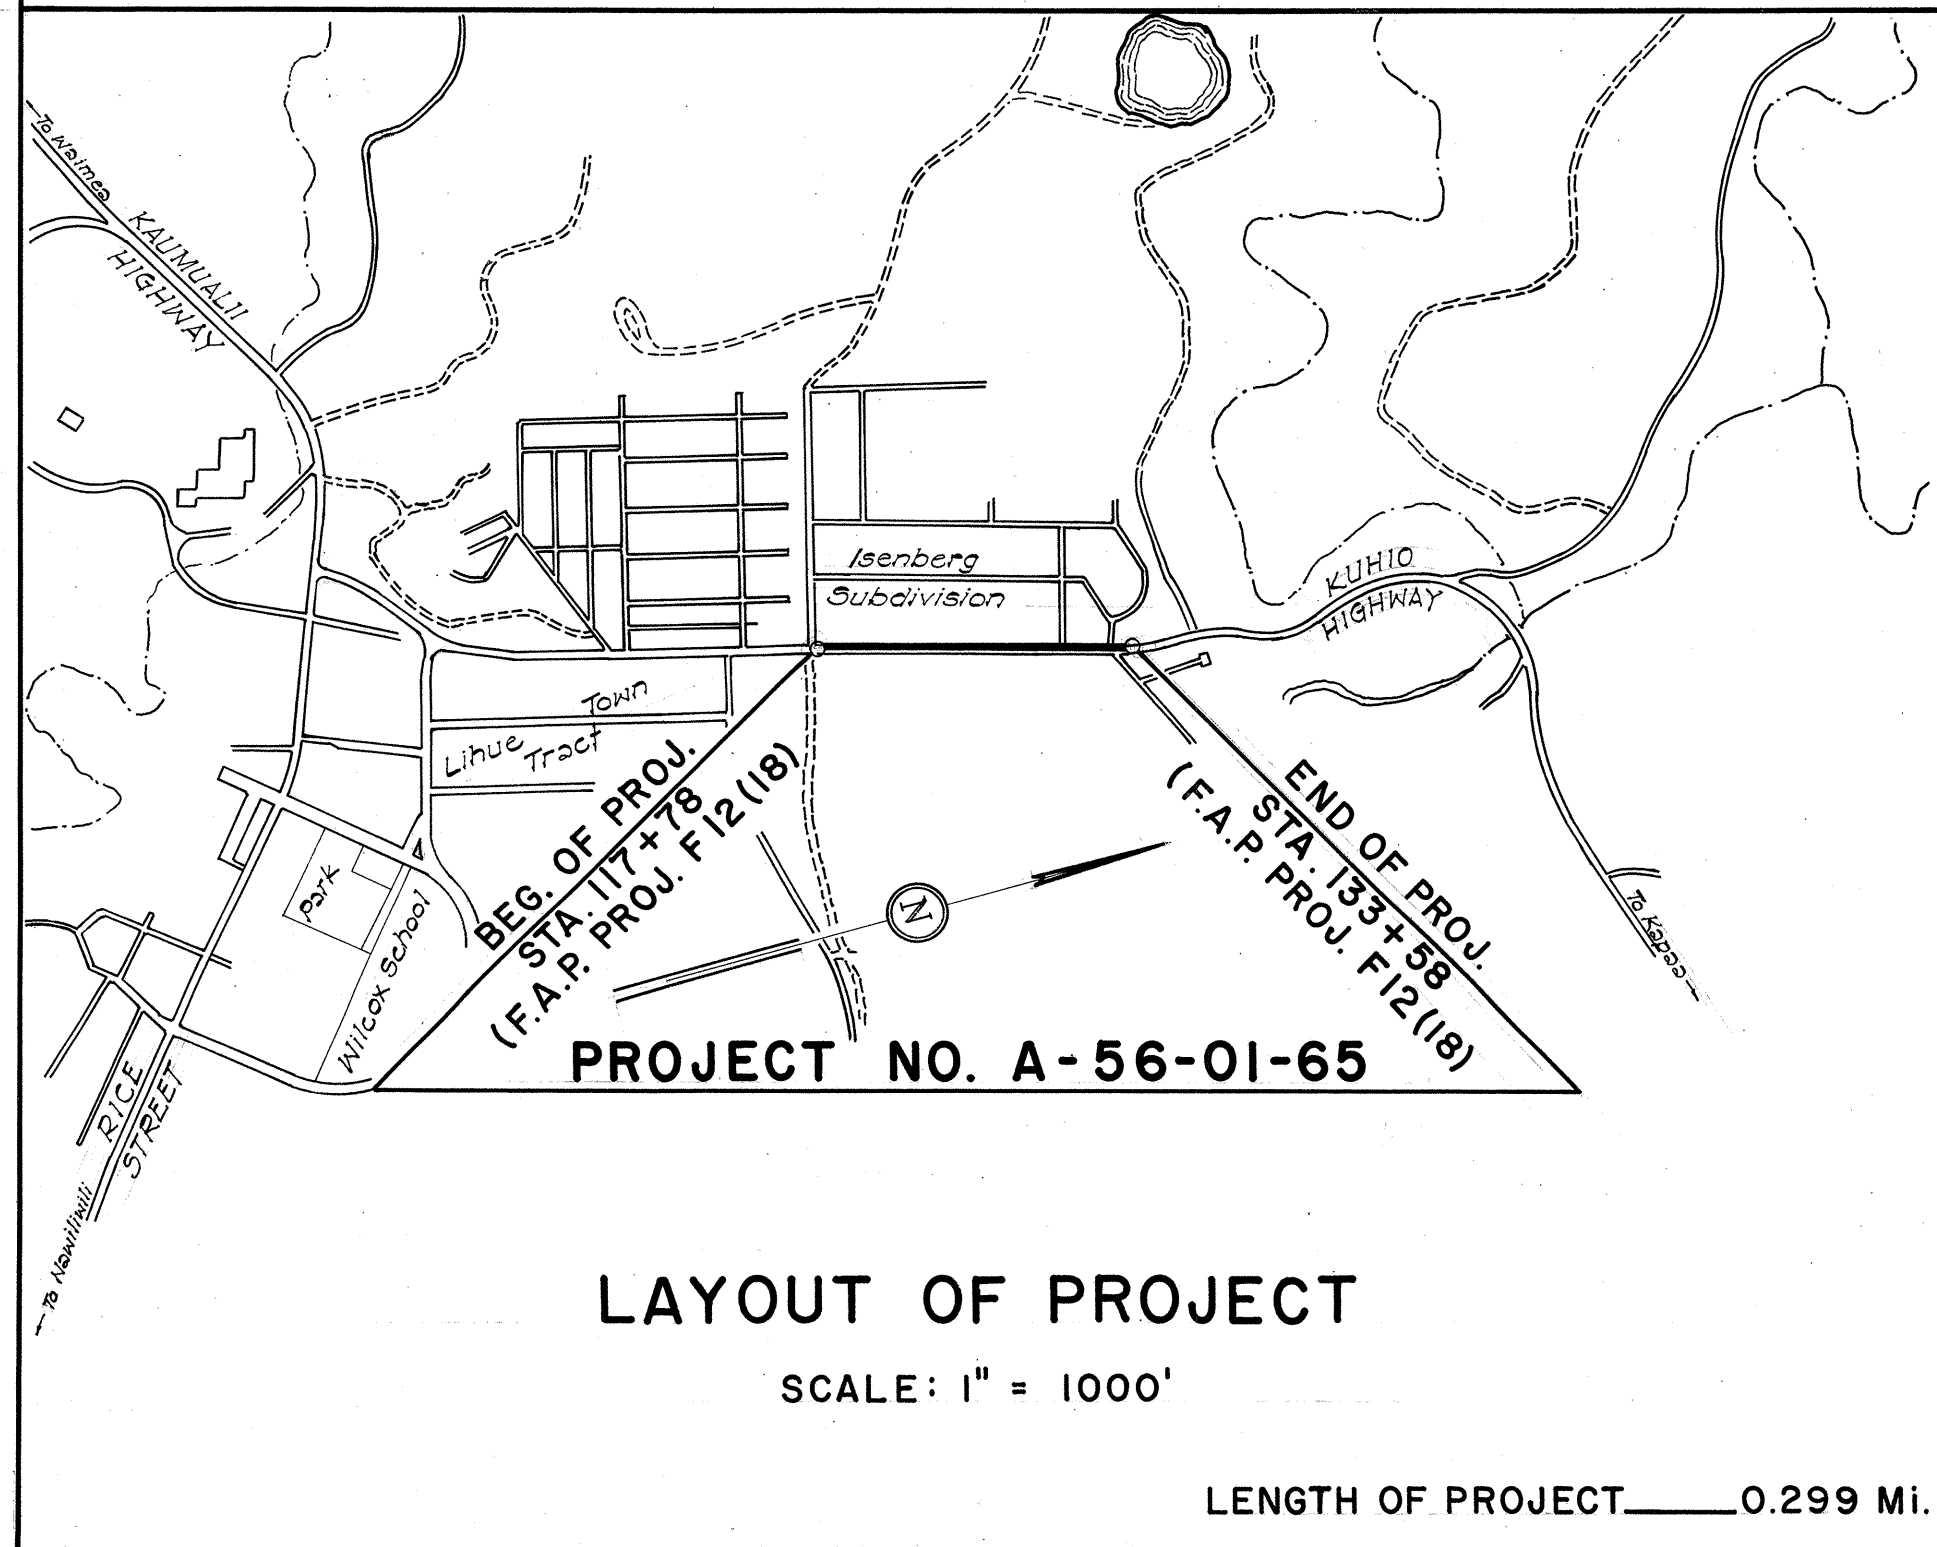

NOTE:
ALL CHANGES MADE DURING
CONSTRUCTION HAVE BEEN NOTED
IN RED ON THESE TRACINGS
AND CHECKED BY:

Peter J. Chamales

PROJ. ENGINEER

8/29/66

DATE

APPROVED :

Raibo A. Kuka

Director of Transportation

12-9-65

Date