
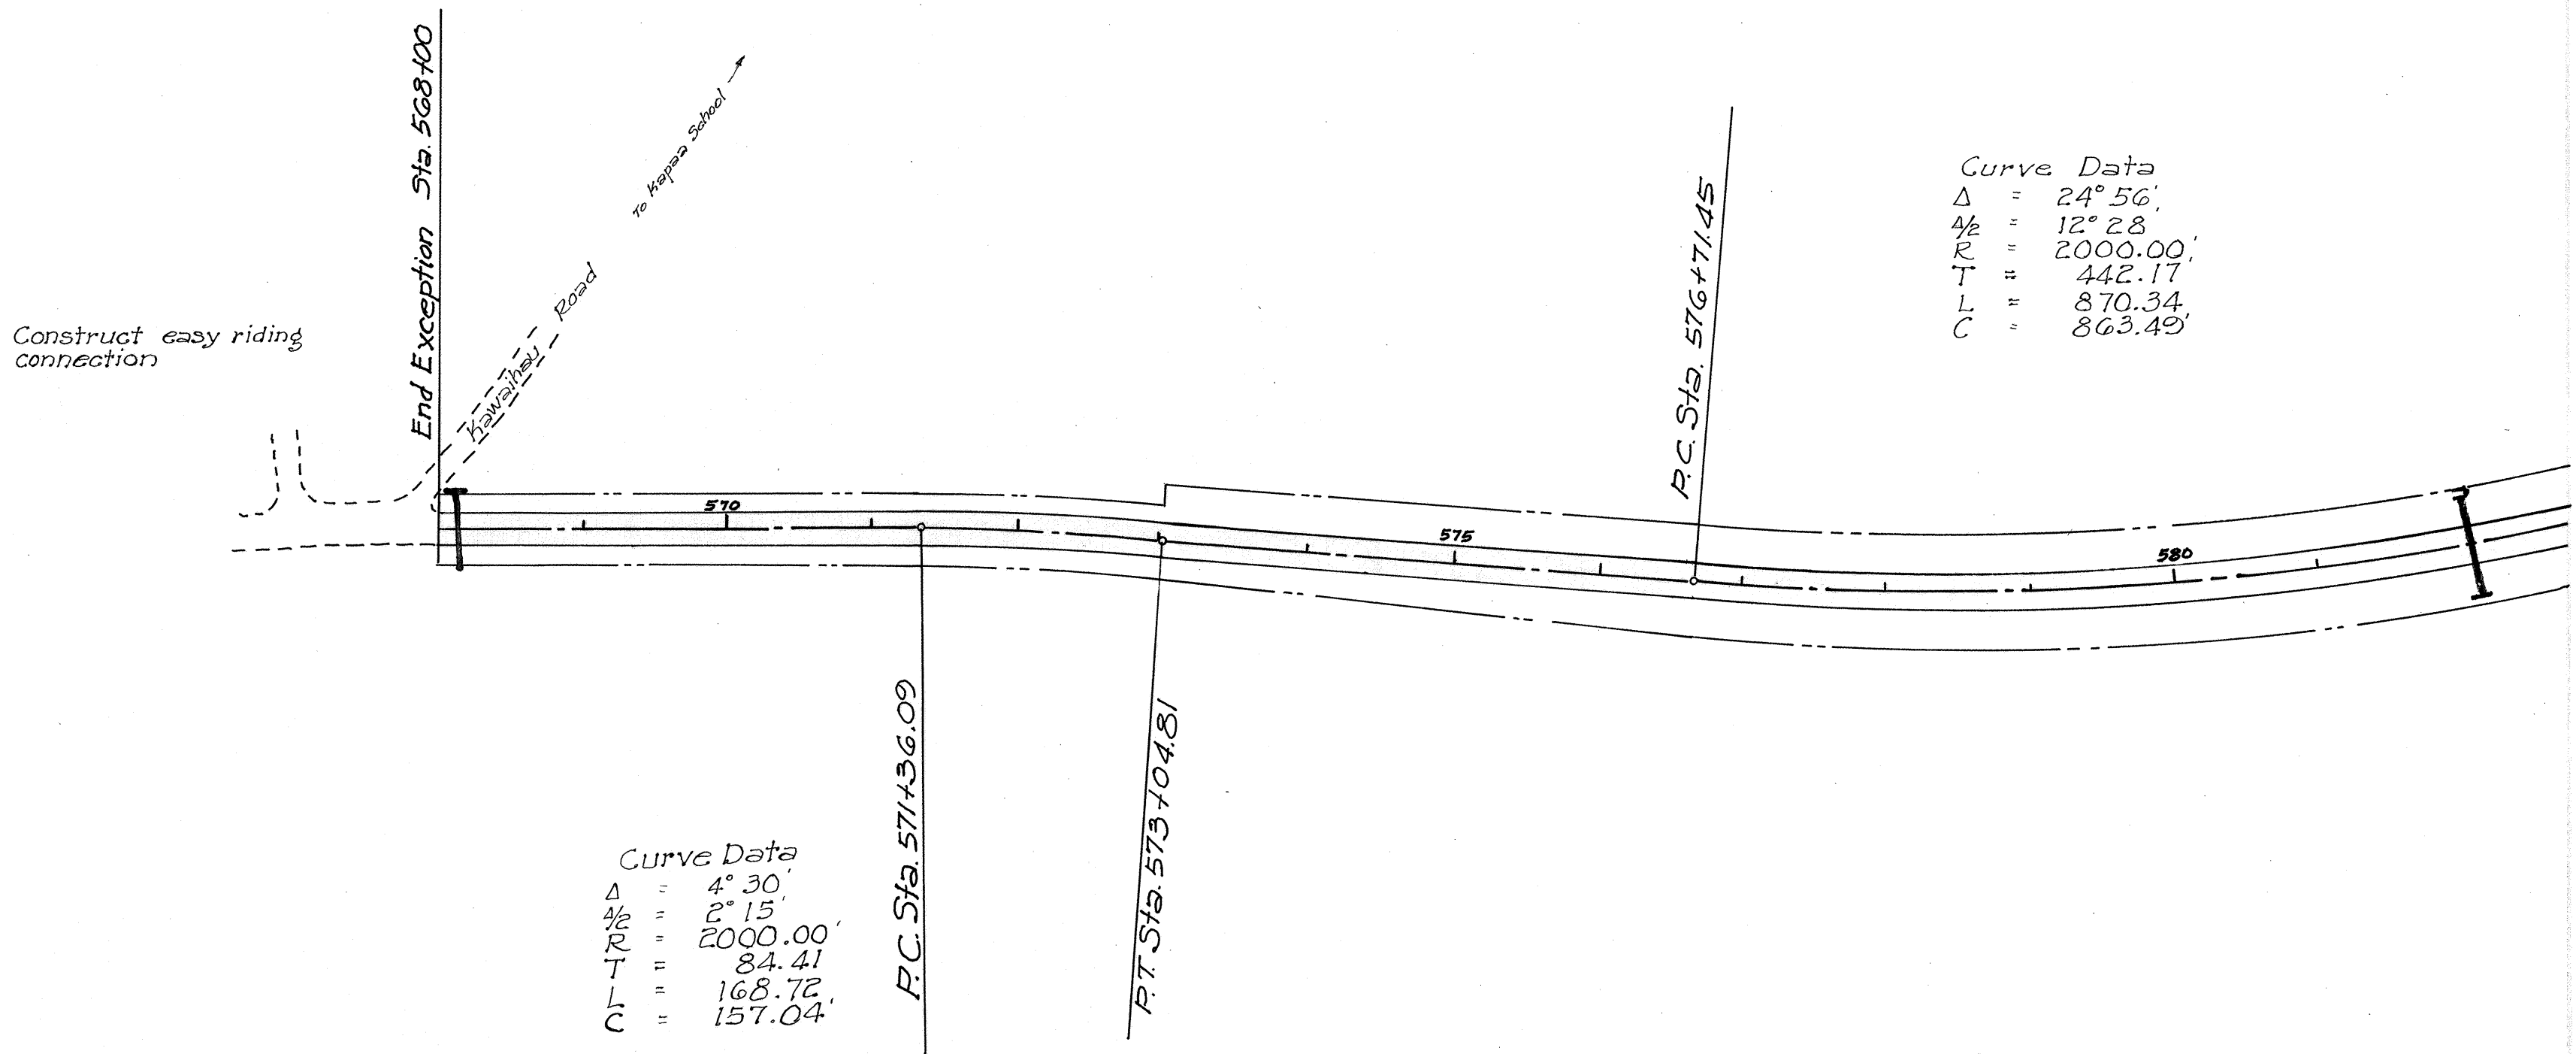
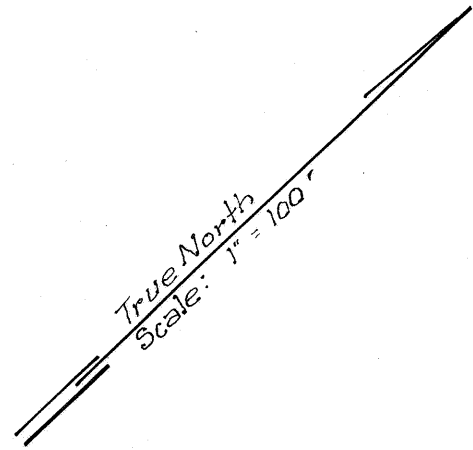


STATE	PROJ. No.	FISCAL YEAR	SHEET No.	TOTAL SHEETS
N.M.	56A-01-07	1966	3	5

Notes:
 1. Leveling of the pavement surfaces prior to laying of A.C. pavement shall be the responsibility of the contractor.
 2. The contractor shall be responsible for the construction of the drainage system and for the construction of the easement for the same.


PLAN	DATE
DESIGNED BY	
CHECKED BY	
DATE	

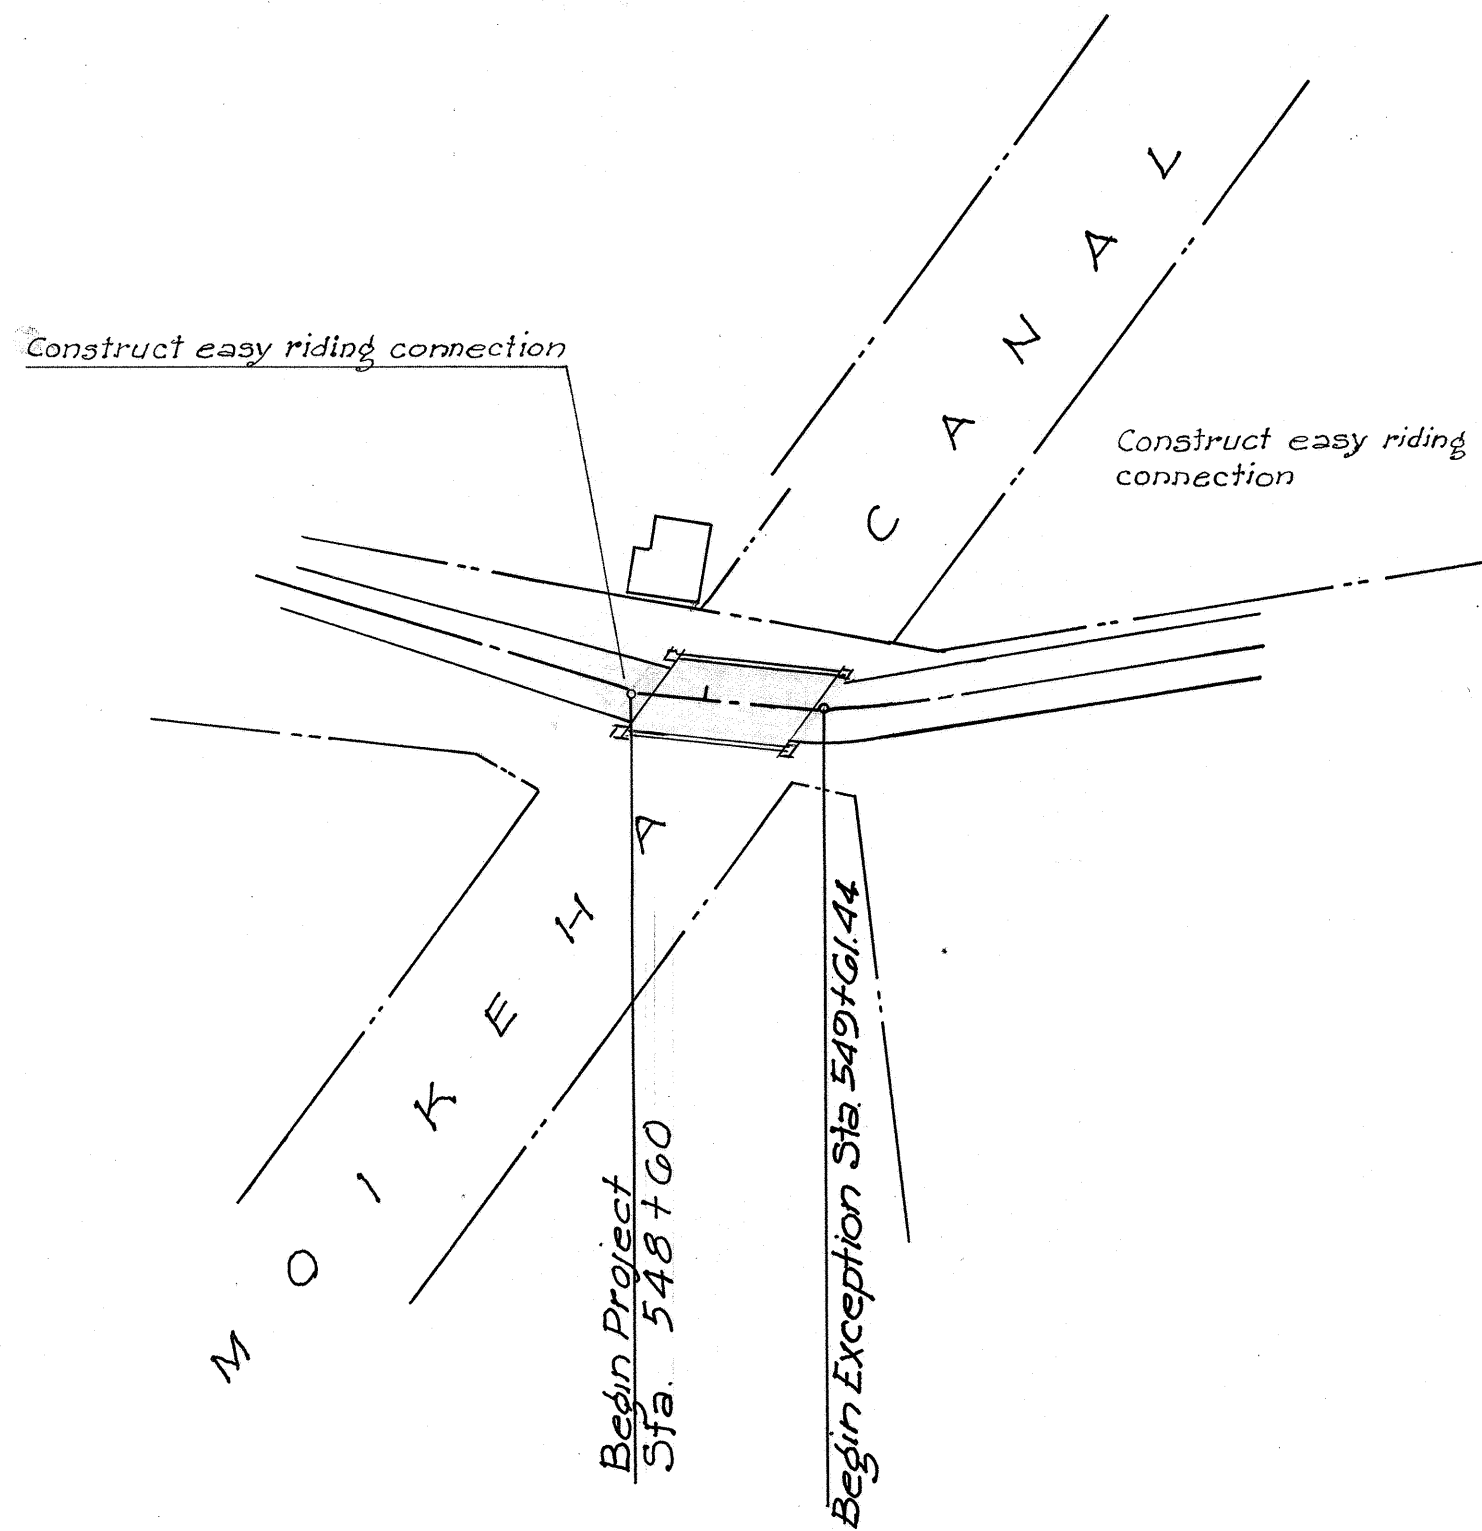

Curve Data
 $\Delta = 24^\circ 56'$
 $\frac{1}{2} = 12^\circ 28'$
 $R = 2000.00'$
 $T = 442.17'$
 $L = 870.34'$
 $C = 863.49'$

Curve Data
 $\Delta = 4^\circ 30'$
 $\frac{1}{2} = 2^\circ 15'$
 $R = 2000.00'$
 $T = 84.41'$
 $L = 168.72'$
 $C = 157.04'$



PROFILE	DATE
DESIGNED BY	
CHECKED BY	
DATE	

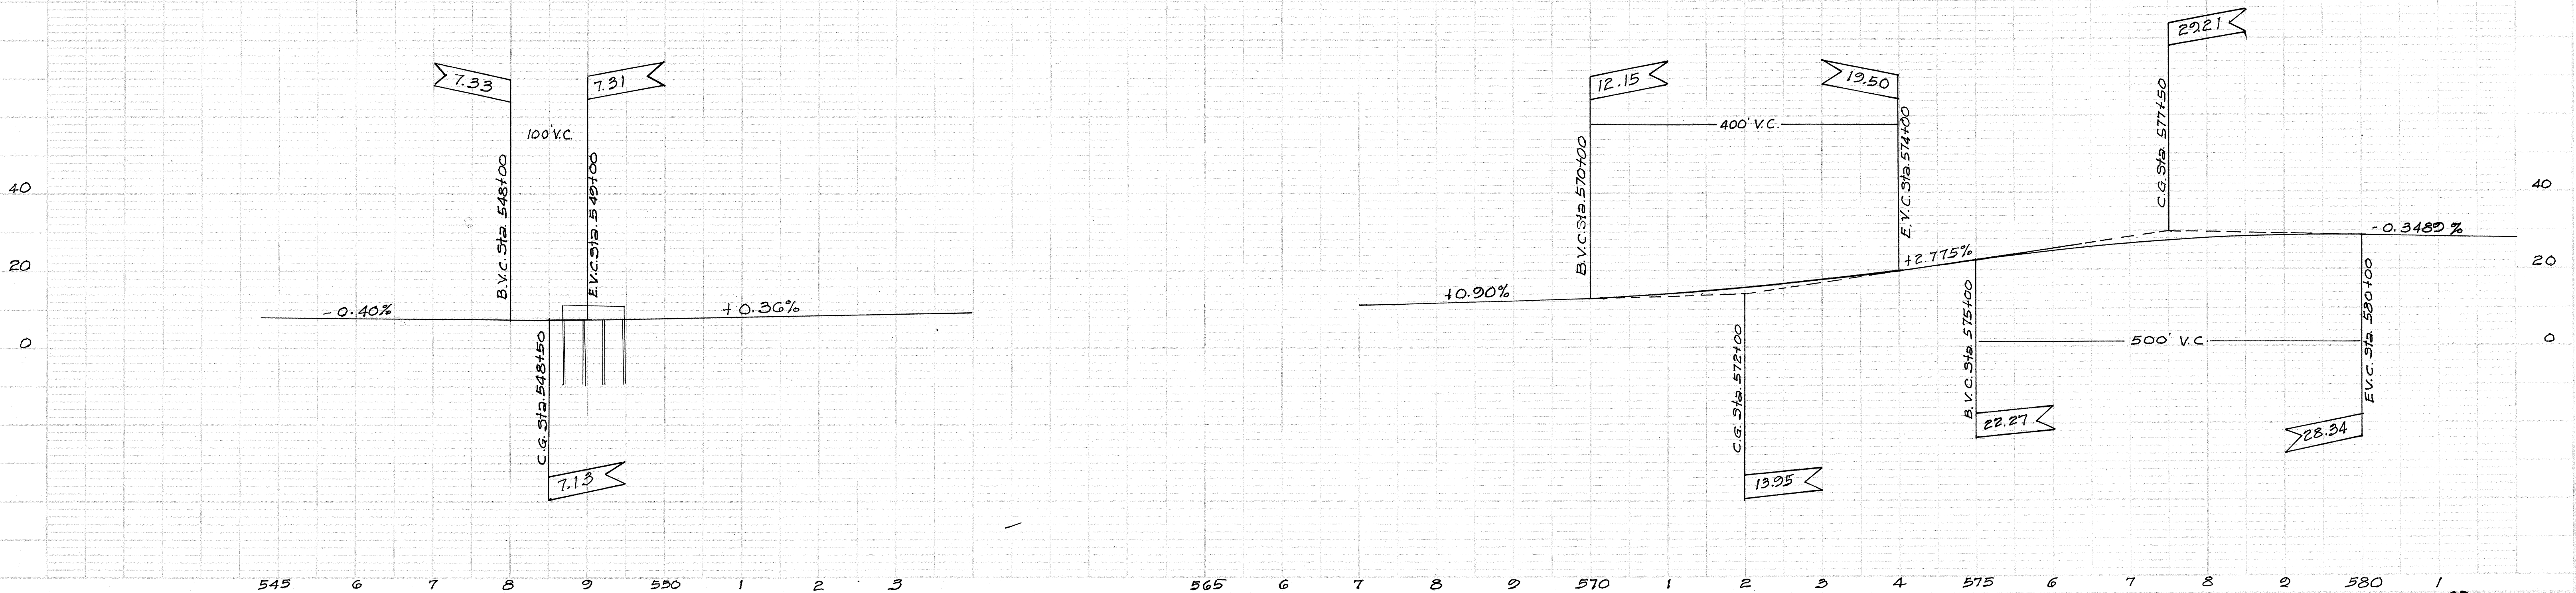

STATE	PROJ. NO.	FISCAL YEAR	SHEET NO.	TOTAL SHEETS
HAW	56A-01-67	1966	4	5

PLAN	DATE	BY	CHECKED	APPROVED

PROFILE	DATE	BY	CHECKED	APPROVED

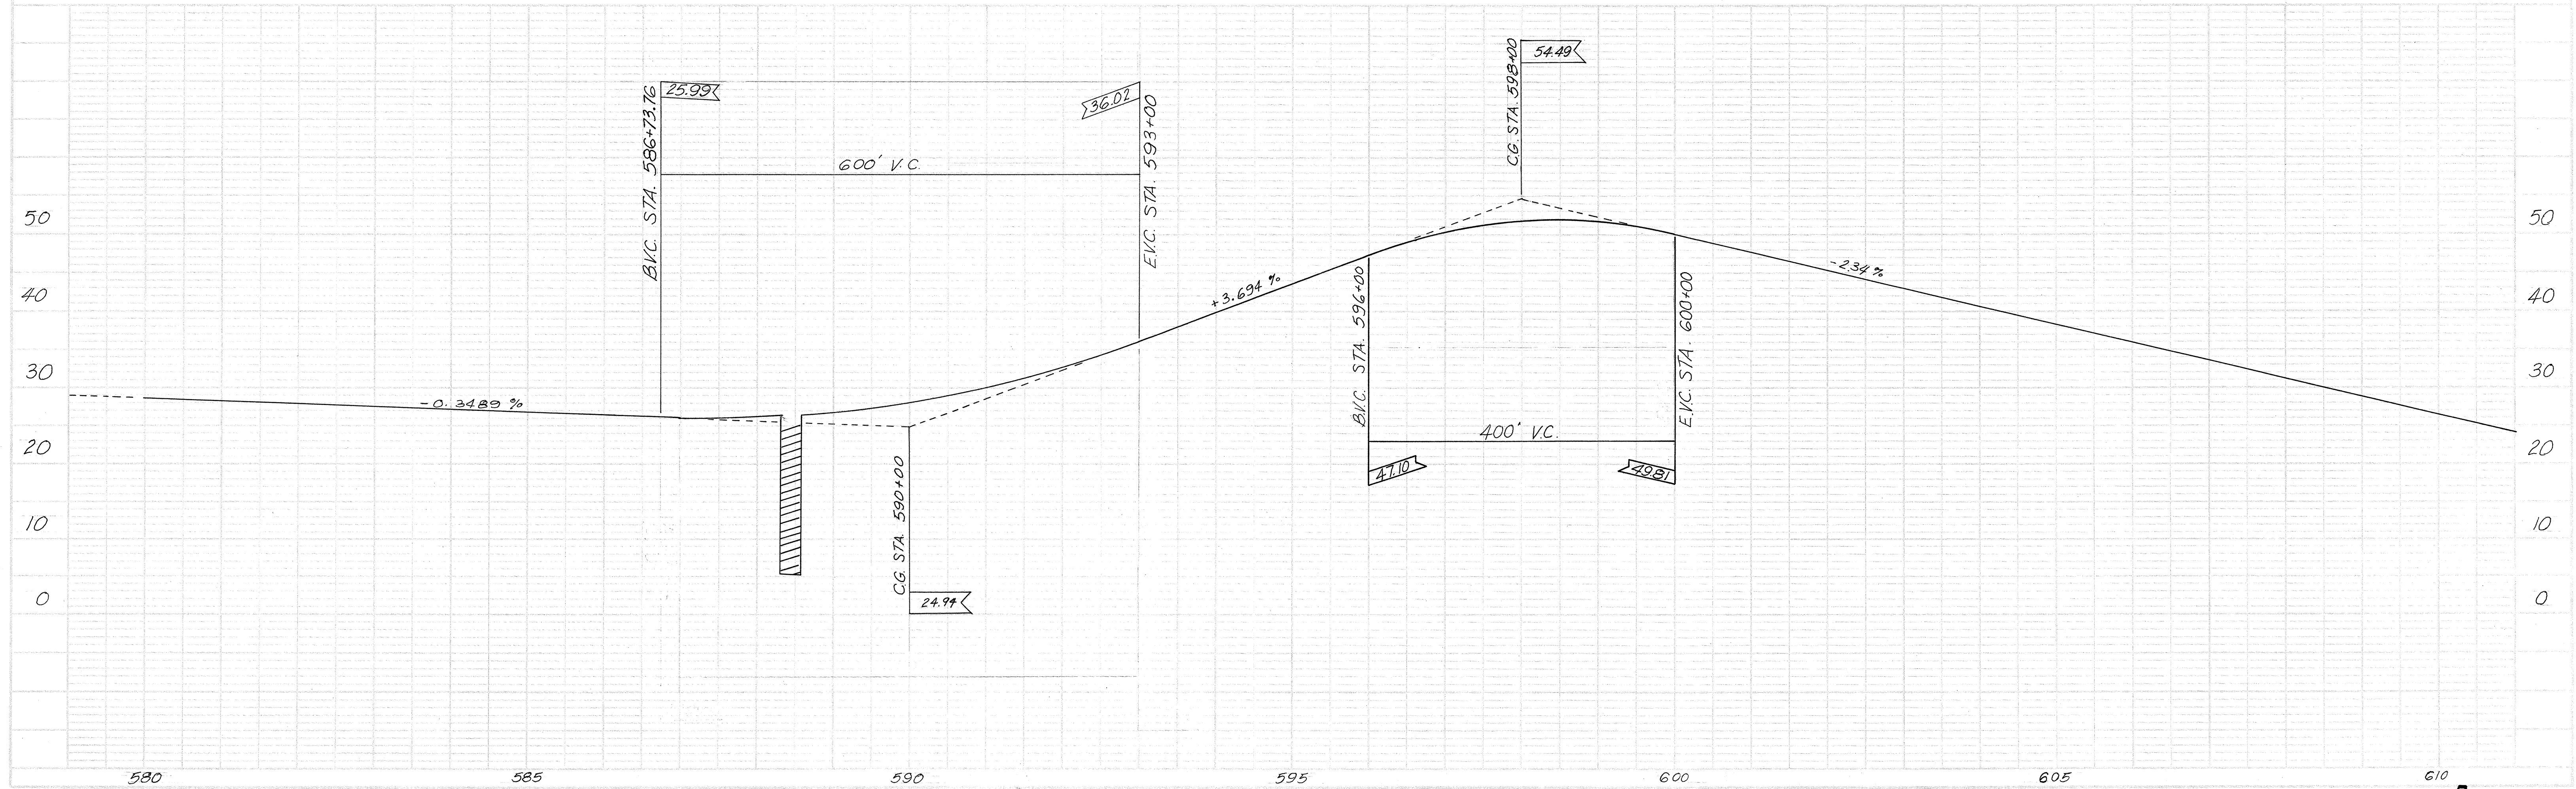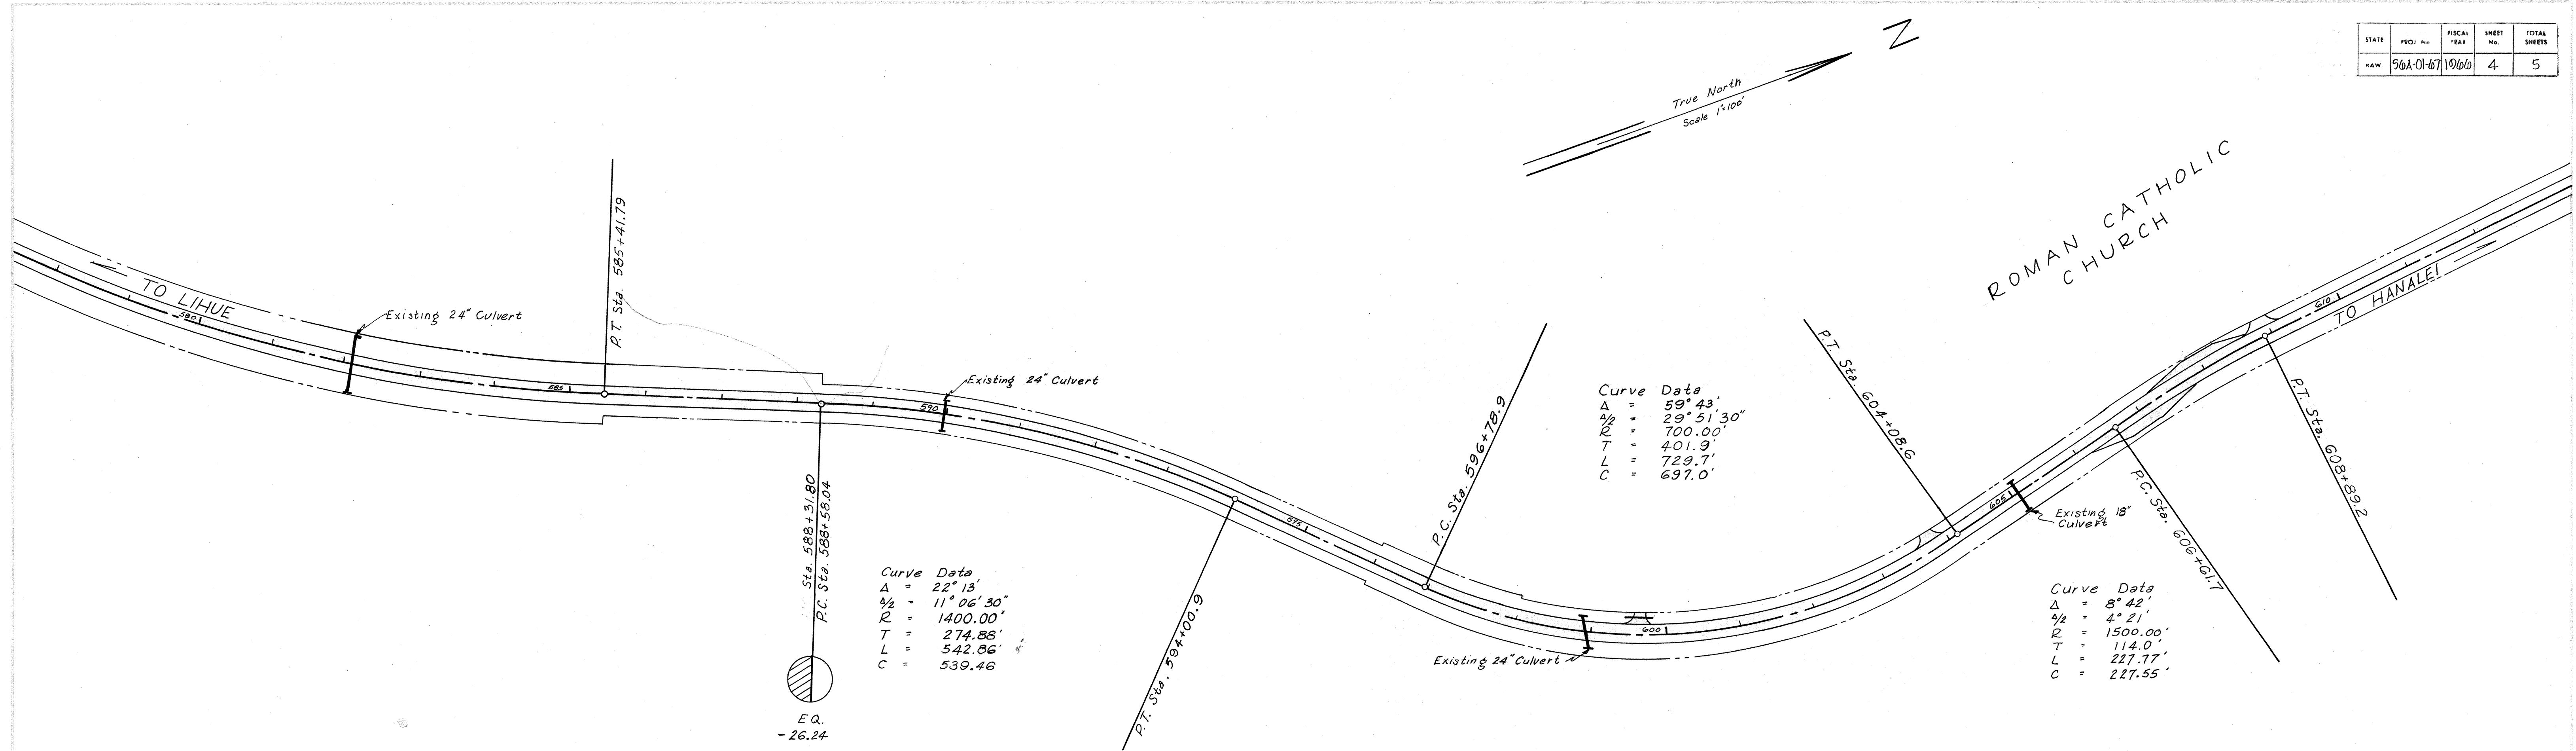

STATE	PROJ. No.	FISCAL YEAR	SHEET No.	TOTAL SHEETS
HAW.	56A-01-67	1966	5	5

PLAN	DATE
APPROVED	
NOTED	
NO.	

PROFILE	DATE
APPROVED	
NOTED	
NO.	

