

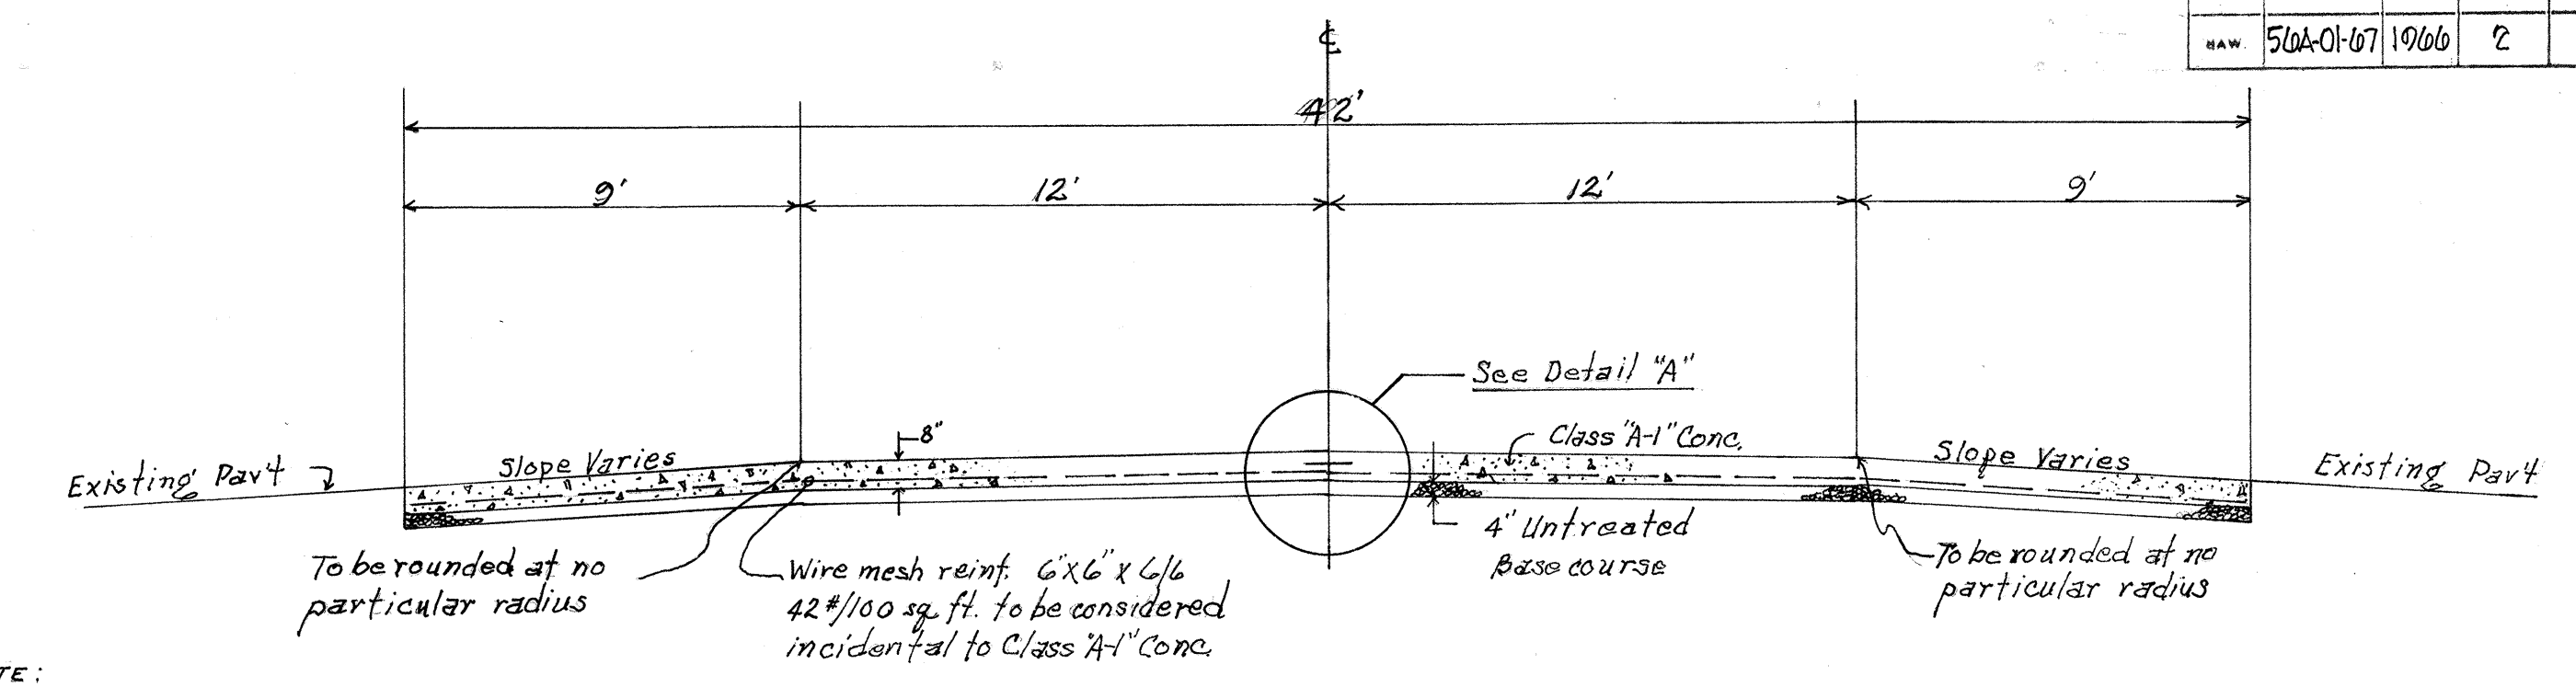
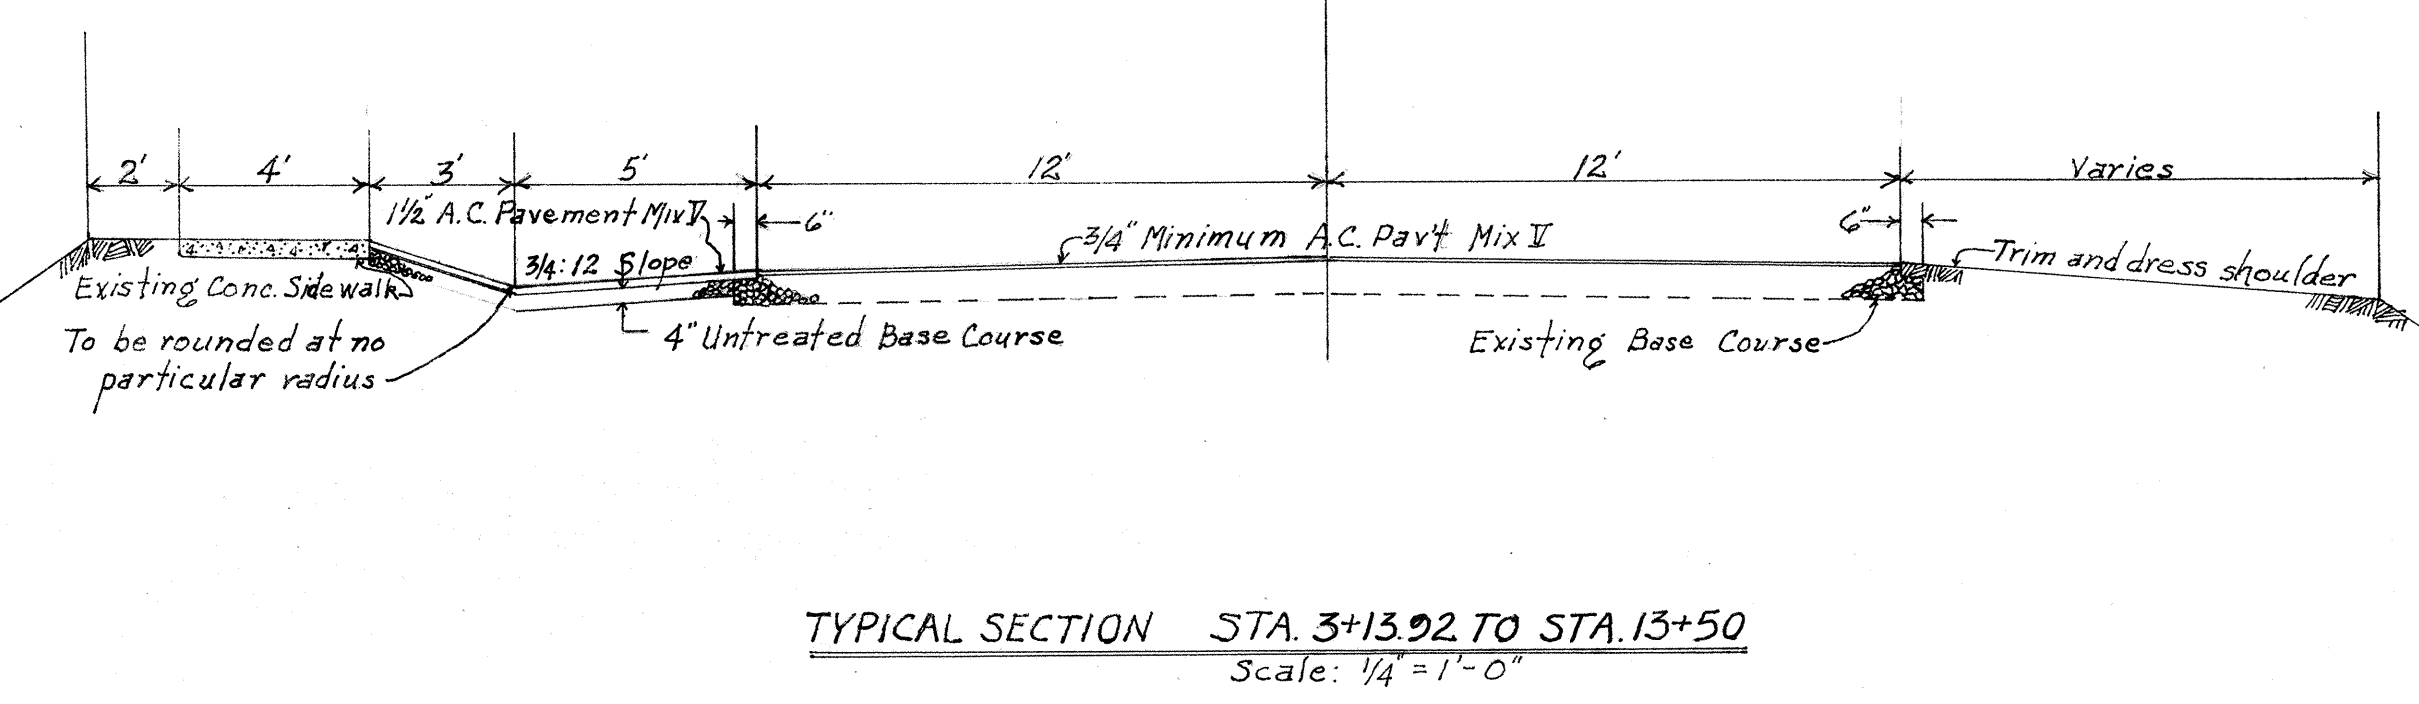
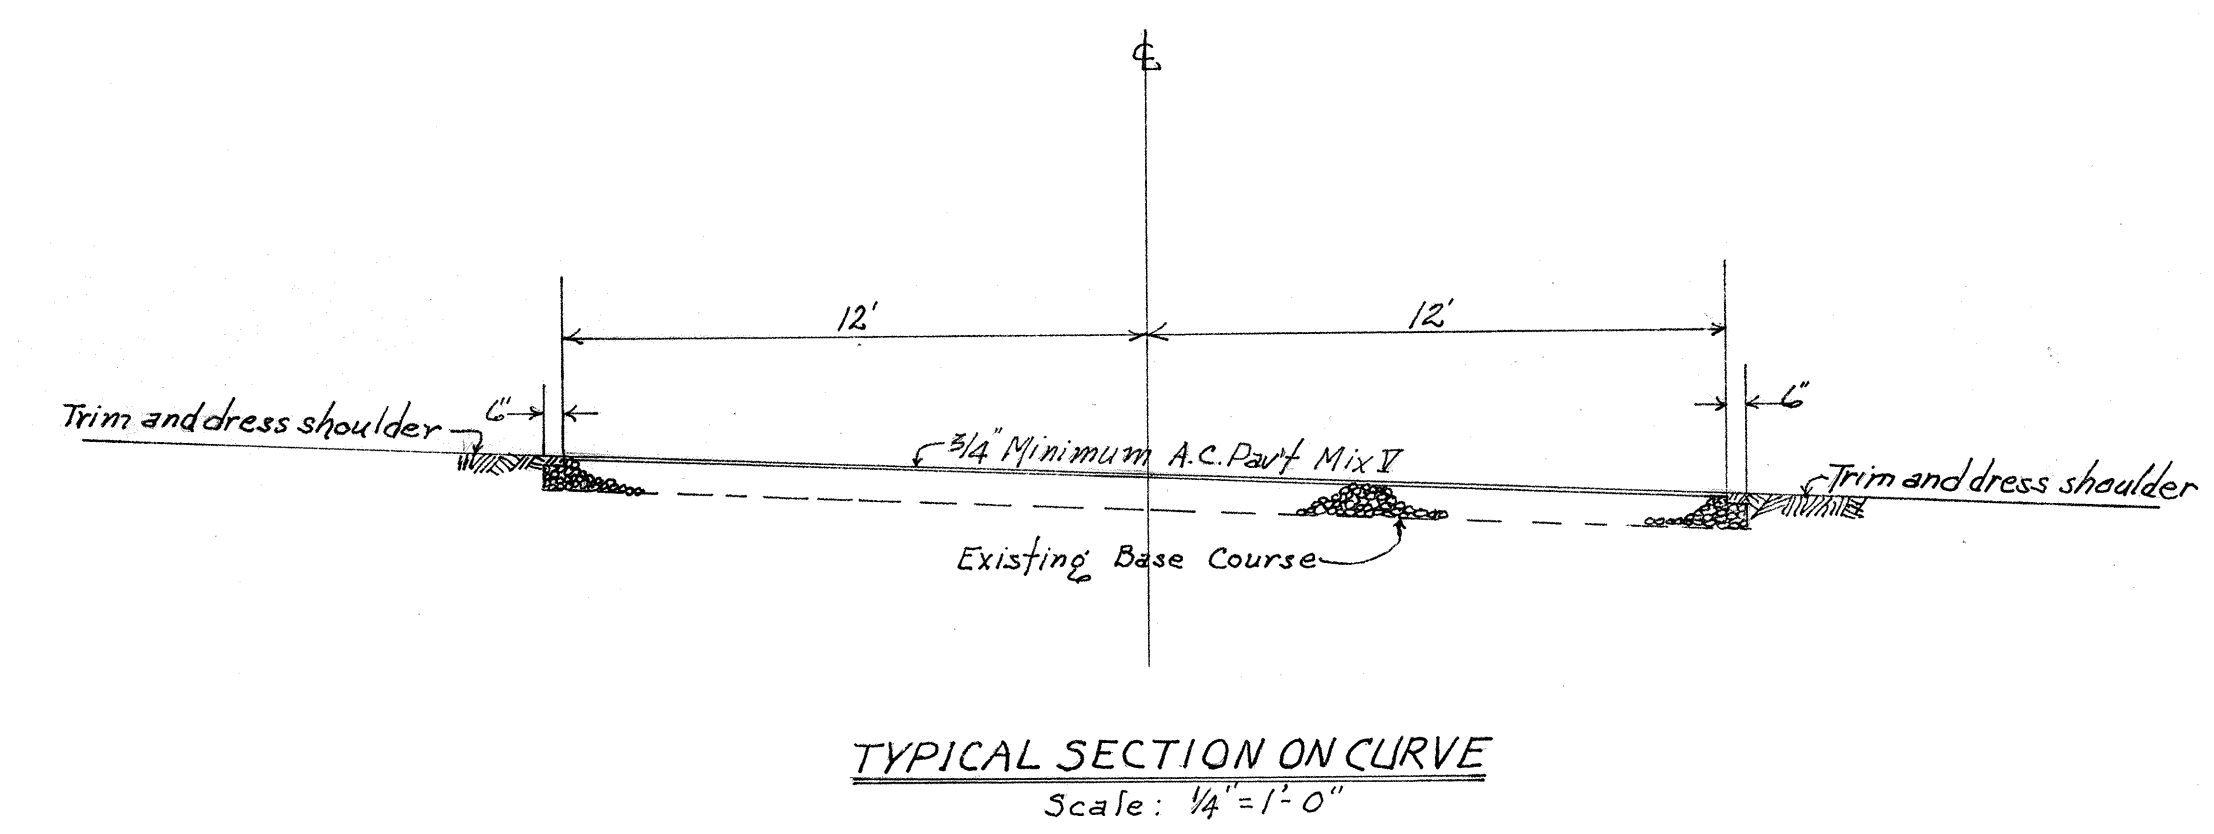
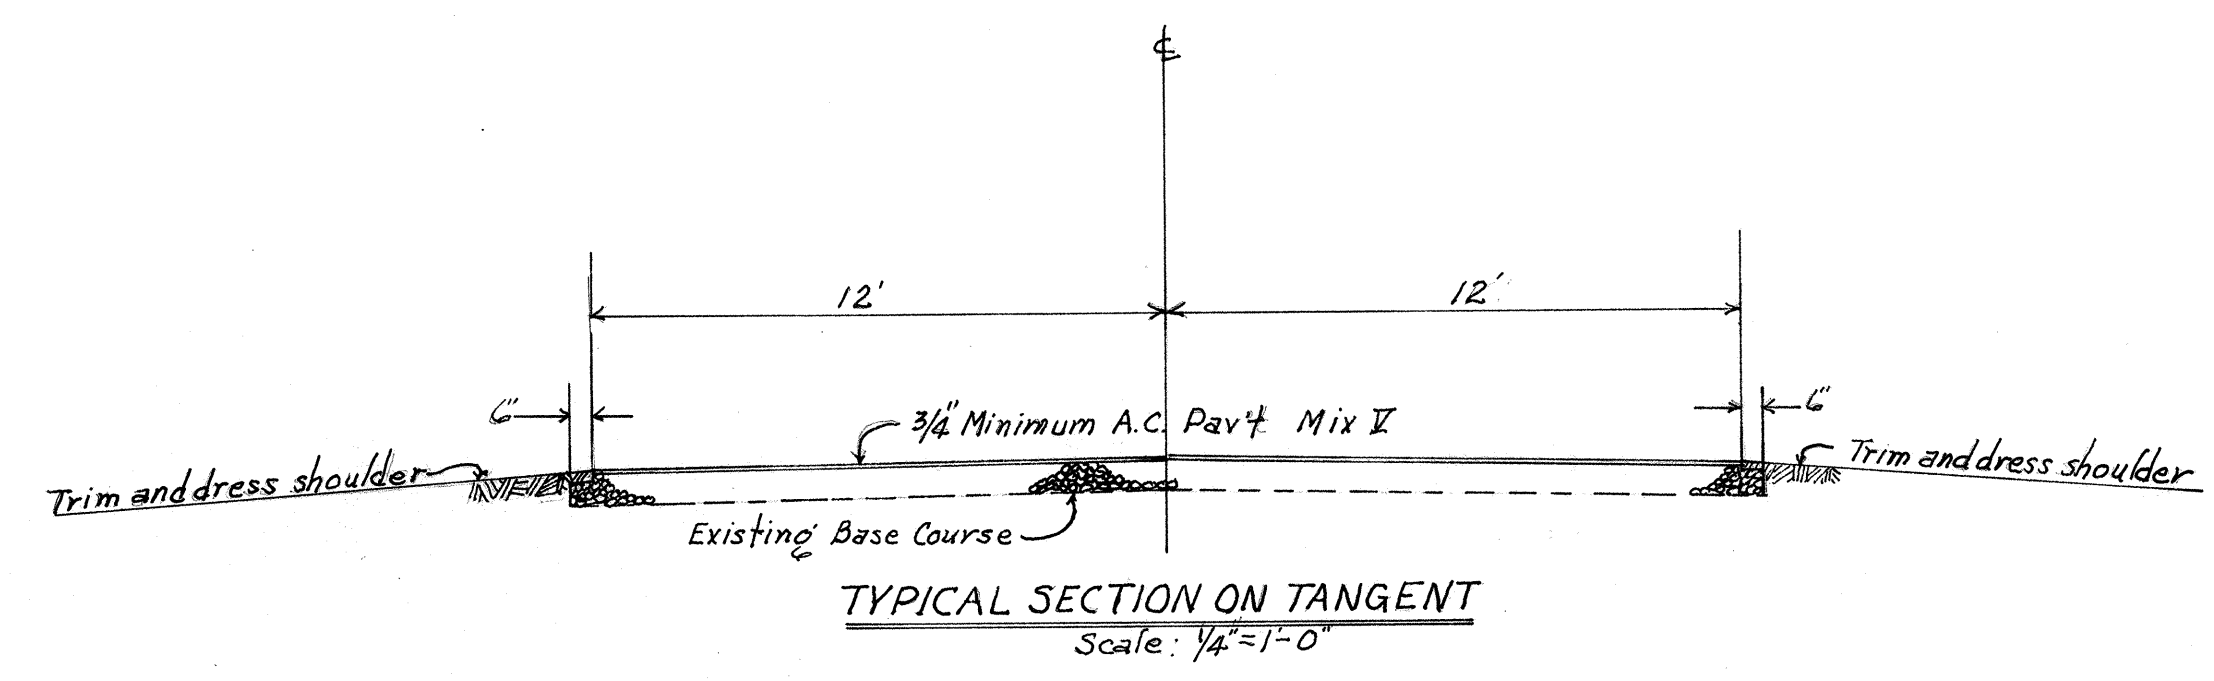


STATE	PROJ. No.	FISCAL YEAR	SHEET No.	TOTAL SHEETS
HAW	56A-01-07	1966	2	5

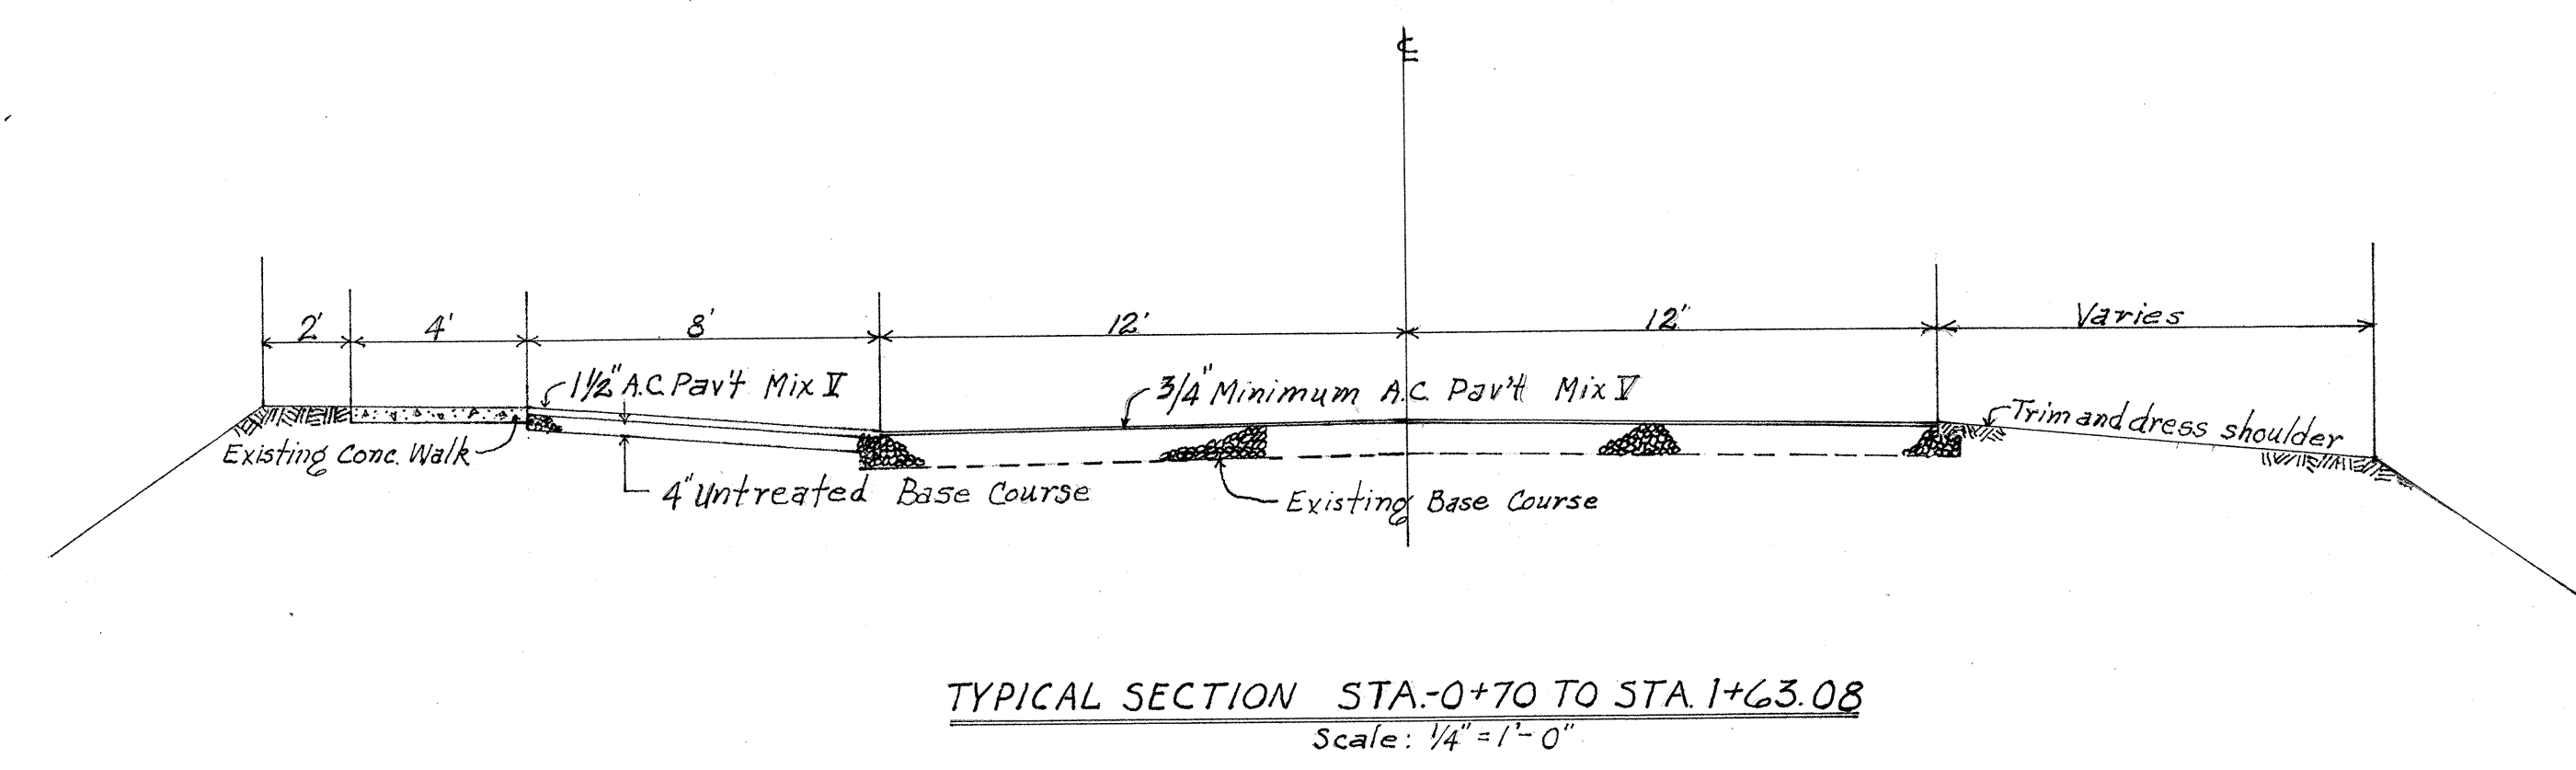

- NOTE:
1. Tractor crossing shall conform to pavement grade and crown.
 2. Dowels for Tractor Crossing shall be considered incidental to Class A-1 Concrete.

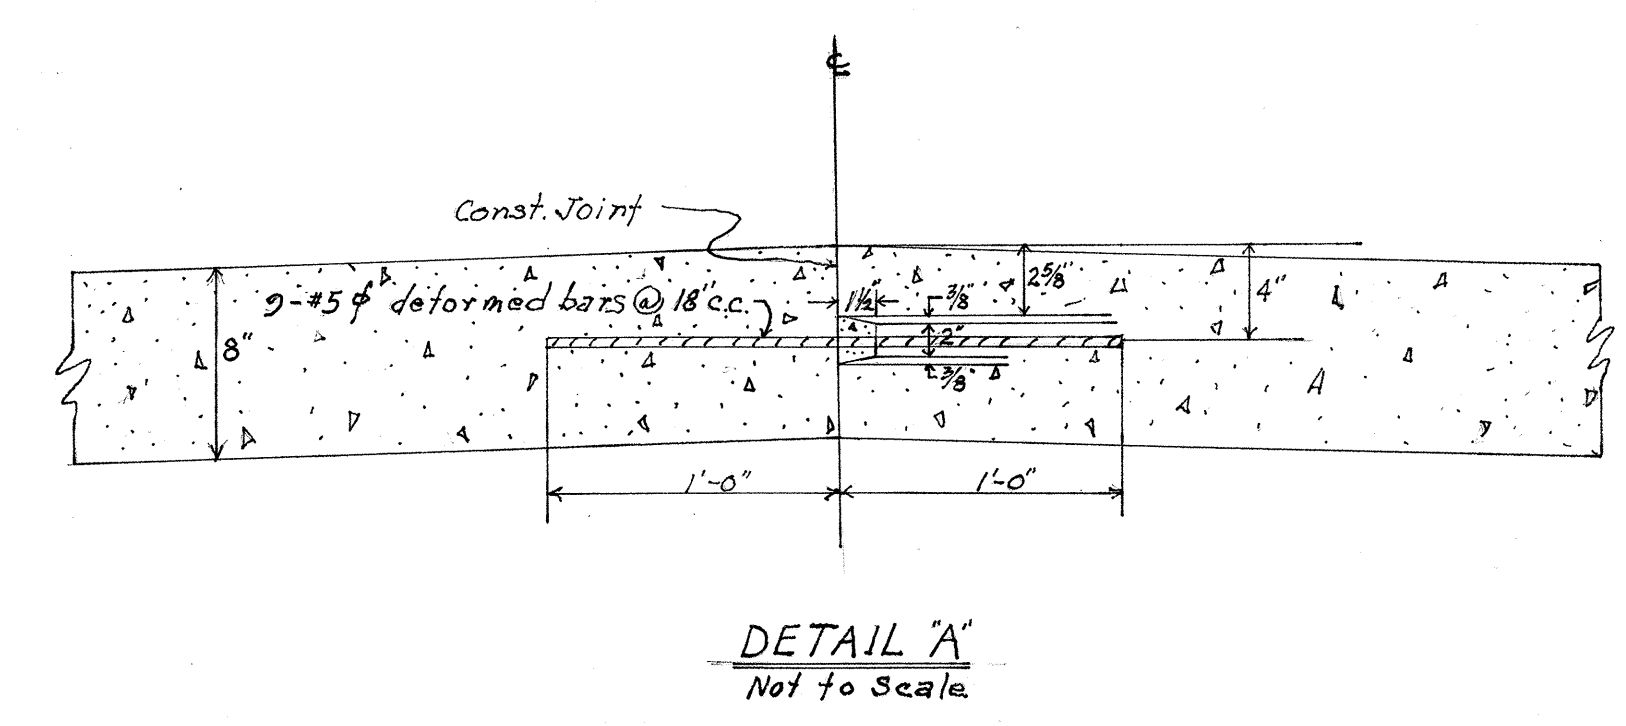

DEPARTMENT OF TRANSPORTATION
HIGHWAYS DIVISION
STATE OF HAWAII
TYPICAL SECTIONS
KAUAI BELT ROAD
RESURFACING PROJ. NO. 56A-01-67
SCALE: AS SHOWN
DATE: JULY, 1966