


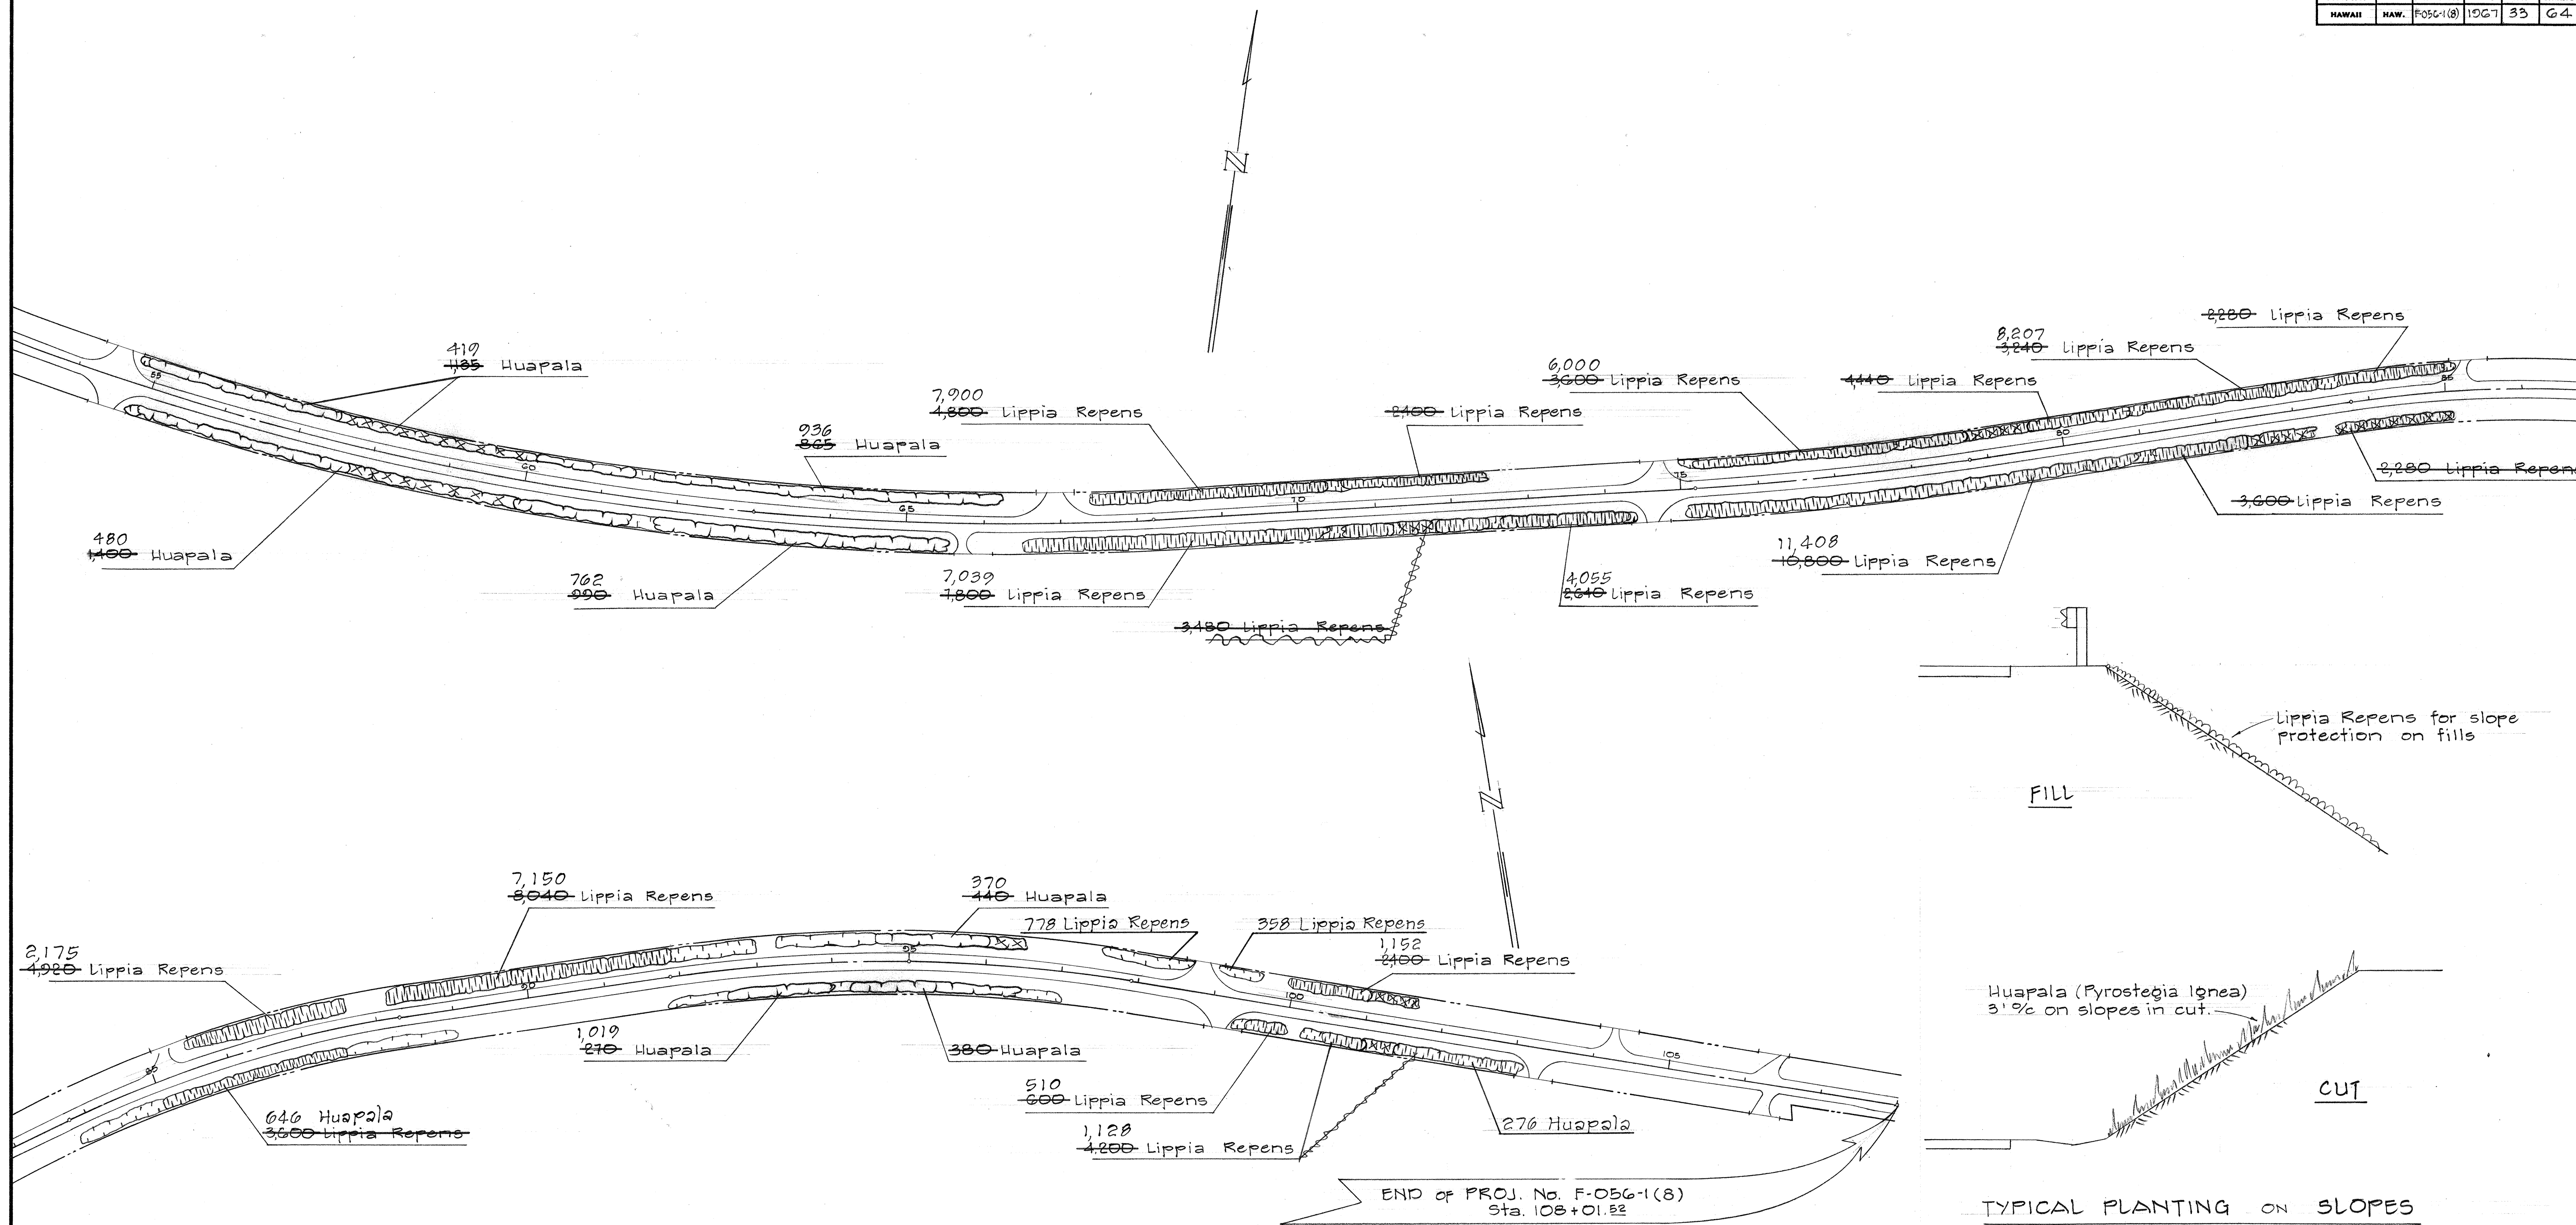

PLANT LIST - THIS SHEET		
BOTANICAL NAME	COMMON NAME	QUANTITY
Lippia Repens	Creeping Lippia	75,120 ± 57,860
Pyrostegia ignea	Huapala	4,080 ea. 4,908

STATE OF HAWAII
DEPARTMENT OF TRANSPORTATION
HIGHWAYS DIVISION

LANDSCAPING

KAUAI BELT ROAD

Kahili to Pilaa

F.A.P. Proj. No. F-05G-1(8)

Scale: 1"=100' July, 1967

SHEET No. 2 OF 2 SHEETS

DATE _____

SURVEY PLOTTED BY _____

DESIGNED BY _____

QUANTITIES BY _____

CHECKED BY _____

ORIGINAL PLAN NOTE BOOK No. _____