






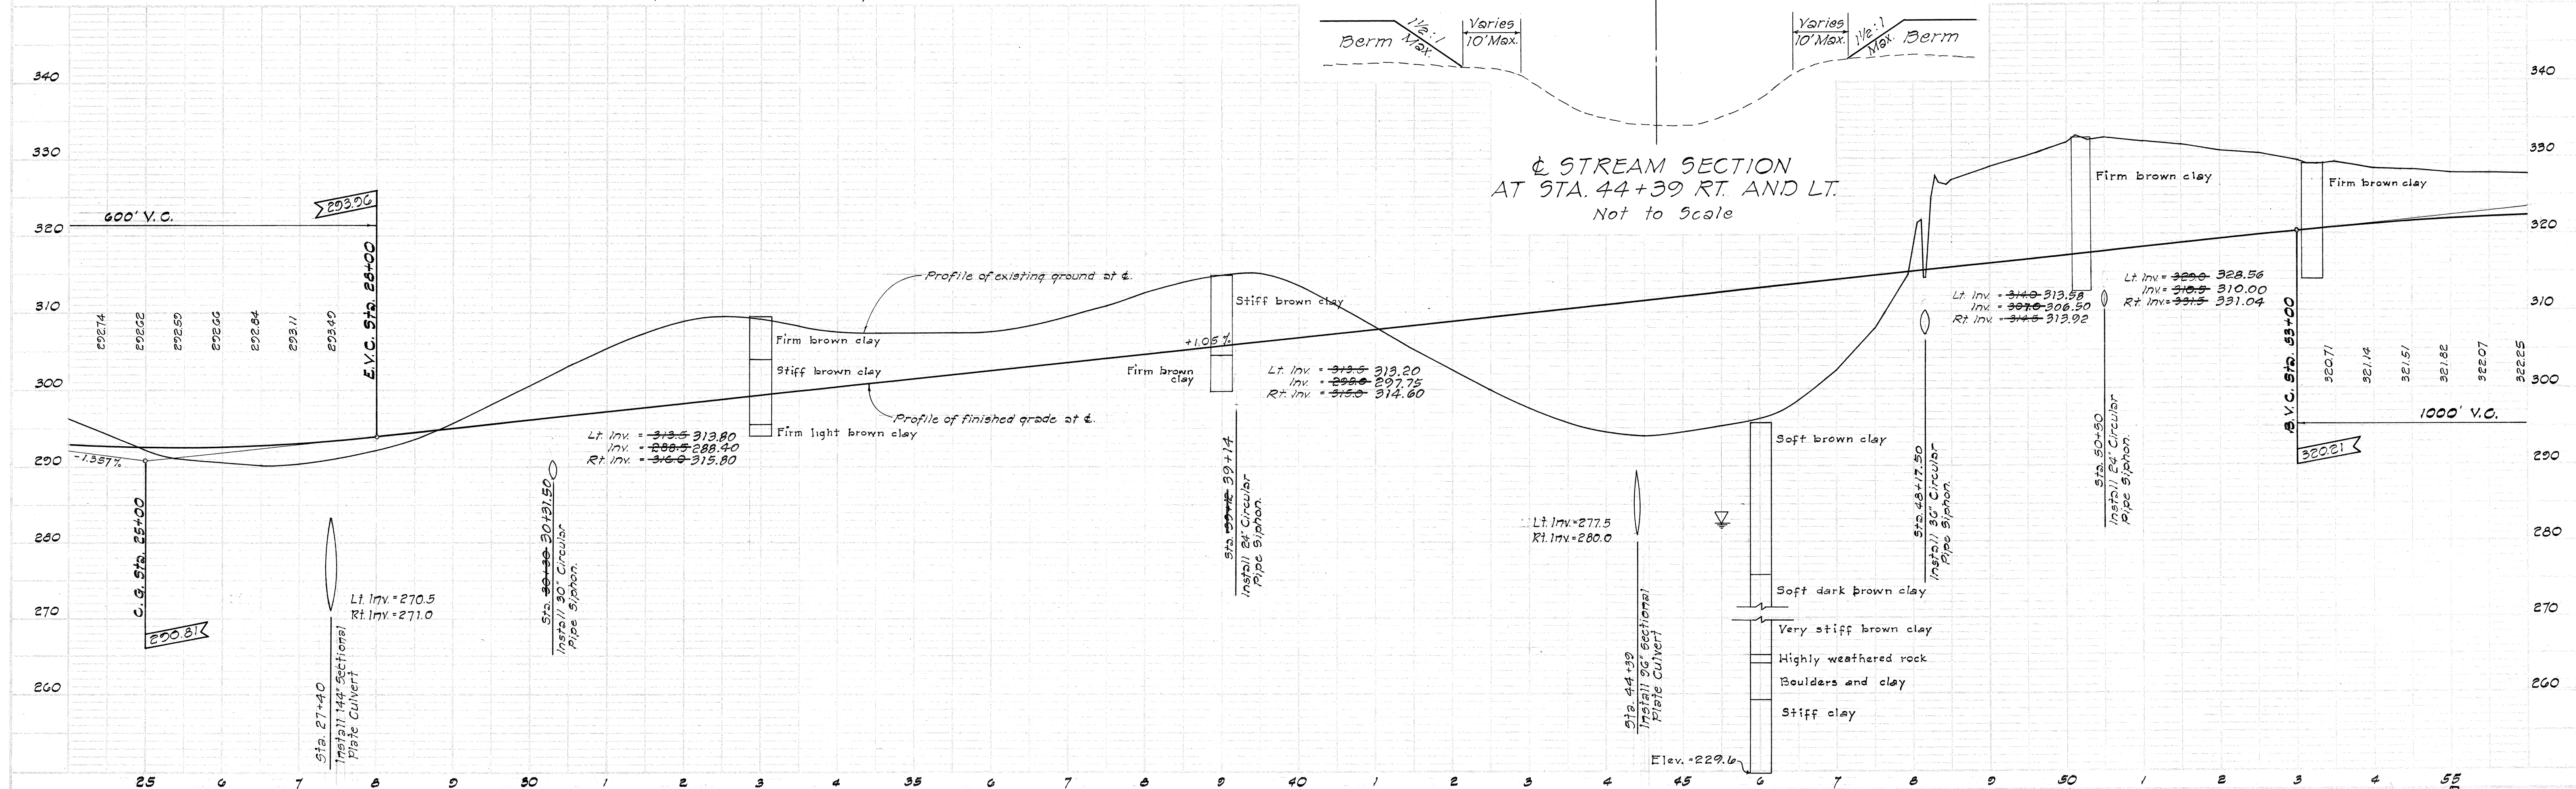

| PLAN               | DATE | BY |
|--------------------|------|----|
| SURVEYED           |      |    |
| NOTE BOOK          |      |    |
| ALIGNMENT CHECKED  |      |    |
| PT. OF WAY CHECKED |      |    |
| NO.                |      |    |

| PROFILE                 | DATE | BY |
|-------------------------|------|----|
| SURVEYED                |      |    |
| NOTE BOOK               |      |    |
| GRADINGS CHECKED        |      |    |
| B. M. NOTED             |      |    |
| STRUCTURE LOCATIONS CHD |      |    |
| NO.                     |      |    |

| FED. ROAD DIST. NO. | STATE | FED. AID PROJ. NO. | FISCAL YEAR | SHEET NO. | TOTAL SHEETS |
|---------------------|-------|--------------------|-------------|-----------|--------------|
| HAWAII              | HAW.  | F-056-1(8)         | 1967        | 6         | 64           |

