


DIST. NO.	STATE	PROJ. NO.	FISCAL YEAR	SHEET NO.	TOTAL SHEETS
HAWAII	HAW.	56A-02-67 UNIT 1	1967	4	10

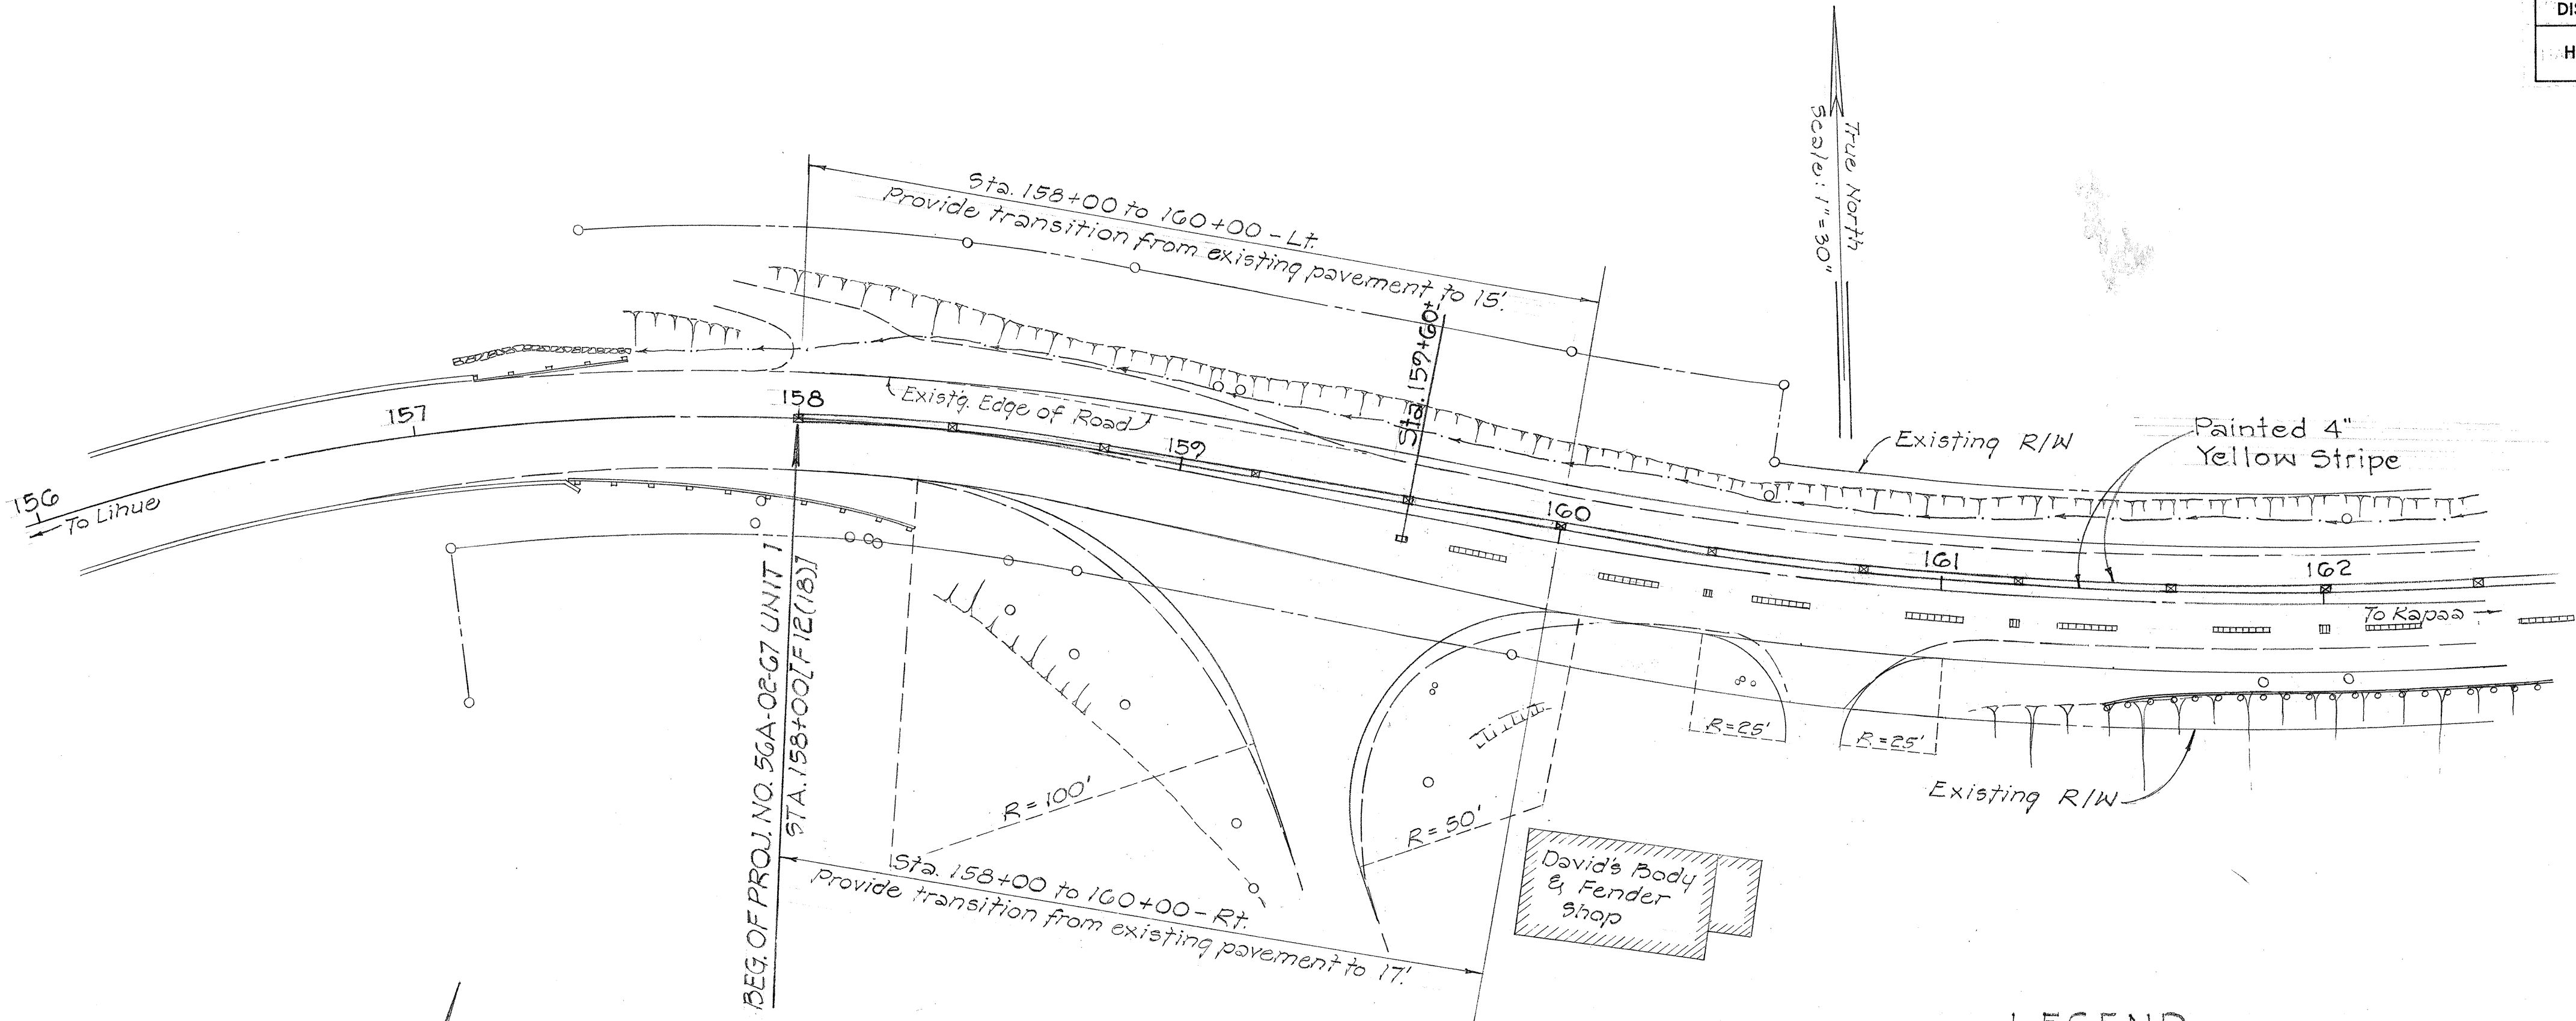

PLAN SHOWING PAVEMENT MARKERS
BEG. PROJ. TO STA. 162+00


SCALE: 1" = 30'

LEGEND

- Denotes Type A Marker
- Denotes Type D Marker
- Denotes Type G Marker

NOTE:

For details of pavement markers see
Standard Details, Plan Sheet No. 10

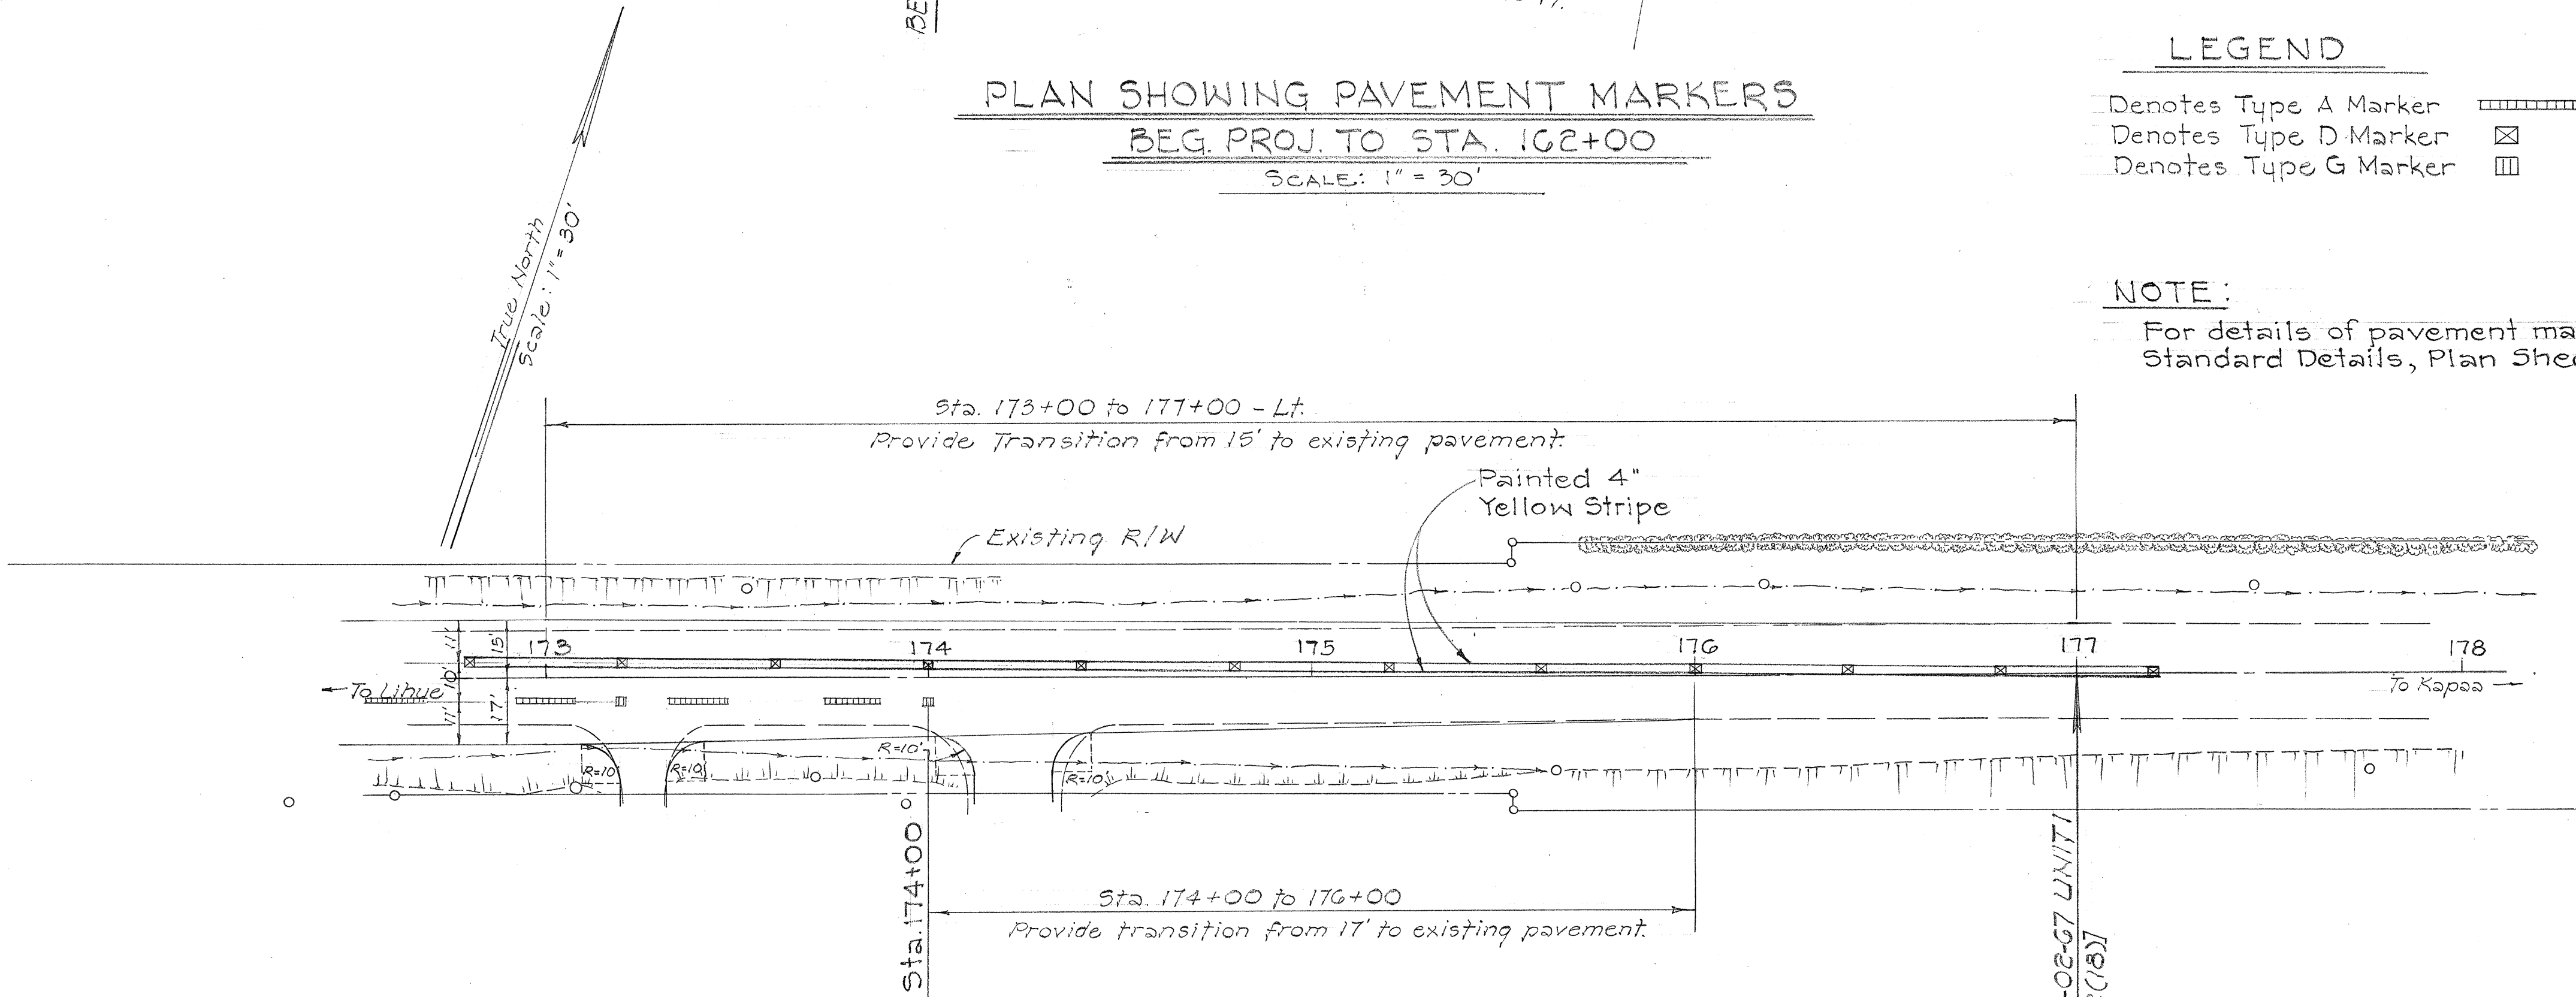

PLAN SHOWING PAVEMENT MARKERS
STA. 173+00 TO END PROJ.

SCALE: 1" = 30'

PAVEMENT MARKERS		QUANTITY
TYPE	A	216
TYPE	D	49
TYPE	G	19

STATE OF HAWAII
DEPARTMENT OF TRANSPORTATION
HIGHWAYS DIVISION

PAVEMENT MARKER LOCATION
& MISC. DETAILS
KAUAI BELT ROAD
PROJ. NO. 56A-02-67 UNIT 1

SCALE: AS SHOWN DATE: SEPT. 1967

SHEET No. 1 OF 4 SHEETS

ORIGINAL PLAN	DATE
SURVEY PLOTTED BY	
DRAWN BY	
TRACED BY	
CHECKED BY	
NOTE BOOK	
NO.	