

INDEX TO DRAWINGS	
SHEET NO.	DESCRIPTION
1	TITLE SHEET
2	TYPICAL SECTIONS
3	CONSTRUCTION IDENTIFICATION SIGN

STATE OF HAWAII

DEPARTMENT OF TRANSPORTATION

HIGHWAYS DIVISION

PLANS FOR



SHOULDER STABILIZATION ALONG

KAUAI BELT ROAD, PAPAA TO PILAA

PROJ. NO. 50D-56AB-01-70

DISTRICTS OF KAWAIHAU & HANAIEI

ISLAND OF KAUAI

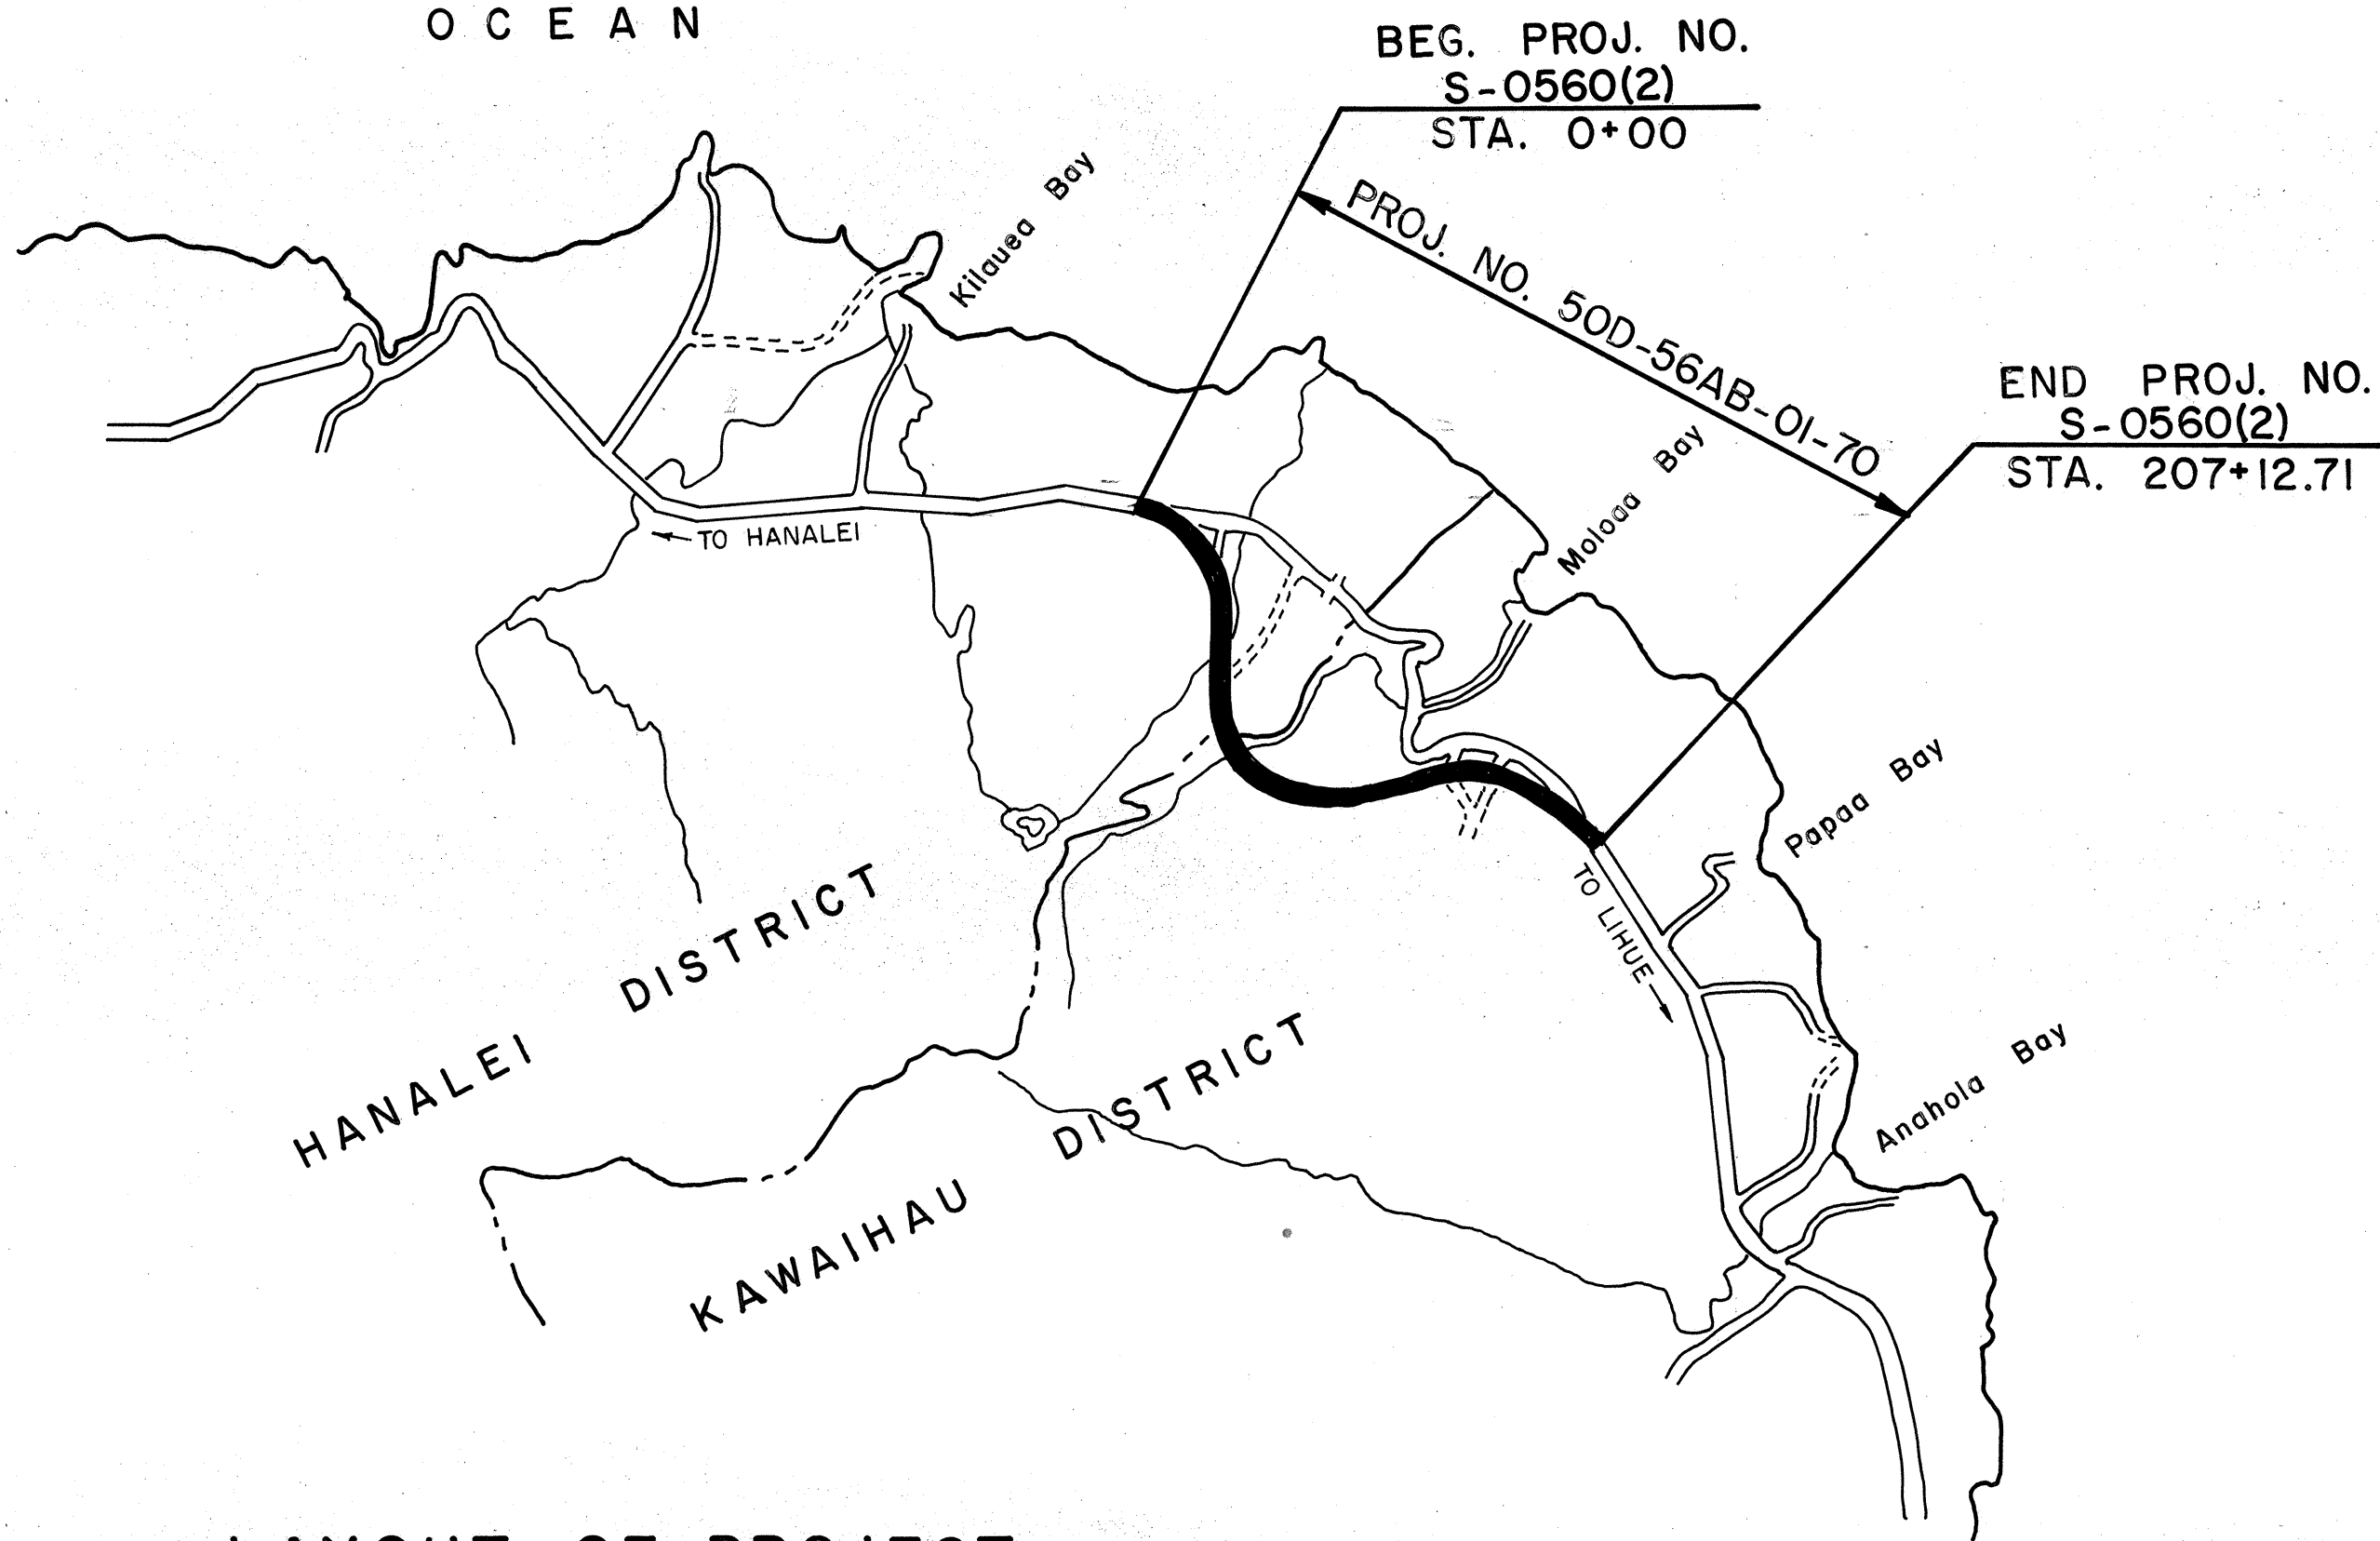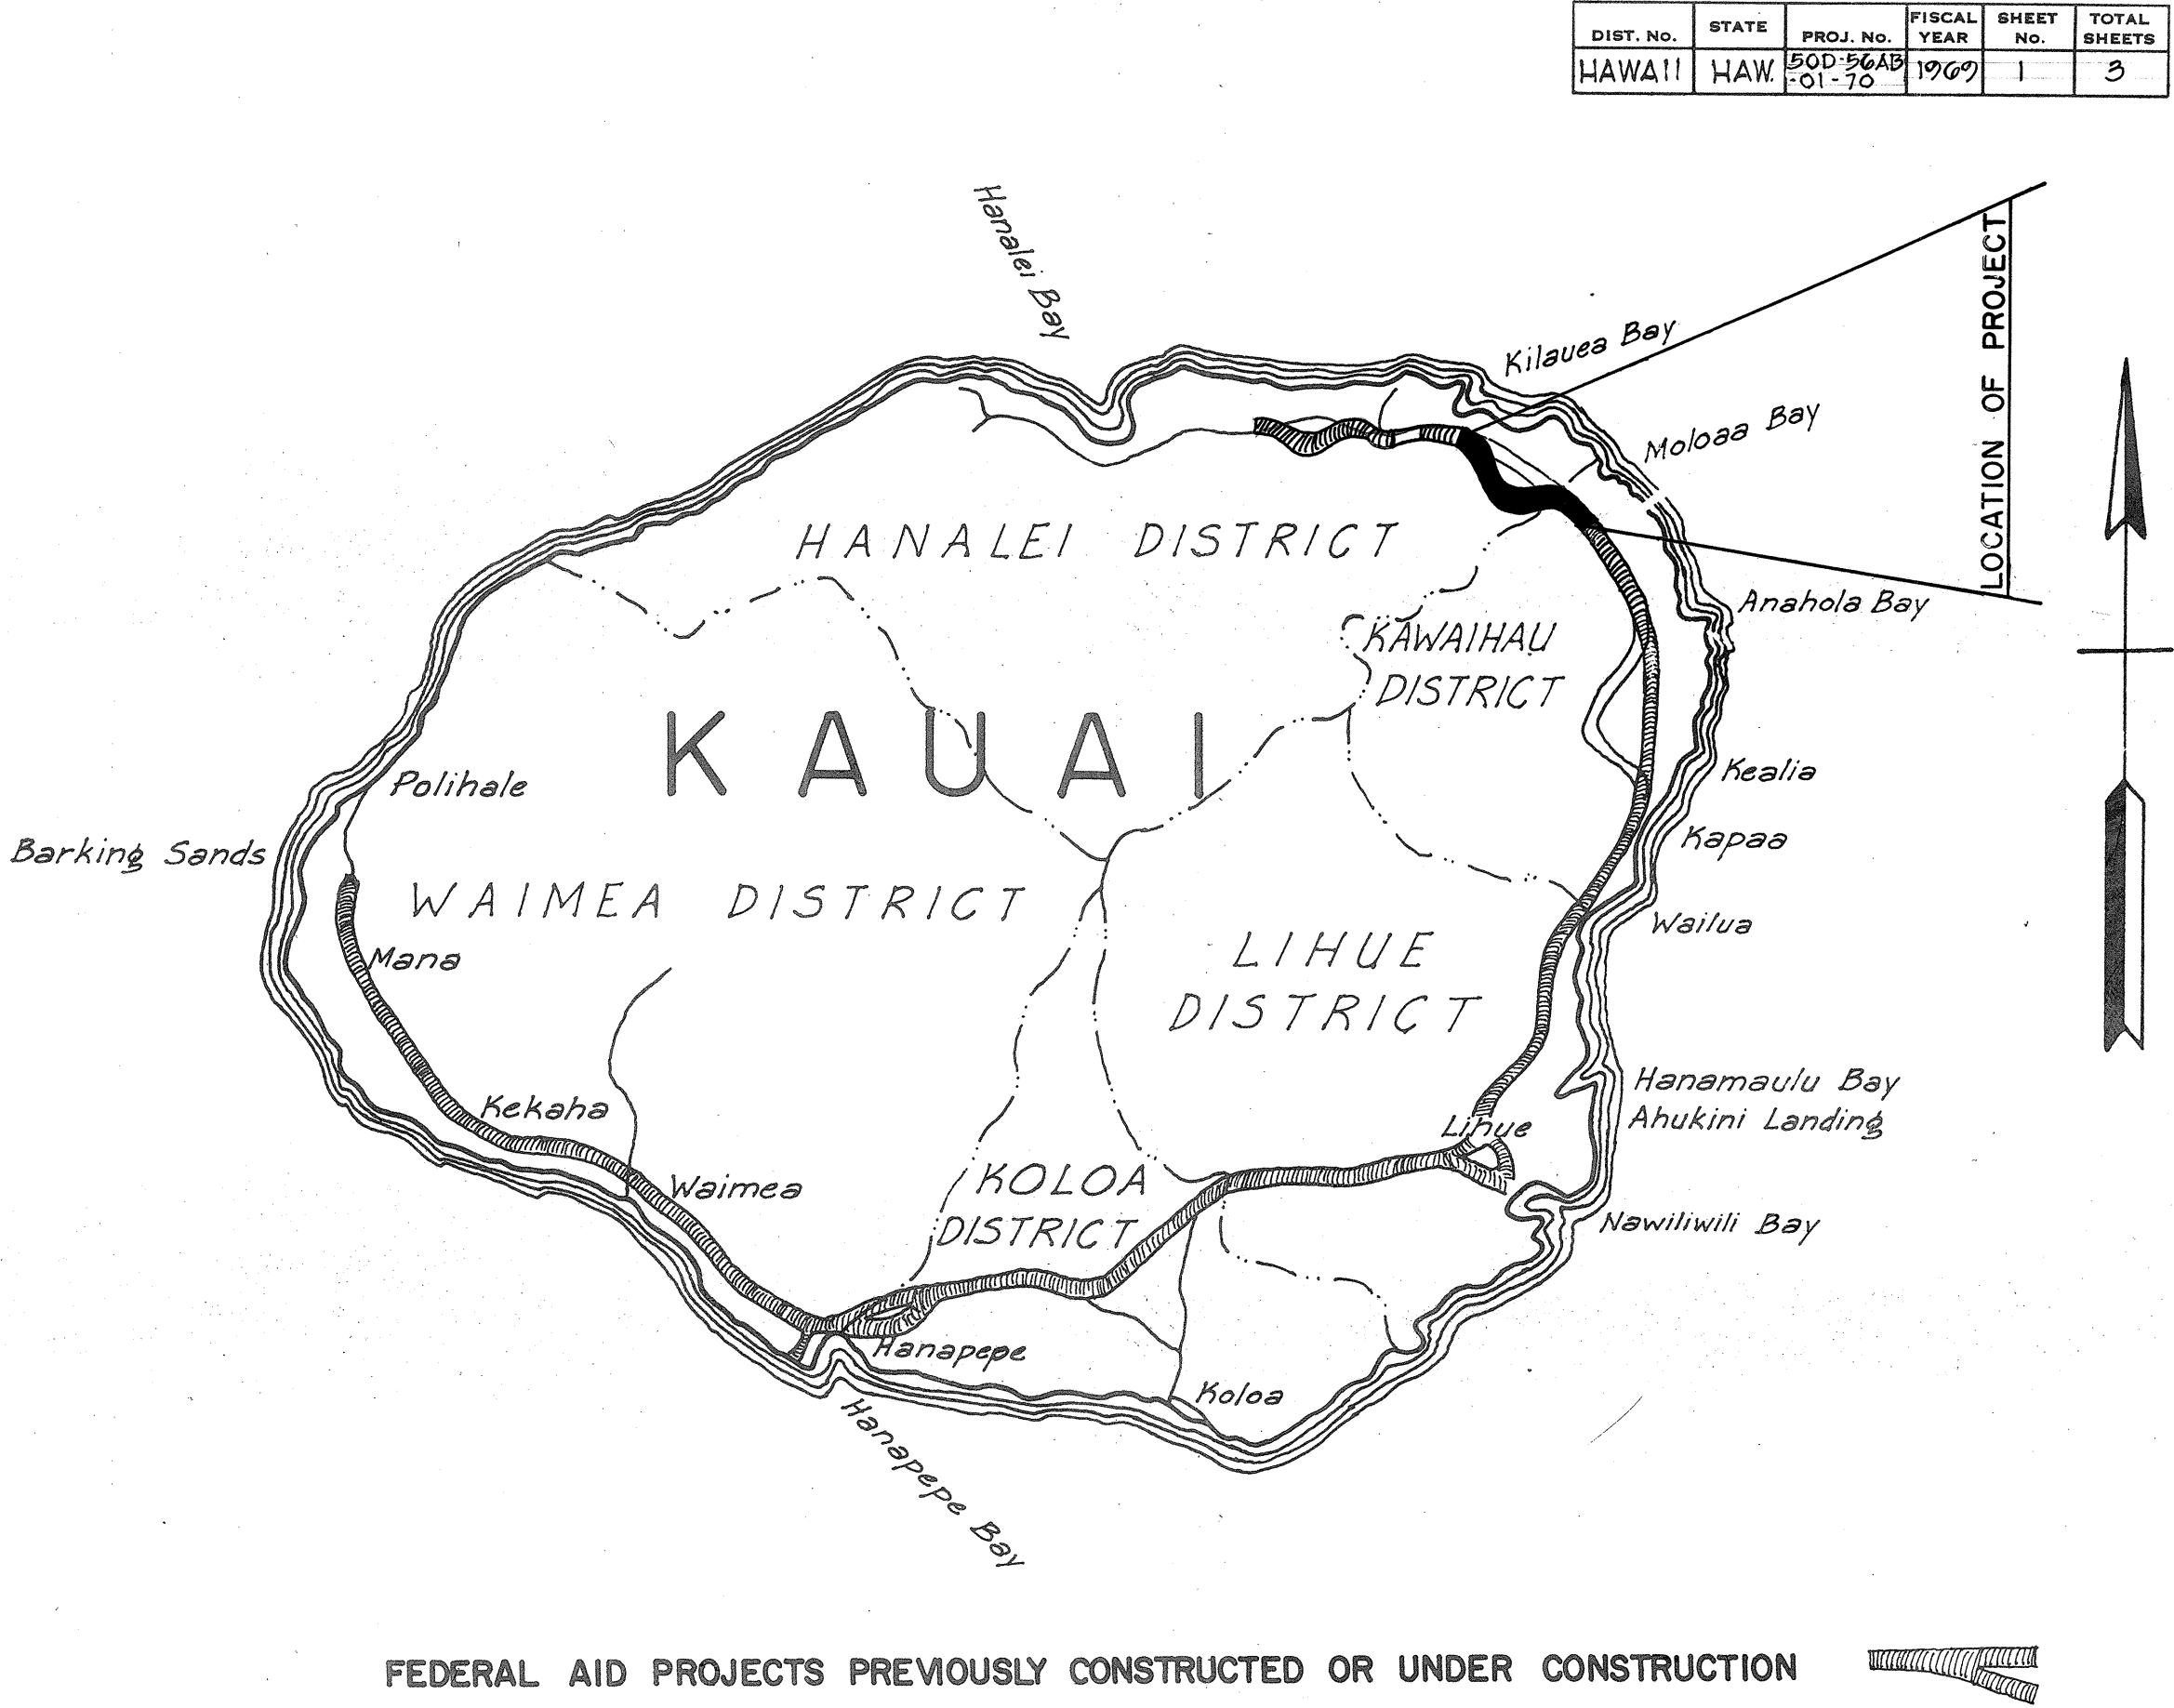

LAYOUT OF PROJECT

SCALE: 1"=5280'

GROSS LENGTH OF PROJECT	3.923 MI.
BRIDGE	0.047 MI.
NET LENGTH OF PROJECT	3.876 MI.

NO AS-BUILT CHANGES MADE

DURING CONSTRUCTION.

Donald Nagamine 8-11-81

PROJECT ENGINEER DATE

APPROVED: DATE 12/4/69

E. Alvey Wright

for DIRECTOR OF TRANSPORTATION

SURVEY PLOTTED BY	DATE
DESIGNED BY	
DRAWN BY	
TRACED BY	
QUANTITIES BY	
CHECKED BY	
NOTE BOOK	
No.	