


ORIGINAL PLAN	SURVEY PLOTTED BY.....	DATE.....
	DRAWN BY.....	
NOTE BOOK	TRACED BY.....	
	DESIGNED BY.....	
	QUANTITIES BY.....	
No.....	CHECKED BY.....	

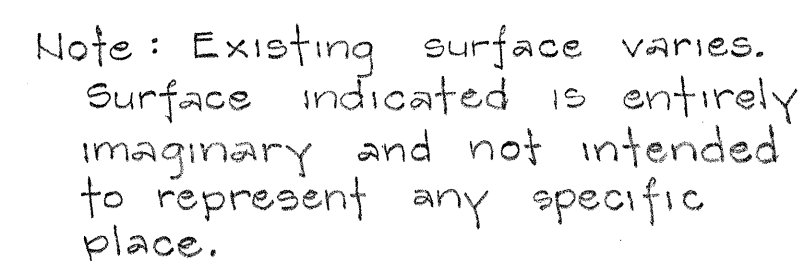

PRINTED ON NO. 1000H CLEARPRINT