


FED. ROAD DIST. NO.	STATE	PROJ. NO.	FISCAL YEAR	SHEET NO.	TOTAL SHEETS
HAWAII	HAW.	56A-04-70	1970	3	7


FINAL SURVEY	BY	DATE
NO. 1		
NO. 2		
NO. 3		
NO. 100		

ORIGINAL SURVEY	BY	DATE
NO. 1		
NO. 2		
NO. 3		
NO. 100		

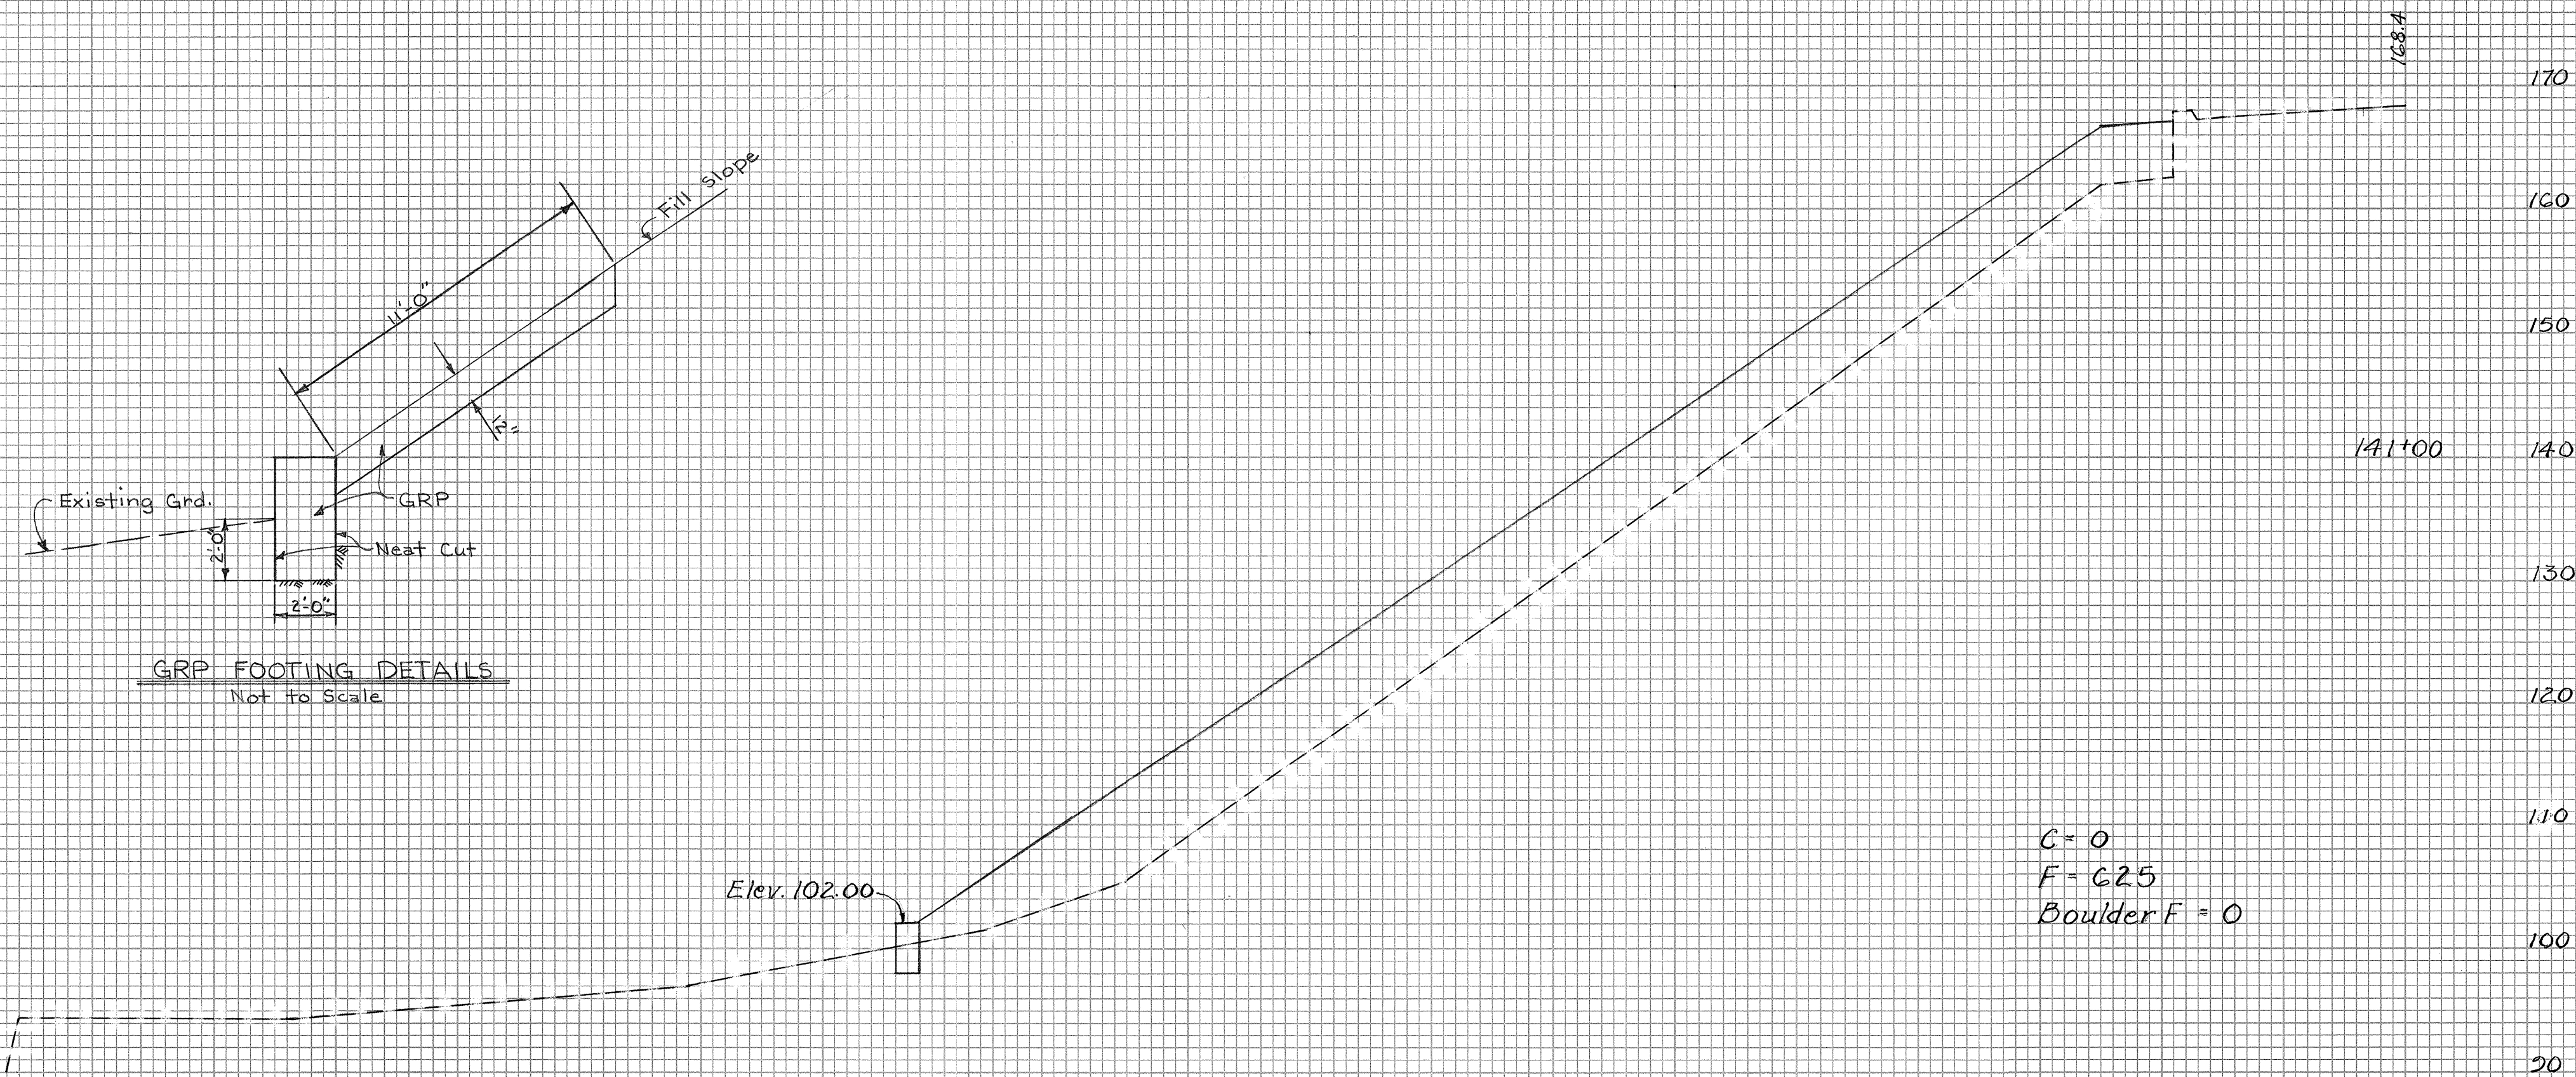

C = 0
F = 6.25
Boulder F = 0

Exc = 0
Emb = 1,207
Boulder Emb = 153

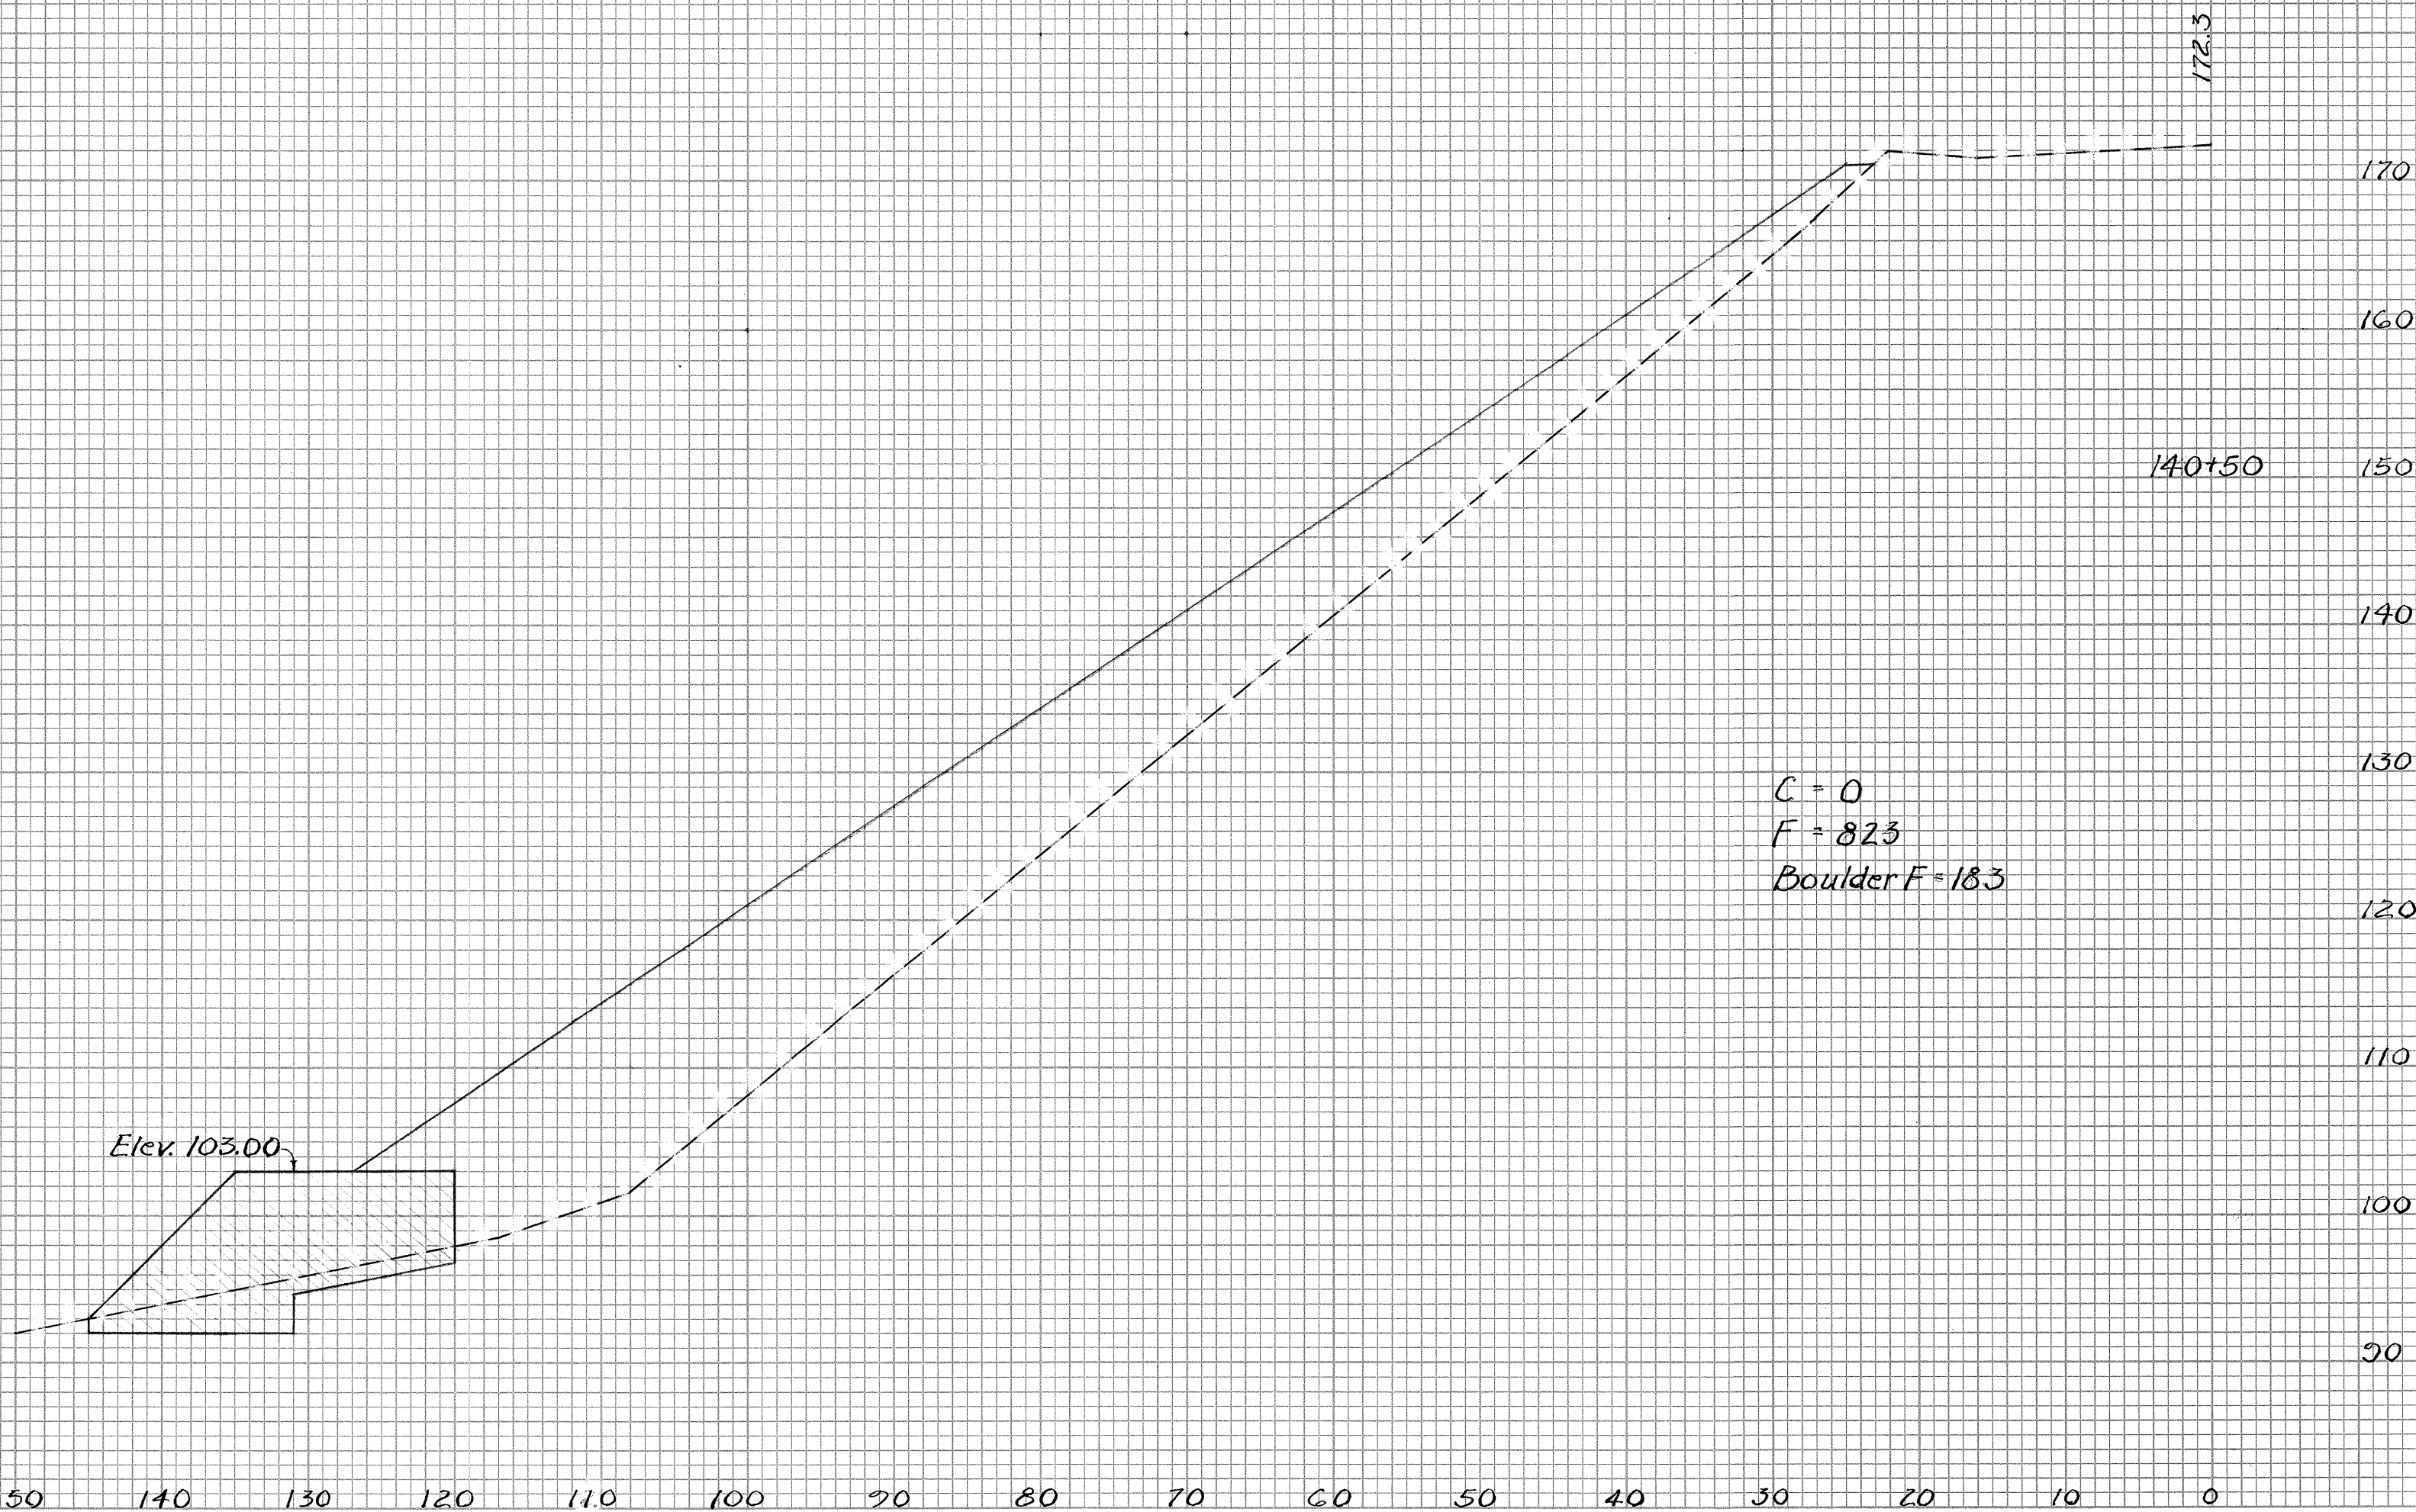


C = 0
F = 8.23
Boulder F = 18.3

FED. ROAD DIST. NO.	STATE	FED. AID PROJ. NO.	FISCAL YEAR	SHEET NO.	TOTAL SHEETS
HAWAII	HAW.	56A-04-70	1970	4	7

FINAL SURVEY	DATE
NO. _____	_____
BY _____	_____
SURVEYED _____	_____
NOTE BOOK _____	_____
AREAS CHECKED _____	_____





ORIGINAL SURVEY	DATE
NO. _____	_____
BY _____	_____
SURVEYED _____	_____
NOTE BOOK _____	_____
AREAS CHECKED _____	_____

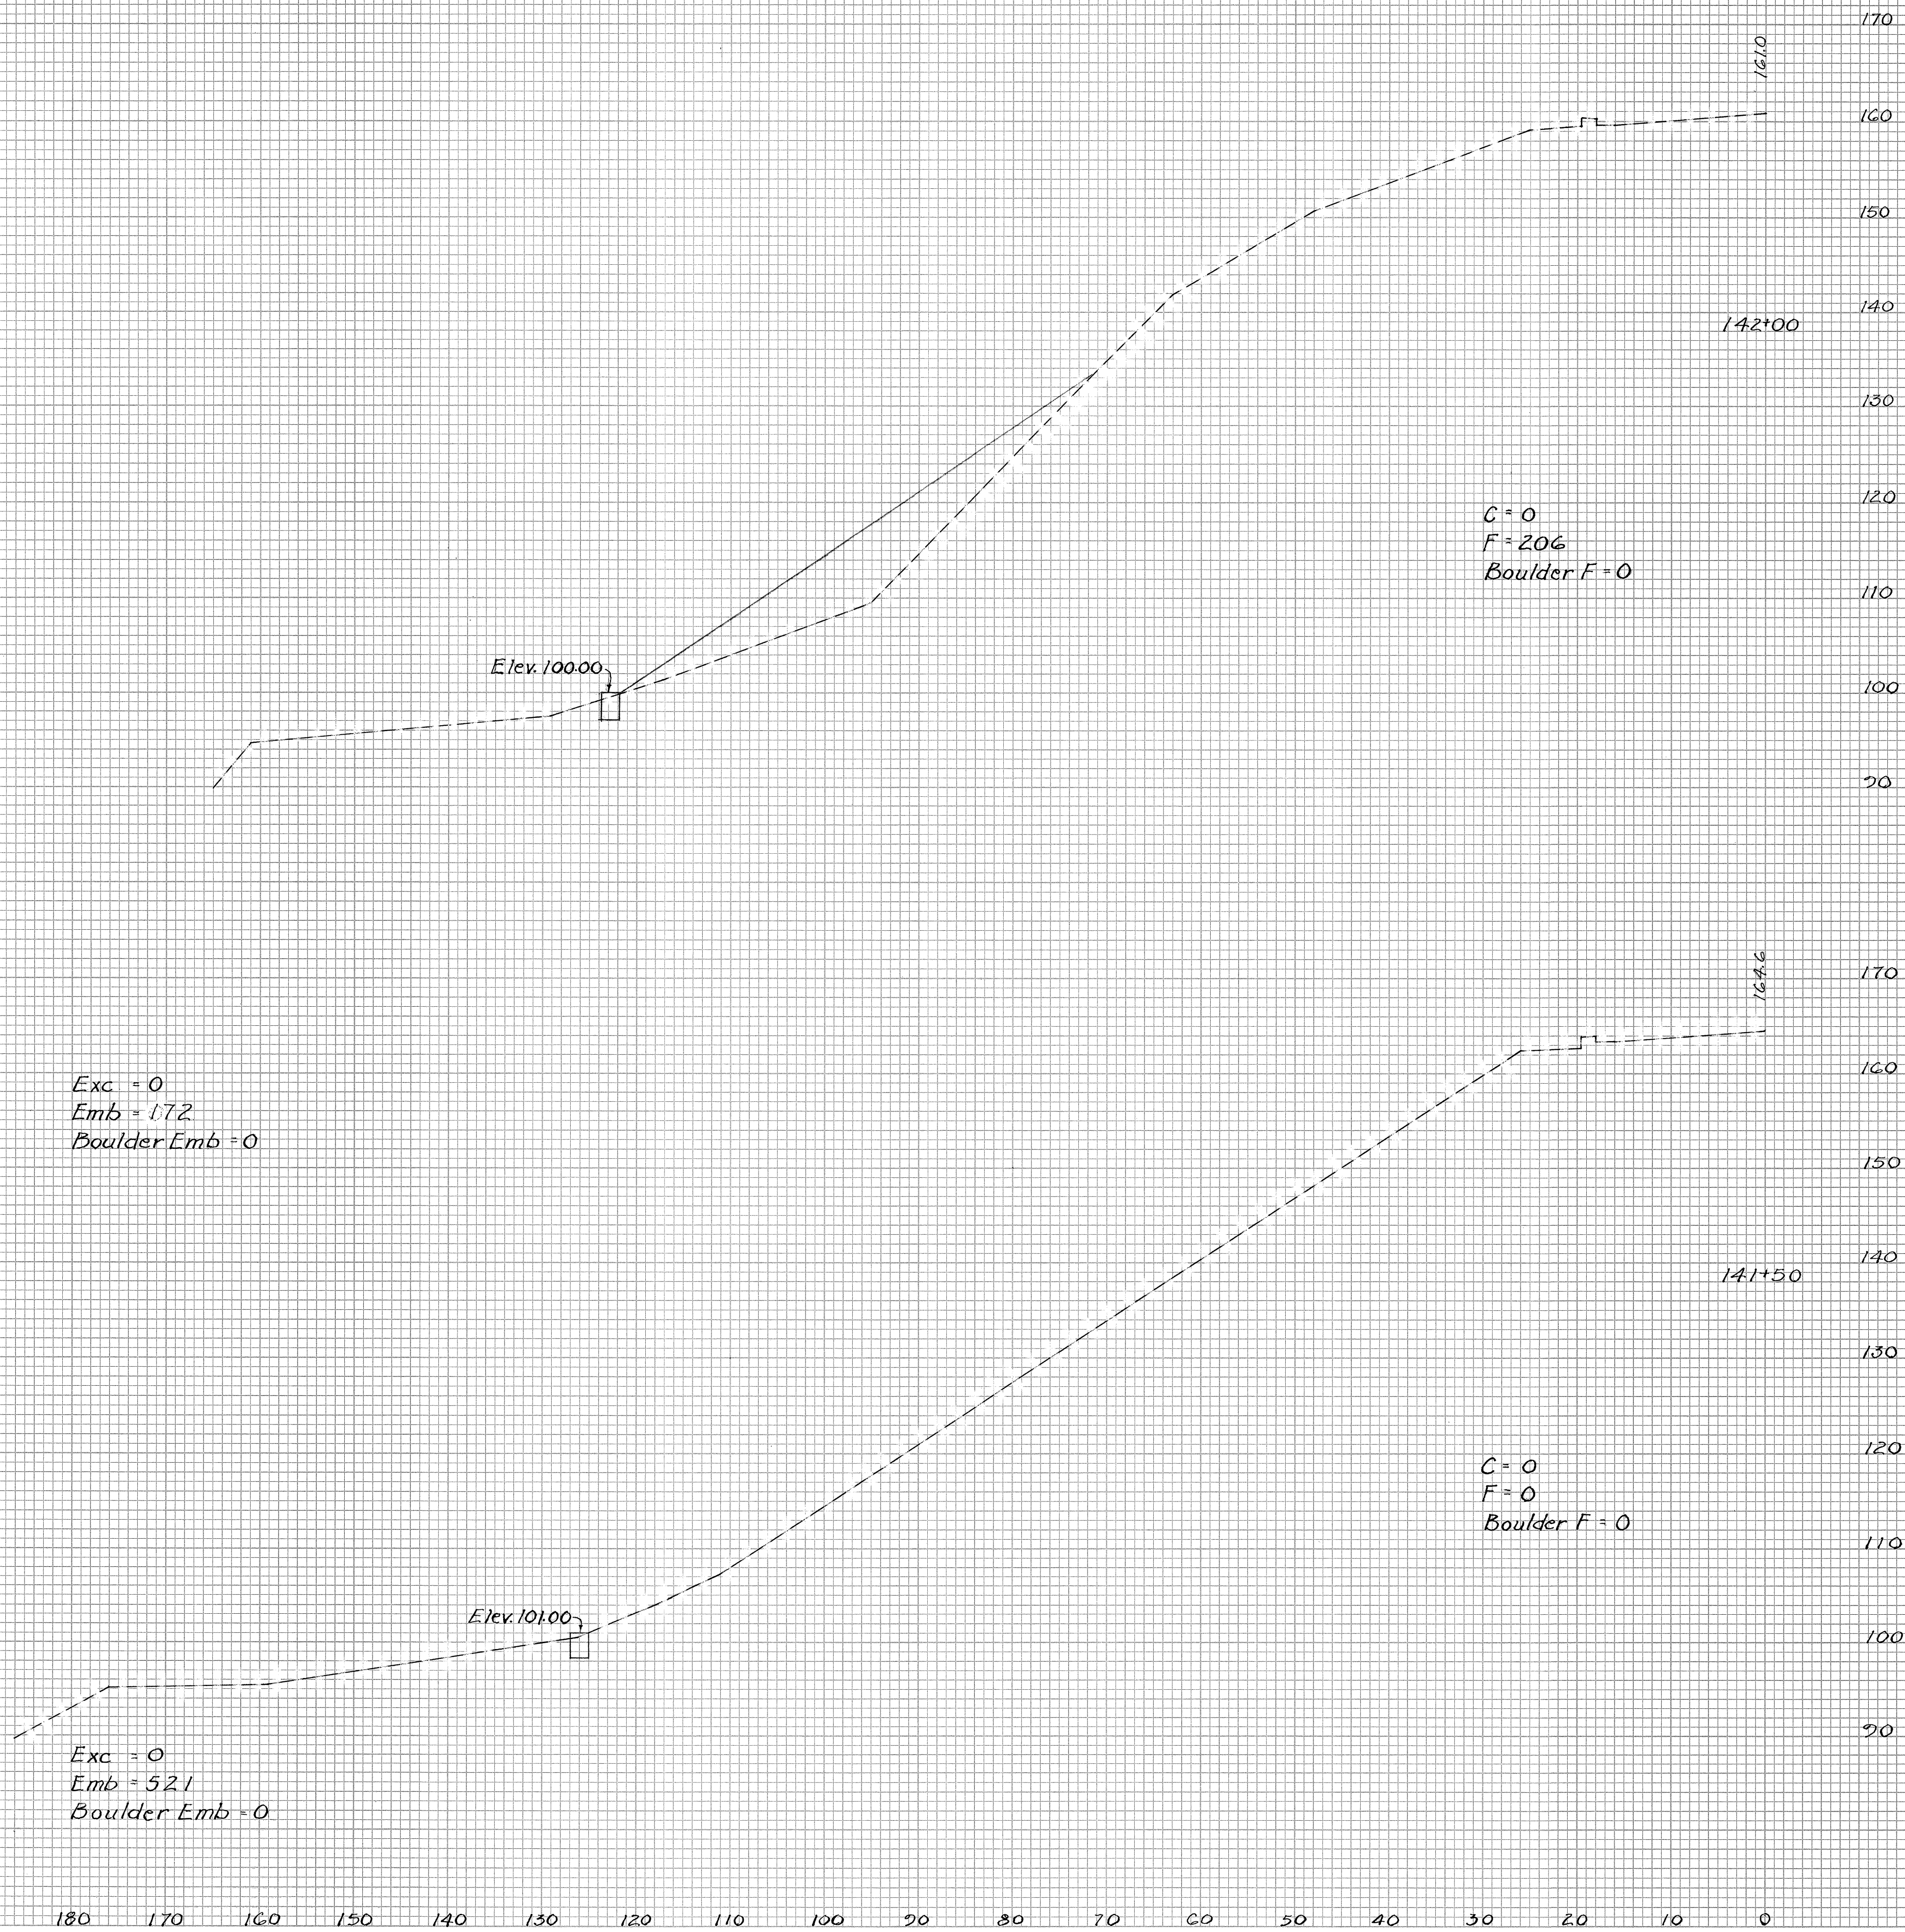

FED. ROAD DIST. NO.	STATE	NO. AND PROJ. NO.	FISCAL YEAR	SHEET NO.	TOTAL SHEETS
HAWAII	HAW.	56A-04-70	1970	5	7

FINAL SURVEY			BY	DATE
SURVEYED				
PLOTTED				
TEMPLATE				
AREAS				
AREAS CHECKED				
NO.				

ORIGINAL			
SURVEY	SURVEYED	BY	DATE
	PLOTTED		
NOTE BOOK	TEMPLATE		
	AREAS		
NO.	AREAS CHECKED		

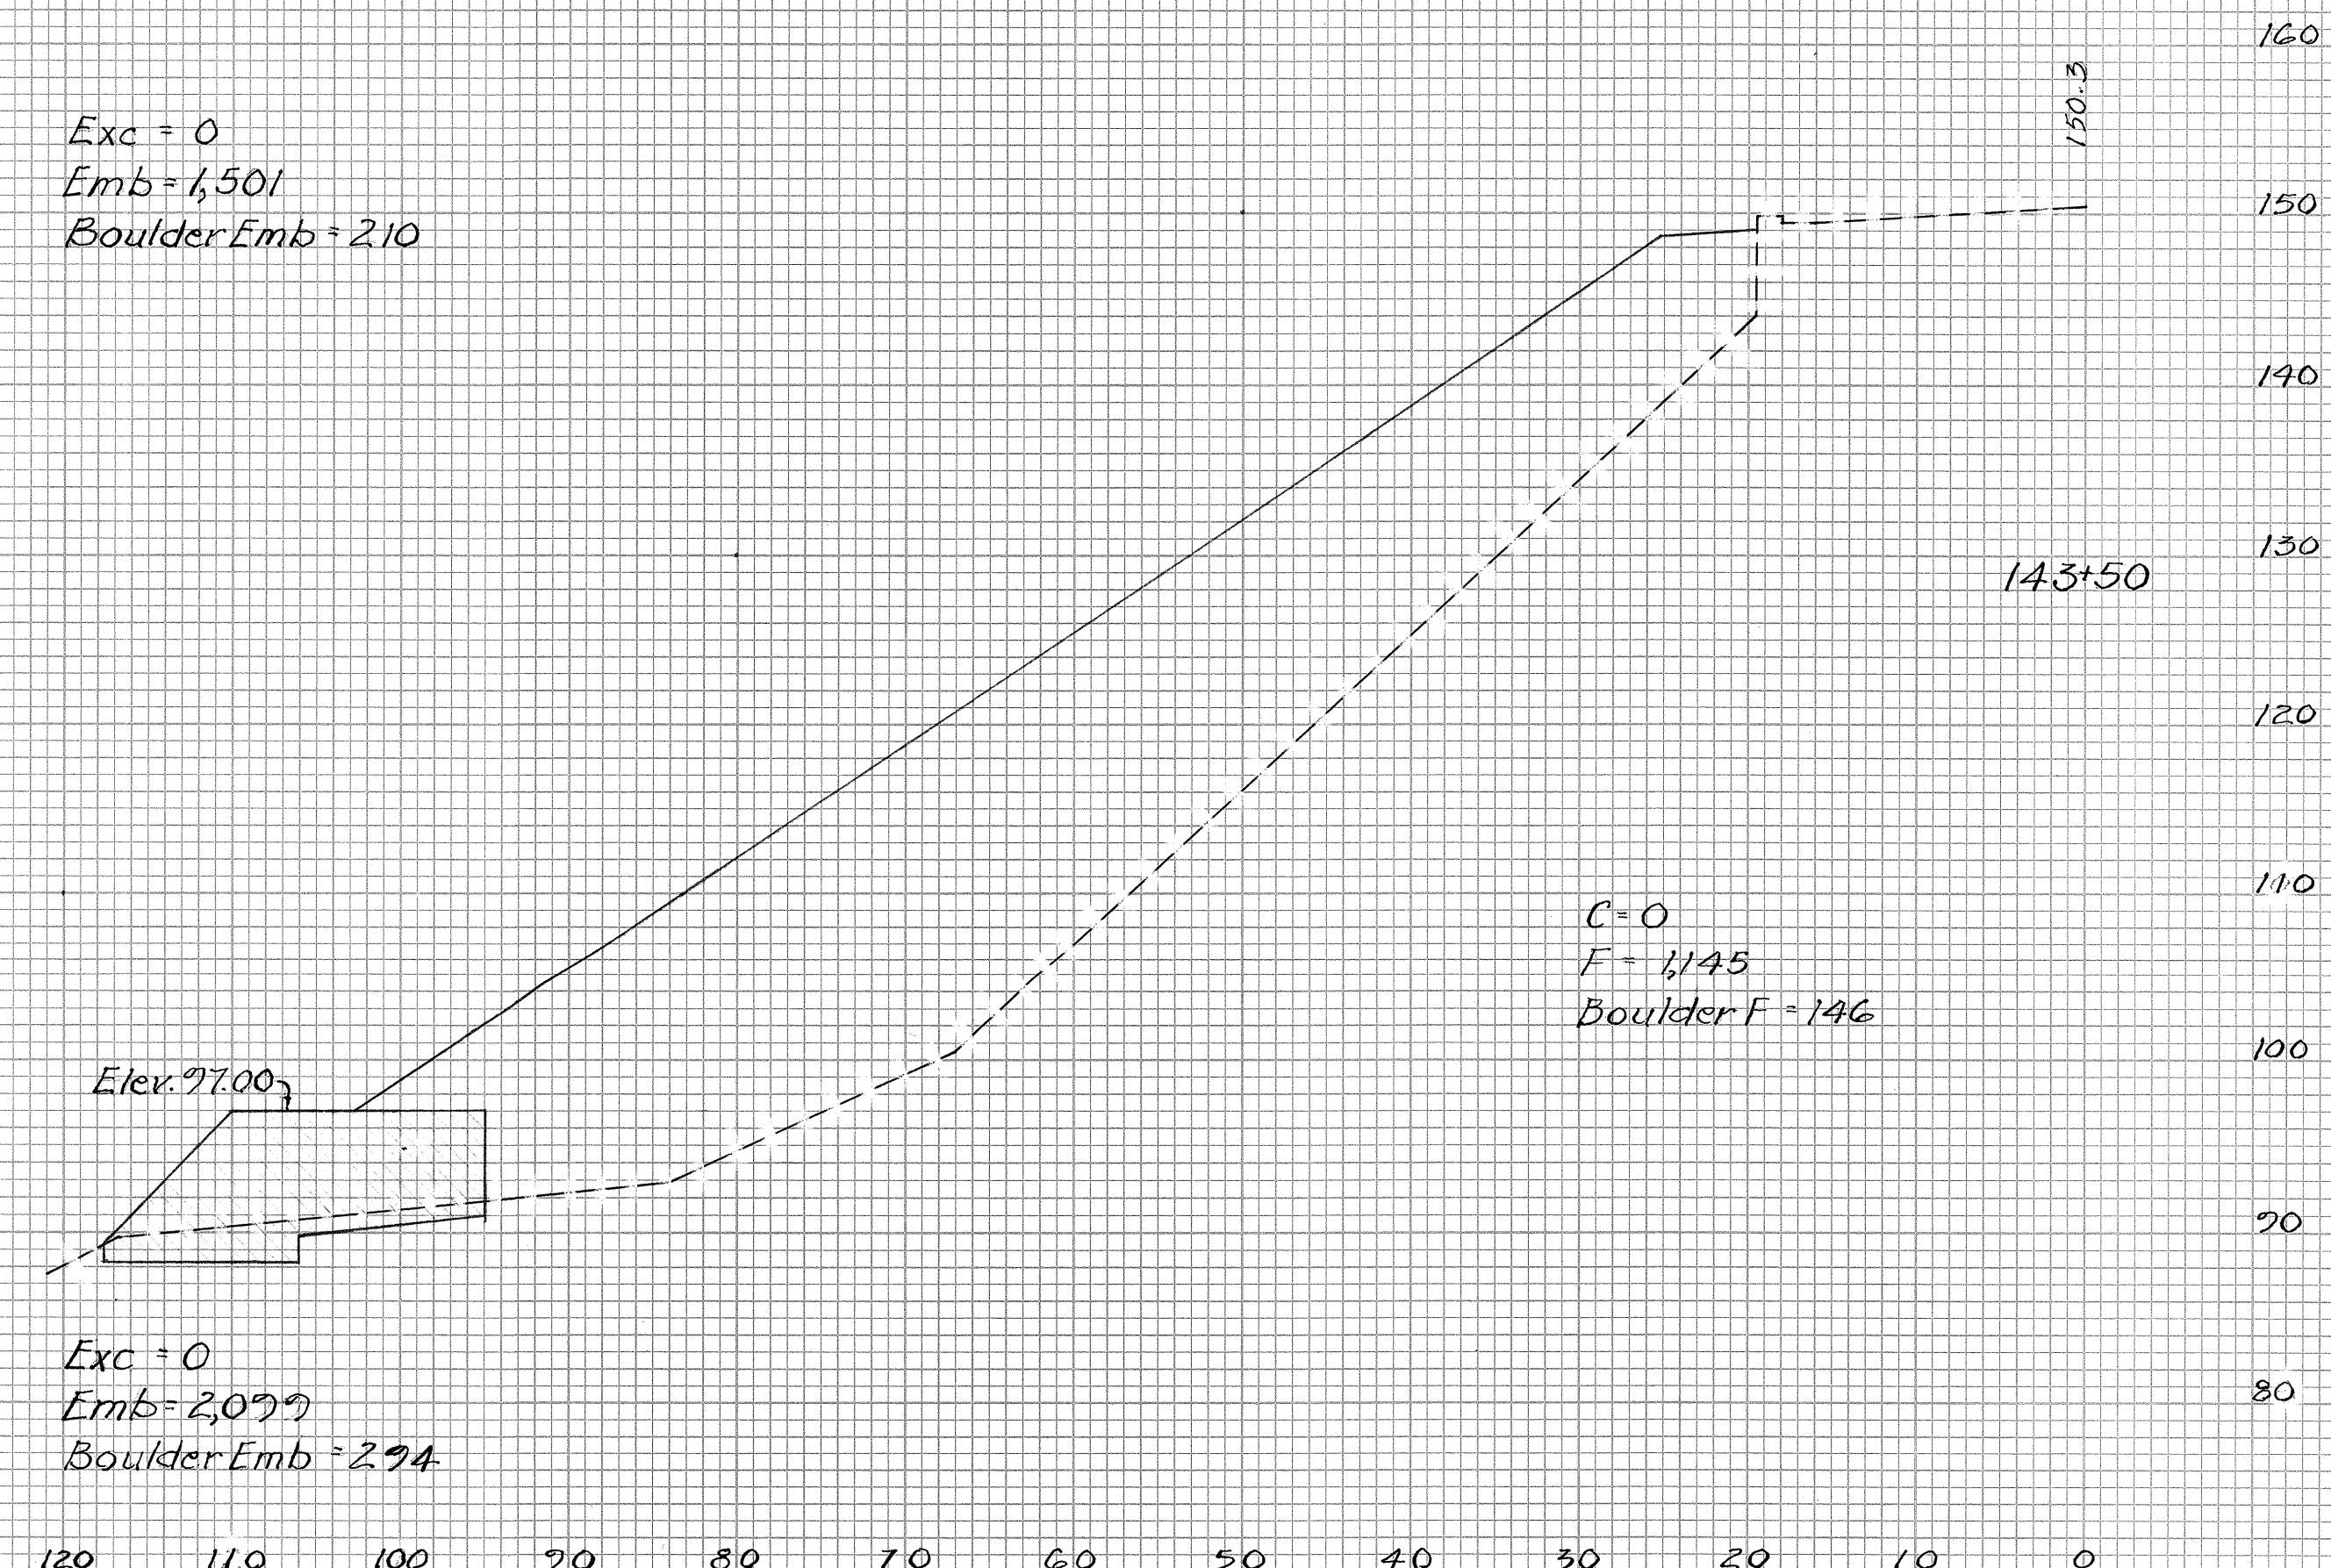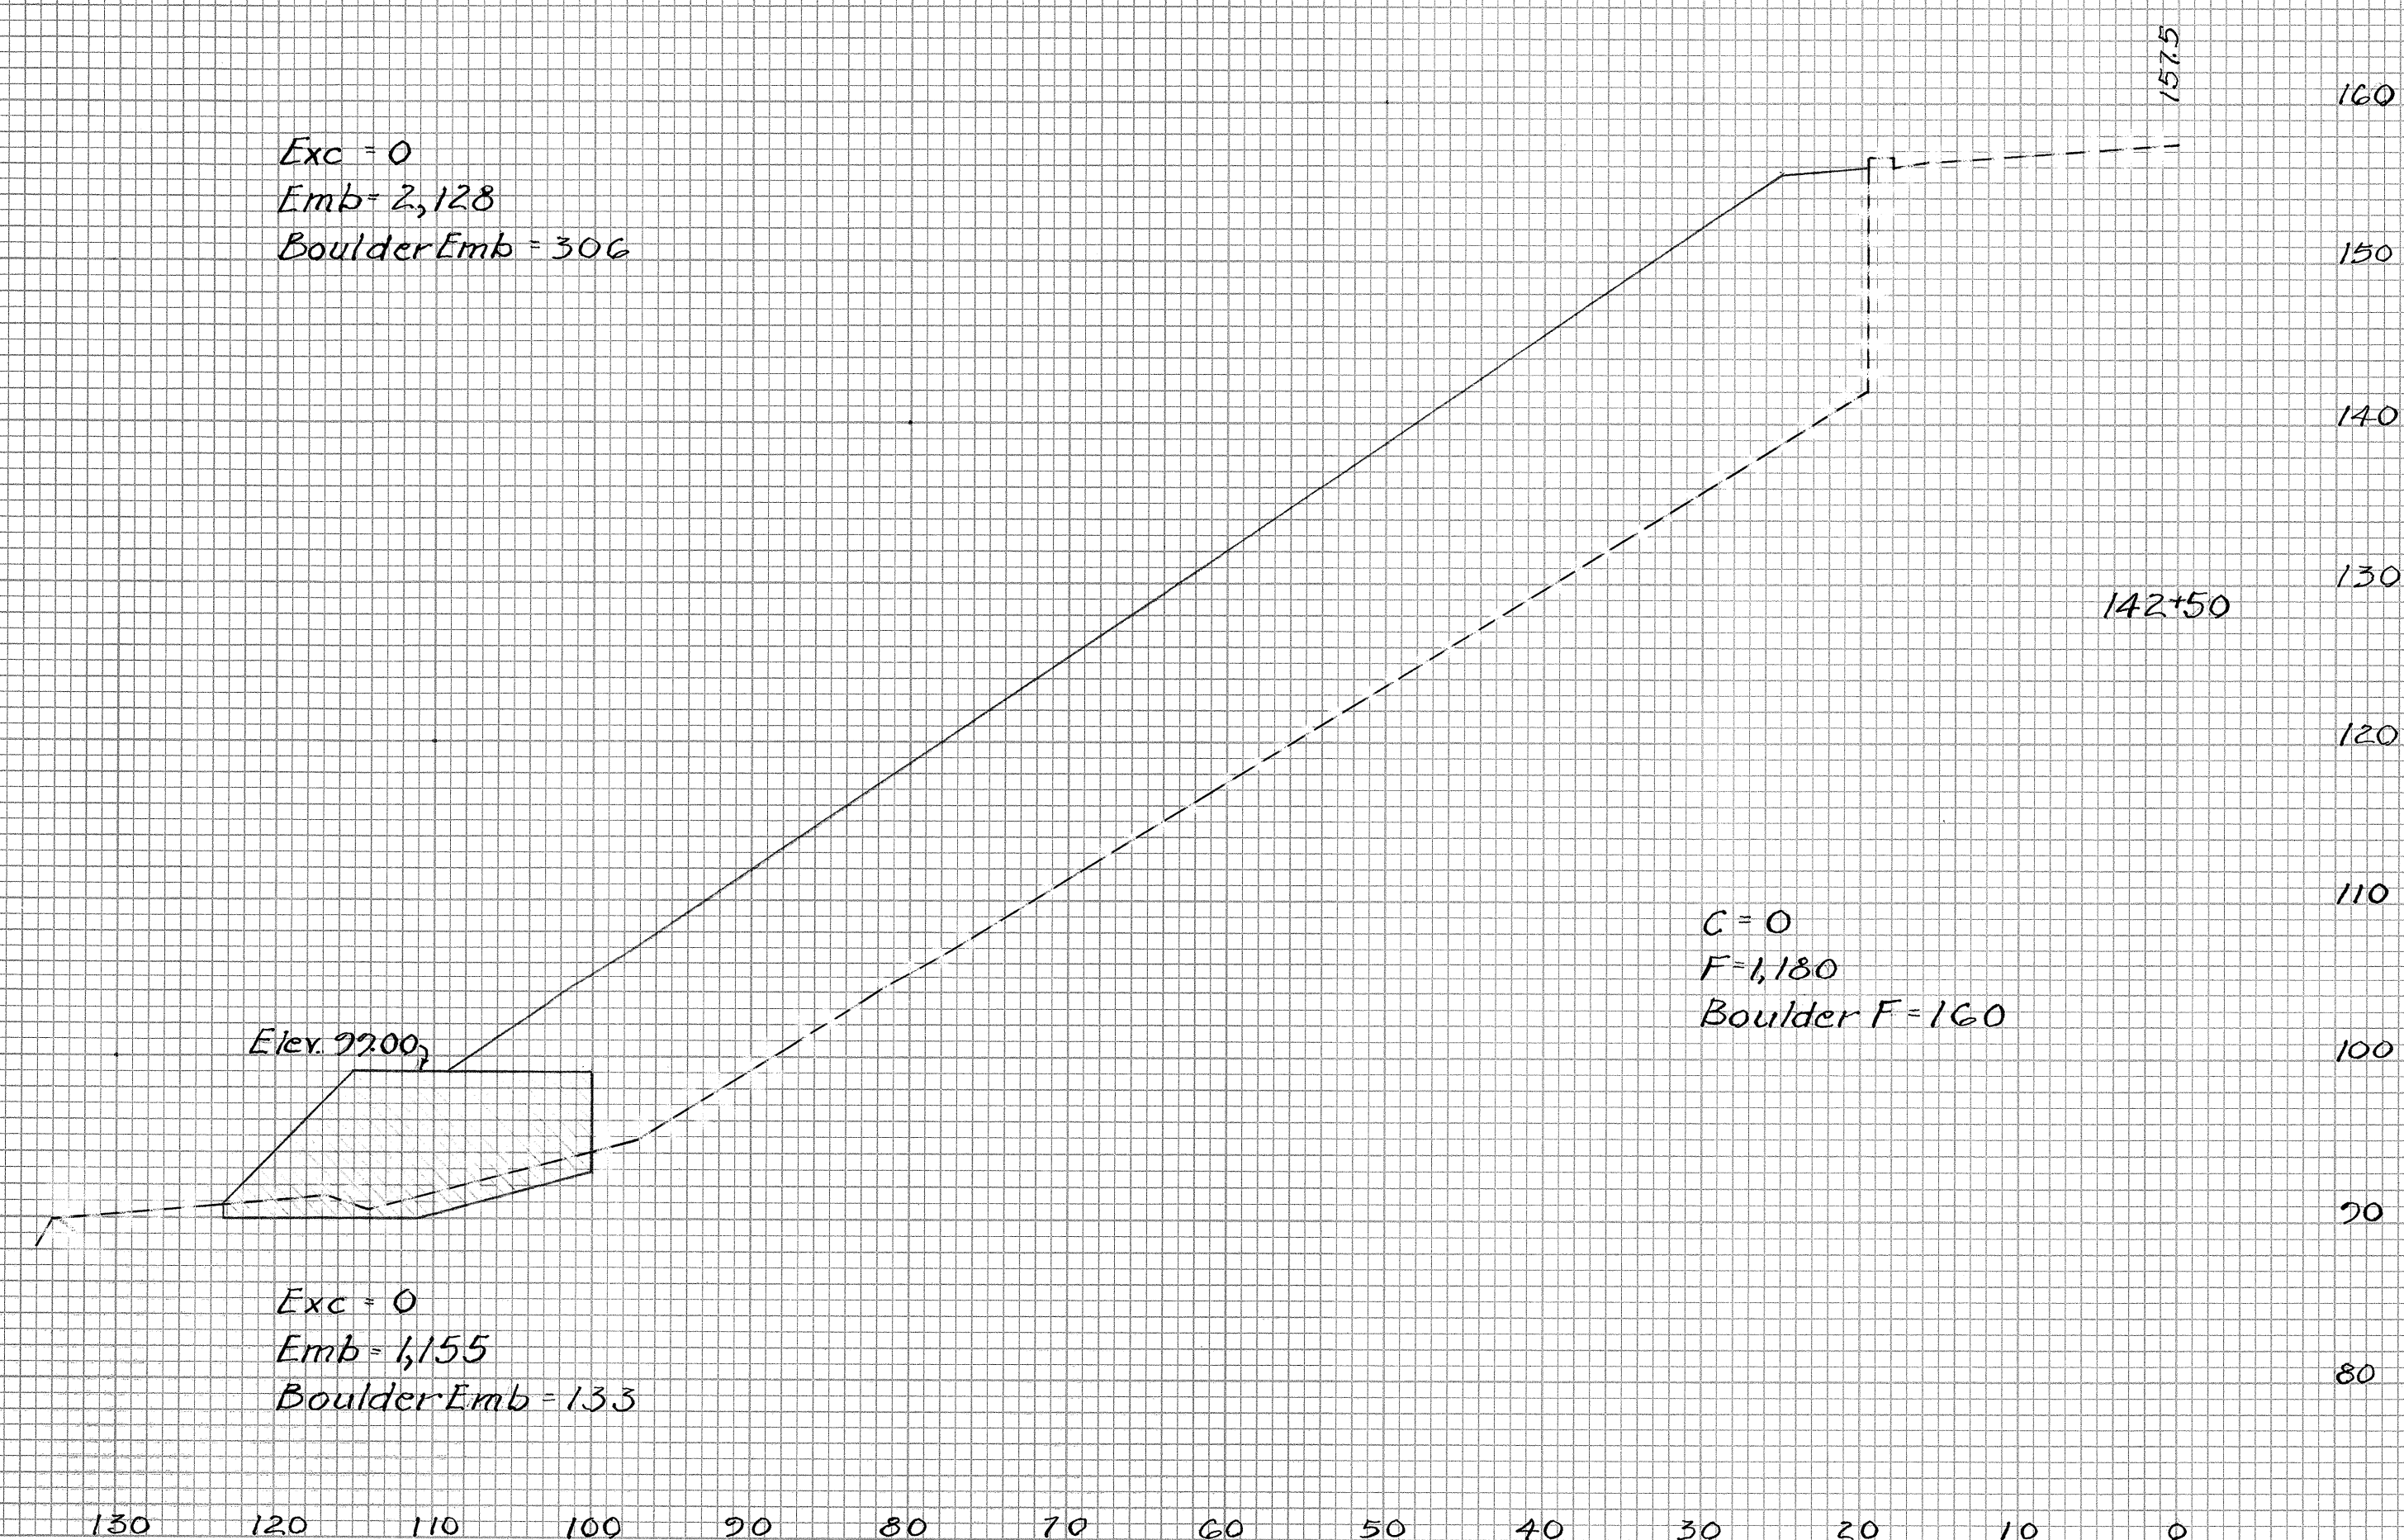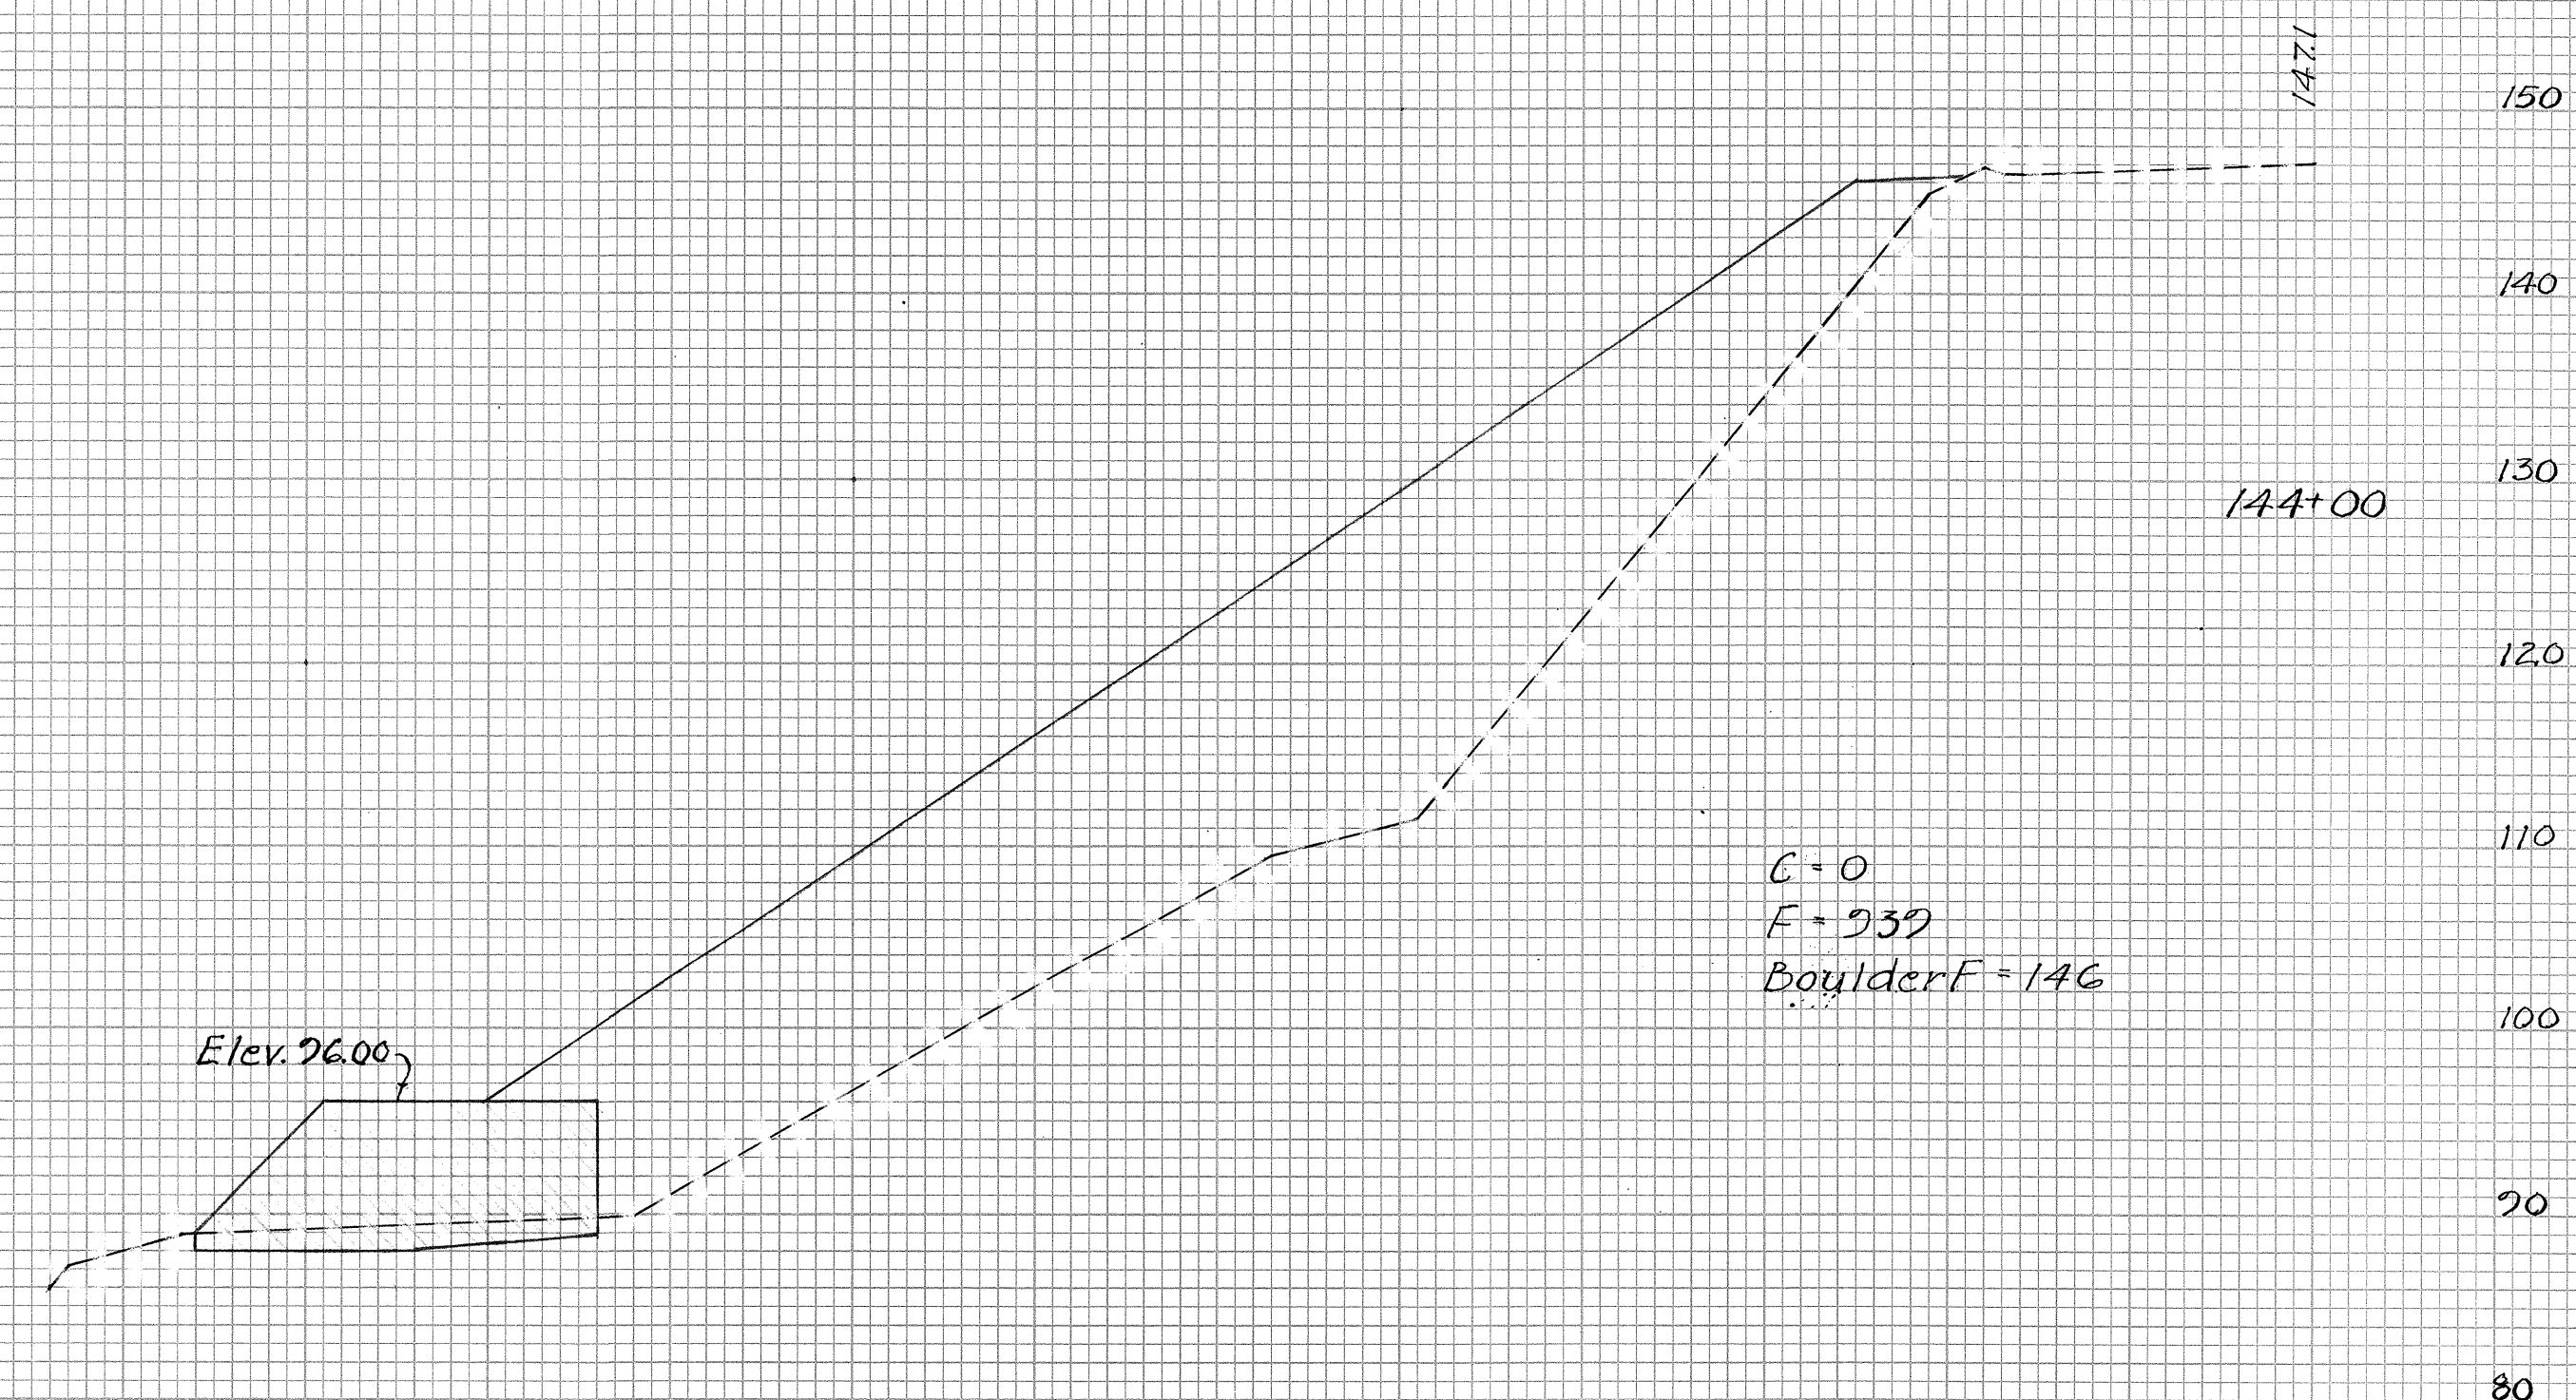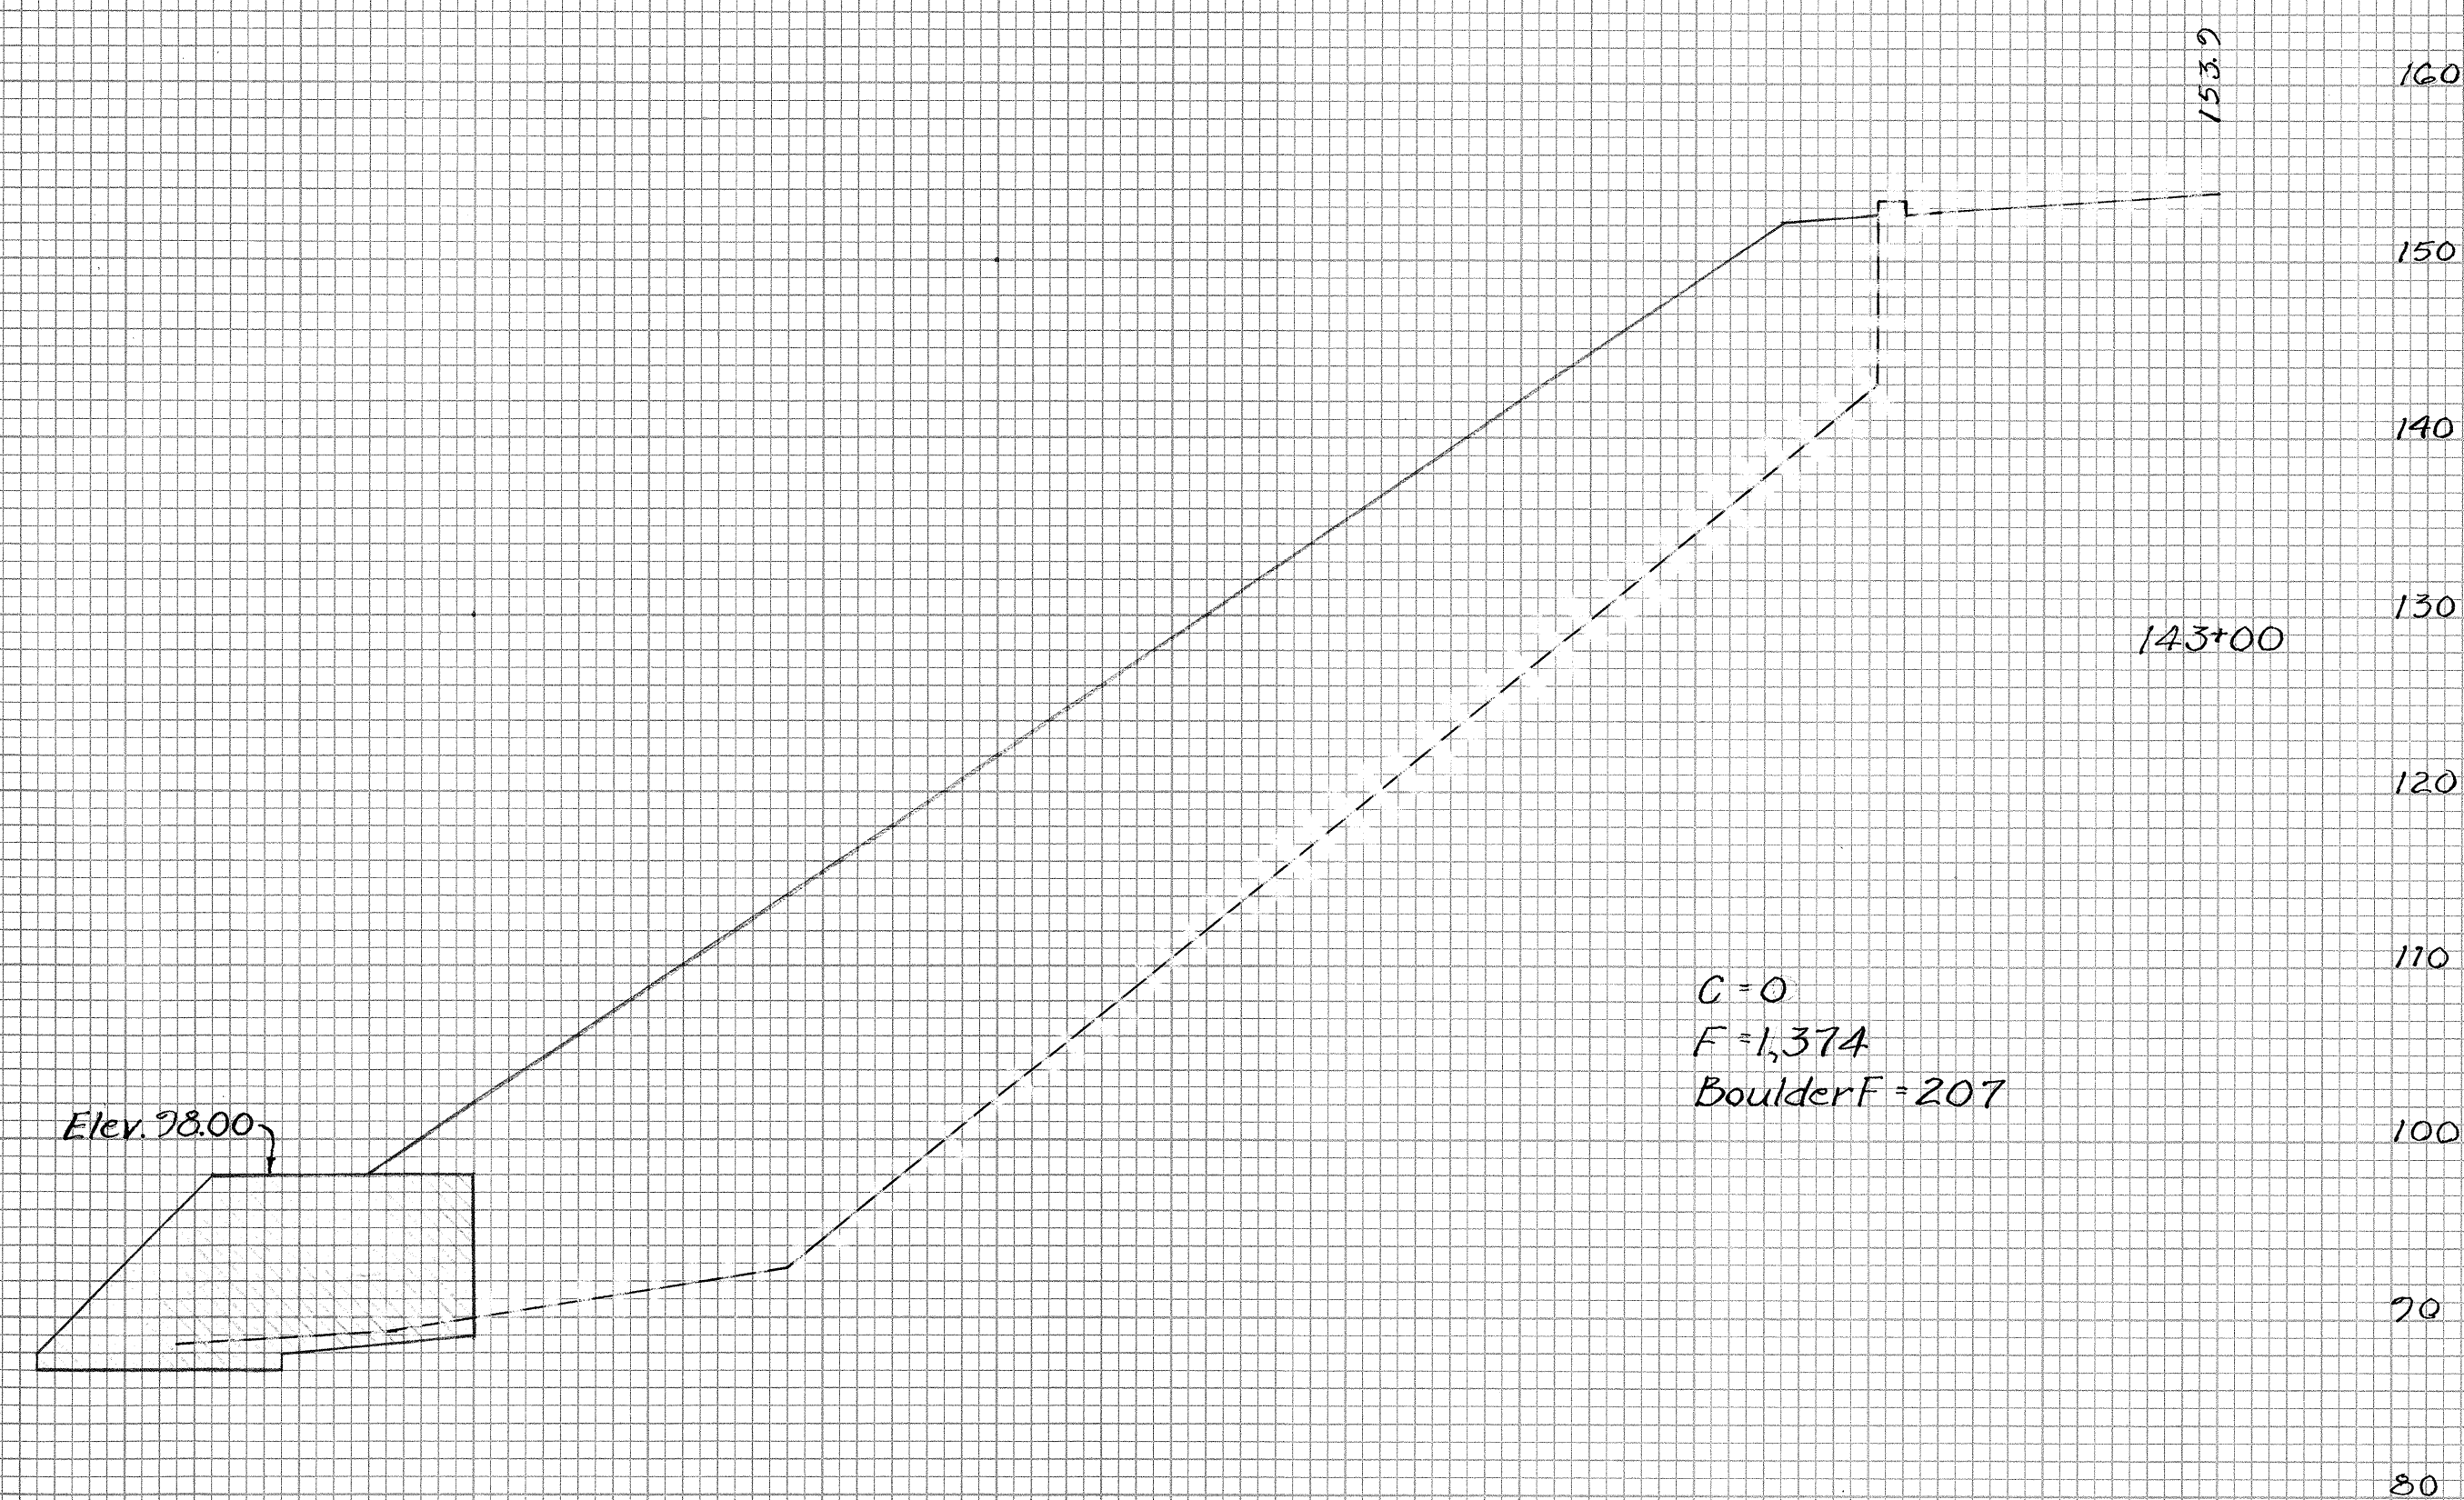

FED. ROAD DIST. NO.	STATE	FED. AID PROJ. NO.	FISCAL YEAR	SHEET NO.	TOTAL SHEETS
HAWAII	HAW.	56A-04-70	1970	6	7

FINAL SURVEY NOTE BOOK NO.	SURVEYED PLOTTED TEMPLATE AREAS CHECKED	BY	DATE

ORIGINAL SURVEY NOTE BOOK NO.	SURVEYED PLOTTED TEMPLATE AREAS CHECKED	BY	DATE

