

STATE OF HAWAII DEPARTMENT OF TRANSPORTATION HIGHWAYS DIVISION AS-BUILT

## PLANS FOR REPAIR HIGHWAY RETAINING WALL AT KAPAIA

PROJECT NO. 56A-04-70


DISTRICT OF LIHUE

ISLAND OF KAUAI

HANAMAULU

LAYOUT OF PROJECT

SCALE I" = 1000'

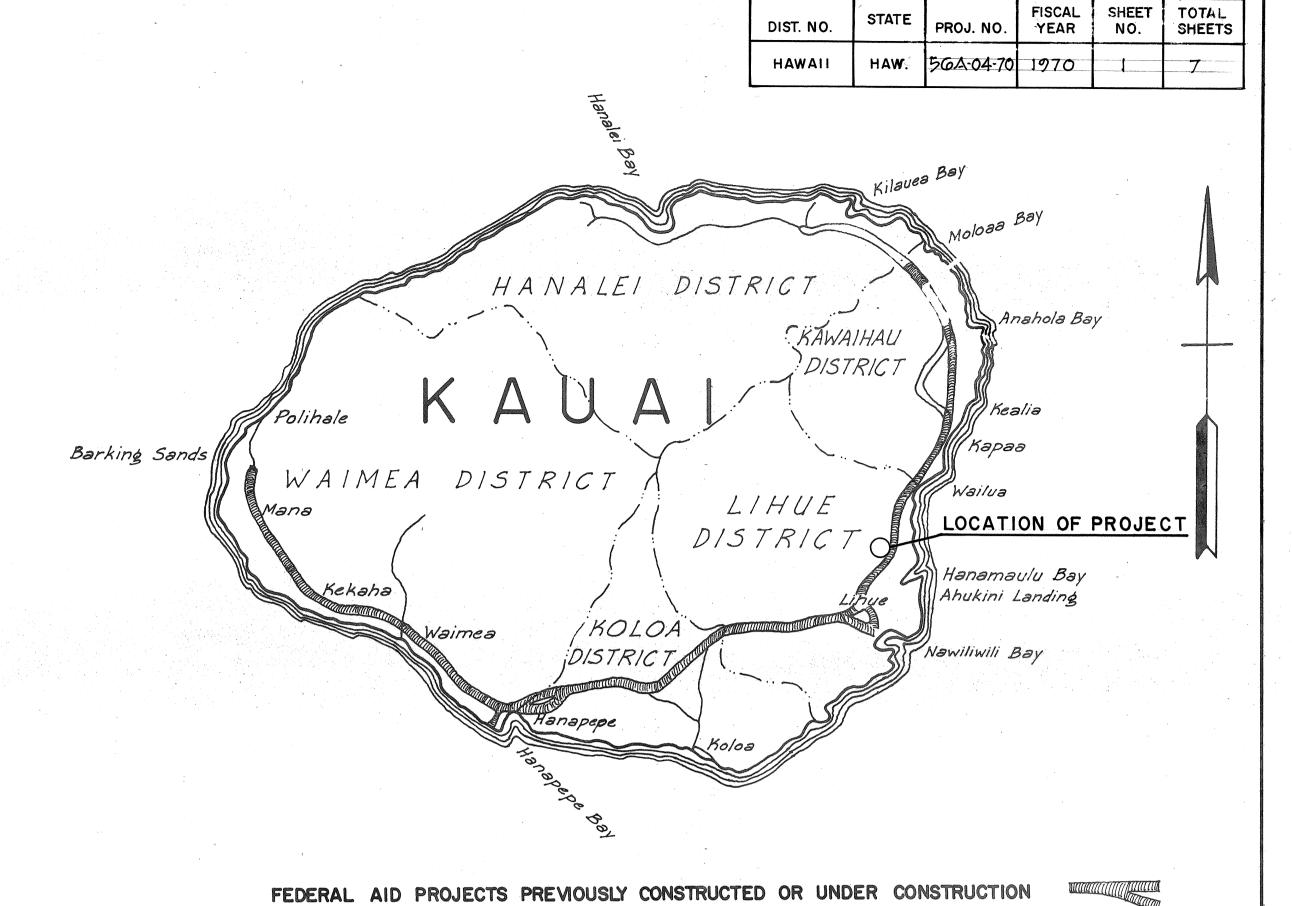

ALL CHANGES MADE DURING CONSTRUCTION HAVE BEEN NOTED IN RED ON THESE TRACINGS AND CHECKED BY:

Jan. 19, 1972

APPROVED:

NOTE:

DEPARTMENT OF TRANSPORTATION STATE OF HAWAII