INC	EX TO DRAWINGS
SHEET NO	DESCRIPTION
	TITLE SHEET
2	PLAN & DETAILS
3	DETAILS
4	STANDARD DETAIL
5	PROJECT INFORMATION SIGN

DEPARTMENT OF TRANSPORTATION
HIGHWAYS DIVISION


"AS\_BUILT"
PLANS FOR
CONSTRUCTION OF


DRAINAGE IMPROVEMENT, KAUAI BELT ROAD,

ANAHOLA, KAUAI PROJECT NO. 56C-01-71

DISTRICT OF KAWAIHAU

ISLAND OF KAUAI

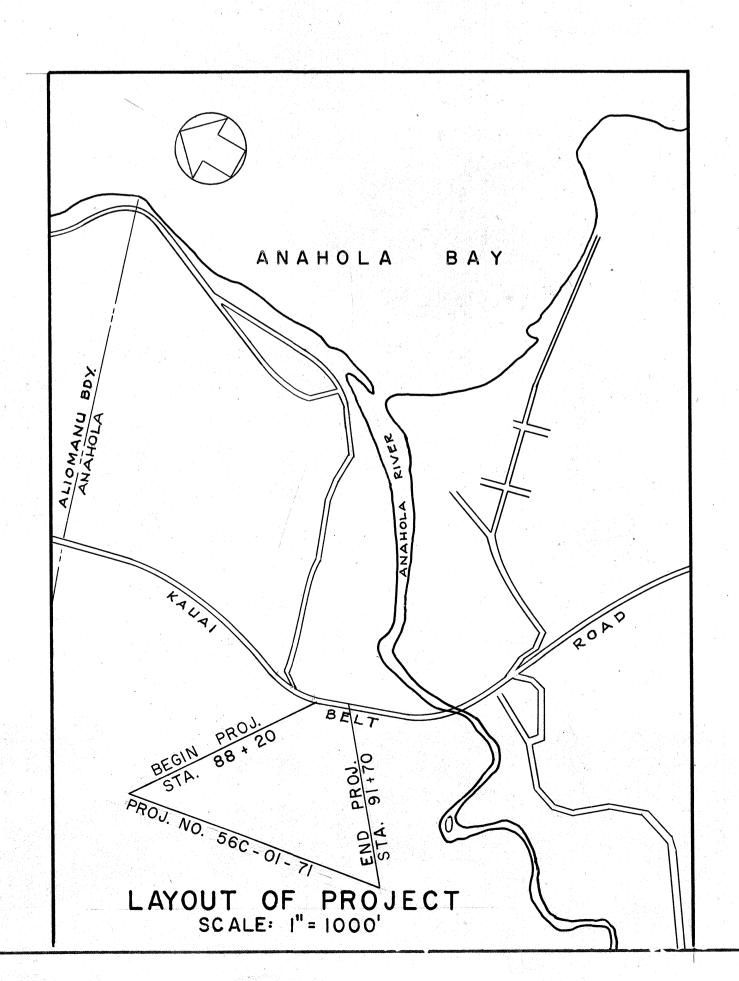

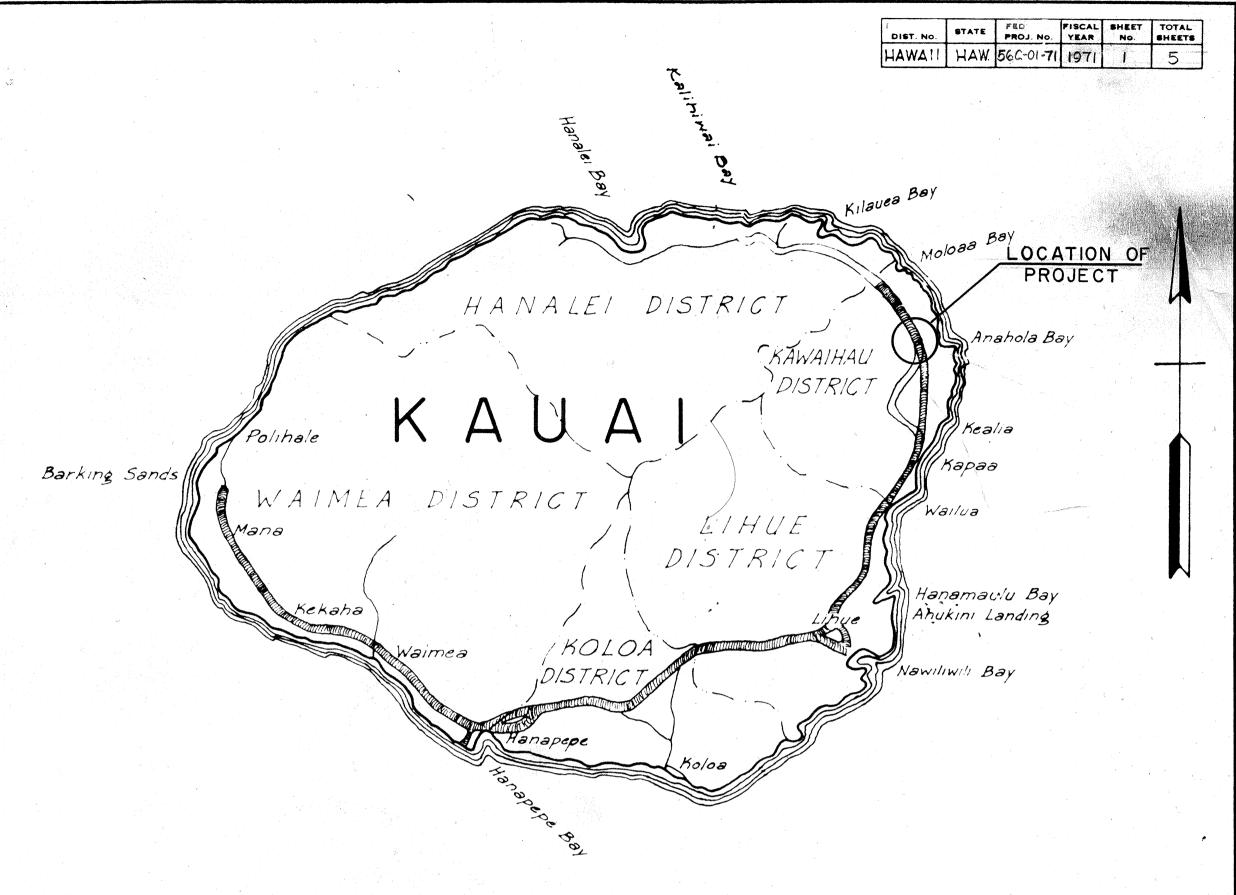

FEDERAL AID PROJECTS PREVIOUSLY CONSTRUCTED OR UNDER CONSTRUCTION

ALL CHANGES MADE DURING CONSTRUCTION
HAVE BEEN INCORPORATED ON THESE PLANS
EXCEPT CHANGES IN THE ORIGINAL THEORETICAL
QUANTITIES

for PROJECT ENGINEER

1-22-81 DATE

DEPARTMENT OF TRANSPORTATION
STATE OF HAWAII
APPROVED:

6. alver Grill 5/10/21

DIR. OF TRANSPORTATION DATE

DEPARTMENT O STURIATION FEDERAL HIGHWAYS ADMINISTRAL.

1161 yeM

DESIGNED BY
DRAWN BY
TRACED BY
QUANTITIES BY

8-6-9