


REVISED: 2-10-72

FED. ROAD DIST. NO.	STATE	FED. AID PROJ. NO.	FISCAL YEAR	SHEET NO.	TOTAL SHEETS
HAWAII	HAW.	RF-056-1(10)	1971	37	74

ESTIMATED QUANTITIES


Concrete- Footing	(220)	Lump Sum
Concrete- All Others	(569)	Lump Sum
Reinforcing Steel	(219,800)	Lump Sum
Prestressed Girder Type IV	(2,003)	Lump Sum
Furnishing - Type I Prestressed Conc. Piles	4,086	Lin. Ft.
Driving Concrete Piles	27,977.9	3,866 Lin. Ft.
Predrill for Piles	70	Lin. Ft.
Metal Bridge Railing (One Rail Traffic Type)	4,934	Lin. Ft.
Concrete Bridge Railing & End Post	539.9	550 Lin. Ft.
Structure Excavation for Bridges	374.7	382 Cu. Yd.
Structure Backfill for Abut. & Wing Walls	310.9	382 Cu. Yd.
Structure Excavation for Bridge Piers	521.5	666 Cu. Yd.
Filter Material	17.7	25 Cu. Yd.
G.R.P.	9.9	11 Cu. Yd.

* Structure Backfill for Bridge Piers incidental to Structure Excavation for Bridge Piers.

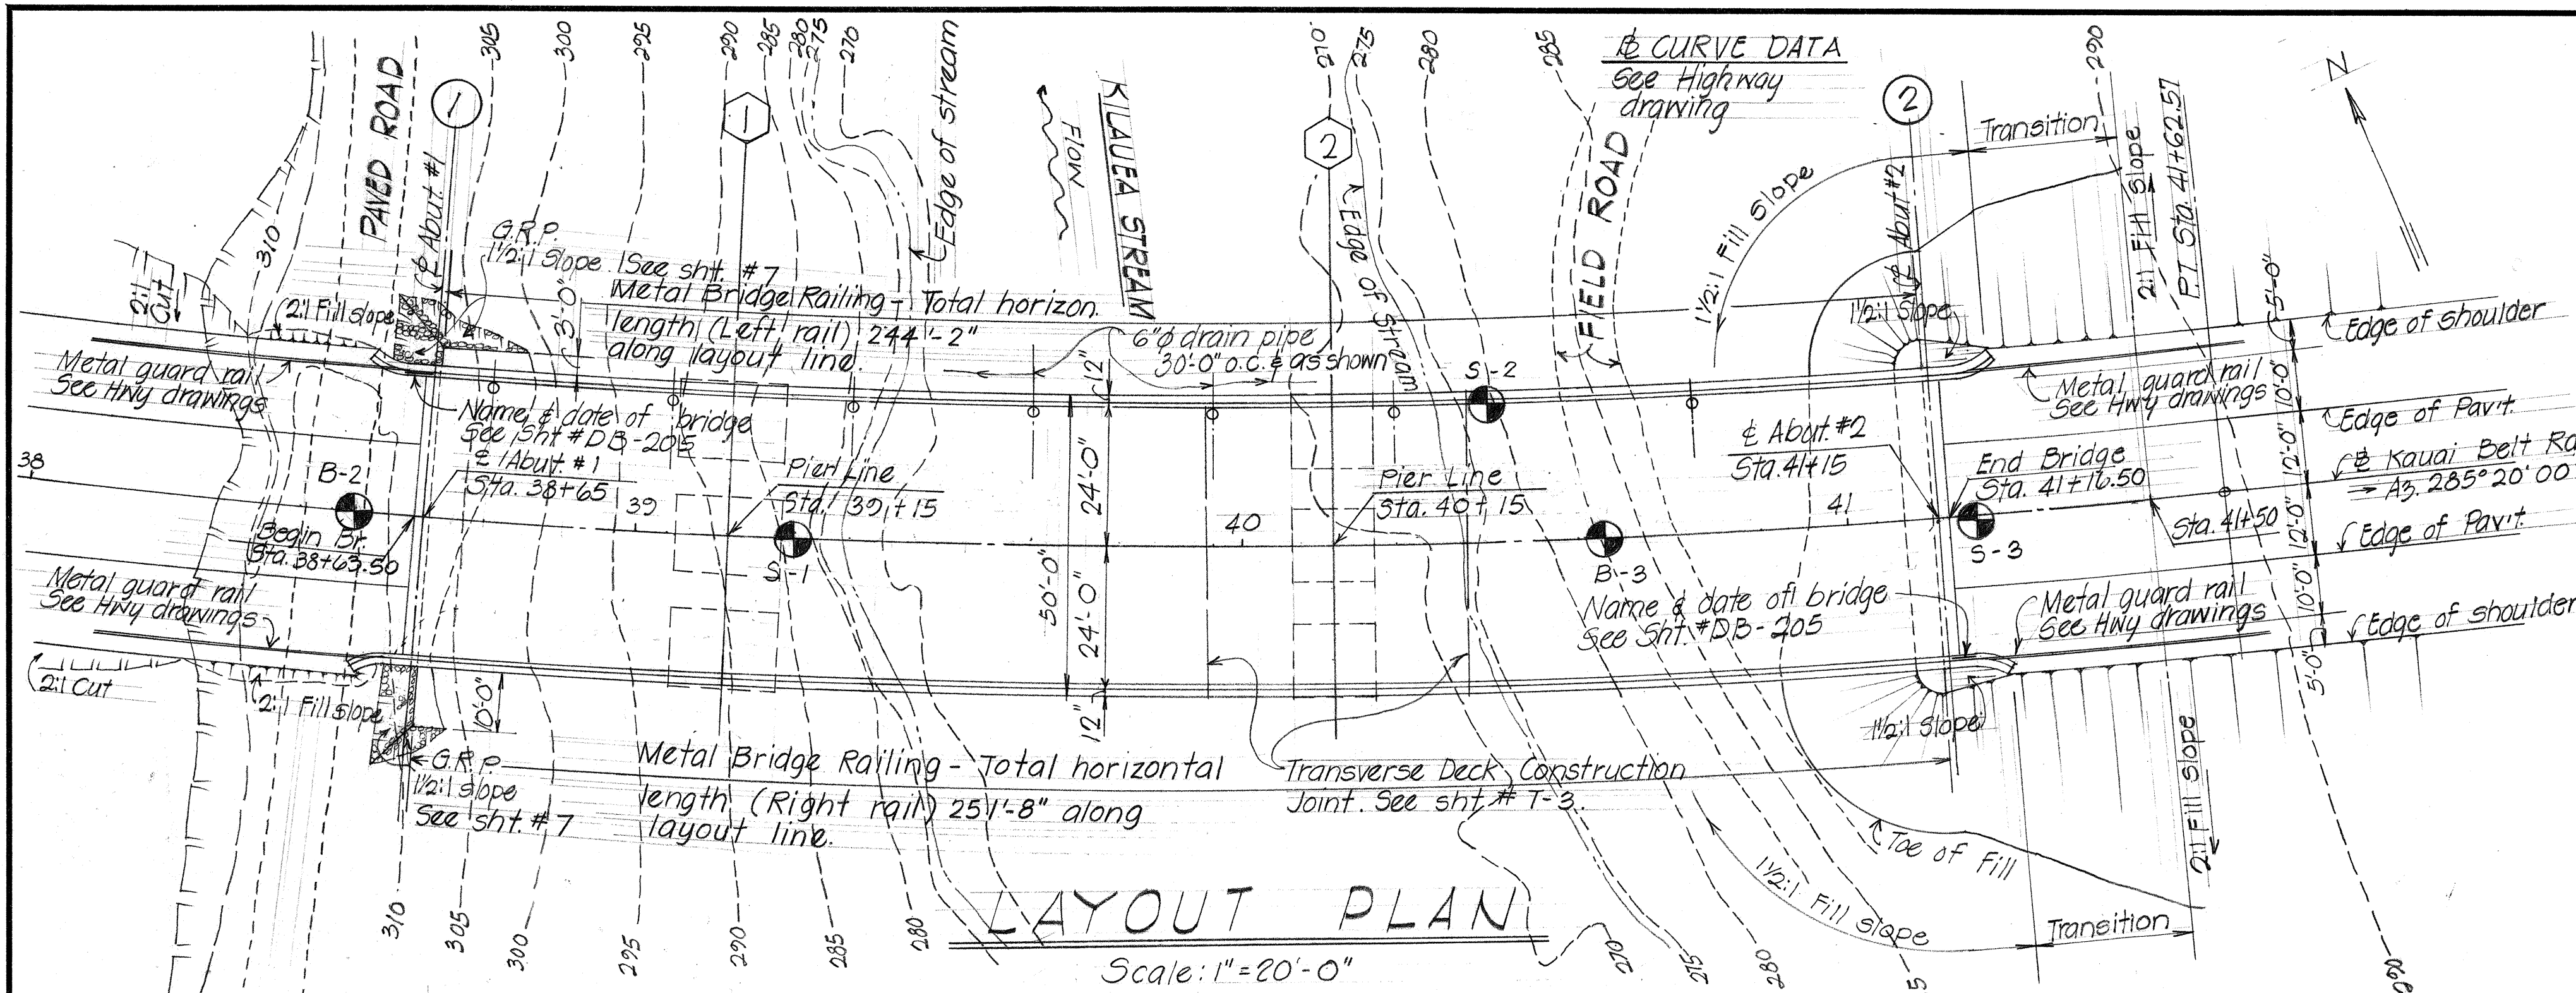


SLAB CAMBER DIAGRAM

No Scale

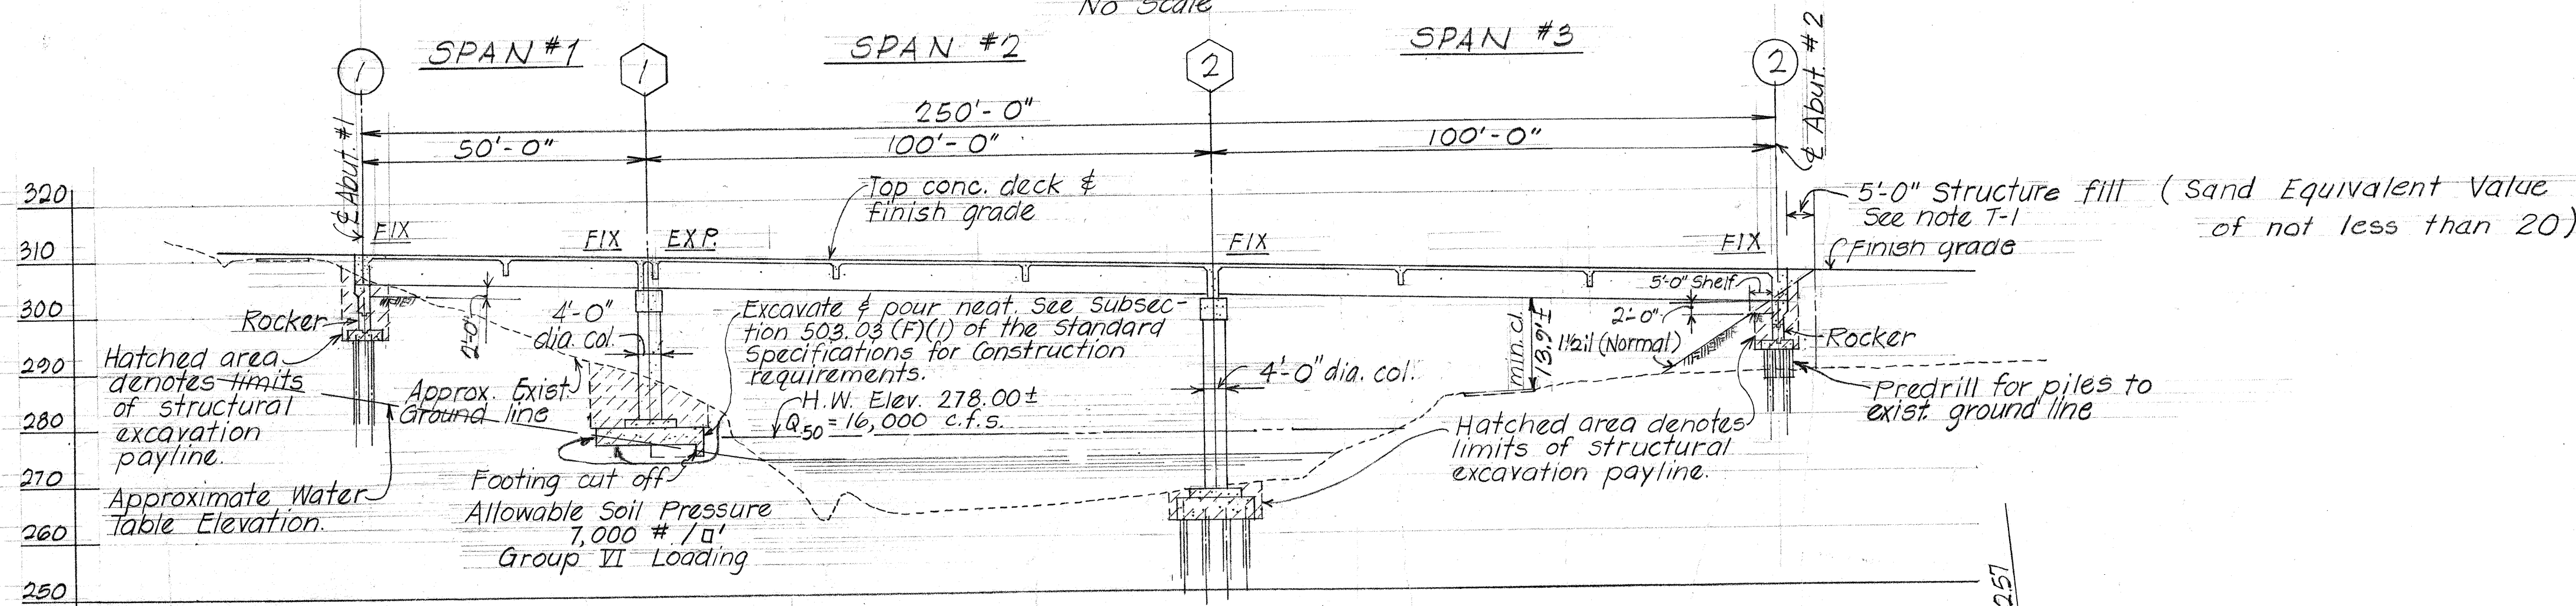


LONGITUDINAL SECTION ALONG ROADWAY

Scale: 1" = 20'-0"

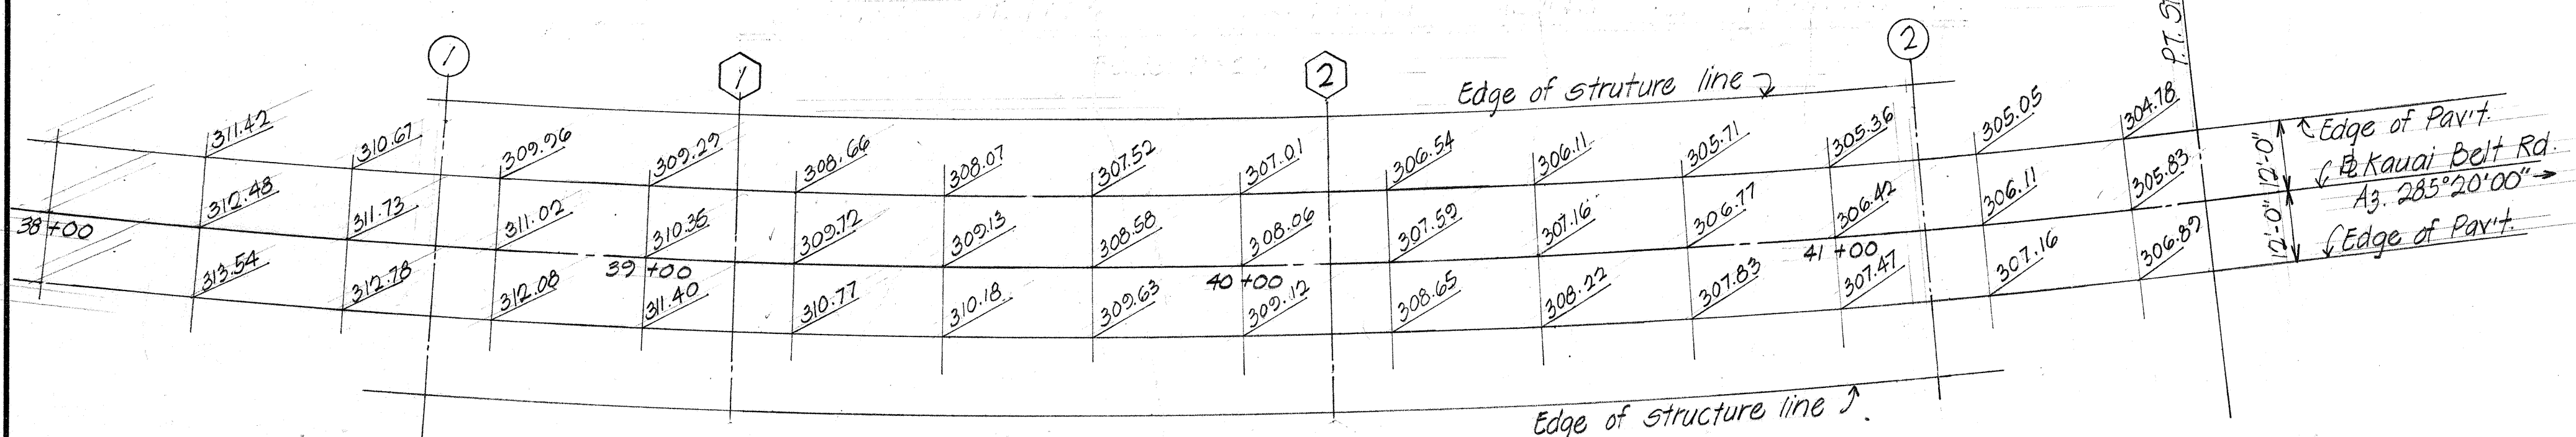

FINISH GRADE PLAN

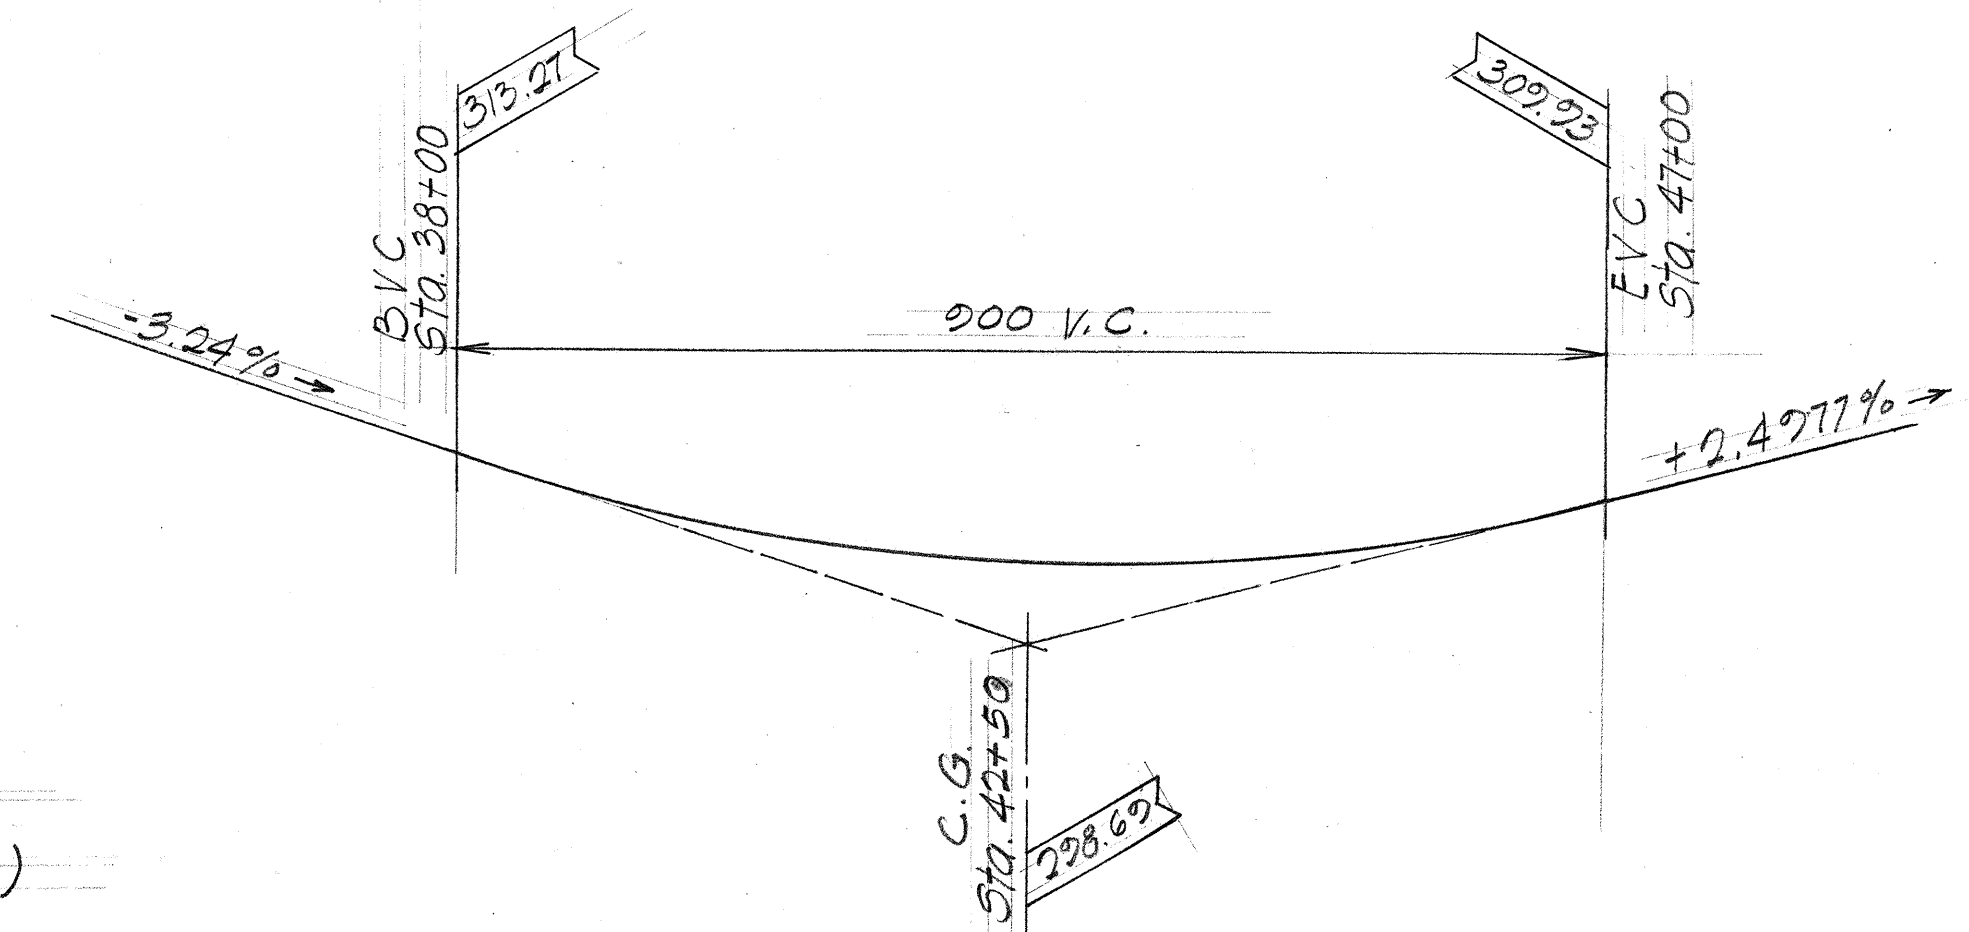

BASELINE PROFILE

No Scale

NOTES: For Design Notes, General Notes, Symbols and Abbreviations, refer to Sht. # T-1

STATE OF HAWAII
DEPARTMENT OF TRANSPORTATION
HIGHWAYS DIVISION

KILAUEA STREAM BRIDGE

STA. 38+63.50 TO STA. 41+16.50

LAYOUT PLAN & SECTION

Proj. No. RF-056-1(10) Apr. 1971

SHEET No. 1 OF 11 SHEETS

F-056-1(9)

FED. ROAD DIST. NO.	STATE	FED. AID PROJ. NO.	FISCAL YEAR	SHEET NO.	TOTAL SHEETS
HAWAII	HAW.	RF-056-1(10)	1971	38	74

NOTE:
Place short dimension of column footings & concrete pedestal parallel with corresponding pier line numbers ① or ②.


SYMBOLS:

- ① - Denotes type I prestressed concrete piles.
- ② - Denotes piles to be predrilled to existing ground line.

Pile bearing capacity - 70 Tons.

FOUNDATION PLAN

Scale: 1" = 10'-0"

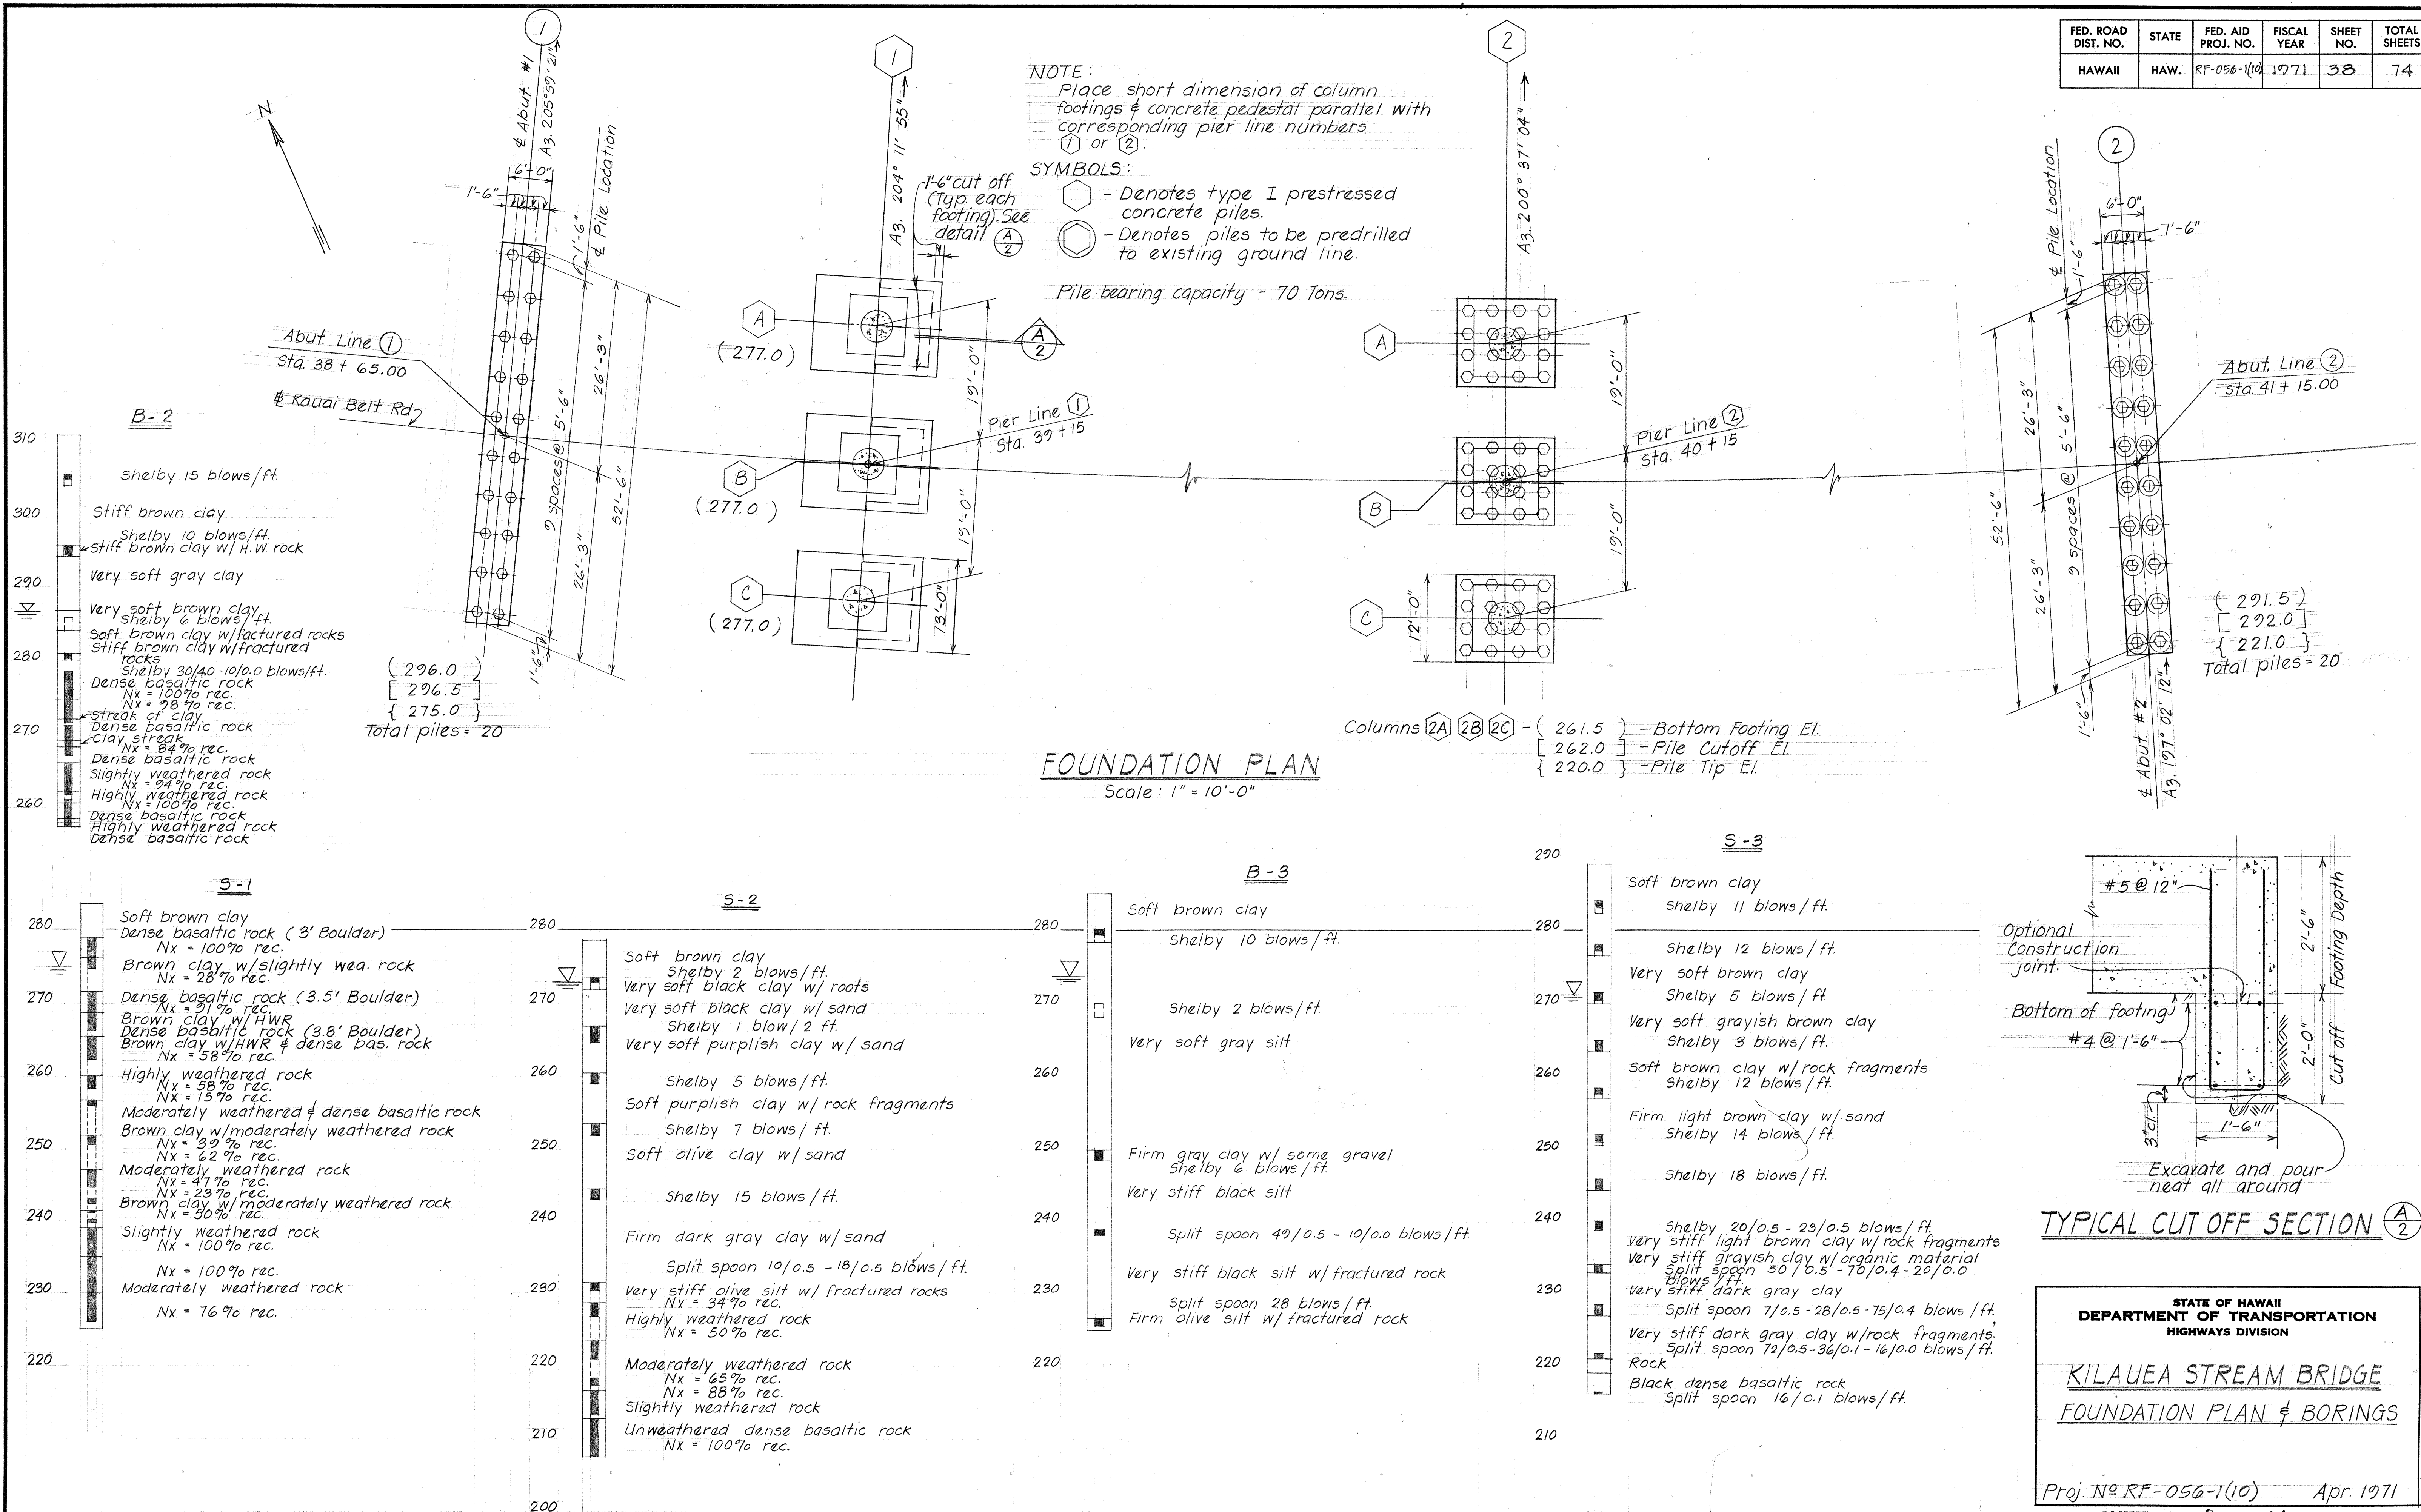

TYPICAL CUT OFF SECTION

STATE OF HAWAII
DEPARTMENT OF TRANSPORTATION
HIGHWAYS DIVISION

KILAUEA STREAM BRIDGE
FOUNDATION PLAN & BORINGS

Proj. No. RF-056-1(10) Apr. 1971

SHEET No. 2 OF 11 SHEETS

33

PILE FOOTING SCHEDULE						
MARK	DESCRIPTION	DEPTH	TOP REINFORCEMENT		BOTTOM REINFORCEMENT	
			LONG WAY	SHORT WAY	LONG WAY	SHORT WAY
PF1		4'-0"	9 - # 5	10 - # 4	17 - # 10	17 - # 10

FED. ROAD DIST. NO.	STATE	FED. AID PROJ. NO.	FISCAL YEAR	SHEET NO.	TOTAL SHEETS
HAWAII	HAW.	RF-056-1(10)	1971	40	74

<u>SPREAD FOOTING SCHEDULE</u>							
TYPE	SIZE	DEPTH	BOTTOM REINF.		TOP REINF.		
			LONGWAY	SHORTWAY	LONGWAY	SHORTWAY	
FI	13'-0" x 17'-6"	2'-6"	33-#10	25-#10	15-#6	13-#4	

Schedulred bars longway. Place bars in upper or lower most layer of footing reinforcement.

Schedulred bars shortway

Long Dimension of Footing

Short Dimension of Footing

PLAN-TYPICAL ARRANGEMENT
FOOTING REINFORCEMENT

ORIGINAL PLAN	SURVEY PLOTTED BY _____	DATE _____
	DRAWN BY <u>L.A.</u>	"
	TRACED BY _____	"
NOTE BOOK	DESIGNED BY <u>D.O.</u>	"
	QUANTITIES BY <u>G.T.M.</u>	"
No. _____	CHECKED BY <u>P.Y. & J.O.</u>	"

STATE OF HAWAII
DEPARTMENT OF TRANSPORTATION
HIGHWAYS DIVISION


KILAUEA STREAM BRIDGE

SCHEDULES & DETAILS


Proj. N^o RF-056-1(10) Apr. 1971

SHEET No. 4 OF 11 SHEETS


FED. ROAD DIST. NO.	STATE	FED. AID PROJ. NO.	FISCAL YEAR	SHEET NO.	TOTAL SHEETS
HAWAII	HAW.	RF-056-1(10)	1971	41	74

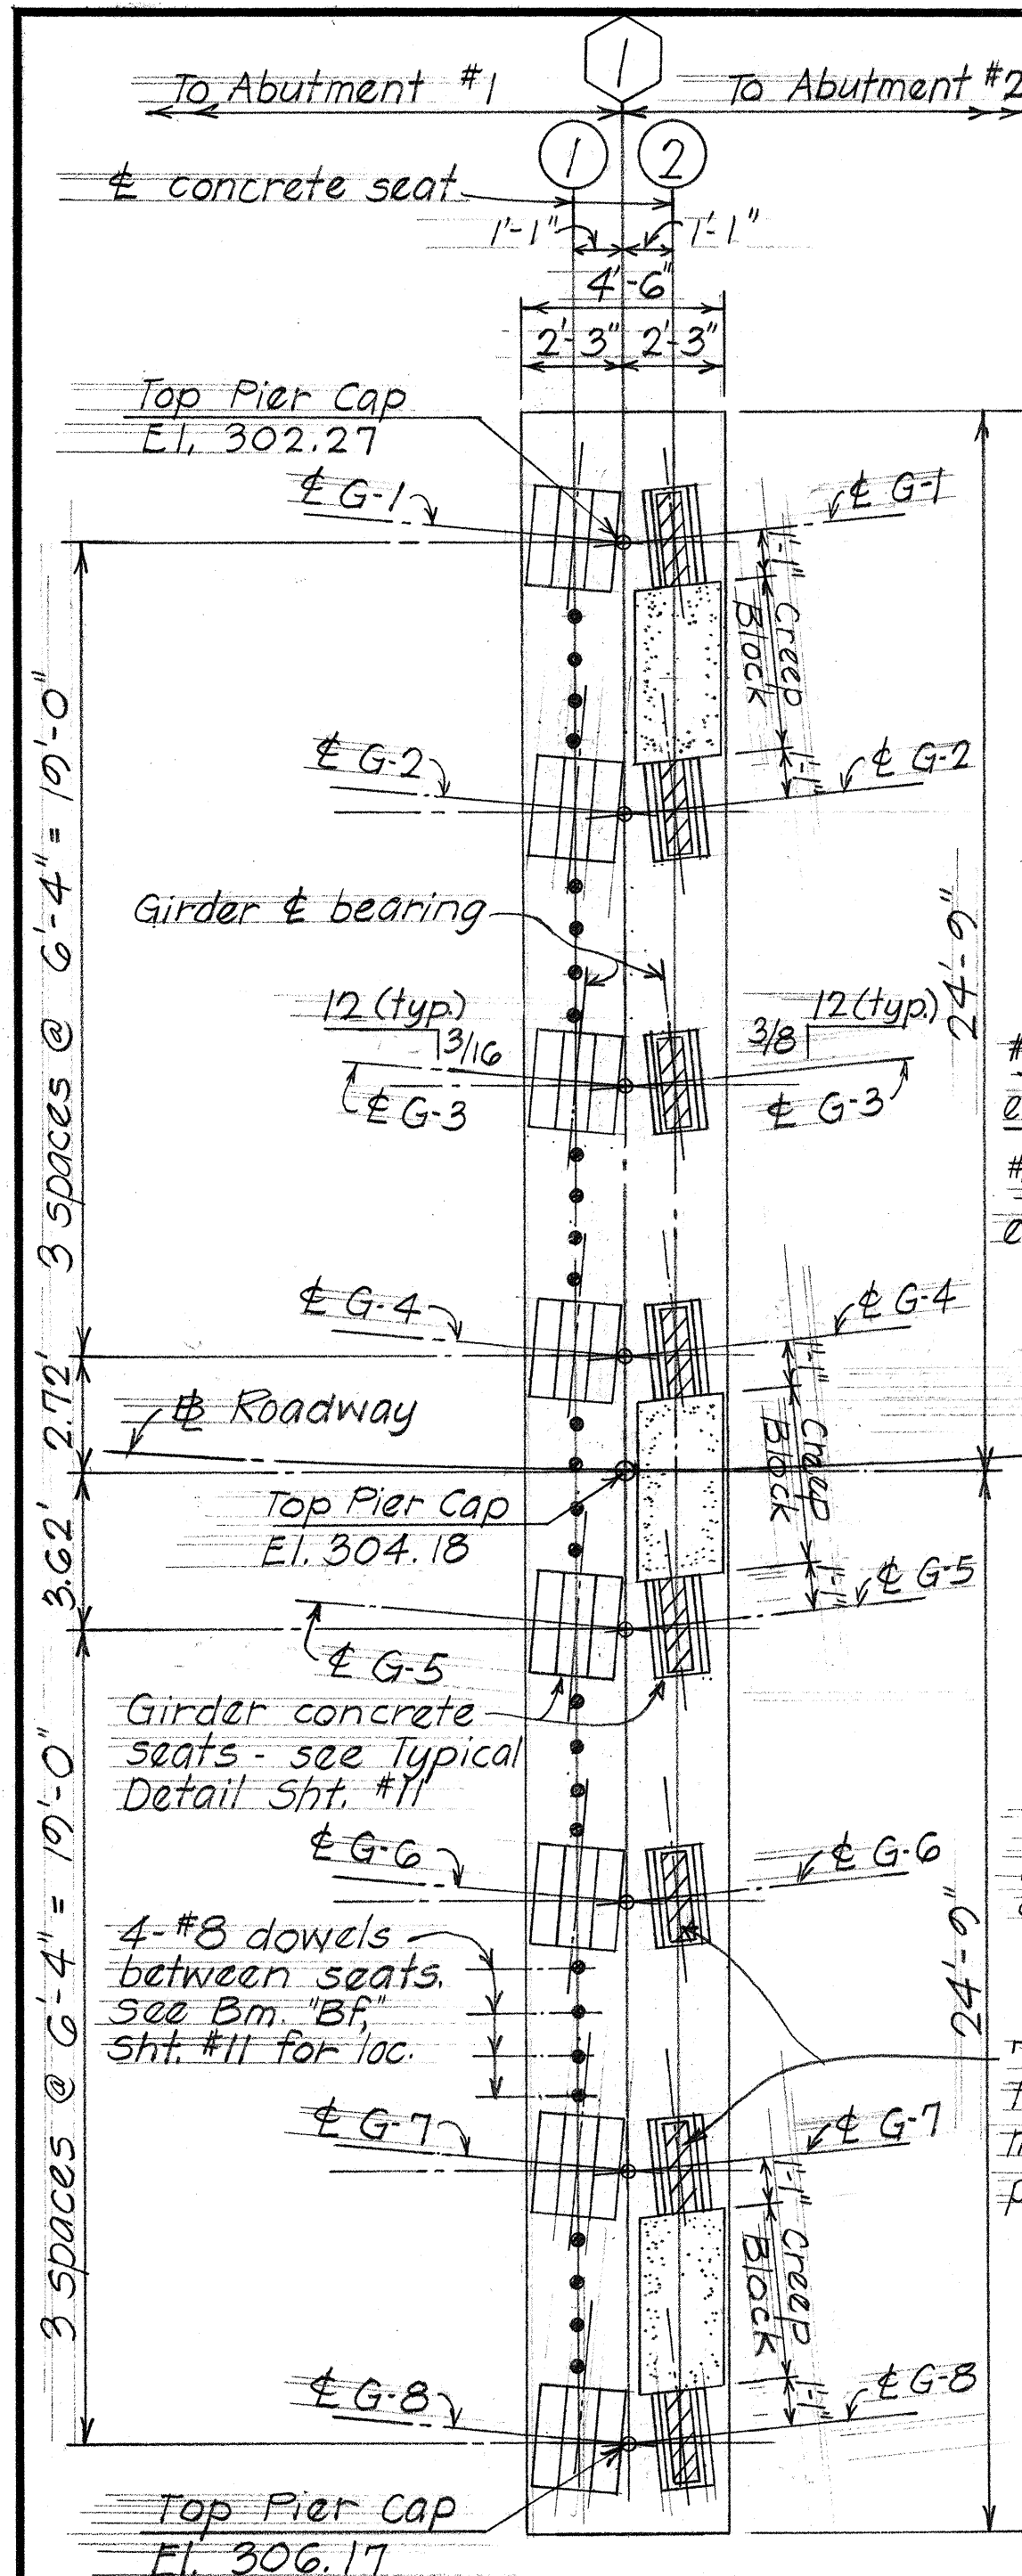


PLAN - PIER LINE 1
Scale: 1/4" = 1'-0"

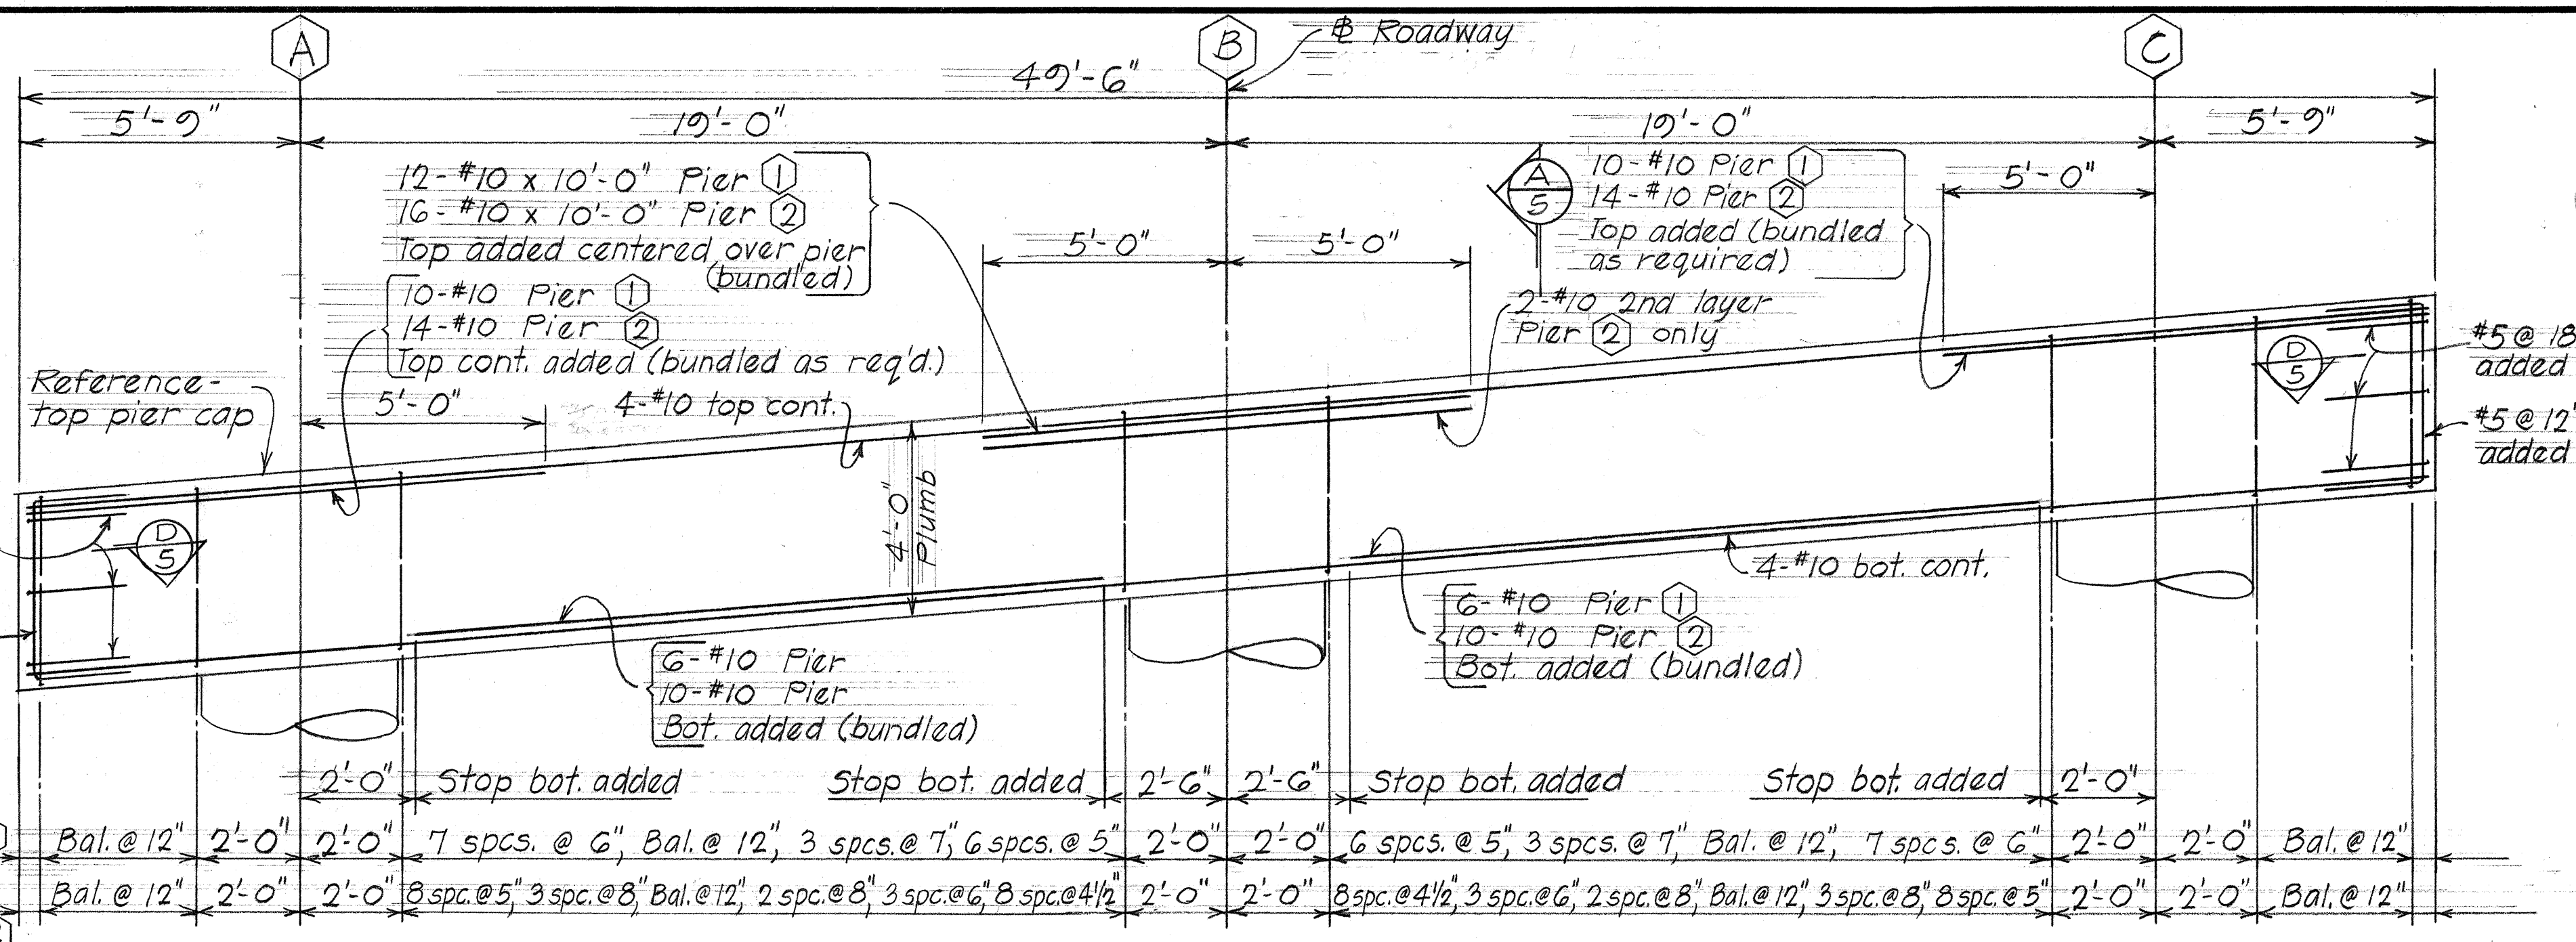


ELEVATION - TYPICAL PIER CAP LINE 1 OR 2 REINFORCEMENT DETAILS
Scale: 3/8" = 1'-0"

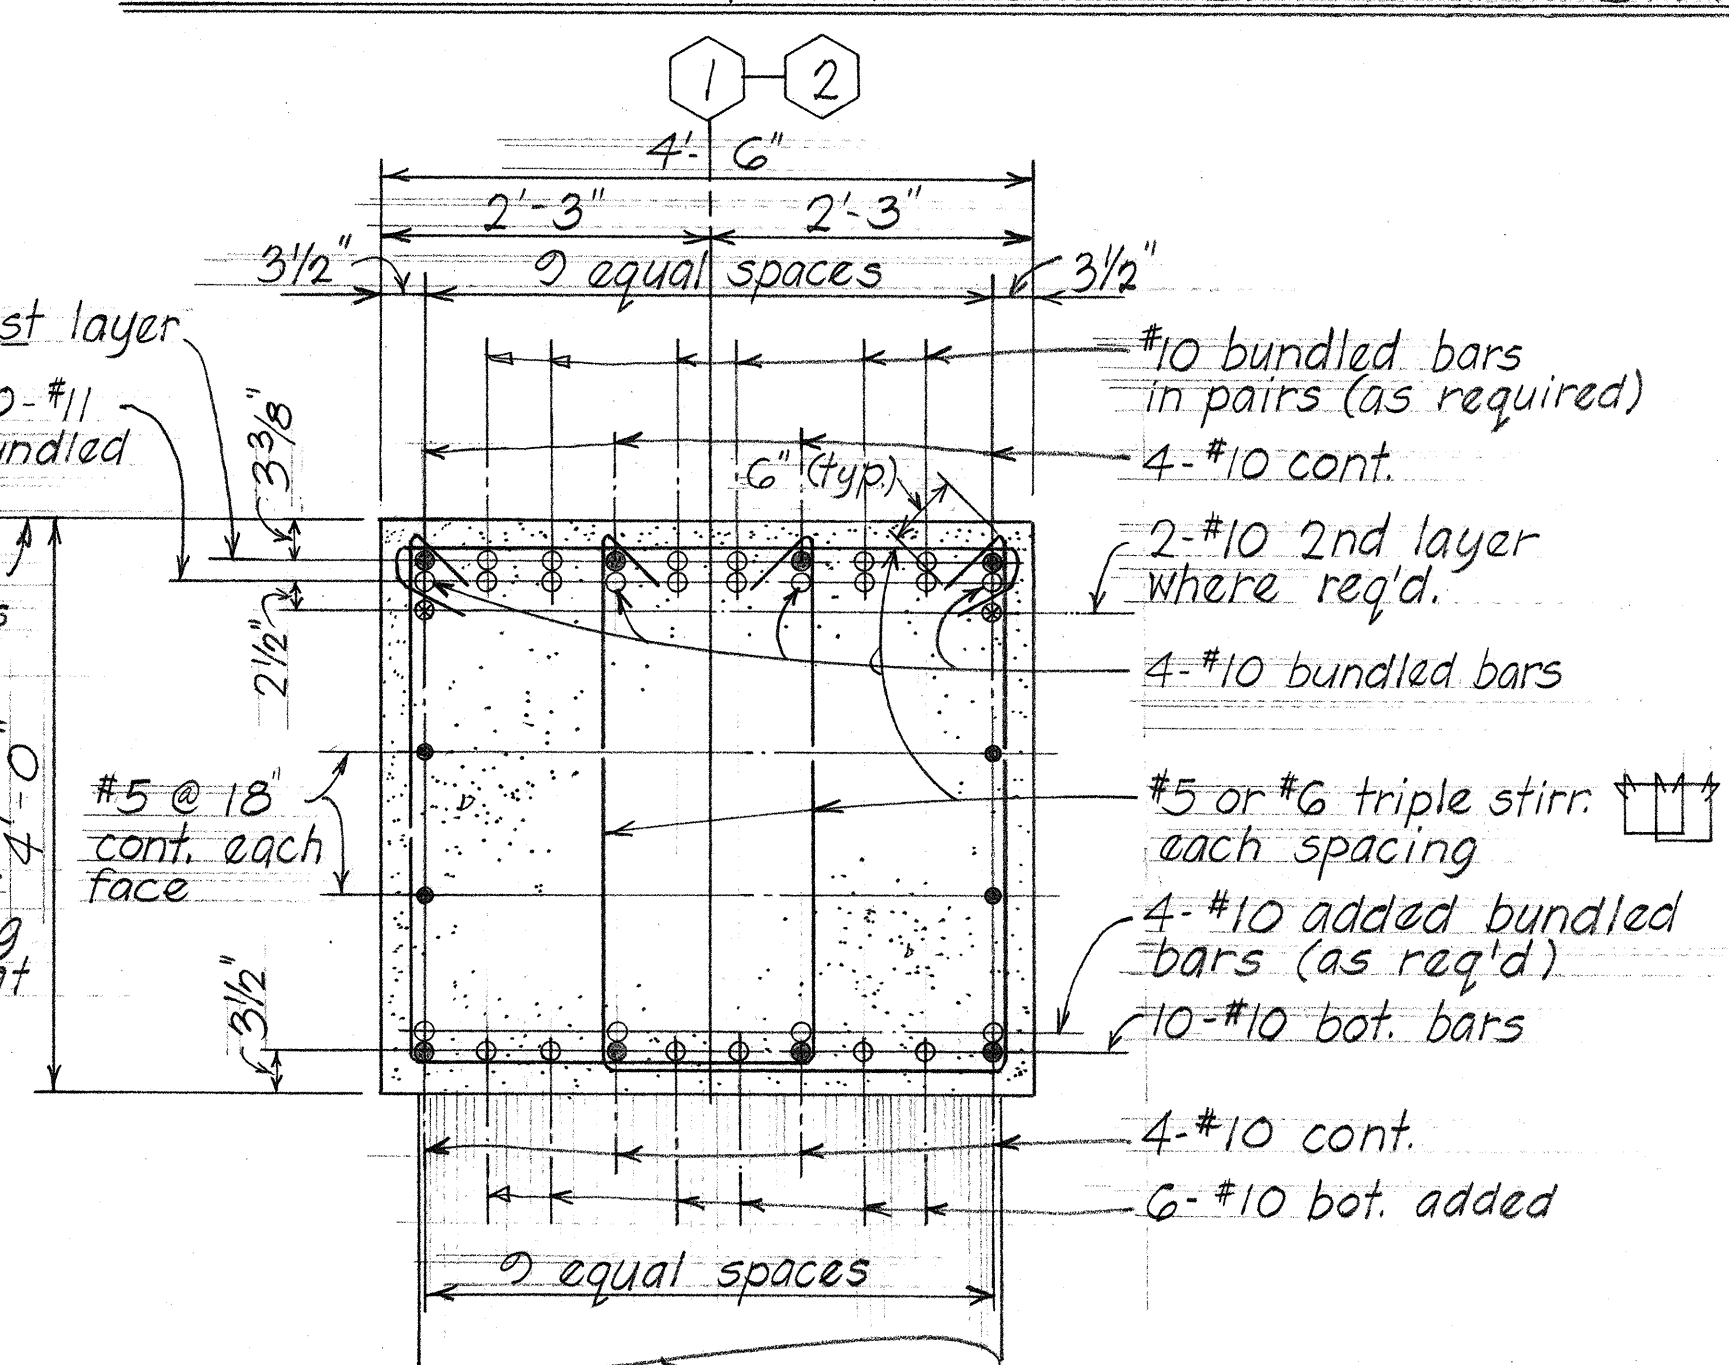


TYPICAL SECTION A
Scale: 3/4" = 1'-0"

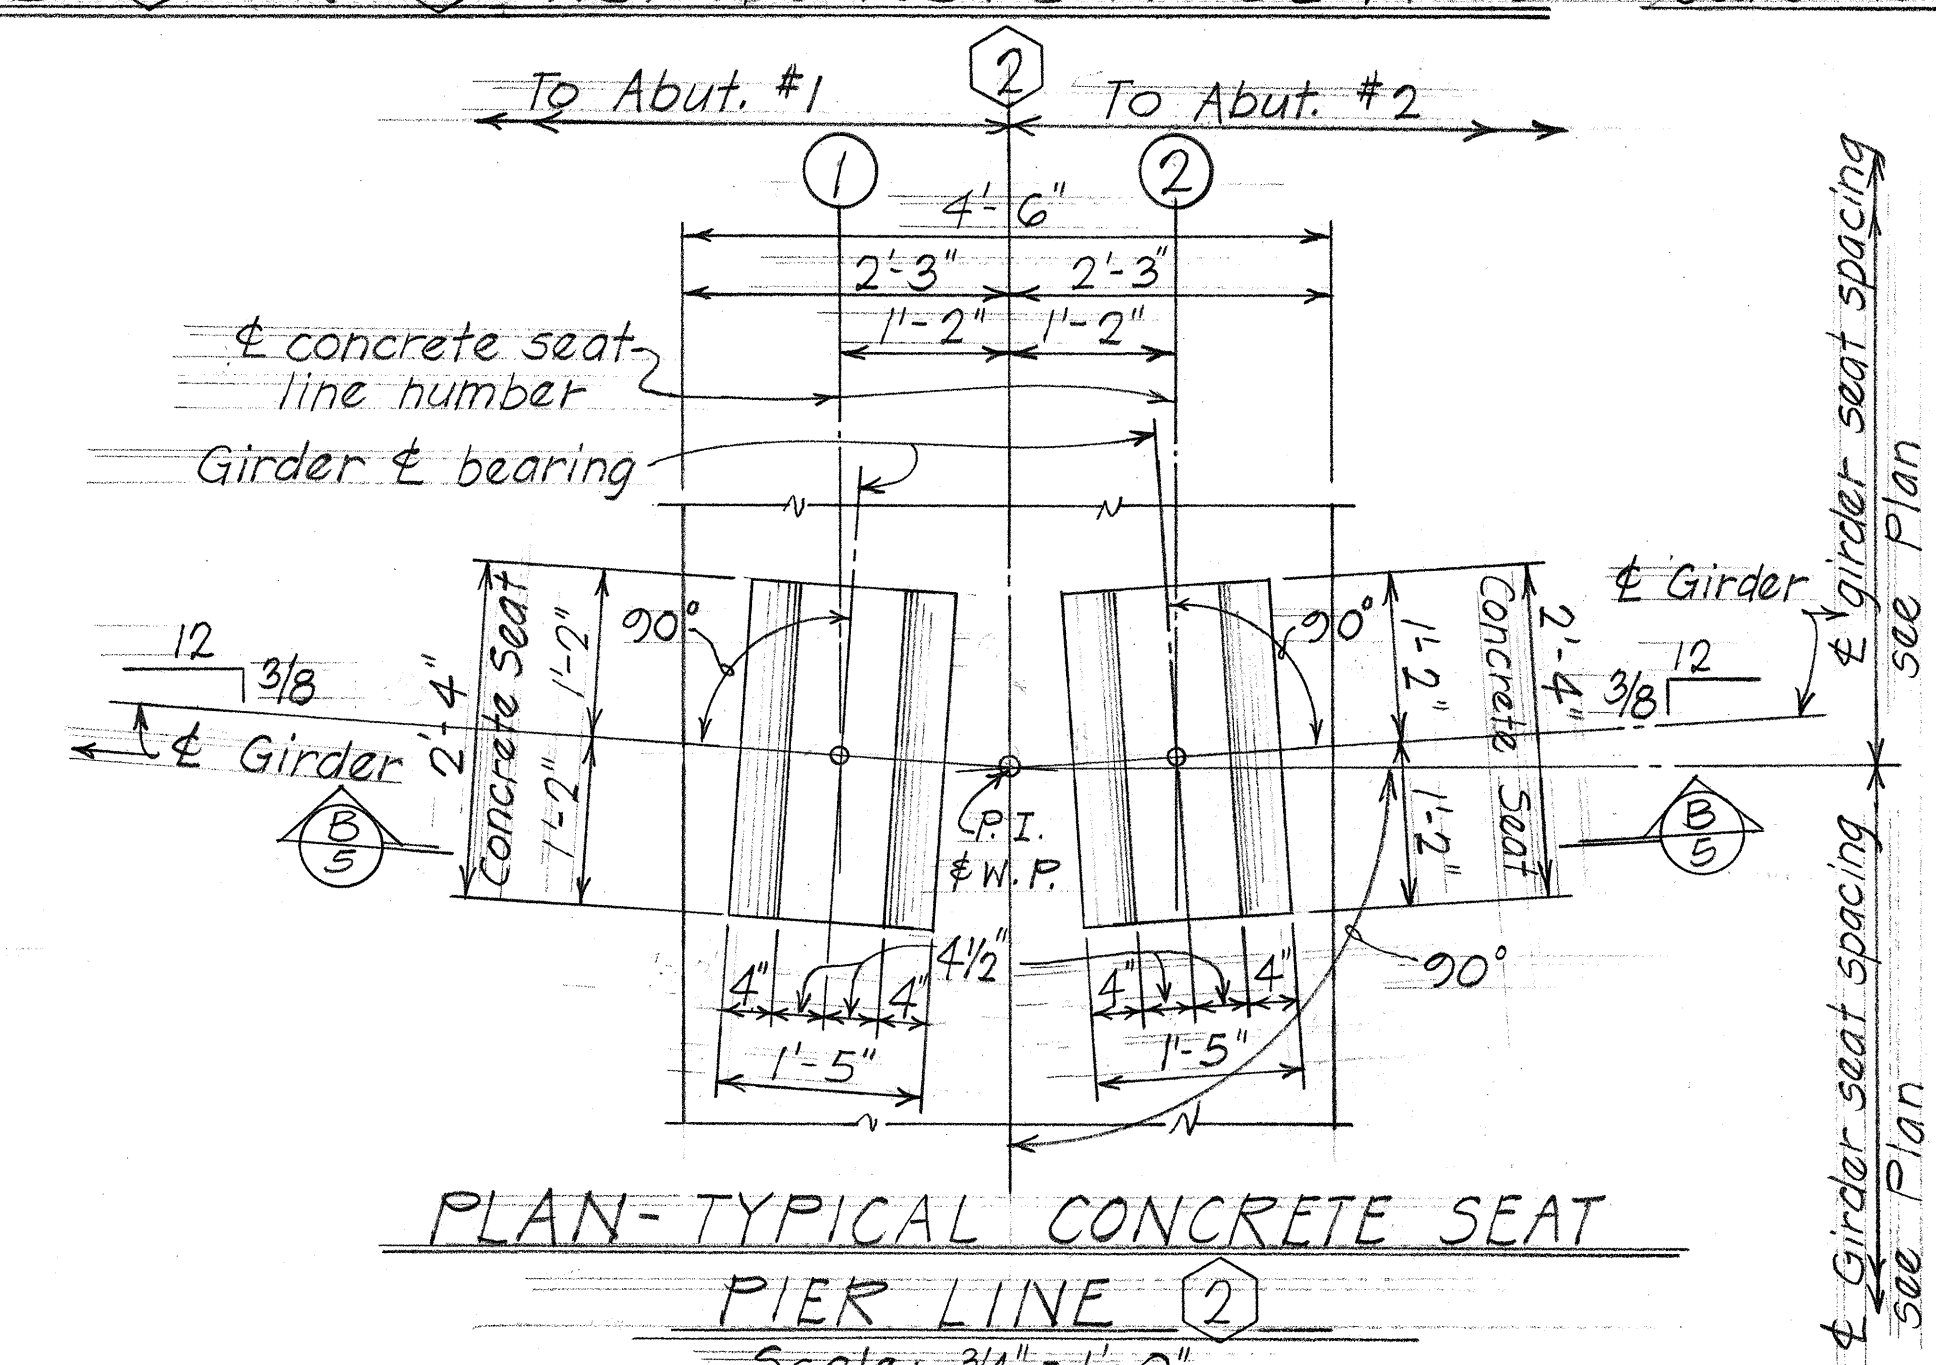


PLAN - TYPICAL CONCRETE SEAT PIER LINE 2
Scale: 3/4" = 1'-0"

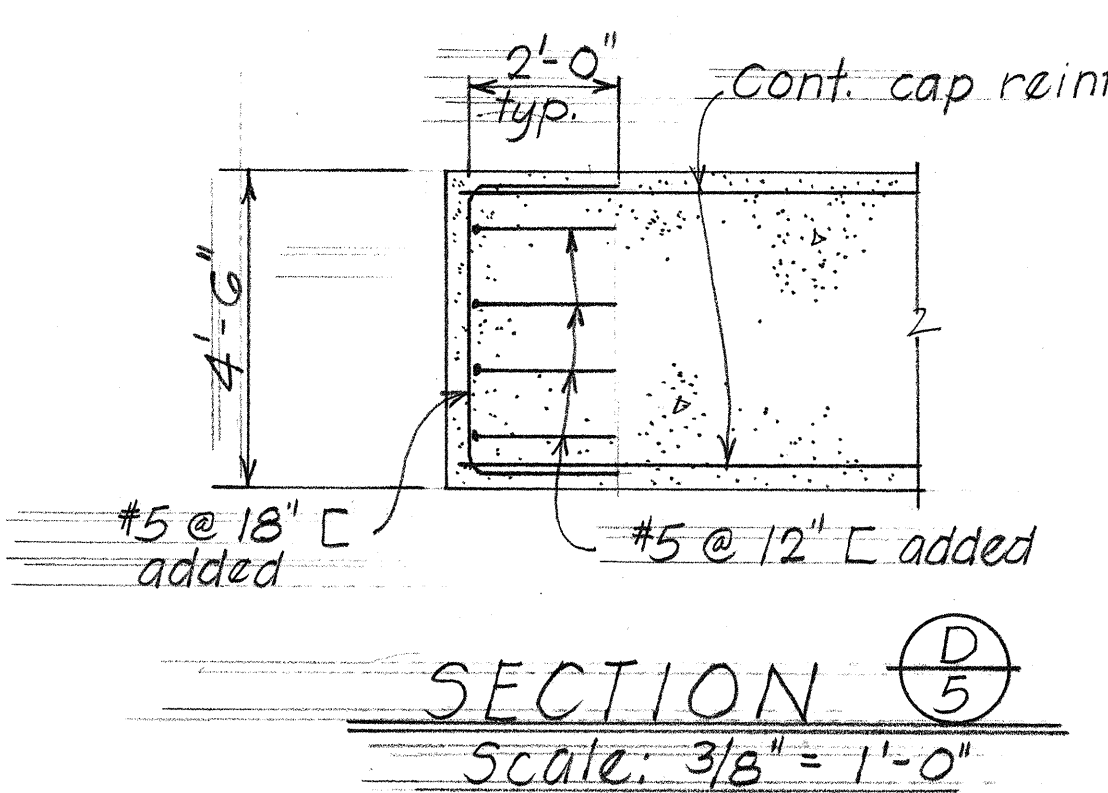


SECTION D
Scale: 3/8" = 1'-0"

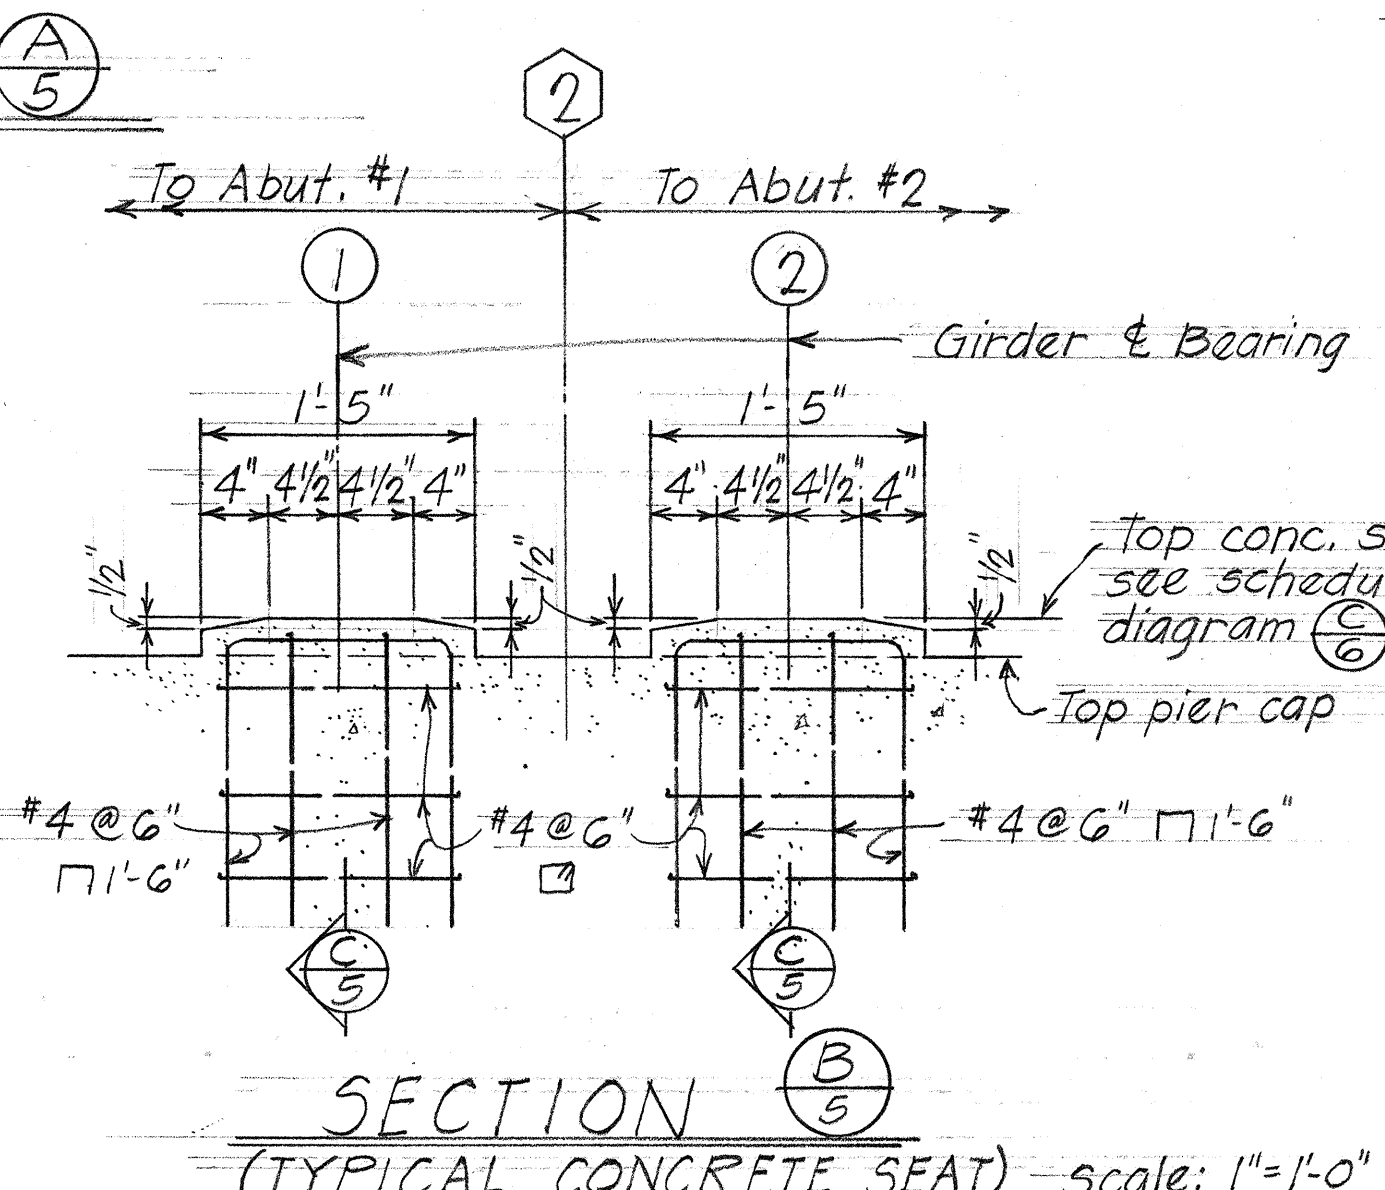

SECTION B
(TYPICAL CONCRETE SEAT) Scale: 1" = 1'-0"

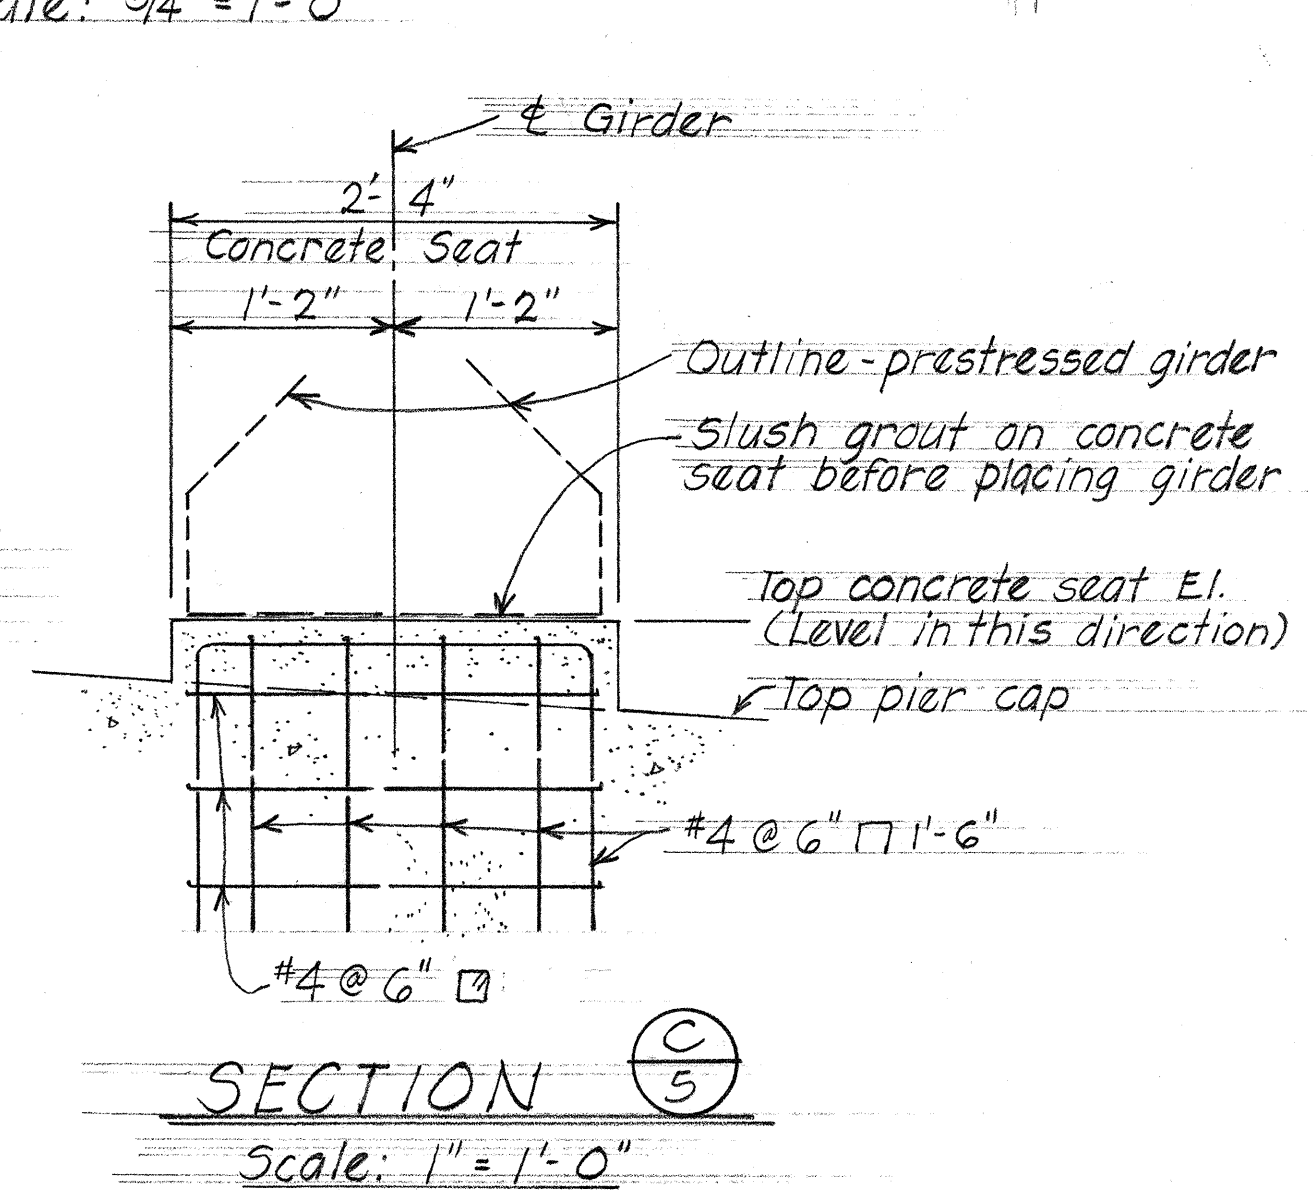

SECTION C
Scale: 1" = 1'-0"

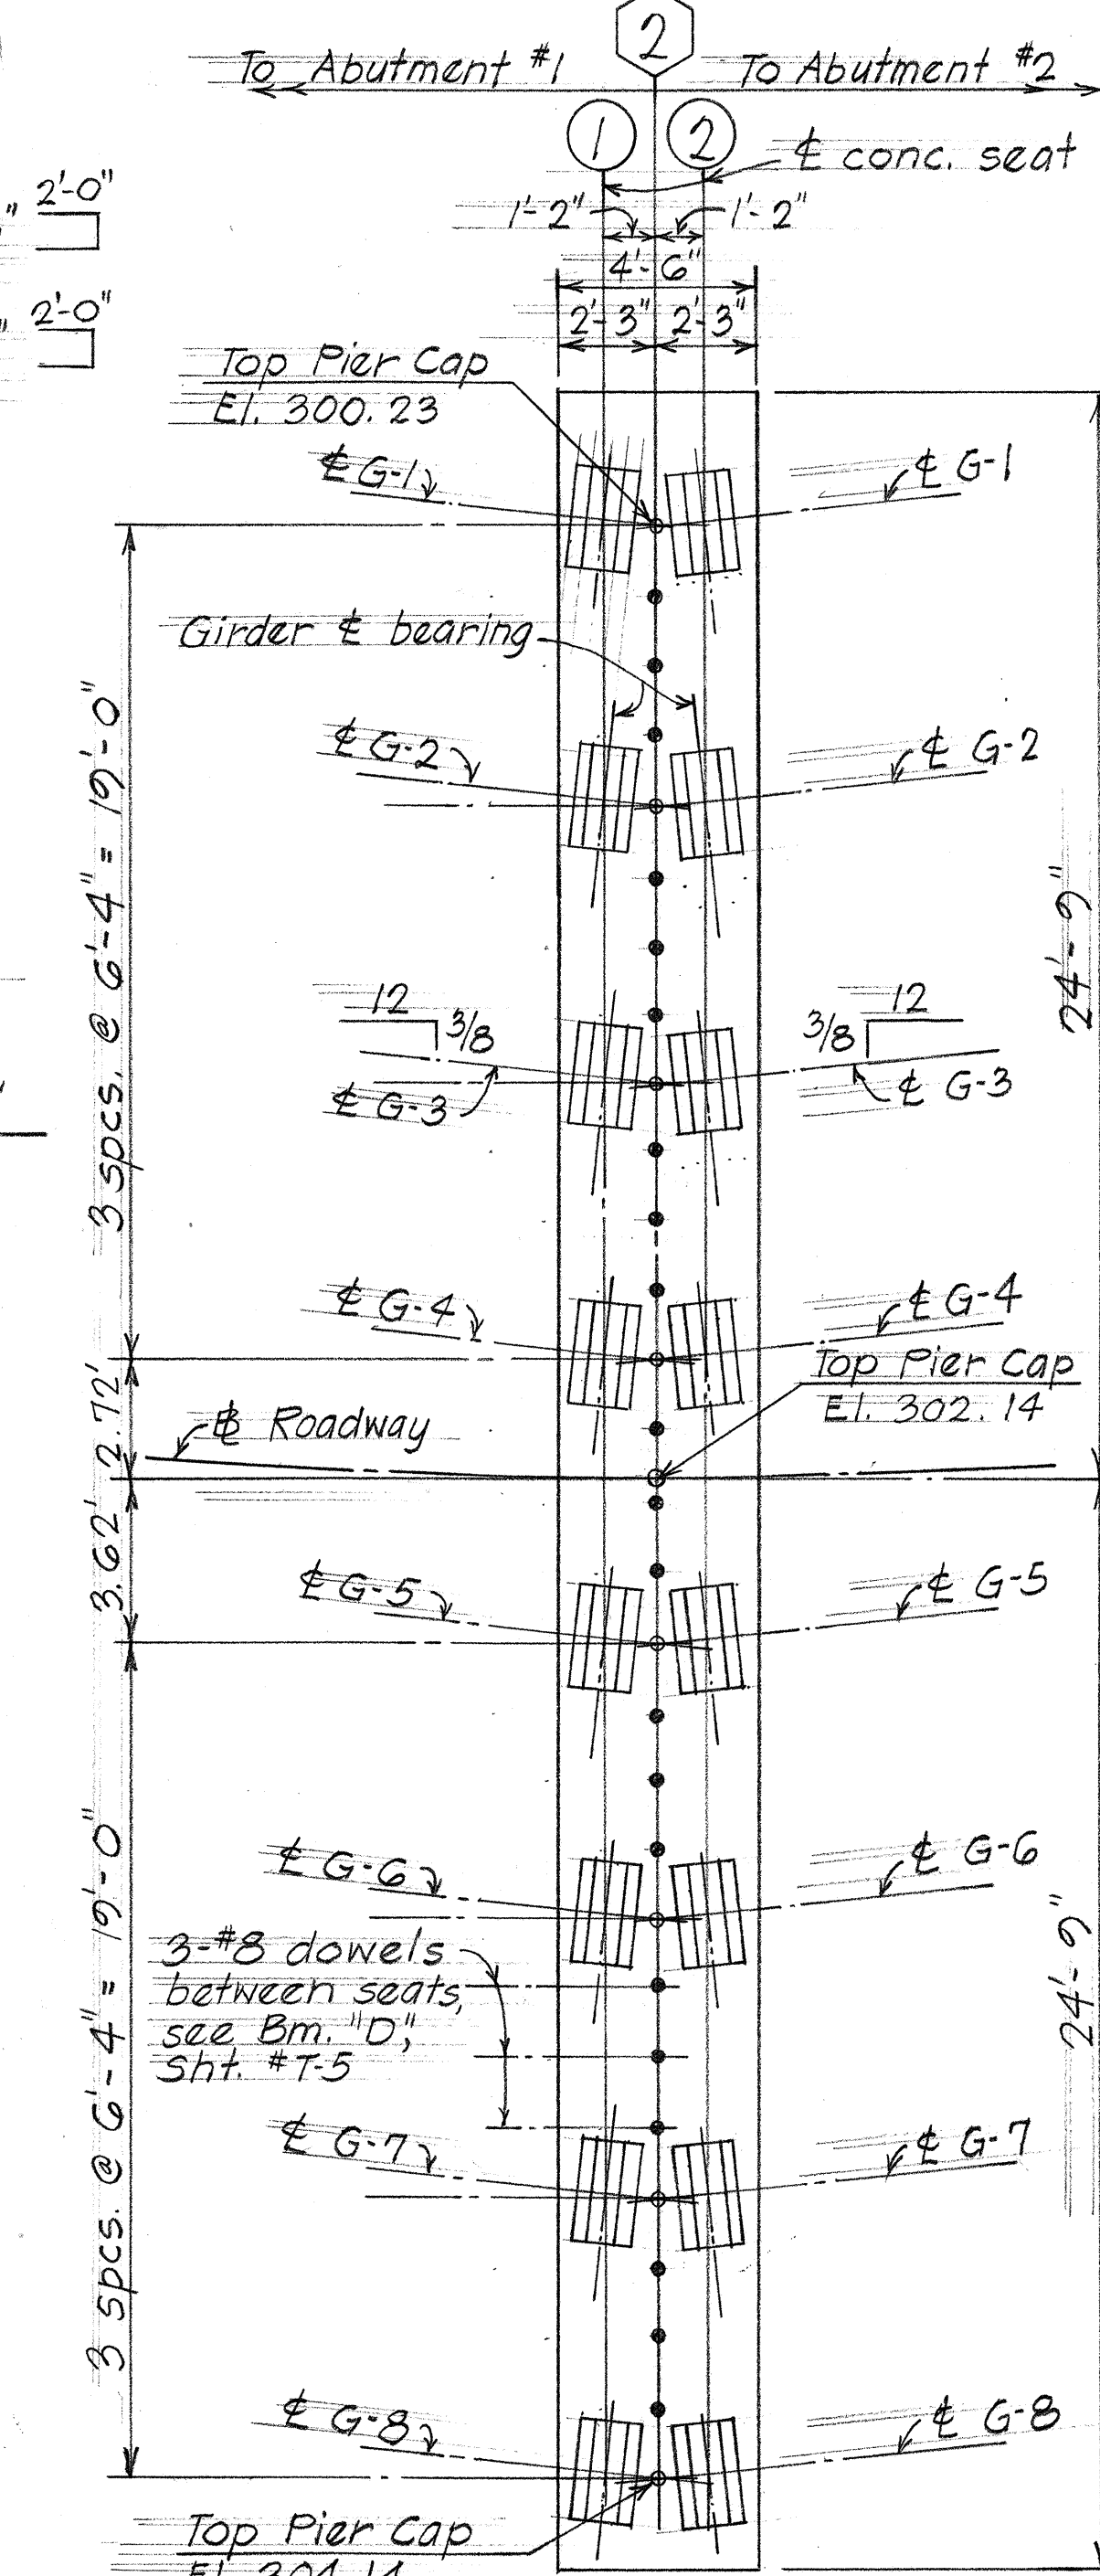

PLAN - PIER LINE 2
Scale: 1/4" = 1'-0"


STATE OF HAWAII
DEPARTMENT OF TRANSPORTATION
HIGHWAYS DIVISION

KILAUEA STREAM BRIDGE
PIER CAP 1, 2 DETAILS


Proj. N^o RF-056-1(10) Apr. 1971
SHEET No. 5 OF 11 SHEETS

DATE	BY
DESIGNED BY	DR.
CHECKED BY	CH.
NOTED BY	NT.
ORIGINAL PLAN	NO.


FED. ROAD DIST. NO.	STATE	FED. AID PROJ. NO.	FISCAL YEAR	SHEET NO.	TOTAL SHEETS
HAWAII	HAW.	RF-056-1(10)	1971	42	74

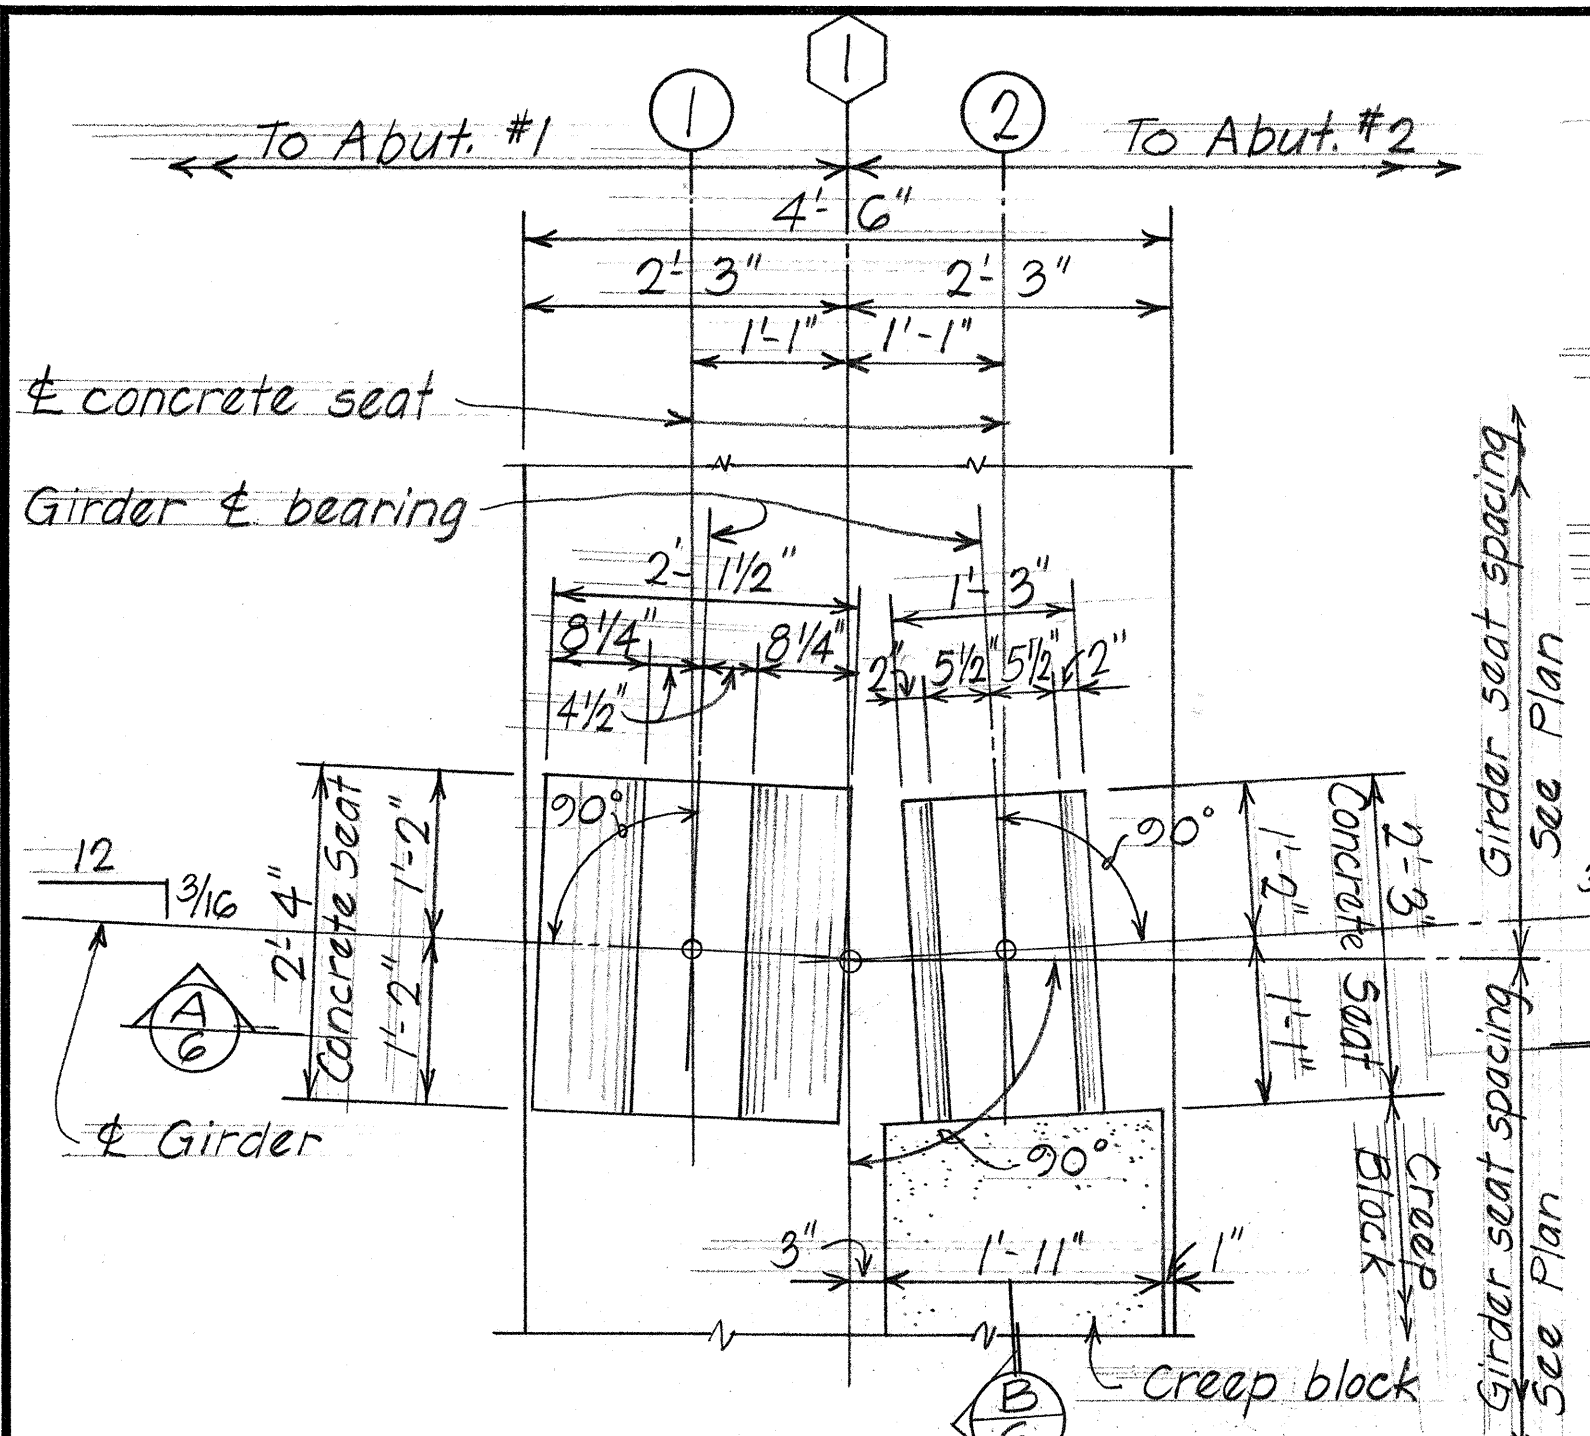


PLAN-TYPICAL CONCRETE SEAT
PIER LINE ①
Scale: 3/4" = 1'-0"

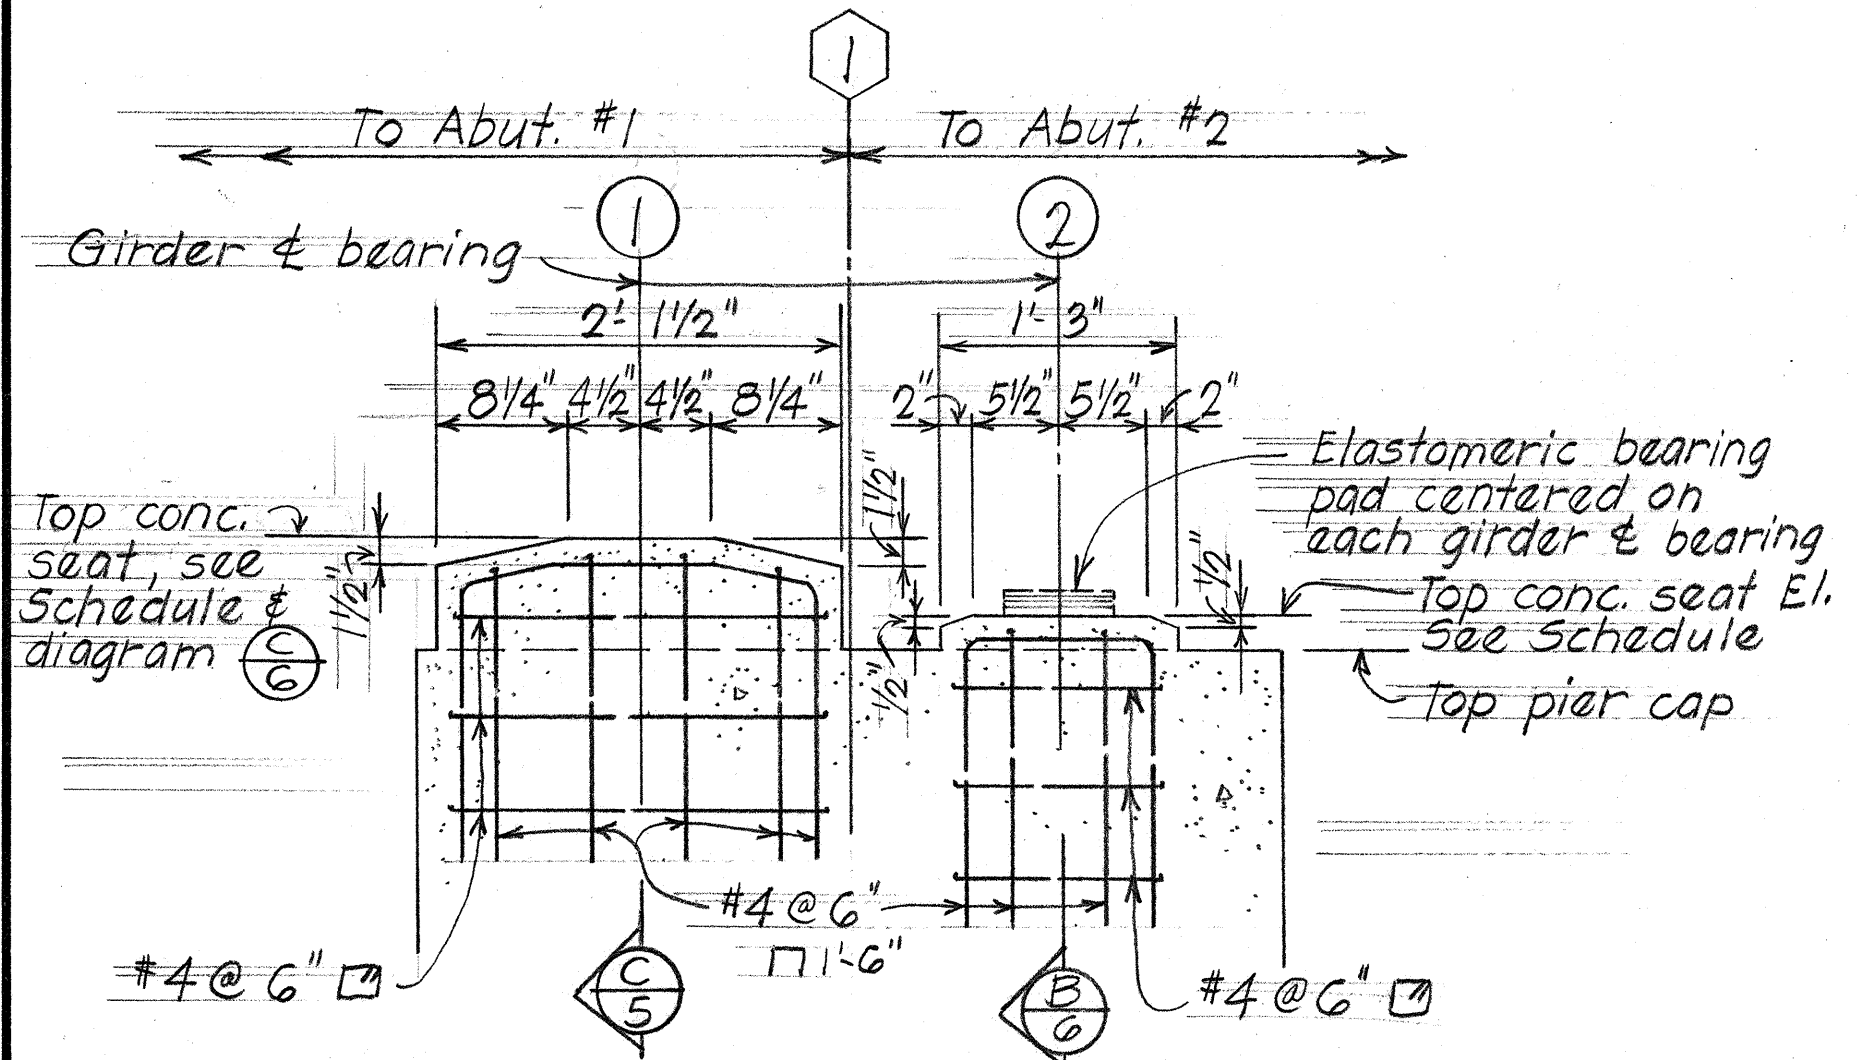


SECTION A-C
Scale: 1" = 1'-0"

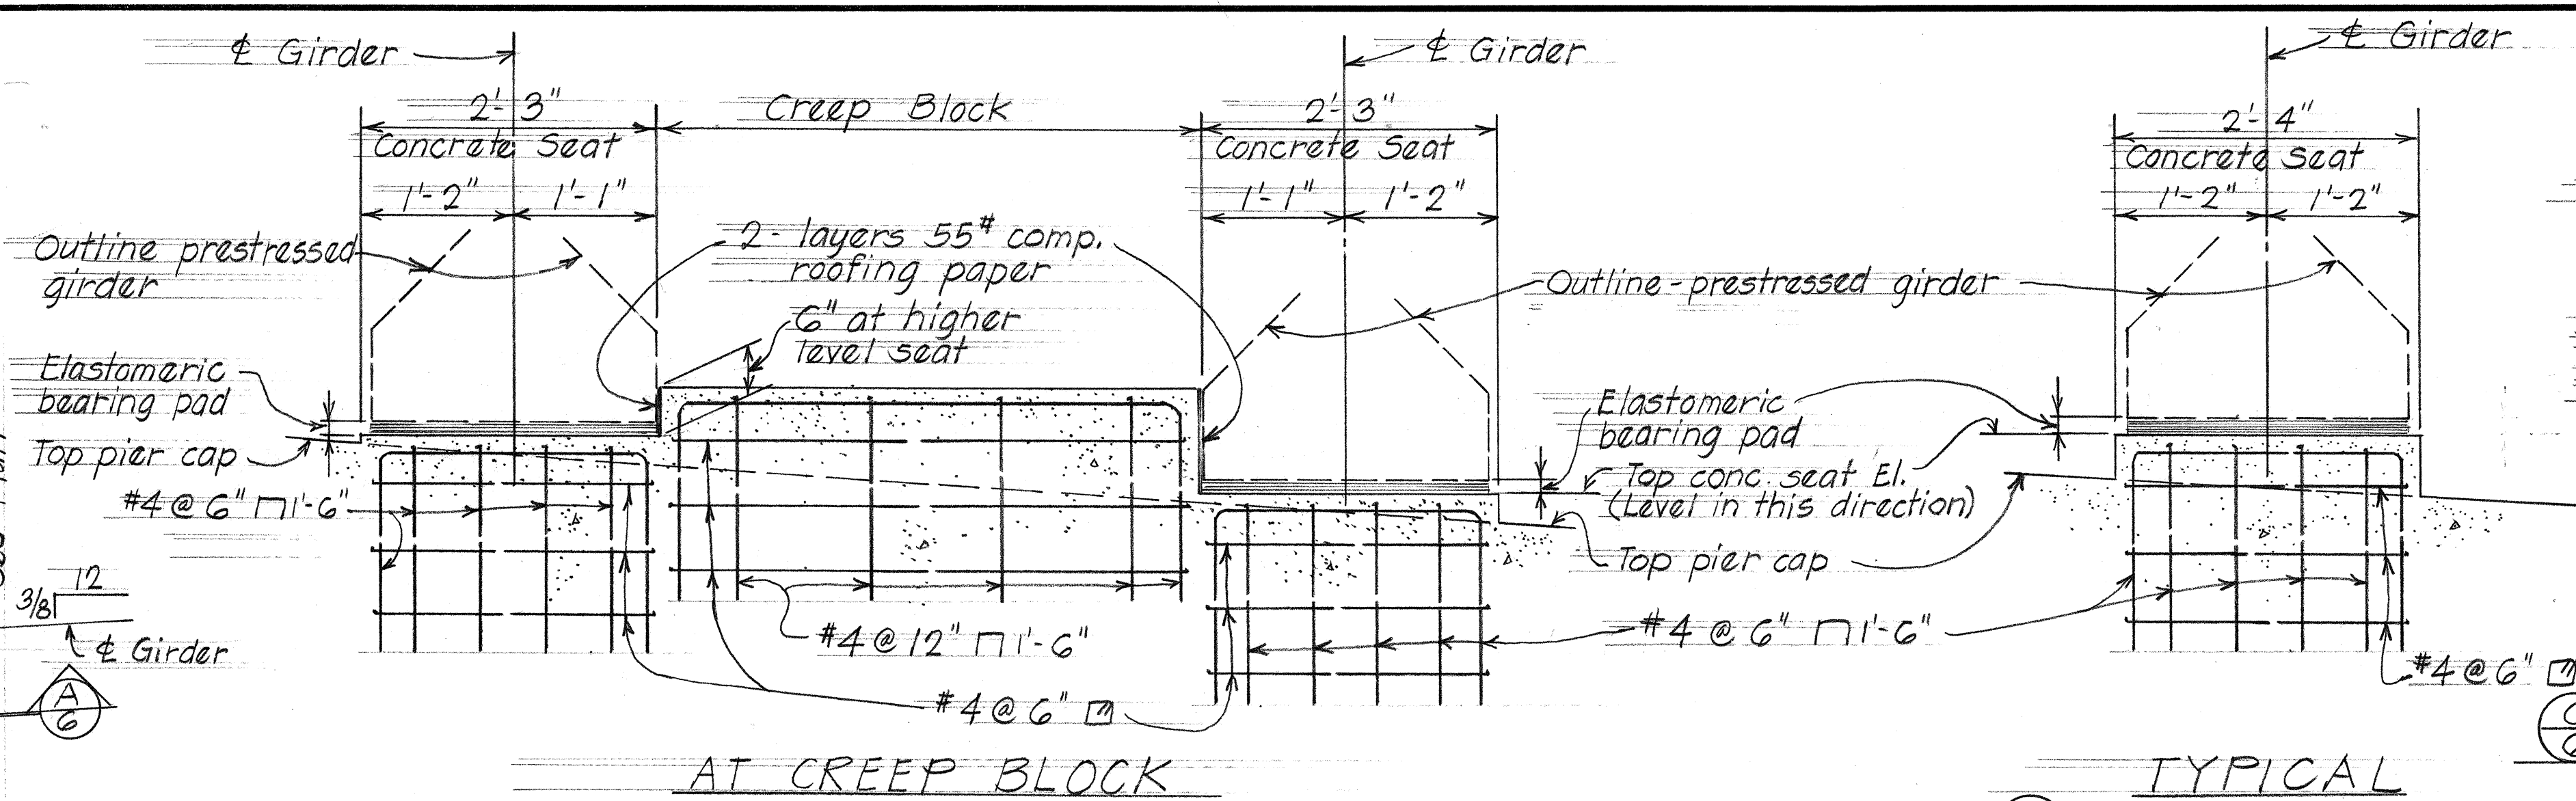

TYPICAL SECTION B-C
Scale: 1" = 1'-0"

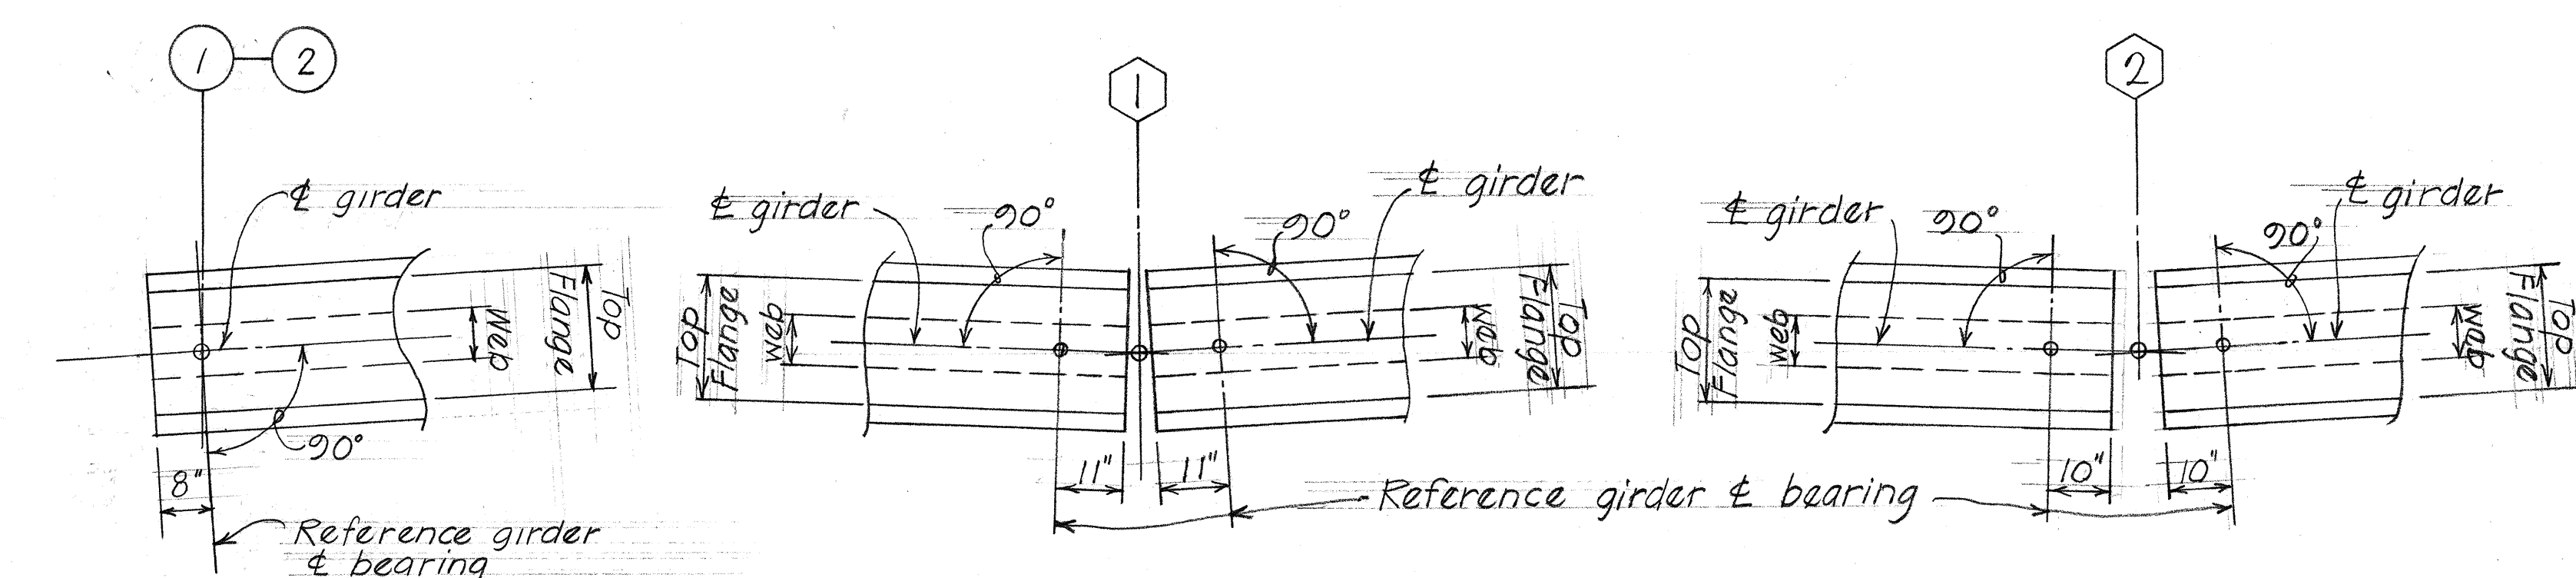

AT ABUTMENT #1 & #2 AT PIER LINE ① AT PIER LINE ②
DIAGRAM-TYPICAL GIRDER END DETAIL AT VARIOUS LOCATIONS
Scale: 1/2" = 1'-0"

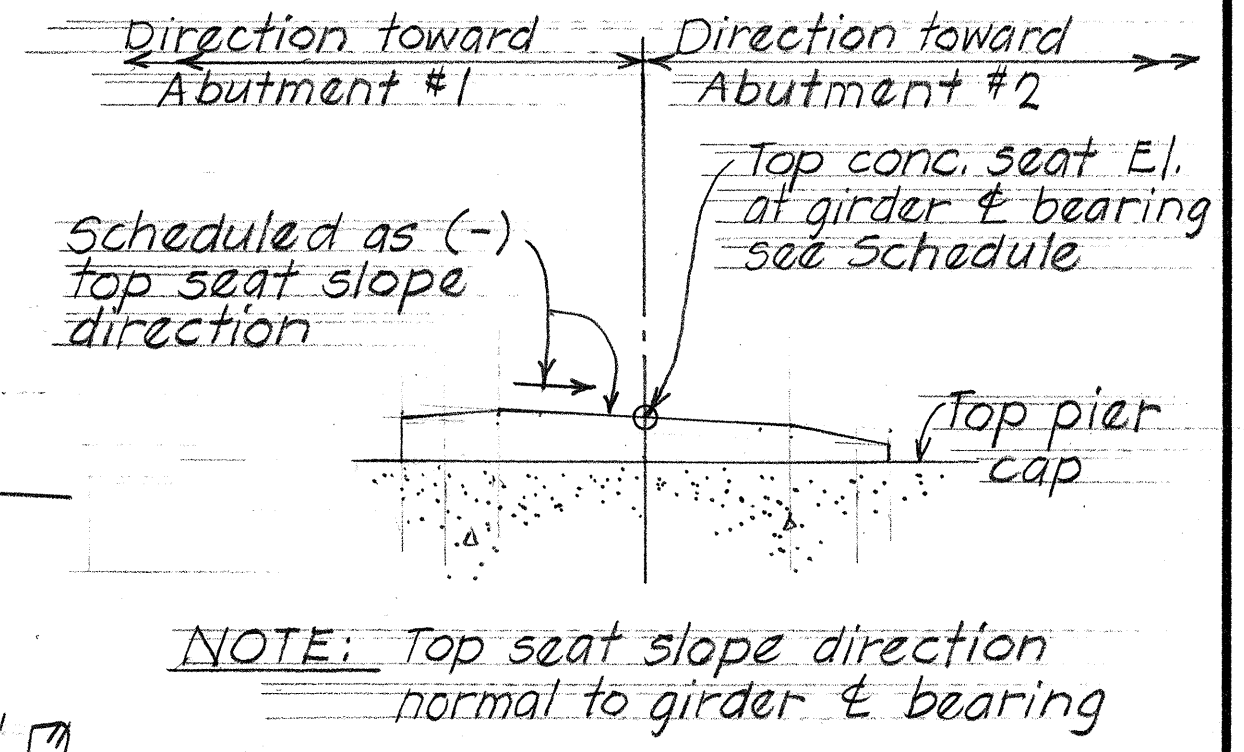

NOTE: Top seat slope direction normal to girder & bearing
⑥ DIAGRAM-VARIOUS CONDITIONS OF TOP CONCRETE SEAT SLOPE & DESIGNATION

TOP GIRDER CONCRETE SEAT ELEVATION AND SLOPE SCHEDULE (AT GIRDER & BEARING) See Sht. #															
		ABUT. #1		DIRECTION		①		DIRECTION		②		DIRECTION		ABUT. #2	
		①	TOP SEAT SLOPE	①	②	TOP SEAT SLOPE	①	②	TOP SEAT SLOPE	②					
G1	304.14	(-)	5/16 : 12	(-)	302.83	302.45	(-)	1/4 : 12	(-)	300.43	300.42	(-)	3/16 : 12	(-)	298.89
G2	304.69	↑	↑	↑	303.39	303.01	↑	↑	↑	300.99	300.98	↑	↑	↑	299.45
G3	305.25				303.94	303.57				301.55	301.54				300.01
G4	305.81				304.50	304.13				302.11	302.09				300.57
G5	306.37				305.06	304.68				302.66	302.65				301.13
G6	306.92				305.62	305.24				303.22	303.21				301.68
G7	307.48	↓	↓	↓	306.17	305.80	↓	↓	↓	303.78	303.77	↓	↓	↓	302.24
G8	308.04	(-)	5/16 : 12	(-)	306.73	306.36	(-)	1/4 : 12	(-)	304.34	304.32	(-)	3/16 : 12	(-)	302.80


STATE OF HAWAII
DEPARTMENT OF TRANSPORTATION
HIGHWAYS DIVISION

KILAUEA STREAM BRIDGE
PIER CAP ①, ② DETAILS

Proj. N° RF-056-1(10) Apr. 1971
SHEET No. 42 OF 74 SHEETS

DATE: _____
SURVEY PLOTTED BY: _____
DRAWN BY: _____
CHECKED BY: _____
ORIGINAL PLAN: _____
NOTE BOOK: _____

FED. ROAD DIST. NO.	STATE	FED. AID PROJ. NO.	FISCAL YEAR	SHEET NO.	TOTAL SHEETS
HAWAII	HAW.	RF-056-1(10)	1971	43	74

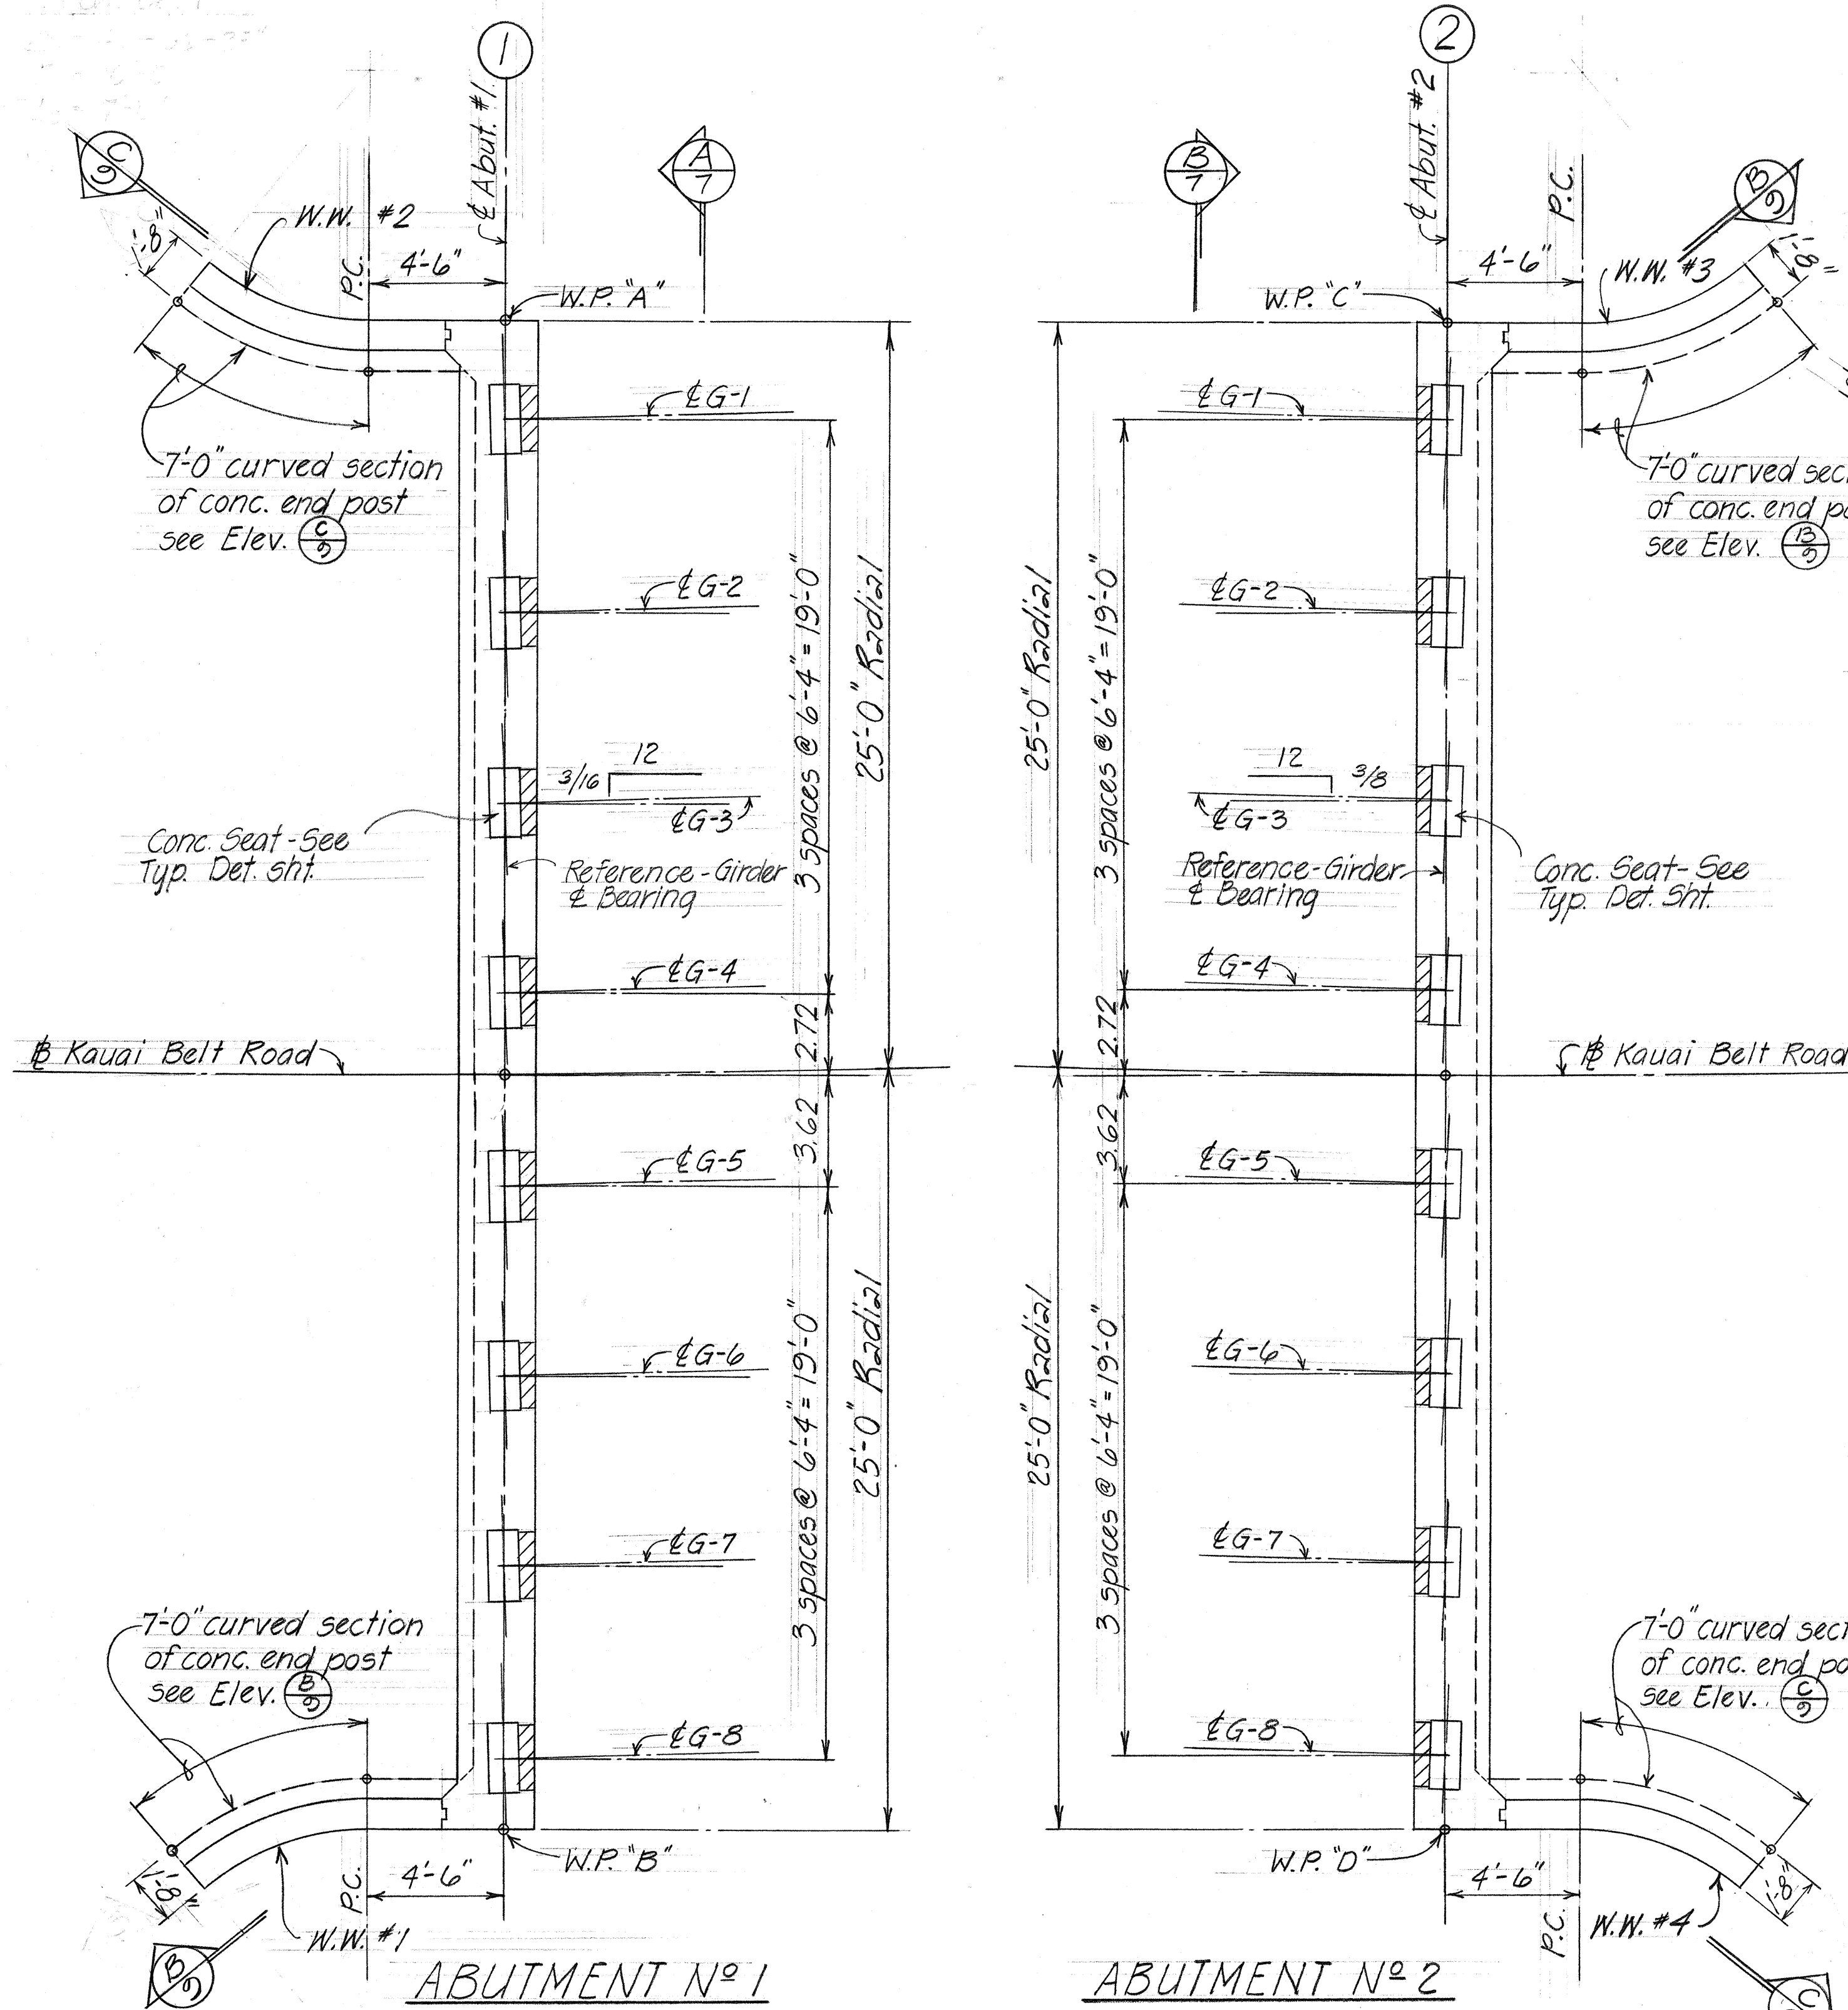


ABUTMENT N^o 1

ABUTMENT N^o 2


PLAN-TOP OF ABUTMENT WALL LEVEL

Scale: 1/4" = 1'-0"

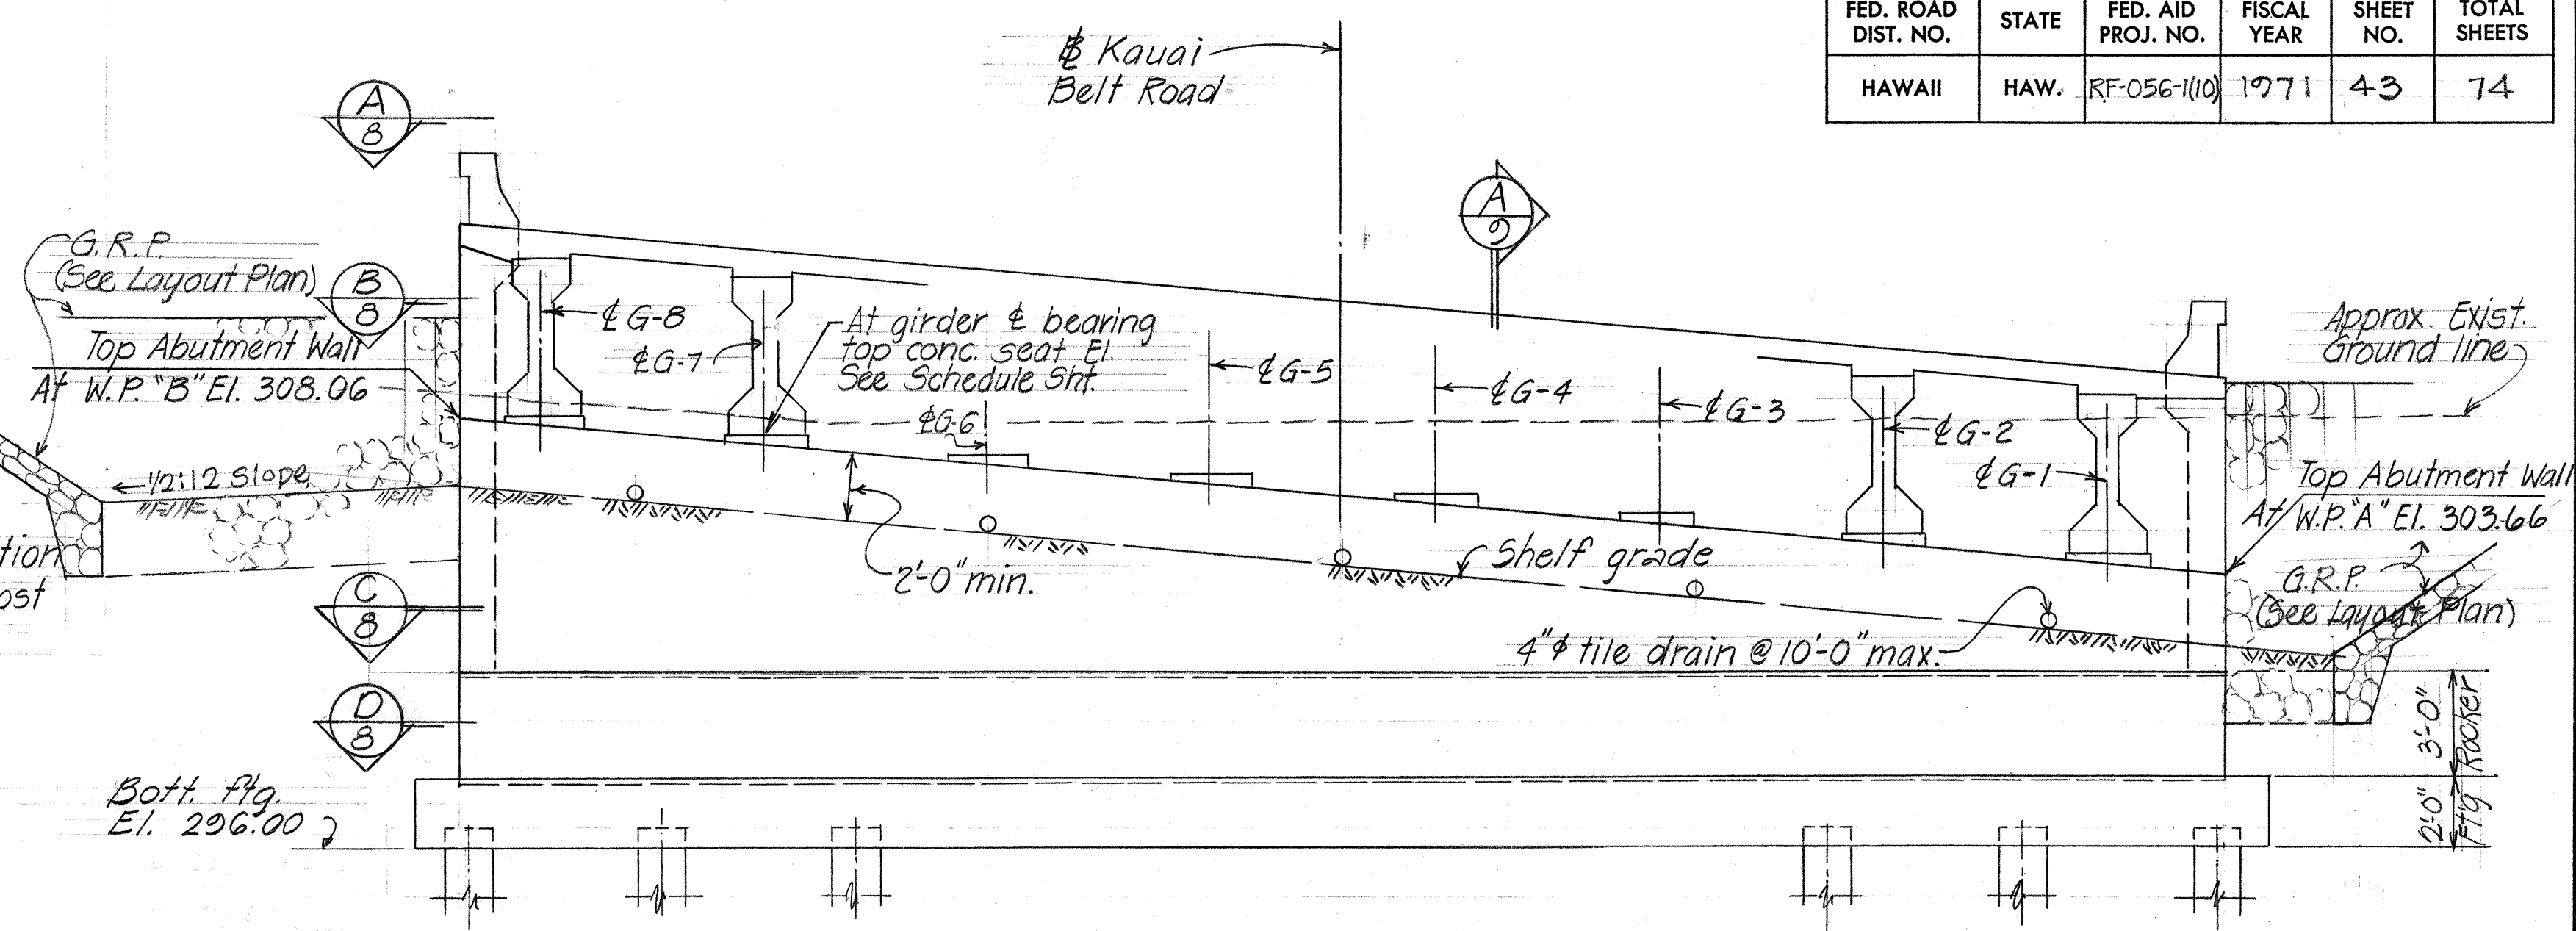


ELEVATION A-7 ABUTMENT N^o 1

Scale: 1/4" = 1'-0"

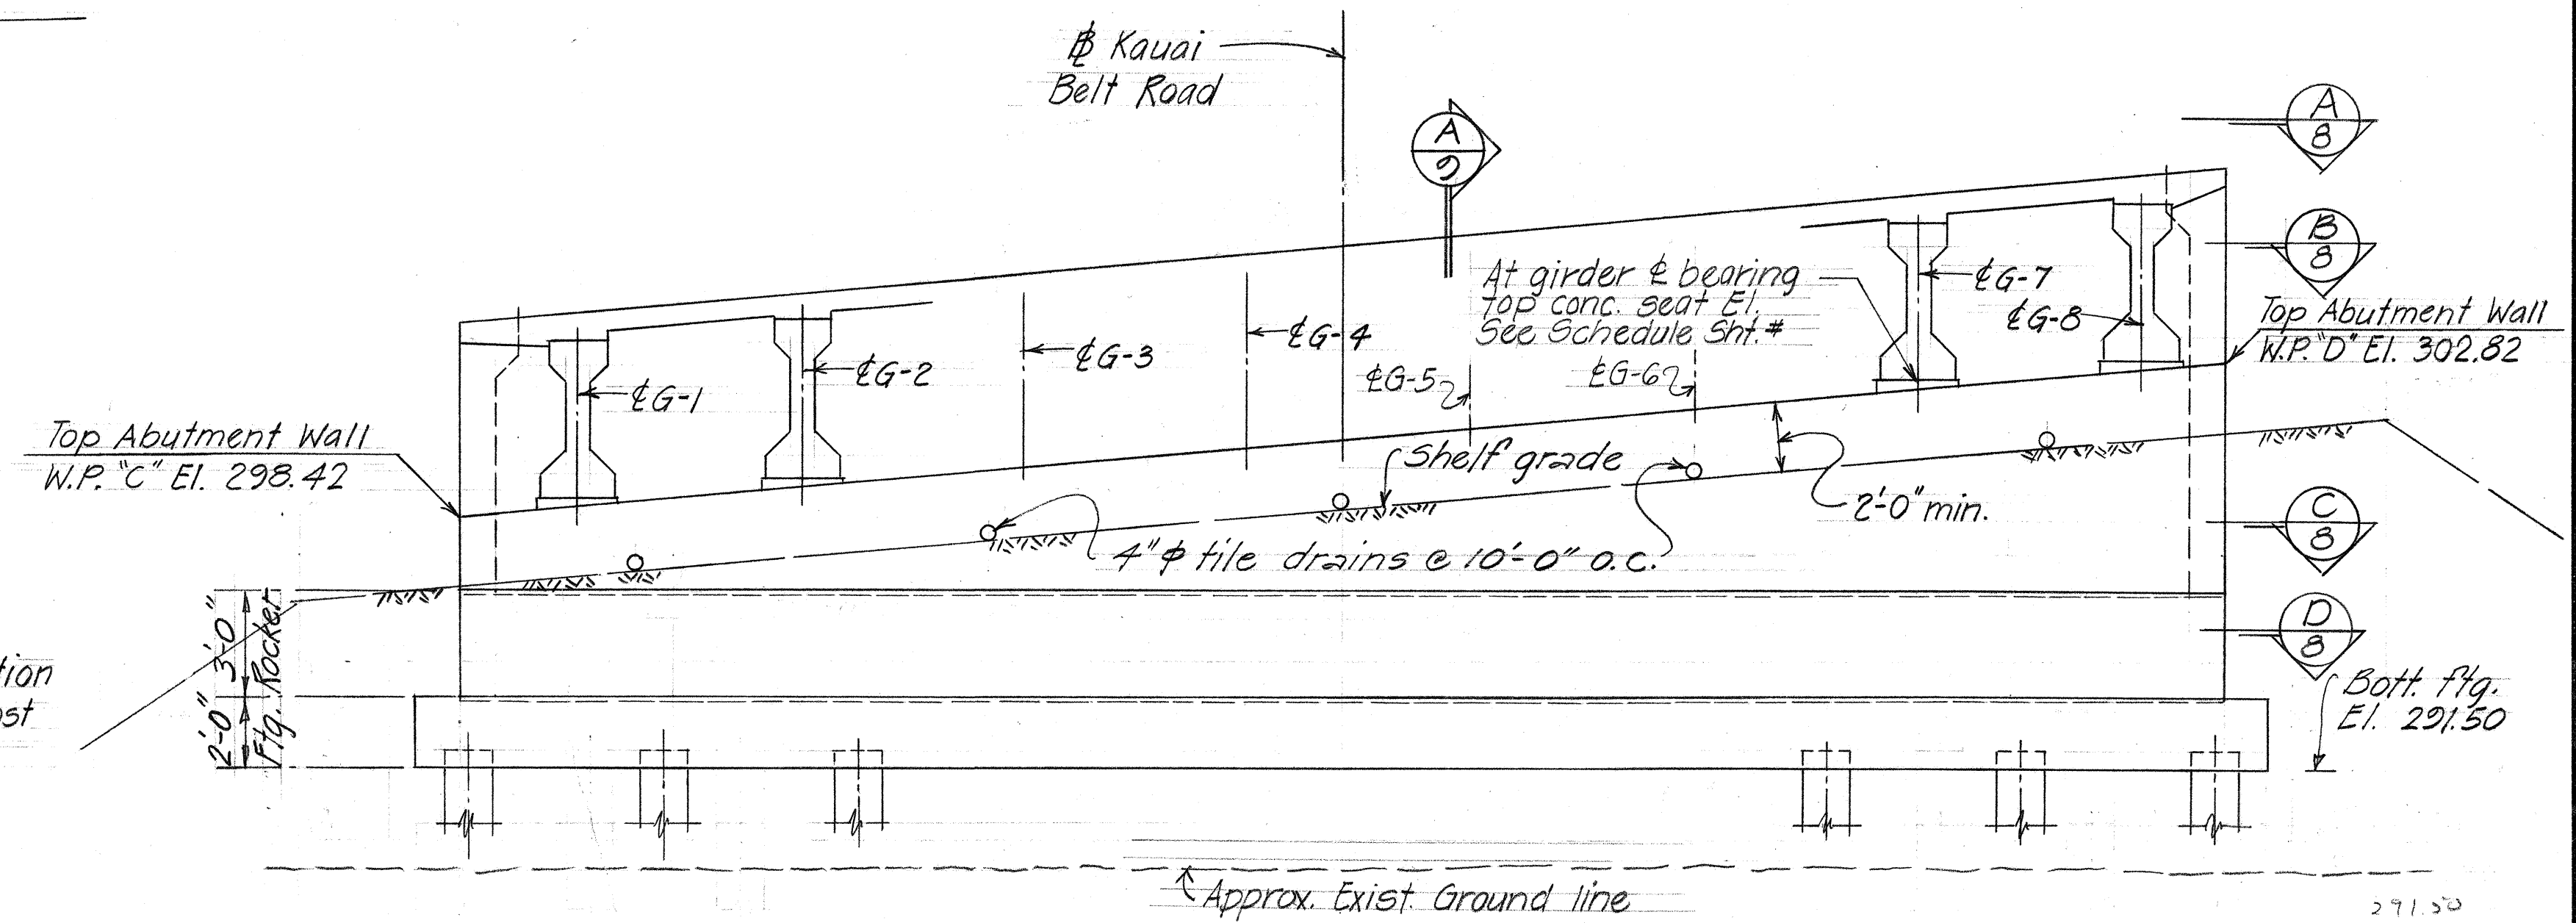

ELEVATION B-7 ABUTMENT N^o 2

Scale: 1/4" = 1'-0"

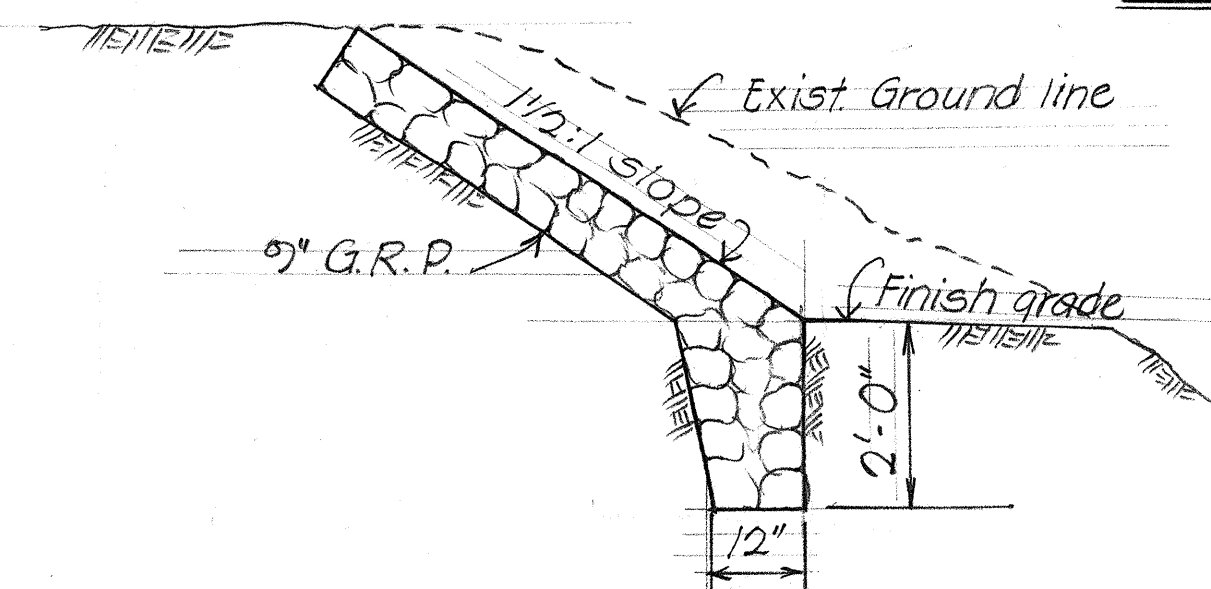

TYPICAL G.R.P. DETAIL

Scale: 1/2" = 1'-0"

STATE OF HAWAII
DEPARTMENT OF TRANSPORTATION
HIGHWAYS DIVISION

KILAUEA STREAM BRIDGE








ABUTMENT #1 & #2
PLAN & DETAILS

Proj. No. RF-056-1(10)

Apr. 1971

SHEET No. 7 OF 11 SHEETS

FED. ROAD DIST. NO.	STATE	FED. AID PROJ. NO.	FISCAL YEAR	SHEET NO.	TOTAL SHEETS
HAWAII	HAW.	RF-056-1(10)	1971	44	74

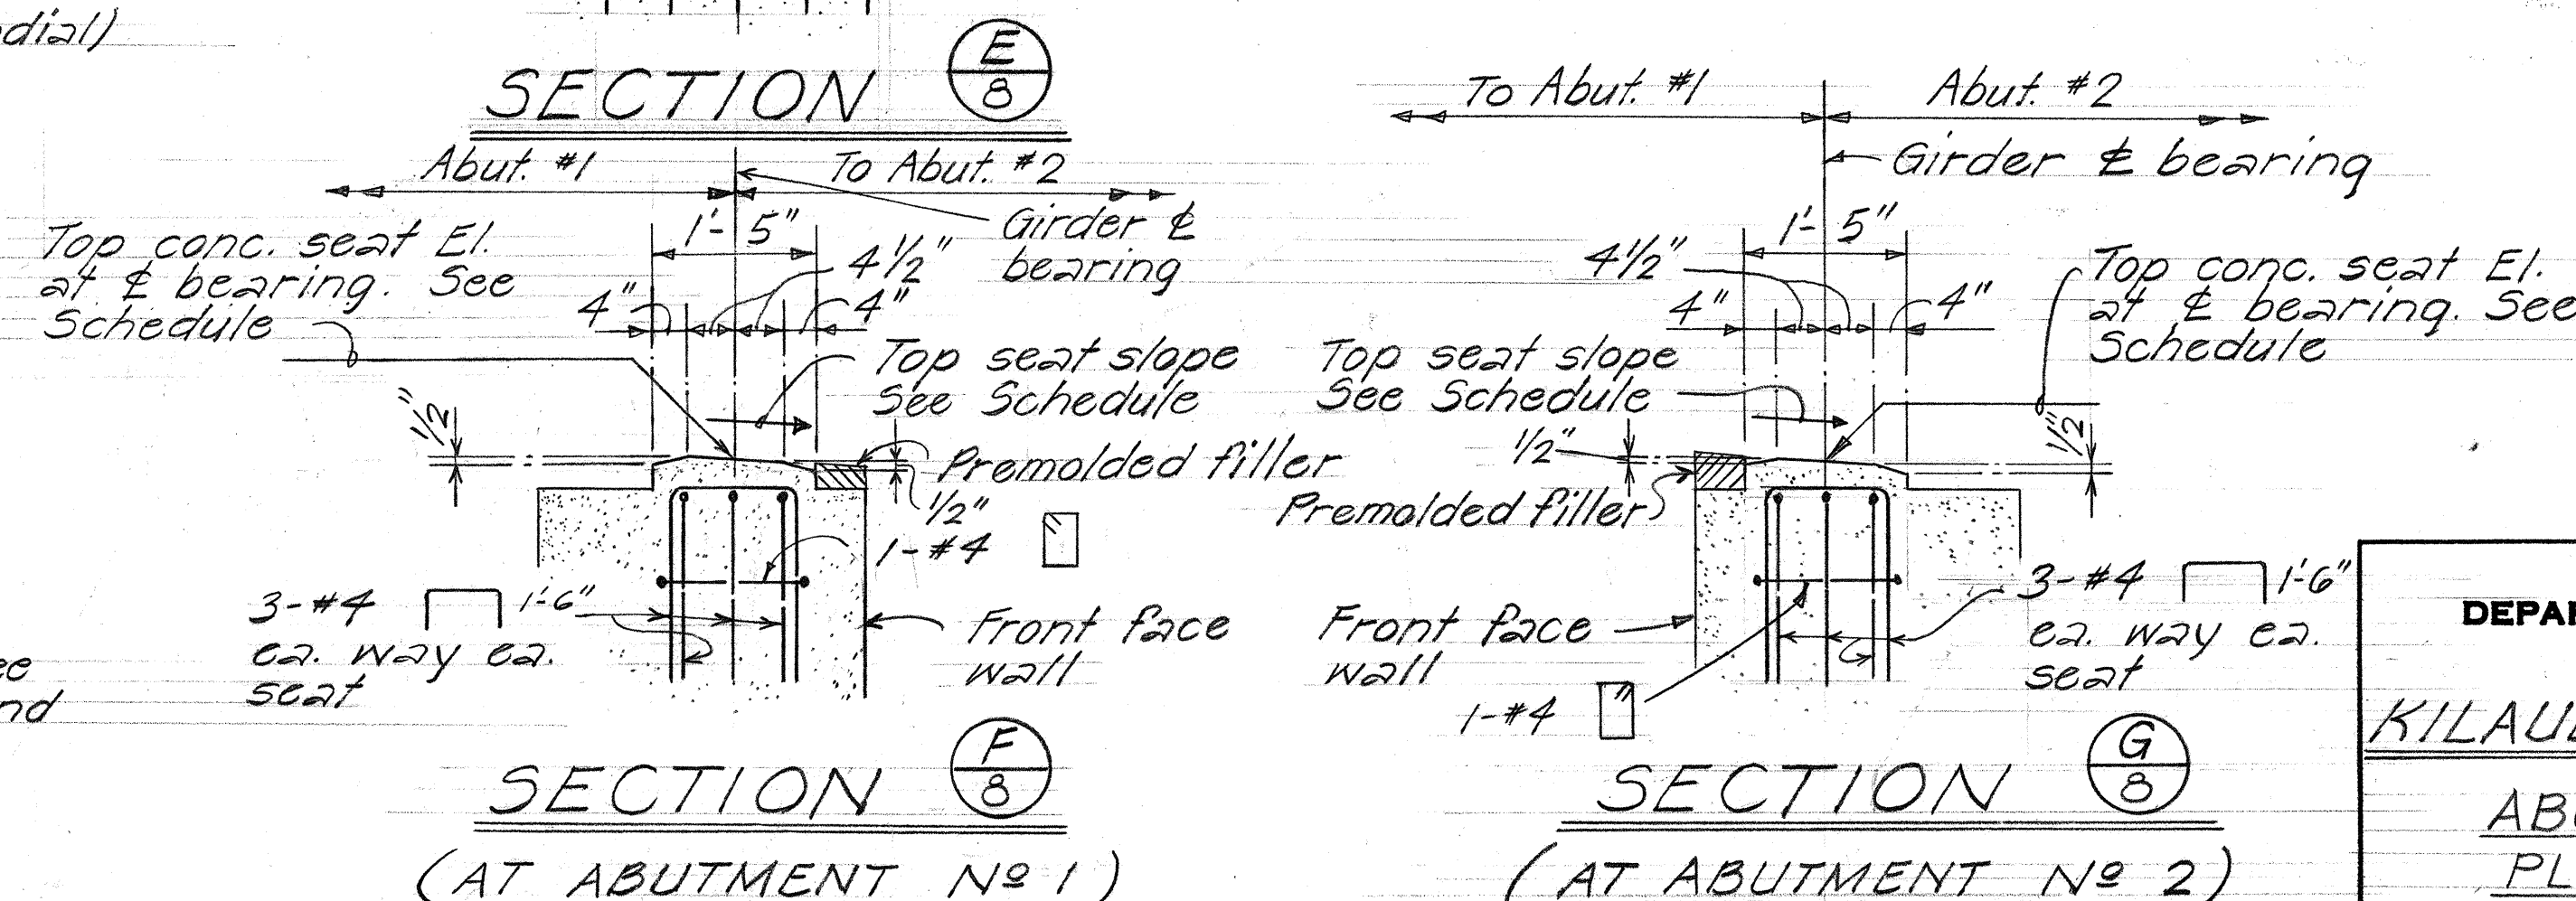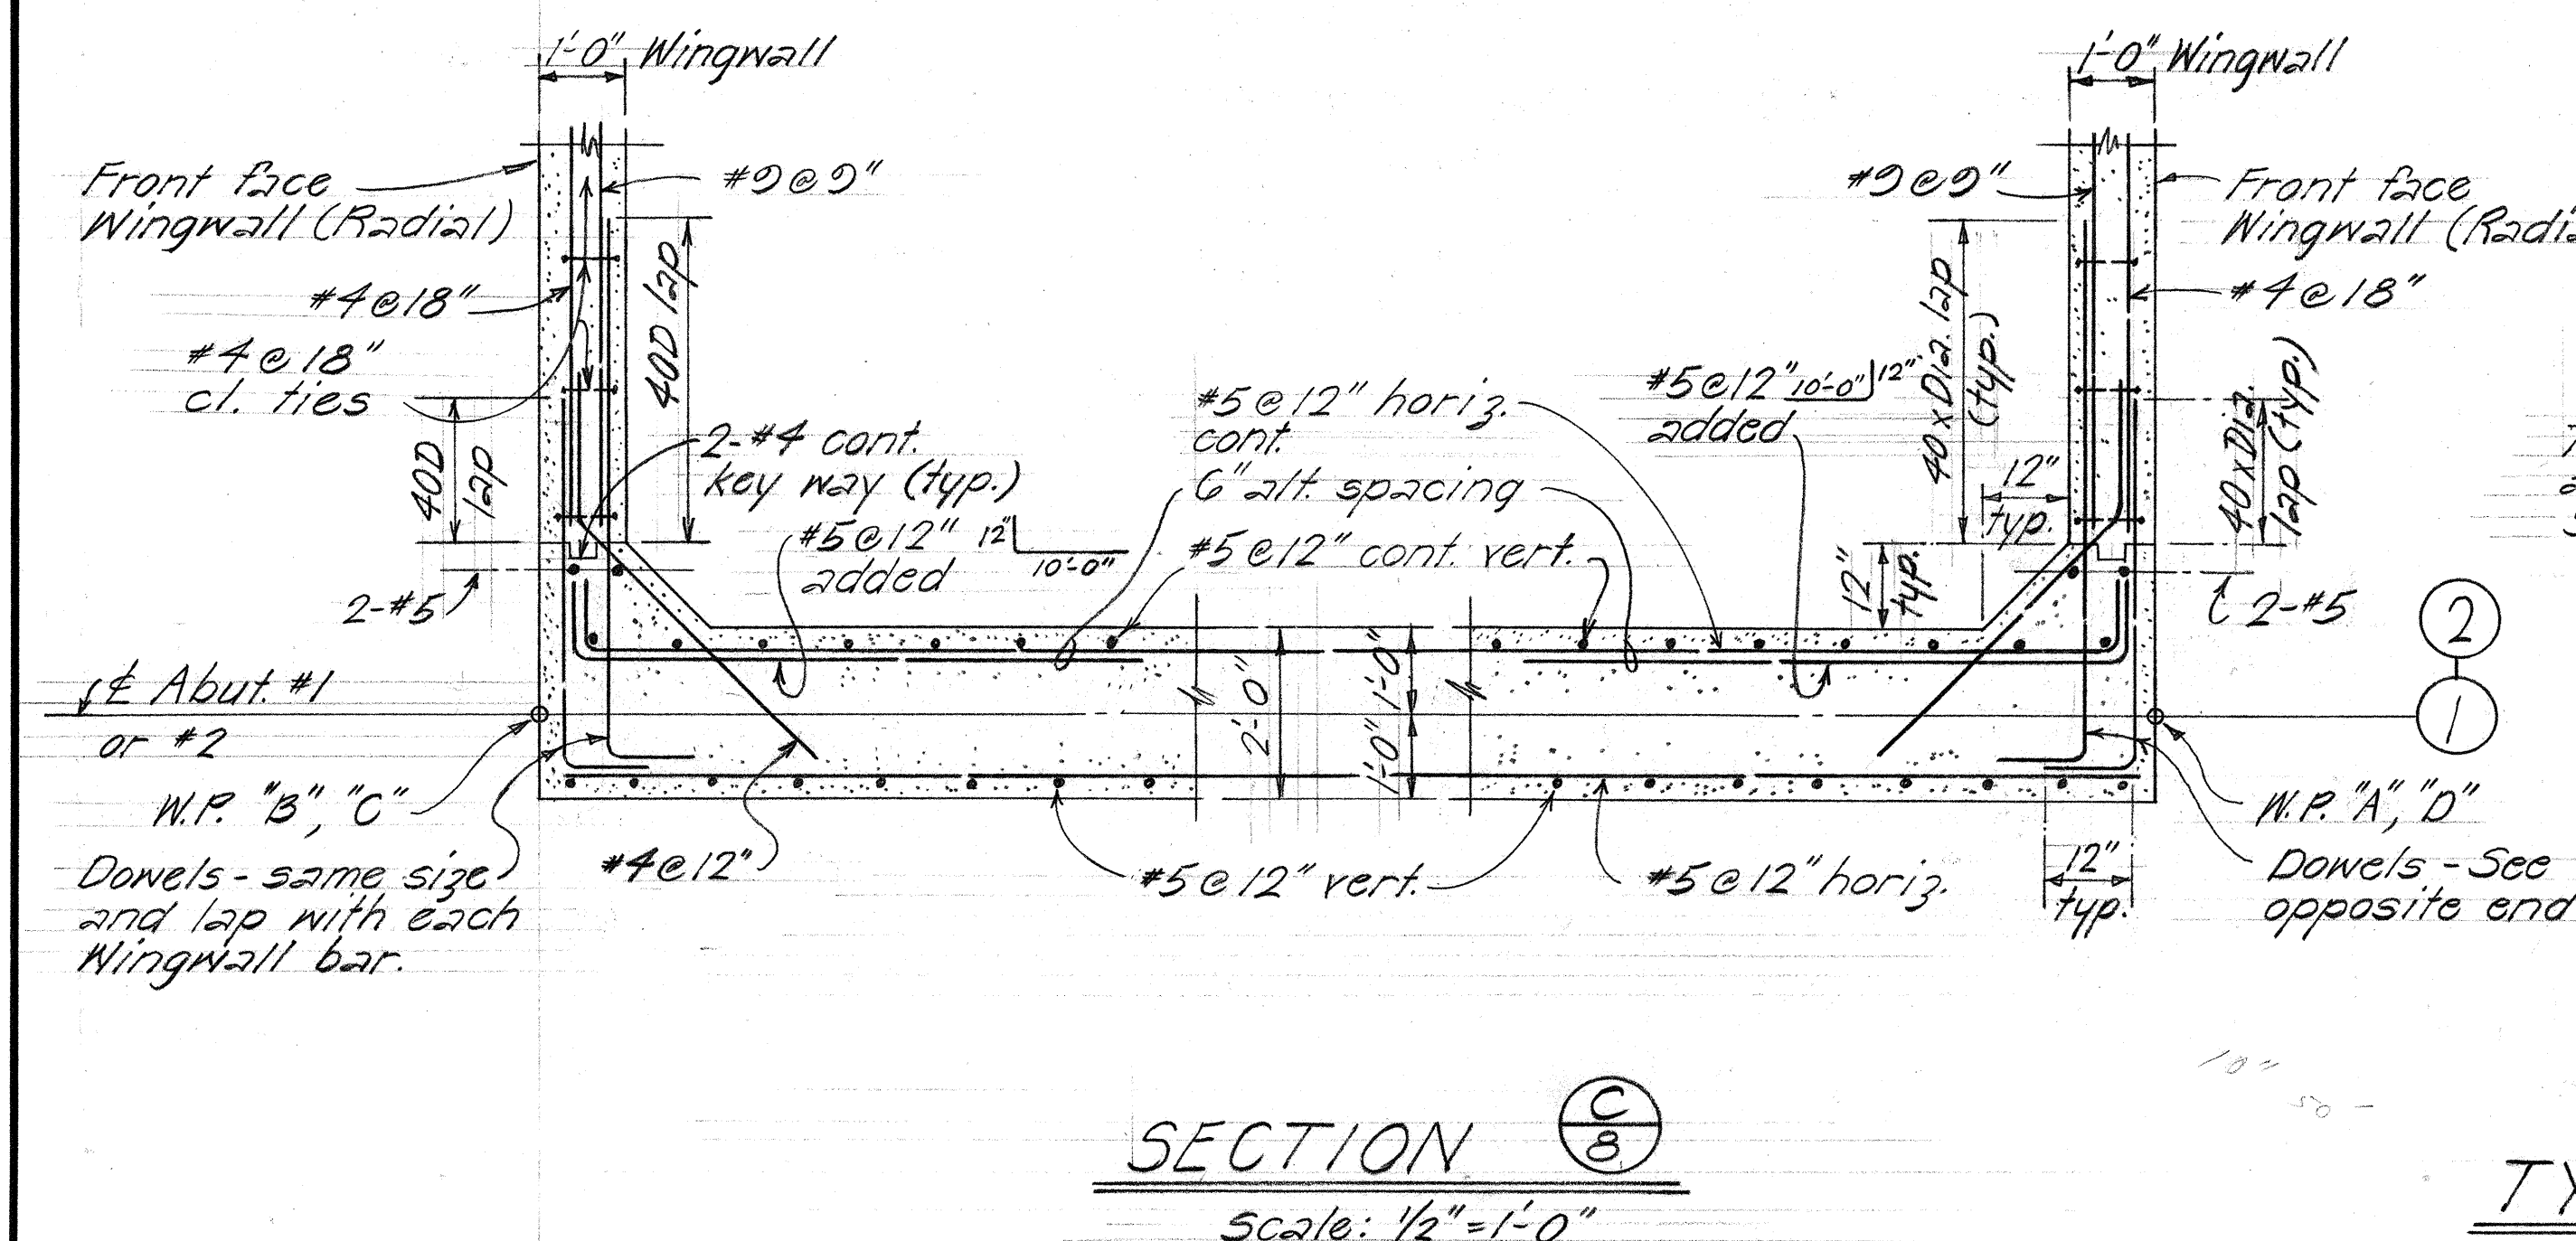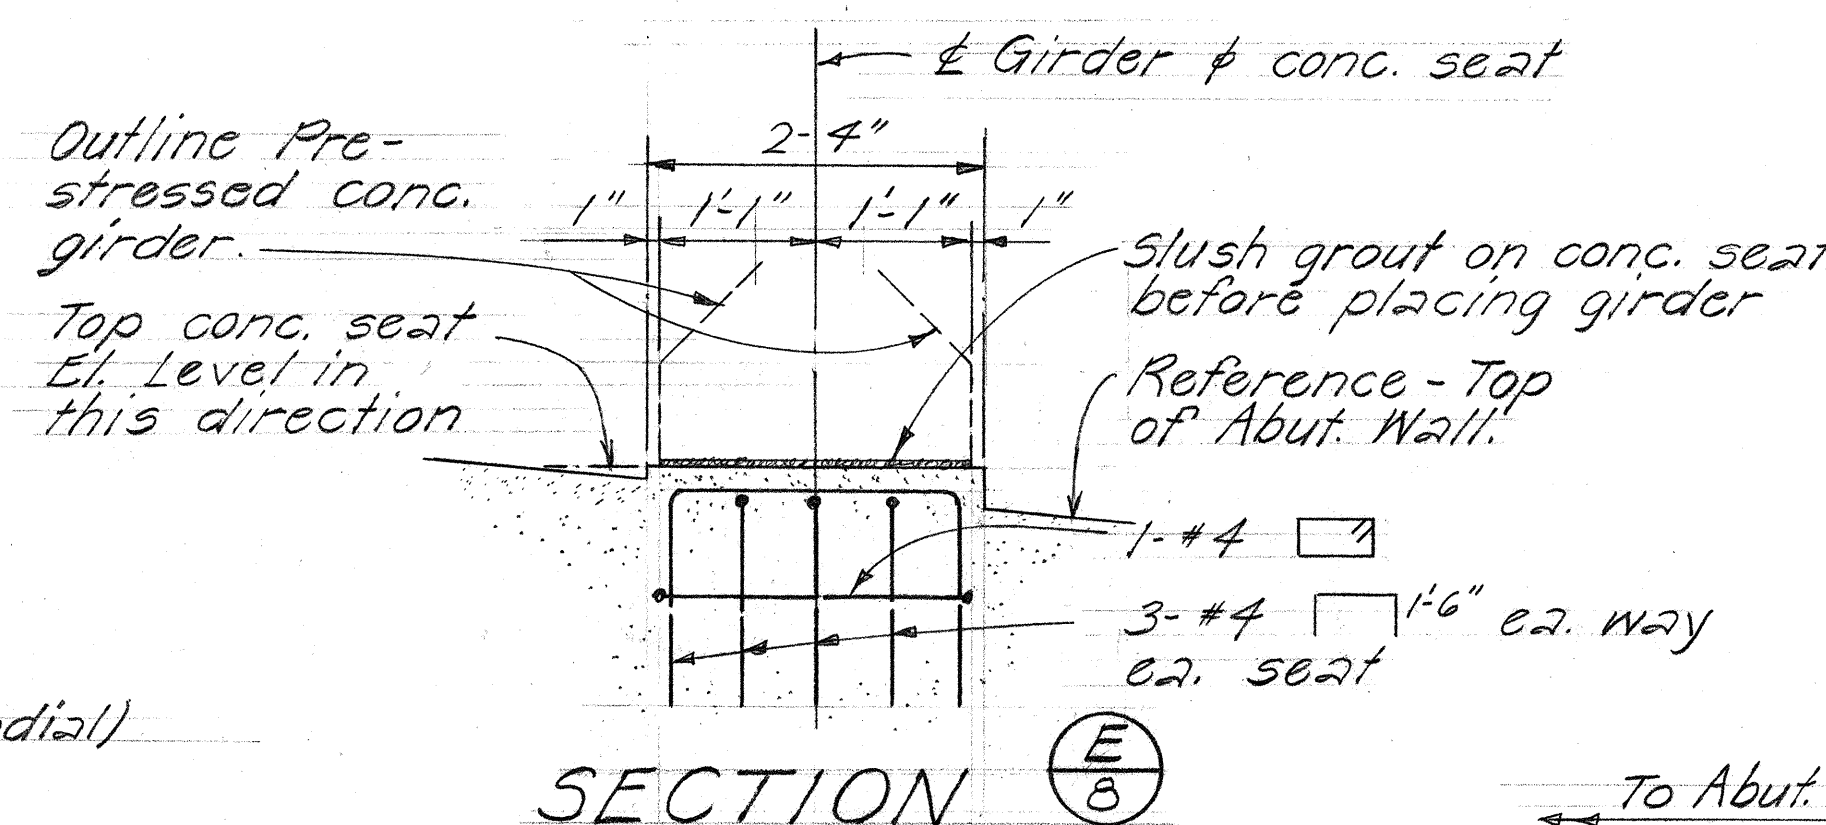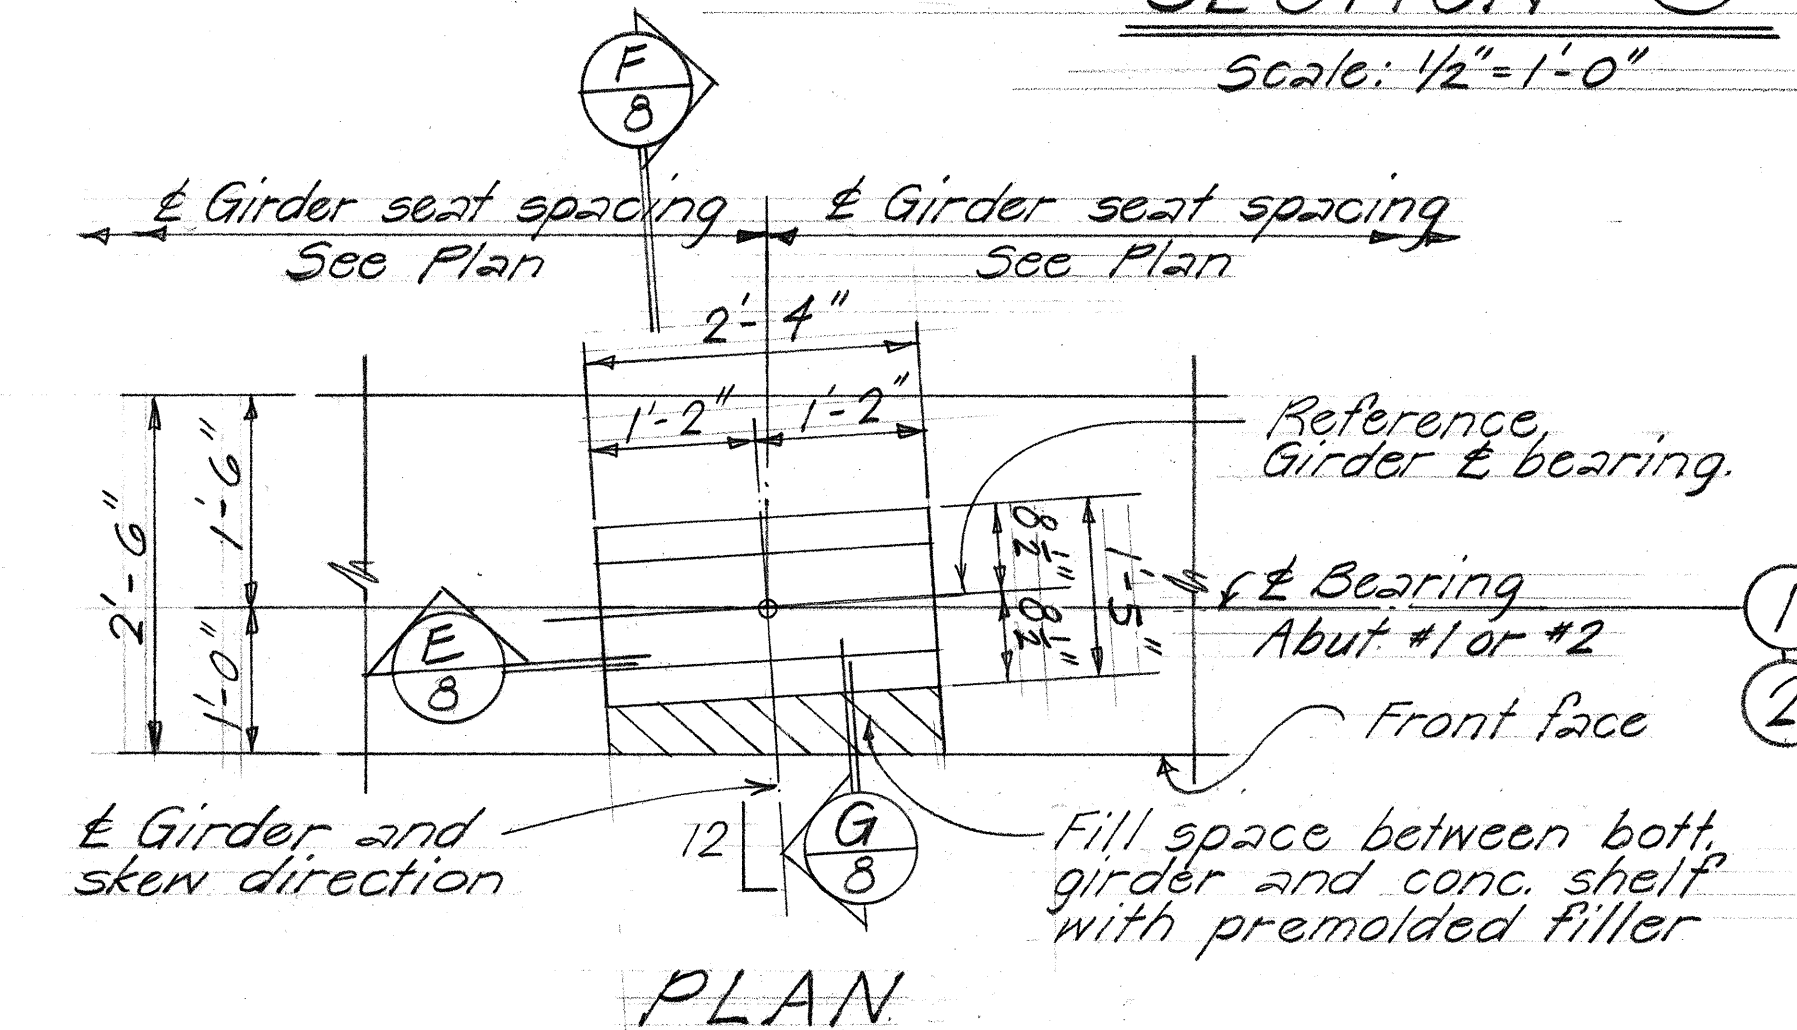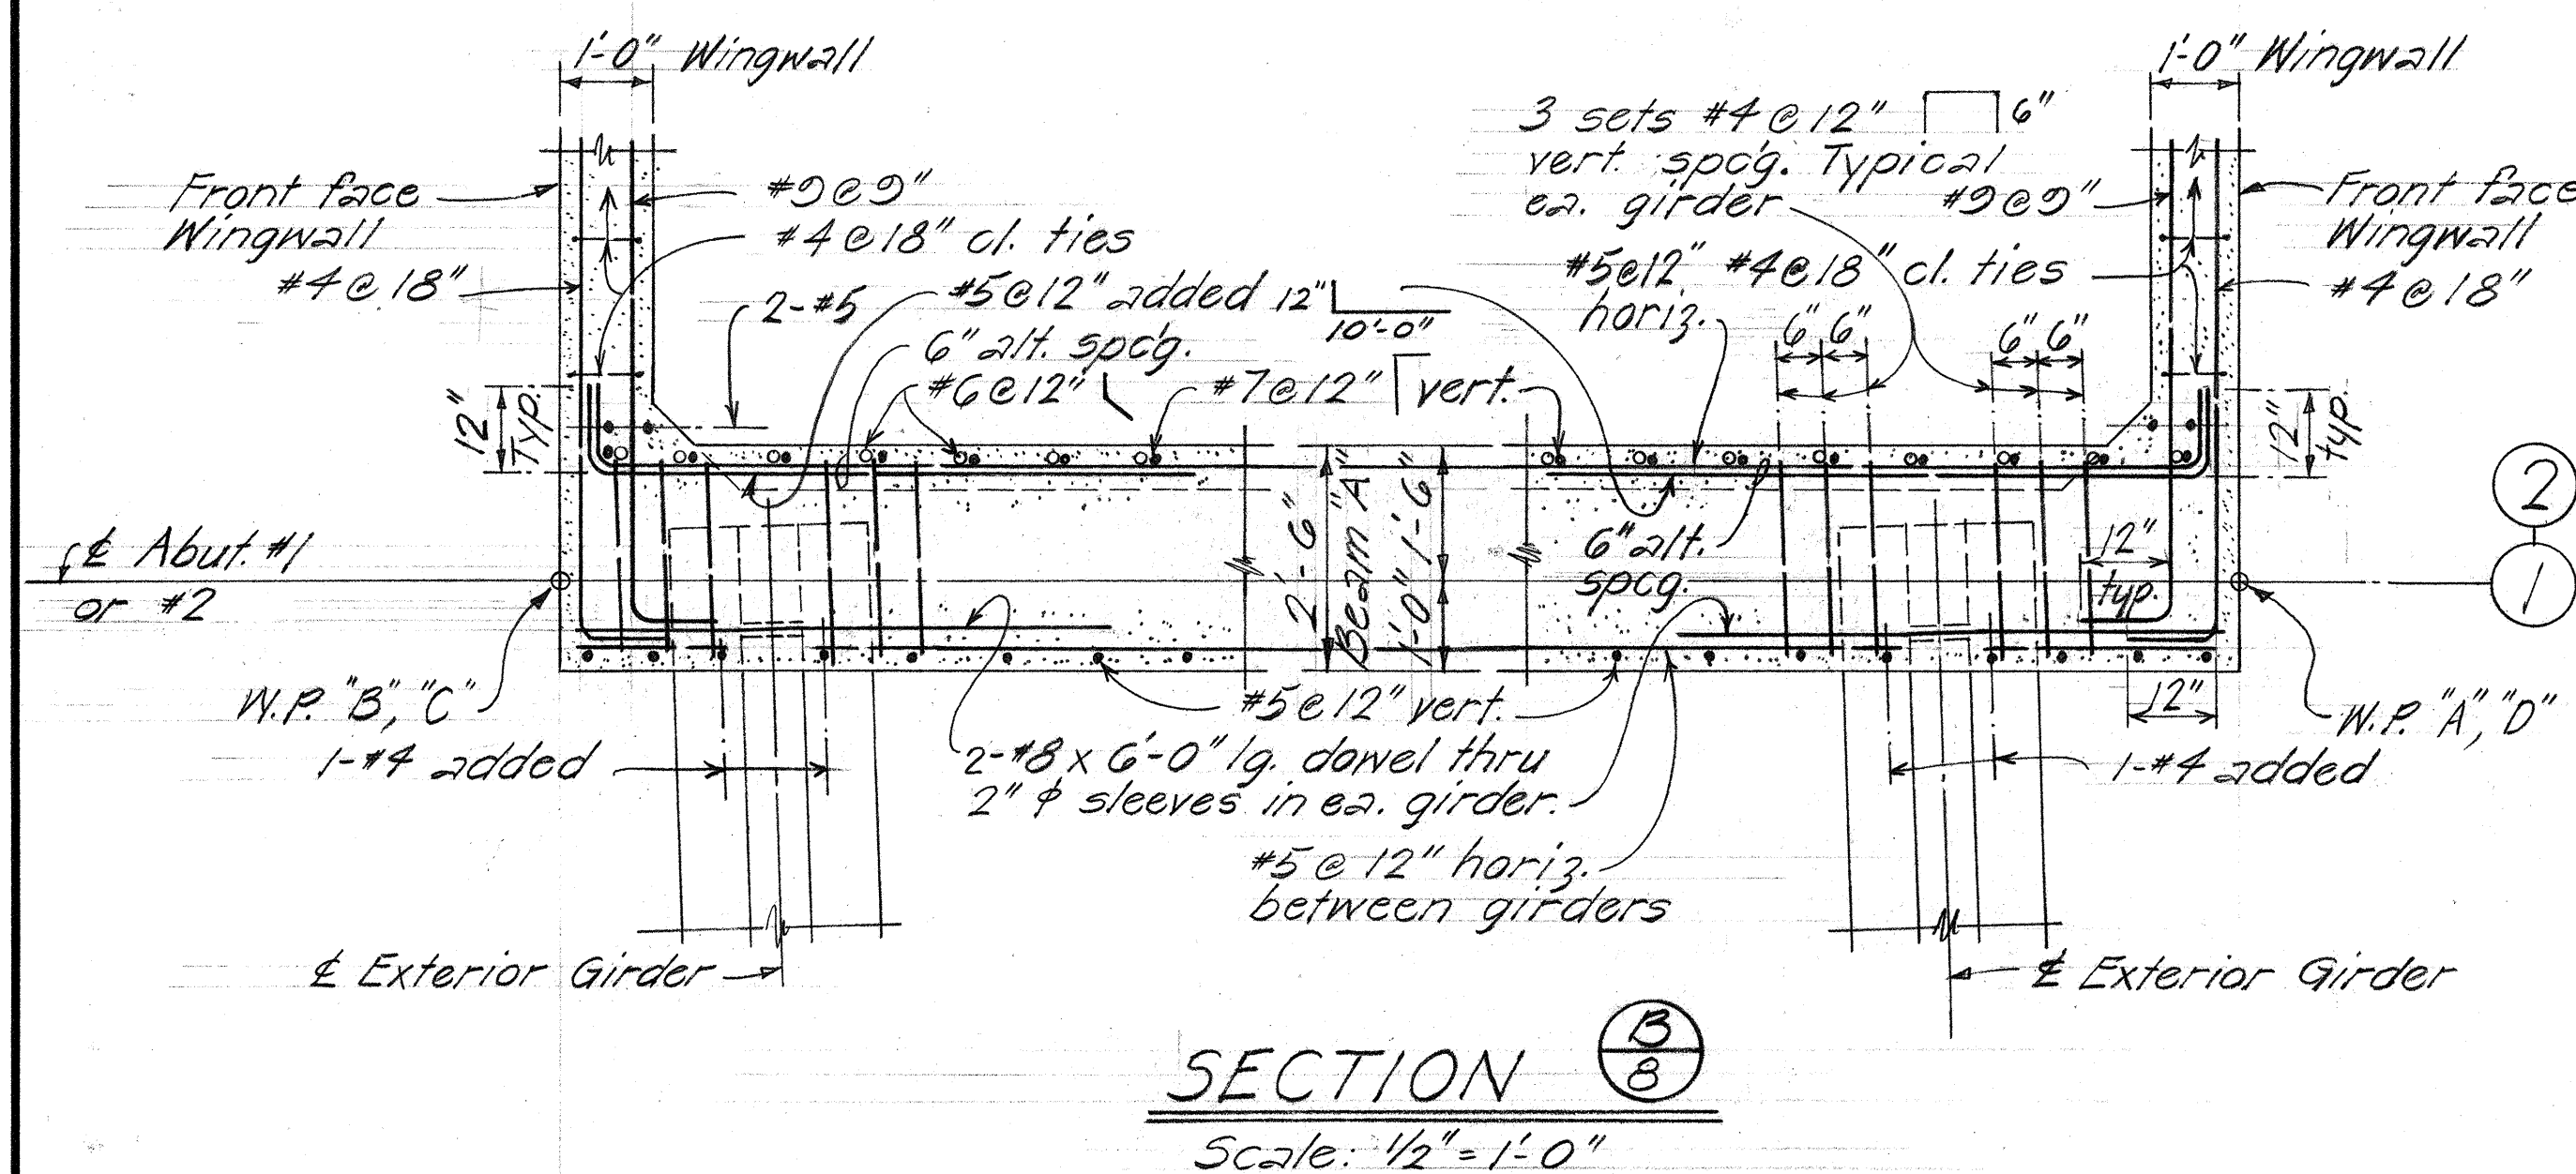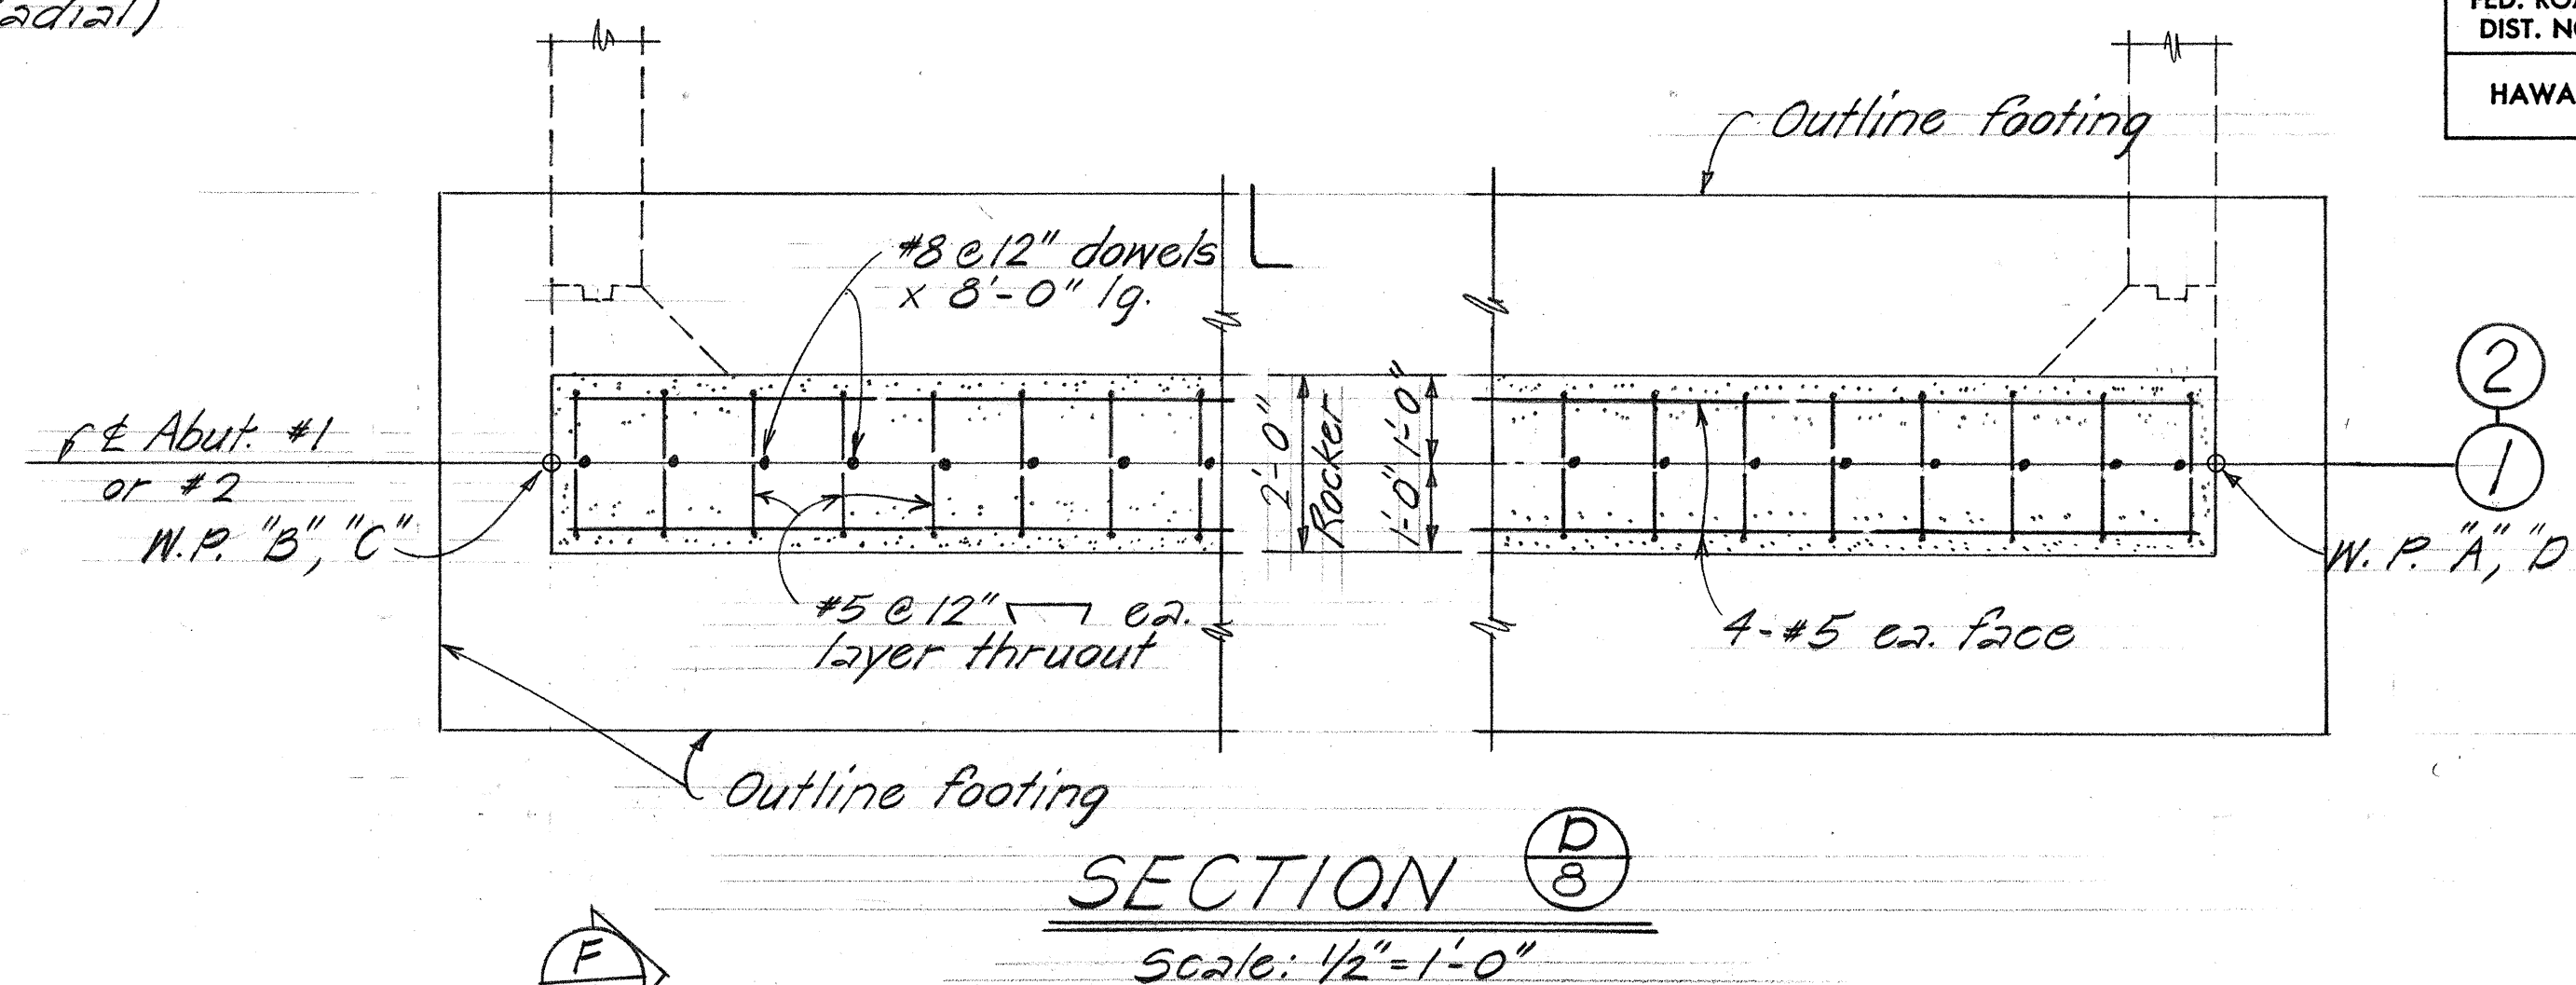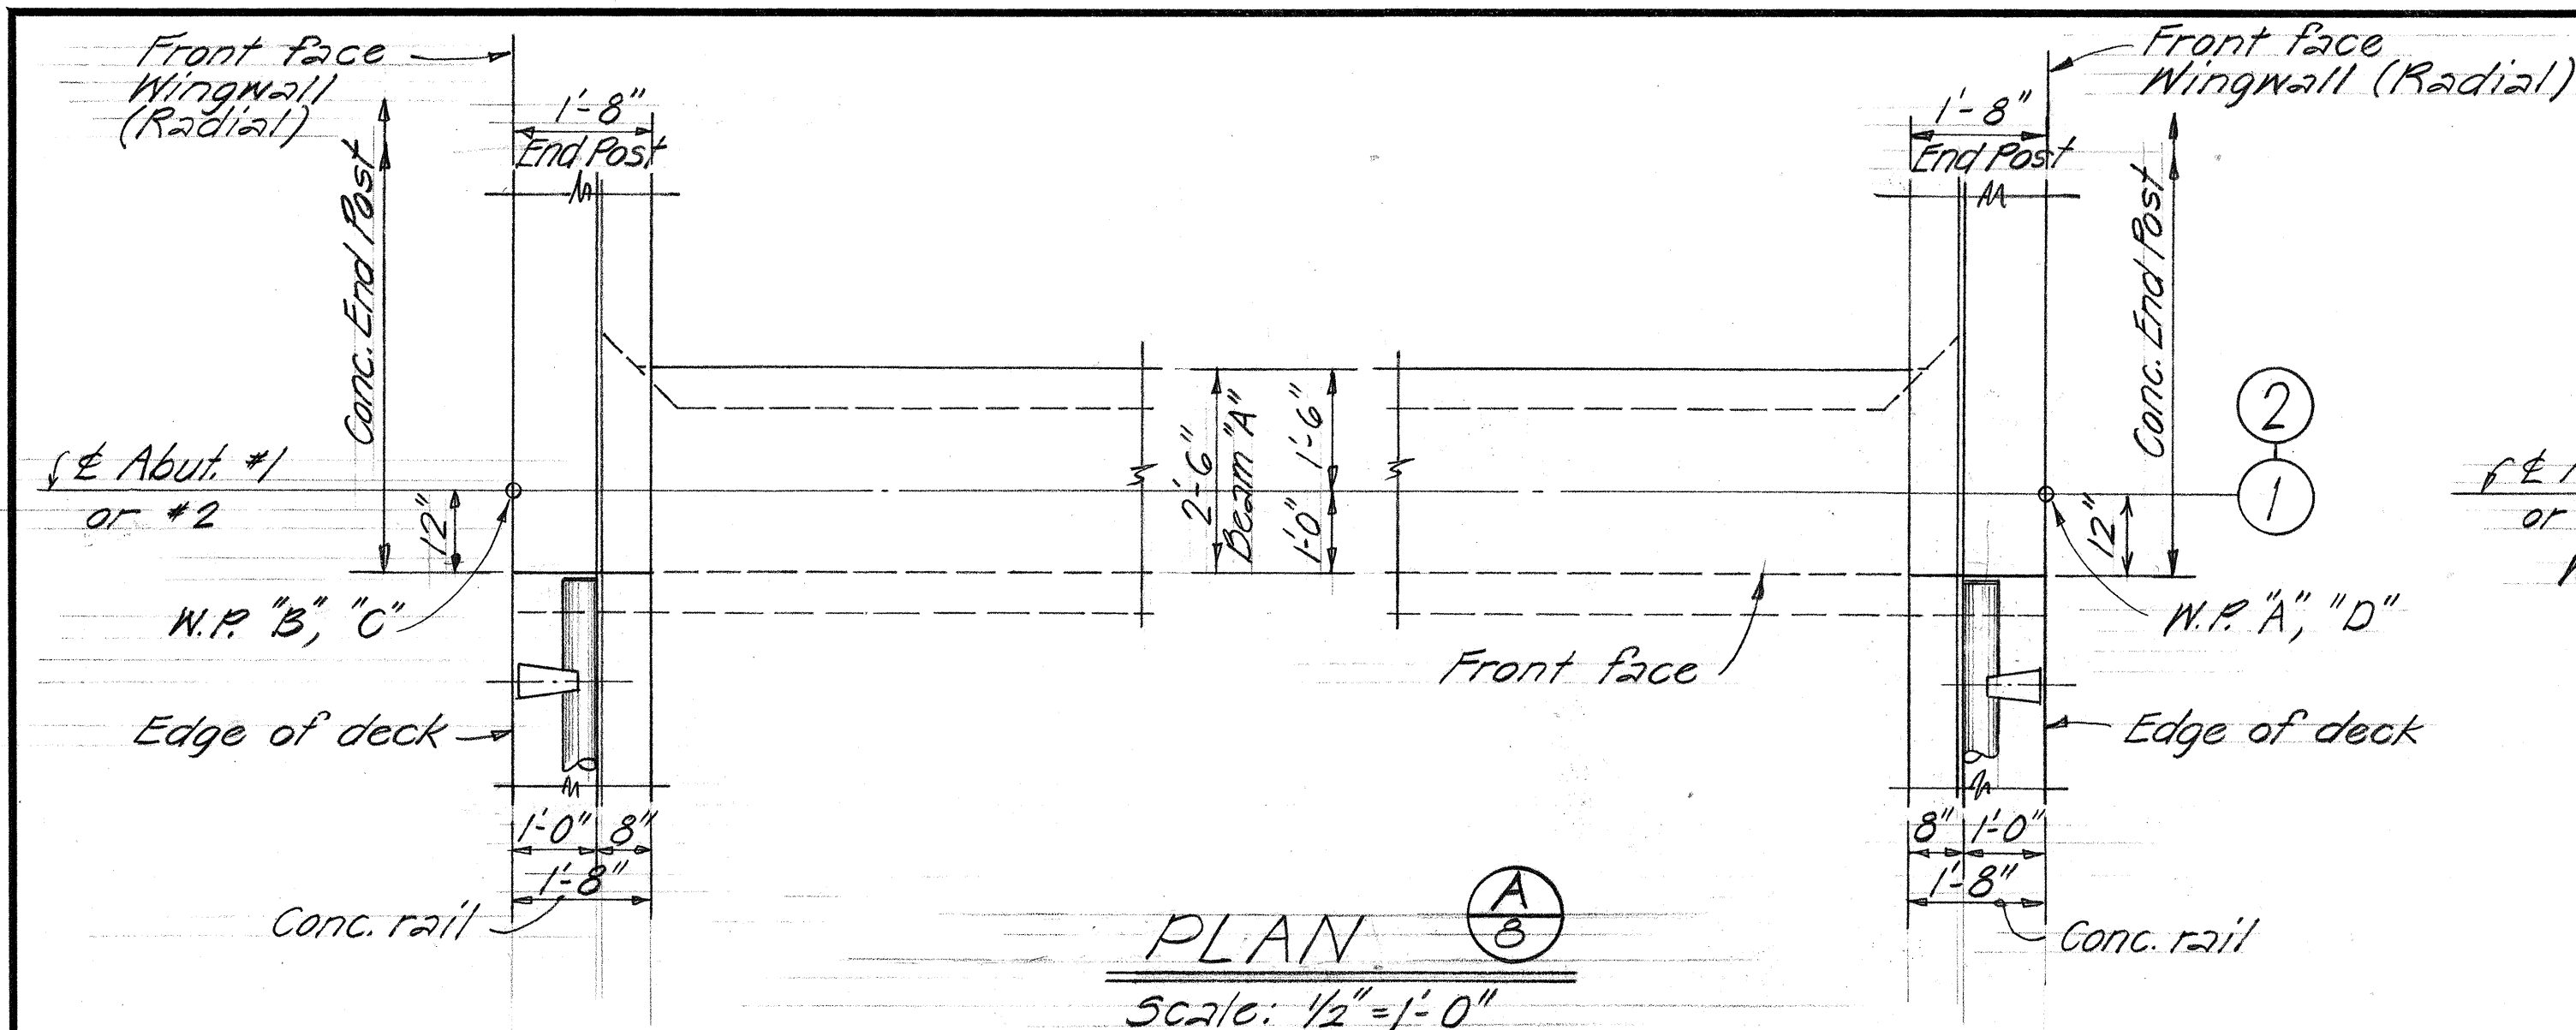


TYPICAL ABUTMENT CONCRETE SEAT DETAILS

STATE OF HAWAII
DEPARTMENT OF TRANSPORTATION
HIGHWAYS DIVISION
KILAUEA STREAM BRIDGE
ABUTMENT #1 & #2
PLAN & SECTIONS
Proj. No RF-056-1(10) Apr. 1971
SHEET No. 8 OF 11 SHEETS

DATE	DESIGNED BY	CHECKED BY
1-1-71	L. M.	P. E. G.
QUANTITIES BY	NOTED BY	NO.
P. E. G.		


FED. ROAD DIST. NO.	STATE	FED. AID PROJ. NO.	FISCAL YEAR	SHEET NO.	TOTAL SHEETS
HAWAII	HAW.	RF-056-1(10)	1971	45	74

REVISED: 2-10-78

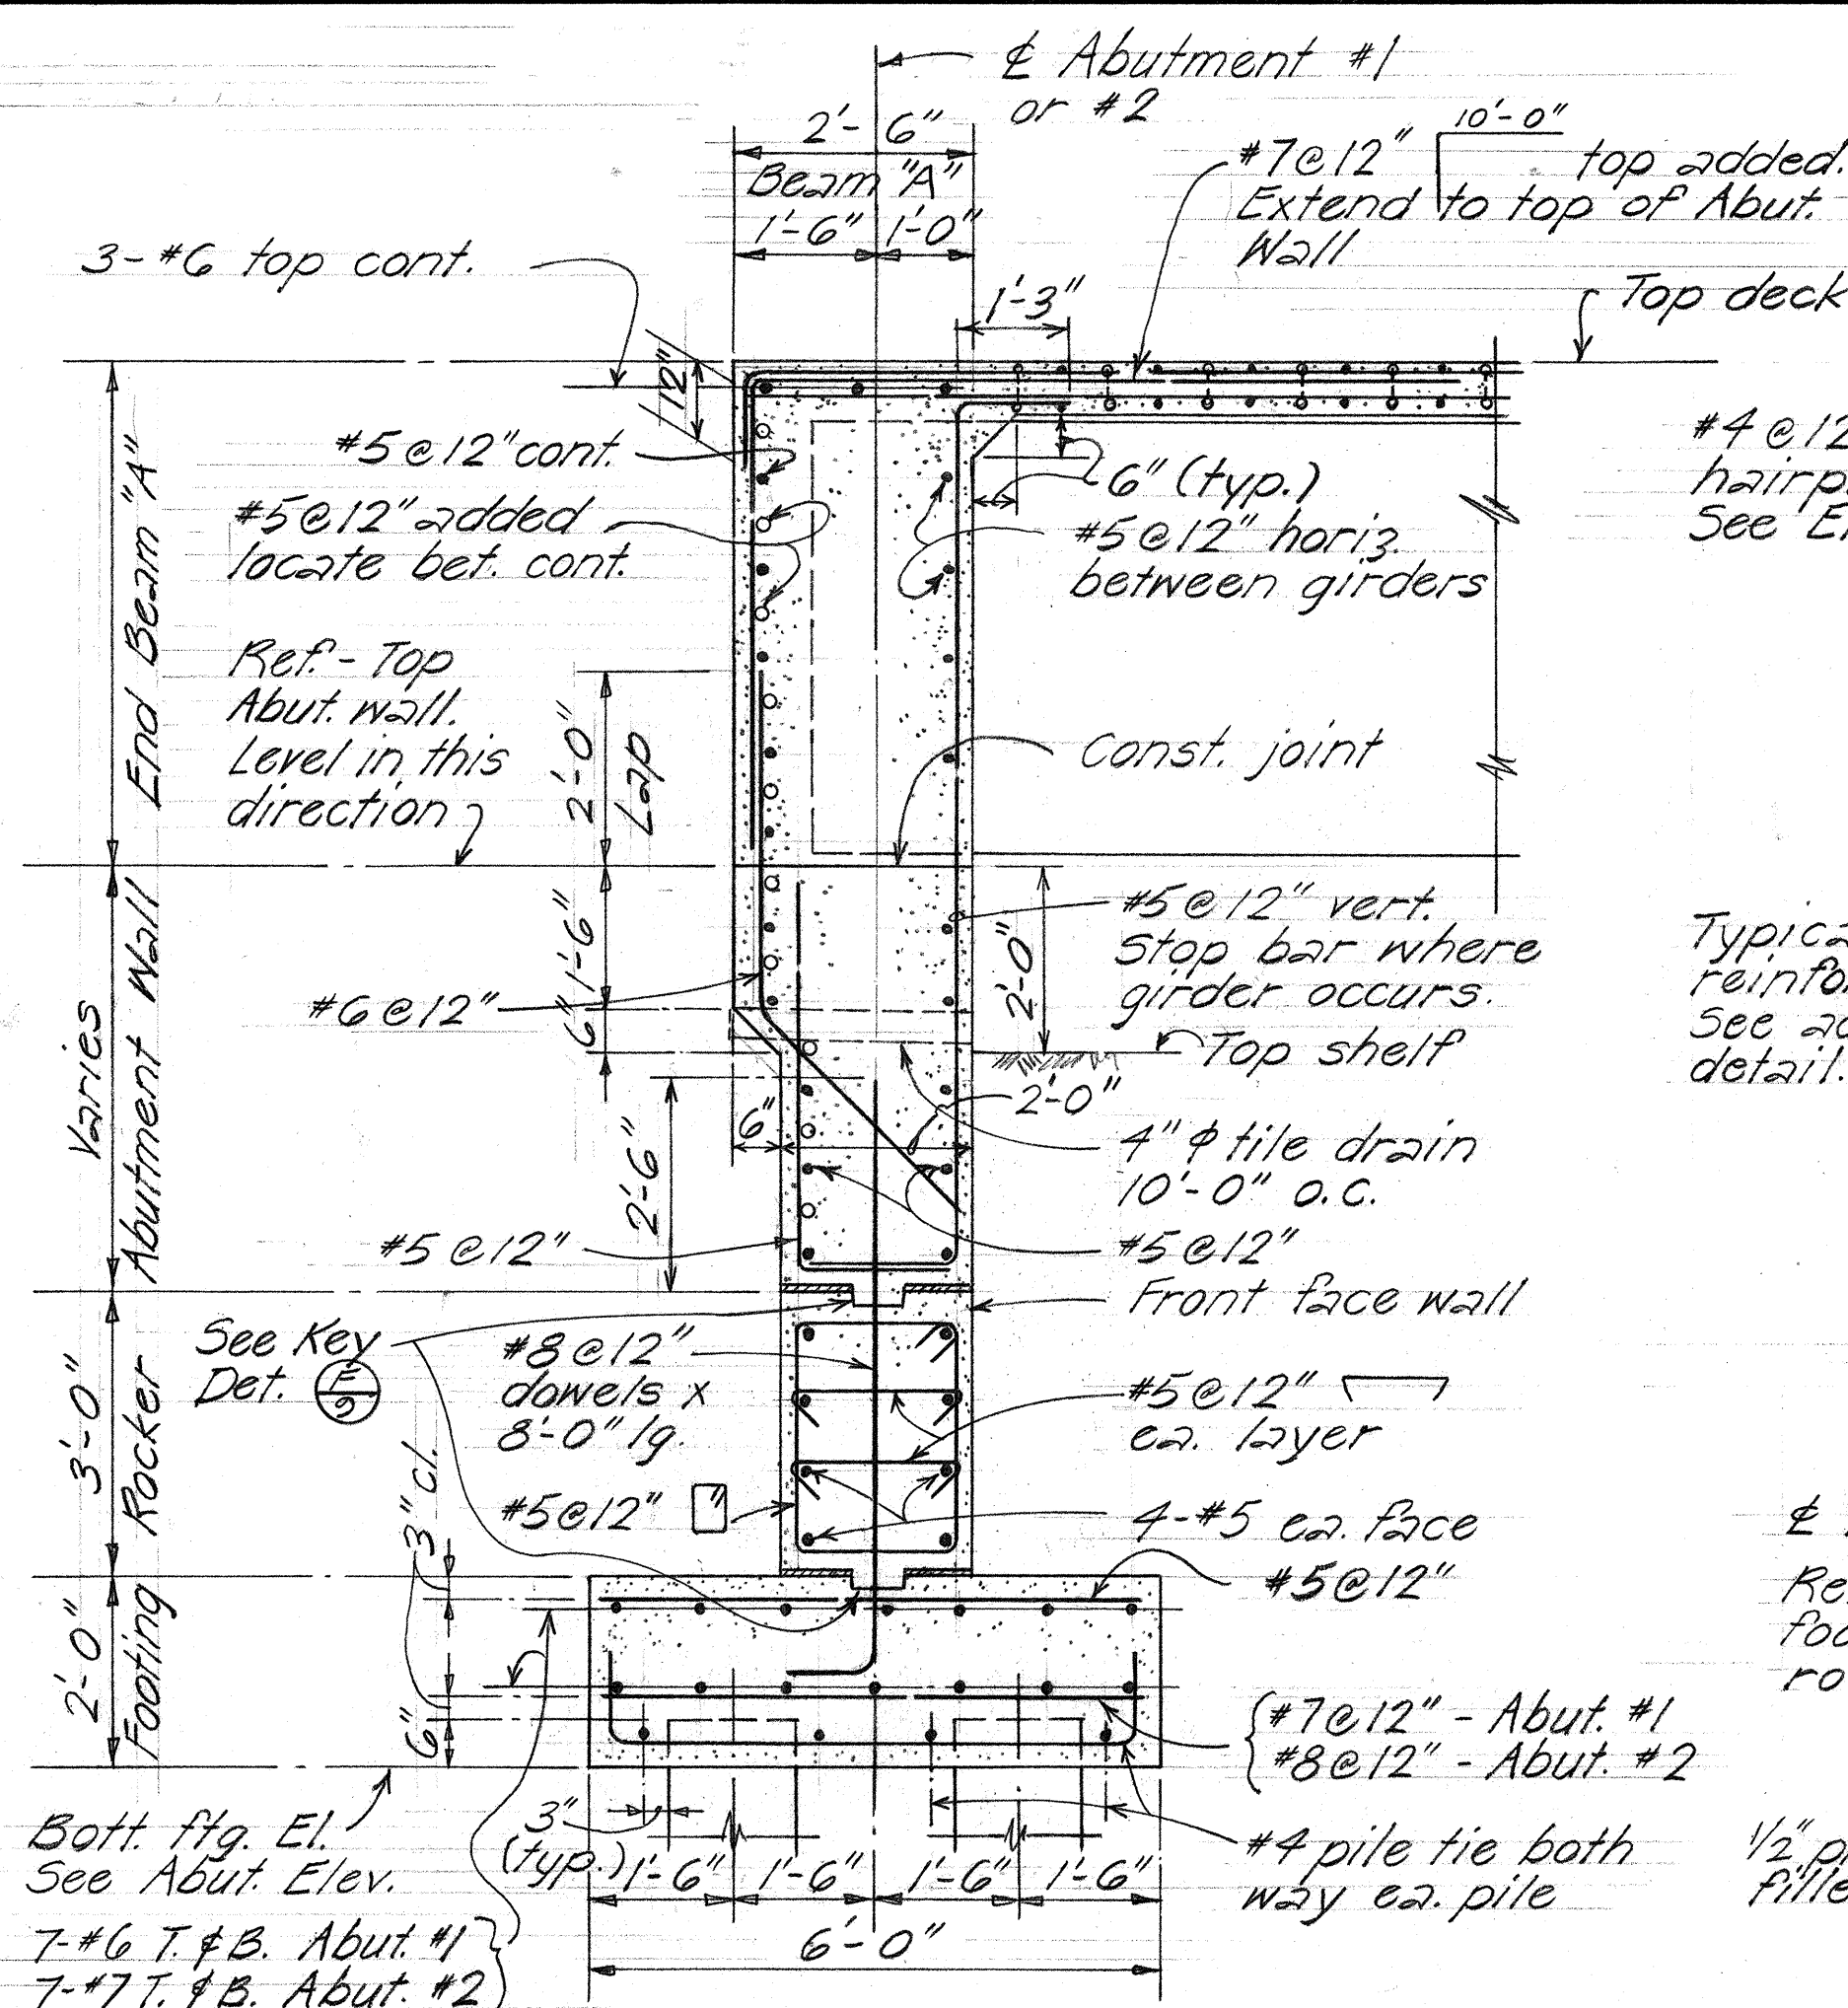


BETWEEN GIRDERS
Scale: 1/2" = 1'-0"


TYPICAL ABUTMENT SECTION (A)

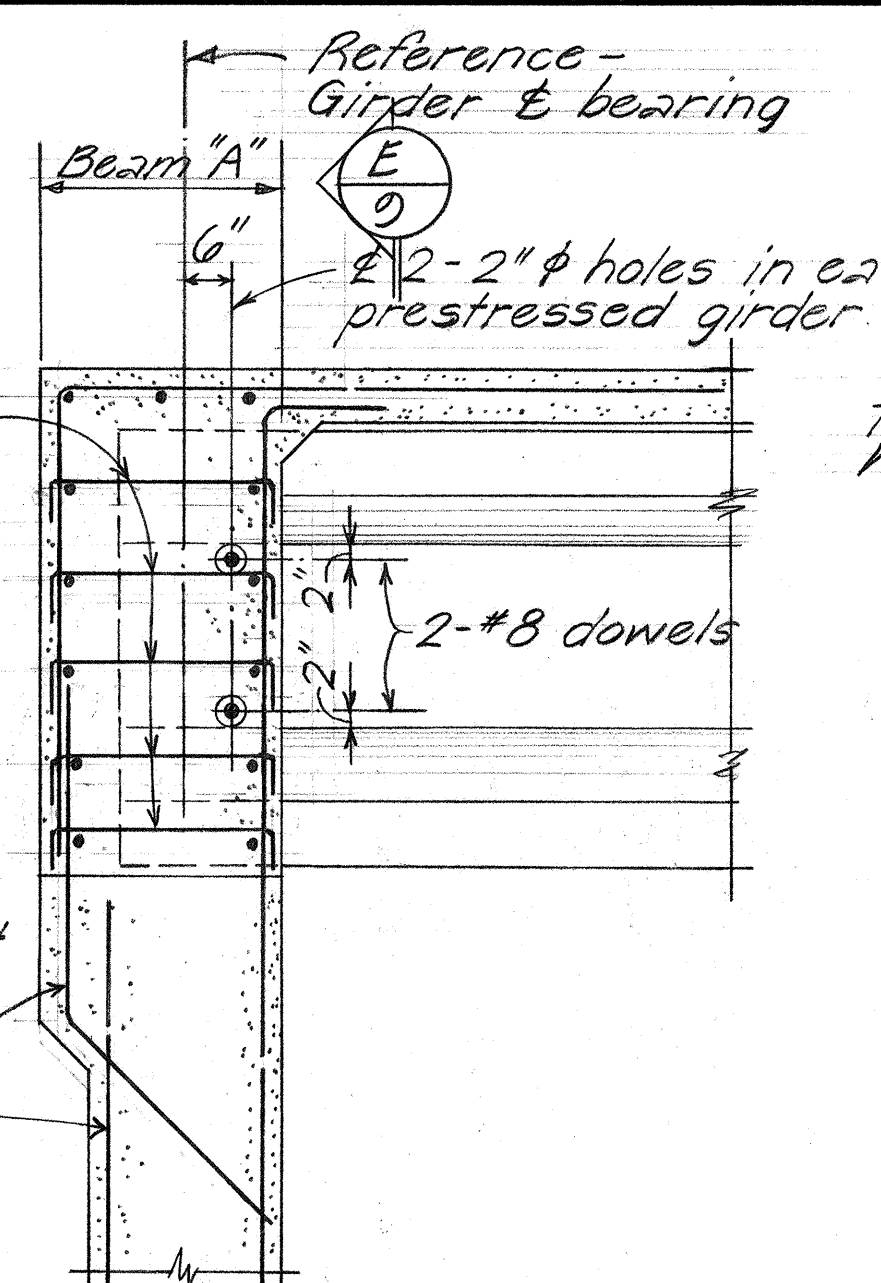

AT EACH GIRDER
Scale: 1/2" = 1'-0"

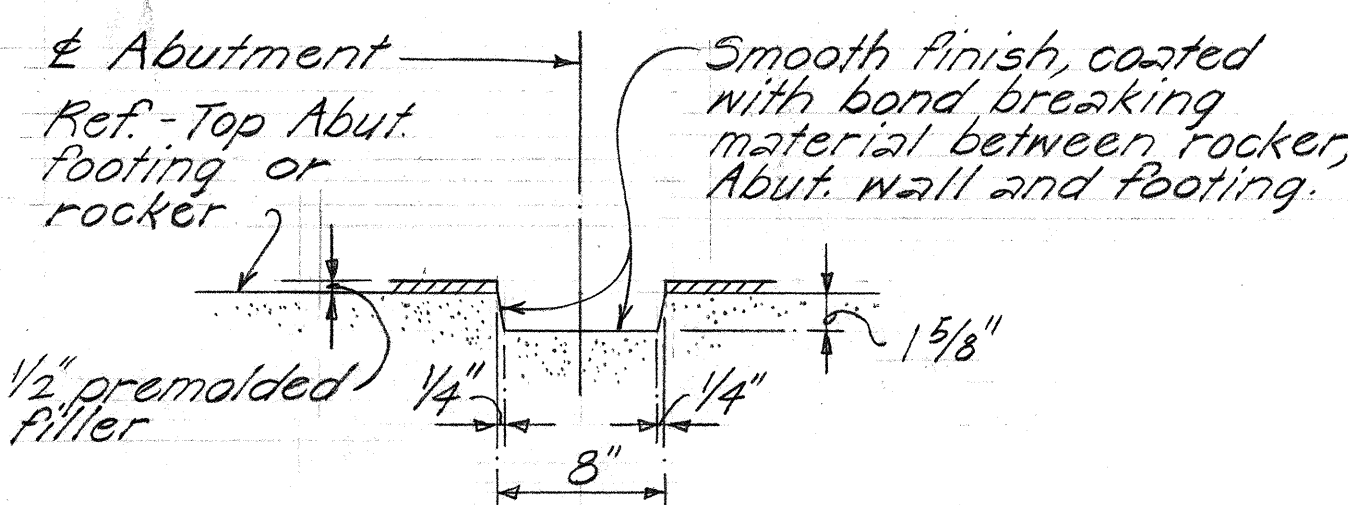


KEY DETAIL (F)
Scale: 1/2" = 1'-0"

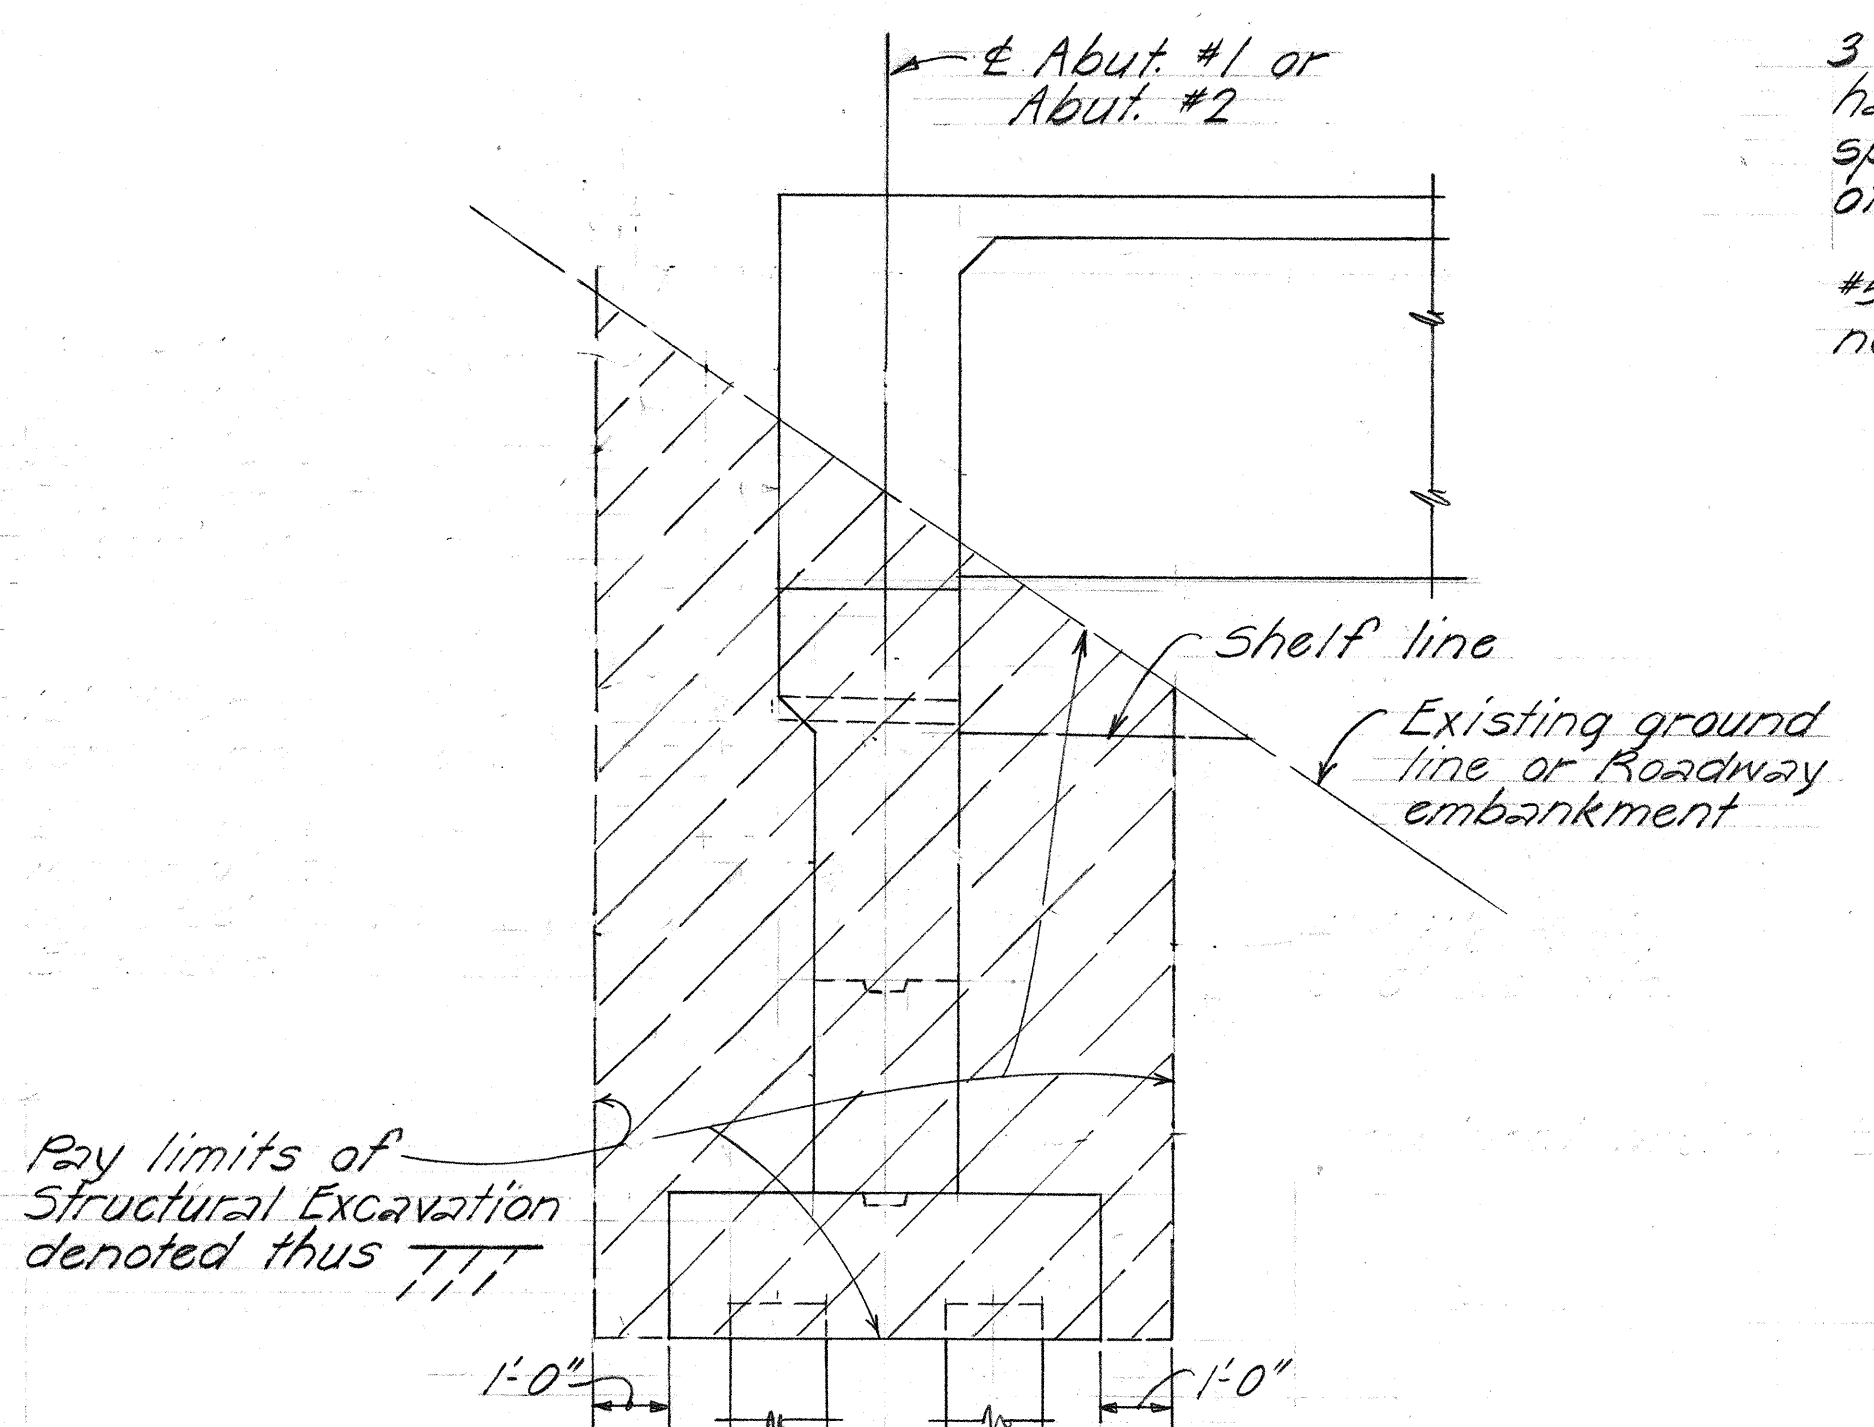


TYPICAL ABUTMENT STRUCTURE EXCAVATION

PAY LIMITS DETAIL
Not to Scale

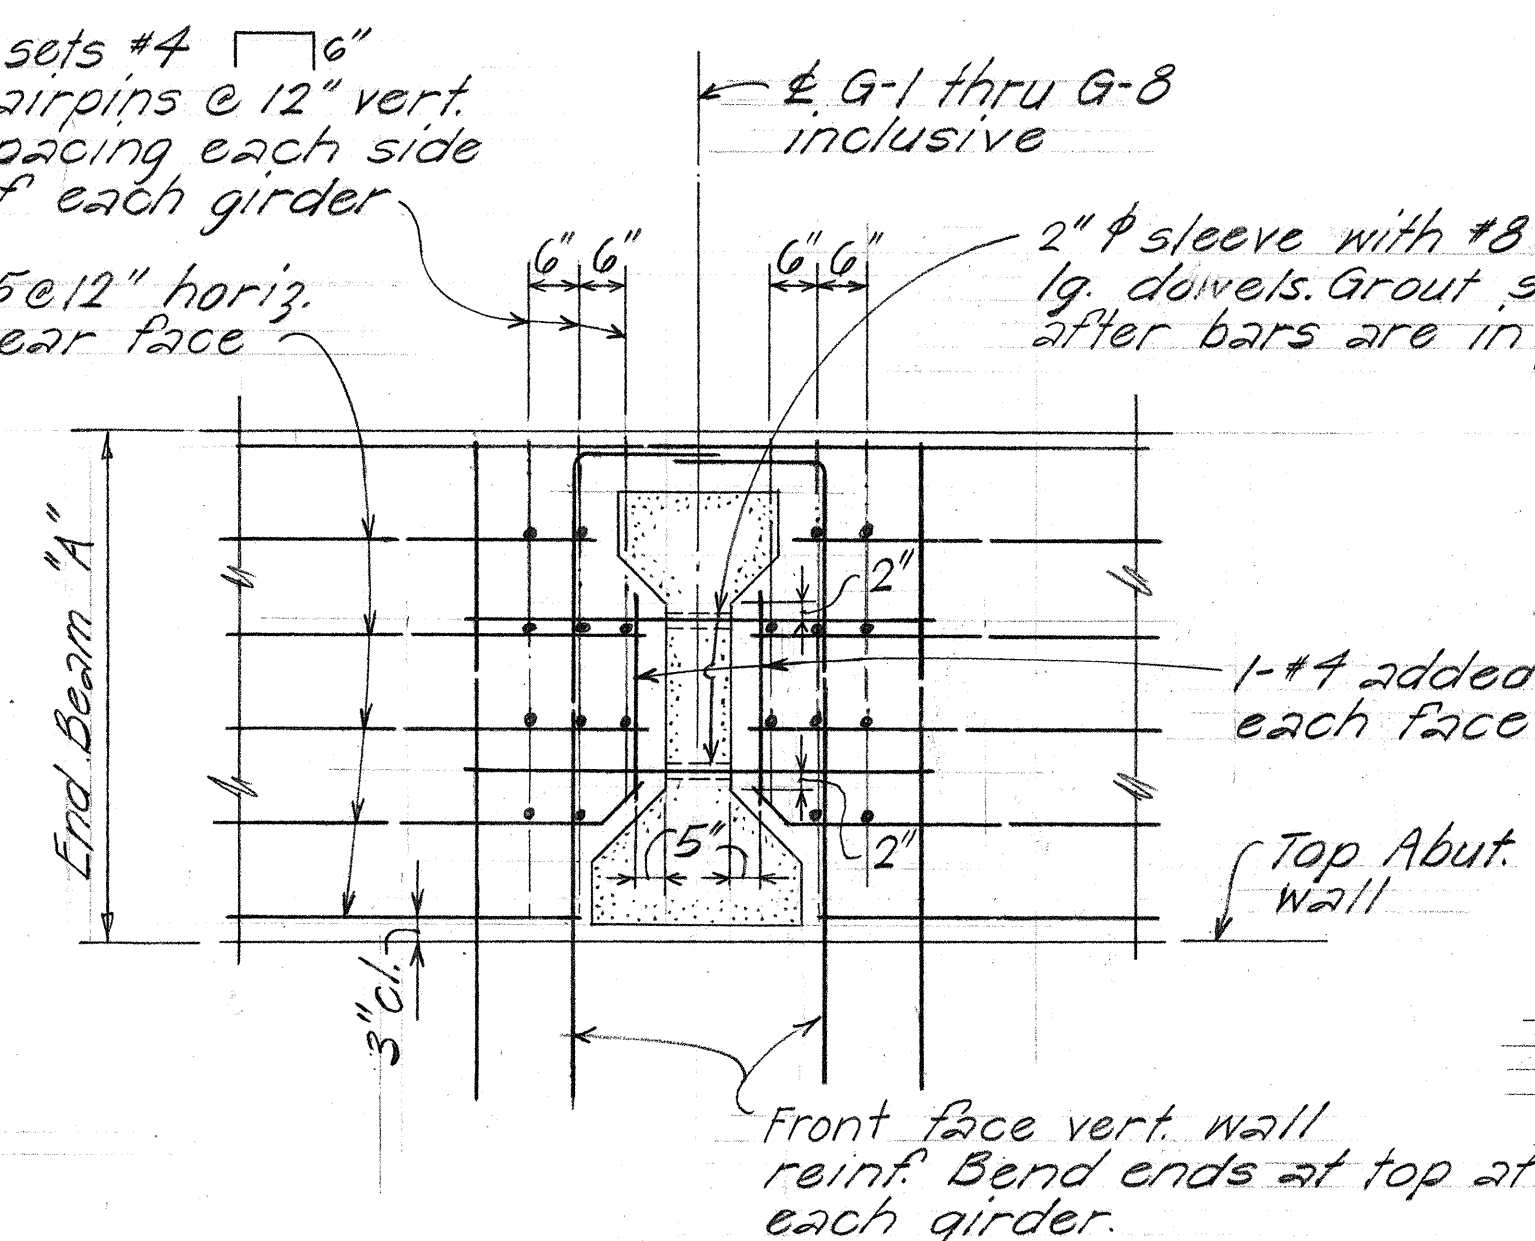


ELEVATION (E)
Scale: 1/2" = 1'-0"

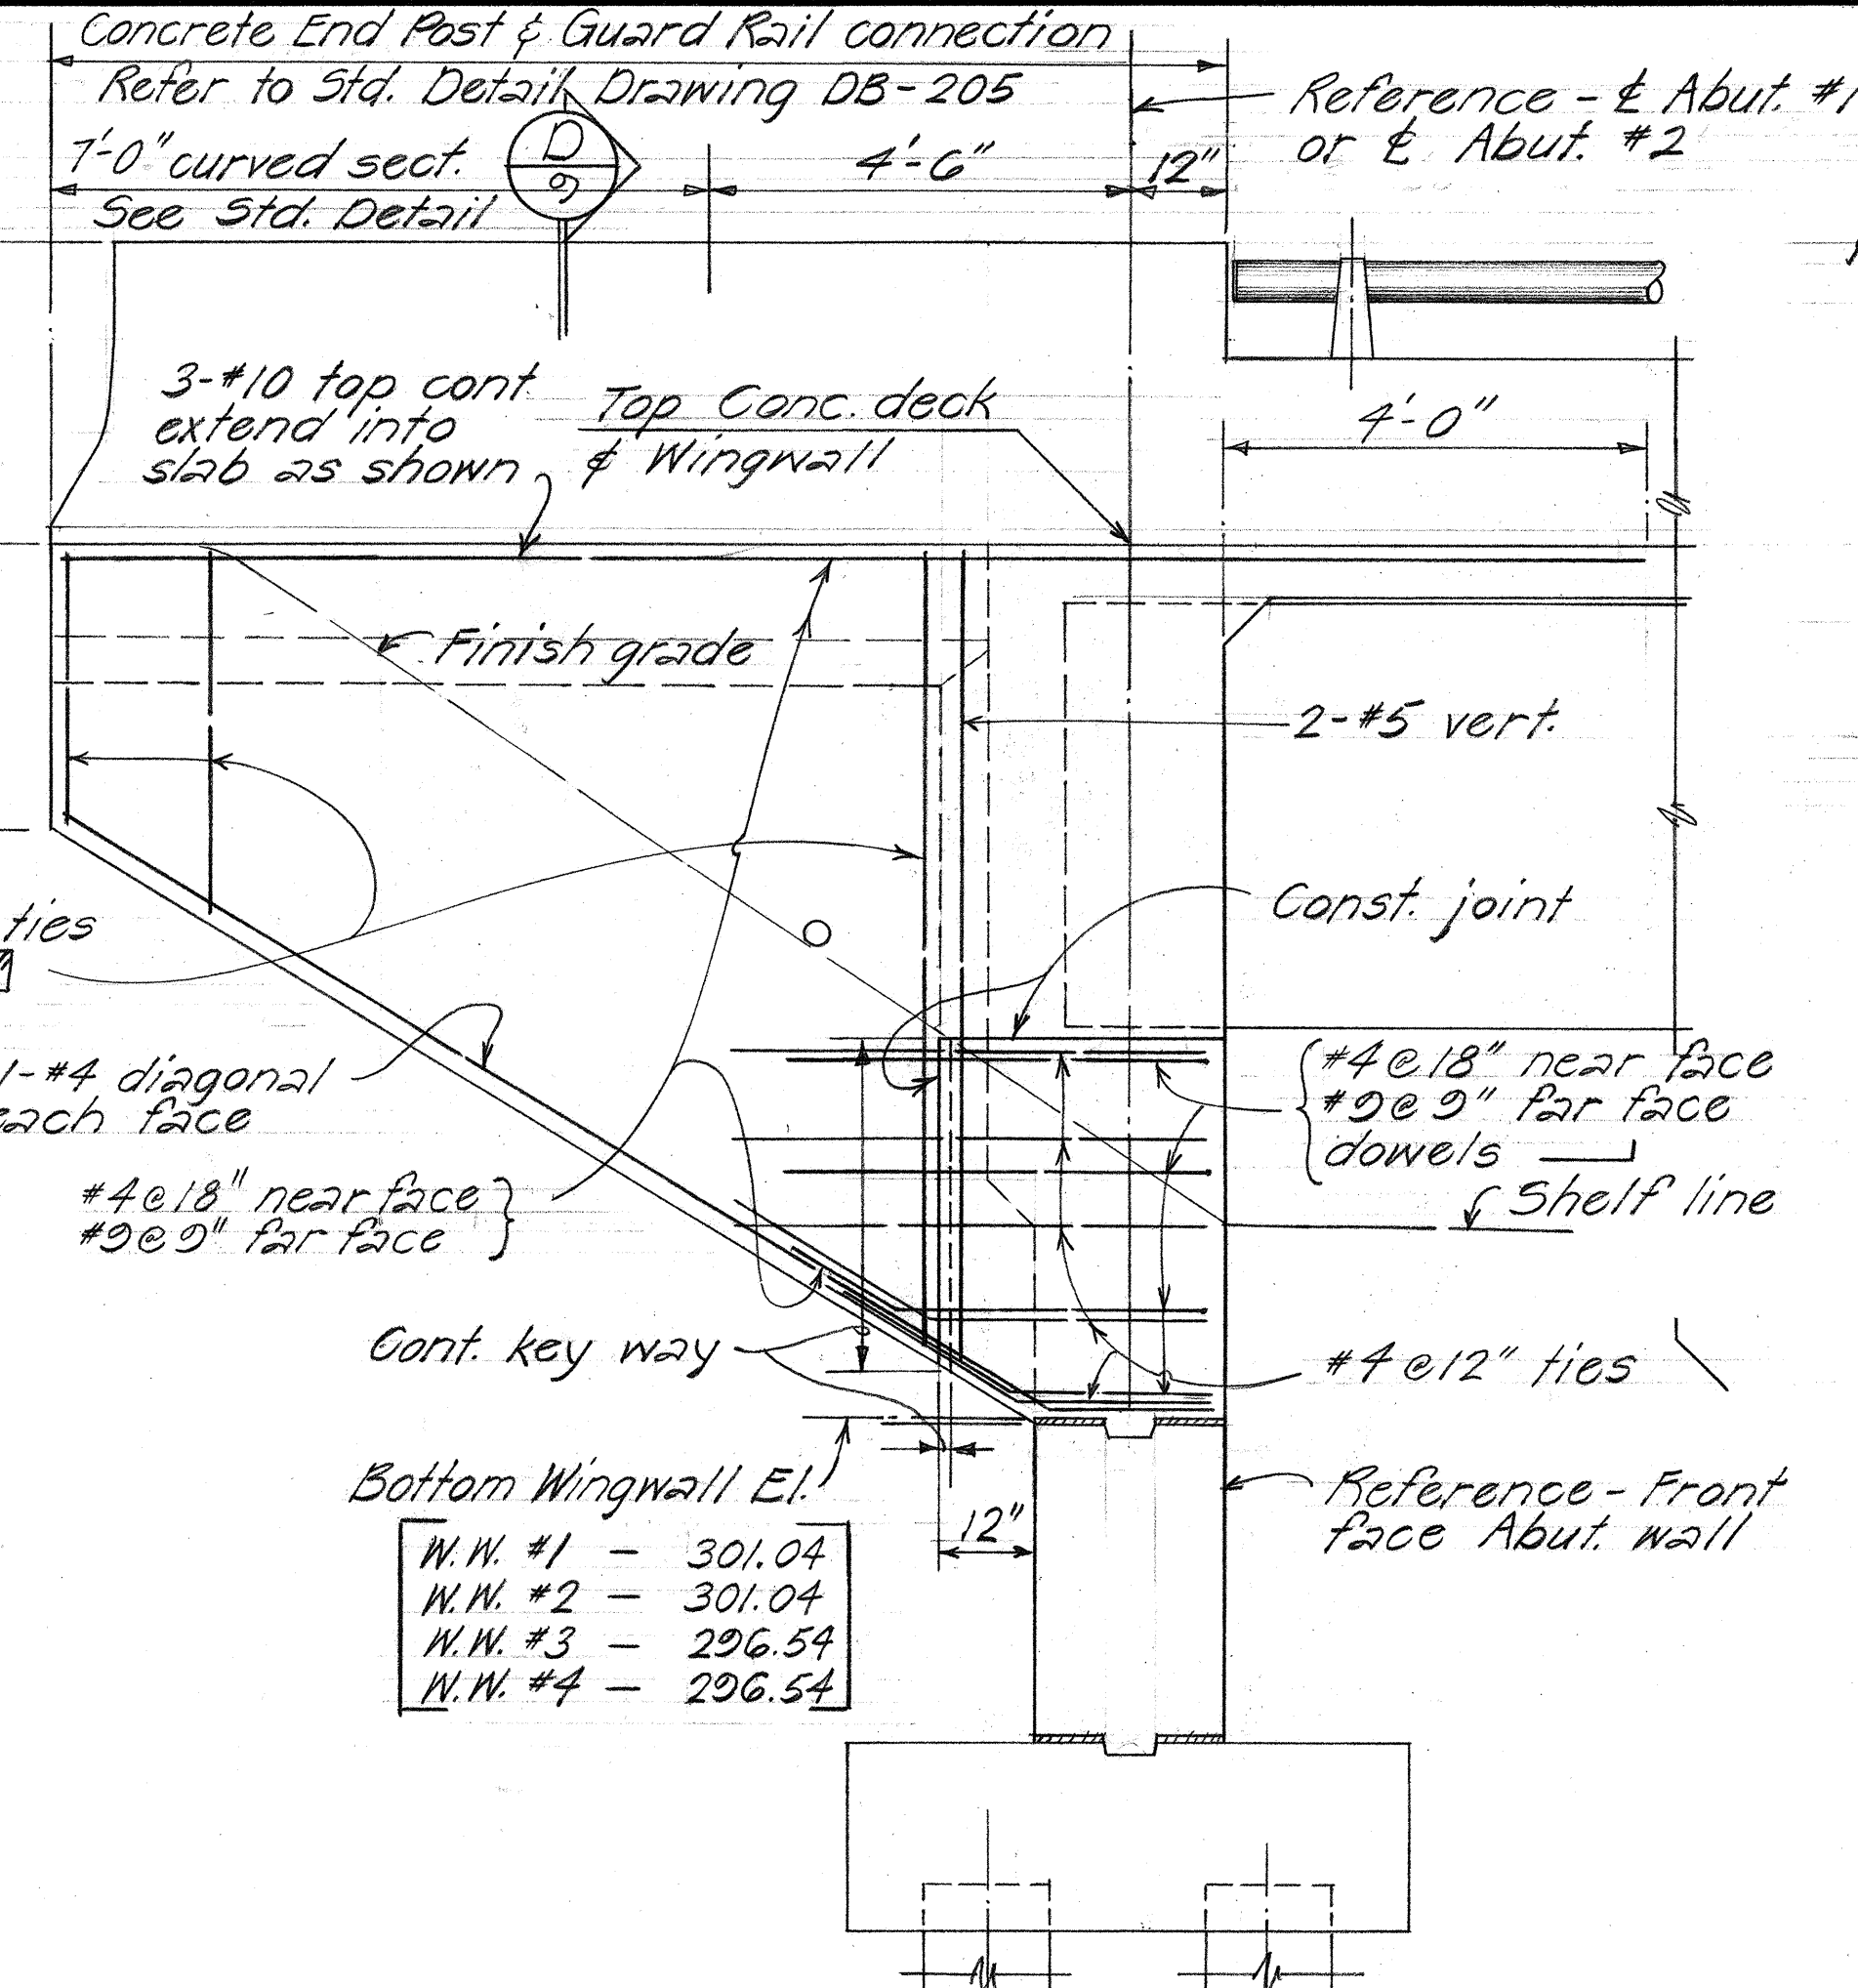


ELEVATION - TYPICAL ABUTMENT WINGWALL (B)

(C) SIMILAR EXCEPT OPPOSITE HAND
Scale: 1/2" = 1'-0"

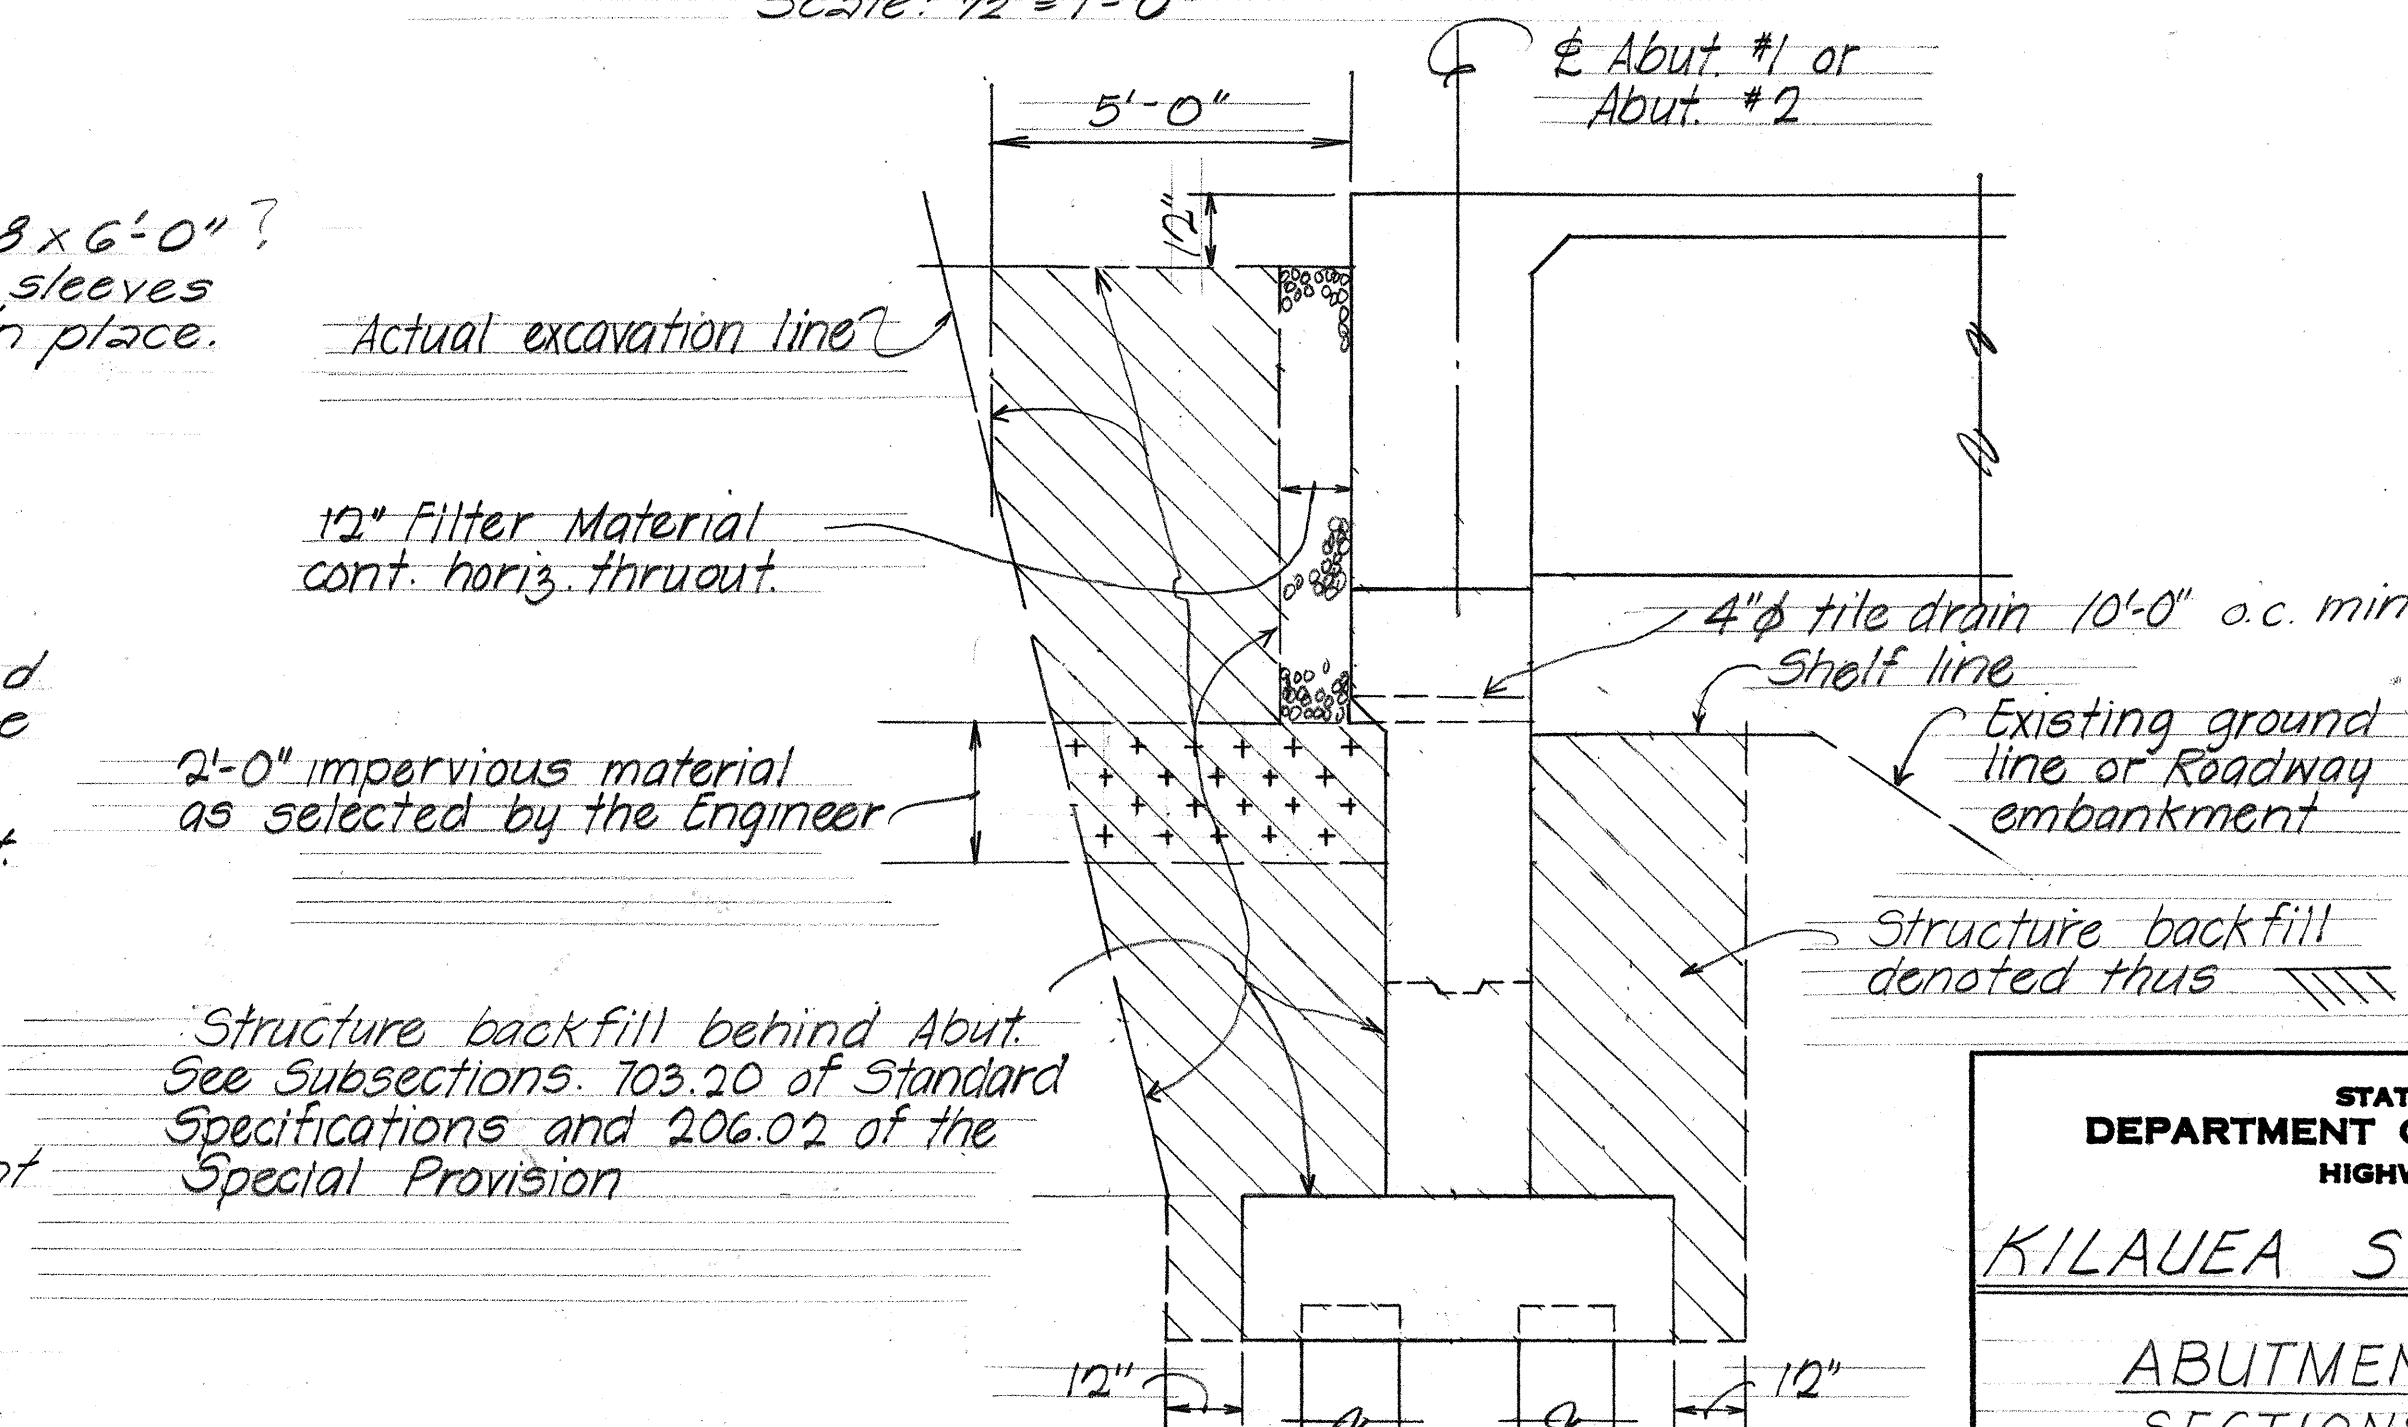



BACKFILL PAY LIMITS DETAIL (D)
Not to Scale

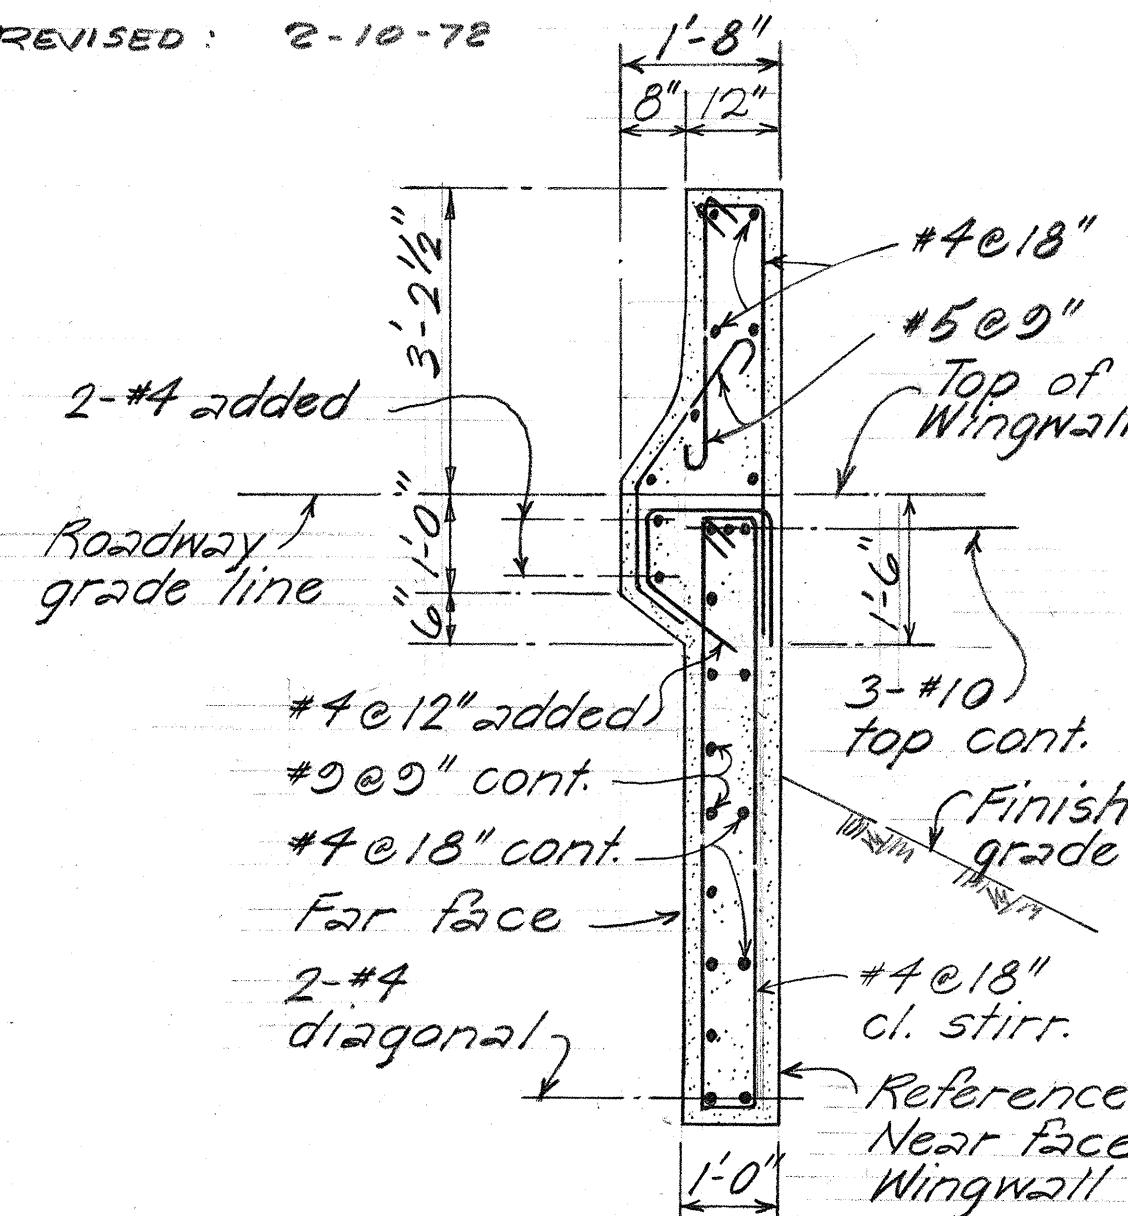

SECTION (D)
Scale: 1/2" = 1'-0"

STATE OF HAWAII
DEPARTMENT OF TRANSPORTATION
HIGHWAYS DIVISION
KILAUEA STREAM BRIDGE
ABUTMENT #1 & #2
SECTIONS & DETAILS
Proj. No RF-056-1(10) Apr. 1971
SHEET No. 9 OF 11 SHEETS

FED. ROAD DIST. NO.	STATE	FED. AID PROJ. NO.	FISCAL YEAR	SHEET NO.	TOTAL SHEETS
HAWAII	HAW.	RF-056-1(10)	1971	46	74

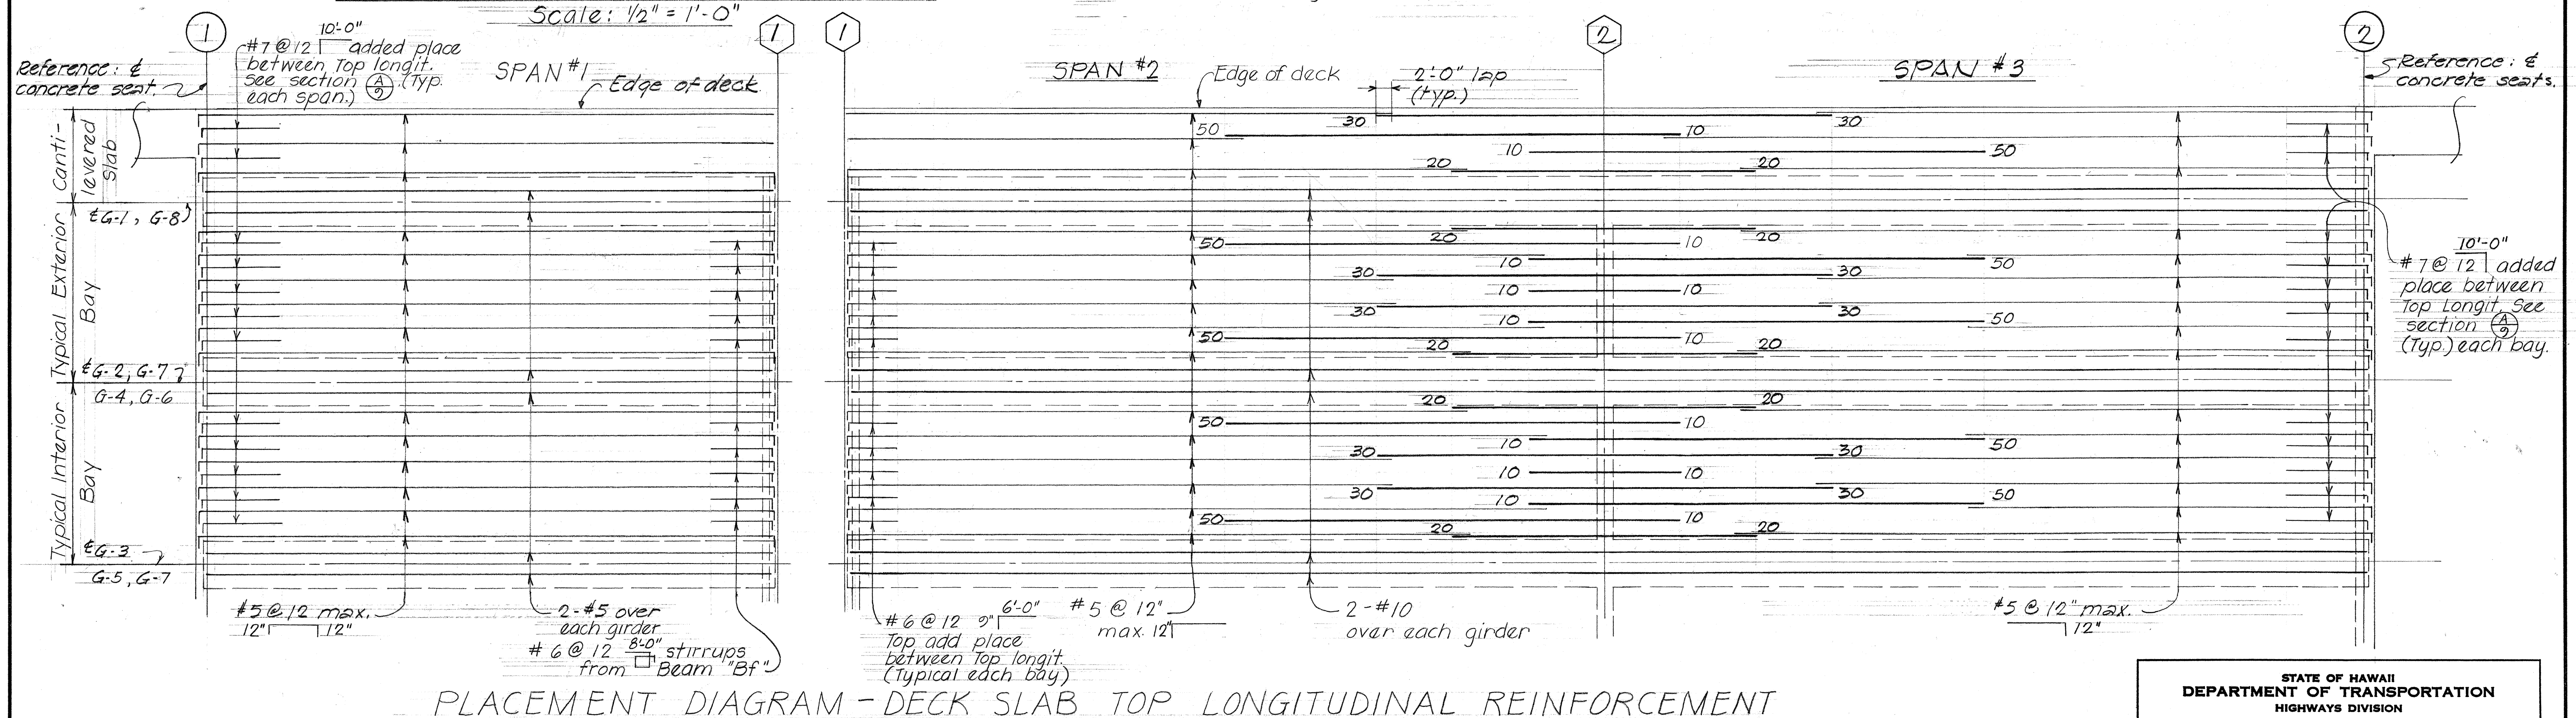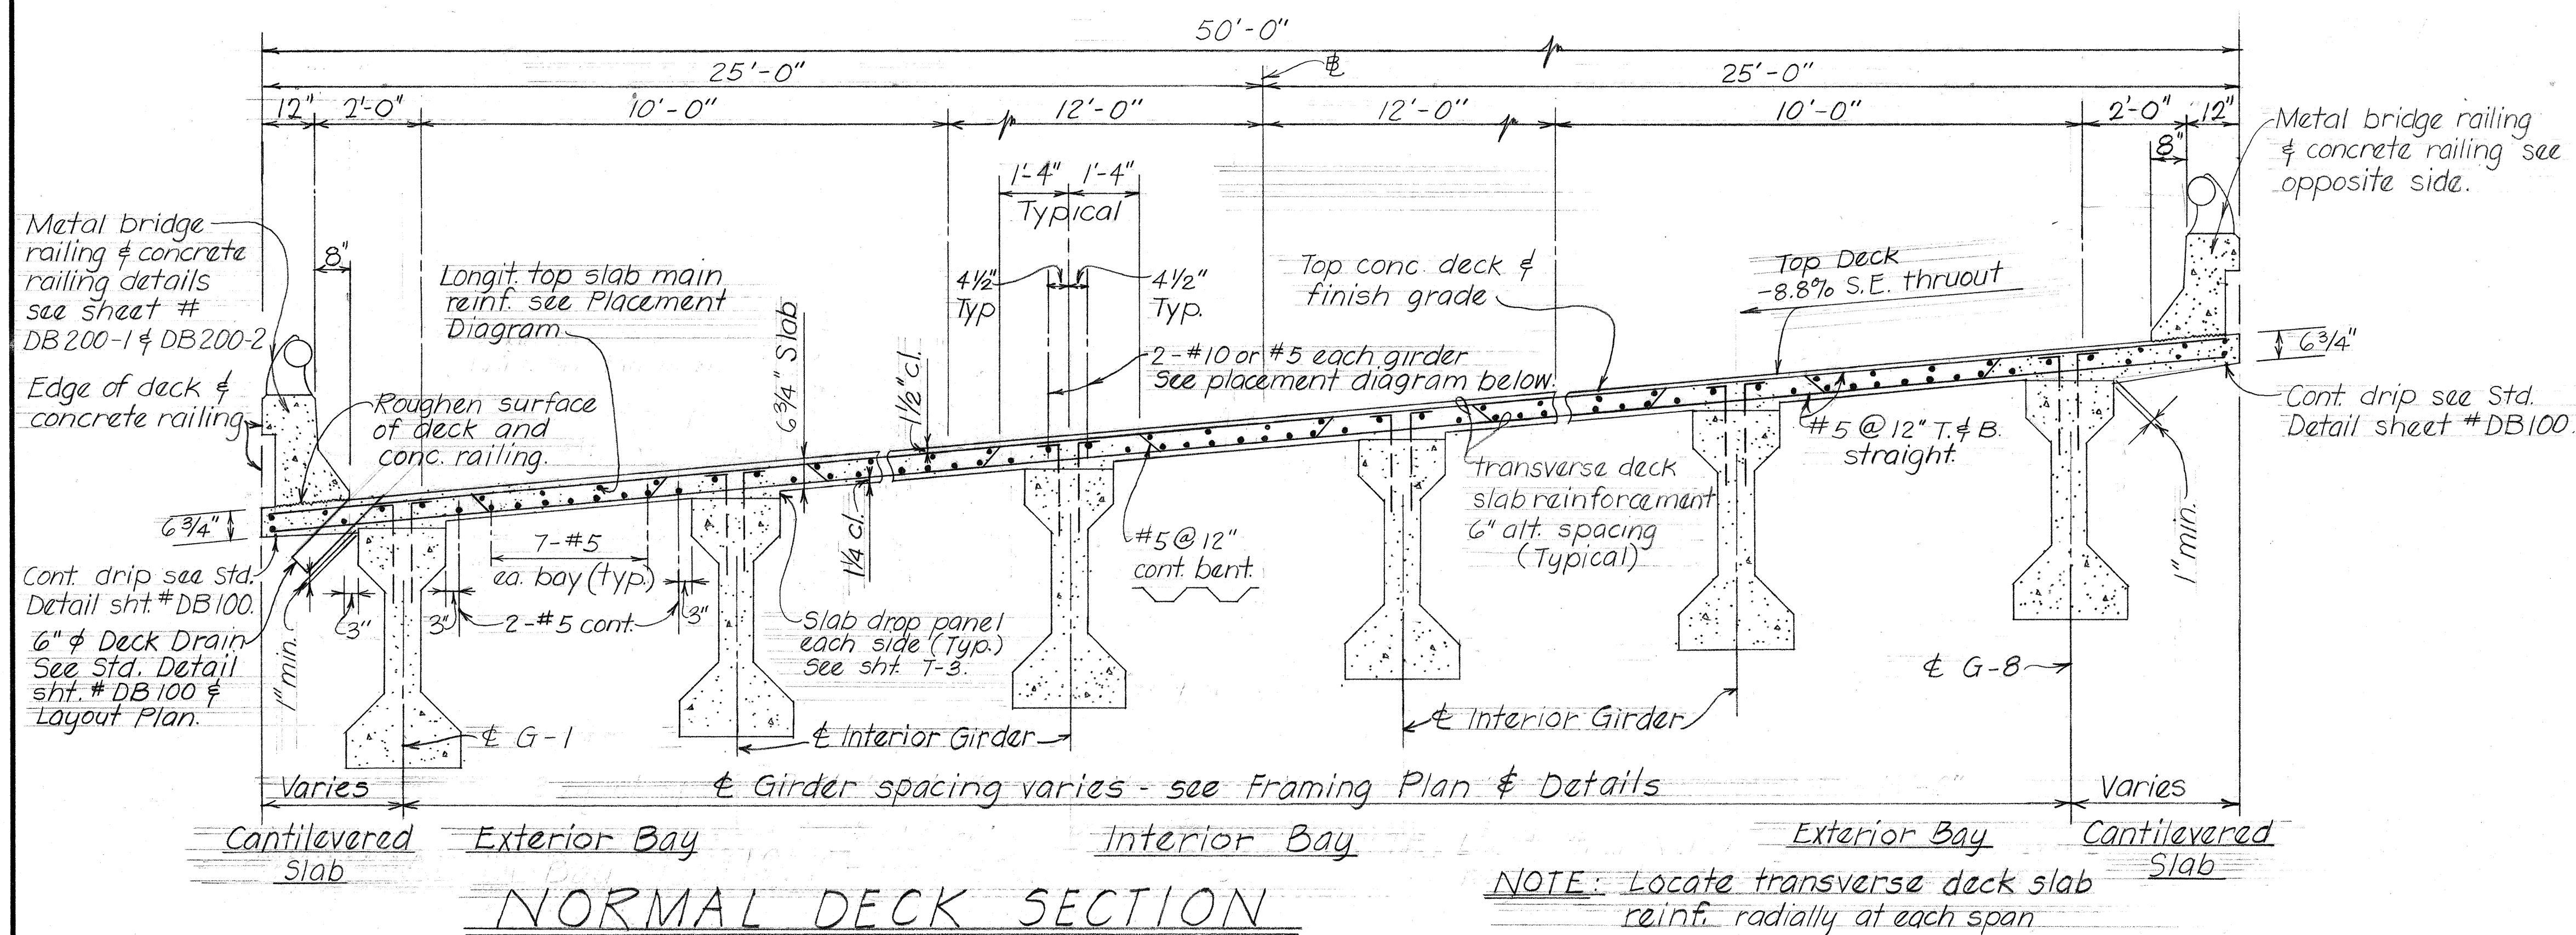

NOTES:

All reinforcement in diagram are #10 except as otherwise noted.

Numbers at ends of bars indicate distance in feet from corresponding pier line (2).

For additional top reinforcement see normal section & corresponding details.

All #5 @ 12" max. bars shall be extended and lapped with the adjacent #10 bars as shown.

Scale : Vertical - $\frac{3}{8}" = 1'-0"$
Horizontal - $1" = 10'-0"$


**STATE OF HAWAII
DEPARTMENT OF TRANSPORTATION
HIGHWAYS DIVISION**

KILAUEA STREAM BRIDGE
NORMAL DECK SECTION
& DETAILS

Proj. № RF-056-1(10) Apr. 1971


SHEET No. 10 OF 11 SHEETS

FED. ROAD DIST. NO.	STATE	FED. AID PROJ. NO.	FISCAL YEAR	SHEET NO.	TOTAL SHEETS
HAWAII	HAW.	RF-056-1(10)	1971	47	74

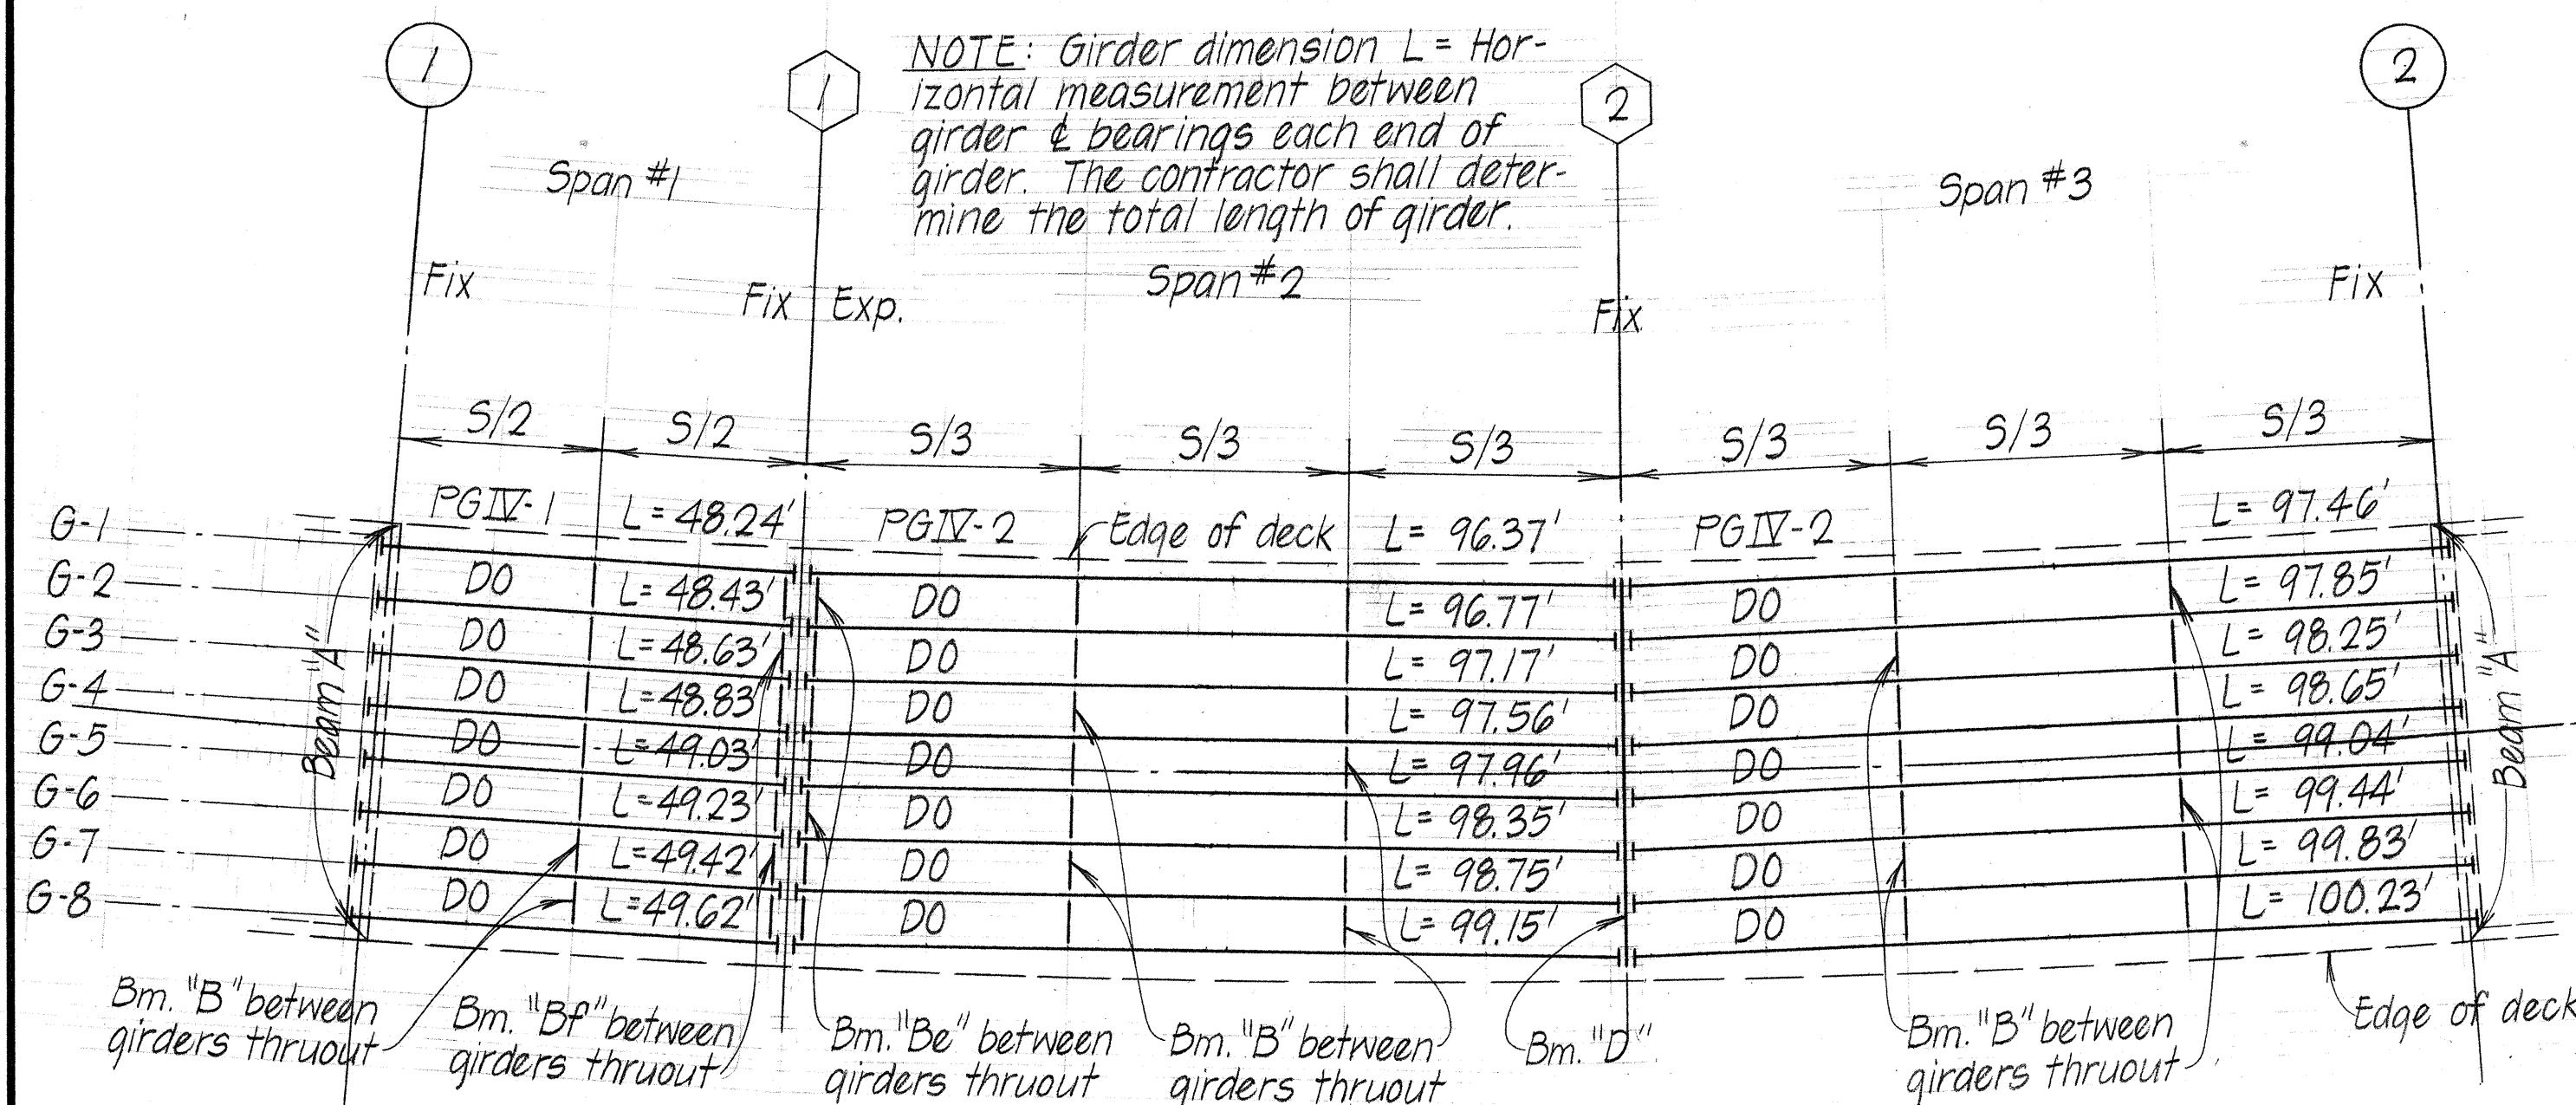


DECK FRAMING PLAN

Scale: 1" = 20'-0"

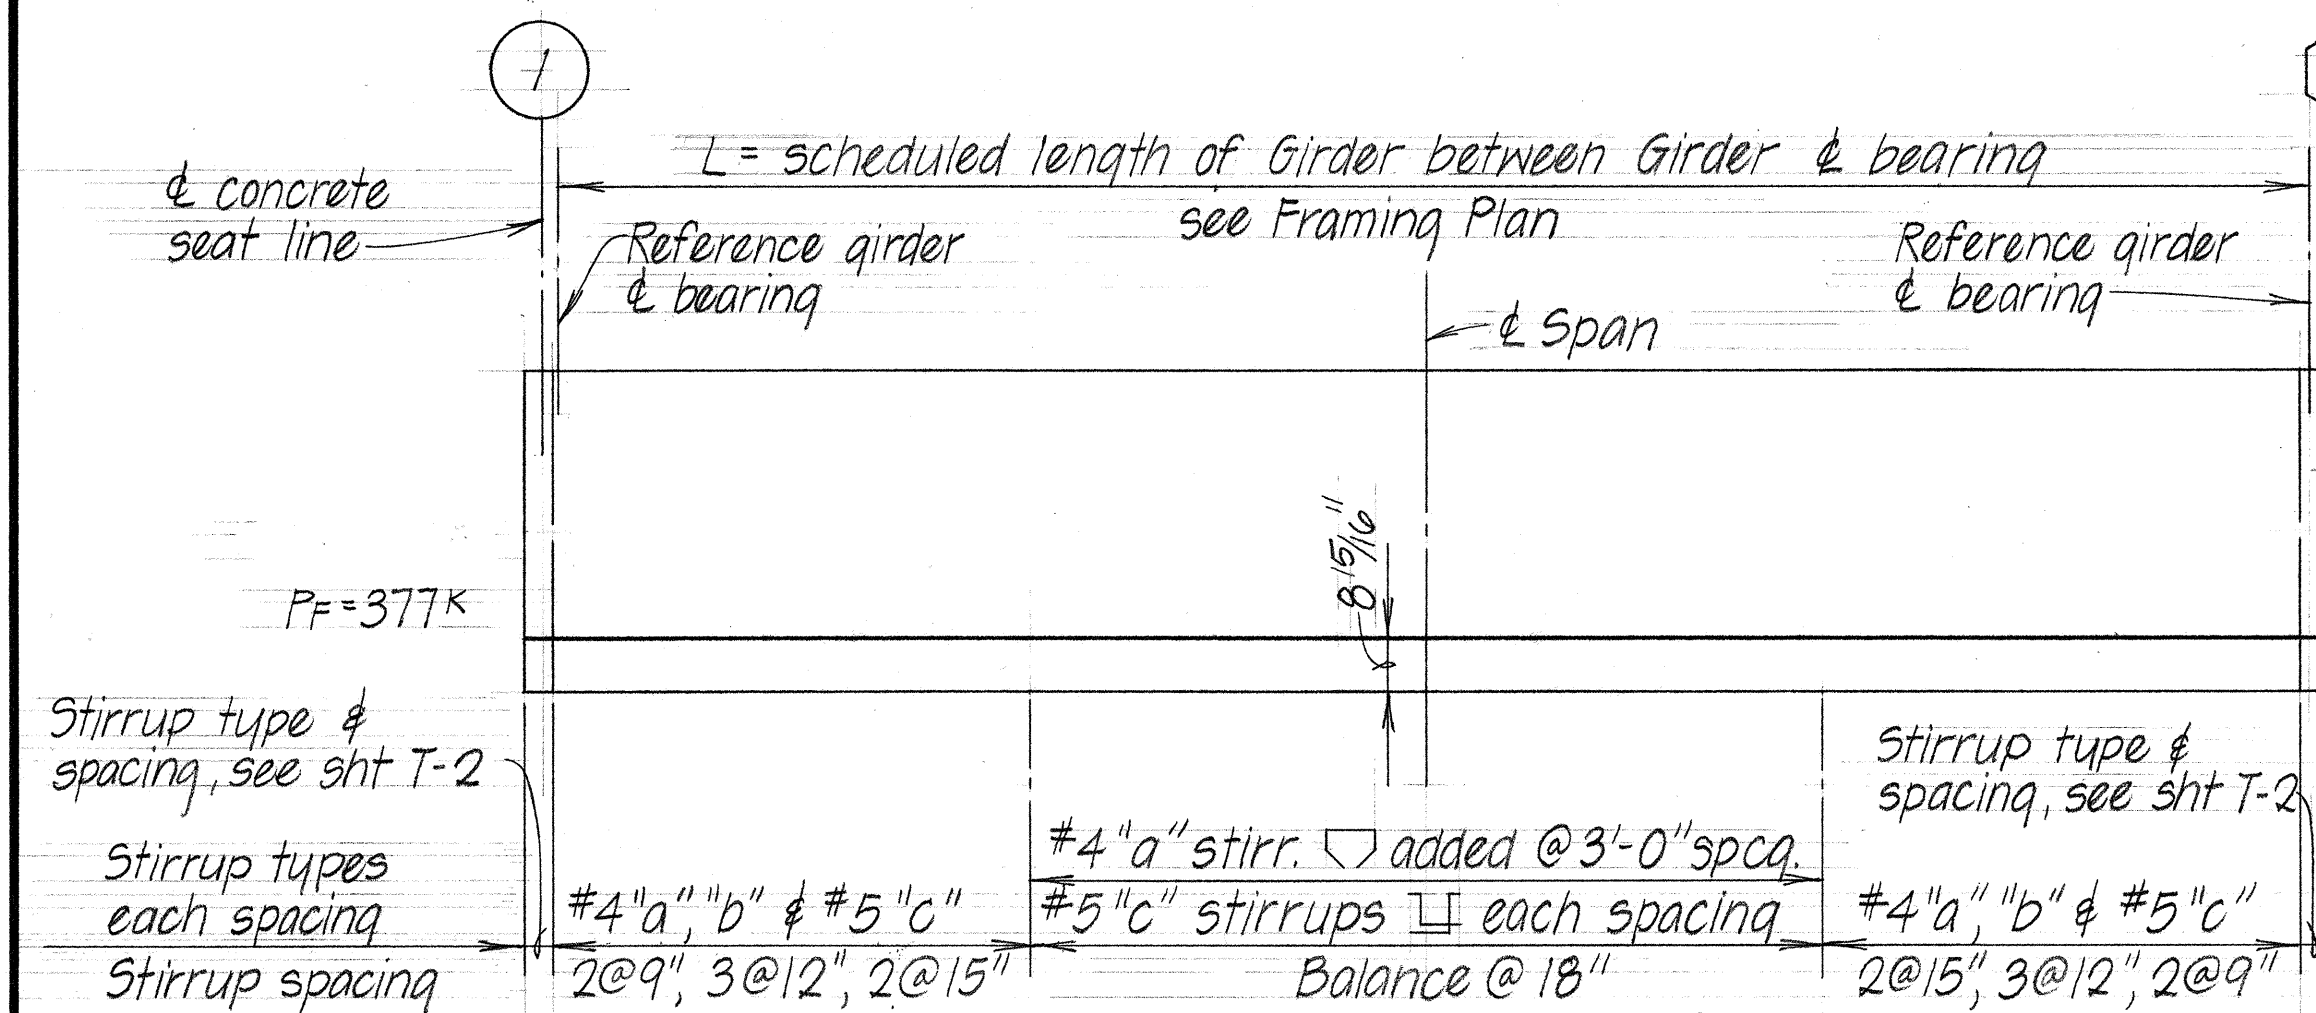


TYPICAL TYPE PGIV-1 GIRDER DETAILS

Not to Scale

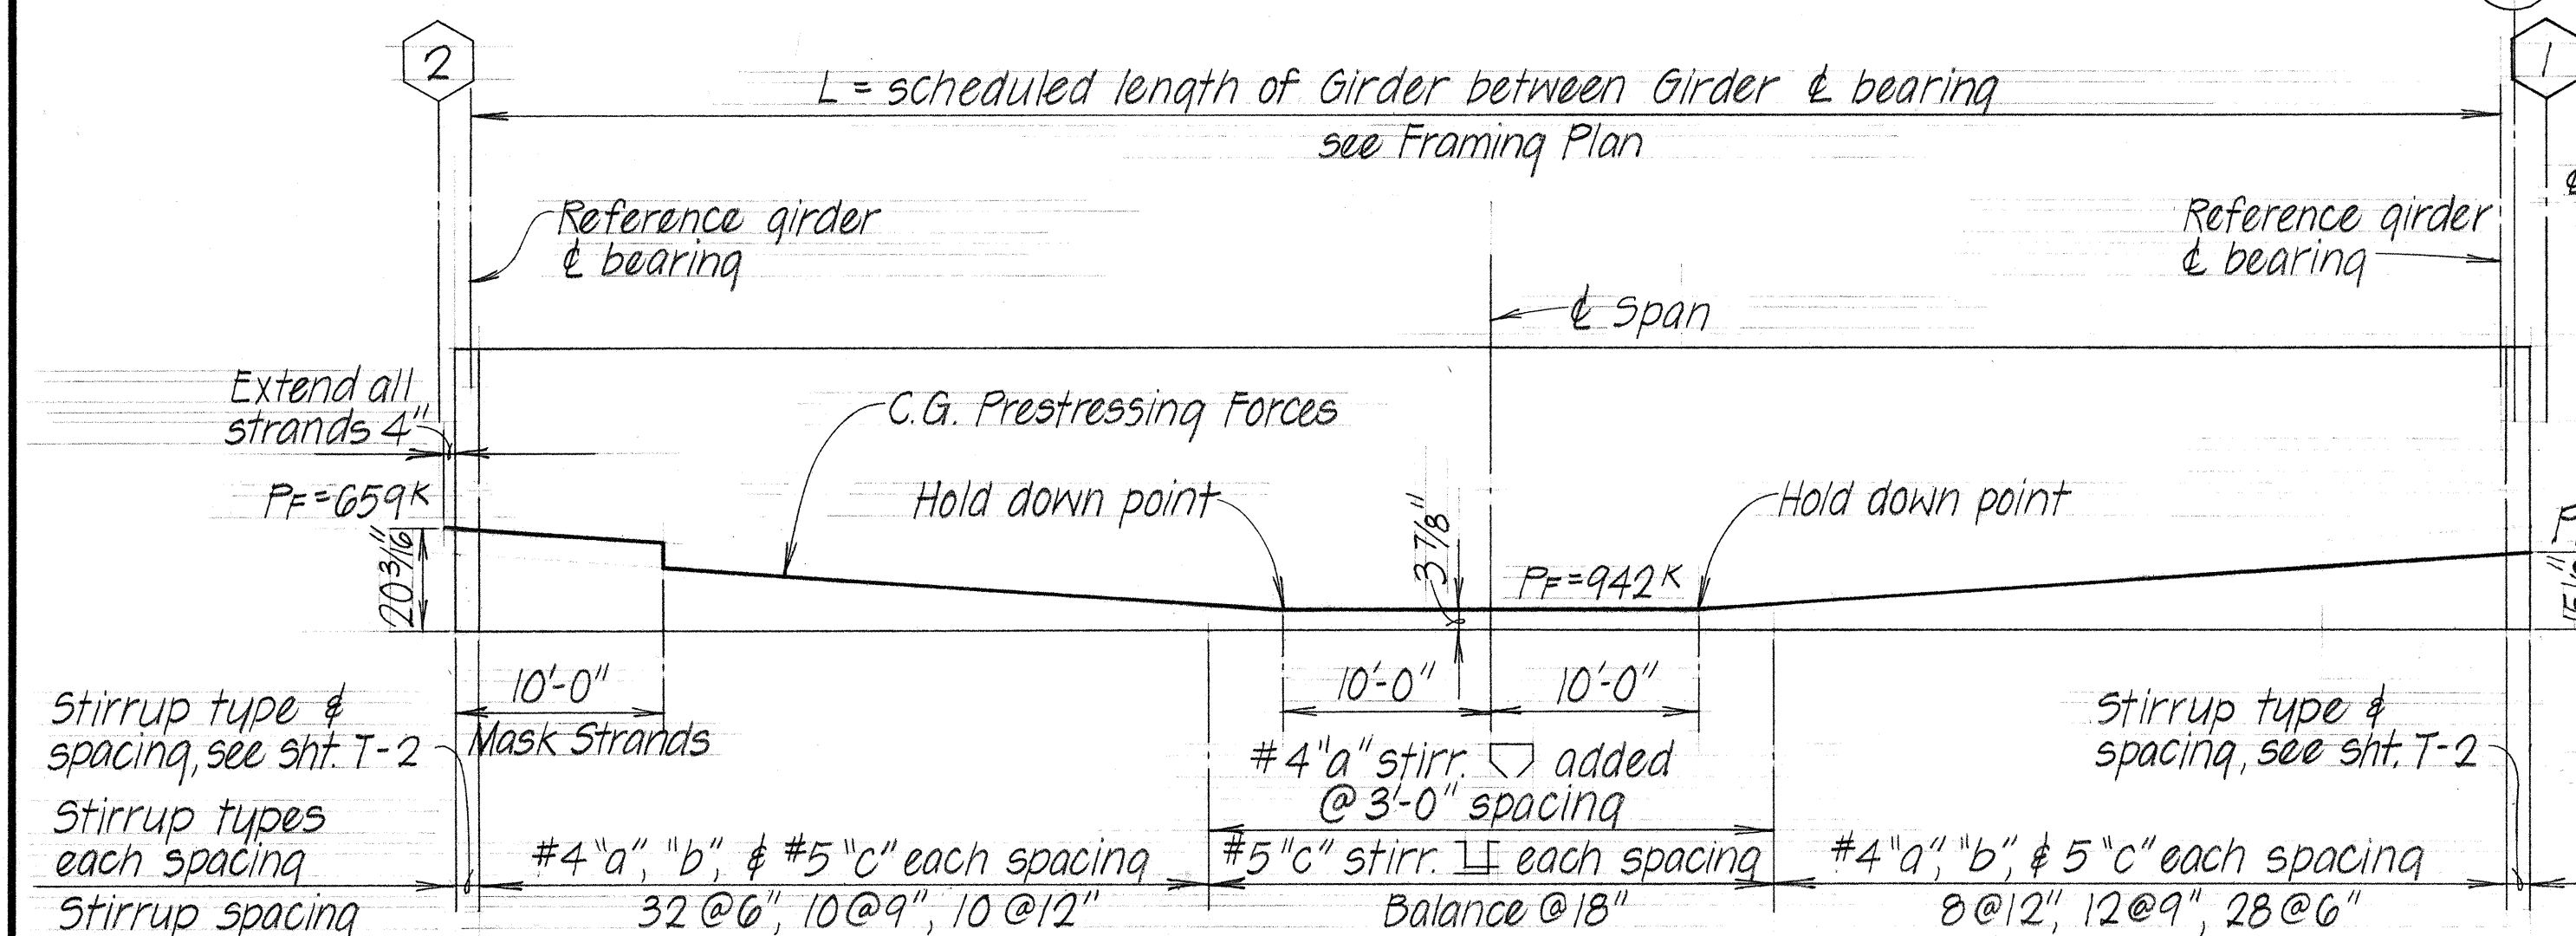


TYPICAL TYPE PGIV-2 GIRDER DETAILS

Not to Scale

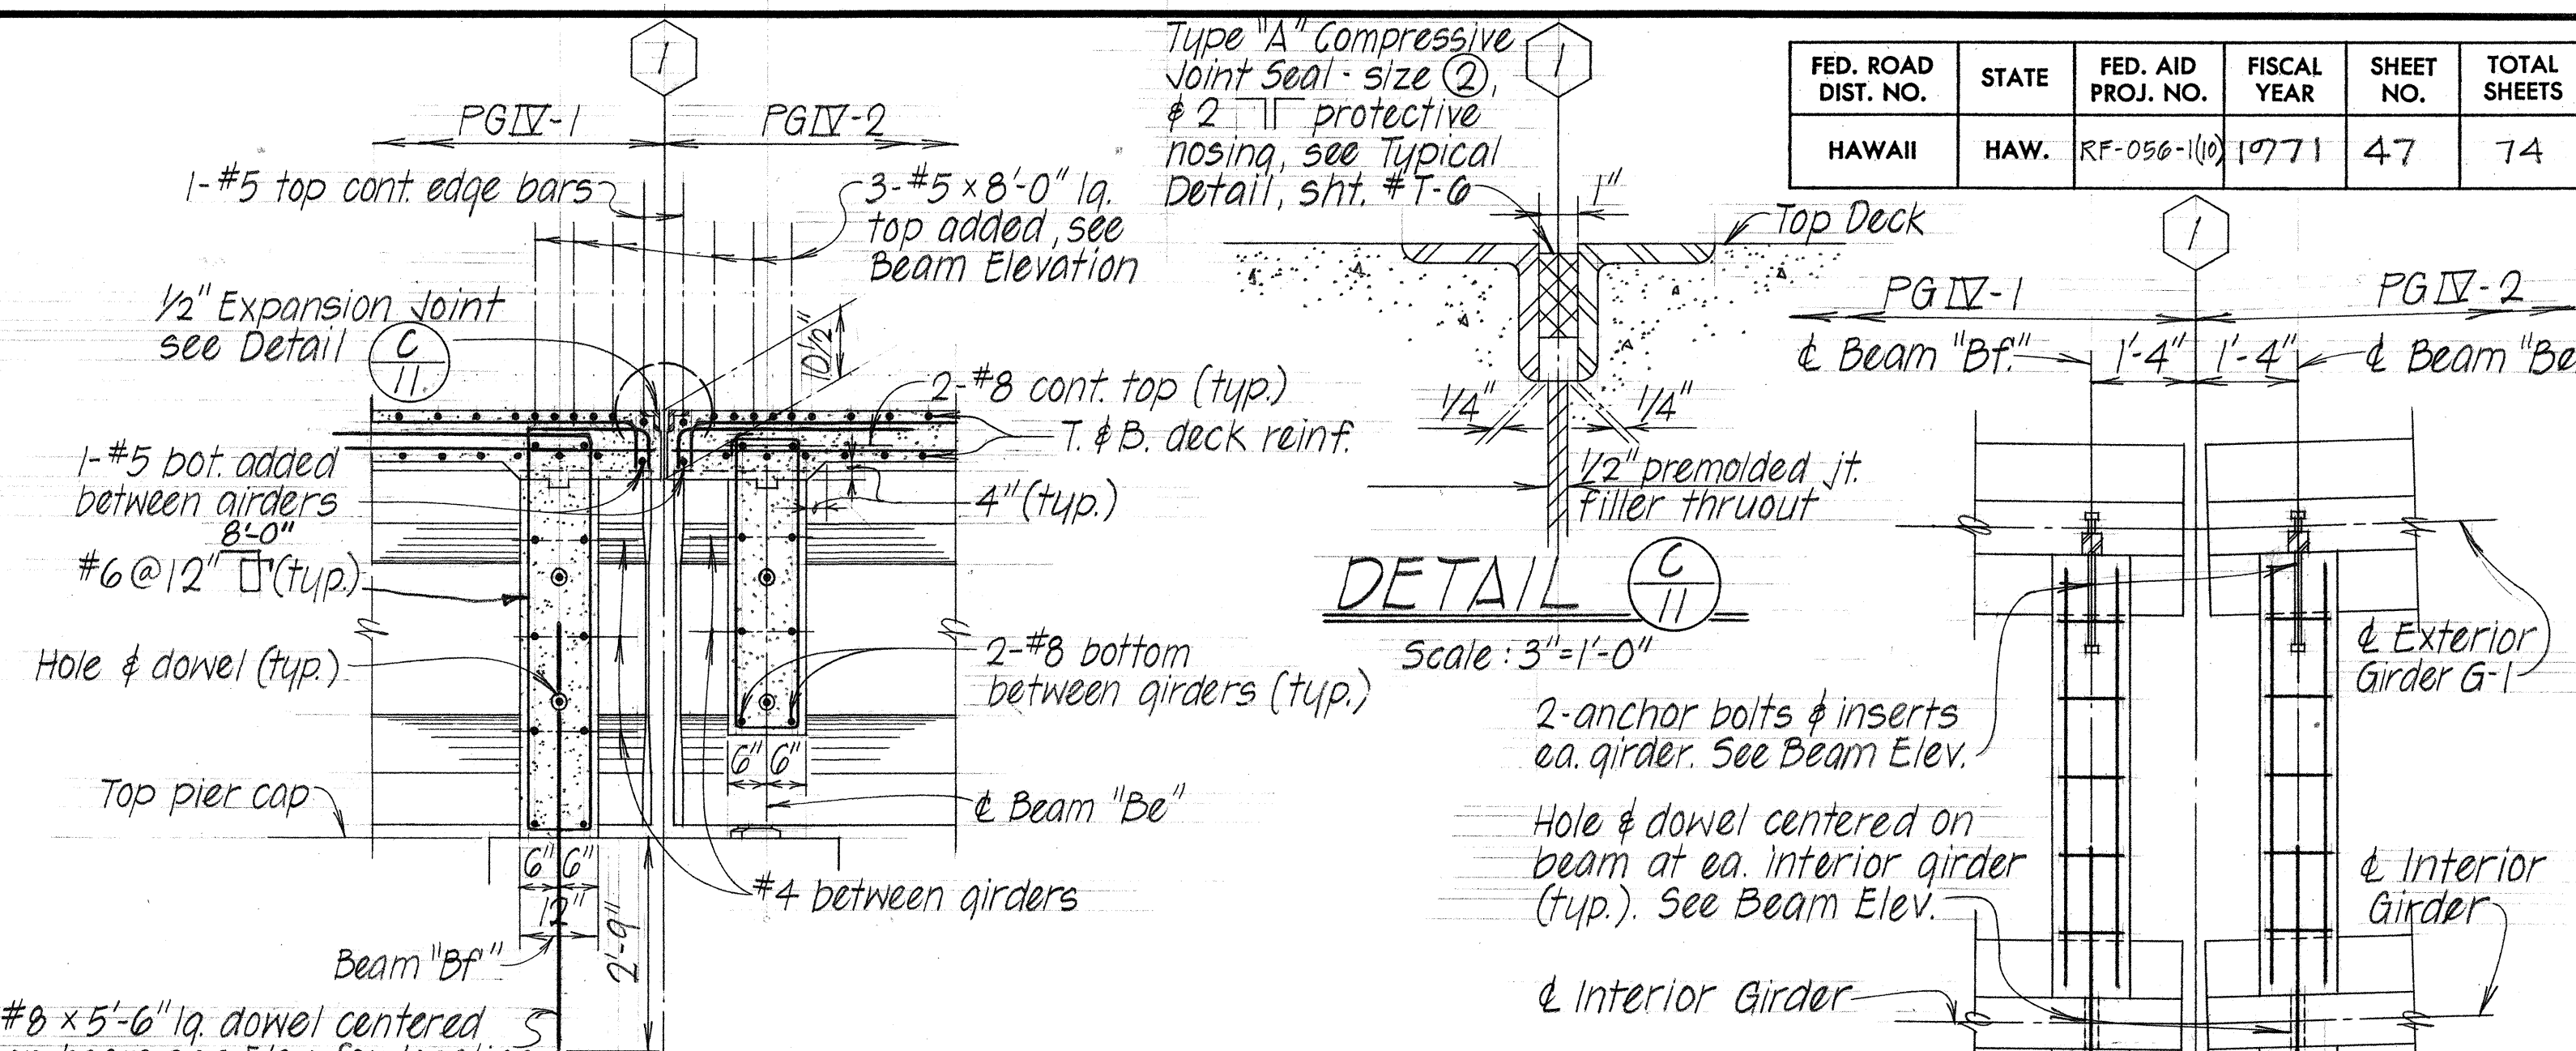


SECTION A-II

Scale: 1/2" = 1'-0"

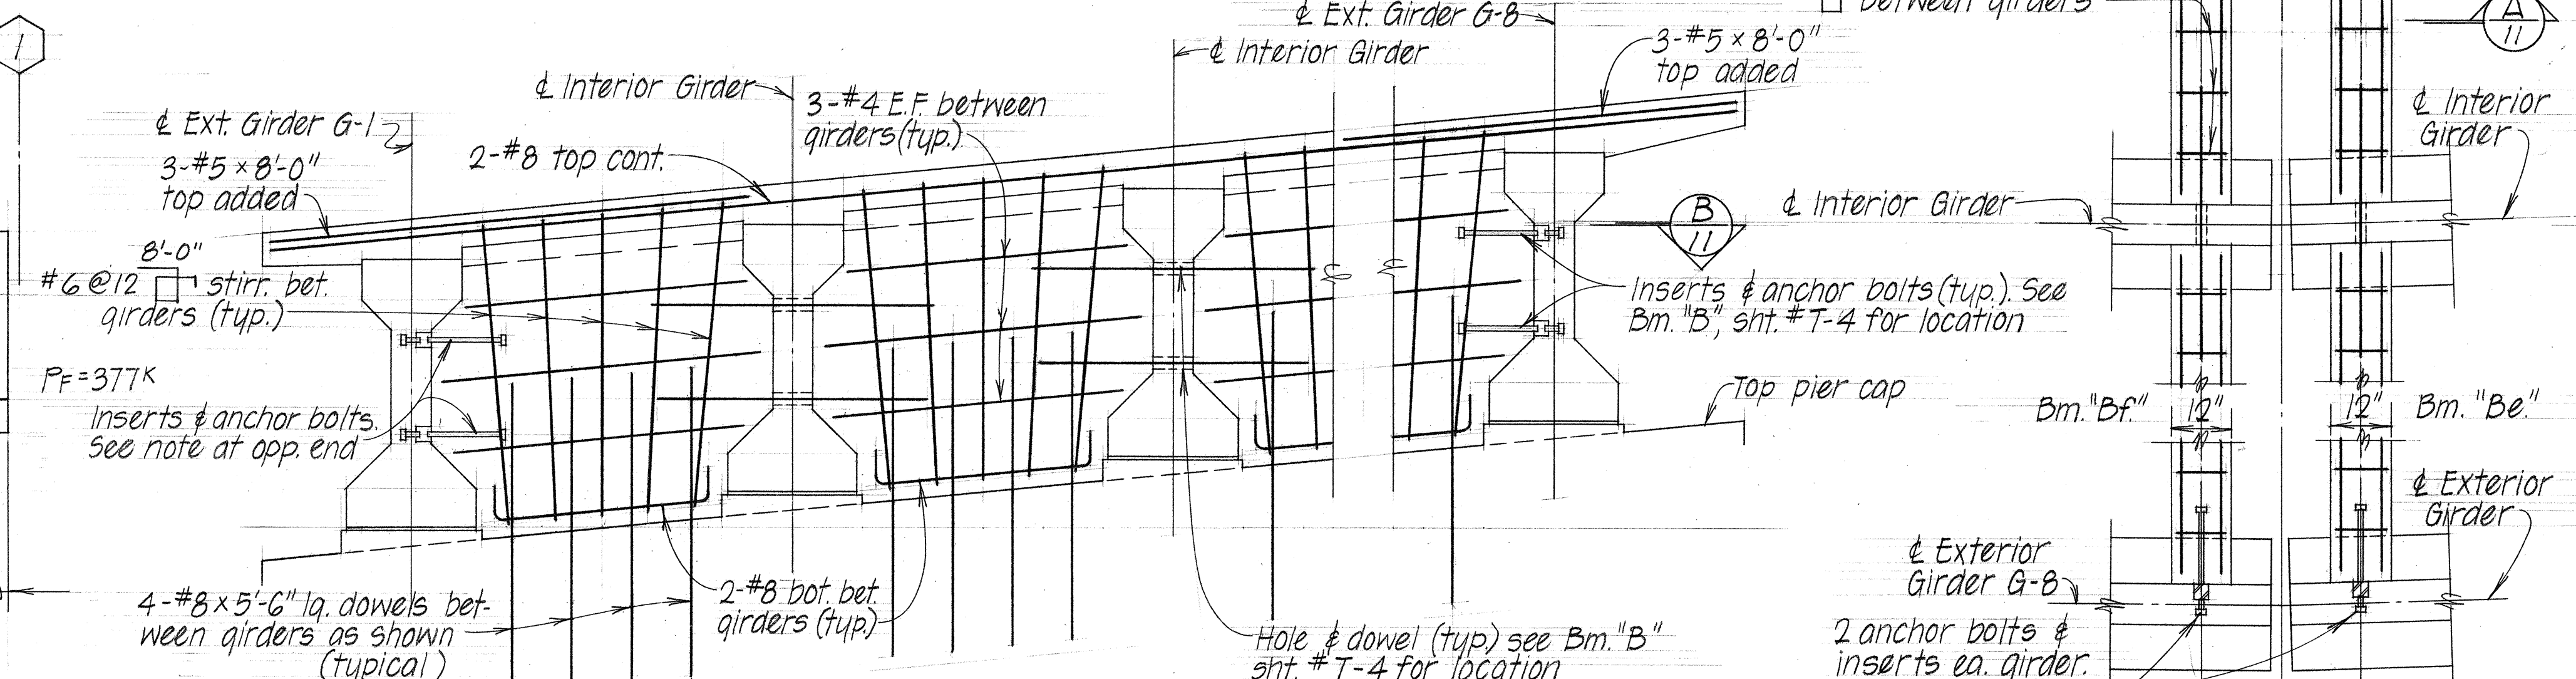

PART NORMAL ELEVATION - BEAM "Bf"

Scale: 1/2" = 1'-0"

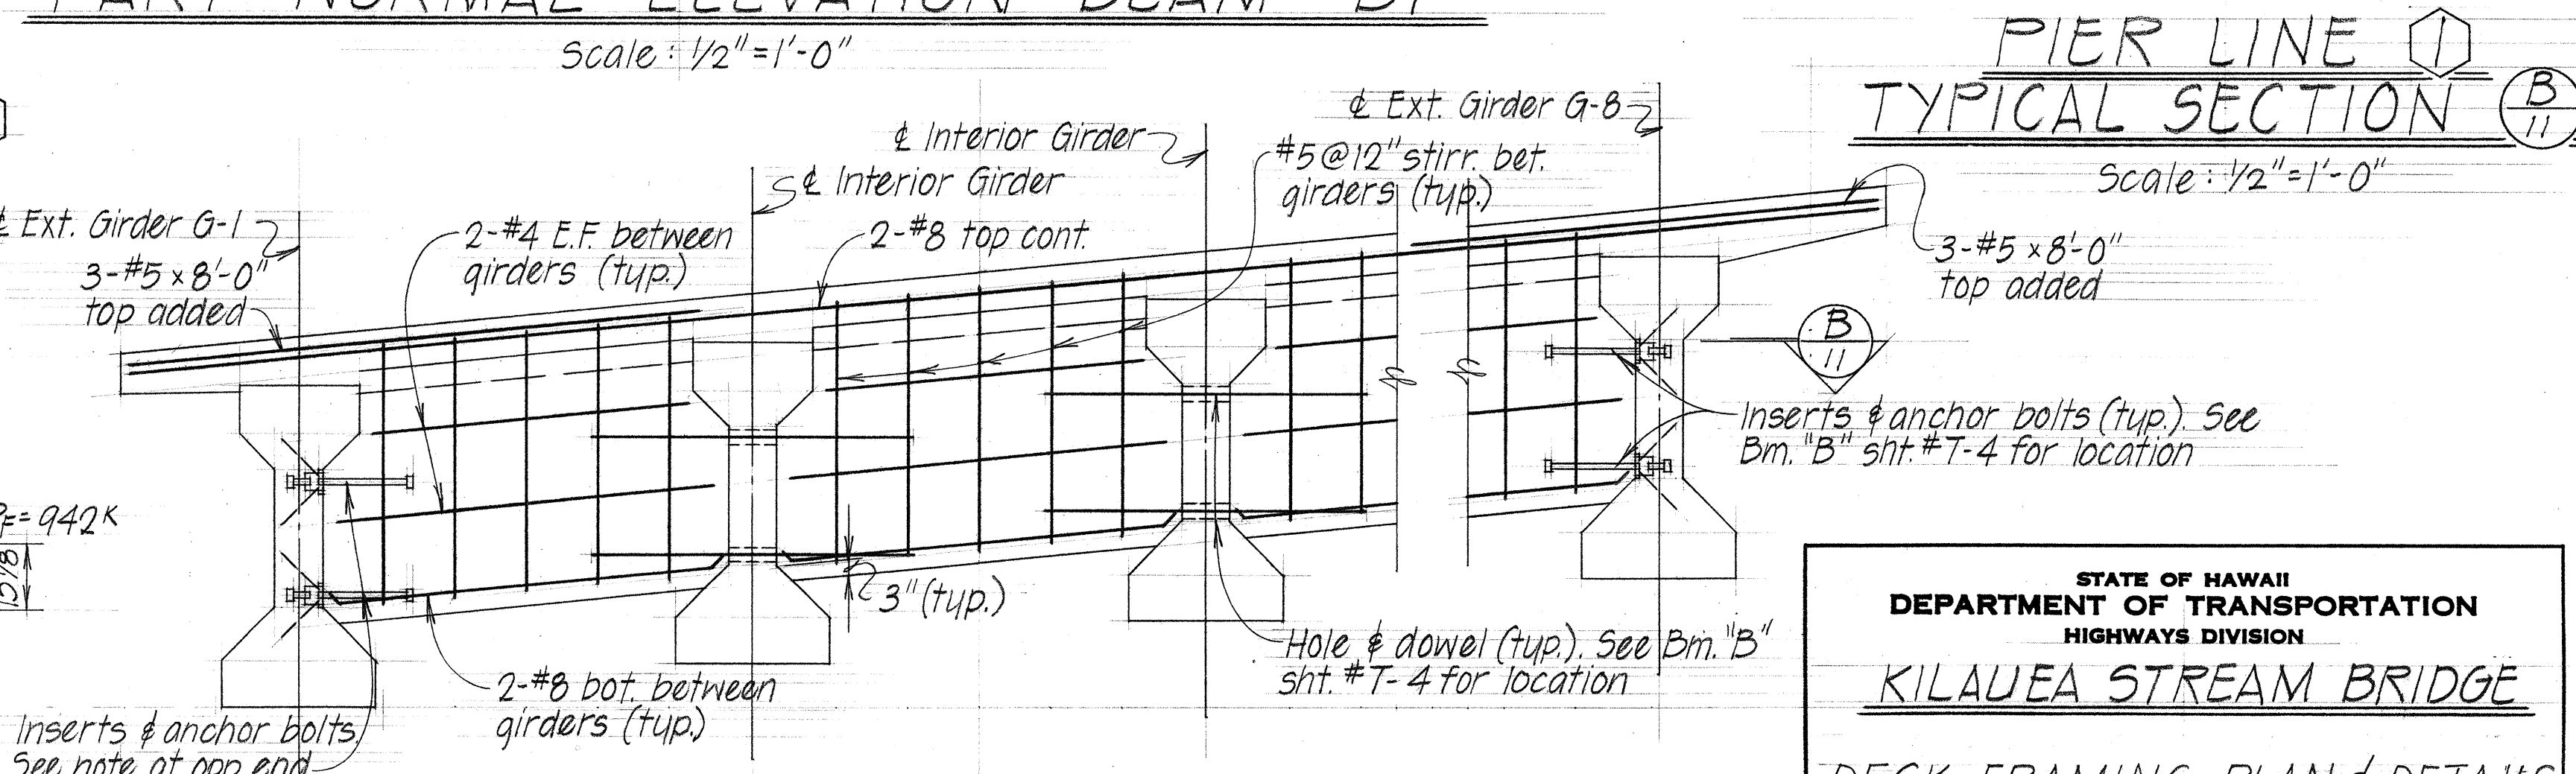

PART NORMAL ELEVATION - BEAM "Be"

Scale: 1/2" = 1'-0"

PIER LINE TYPICAL SECTION B-II

Scale: 1/2" = 1'-0"

STATE OF HAWAII
DEPARTMENT OF TRANSPORTATION
HIGHWAYS DIVISION

KILAUEA STREAM BRIDGE

DECK FRAMING PLAN & DETAILS

Proj. No. RF-056-1(10) Apr. 1971

SHEET No. 11 OF 11 SHEETS

FED. ROAD DIST. NO.	STATE	FED. AID PROJ. NO.	FISCAL YEAR	SHEET NO.	TOTAL SHEETS
HAWAII	HAW.	RF-056-1(10)	1971	48	74

DESIGN NOTES

DESIGN SPECIFICATIONS AASHO

Standard Specifications for Highway Bridges (10th Edition) with subsequent Interim Specifications.

DESIGN LOADS: HS-20-44 or Interstate loading

DESIGN STRESSES:

1. R.C. beams & slabs - See AASHO Specifications and Special Provisions except as otherwise noted.

Class A	Class E
$f'_c = 3,000$ psi	4,500 psi
$f_c = 1,200$ psi	1,800 psi
$n = 10$	8
$f_s =$ ASTM A615, see Special Provisions	

2. Prestressed Girders

$f'_c = 5,500$ psi | $\frac{1}{2}$ " dia. 7 wire strands
 $f'_{ci} = 4,000$ psi | Tensioning load = 25,200 lbs. per strand
Design load = 23,550 lbs. per strand.

Forms must be removed and the beams inspected before the strands are cut.

3. Pile Capacity - See corresponding bridge detail drawings.

GENERAL NOTES

MATERIALS:

- All concrete shall be class A except as otherwise noted on plans. Concrete for prestressed concrete girders see Standard Specifications and as noted under Design Stresses.
- Preformed fabric bridge bearing pads are incidental to concrete and will not be paid for separately.
- See Special Provisions for admixture in concrete.
- All piles to be prestressed concrete piles Type I - see Standard Det. Sht. Nos. DB-300-1, DB-300-2.
- The limits of the structure fill or backfill material requiring a sand equivalent value of not less than 20 shall extend up to the bottom of the roadway subgrade lines.

CONSTRUCTION METHODS:

- See Standard Specifications and Special Provisions.
- For Concrete finish see Special Provisions. Concrete seats and creep blocks to be poured monolithically with pier. Top surfaces of conc. seats to have hard trowel finish.
- See details for additional surface finish.
- In general, top & edge of concrete deck of superstructure shall be constructed to follow the finish roadway vertical & horizontal curves and grades.
- Backfill for both abutments to be placed simultaneously at each abutment after the superstructure is cured.







REFERENCE:

- Refer to Standard Detailed Drawings for additional details not covered by detailed plans.
- Typical Details drawing sheet Nos T-1 thru T-6 inclusive refers to the bridge structure except for modification as may be required by special conditions. For such modifications see corresponding detailed plans.

GENERAL:

- Additional structure fill where indicated on detailed drawings shall be incidental to structural excavation, roadway excavation, or imported borrow.
- All items noted incidental will not be paid for separately.

SYMBOLS & ABBREVIATION

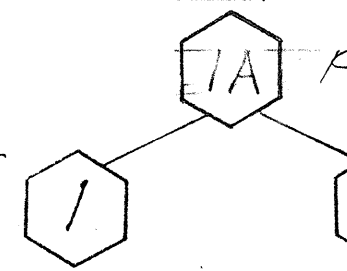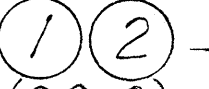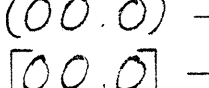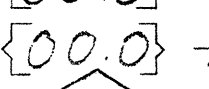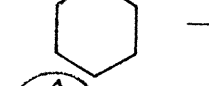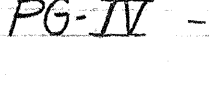- Location pier line number  Pier column number
-  Location concrete seat line number
-  Bottom footing elevation
-  Pile cut-off elevation
-  Pile tip elevation
-  Type I pile
-  Section Designation
-  Sht. number detail is drawn on
-  Boring number and designation
- PG-IV - Prestressed Girder Type

S.E. - Superelevation
G-1, G-2 - Girder numbers.

B. - Baseline
Pt. - Point
Exp. - Expansion
No. - Number
Cont. - Continuous
E.F. - Each Face
B.F. - Both Face
N.F. - Near Face
F.F. - Far Face
W.P. - Working Point
ea. - each
Bal. - Balance
Bot, Bott - Bottom
T. - Top
Ext. - Exterior
Int. - Interior
oc. - on center
Typ. - Typical

Str. - Straight
Stirr. - Stirrup

DATE	_____
SURVEY PLOTTED BY	_____
DRAWN BY	_____
NOTED BY	_____
CHECKED BY	_____
ORIGINAL PLAN	_____
NOTE BOOK	_____
No.	_____

STATE OF HAWAII
DEPARTMENT OF TRANSPORTATION
HIGHWAYS DIVISION
TYPICAL DETAILS
KILAUEA STREAM BRIDGE
NOTES AND ABBREVIATIONS

Proj. No. RF-056-1(10) Apr. 1971


SHEET No. T-1 OF 6 SHEETS

FED. ROAD DIST. NO.	STATE	FED. AID PROJ. NO.	FISCAL YEAR	SHEET NO.	TOTAL SHEETS
HAWAII	HAW.	RF-056-1(10)	1971	47	74


DIST. NO.

HAWAII

AASHTO-PCI STANDARD BRIDGE GIRDER DIMENSION															
GIRDER TYPE	H	X	Y	a	b	c	d	e	f	g	J	K	L	m	n
PG I	2'-4"	1'-0"	1'-4"	5"	5"	11"	3"	—	4"	6"	—	3"	5"		
PG II	3'-0"	1'-0"	1'-6"	6"	6"	1'-3"	3"	—	6"	6"	—	3"	6"		
PG III	3'-9"	1'-4"	1'-10"	7"	7½"	1'-7"	4½"	—	7"	7"	—	4½"	7½"		
PG IV	4'-6"	1'-8"	2'-2"	8"	9"	1'-11"	6"	—	8"	8"	—	6"	9"		

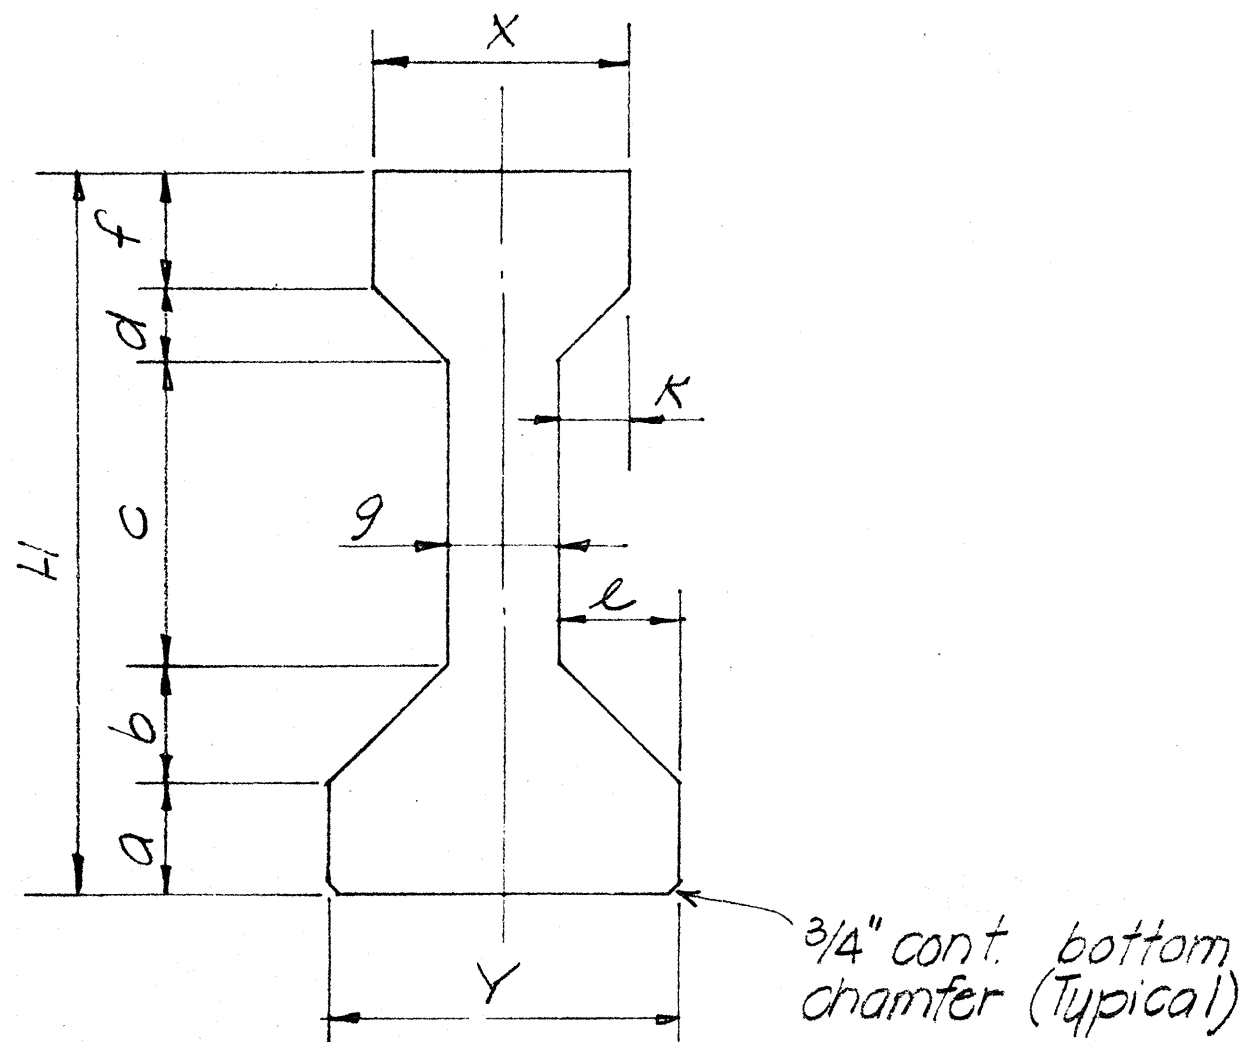

TYPE PG I THRU TYPE PG IV

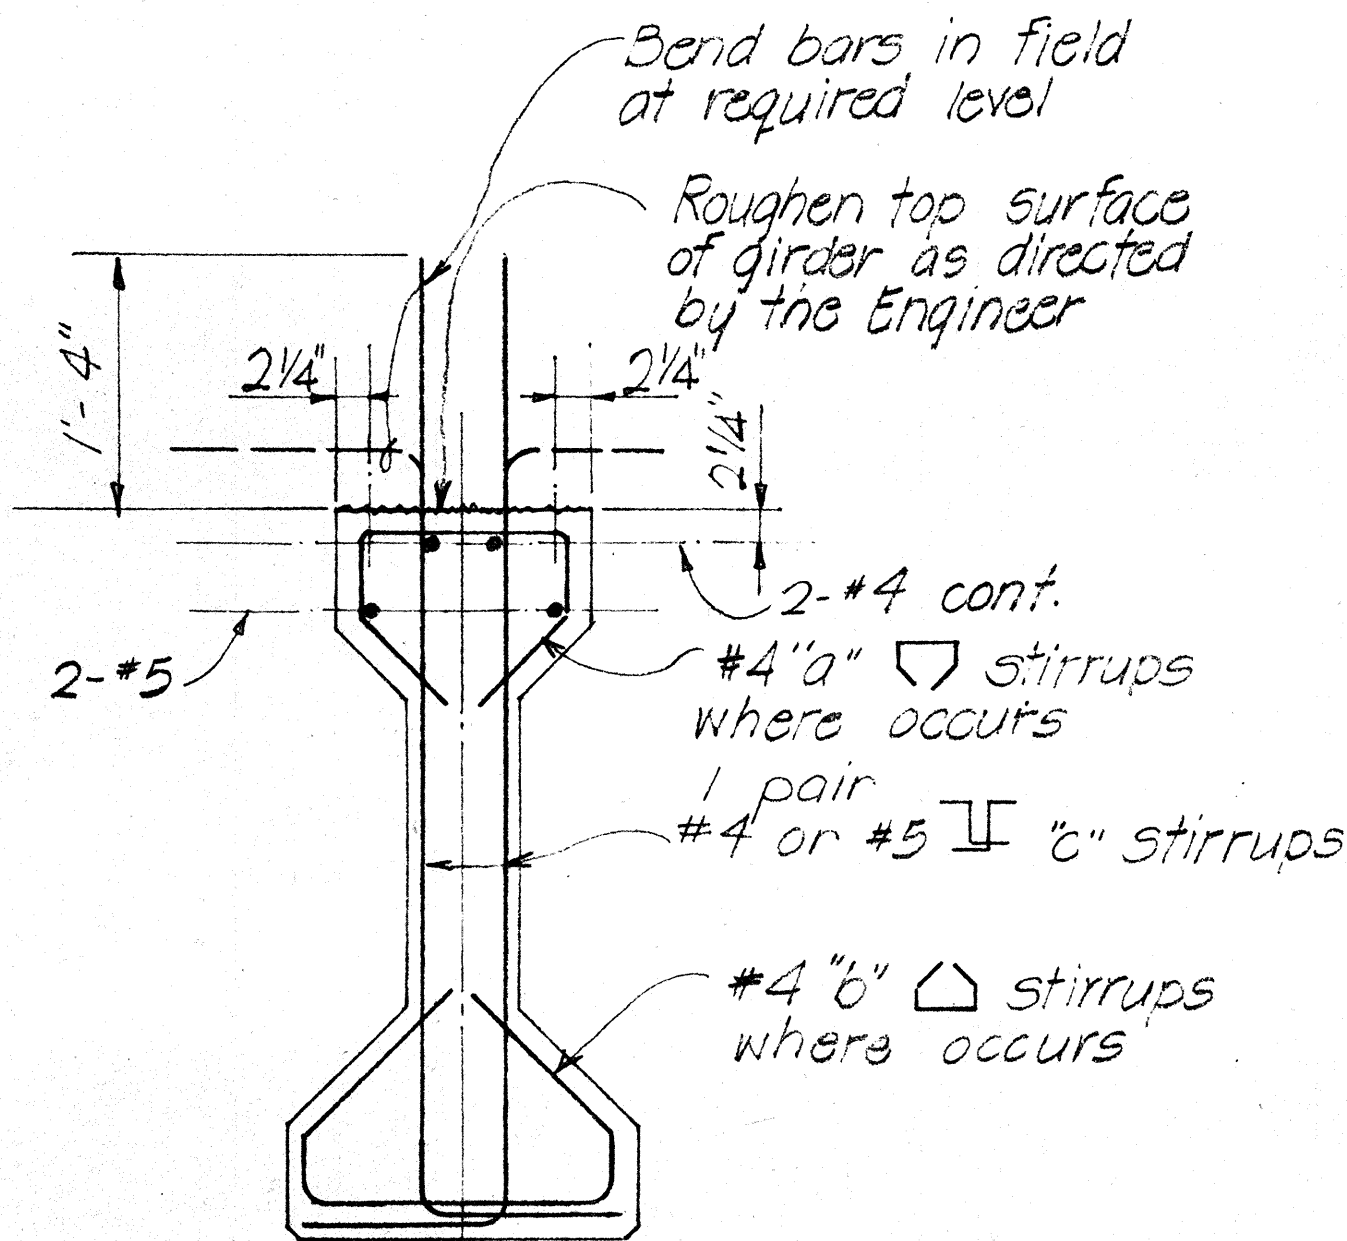


TYPE PG I THRU TYPE PG IV

TYPICAL SECTION PRESTRESSED CONC. GIRDERS

BUNDLING OF PRESTRESSING REINFORCEMENT

ARRANGEMENT AND CLEARANCE FOR POST TENSIONED UNITS	ARRANGEMENT AND CLEARANCE FOR PRETENSIONED STRANDS
- Horizontal clearance between units equals 2" min. - Units may be bundled vertically in groups of 3 maximum. - Vertical clearance between bundled units equal 3" minimum. - Approval of the Engineer is required for deviation.	- Strands may be bundled in groups as shown. - The minimum distance "S" between groups or individual strands is 2" for 1/2" strands. "S" is measured between centers of adjacent strands.
	CASE I CASE II

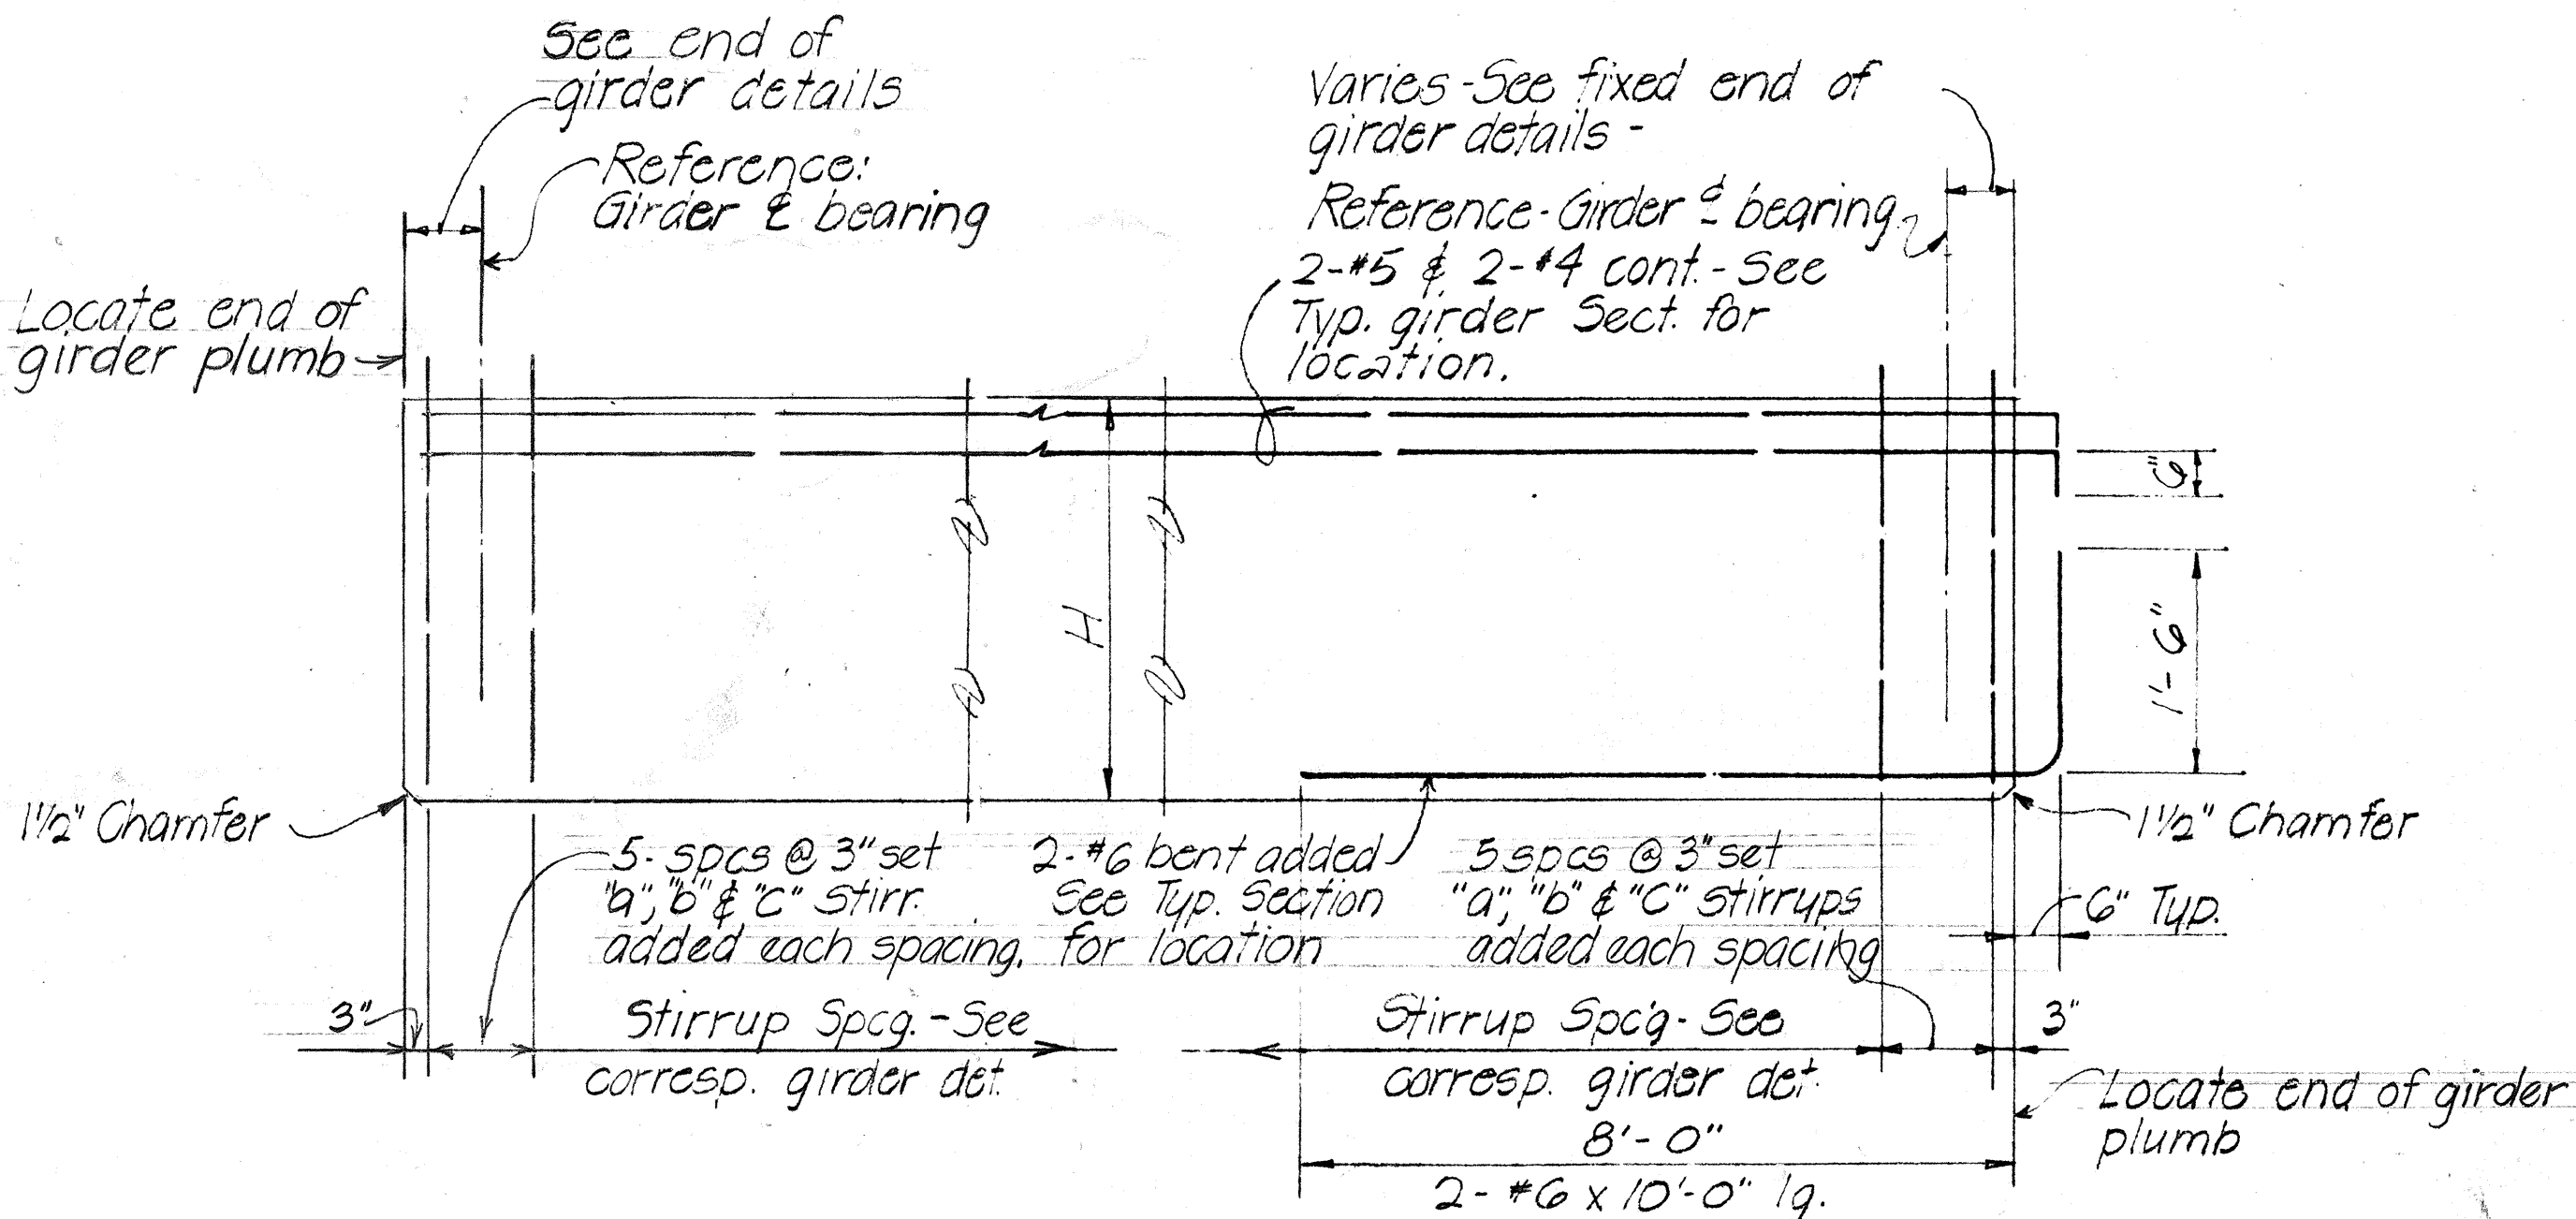

AT PIER 1 ENDS OF GIRDER

TYPICAL DETAILS

AT PIER 2 ENDS OF GIRDER

AT ABUTMENTS #1 & #2 ENDS OF GIRDER

GENERAL NOTES

- For additional holes and inserts in prestressed girders for beam connections, refer to corresponding beam details.
- For design stress refer to Shts. T-1 & corresponding girder detail drawings.


STATE OF HAWAII
DEPARTMENT OF TRANSPORTATION
HIGHWAYS DIVISION

TYPICAL DETAILS
PRESTRESSED GIRDER
KILAUEA STREAM BRIDGE

Proj. No. RF-056-1(10) Apr. 1971
SHEET No. T-2 OF 6 SHEETS


DESIGNED BY	DATE
DRAWN BY	
CHECKED BY	
NOTED BY	
NO.	

FED. ROAD DIST. NO.	STATE	FED. AID PROJ. NO.	FISCAL YEAR	SHEET NO.	TOTAL SHEETS
HAWAII	HAW.	RF-056-1(10)	1971	50	74

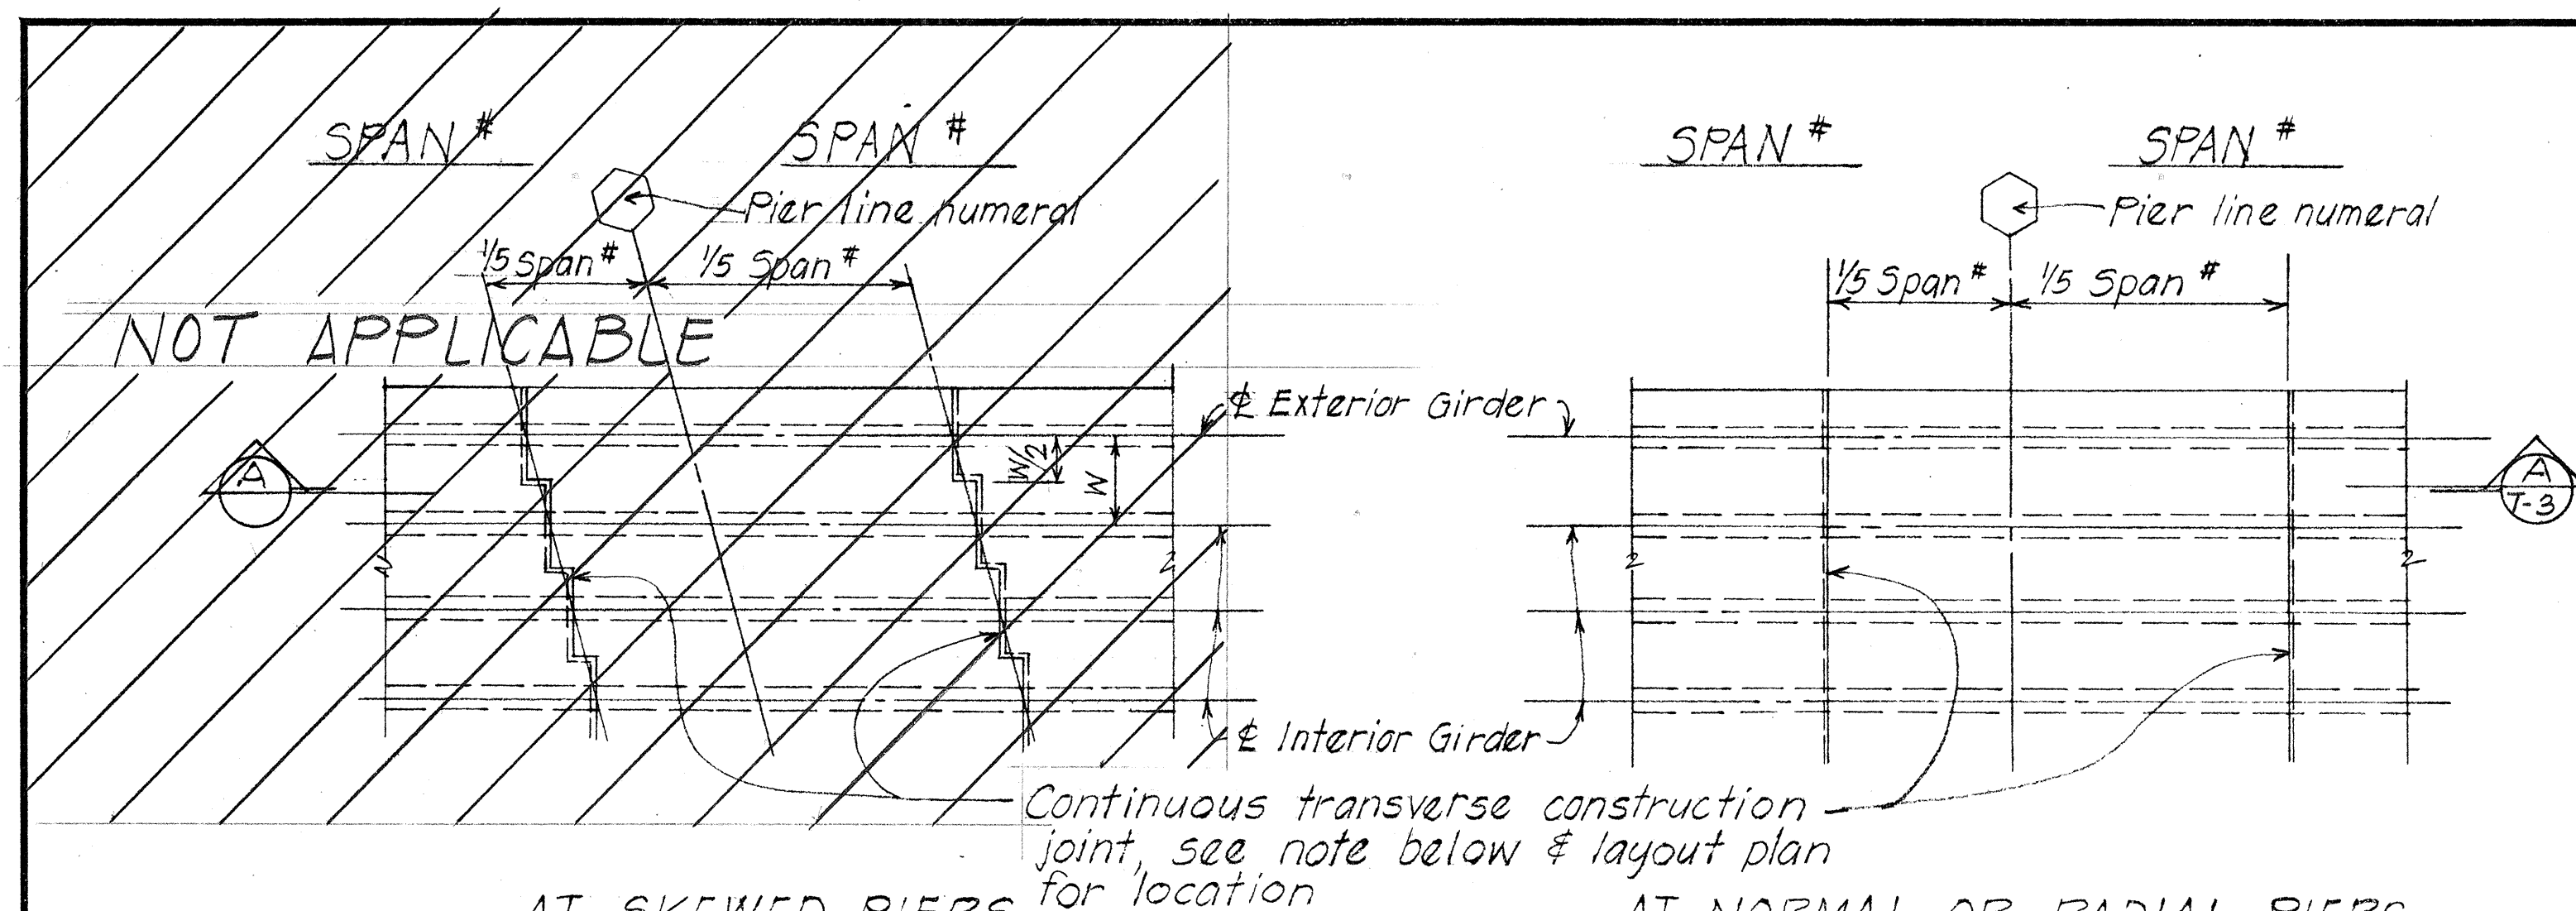


AT SKEWED PIERS
PLAN-TYPICAL TRANSVERSE DECK CONSTRUCTION JOINT LOCATION


AT NORMAL OR RADIAL PIERS

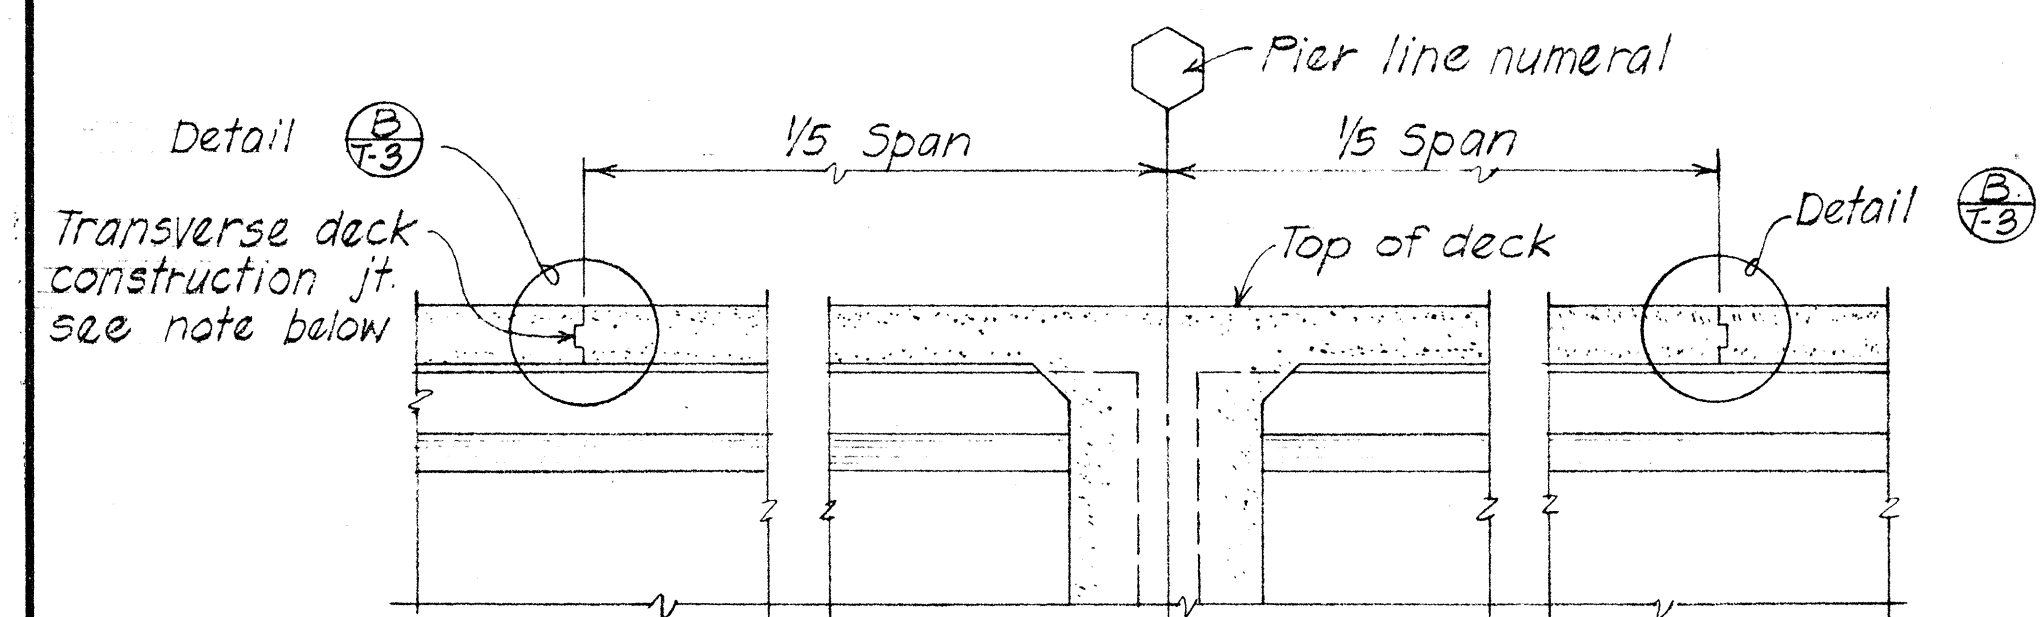

DETAIL OF CONTINUOUS SLAB OVER PIER

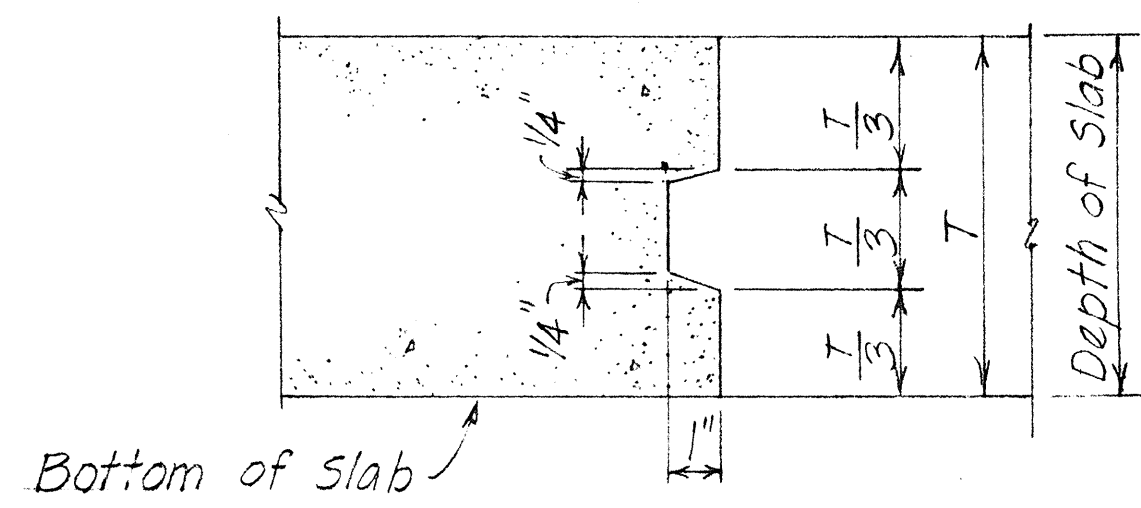

TYPICAL SLAB CONSTRUCTION JOINT DETAIL

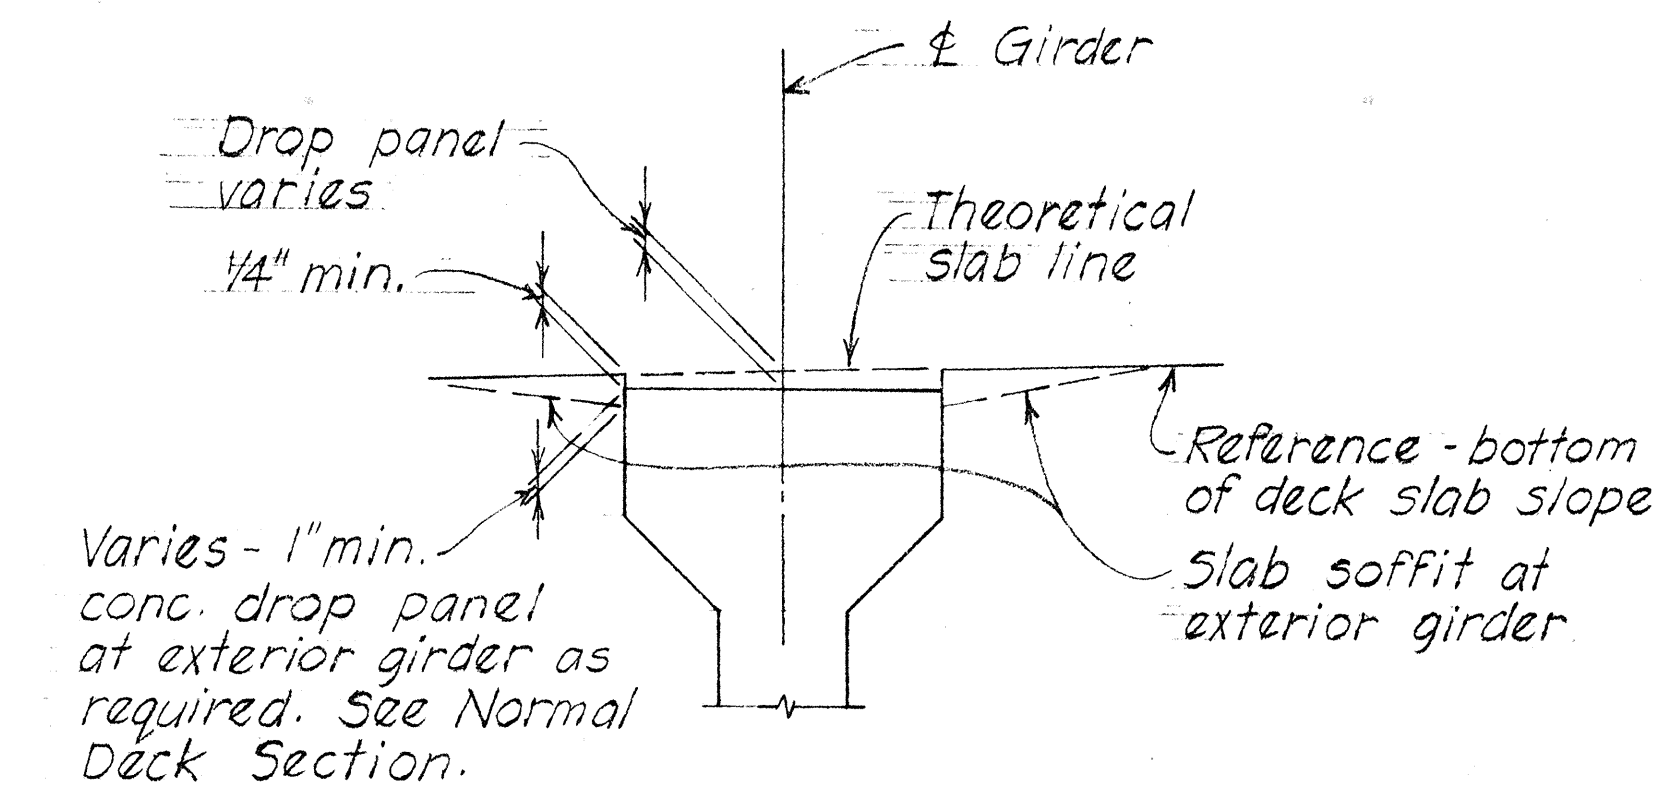

TYPICAL SLAB DROP PANEL DETAIL
AT PRESTRESSED GIRDER
No Scale

NOTE:
Transverse deck construction joint shall be used at these locations. The portion of the pour indicated between construction joints over the pier shall not be poured until the pours for the adjacent positive moment areas have been completed.
Transverse deck construction joints may be eliminated if permitted by the Engineer in writing. If the construction joints are eliminated, water reducing and retarding admixture conforming to AASHTO Designation: M194, Type D, shall be added to the deck concrete over the pier within the indicated lines. The type of the admixture shall be such that the amount of dosage used will produce the retardation required. The type and dosage of the admixture, and the method of pour shall be approved by the Engineer.



DATE	____
DESIGNED BY	____
TRACED BY	____
NOTED BY	____
CHECKED BY	____
ORIGINAL PLAN	____
NOTE BOOK	____
No.	____

STATE OF HAWAII
DEPARTMENT OF TRANSPORTATION
HIGHWAYS DIVISION




TYPICAL DETAILS
KILAUEA STREAM BRIDGE
PRESTRESSED GIRDER SUPERSTRUCTURE

Proj. No. RF-056-1(10) Apr. 1971
SHEET No. 73 OF 6 SHEETS

FED. ROAD DIST. NO.	STATE	FED. AID PROJ. NO.	FISCAL YEAR	SHEET NO.	TOTAL SHEETS
HAWAII	HAW.	RF-056-1(10)	1971	51	74

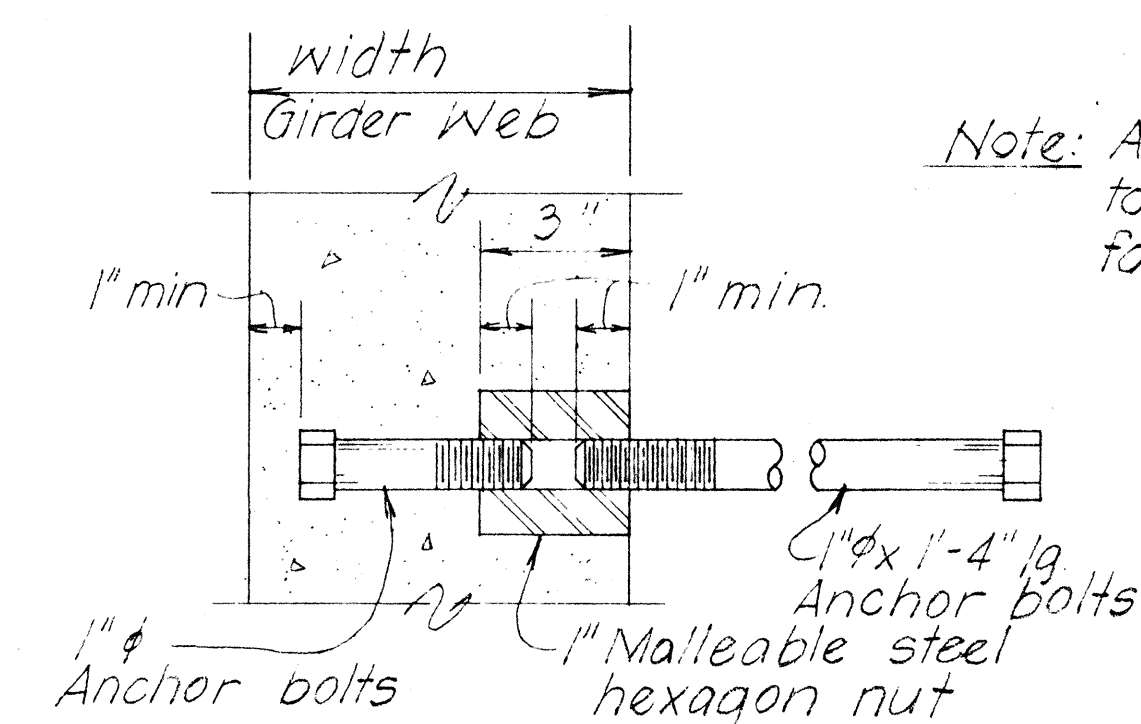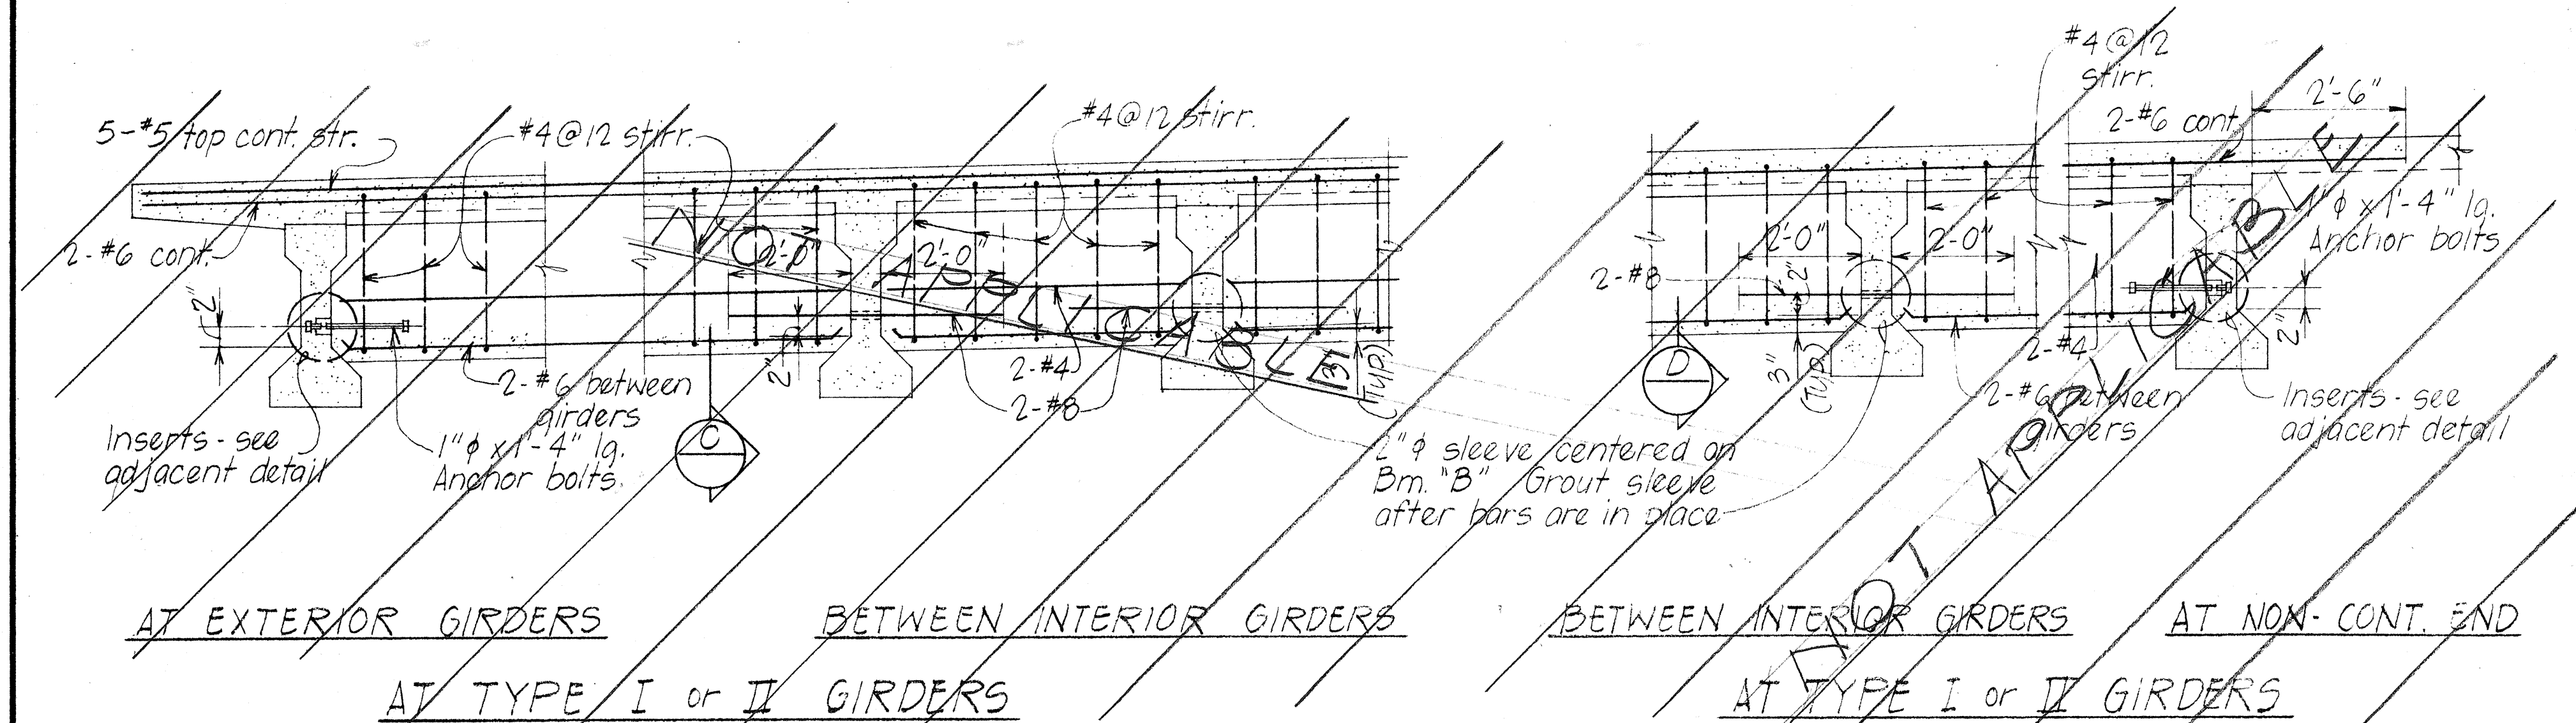

TYPICAL INSERT DETAIL
Scale: 3" = 1'-0"

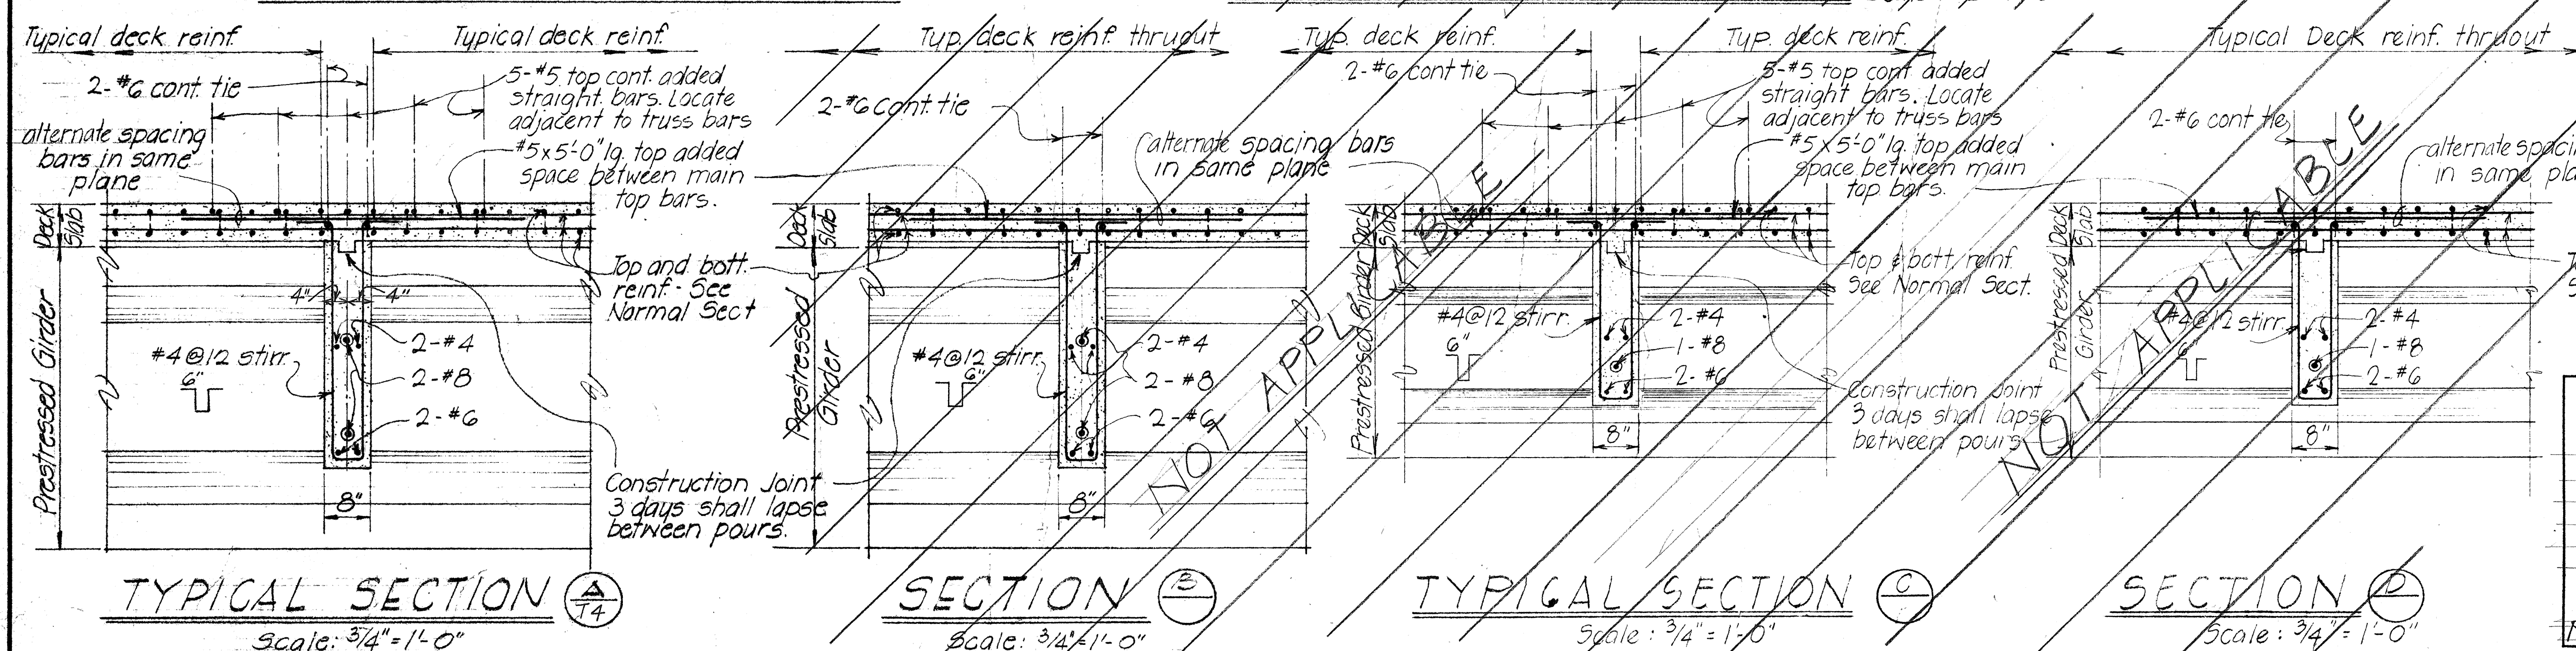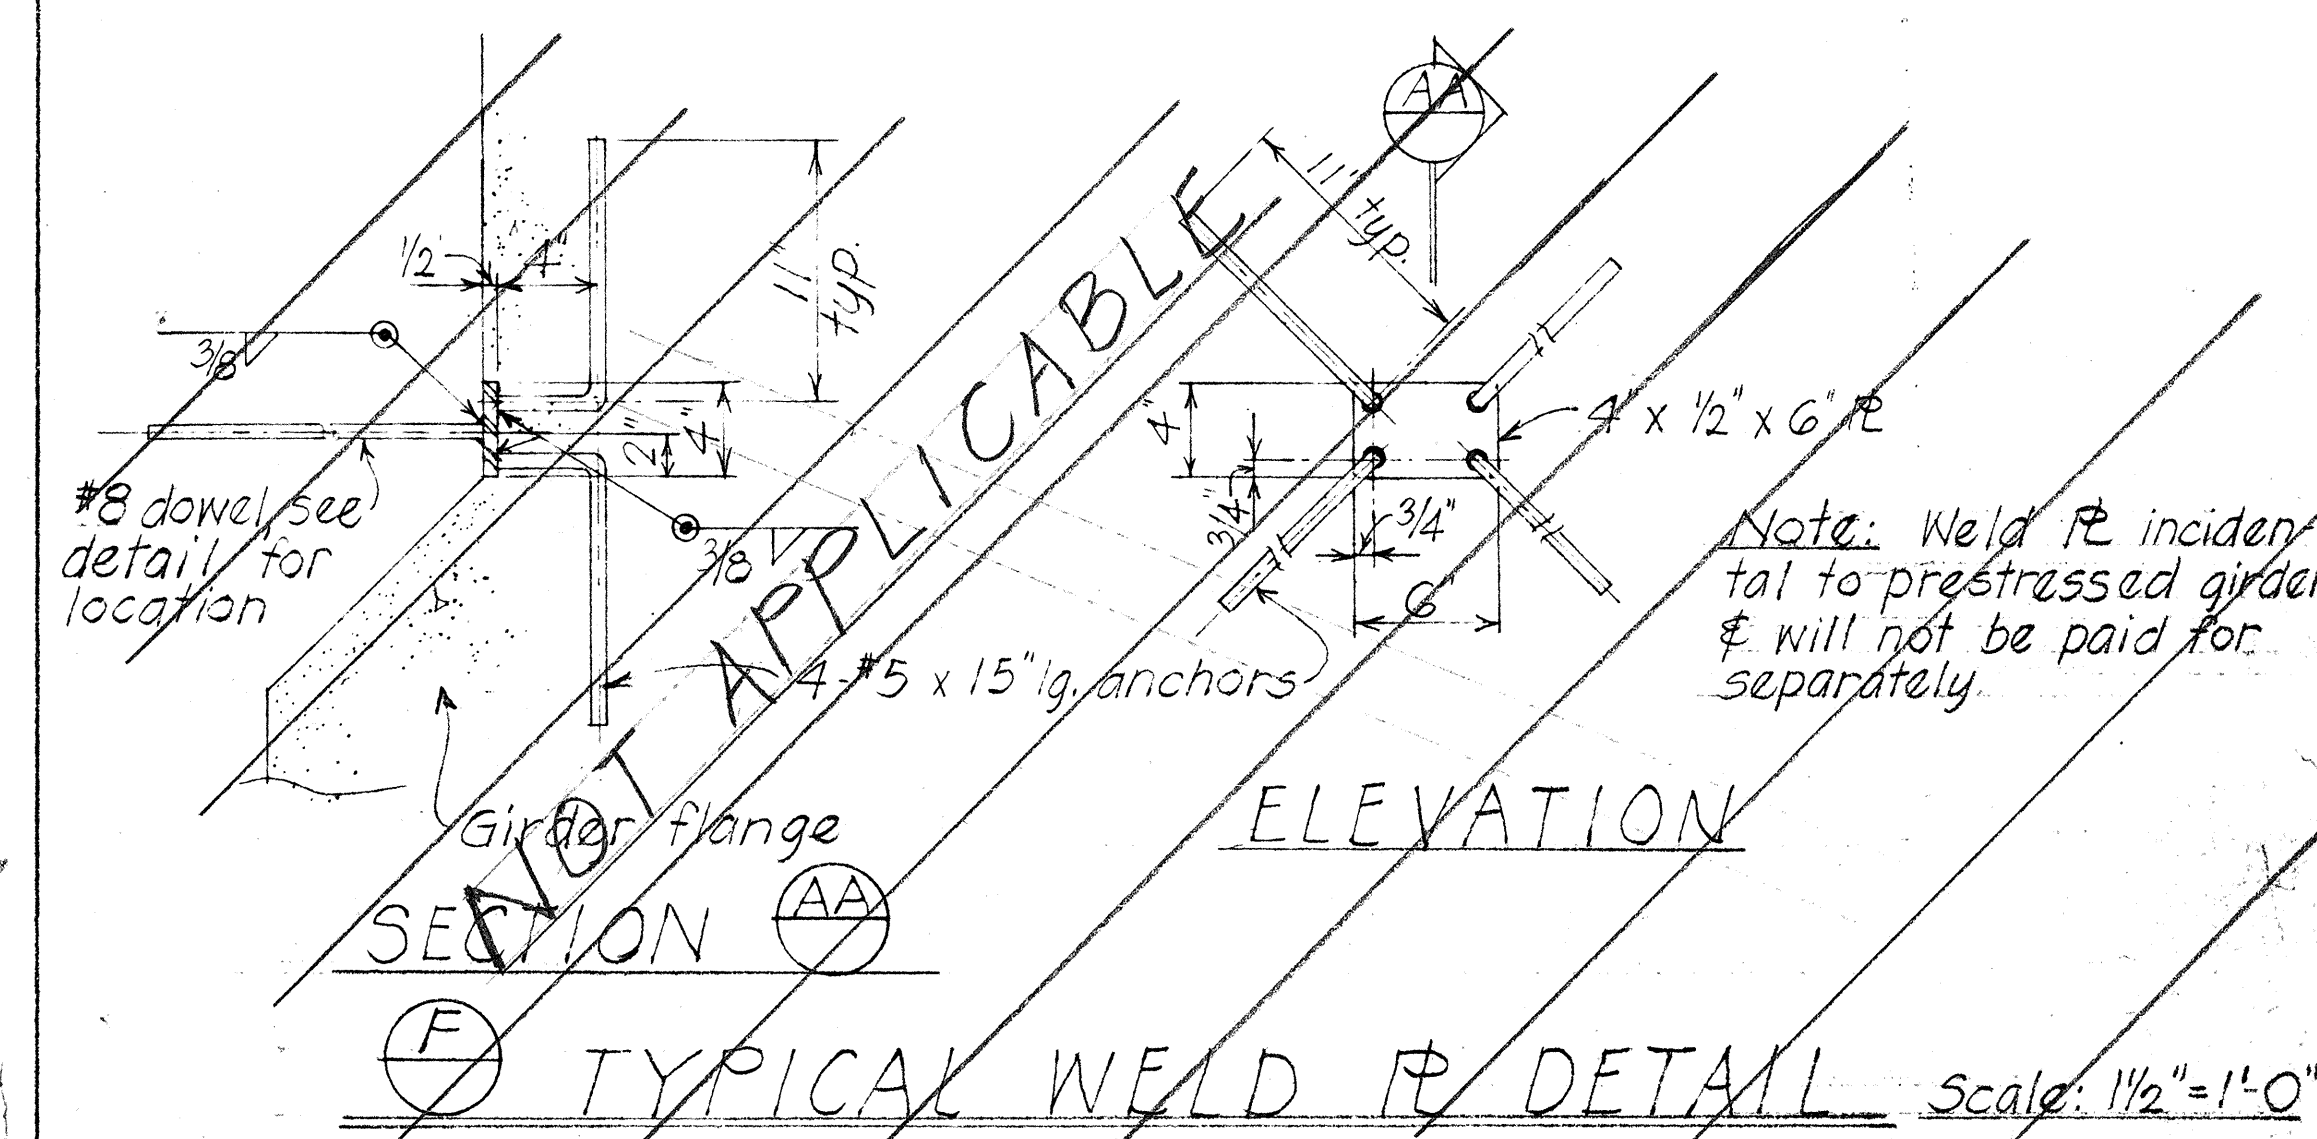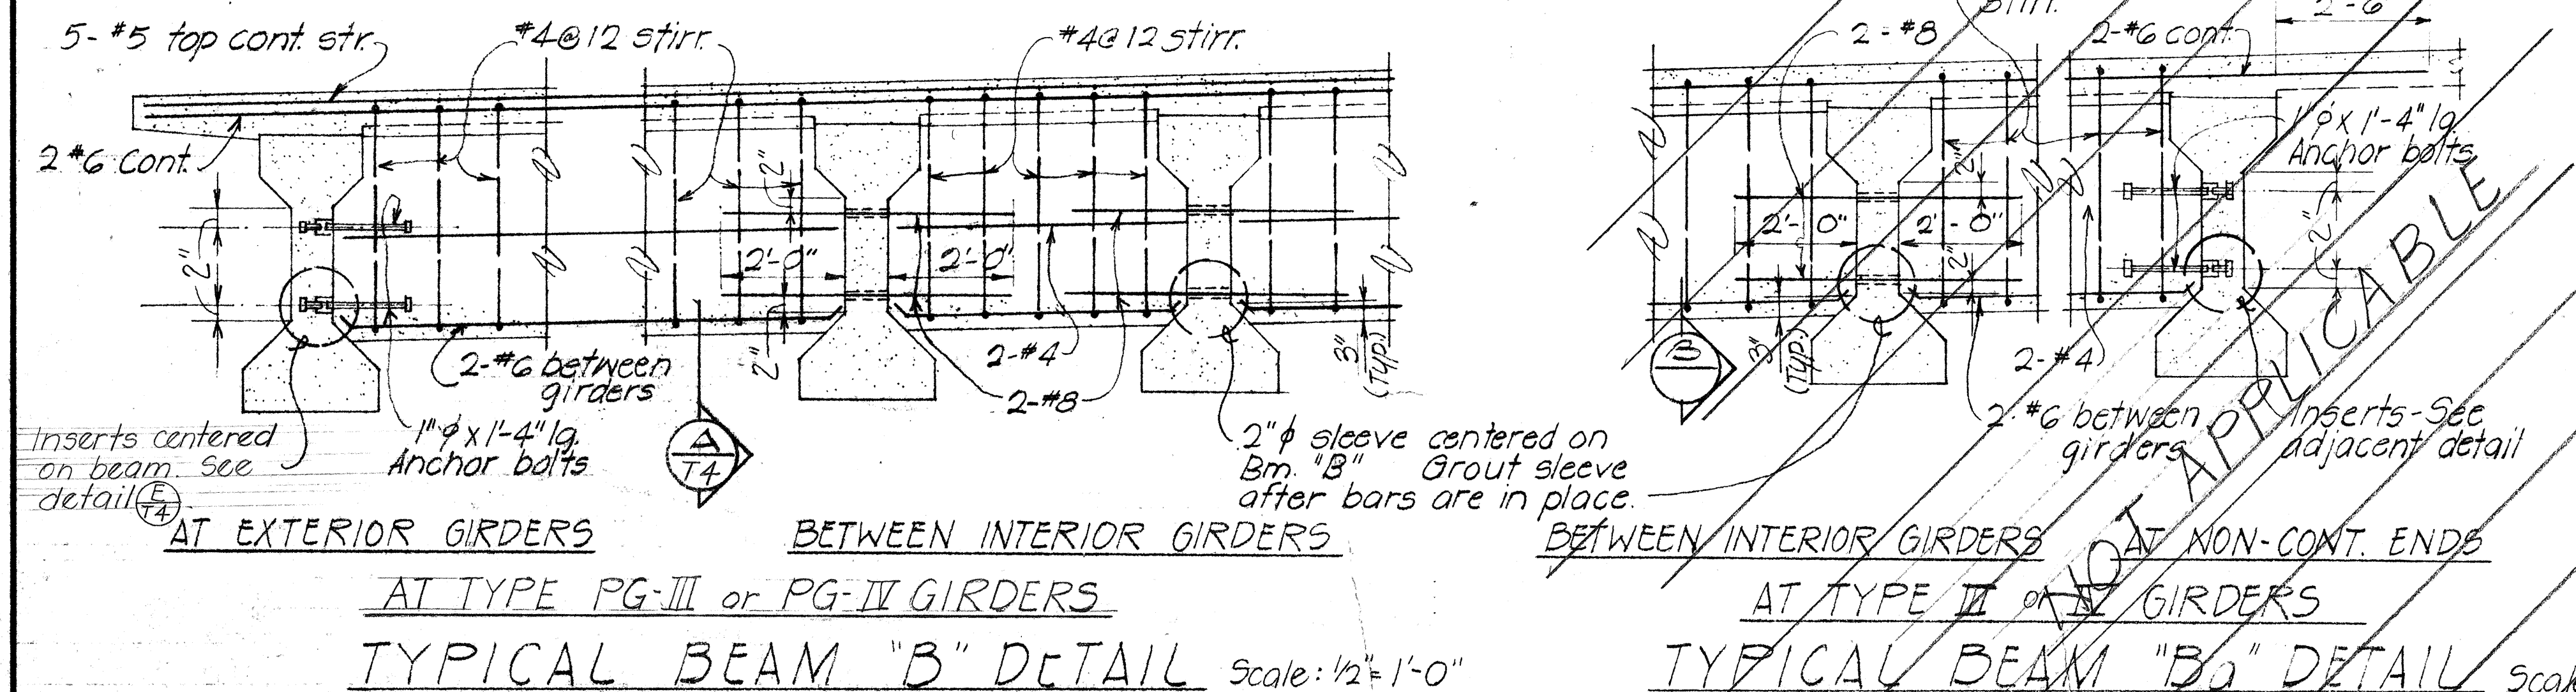


STATE OF HAWAII
DEPARTMENT OF TRANSPORTATION
HIGHWAYS DIVISION

TYPICAL DETAILS
KILAUEA STREAM BRIDGE
CAST-IN-PLACE BEAM "B"


Proj. No. RF-056-1(10) Apr. 1971
SHEET No. 7-40F 6 SHEETS

SURVEY PLOTTED BY	DATE
DRAWN BY	
DESIGNED BY	
NOTED BY	
CHECKED BY	

FED. ROAD DIST. NO.	STATE	FED. AID PROJ. NO.	FISCAL YEAR	SHEET NO.	TOTAL SHEETS
HAWAII	HAW.	RF-056-1(10)	1971	52	74


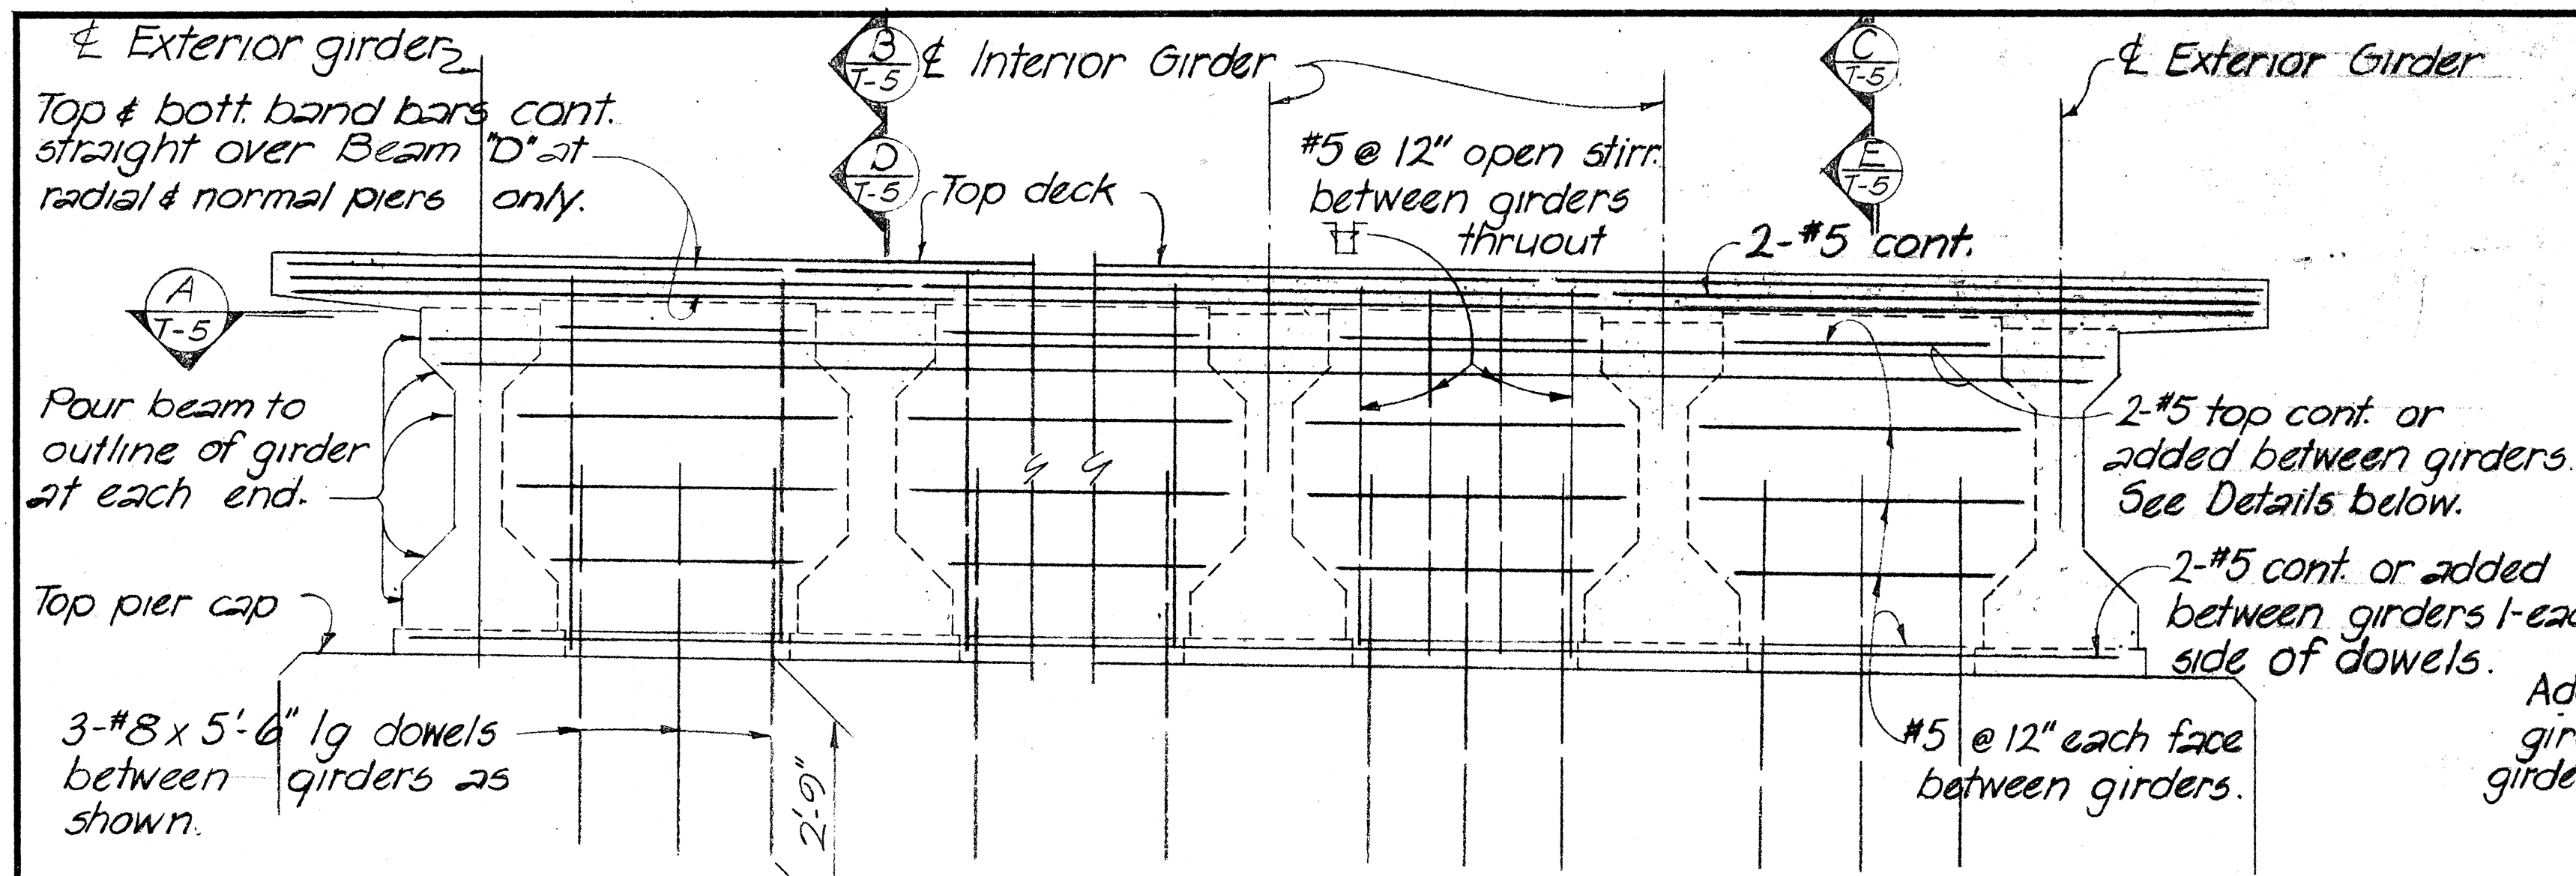


ELEVATION - TYPICAL TRANSVERSE BEAM "D" Scale: 1/2" = 1'-0"

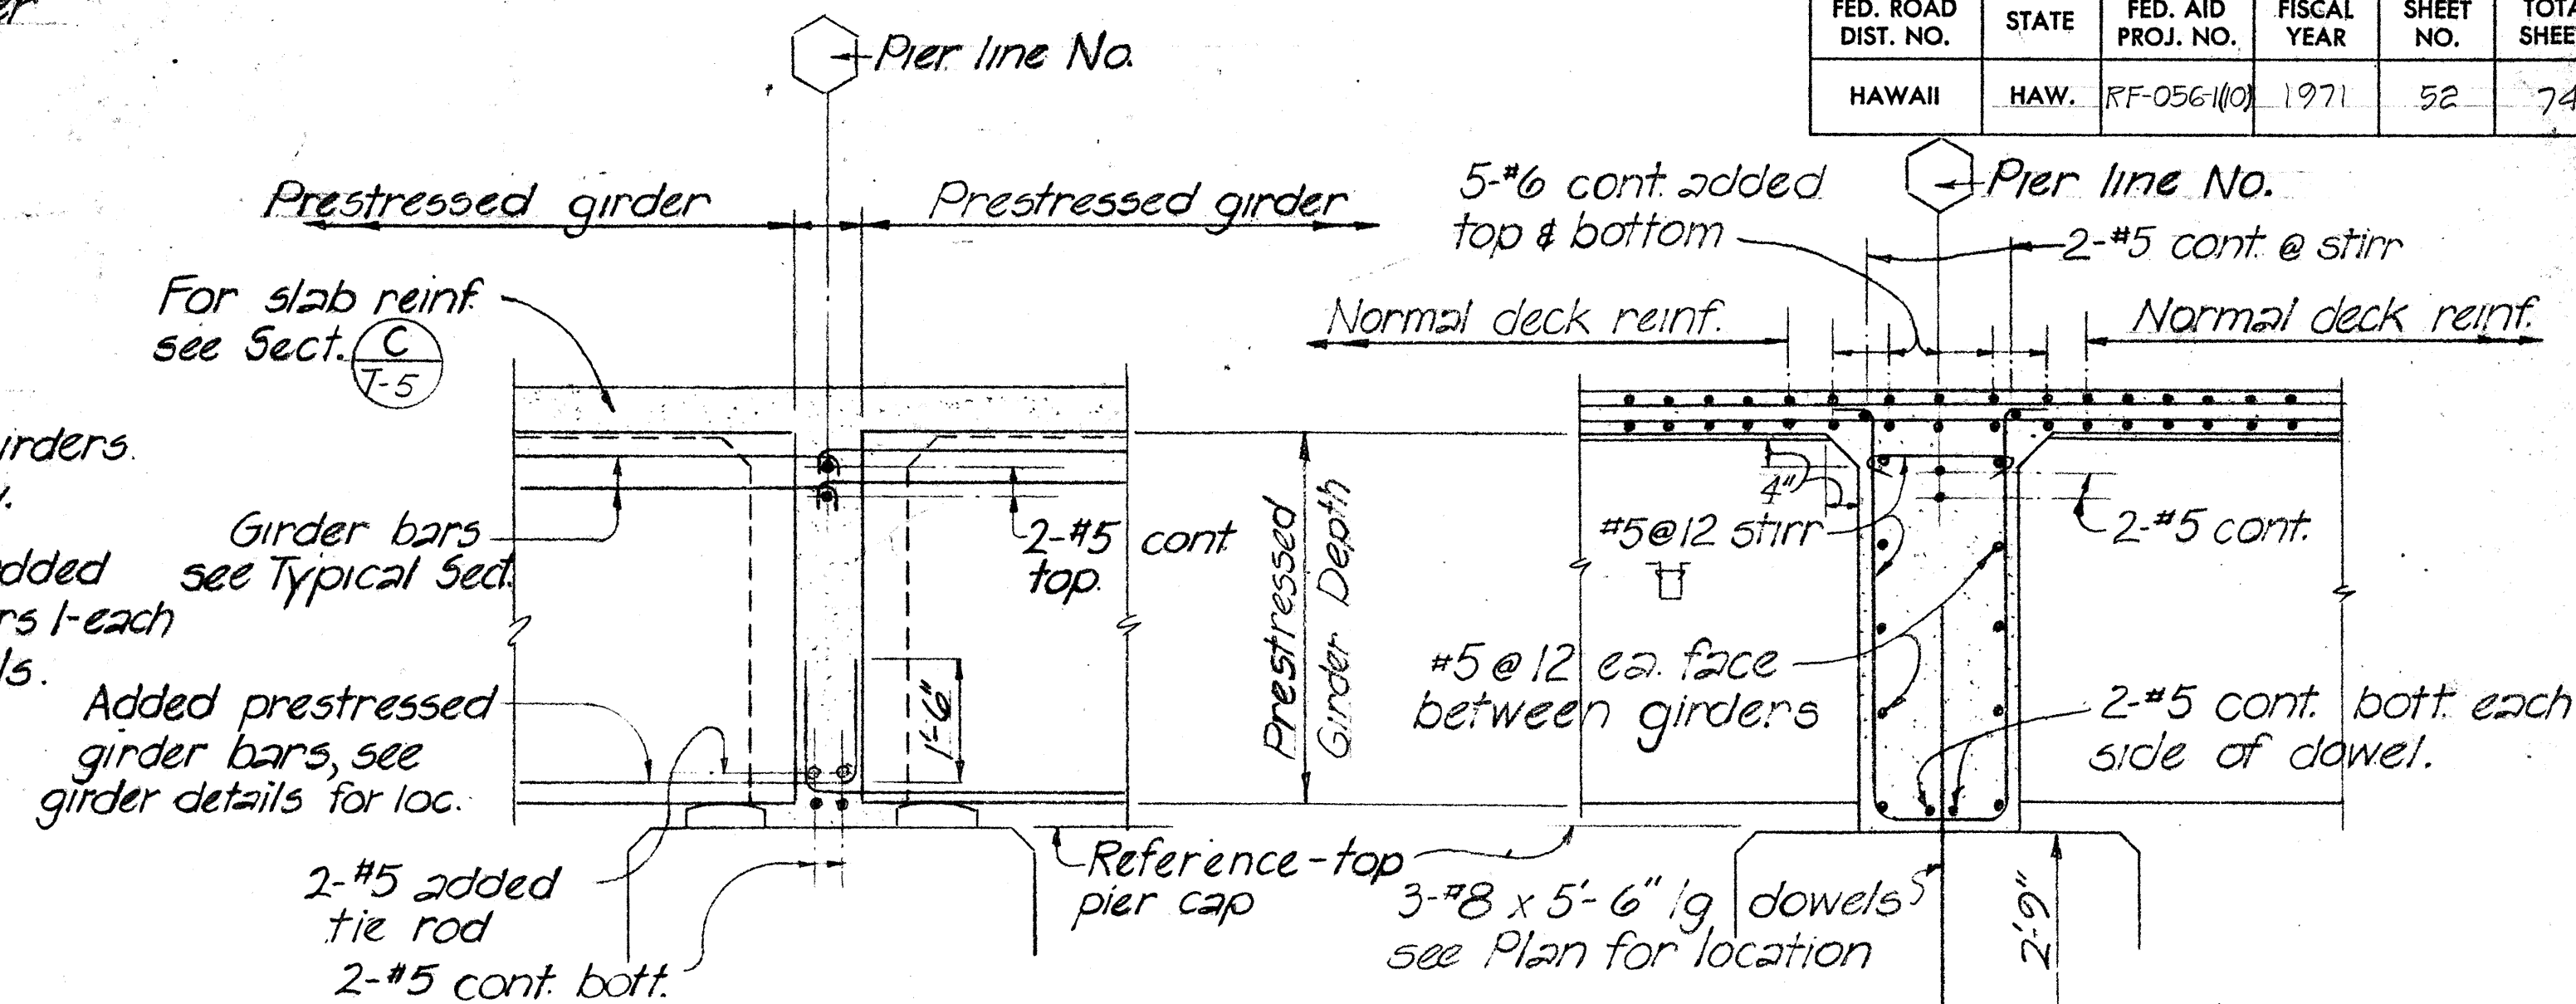

SECTION B-T-5 (AT GIRDERS) Scale: 1/2" = 1'-0"

SECTION C-T-5 (BETWEEN GIRDERS) Scale: 1/2" = 1'-0"

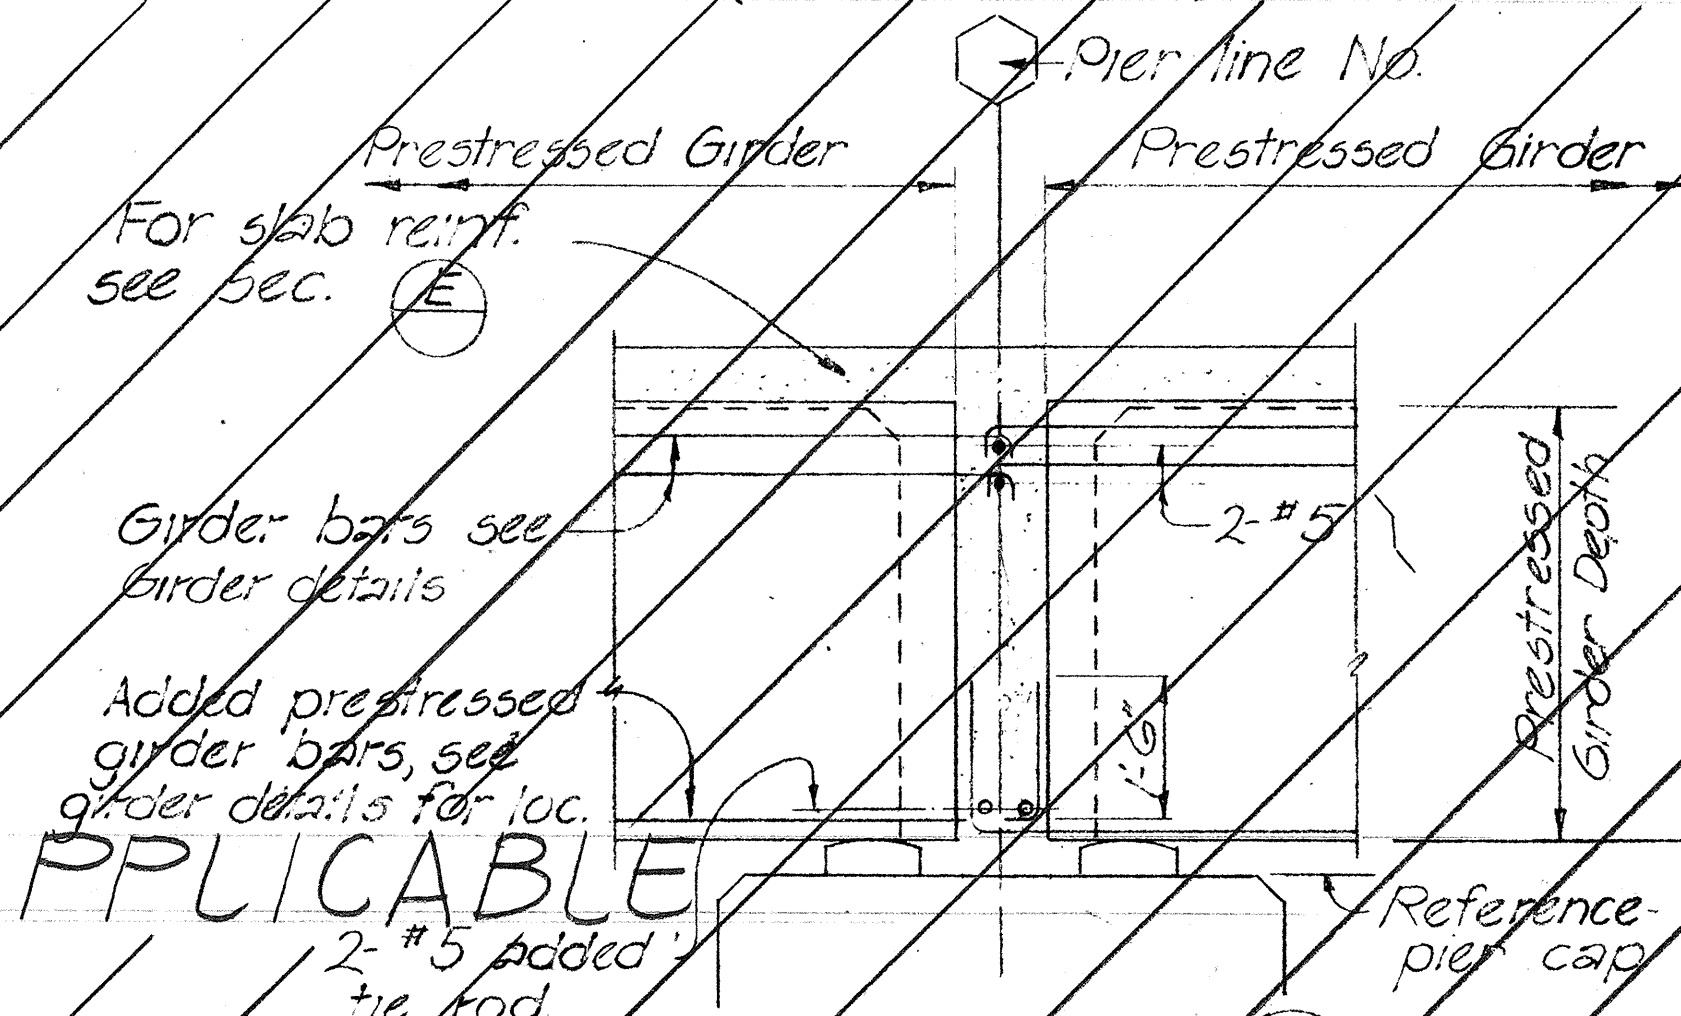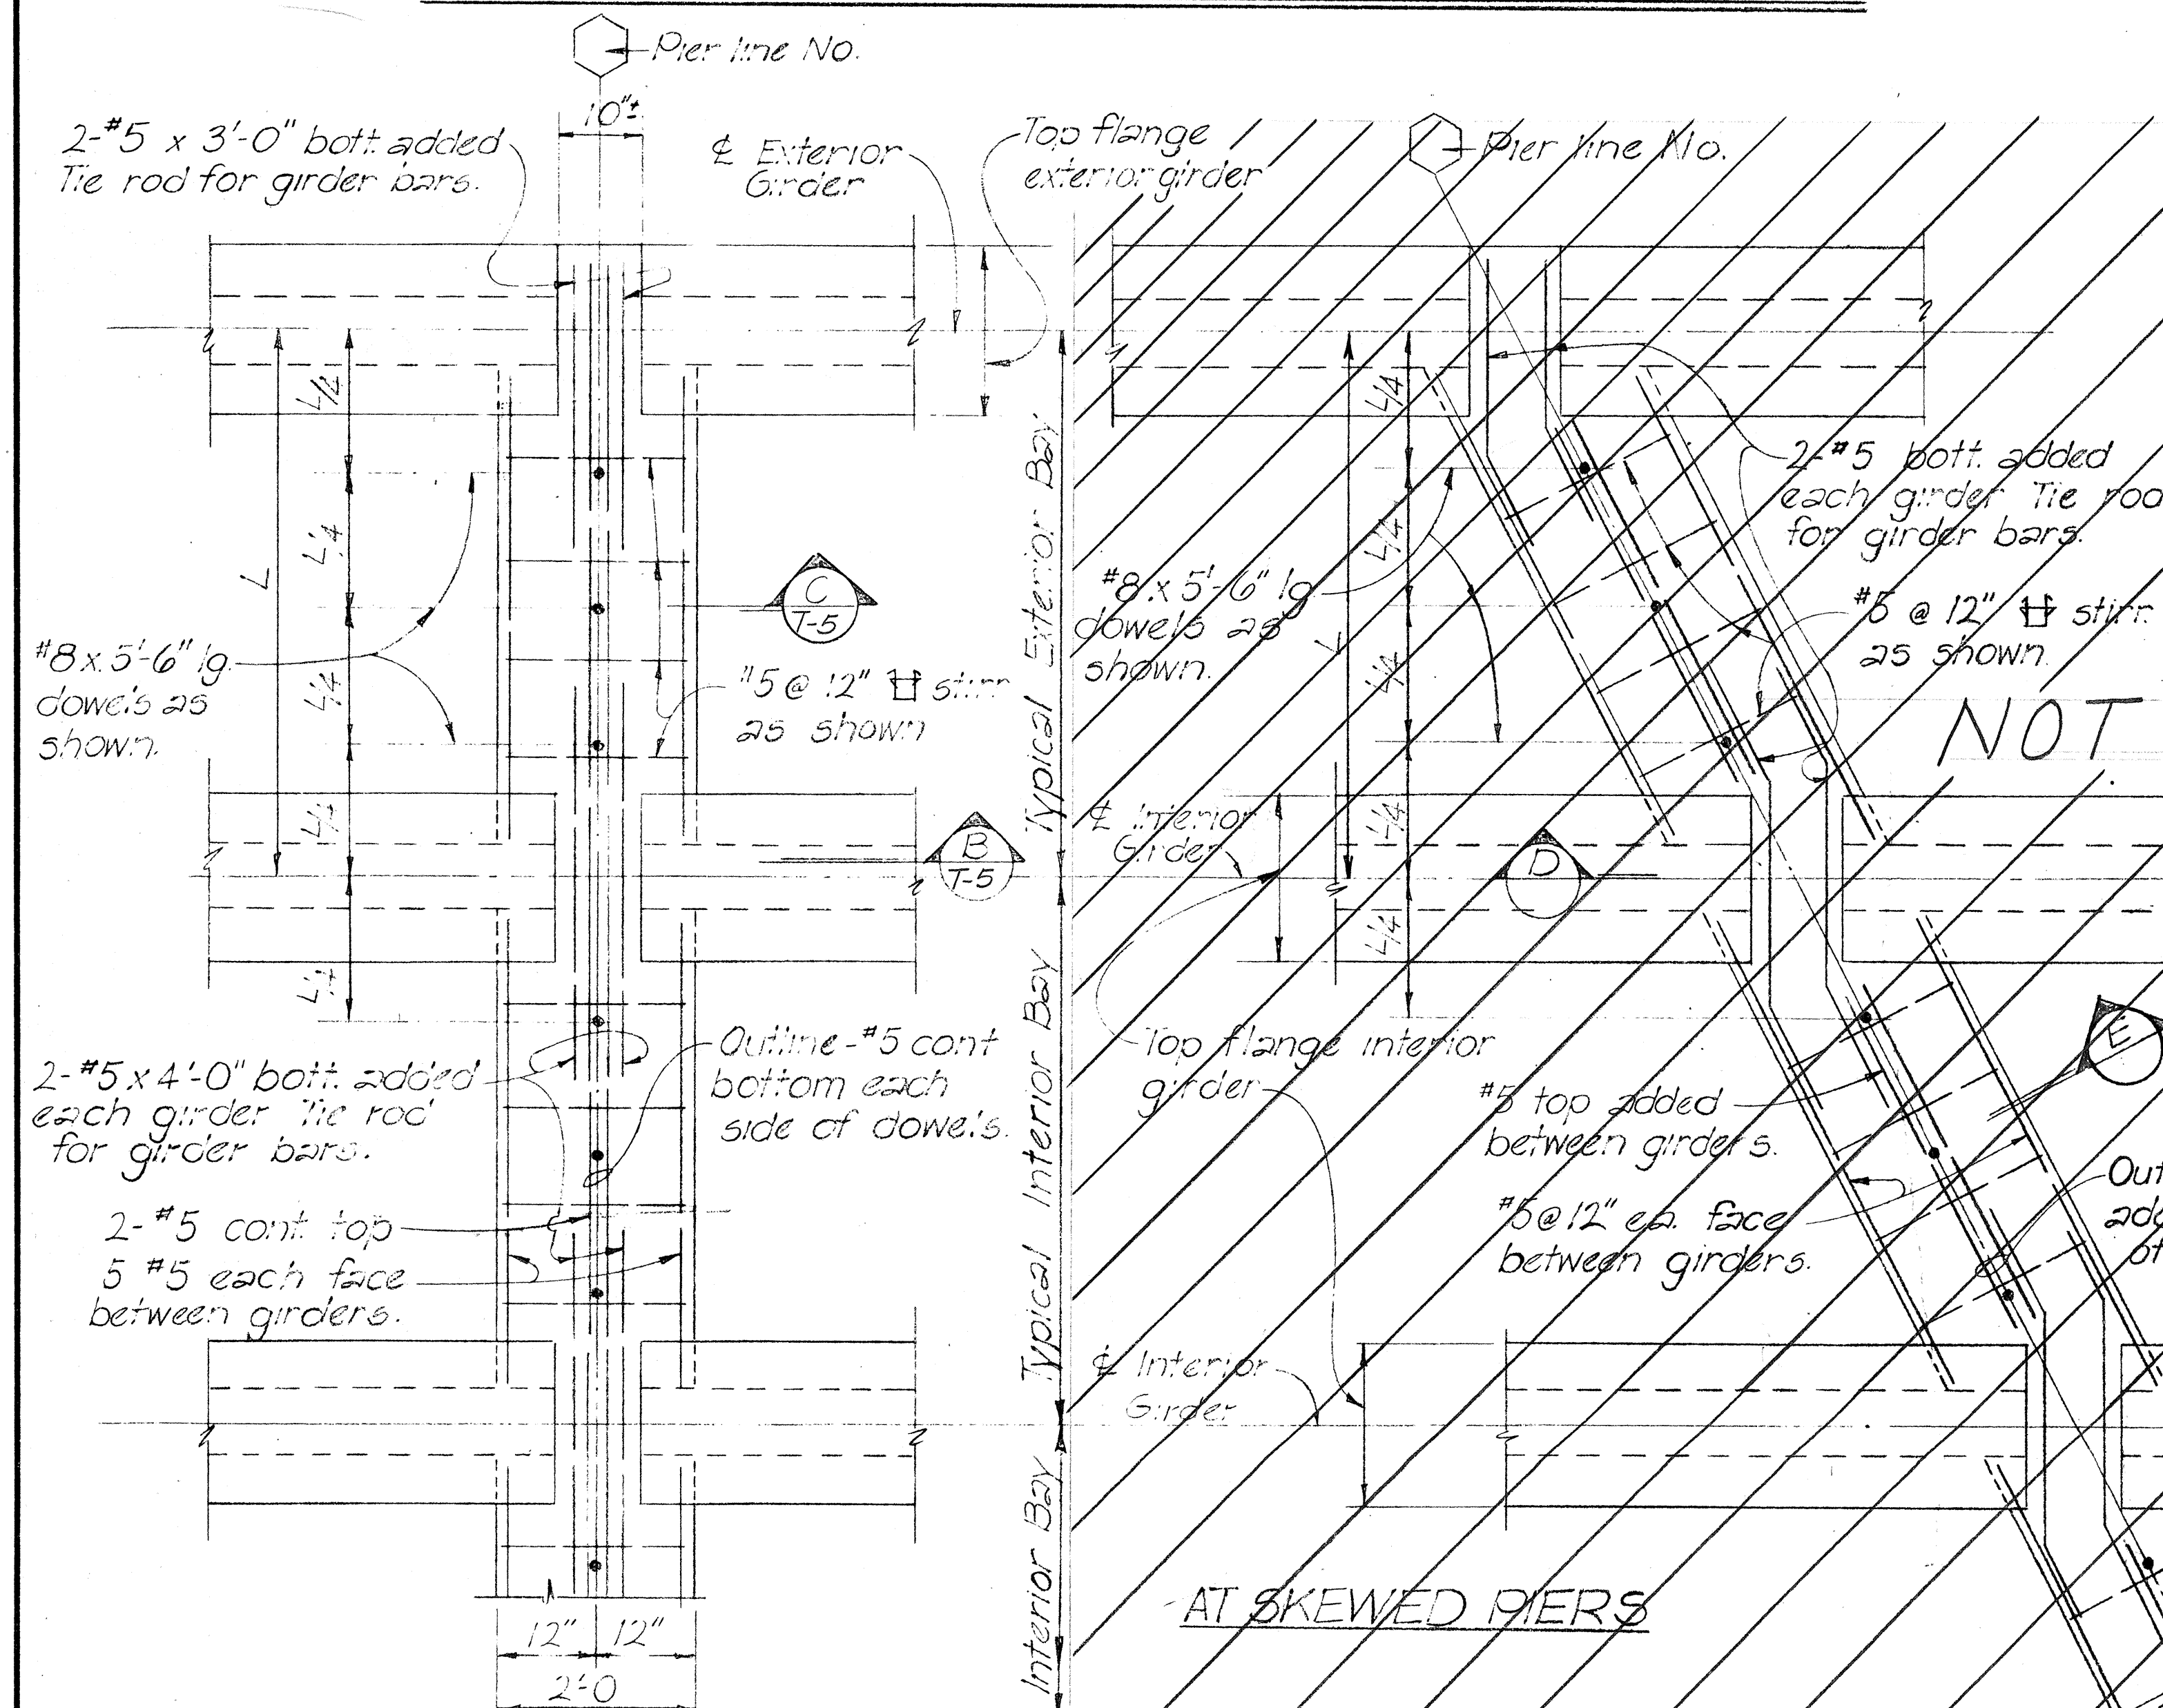

SECTION D-T-5 (AT GIRDERS) Scale: 1/2" = 1'-0"

SECTION E-T-5 (BETWEEN GIRDERS) Scale: 1/2" = 1'-0"

AT RADIAL & NORMAL PIERS

TYPICAL SECTION

A-T-5 Scale: 3/4" = 1'-0"



STATE OF HAWAII
DEPARTMENT OF TRANSPORTATION
HIGHWAYS DIVISION
TYPICAL DETAILS
KILAUEA STREAM BRIDGE
CAST IN PLACE BEAM "D" DETAILS

Proj. No. RF-056-1(10) April 1971



SHEET No. T-5 OF 6 SHEETS

ORIGINAL PLAN	DATE
DRAWN BY	
CHECKED BY	
NOTED BY	
QUANTITY BY	
CHECKED BY	

FED. ROAD DIST. NO.	STATE	FED. AID PROJ. NO.	FISCAL YEAR	SHEET NO.	TOTAL SHEETS
HAWAII	HAW.	RF-056-1(10)	1971	53	74

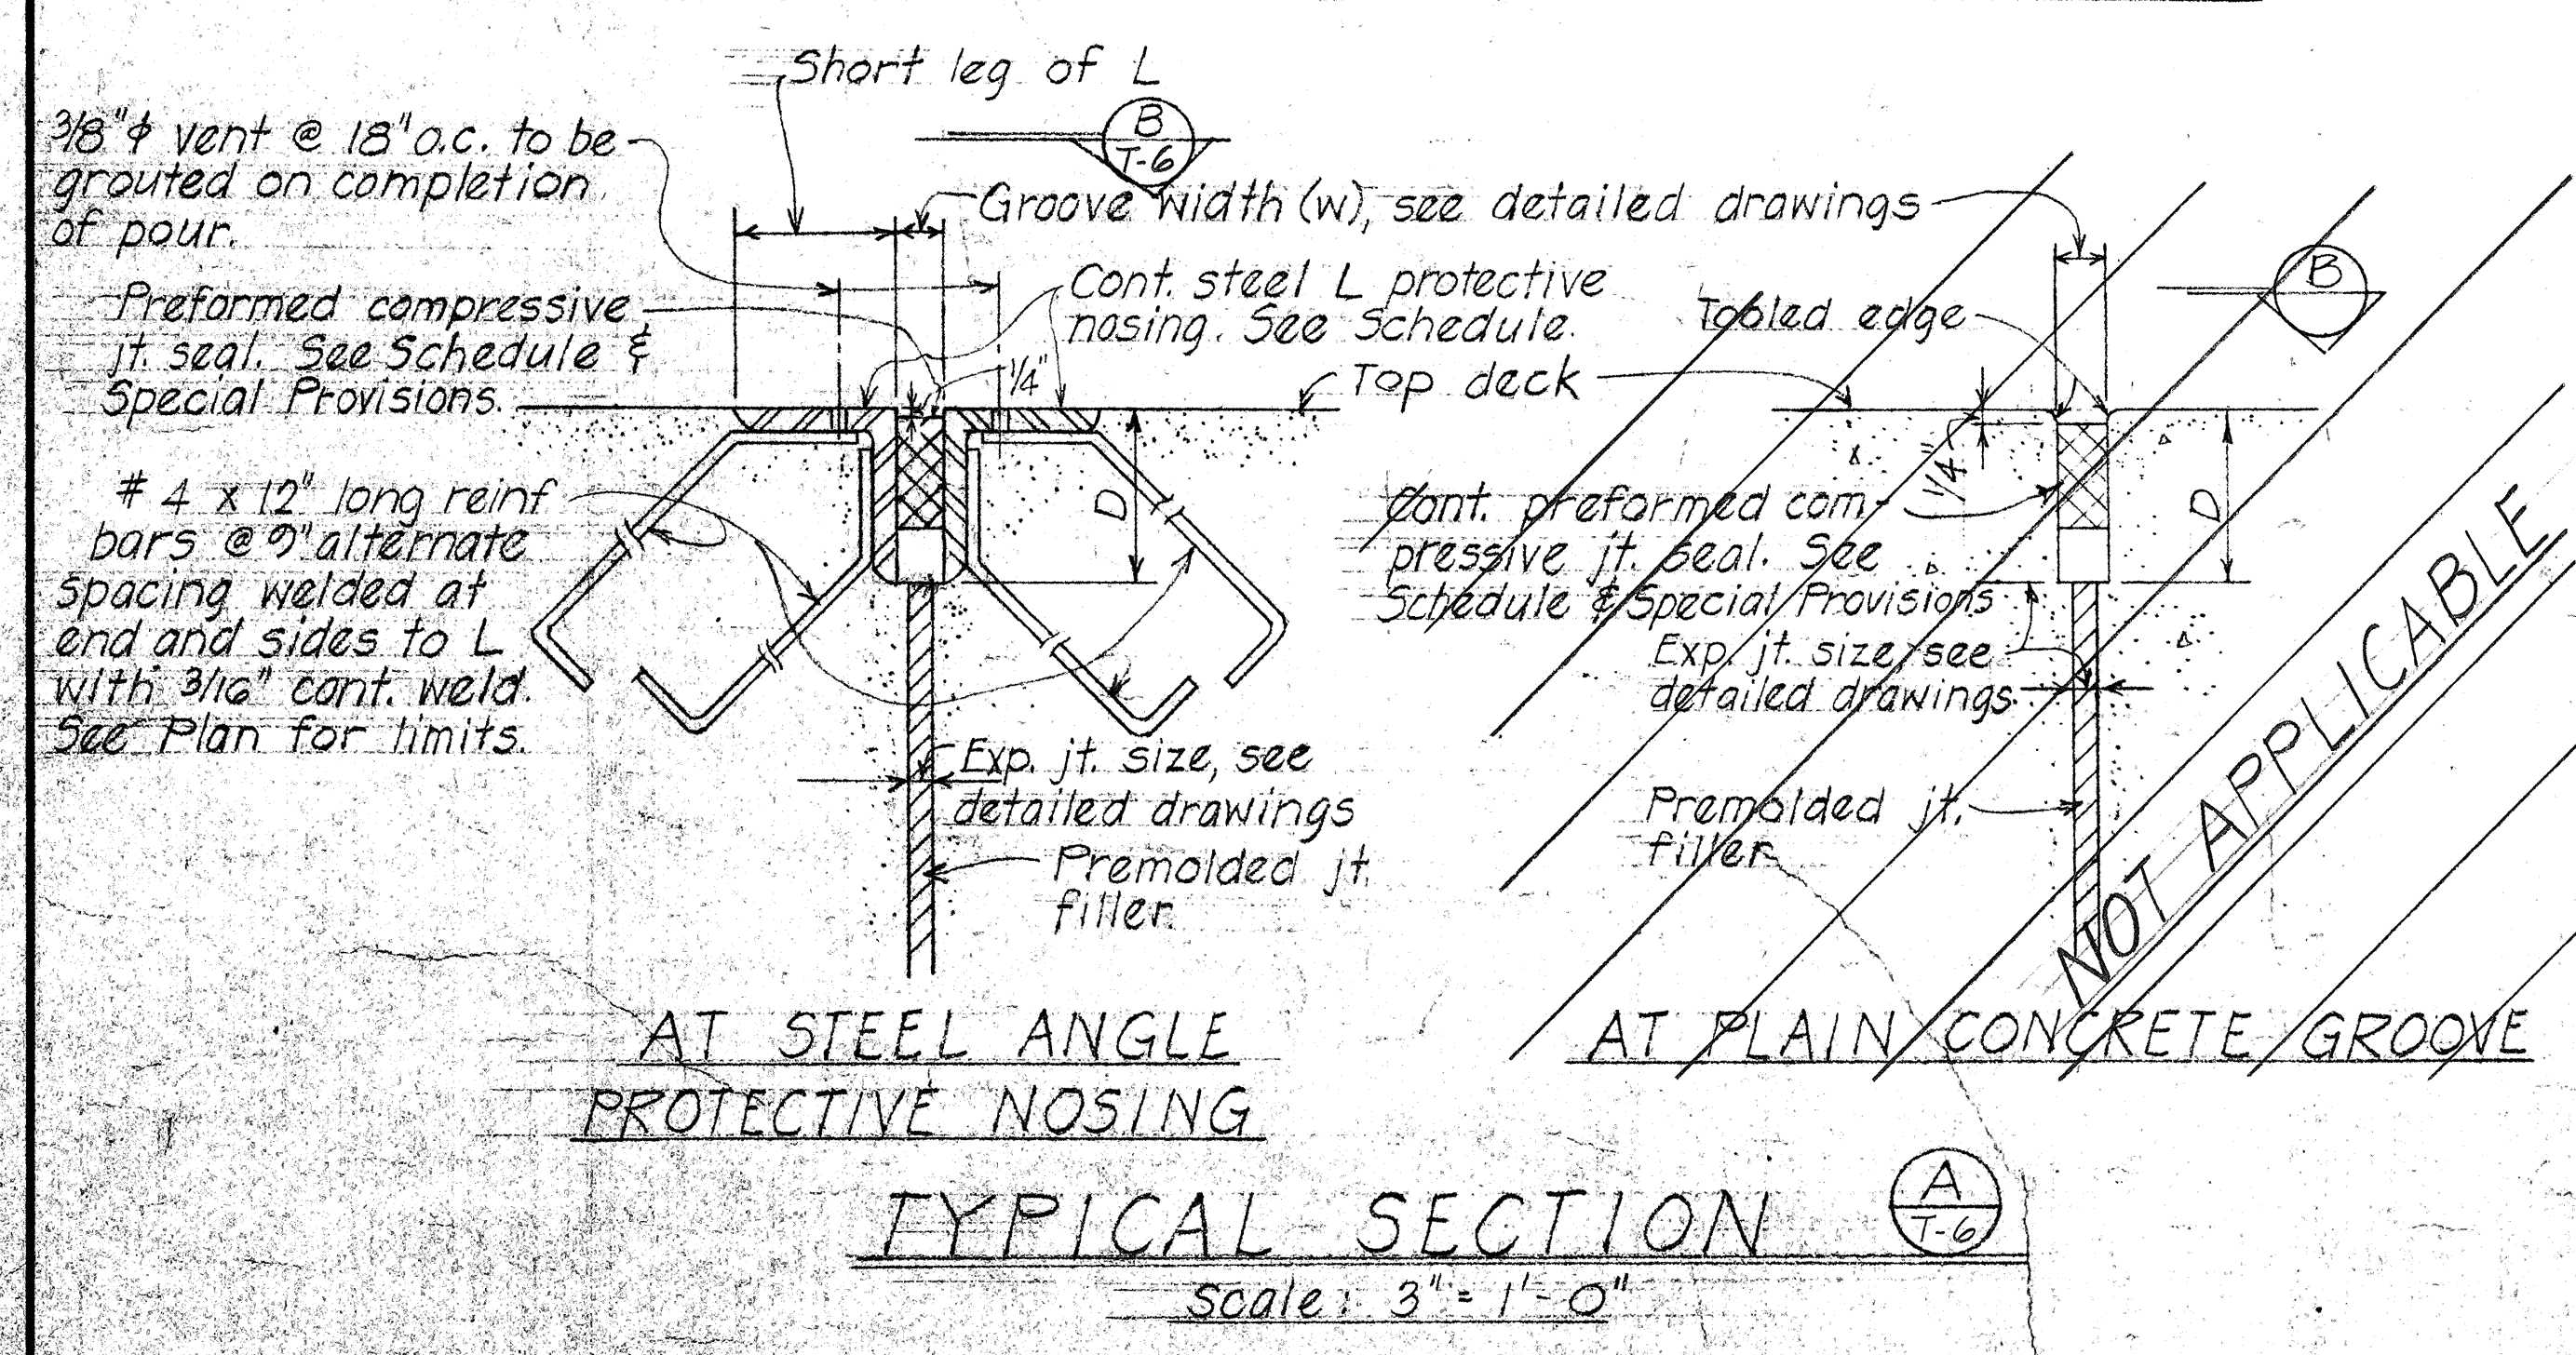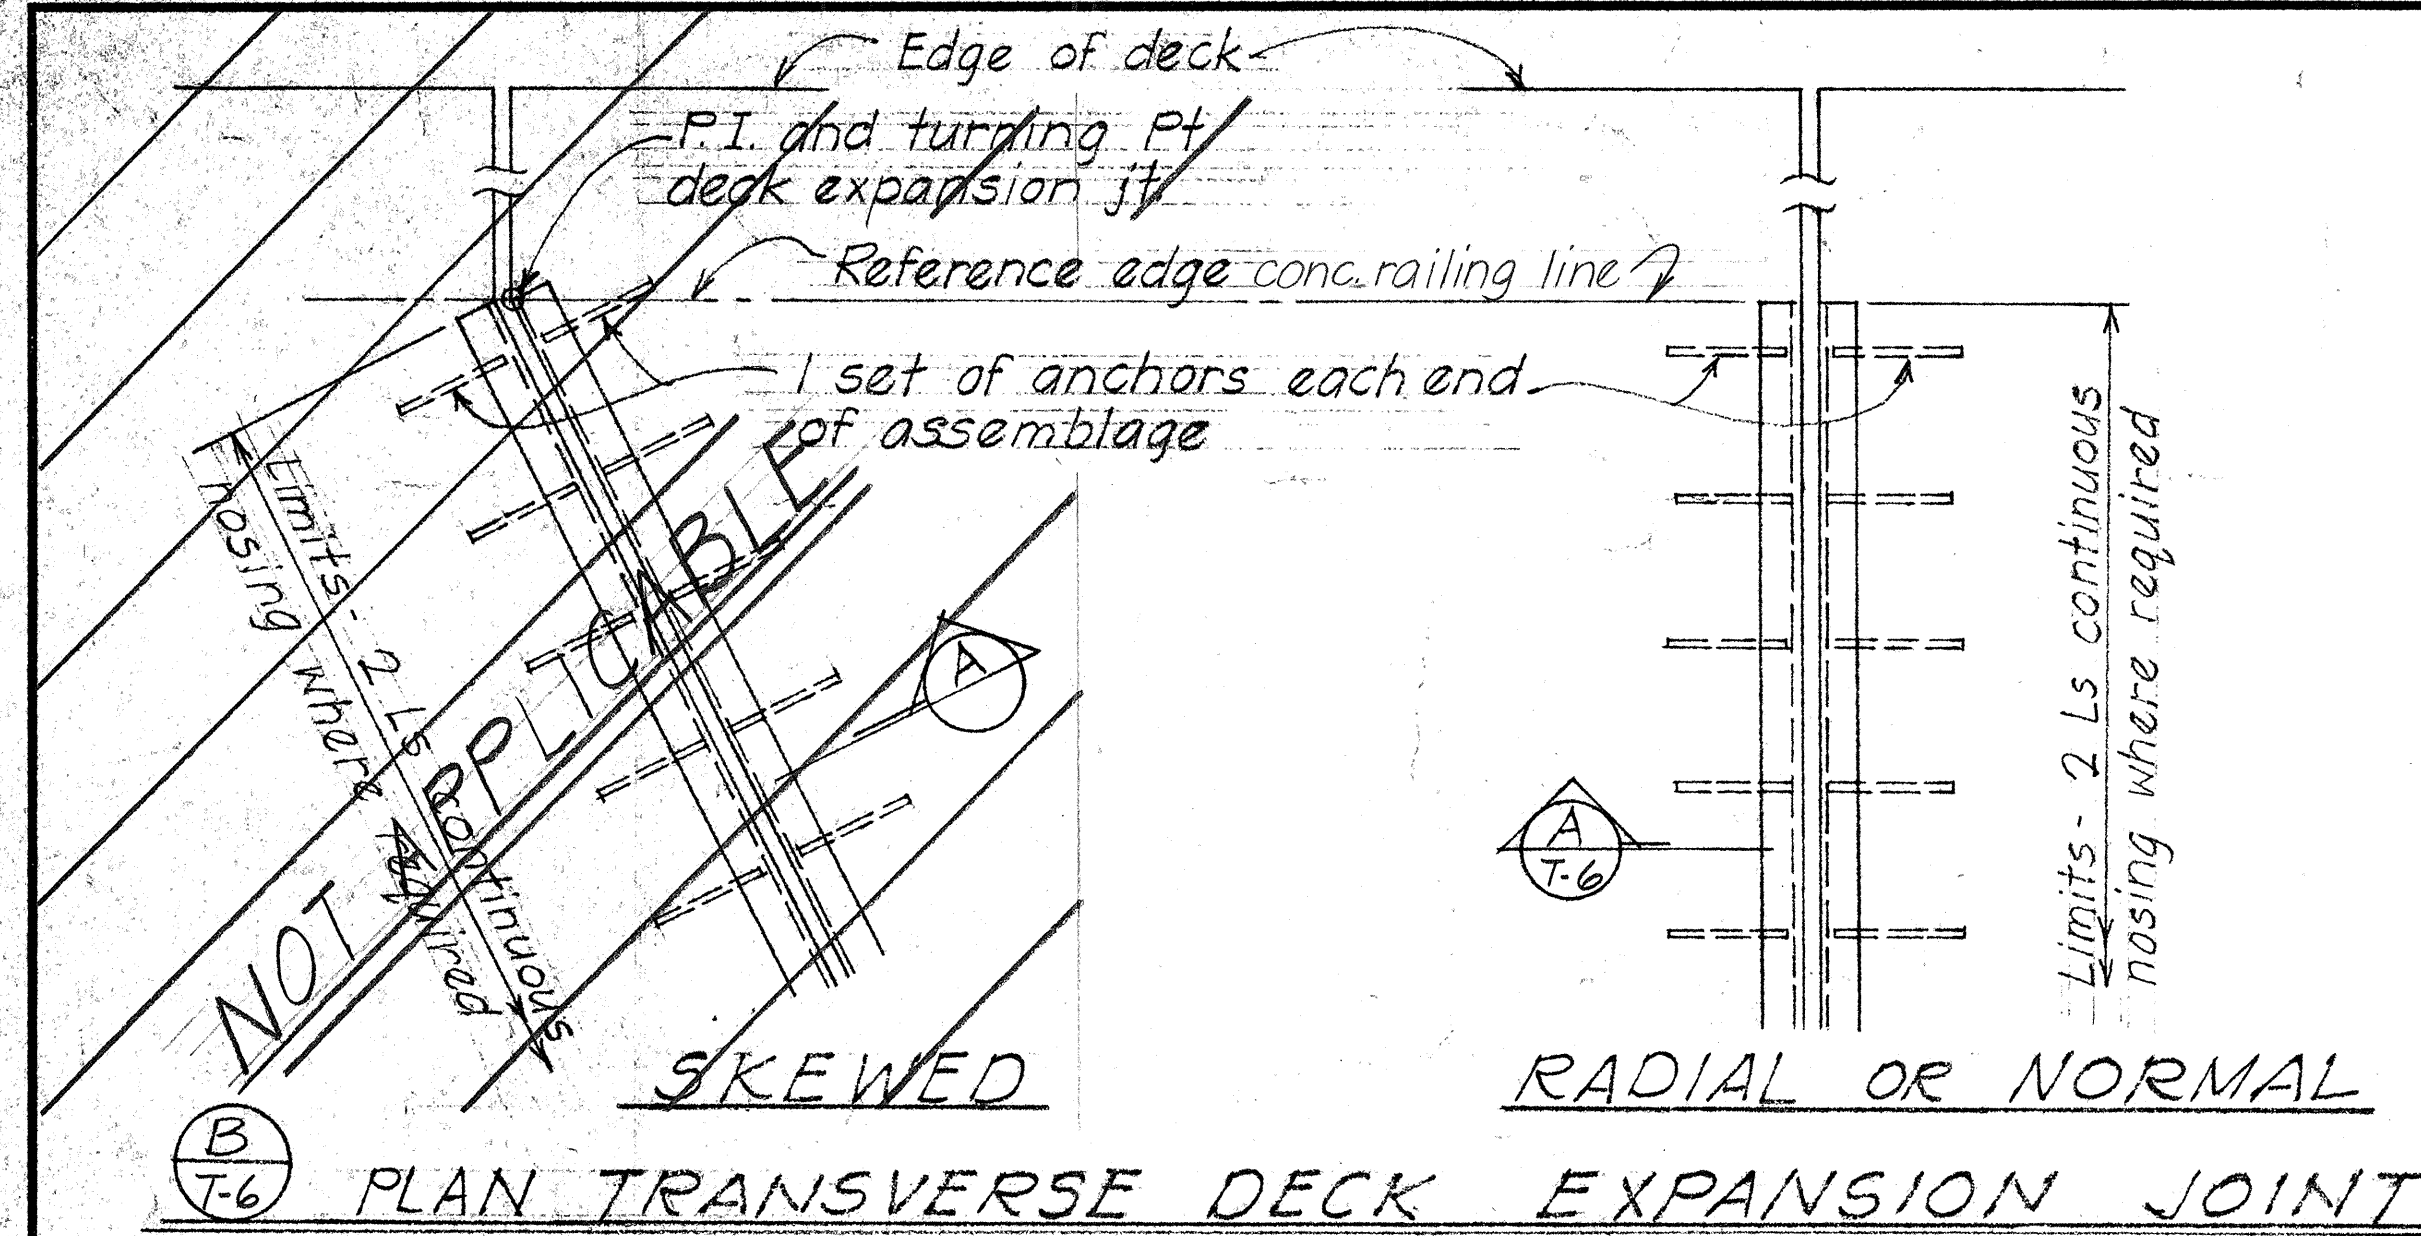

EXPANSION JOINT SEALER SCHEDULE										
Joint Seal Size	Type A - Joint Sealer (Dimensions and Tolerances)				Steel Angle Protective Nosing	Groove Dim. D	Type B - Joint Sealer (Dimensions and Tolerances)			
	J	H	Thickness				J	H	Thickness	
			T	t					T	t
②	1 3/4 +3/16 -0	2 ± 1/8	1/8 +1/32 -1/64	3/32 +1/64 -1/32	3 1/2" x 3 1/2" x 1/2"	3 1/2"	1 3/4 +3/16 -0	2 ± 1/8 +3/16 -0	5/64 +1/32 -0	
③	2 +3/16 -0	2 1/16 ± 1/8	1/8 +1/32 -1/64	3/32 +1/32 -1/64	4" x 3 1/2" x 1/2"	4"	2 +5/32 -0	2 ± 1/8 +1/8 -0	1/16 +1/32 -0	
④	2 1/2 ± 1/4 -0	2 3/4 ± 1/8	3/16 +3/64 -1/64	3/32 +1/32 -1/64	5" x 3 1/2" x 1/2"	5"				
⑤	3 +1/4 -0	3 13/32 ± 3/16	3/16 +3/64 -1/64	1/8 +3/64 -1/64	6" x 3 1/2" x 1/2"	6"				
⑥	4 +5/16 -0	4 23/32 ± 1/4	1/4 +3/64 -1/32	3/16 +3/64 -1/64	7" x 4" x 1/2"	7"				

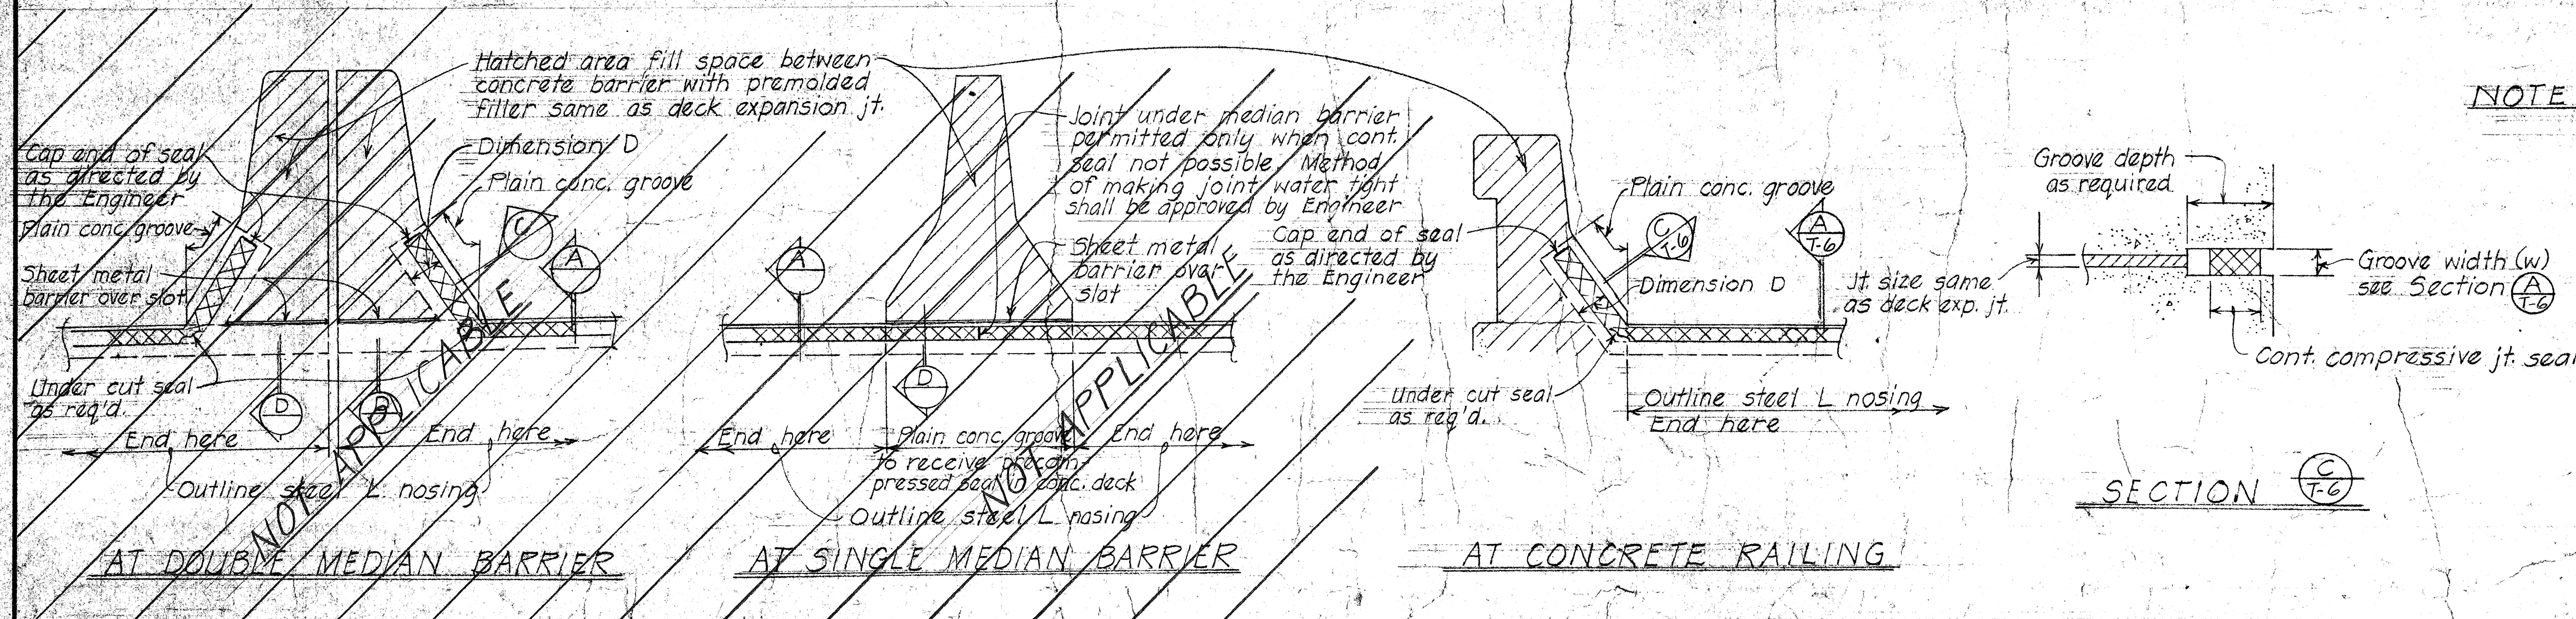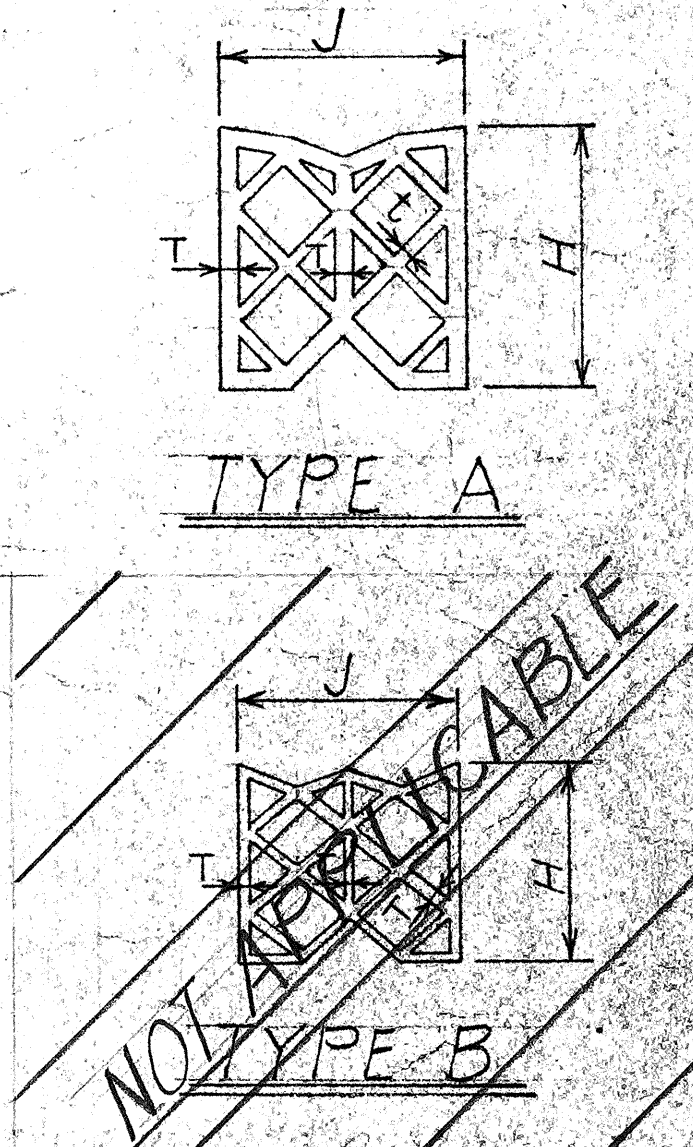

NOTE: Steel angle protective nosing assembly to be hot dipped galvanized after fabrication. Steel angle protective nosing assembly and joint sealer incidental to concrete and will not be paid for separately.

STATE OF HAWAII
DEPARTMENT OF TRANSPORTATION
HIGHWAYS DIVISION

TYPICAL DETAILS

EXPANSION JOINT PREFORMED
COMPRESSIVE JOINT SEALER
WATERPROOFING DETAILS
KILAUEA STREAM BRIDGE
Proj. No. RF-056-1(10) Apr. 1971

SHEET No. 7-6 OF 6 SHEETS


DATE
SURVEY PLOTTED BY
DRAWN BY
DESIGNED BY
NOTES BOOK
QUANTITIES BY
CHECKED BY

GENERAL NOTES

- All concrete shall be Class A unless otherwise noted.
- Reinforcing shall be detailed in accordance with A.C.I. Manual of Standard Practice for Detailing Reinforced Concrete Highway Structures unless otherwise noted.
- Clearance for reinforcing bars shall be as follows, unless otherwise noted:
 - 1/2" For stirrups of beams & pier caps.
 - 2" For ties of columns.
 - 2" For formed walls.
 - 3" For footings.
- Minimum spacing between parallel bars shall be 2 1/2 times the diameter of bars, but in no case shall the clear distance between the bars be less than 1 1/2 times the maximum size of the coarse aggregate.
- All dimensions relating to reinforcing are to centers of bars unless otherwise noted.
- Reinforcing bars shall be securely tied at all intersections & lap splices & shall be held in place during pouring to maintain their proper locations as shown on plans.
- Vertical column bars shall be arranged in such a manner as to miss pier cap bars above as directed by the Engineer.
- Except as otherwise noted on drawings, all exterior corners & re-entrant angles in concrete work shall be chamfered 3/4" x 3/4".
- Concrete seats receiving steel plates, lead plates or neoprene pads shall be poured monolithically with supporting structures & top of concrete seats shall be finished with a steel trowel to a smooth level surface at the elevation shown on the plans.
- Elastomeric Pads: Bottom of bridge bearing pads shall be secured against displacement with adhesives approved by the Engineer. Pads shall be incidental to concrete and will not be paid for separately.
- Forms for all exposed surfaces of separation structures and surfaces of retaining walls visible from a traveled way or from a populated area shall be plywood except that metal forms may be permitted provided a surface finish satisfactory to the Engineer can be obtained and the use of such forms is approved in writing by the Engineer. Forms for round columns shall be made of materials that will give a smooth finish and true dimensions as given in the plans. Forms for prestressed concrete members shall be either metal or plywood.
- Gothic letters and figures approximating dimensions shown will be acceptable if approved by the Engineer.
- The contractor shall verify the location of all existing utility lines and notify the respective owners before commencing work of excavation or driving of piles.
- Standard Detail Drawings refer to all structures in general, except for modifications as may be required for special conditions. For such modifications refer to the corresponding detailed drawings.

TYPICAL CONCRETE GROOVE DETAIL


DRIP DETAIL

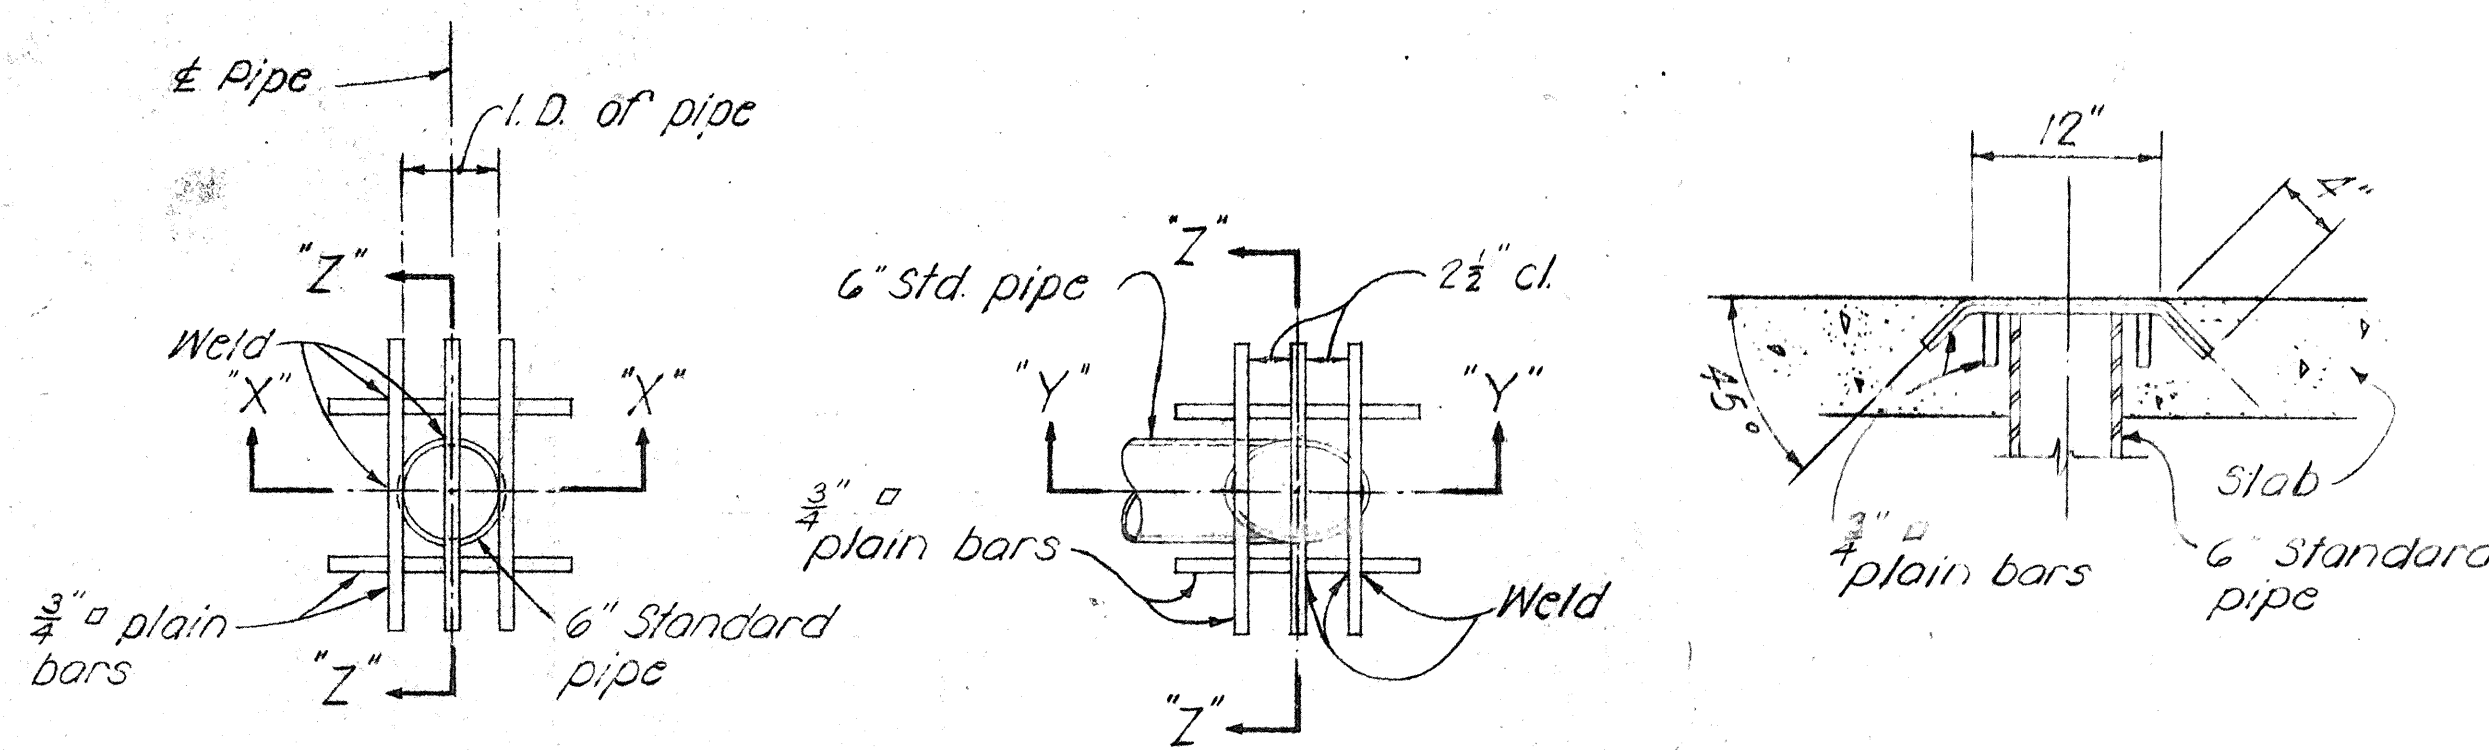

PLAN

PLAN

SECTION "Z-Z"

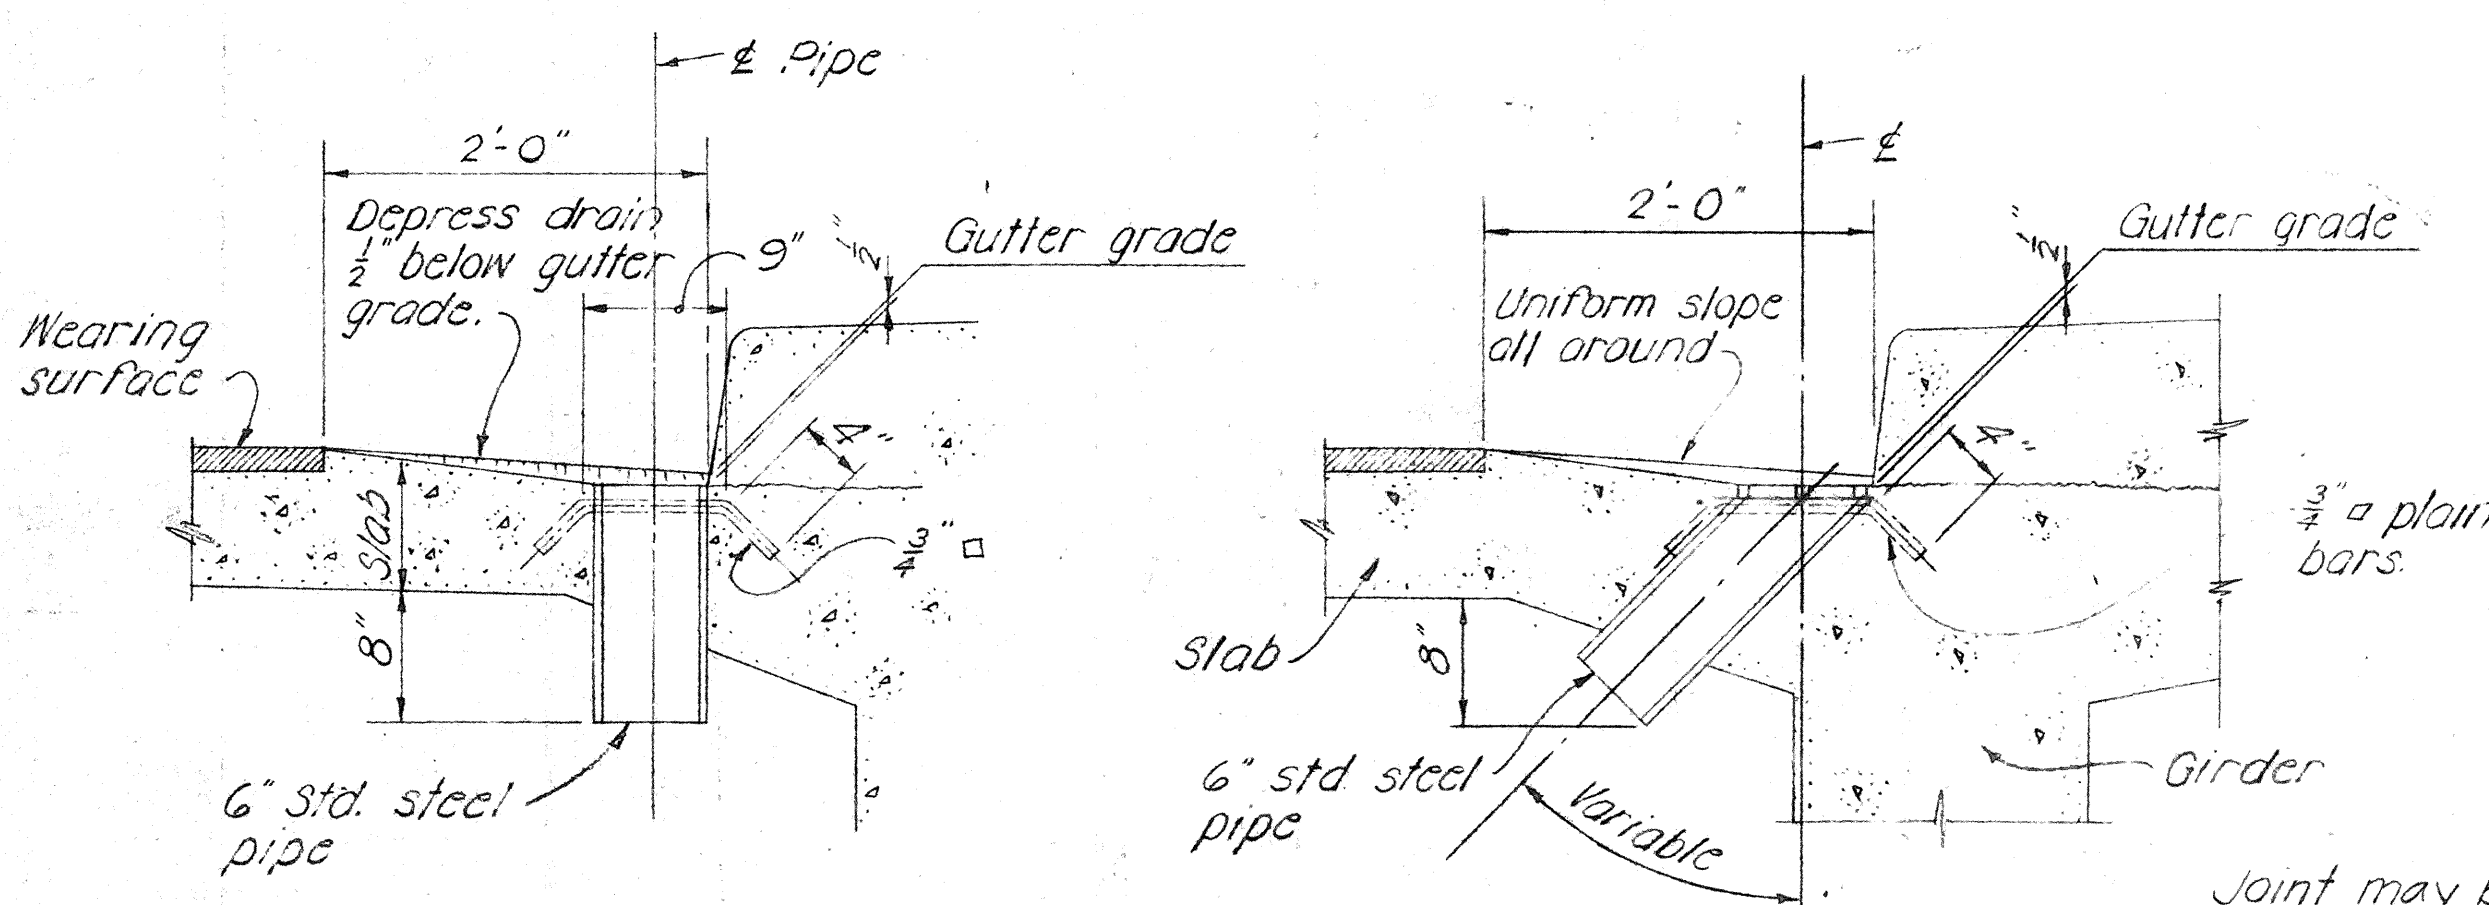


SECTION "X-X"


SECTION "Y-Y"

NOTE: Metal drains shall be considered incidental to Class A Concrete in both concrete and steel bridges and will not be paid for separately. Assembly of grillage and pipe shall be hot-dip galvanized after all welding is completed.

TYPICAL DRAINAGE DETAILS


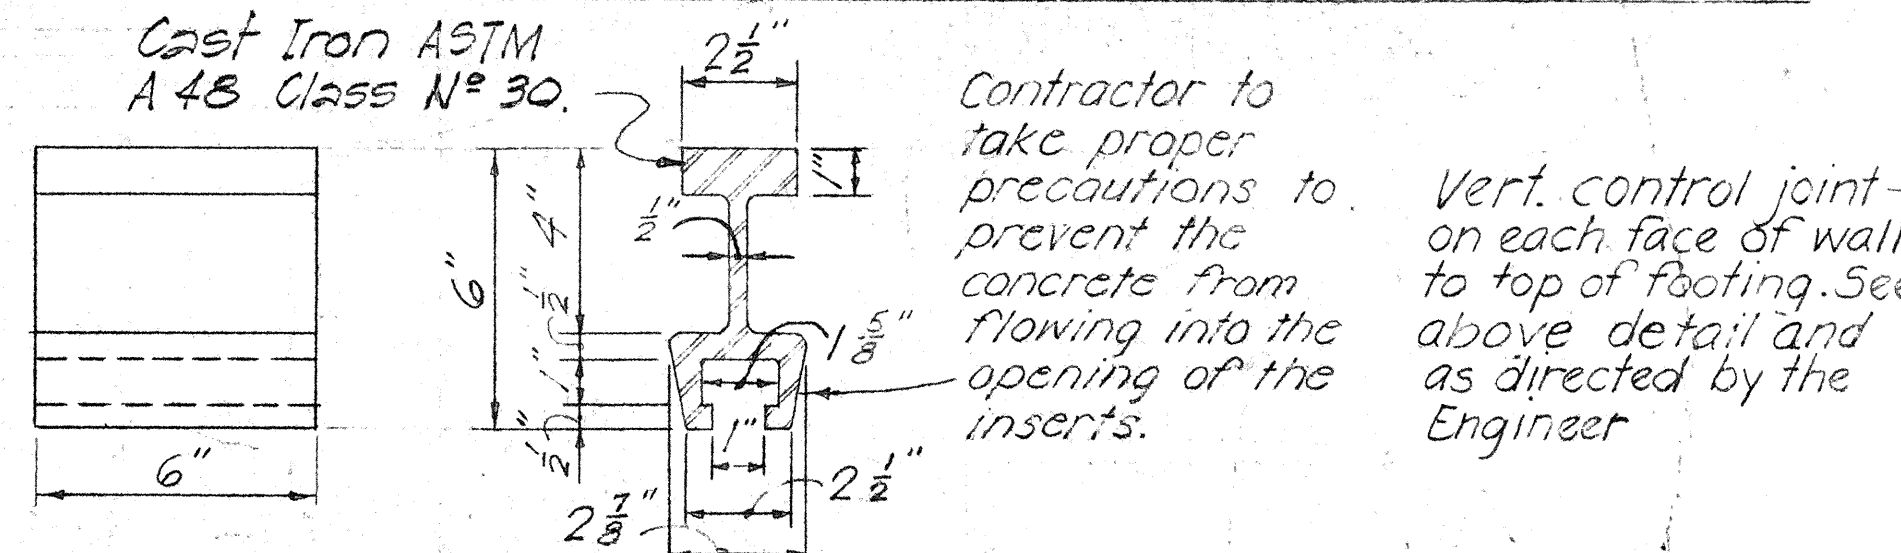


INSERT DETAIL

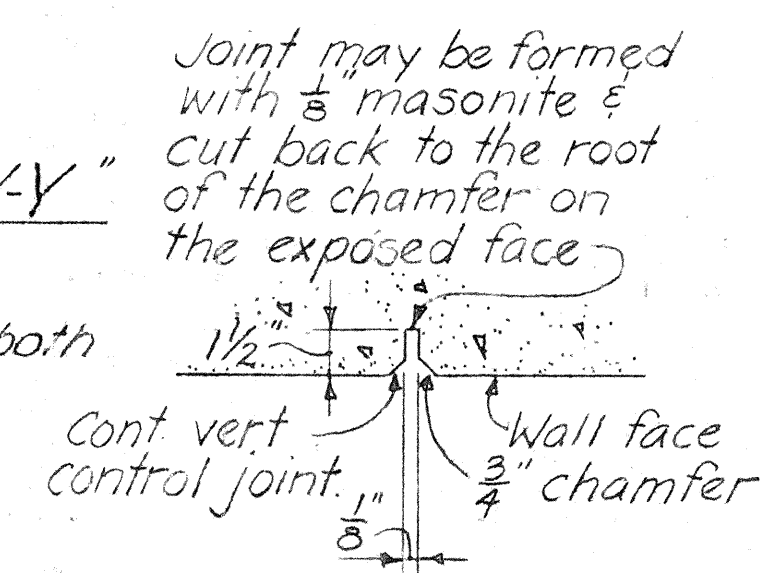

CONTROL JOINT DETAILS

TYP FLASHING COMPOUND WATERPROOFING DETAIL

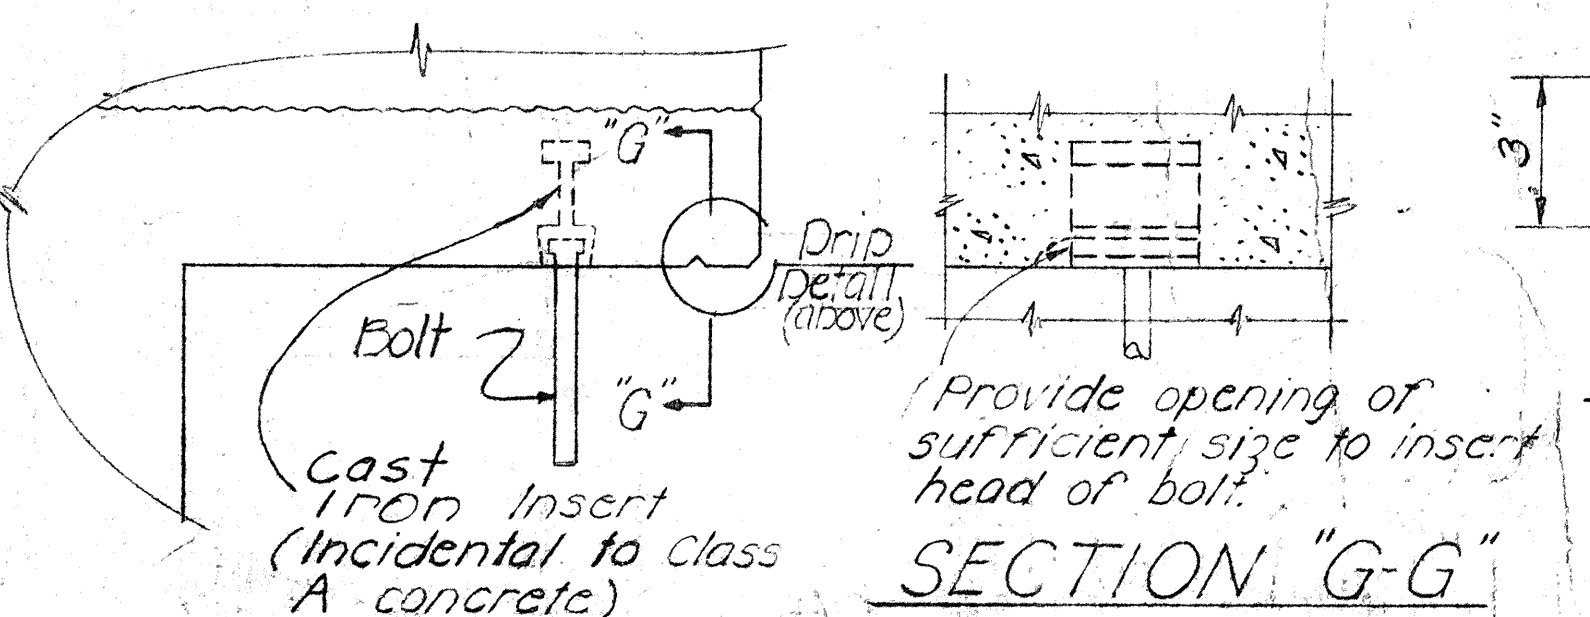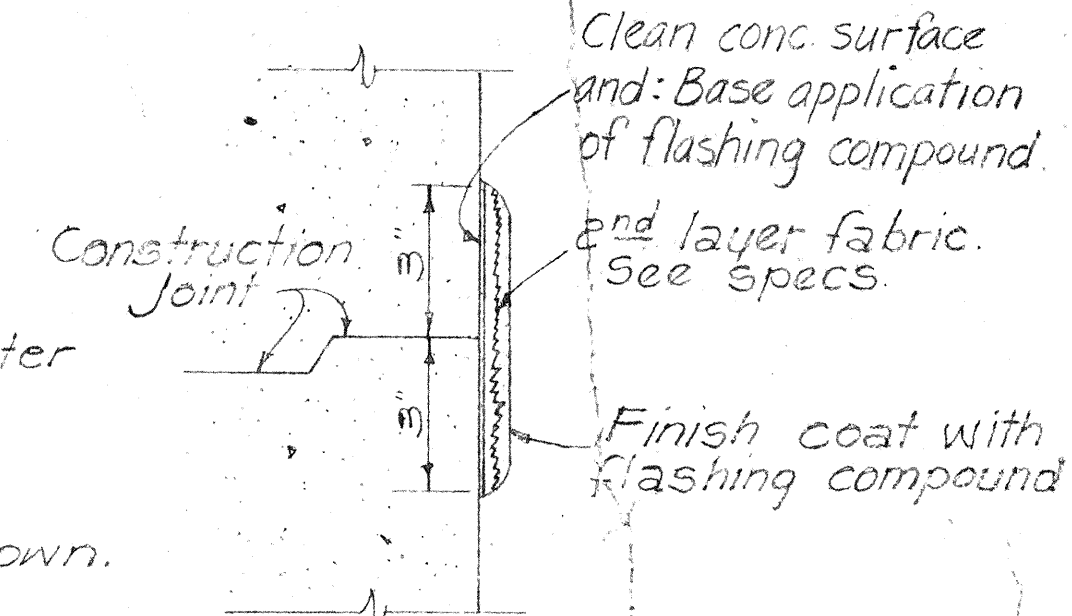


SECTION "G-G"

NAME DATE

Use correct name of bridge Date of Year built
NOTE: Refer to corresponding detail drawings for placement of such names & dates at end post. Exact details & spacing of letters & figures shall be as directed by the Engineer. See Note #12.

TYPICAL DETAIL OF LETTERS & FIGURES AT CONCRETE END POST

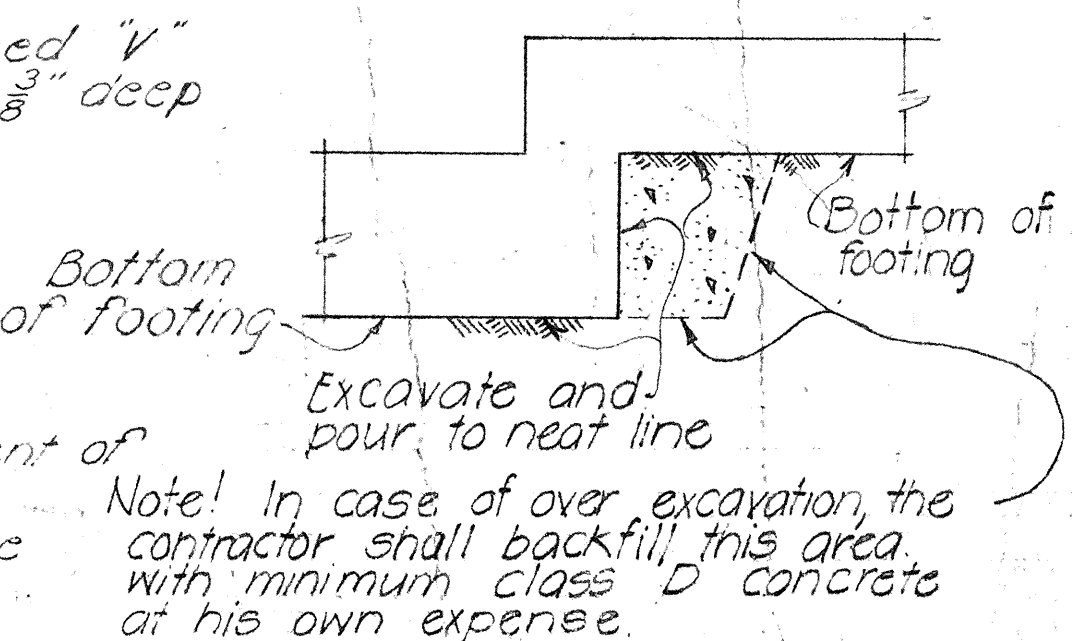

TYPICAL EXCAVATION FOR CONTINUOUS FOOTING STEP-UP

APPROVAL RECOMMENDED:
 Paul T. Yamashita
 BRIDGE DESIGN ENGINEER 1-23-70
 DATE

APPROVED
 Paul T. Yamashita
 ASSISTANT CHIEF, ENGINEERING 1-28-70
 DATE


NO.	REVISION	APPROVED BY	DATE

STATE OF HAWAII
 DEPARTMENT OF TRANSPORTATION
 HIGHWAYS DIVISION
STANDARD DETAILS
 NOTES AND MISCELLANEOUS
 DETAILS

DATE
 SURVEY PLOTTED BY
 DRAWN BY
 DESIGNED BY
 CHECKED BY
 ORIGINAL
 NOTE BOOK
 No.

K-E CRYSTALENE® LA 2020
TEACHING PAPER

FED. ROAD DIST. NO.	STATE	FED. AID PROJ. NO.	FISCAL YEAR	SHEET NO.	TOTAL SHEETS
HAWAII	HAW.	RF-056-1(10)	1971	56	74

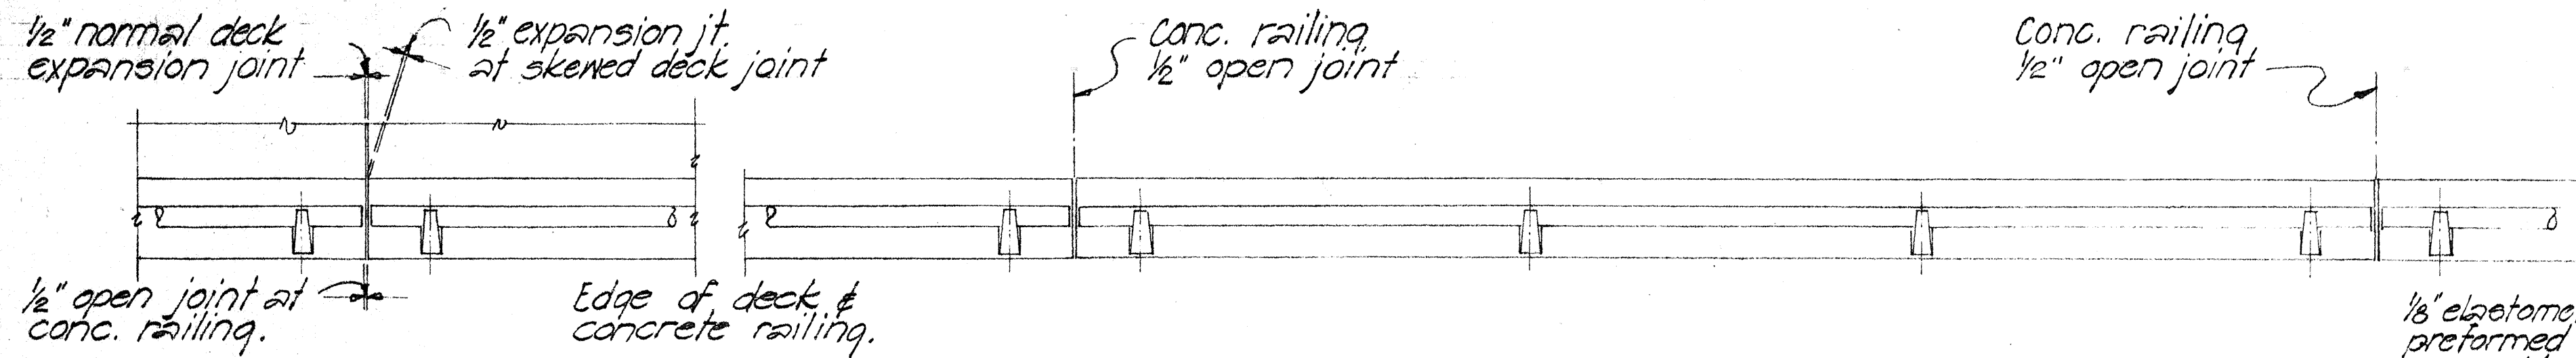


AT DECK EXPANSION JOINT

**** Note !!**
 1. The contractor shall layout the railing to provide 3 cont. panels whenever possible. 12 or 4 cont. panels will be permitted to complete the layout when 3 cont. panels cannot be made. Single panels will not be permitted.


RAILING PLAN SCALE 3/8" = 1'-0"

- Rail Posts shall be normal to grade.
- Provide double posts at each expansion jt., fixed bridge jt., continuous support, and as shown on detailed drawing.

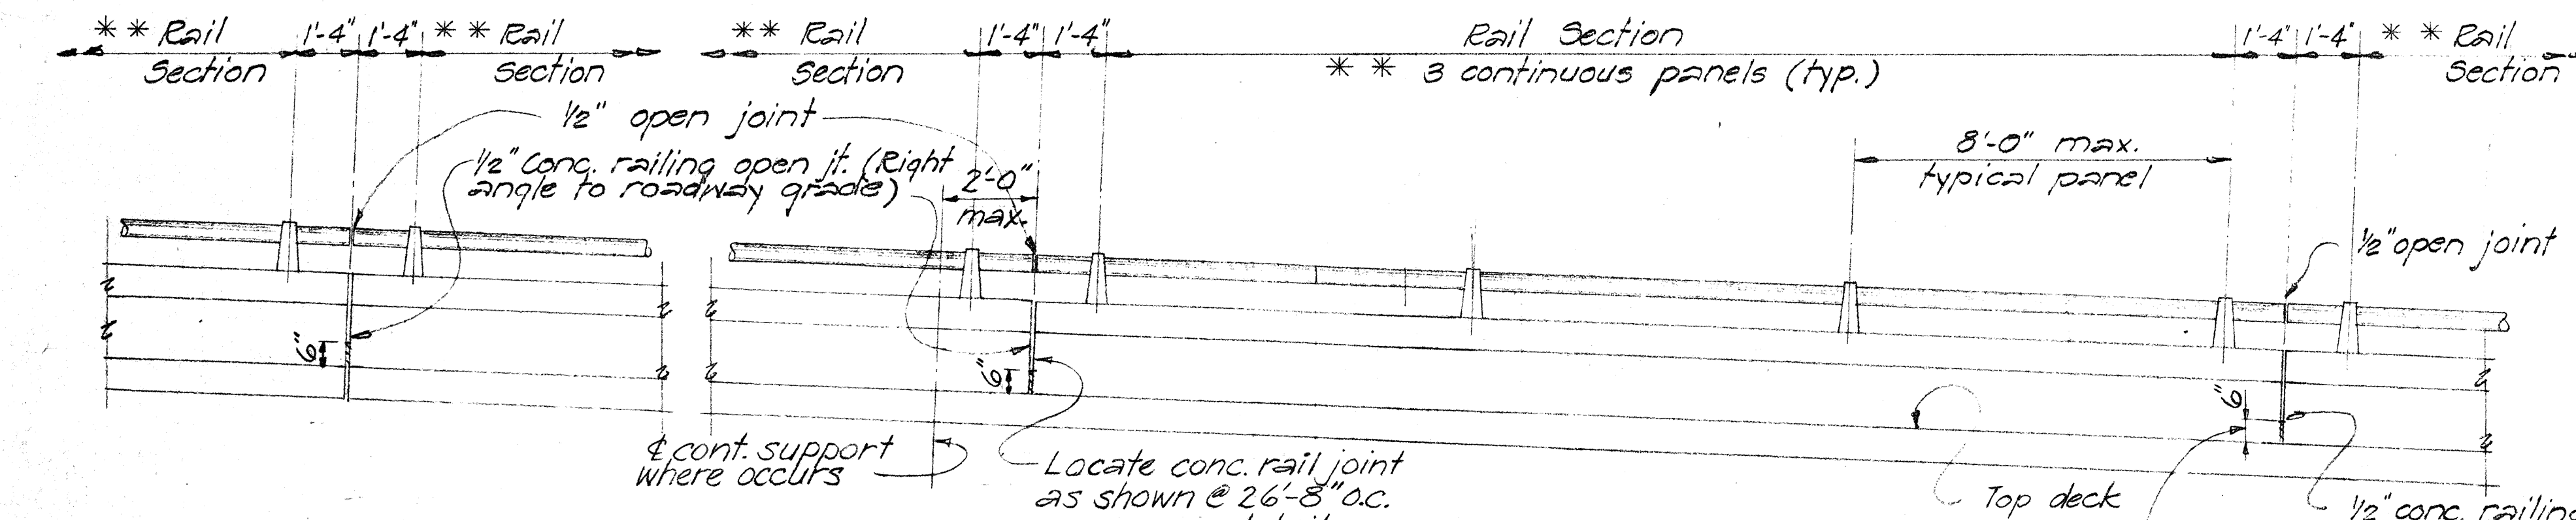


AT DECK EXPANSION JOINT

EXTERIOR RAILING ELEVATION SCALE: 3/8" = 1'-0"

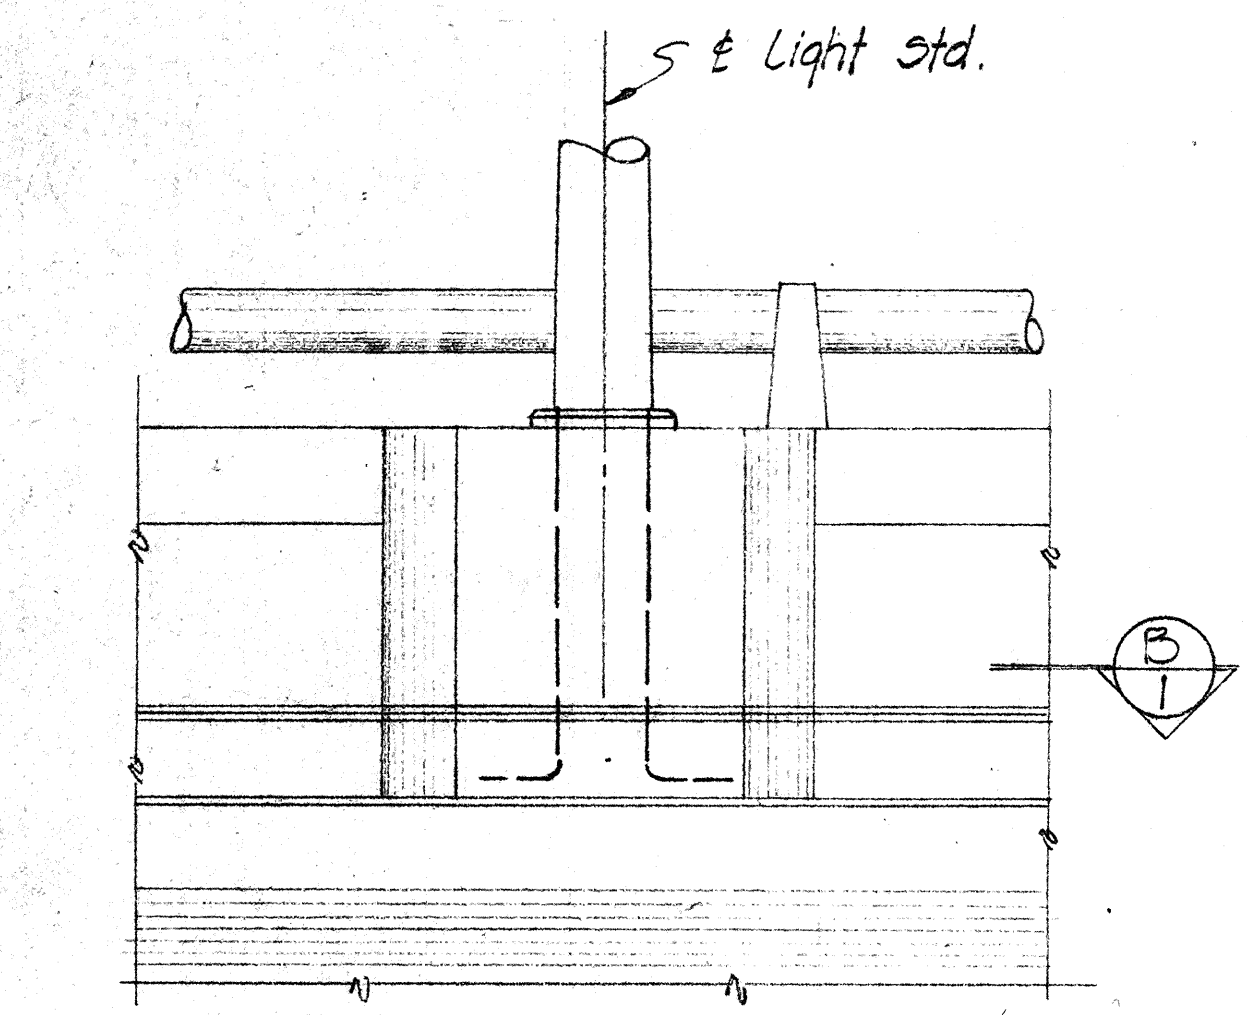


PART ELEVATION

SCALE: 3/4" = 1'-0"

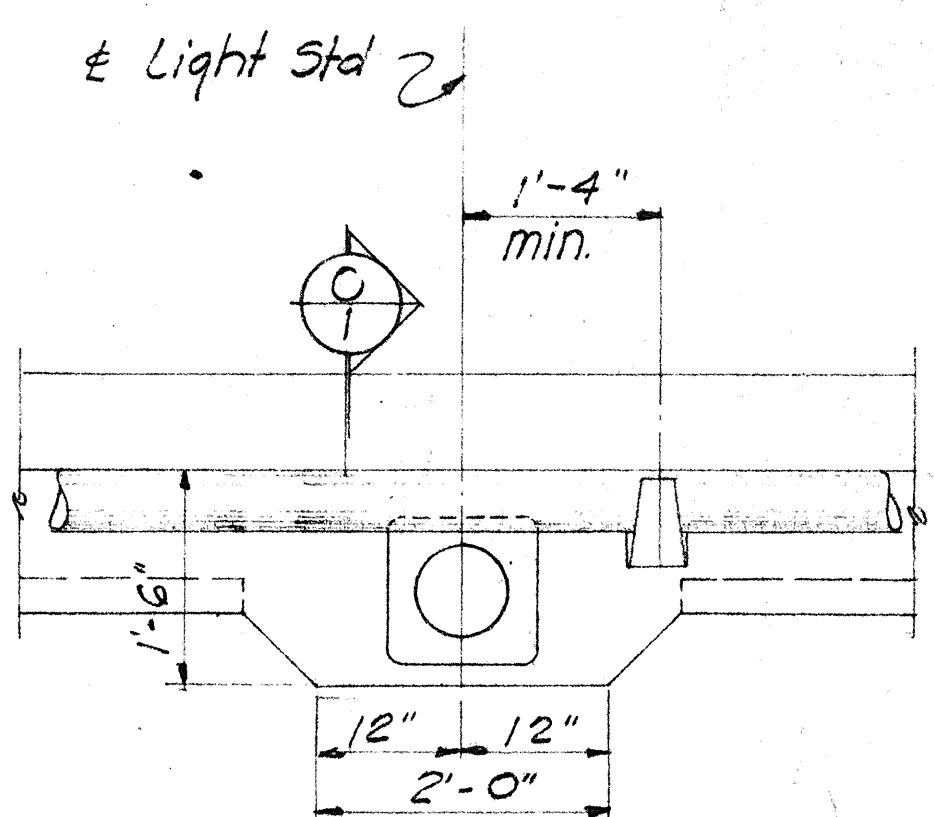

PART PLAN

SCALE: 3/4" = 1'-0"

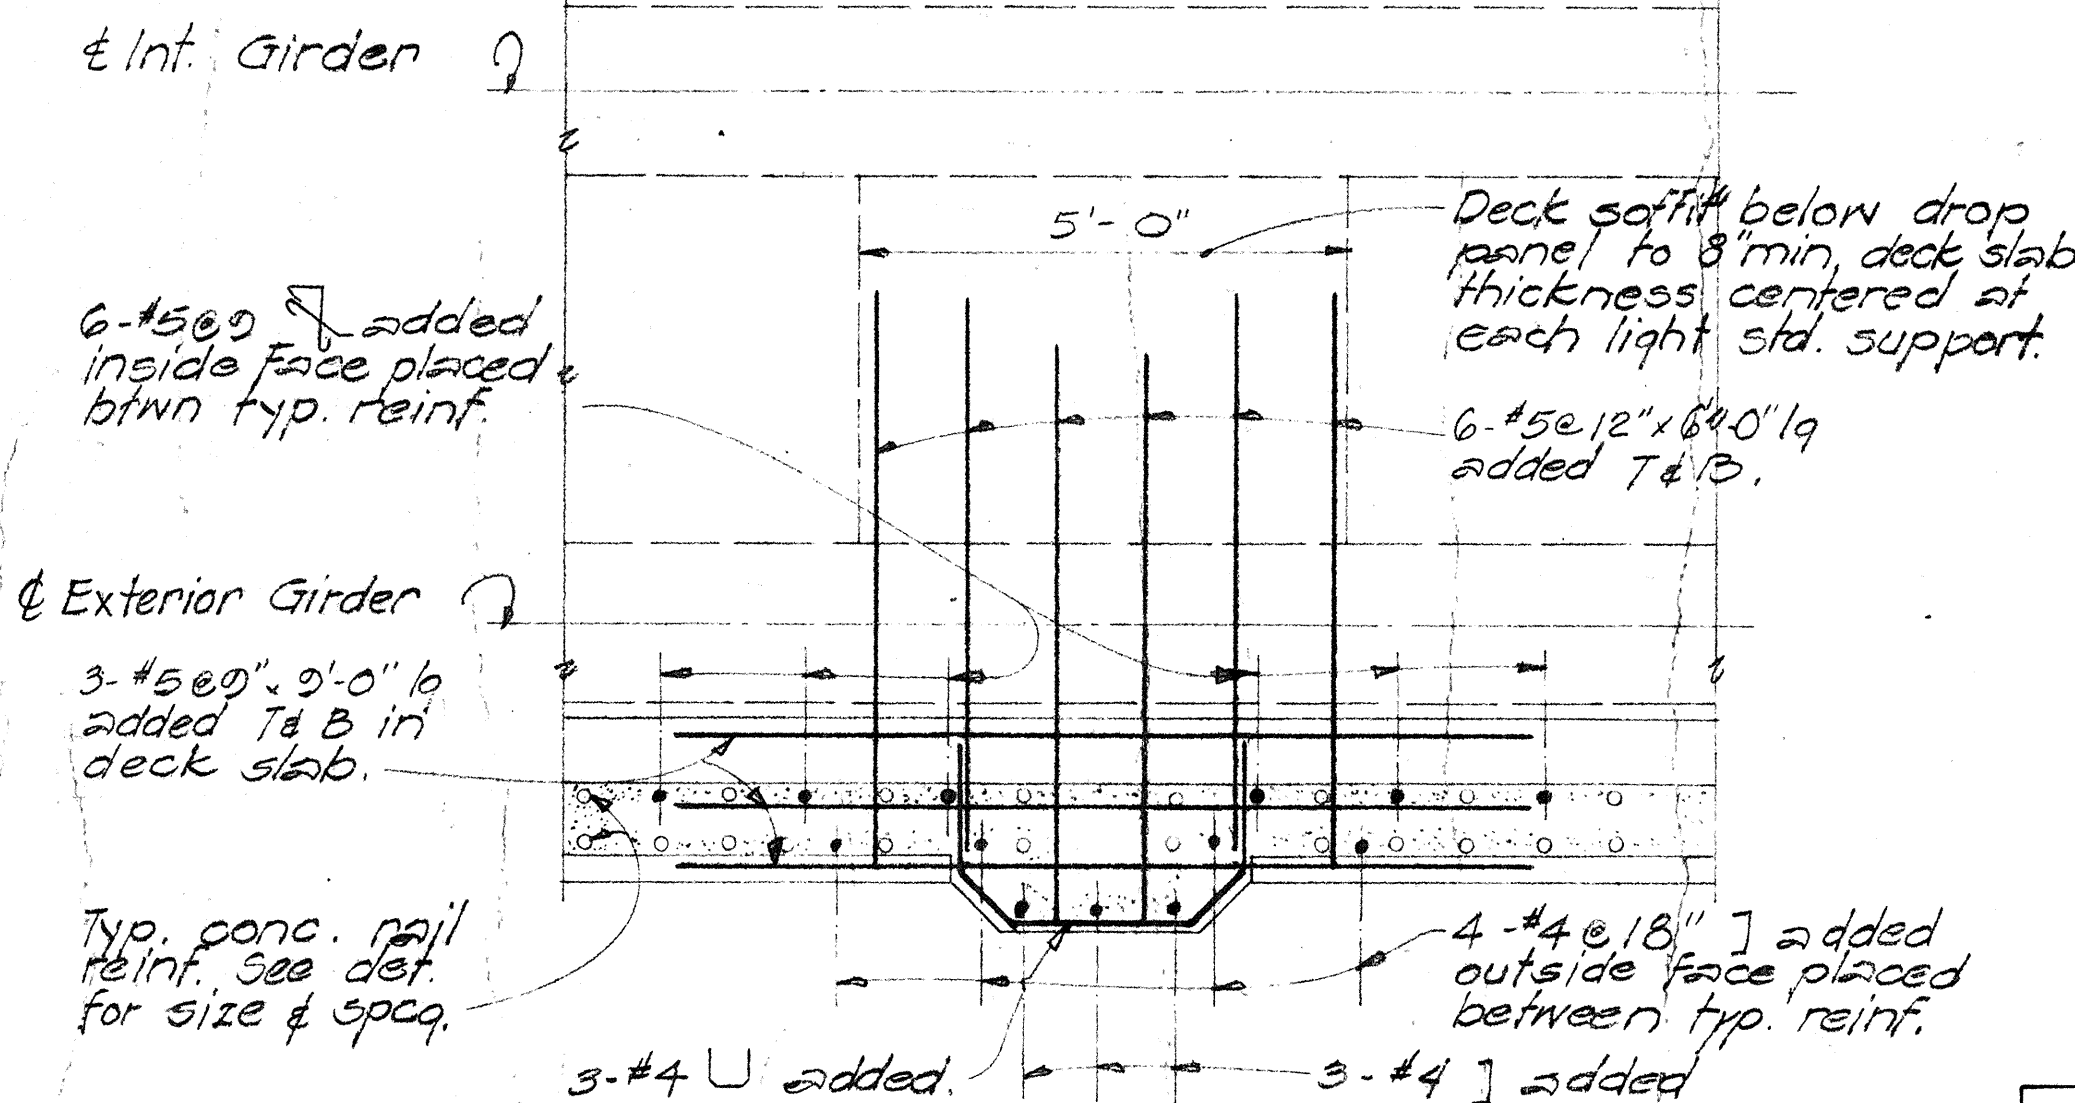


SECTION (B)

SCALE: 1/2" = 1'-0"


DETAILS OF RAILING AT LIGHT STANDARD

SCALE AS NOTED

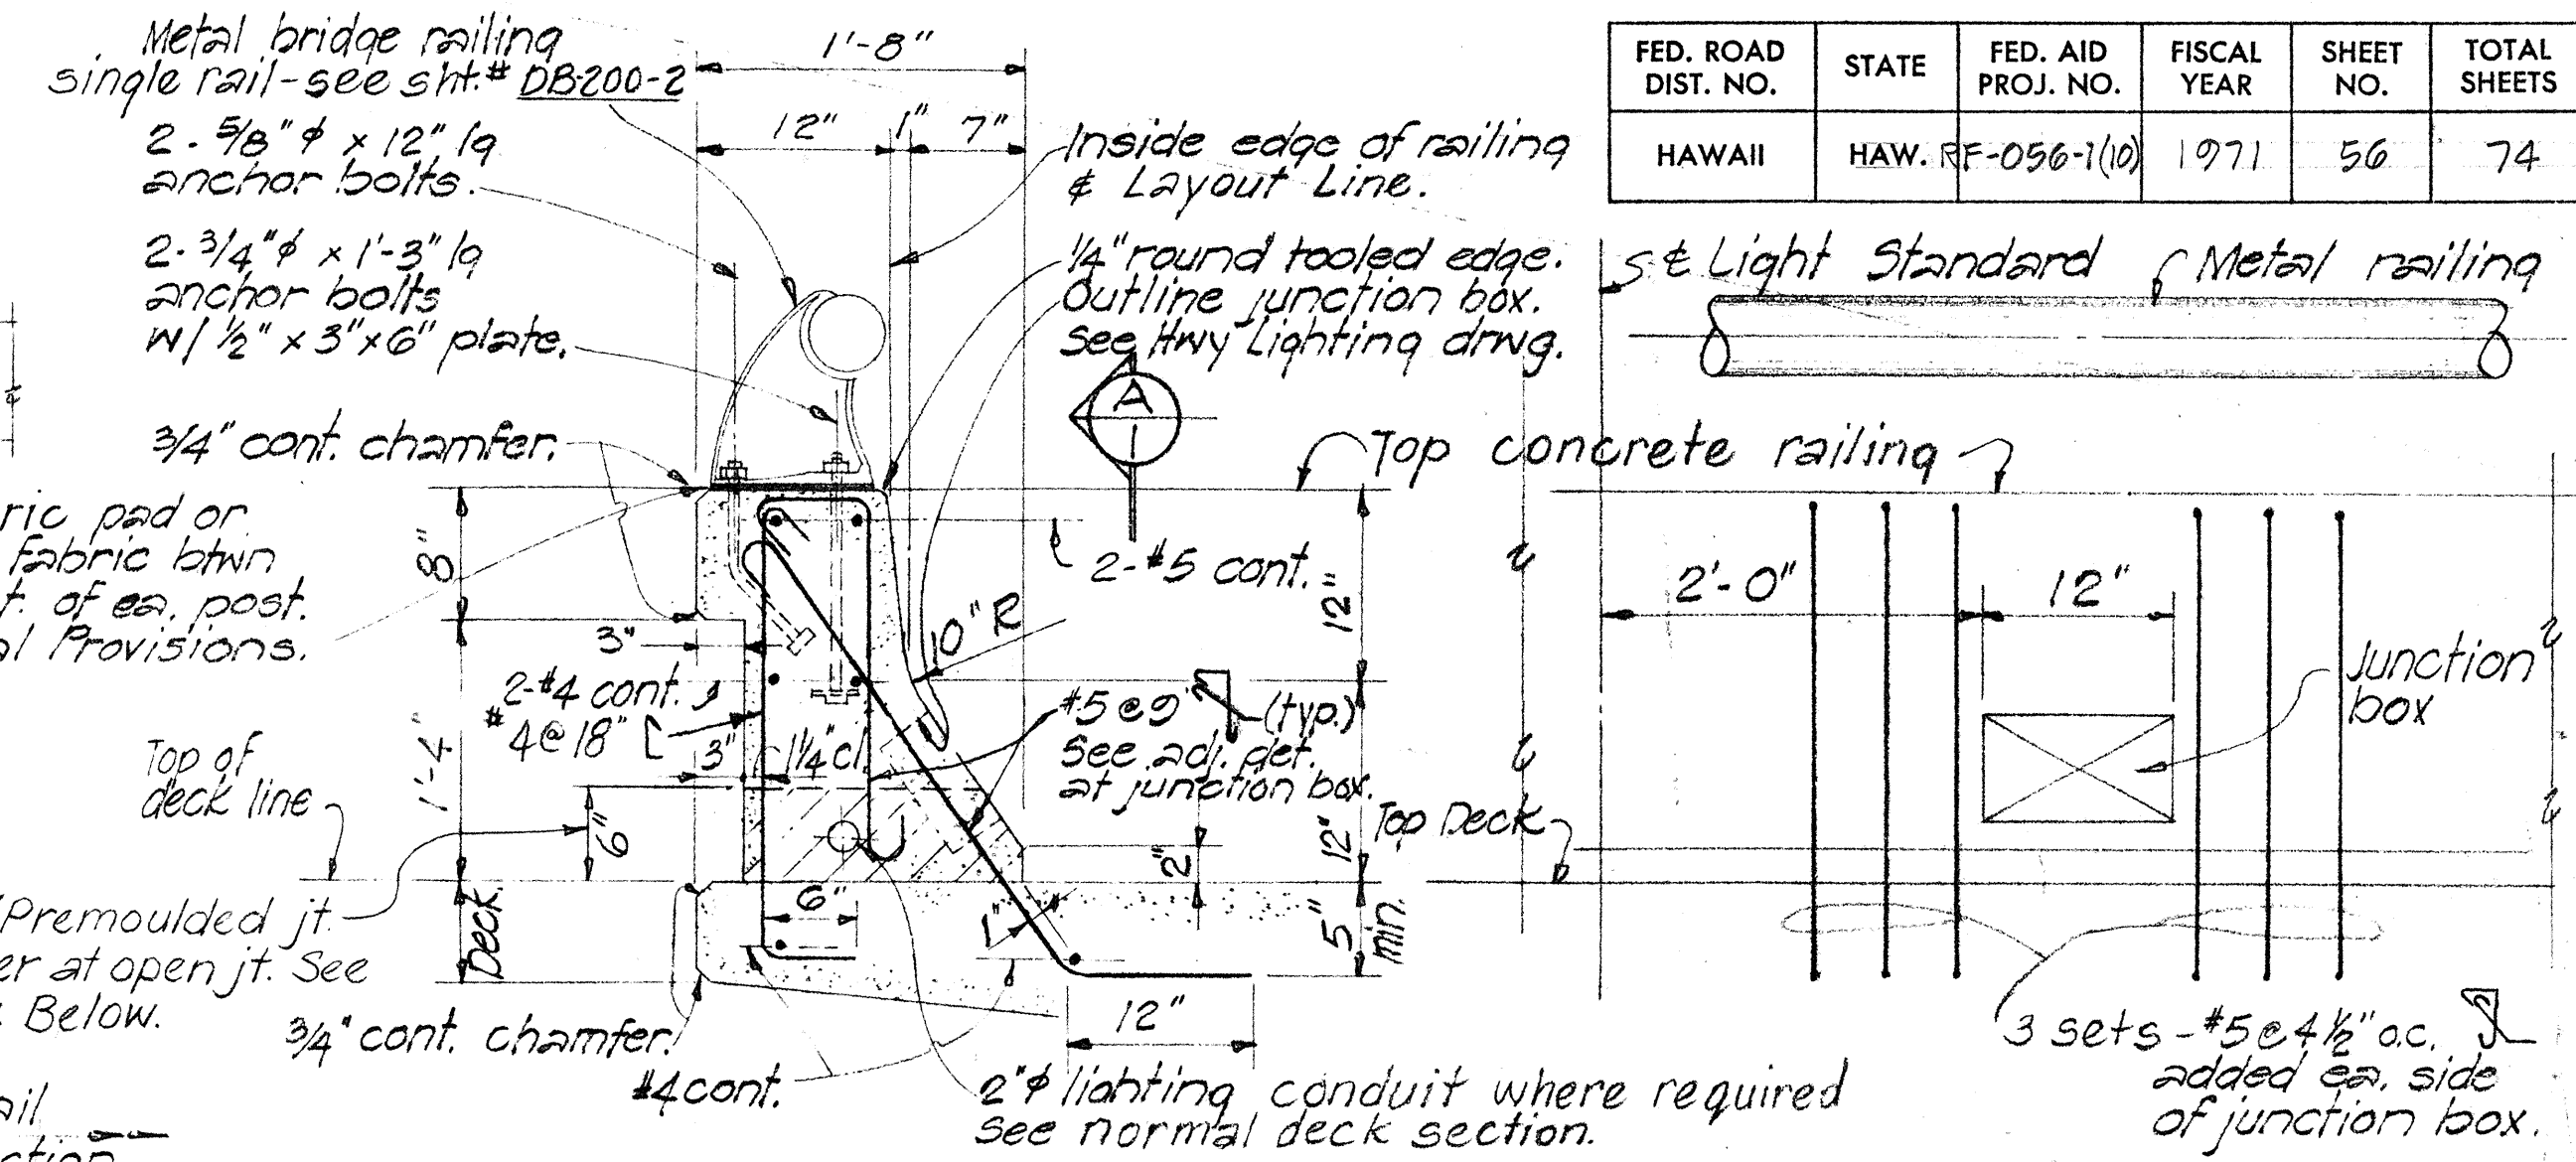

TYPICAL CONCRETE RAILING SECTION SCALE: 1" = 1'-0"

ELEVATION (A) SHOWING SPECIAL REINFORCEMENT AT JUNCTION BOX SCALE: 1" = 1'-0"

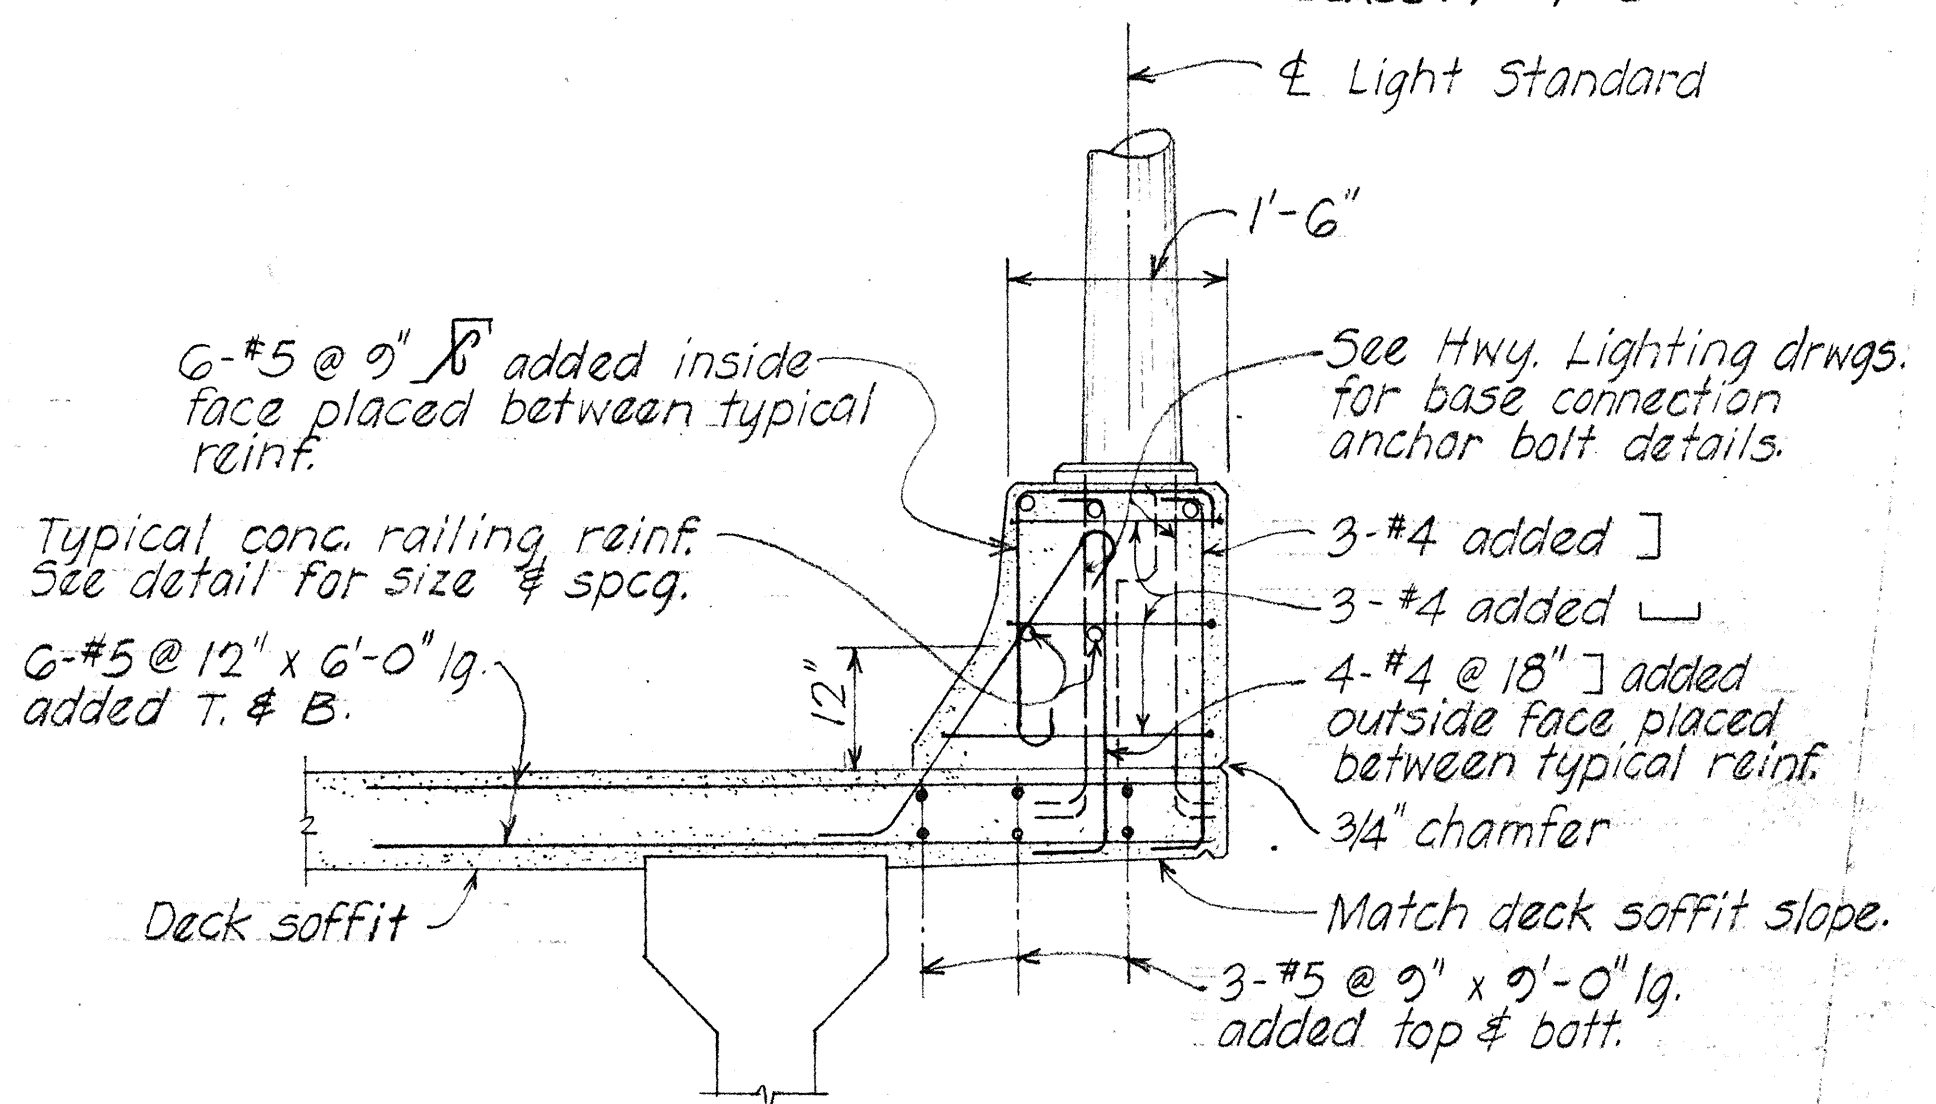

SECTION (C)

Scale: 3/4" = 1'-0"


APPROVAL RECOMMENDED:
 Paul T. Yamashita
 BRIDGE DESIGN ENGINEER 1-23-70
 DATE

APPROVED:
 Paul T. Yamashita
 ASSISTANT CHIEF, ENGINEERING 1-28-70
 DATE


NO.	REVISION	APPROVED BY	DATE

STATE OF HAWAII
 DEPARTMENT OF TRANSPORTATION
 HIGHWAYS DIVISION
STANDARD DETAILS
METAL BRIDGE RAILING
ONE RAIL COMBINATION TYPE
ON PARAPET
 Date: October 1969
 SHEET No. 53 OF 6 SHEETS DB-200-1

DATE
 DRAWN BY
 DESIGNED BY
 CHECKED BY
 NO.

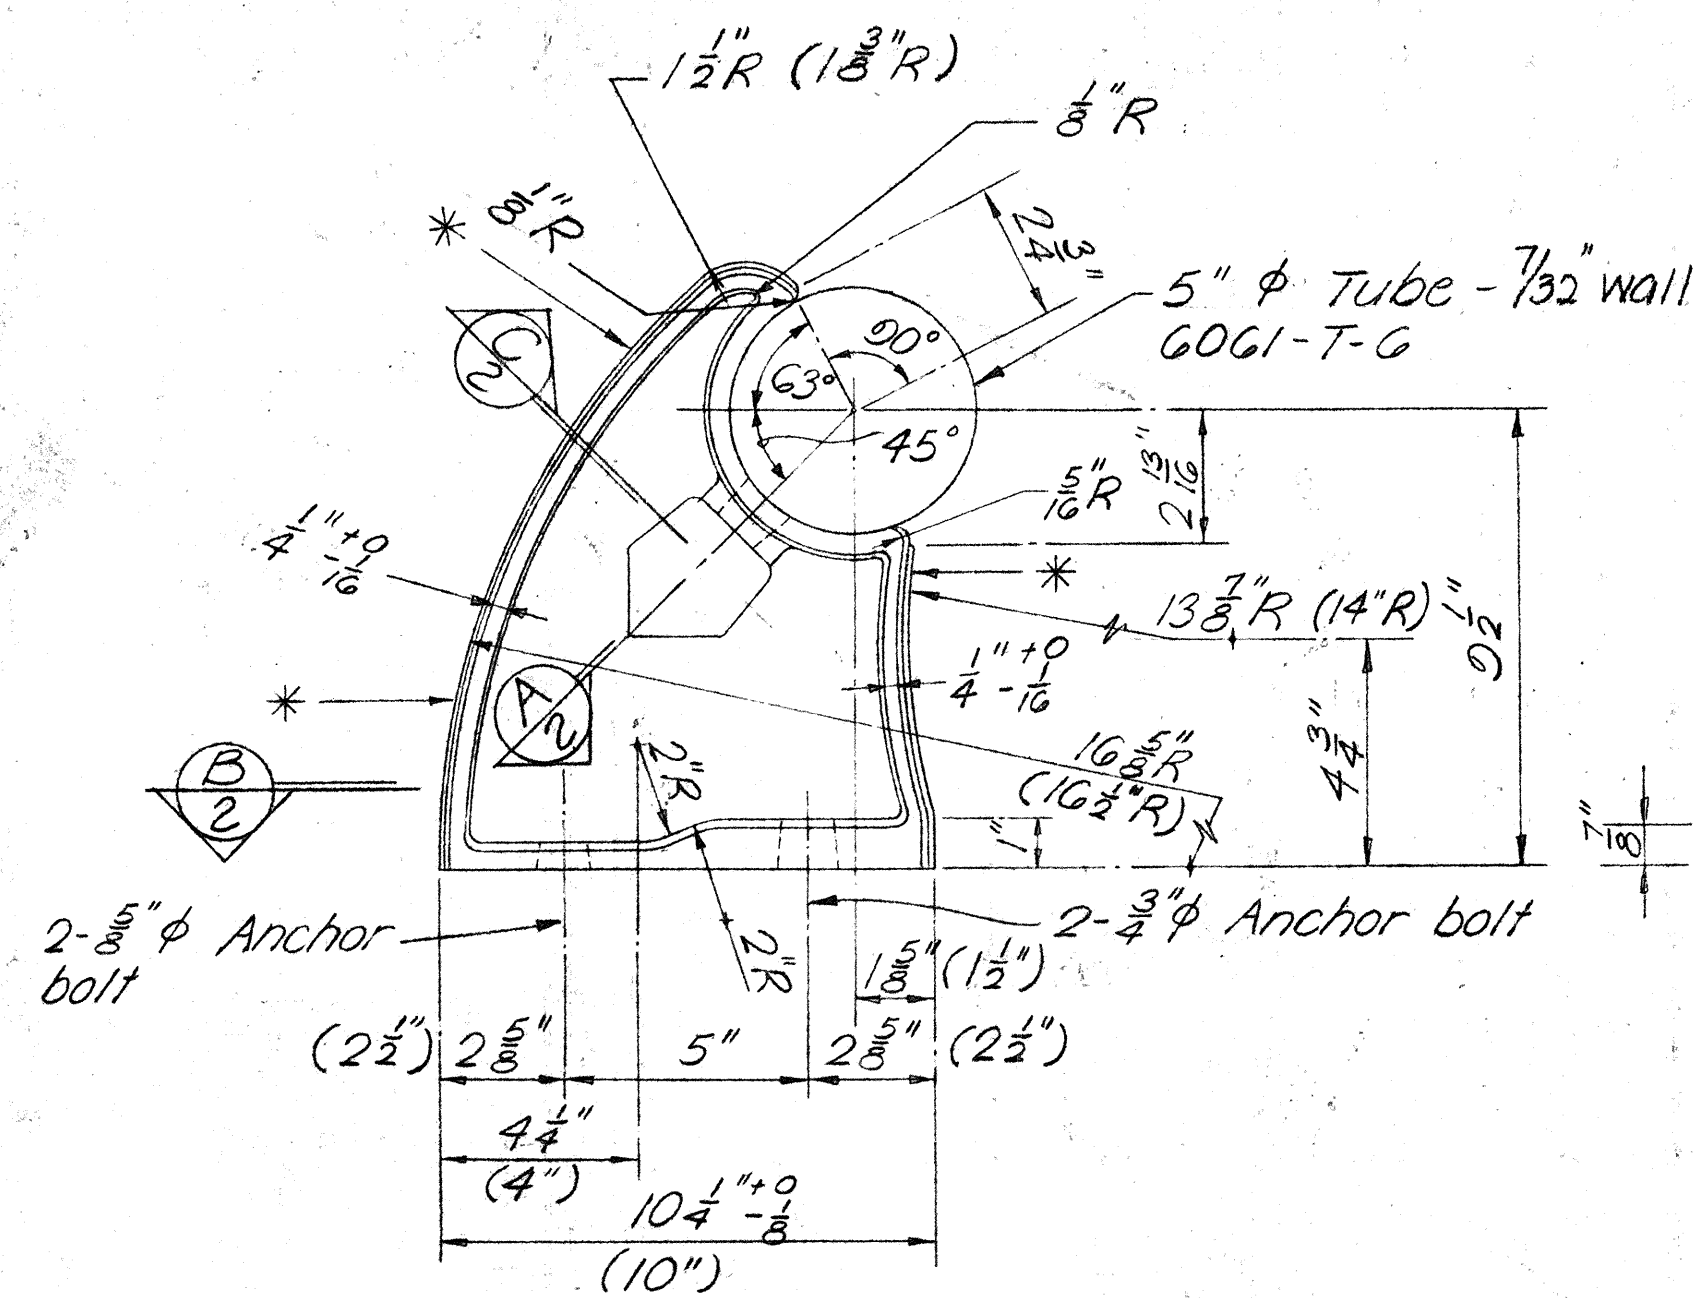

SIDE ELEVATION

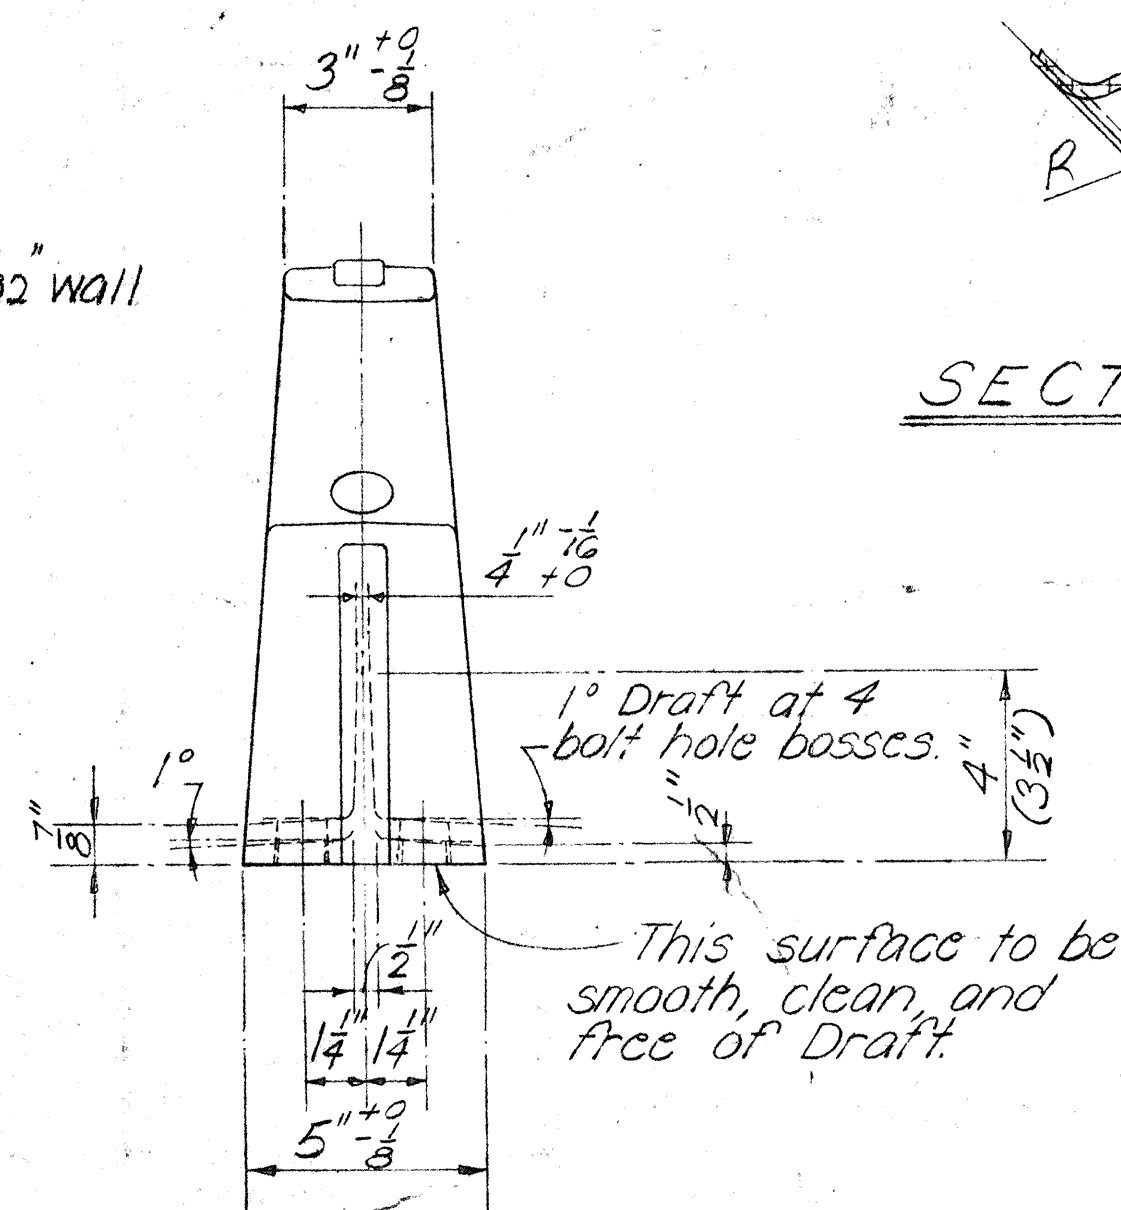


END ELEVATION

NOTE:

* Casting to be supplied with a standard scratch brush finish on entire gating rib surface and as indicated by an asterisk (*). Finish shall be approved by the Engineer.
Casting to be neatly trimmed and any protruding flash to be broken off. Unless otherwise specified, draft angles to be 3°, corner radii to be 3/32" R, fillet radii to be 3/8" R, casting tol. to be ±1/16", wall thickness to be ±1/32". Dimensions may be as shown or as shown in parenthesis ().

TYPICAL RAIL POST DETAILS

Scale: 3" = 1'-0"

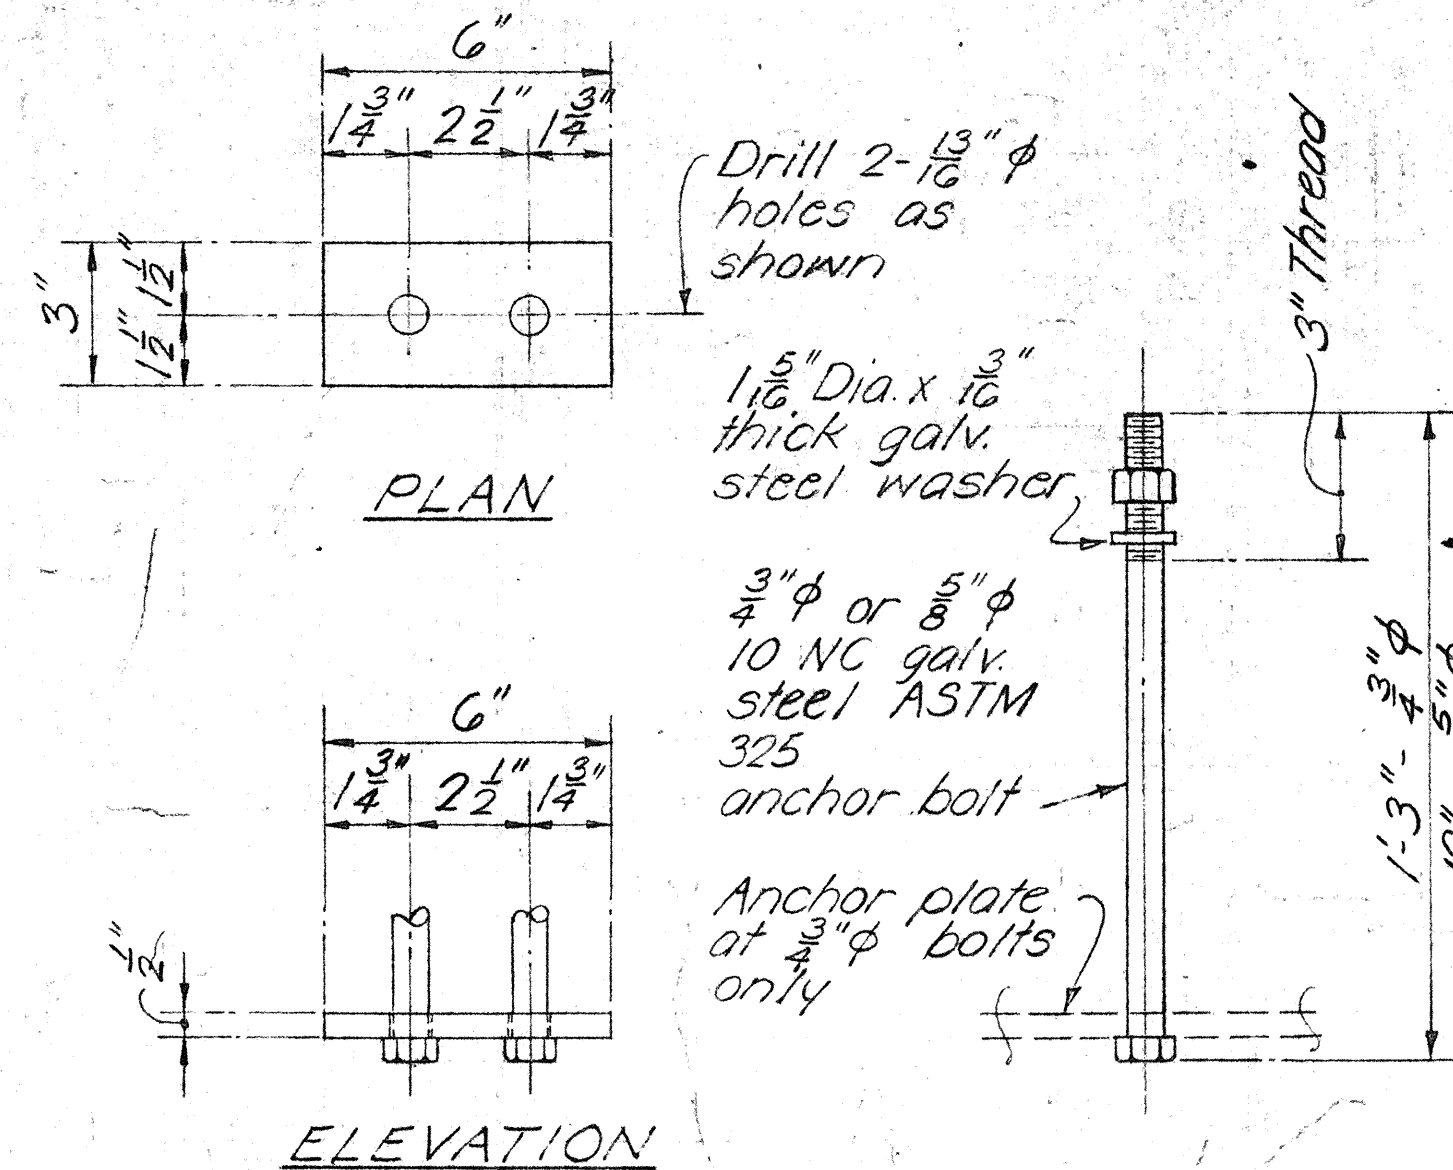

PLAN


ELEVATION

ANCHOR BOLT DETAIL ANCHOR BOLT

TYPICAL RAIL POST

STEEL ANCHOR BOLT ASSEMBLY

Scale: 3" = 1'-0"

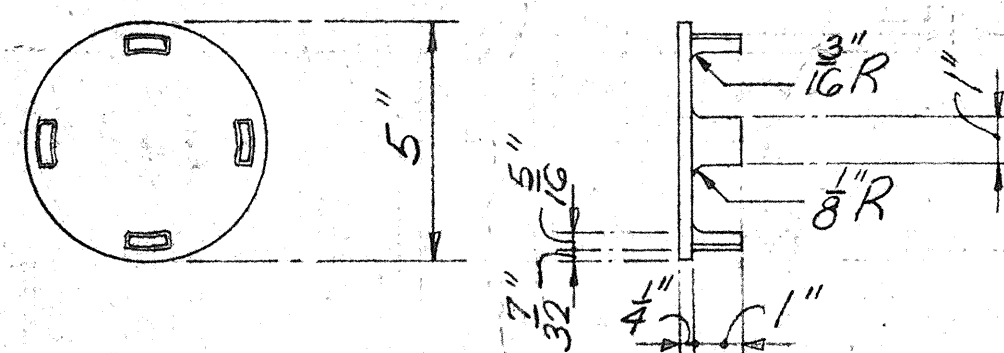

All draft angles = 3°


RAIL CAP DETAIL

Scale: 3" = 1'-0"


GENERAL NOTES:

Metal bridge railing shown is for Aluminum bridge railing. See Specifications for alternate railing in steel.

This surface to be cast flat

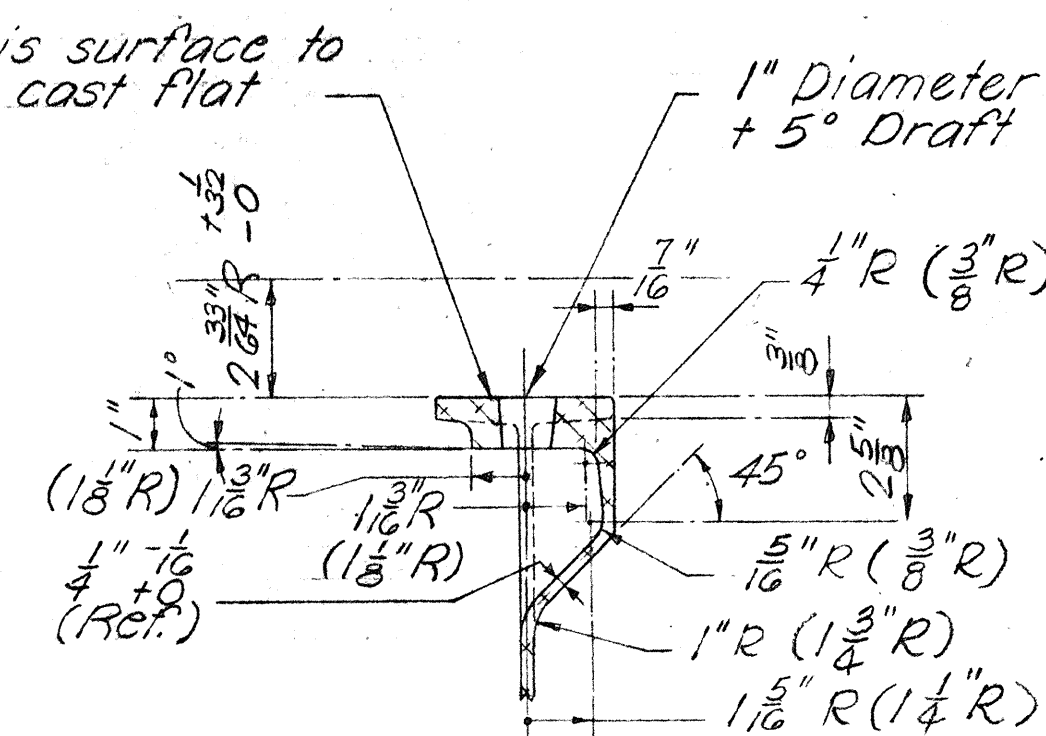

SECTION A-A

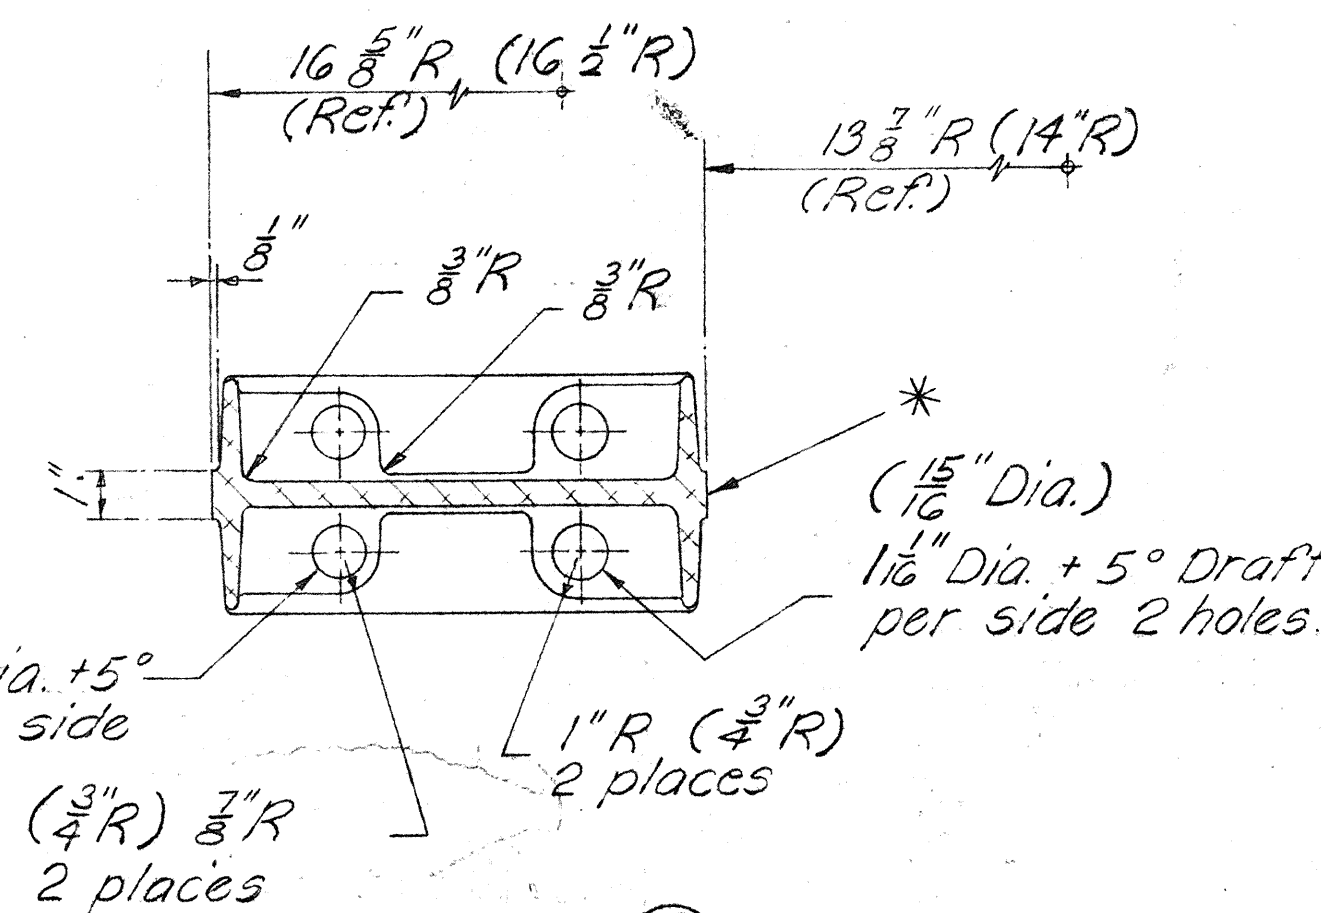


SECTION B-B

NOTE:

TOGGLE BOLT


Cadmium plating on steel - Type NS 0.0005" thick ASTM - A 165. (all parts).

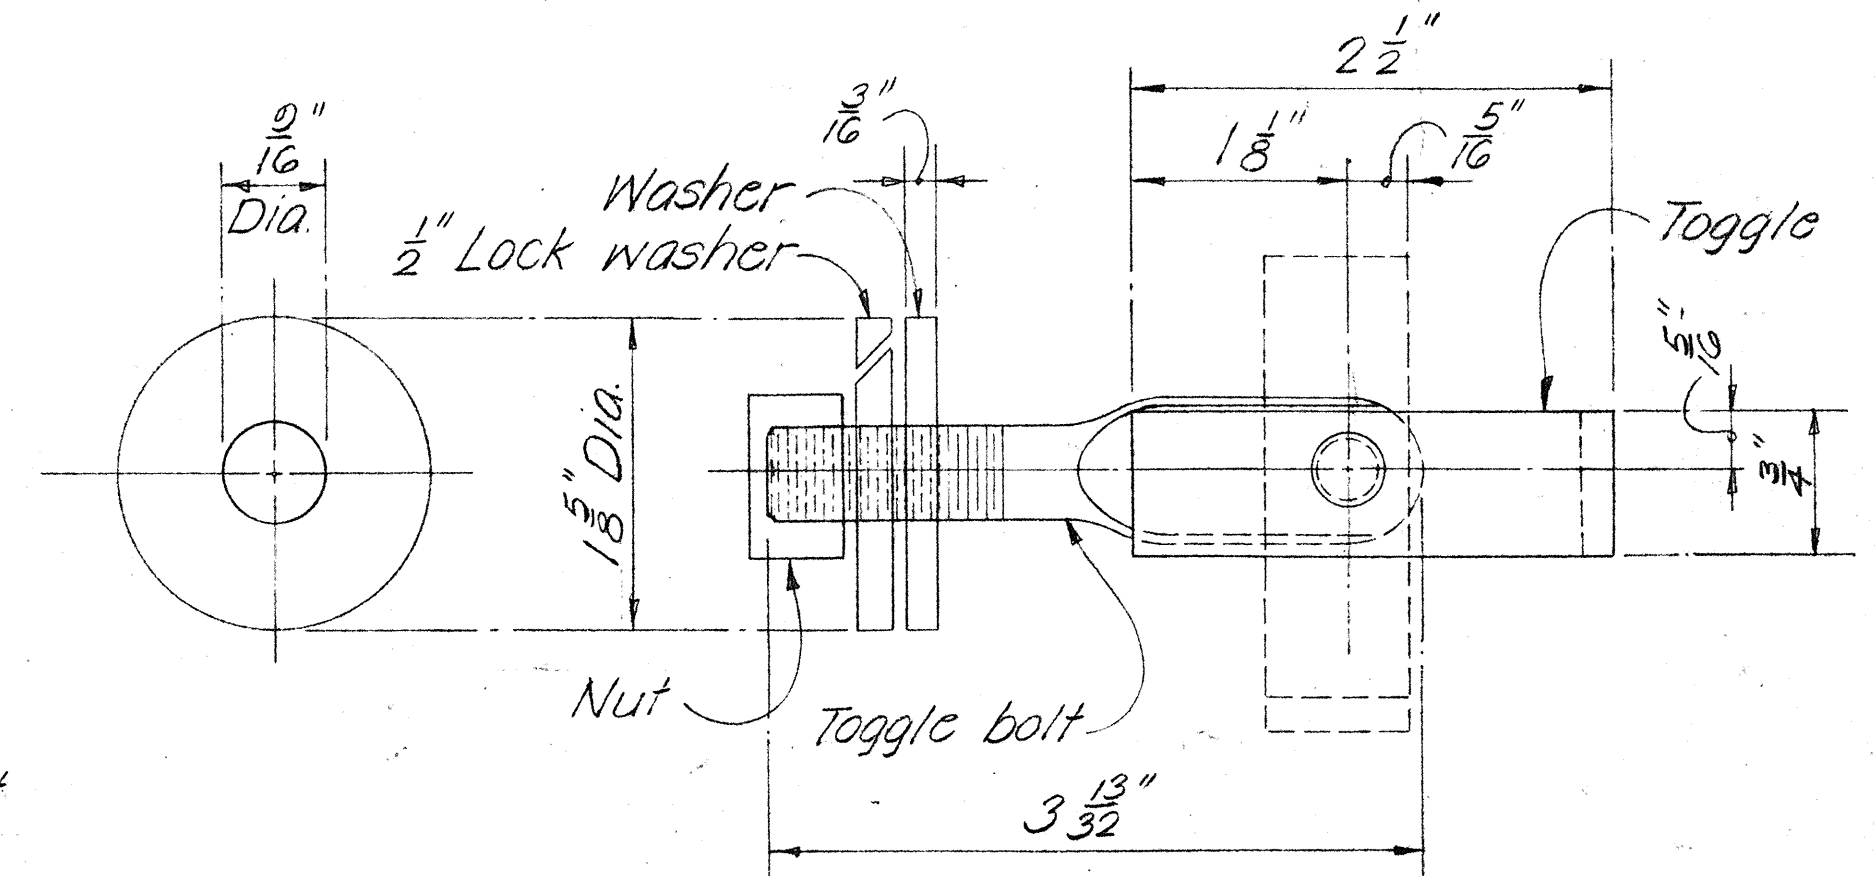

WASHER

SIDE ELEVATION ASSEMBLY

Special rivet material 1038 C.R. steel, heat treated ASTM A 195

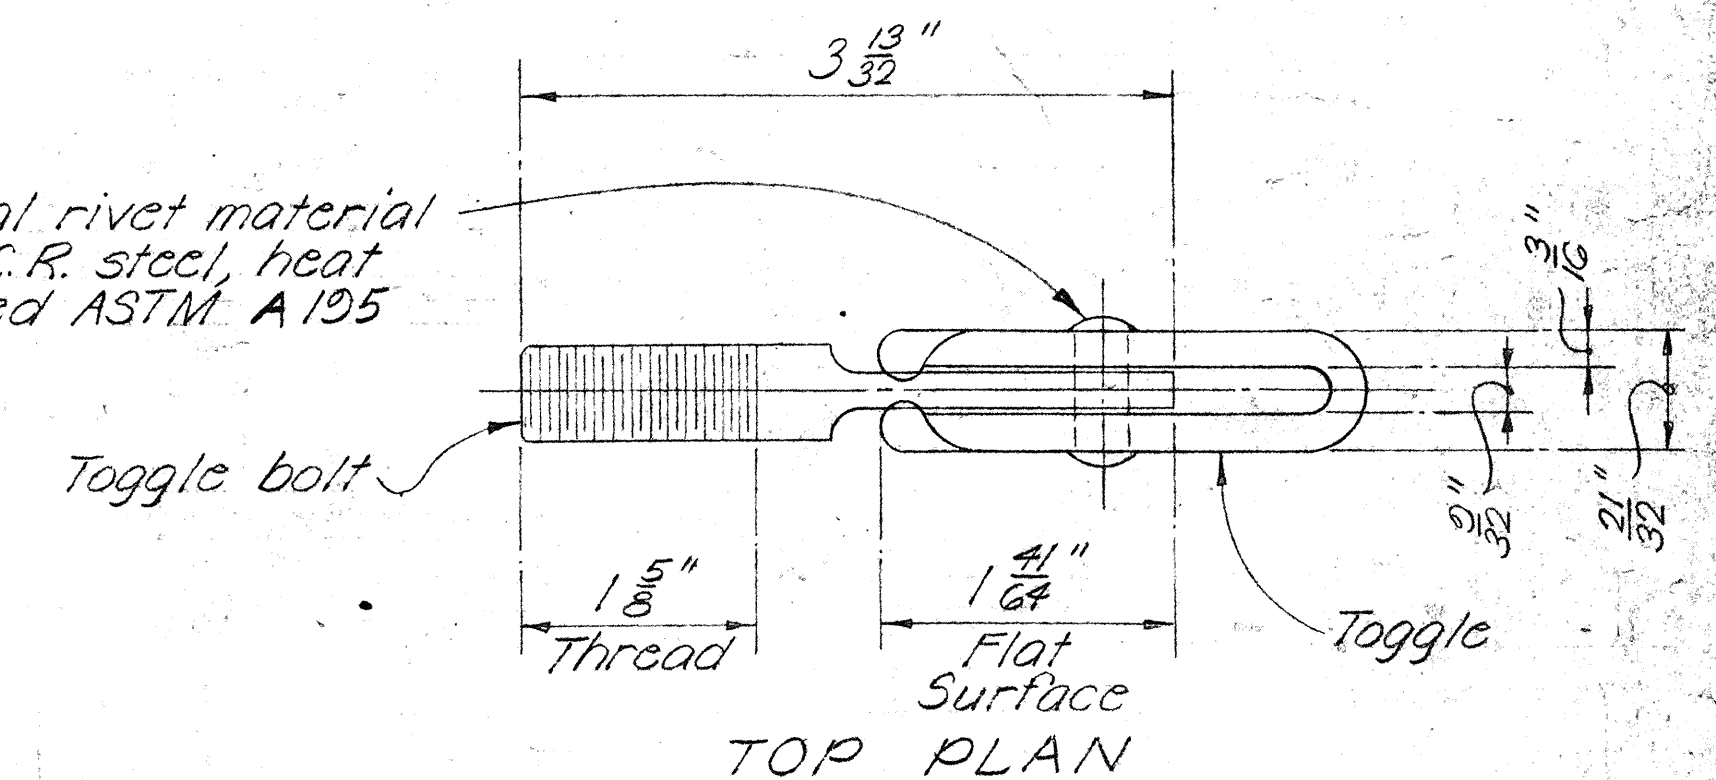

TOP PLAN

1/2" Ø STEEL TOGGLE BOLT DETAILS

Full Scale

APPROVAL RECOMMENDED:

Paul T. Yamashita
BRIDGE DESIGN ENGINEER

1-23-70
DATE


APPROVED

Paul T. Yamashita
For ASSISTANT CHIEF, ENGINEERING

1-28-70
DATE

NO.	REVISION	APPROVED BY	DATE

STATE OF HAWAII
DEPARTMENT OF TRANSPORTATION
HIGHWAYS DIVISION
STANDARD DETAILS
METAL BRIDGE RAILINGS
ONE RAIL COMBINATION TYPE
ON PARAPET
Scale as noted Date: _____

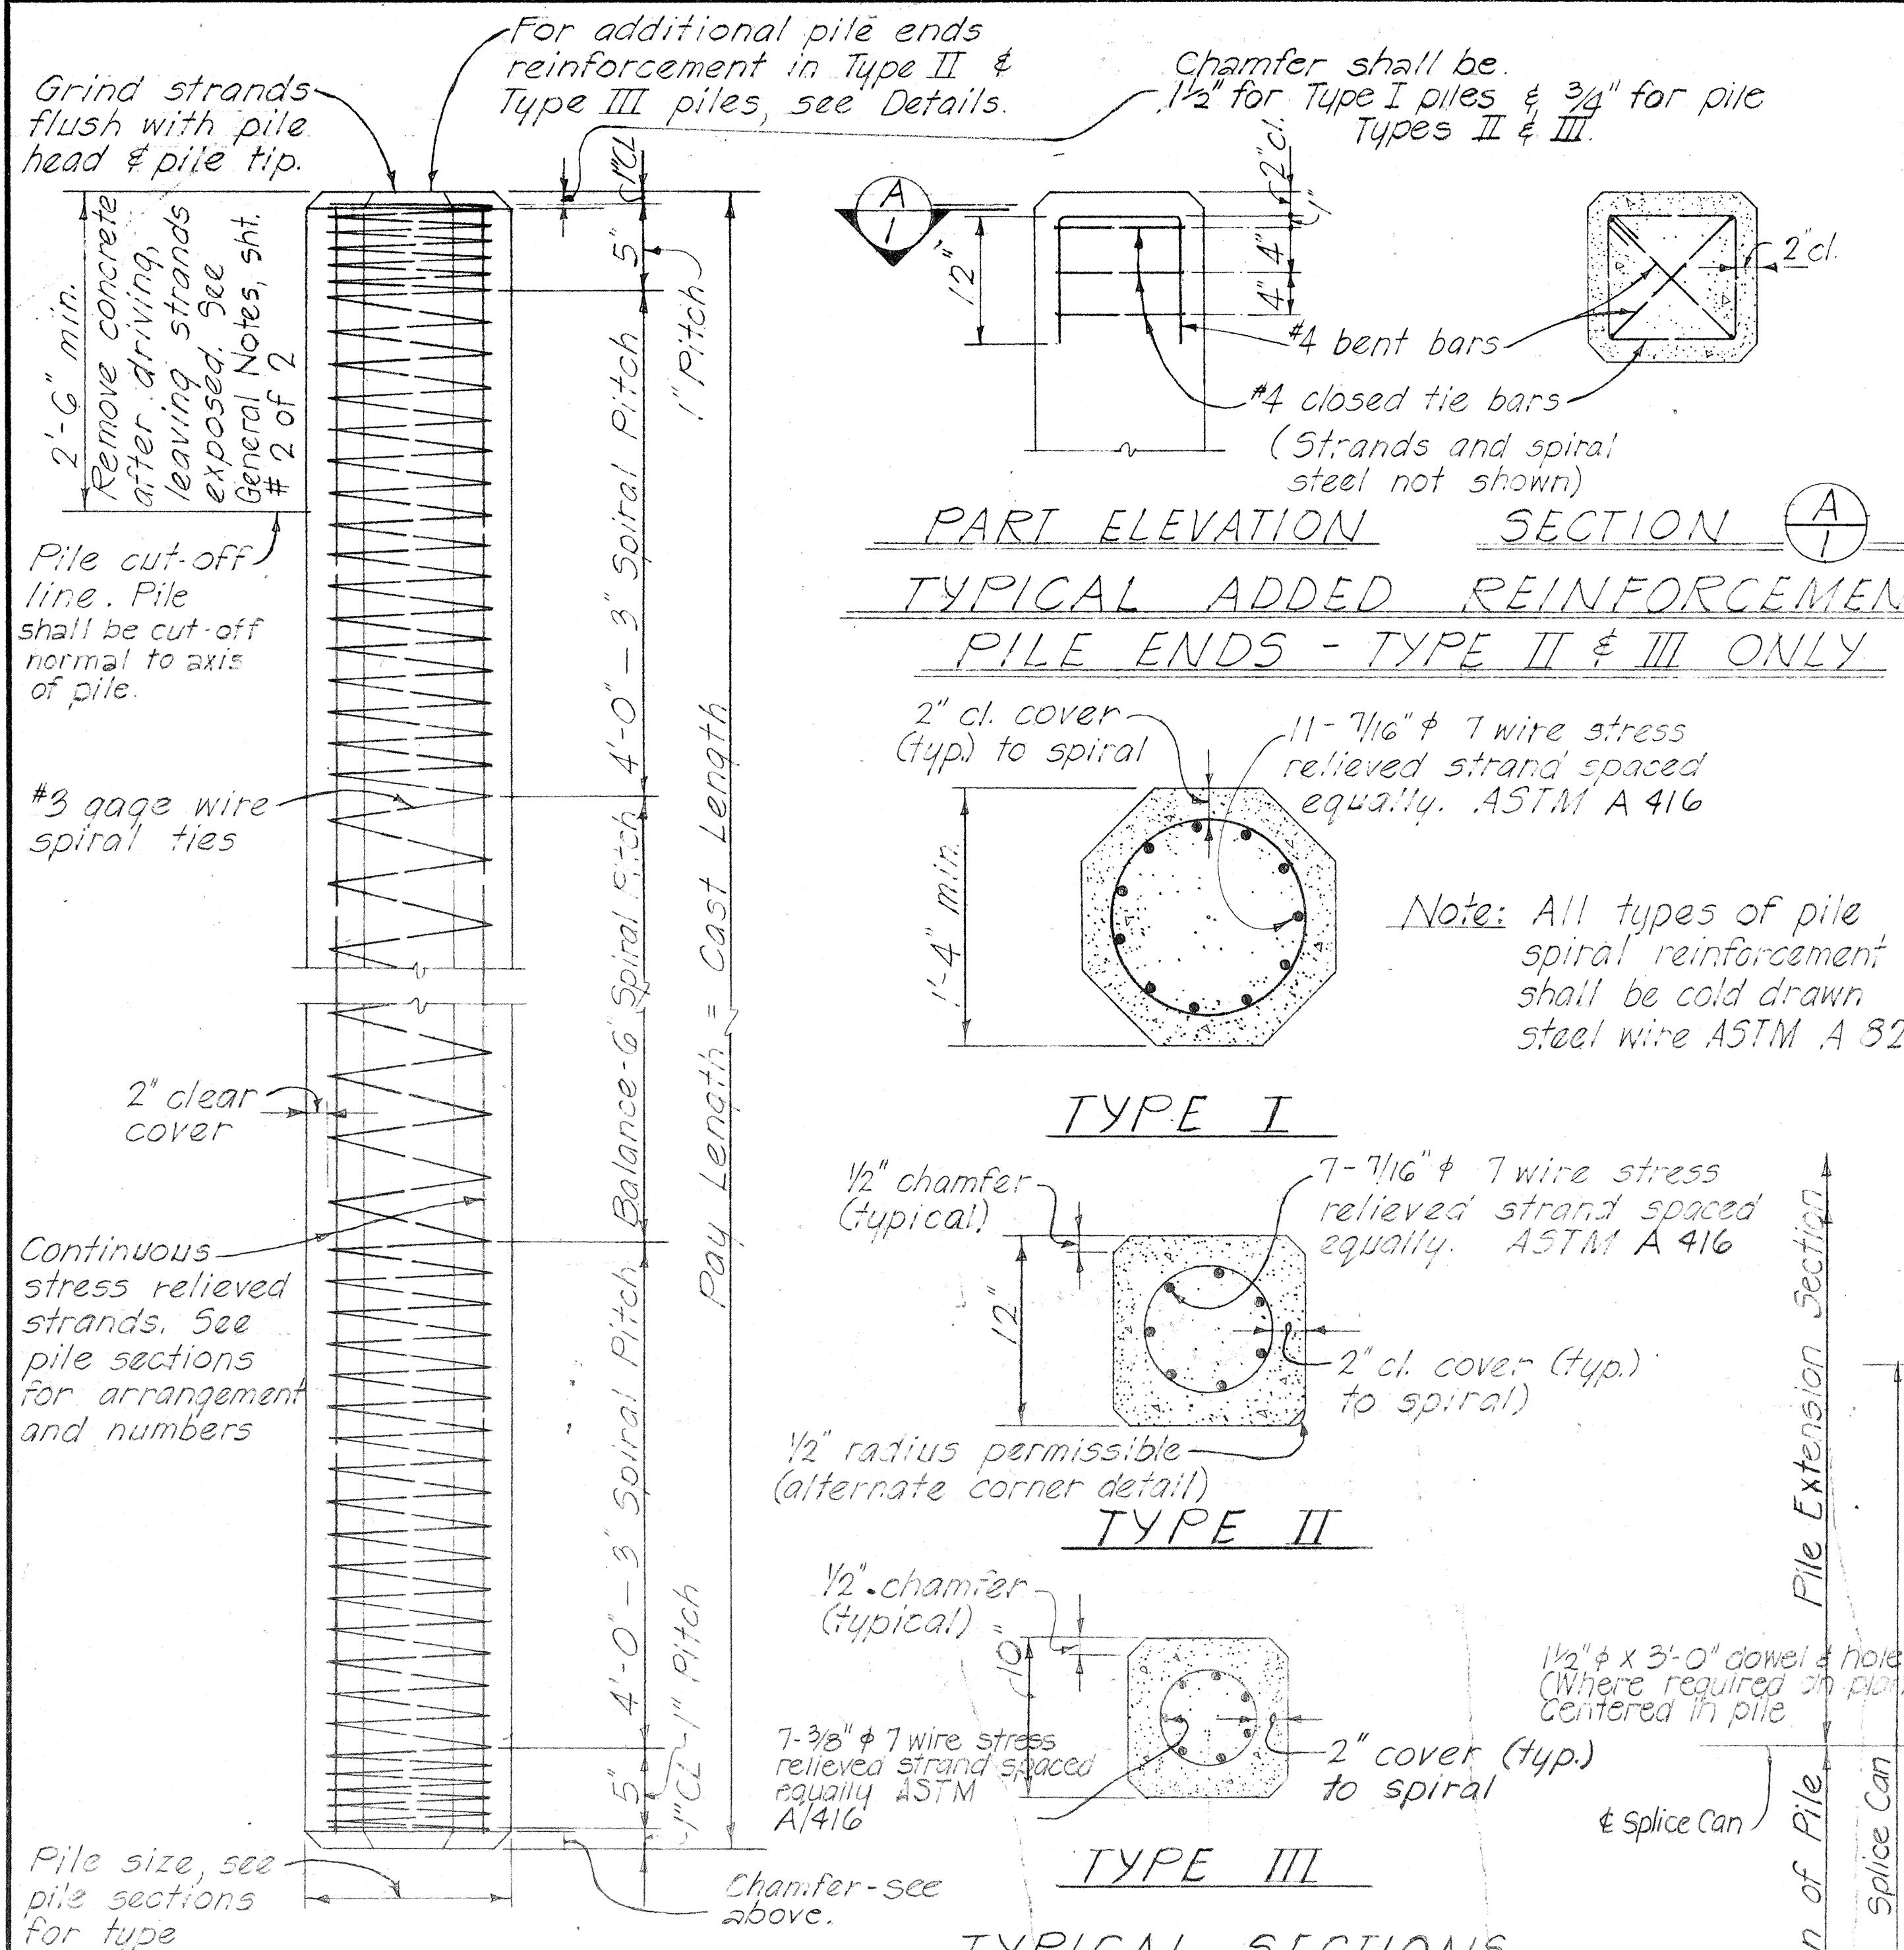

TYPICAL PILE DETAIL


Max. Length "L"*	Max. Length "L"*	Length "L"*
Type I "L" = 53'-0"	Type I "L" = 75'-0"	Type I "L" over 75'-0"
12" Type II "L" = 50'-0"	12" Type II "L" = 72'-0"	12" Type II "L" over 72'-0"
10" Type III "L" = 46'-0"	10" Type III "L" = 66'-0"	10" Type III "L" over 66'-0"
0.30L 0.70L	0.21L 0.58L 0.21L	0.15L 0.35L 0.35L 0.15L

*The length "L" is the distance end to end of pile.

1 POINT PICK-UP 2 POINT PICK-UP 3 POINT PICK-UP

NOTE: Unless special lifting devices are attached for pick-up points, pick-up points shall be plainly marked on all piles after removal of the forms and all lifting shall be done at these points. The use of special embedded or attached lifting devices, the employment of other pick-up points or any other method of pick-up shall be subject to approval by the Engineer.

NOTE:
Concrete in pile build-ups without driving shall be Class A Concrete. Concrete in pile build-ups with driving shall have a minimum compressive cylinder strength f'_c of 5000 p.s.i. at 28 days. Build-ups may be driven if the specimen of concrete from which the piles were poured develops a strength of at least 3500 p.s.i. but not earlier than 7 days.

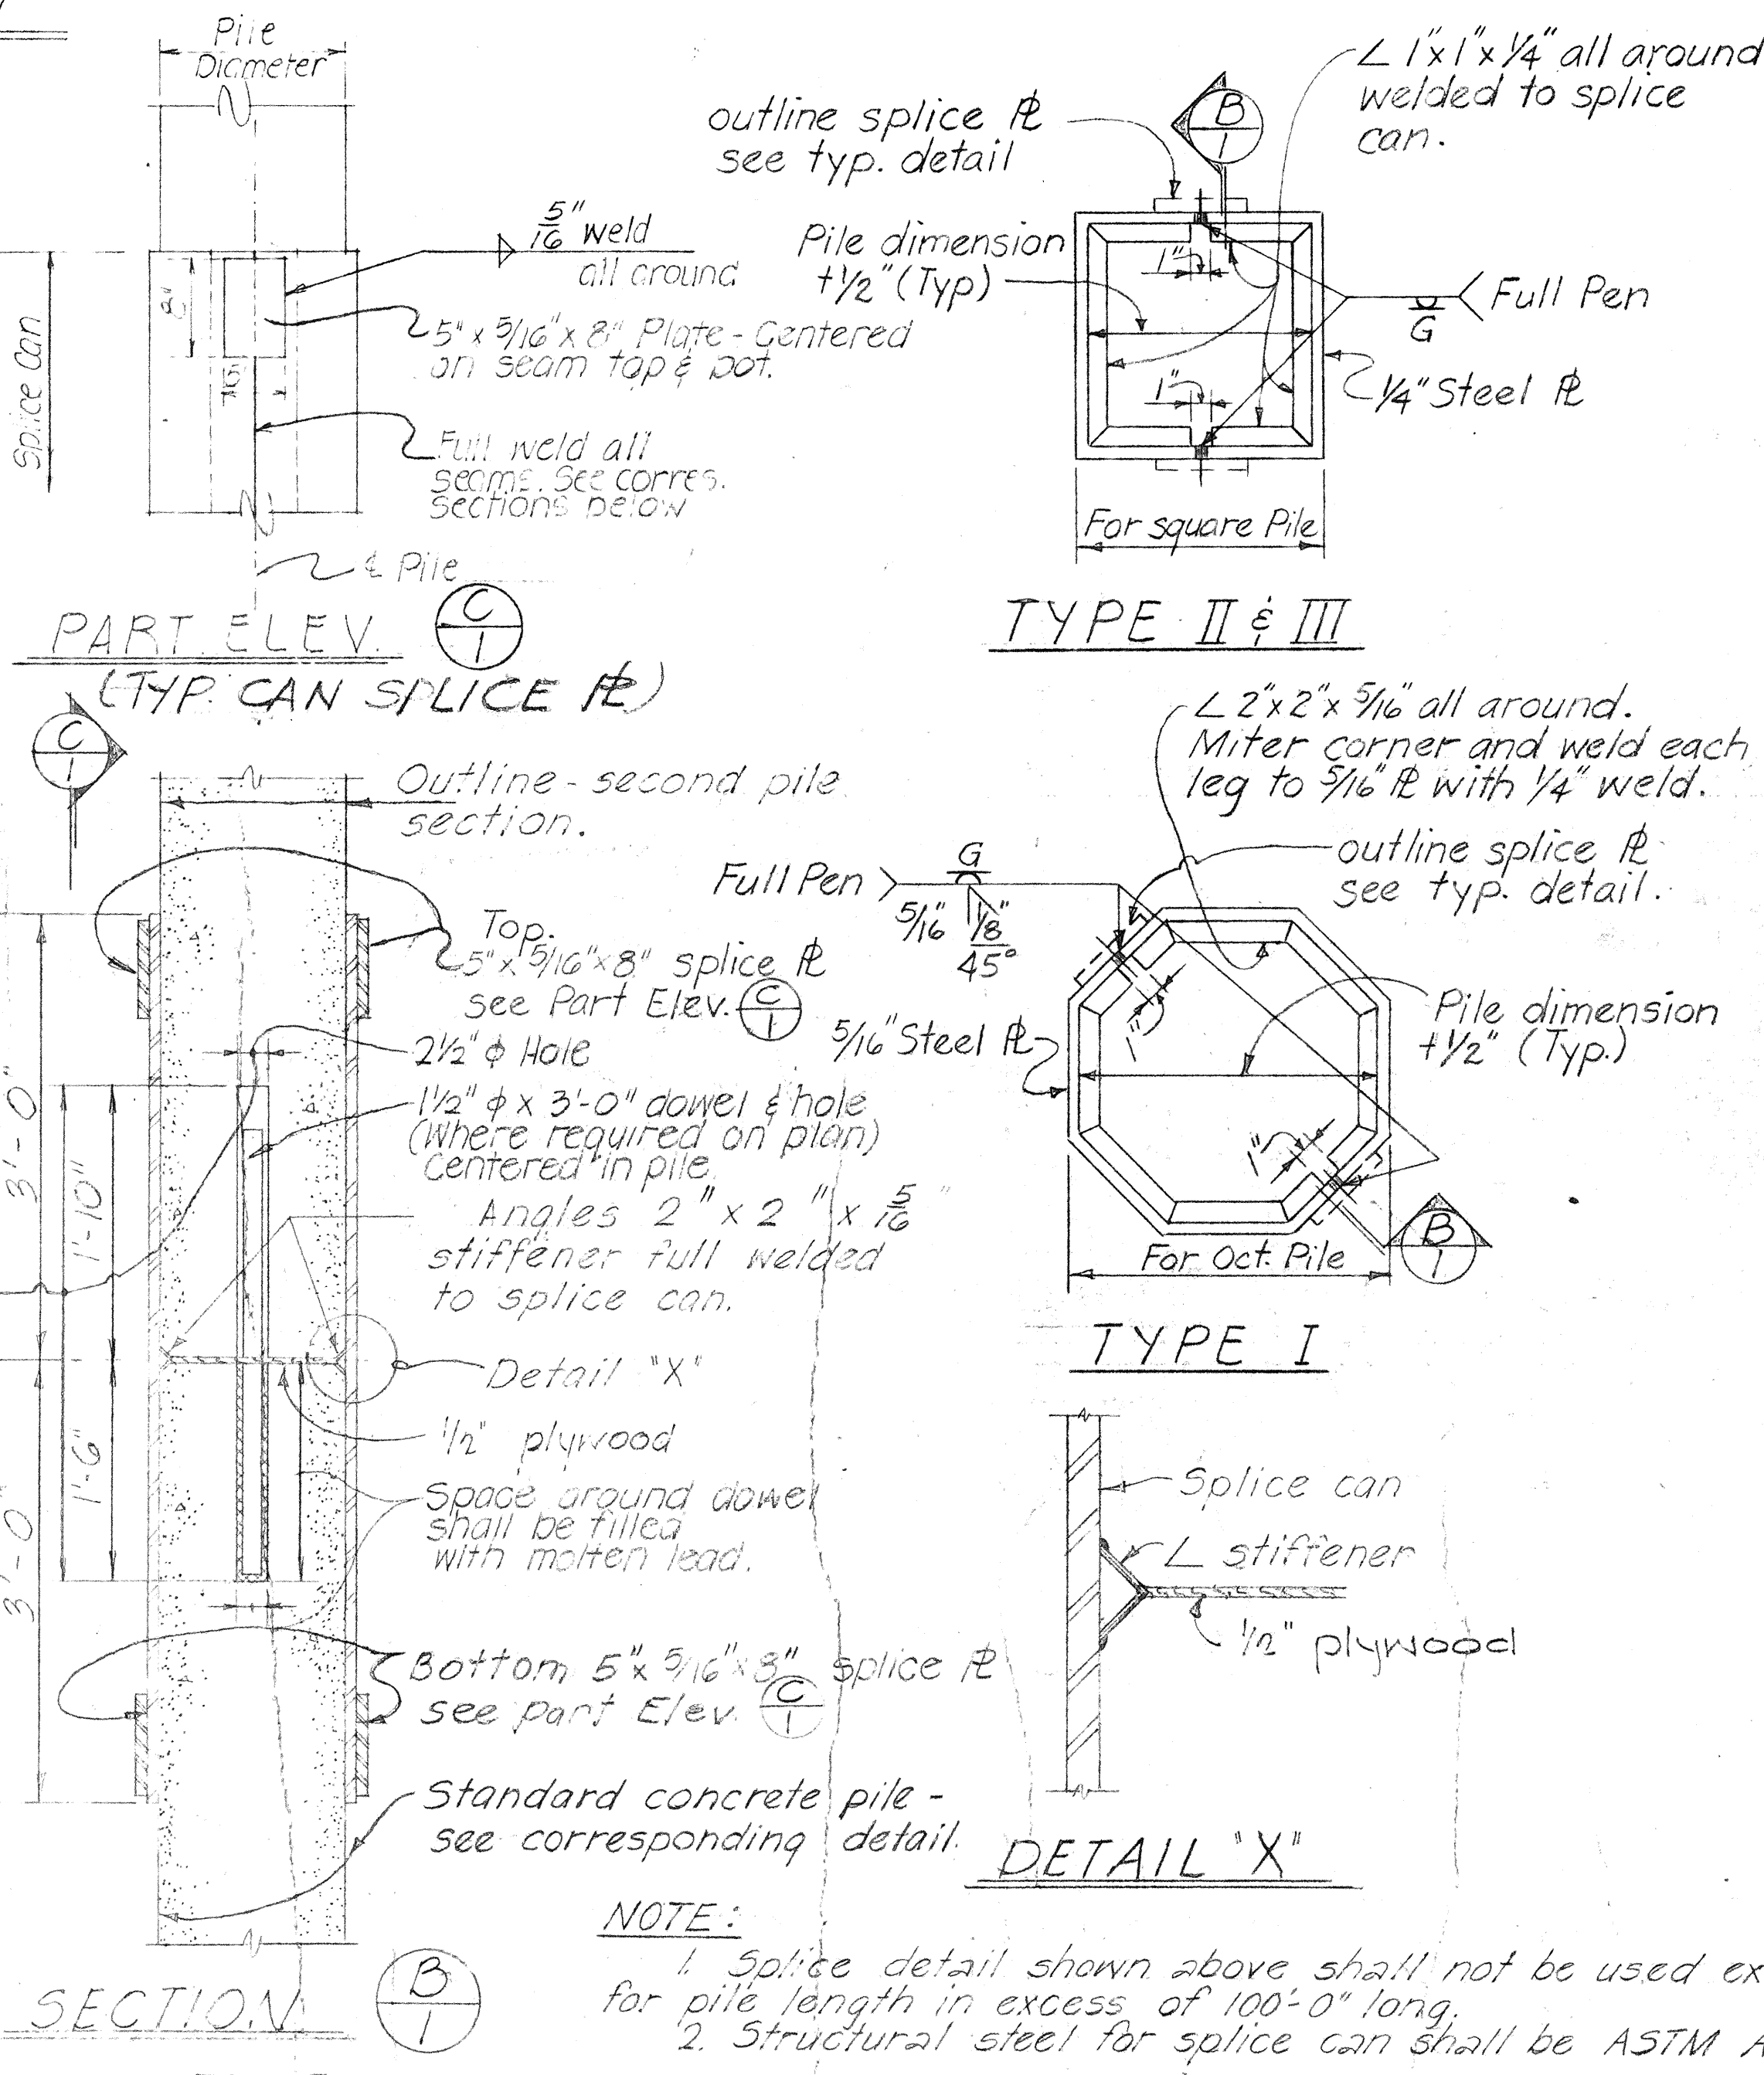

NO.	REVISION	APPROVED BY	DATE

APPROVAL RECOMMENDED:
Paul T. Yamashita
BRIDGE DESIGN ENGINEER 1-23-76
DATE

APPROVED:
Paul T. Yamashita
ASSISTANT CHIEF, ENGINEERING 1-28-76
DATE


STATE OF HAWAII
DEPARTMENT OF TRANSPORTATION
HIGHWAYS DIVISION
STANDARD DETAILS
PRESTRESSED CONCRETE PILES
Date
SHEET No. 55 OF 6 SHEETS DB-300-1

DATE
DESIGNED BY
CHECKED BY
ORIGINAL PLAN
NOTE BOOK
QUANTITIES BY
NO.


2'-6" min. unless otherwise directed by the Engineer. Remove concrete after driving, leaving reinf. exposed

HAWAII	HAW. R.	F-056-1(10)	1971	59	74
--------	---------	-------------	------	----	----

Chamfer - See Typical Pile Detail.

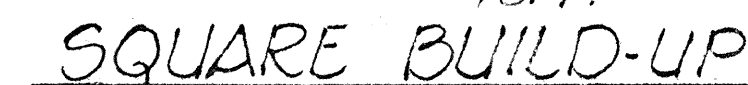

Note:
Circular section may be used instead of square section if approved by the Engineer.

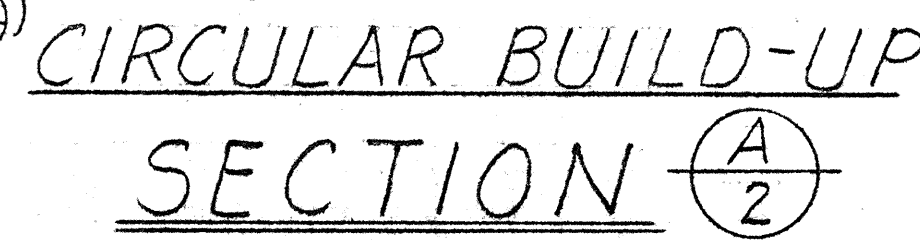

Notes:

Selection of pile build-up type without driving to be determined by the Engineer.


When height of depressed portion of footing (H) exceeds 4', the depressed section shall be poured separately from the main body of the footing.

Depressed portion of footing may be omitted for pile heads embedded at least 4" into footing provided at least 90% of the piles in each footing have the minimum embedment into footing as shown in contract plans.

GENERAL NOTES

1. Work of cutting off prestressed conc. piles or concrete build-ups shall be performed in such a manner as to avoid spalling or damaging the pile below cut-off. In case of such damage, the pile shall be replaced or repaired by the Contractor at his expense as directed by the Engineer.

2. Portion of pile embedded into footing shall be of sound concrete. Damaged portions shall be removed and pile cut-off elevation lowered as required by the Engineer.

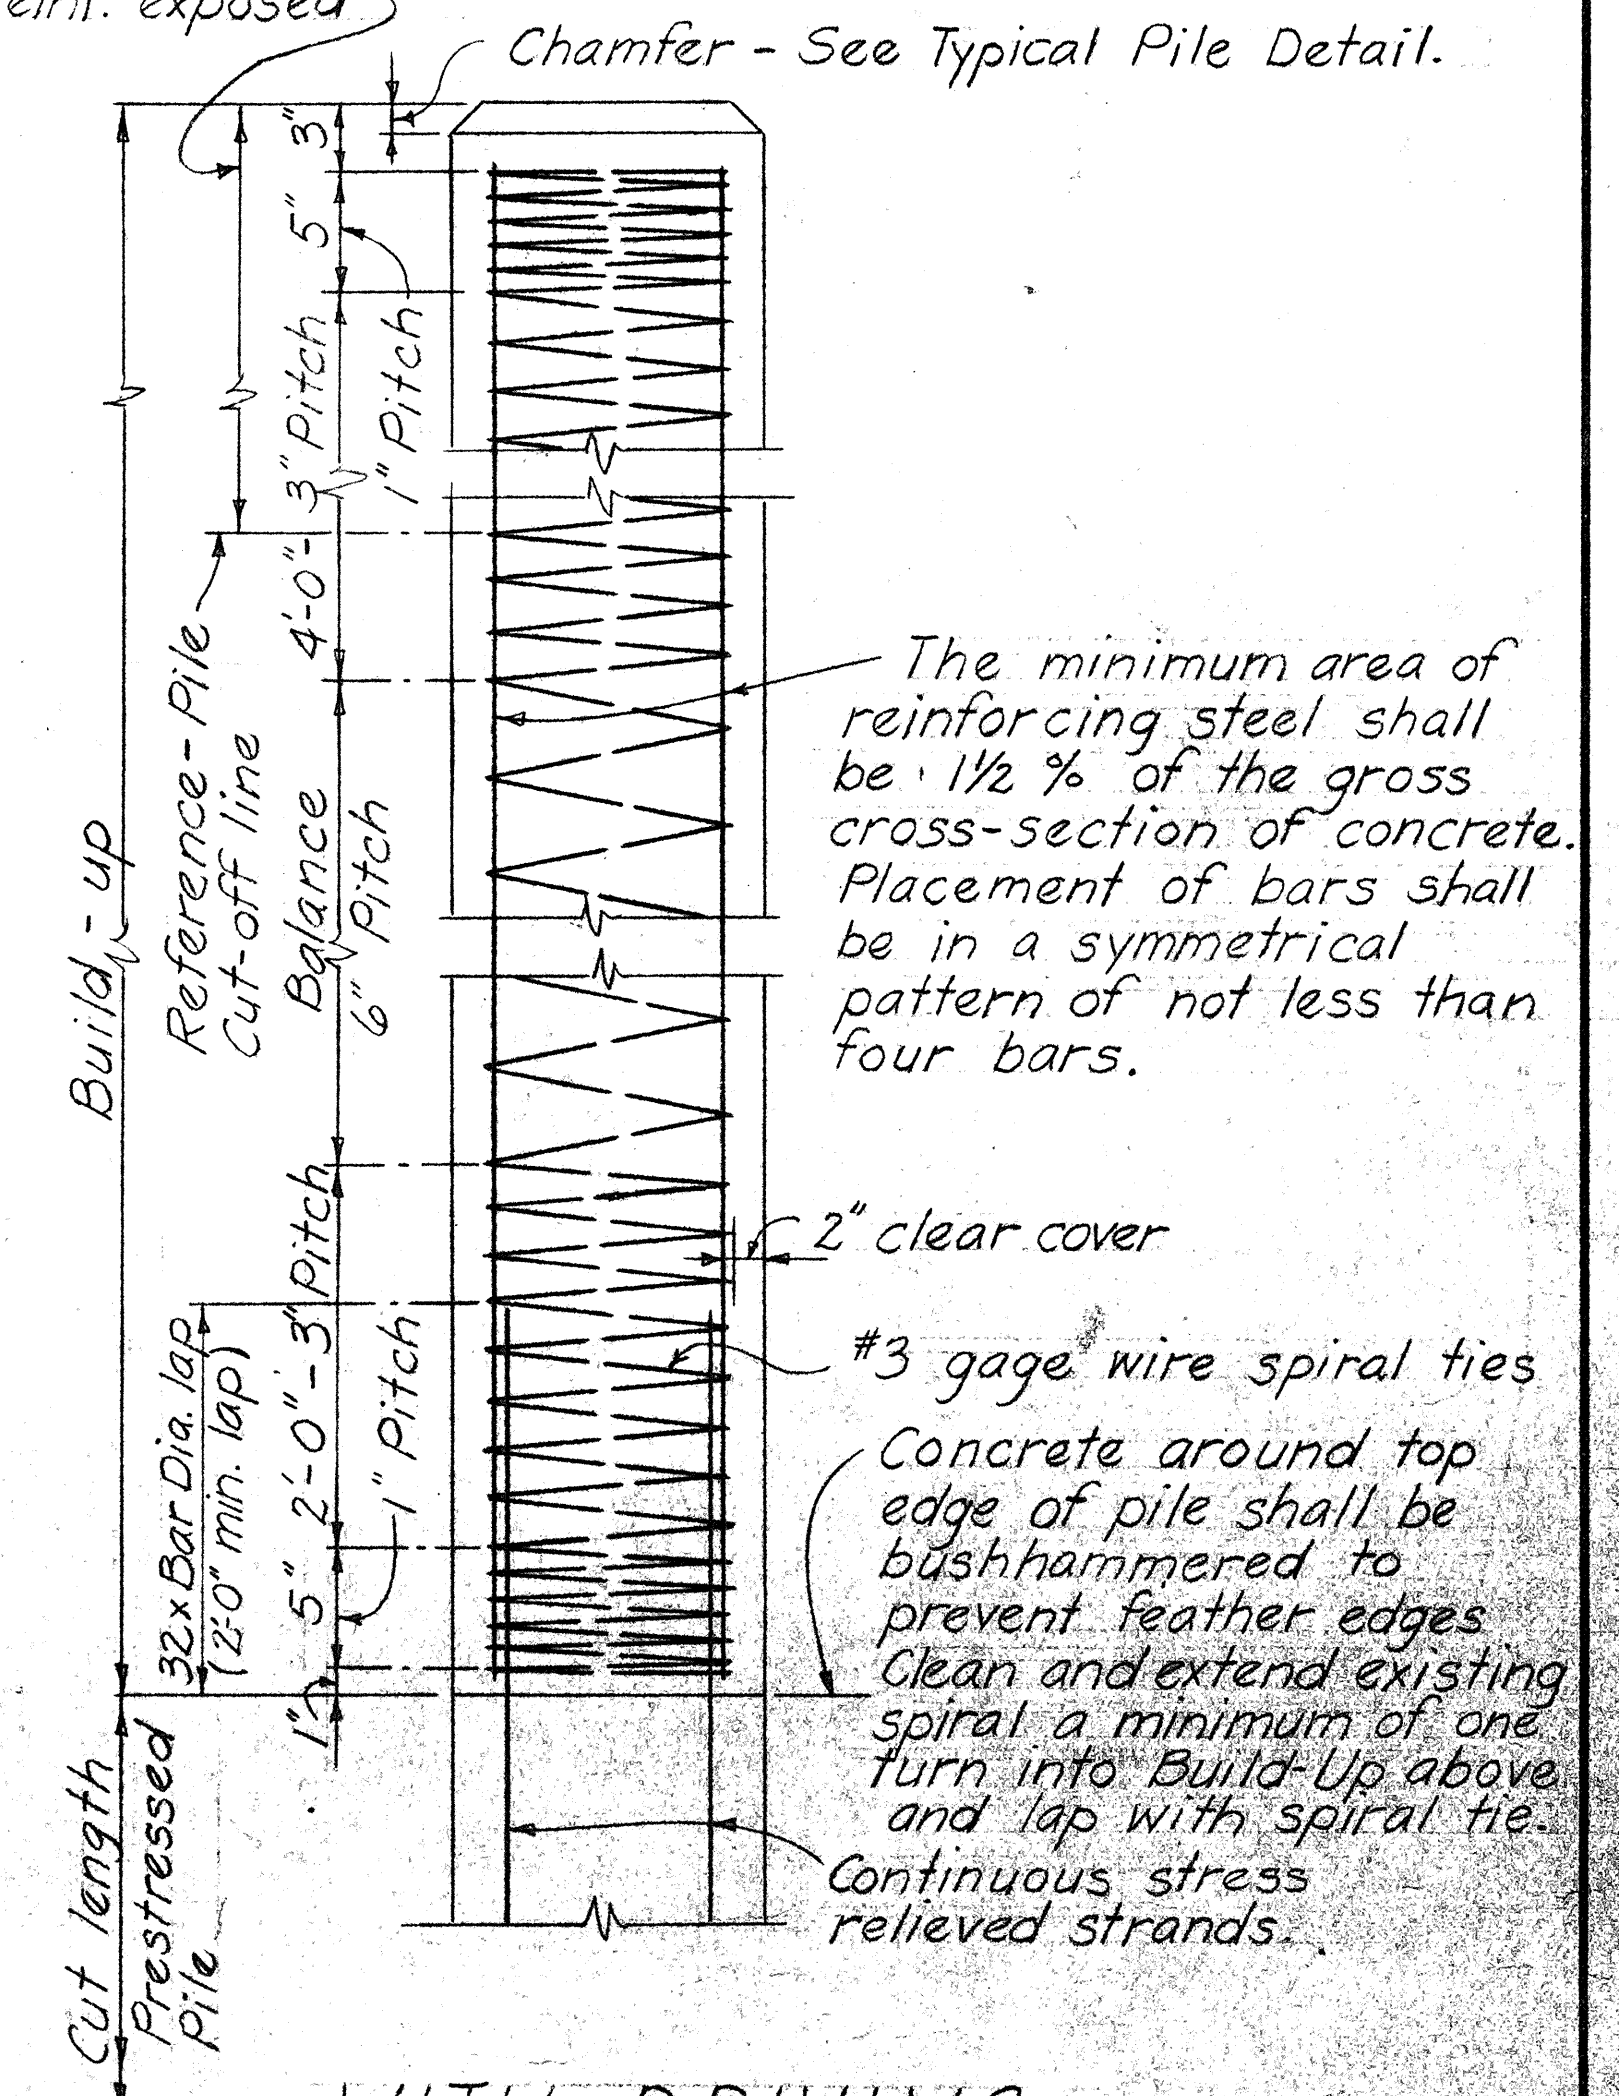

WITH DRIVING
TYPICAL PILE BUILD-UP DETAIL

APPROVAL RECOMMENDED: Paul T. Yamashita 1-23-70
BRIDGE DESIGN ENGINEER DATE

APPROVED Paul T. Yamauchi 1-28-70
For ASSISTANT CHIEF, ENGINEERING DATE

STATE OF HAWAII
DEPARTMENT OF TRANSPORTATION
HIGHWAYS DIVISION

STANDARD DETAILS

PRESTRESSED CONCRETE PILES

Date: Oct. 1968

Date: Oct. 1968

SHEET No. 56 OF 6 SHEETS DB-300-2

ORIGINAL	SURVEY PLOTTED BY _____	DATE _____
PLAN	DRAWN BY _____	" _____
	TRACED BY _____	" _____
NOTE BOOK	DESIGNED BY _____	" _____
	QUANTITIES BY _____	" _____
No. _____	CHECKED BY _____	