

SHEET NO	DESCRIPTION
1	TITLE SHEET
2 - 3	TYPICAL SECTIONS
* 4 - 7	ROADWAY PLAN AND PROFILE
8	LANDSCAPING PLAN
* 9 - 18	IRRIGATION & DRAINAGE DETAILS
19 - 36	MISCELLANEOUS STANDARD DETAILS
37 - 59	KILAUEA STREAM BRIDGE STRUCTURE
60 - 74	CROSS SECTIONS

FED. ROAD DIST. NO.	STATE	FED. AID PROJ. NO.	FISCAL YEAR	SHEET NO.	TOTAL SHEETS
HAWAII	HAW.	RF-056-1(10)	1971	1	74

HIGHWAYS DIVISION "AS-BUILT" PLANS FOR KAUAI BELT ROAD

(KILAUEA TO KAHILI)


FEDERAL AID PRIMARY PROJECT NO. DP-RF-056-1(10)

DISTRICT OF HANA LEI

ISLAND OF KAUAI

SCALES

PLAN	1 INCH = 100 FT.
PROFILE	HOR. 1 INCH = 100 FT.
	VER. 1 INCH = 10 FT.
CROSS SECTION	HOR. 1 INCH = 10 FT.
	VER. 1 INCH = 10 FT.

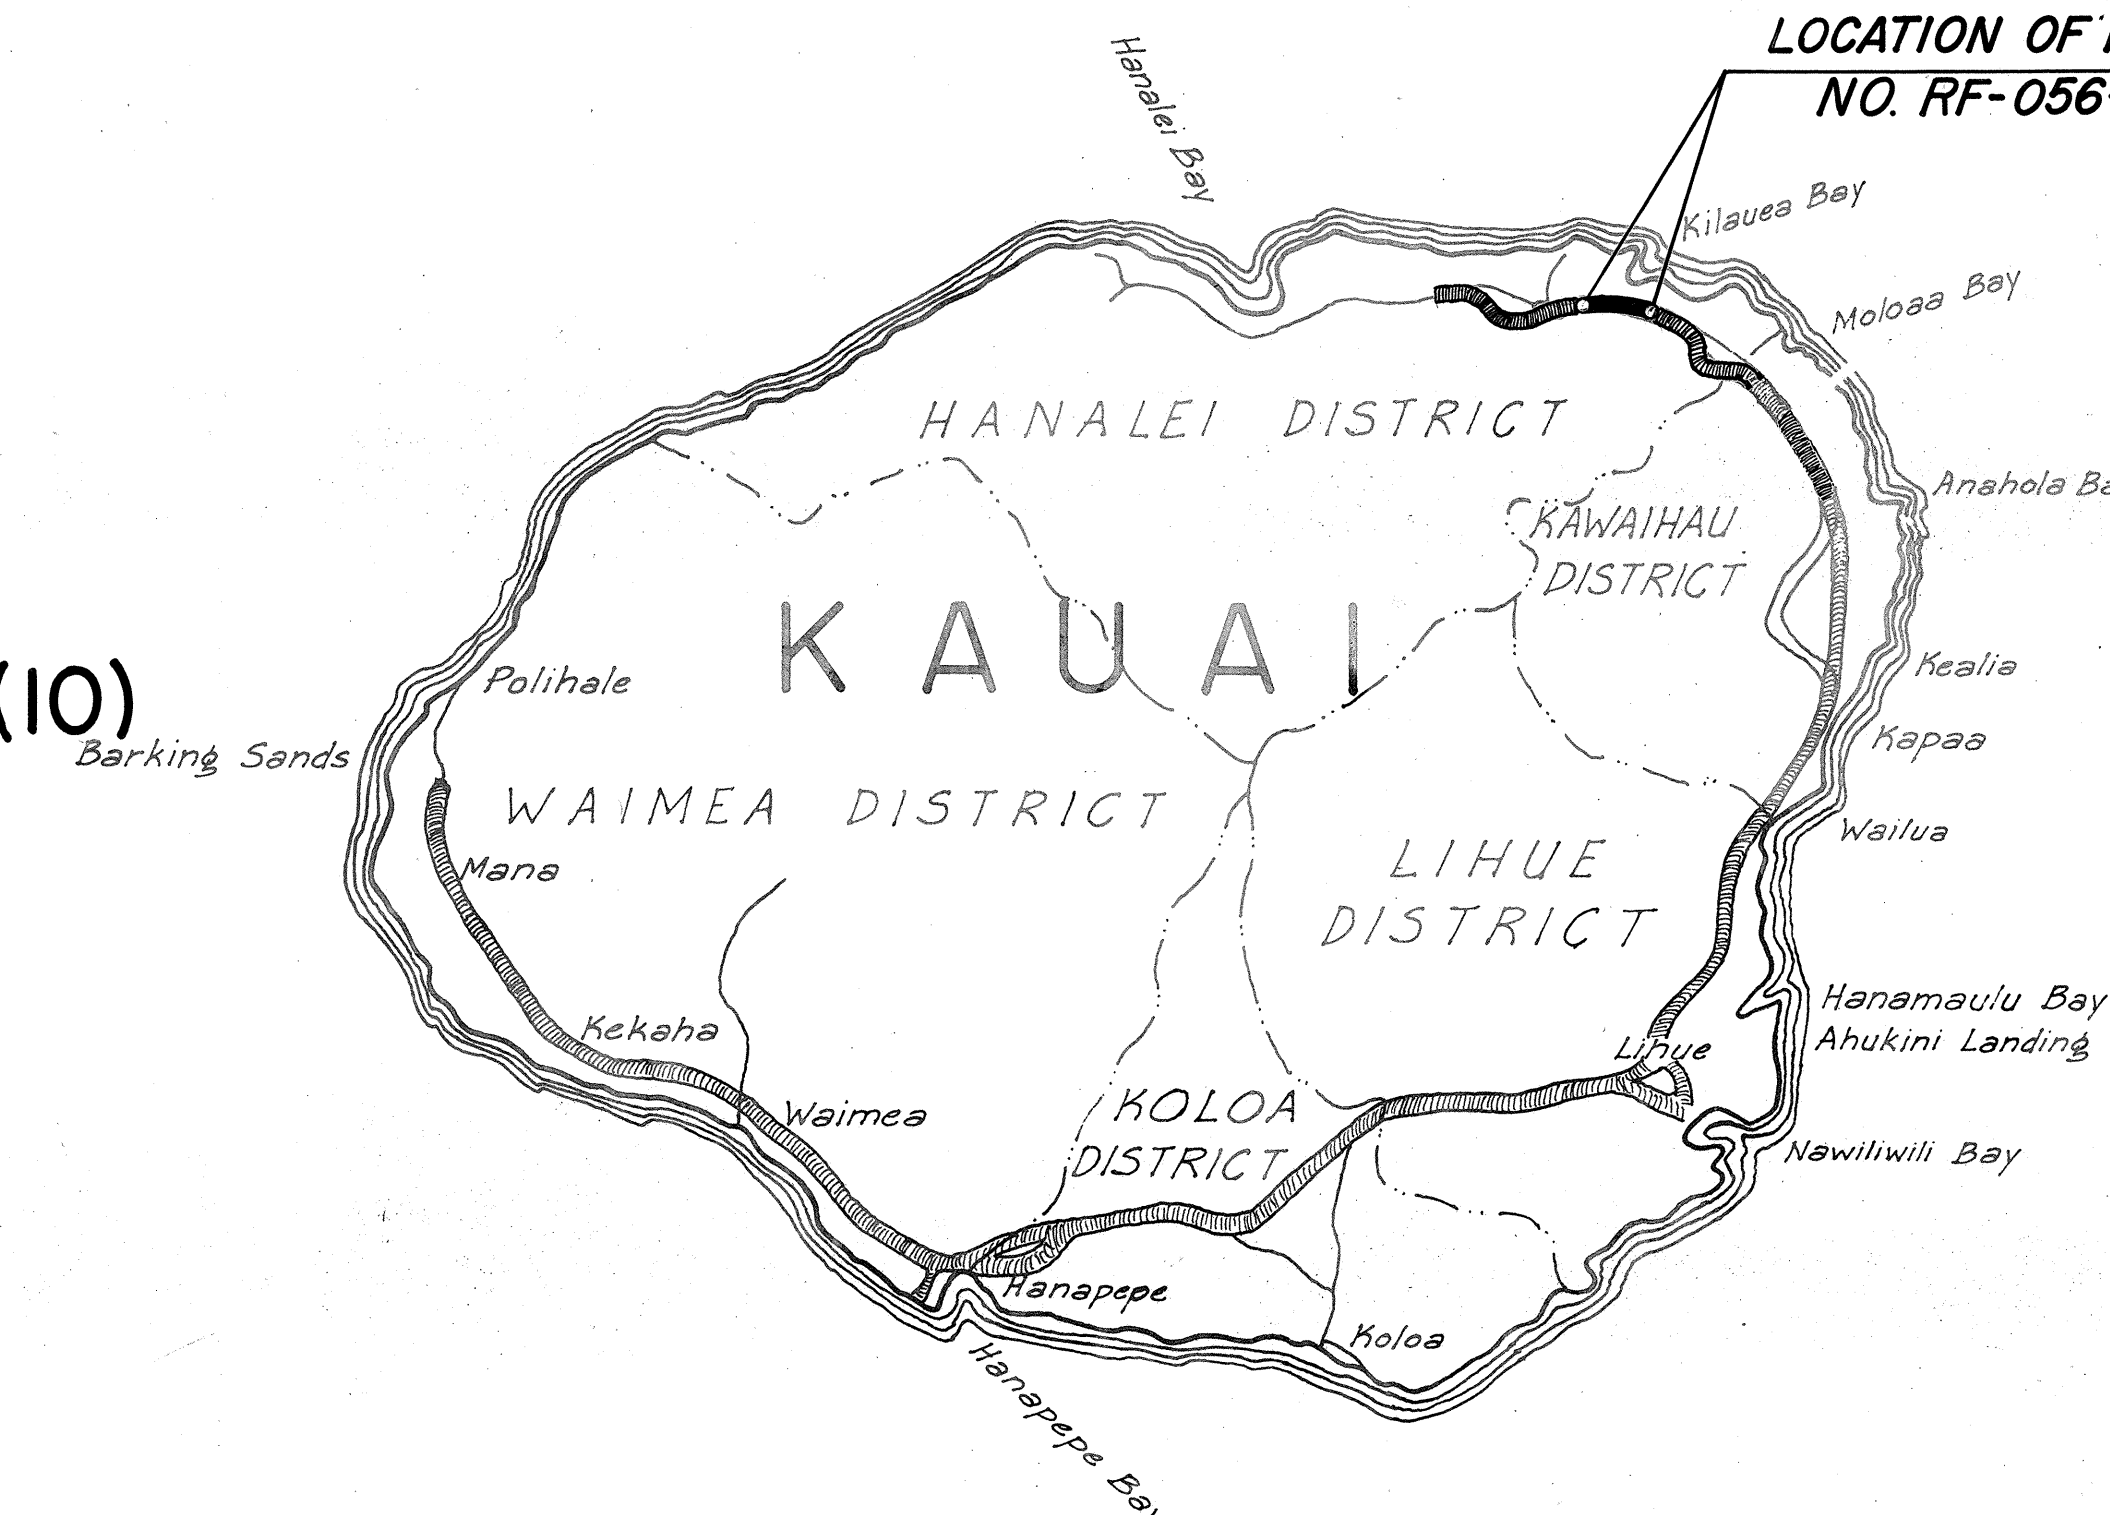

FEDERAL AID PROJECTS PREVIOUSLY CONSTRUCTED OR UNDER CONSTRUCTION

NOTE:


ALL CHANGES MADE DURING CONSTRUCTION
HAVE BEEN NOTED IN RED ON THESE TRACINGS
AND CHECKED BY:

PROJECT ENGINEER

6/6/74
DATE

DESIGN CLASSIFICATION

ADT (1971)	1550
DESIGN ADT (1991)	4500
DHV	10%
D	55/45
T	15%
T ₂₄	5.5%
V	60MPH

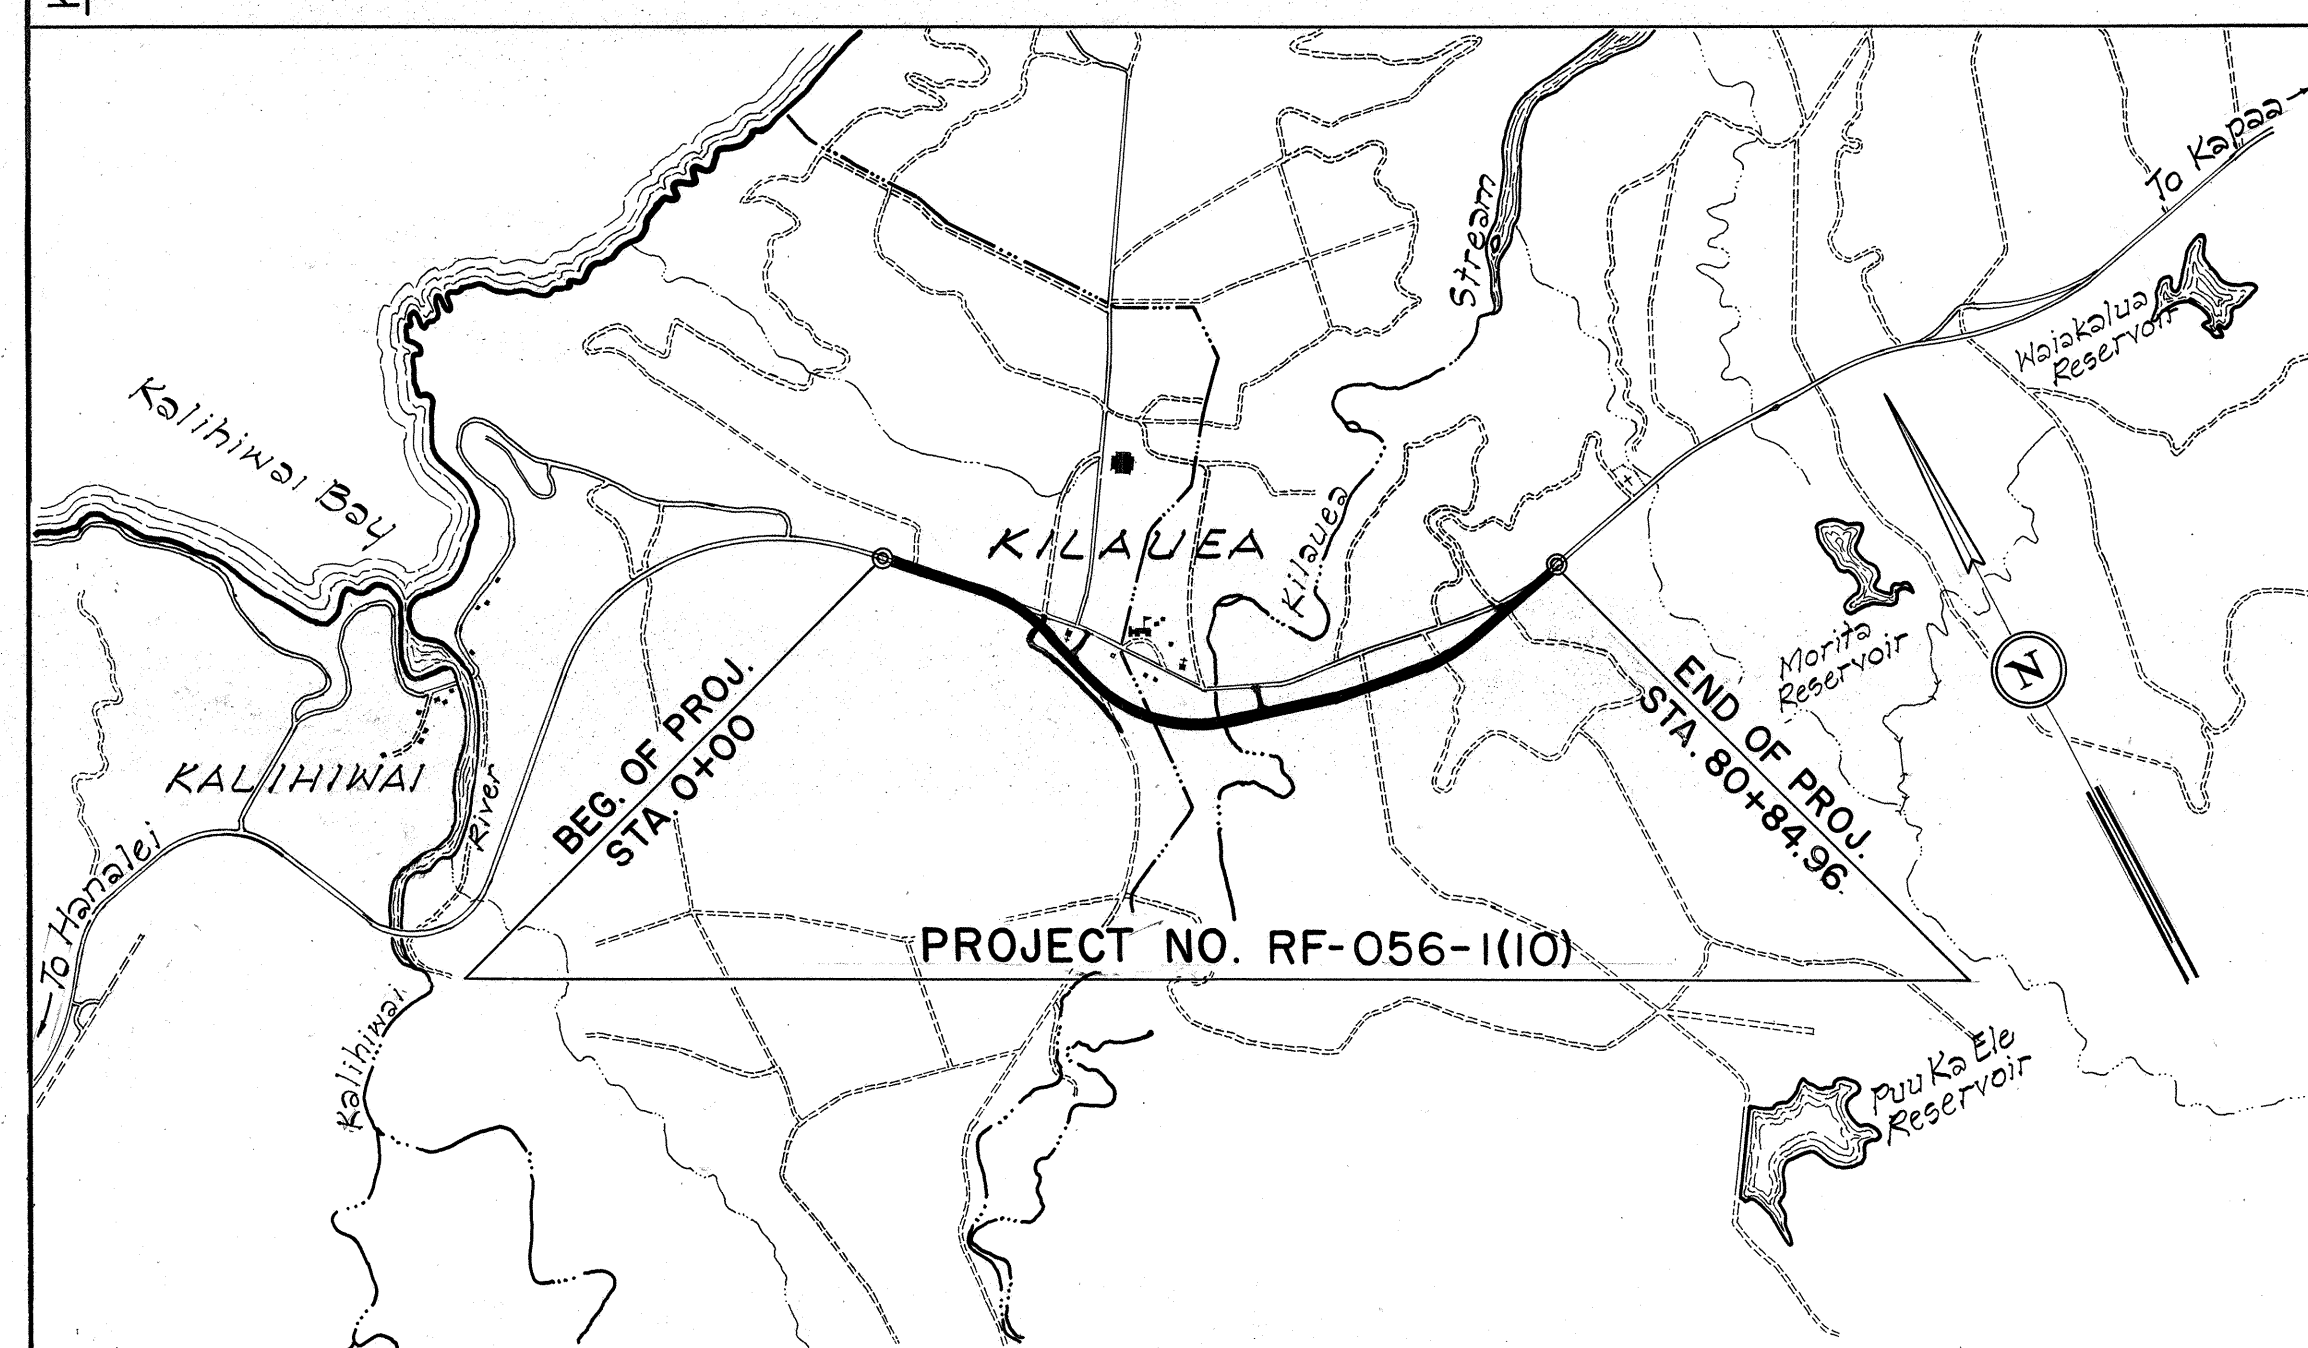

LAYOUT OF PROJECT

SCALE: 1" = 2000'

GROSS LENGTH OF PROJ. 1.531 mi
BRIDGE LENGTH 0.048 mi
NET LENGTH OF PROJ. 1.483 mi

DEPARTMENT OF TRANSPORTATION FEDERAL HIGHWAY ADMINISTRATION	
APPROVED:	
	6-17-71
DIVISION ENGINEER	DATE

DEPARTMENT OF TRANSPORTATION STATE OF HAWAII	
APPROVED:	
E. Alvey Wright 5/24/77	
for	DIR. OF TRANSPORTATION DATE

ORIGINAL PLAN	SURVEY PLOTTED BY _____ DESIGNED BY <u>P. Mikami</u> DRAWN BY _____ TRACED BY _____ QUANTITIES BY _____ QUANTITIES CHECKED BY _____ CHECKED BY _____	DATE <u>Dec. 12, 69</u>
NOTE BOOK		
No. _____		