
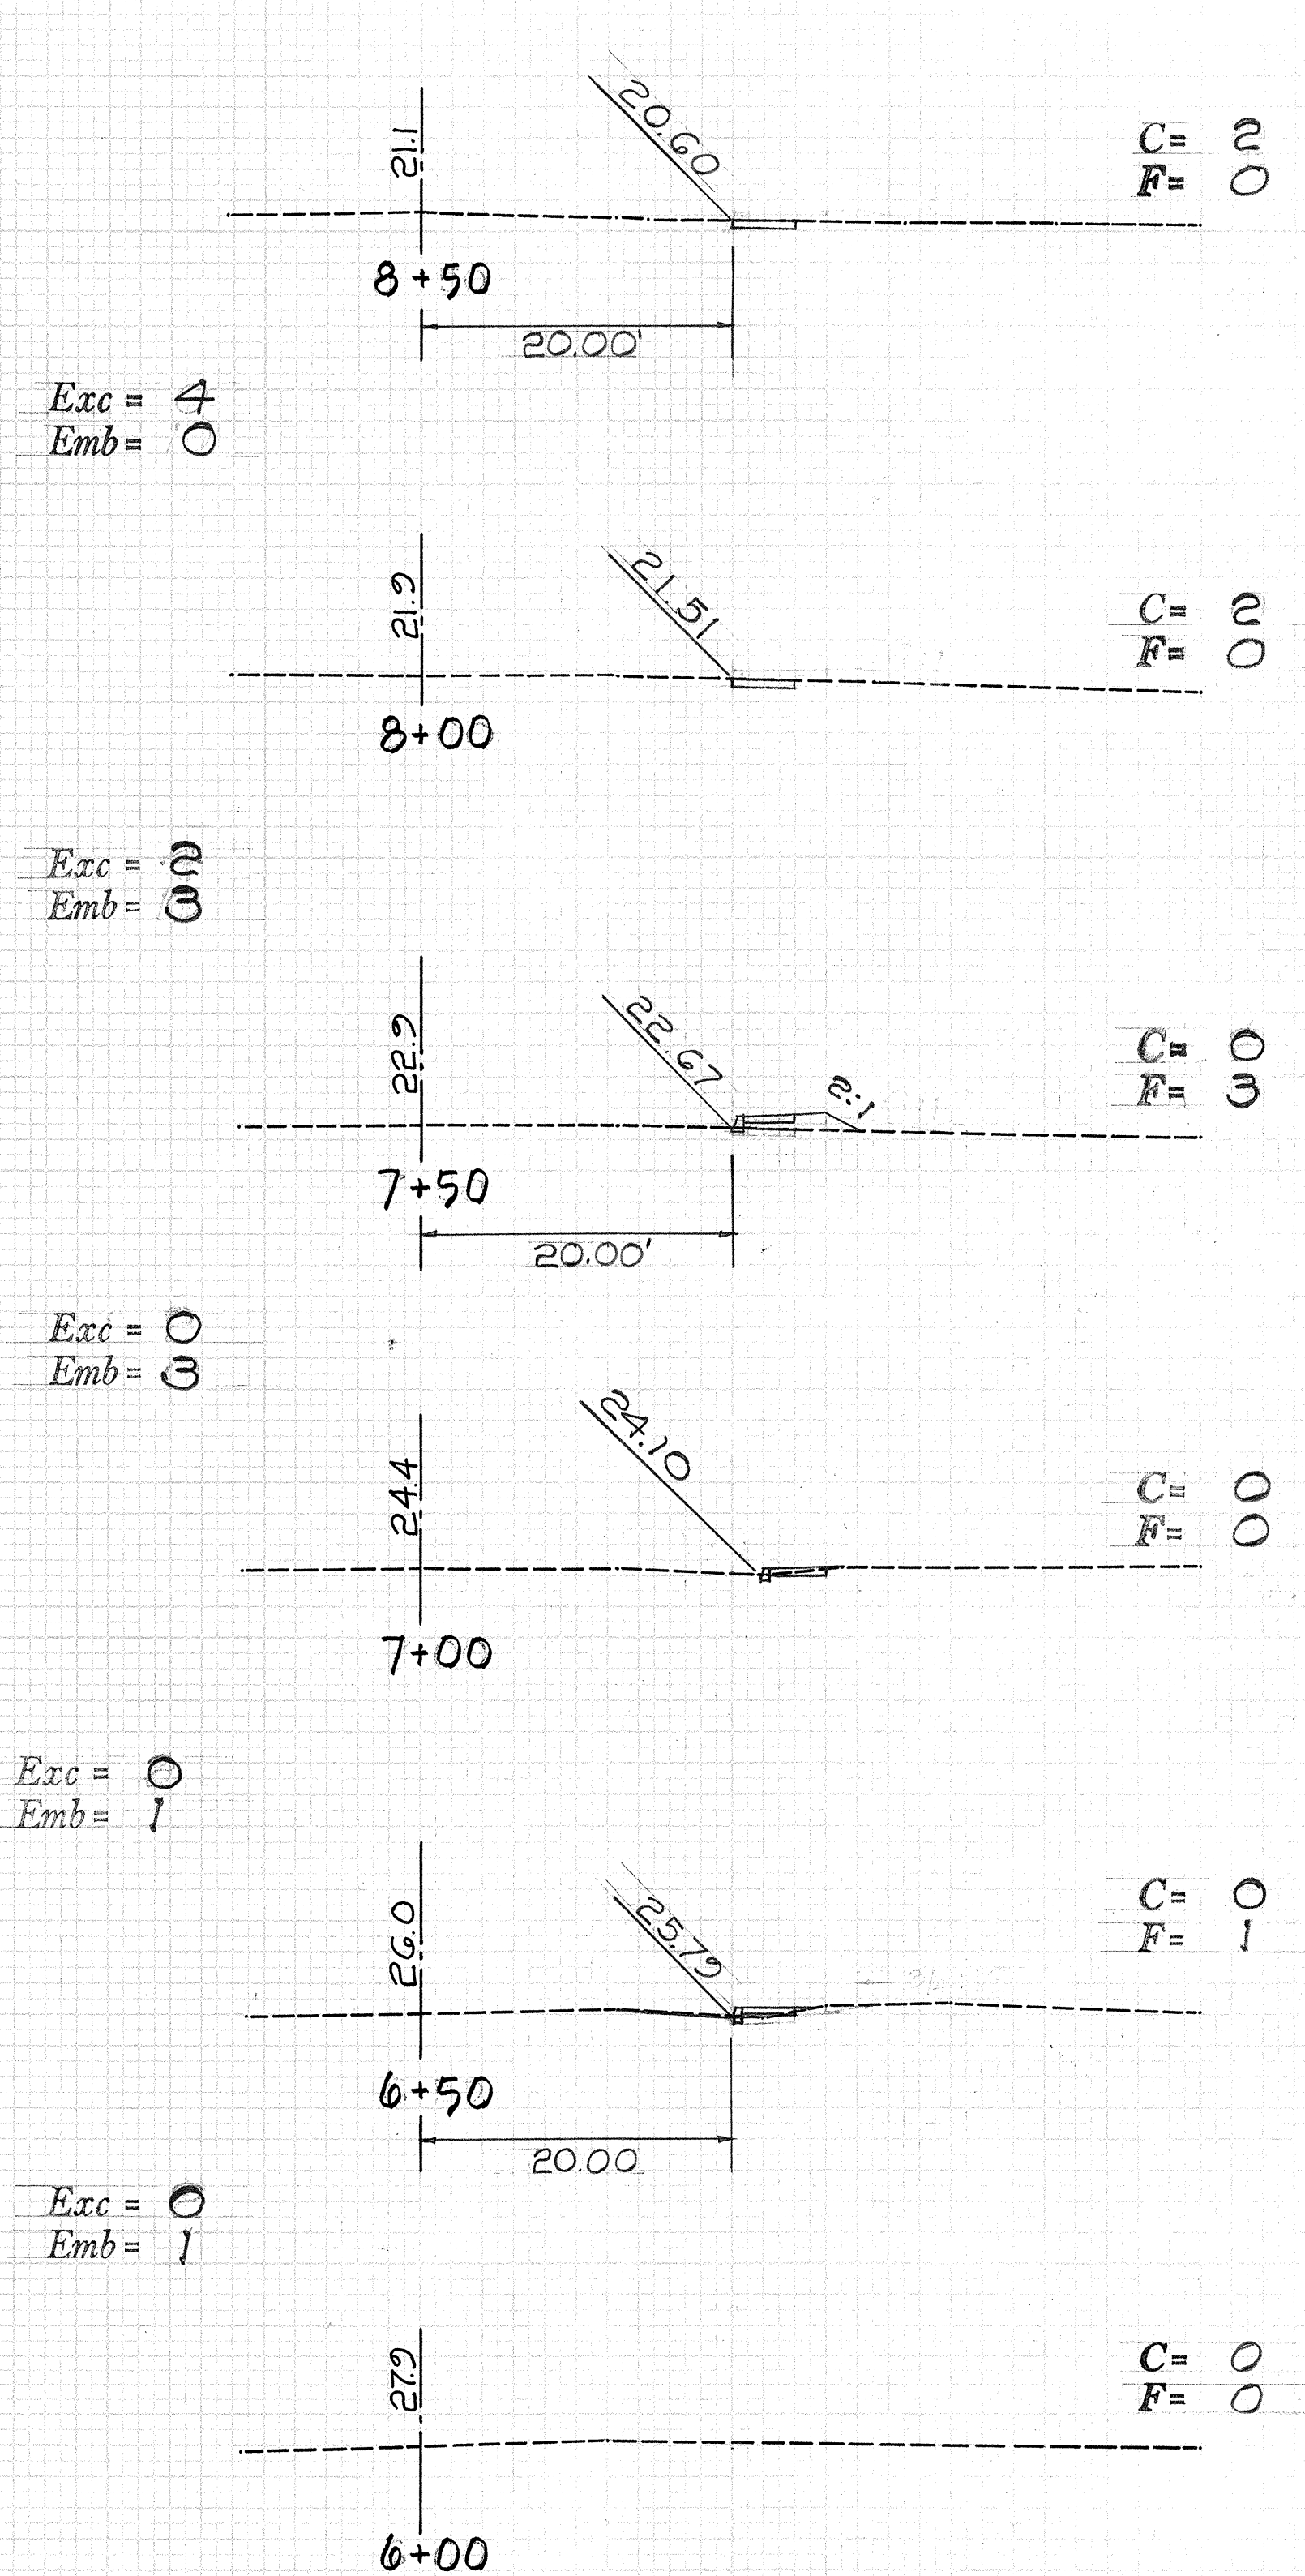
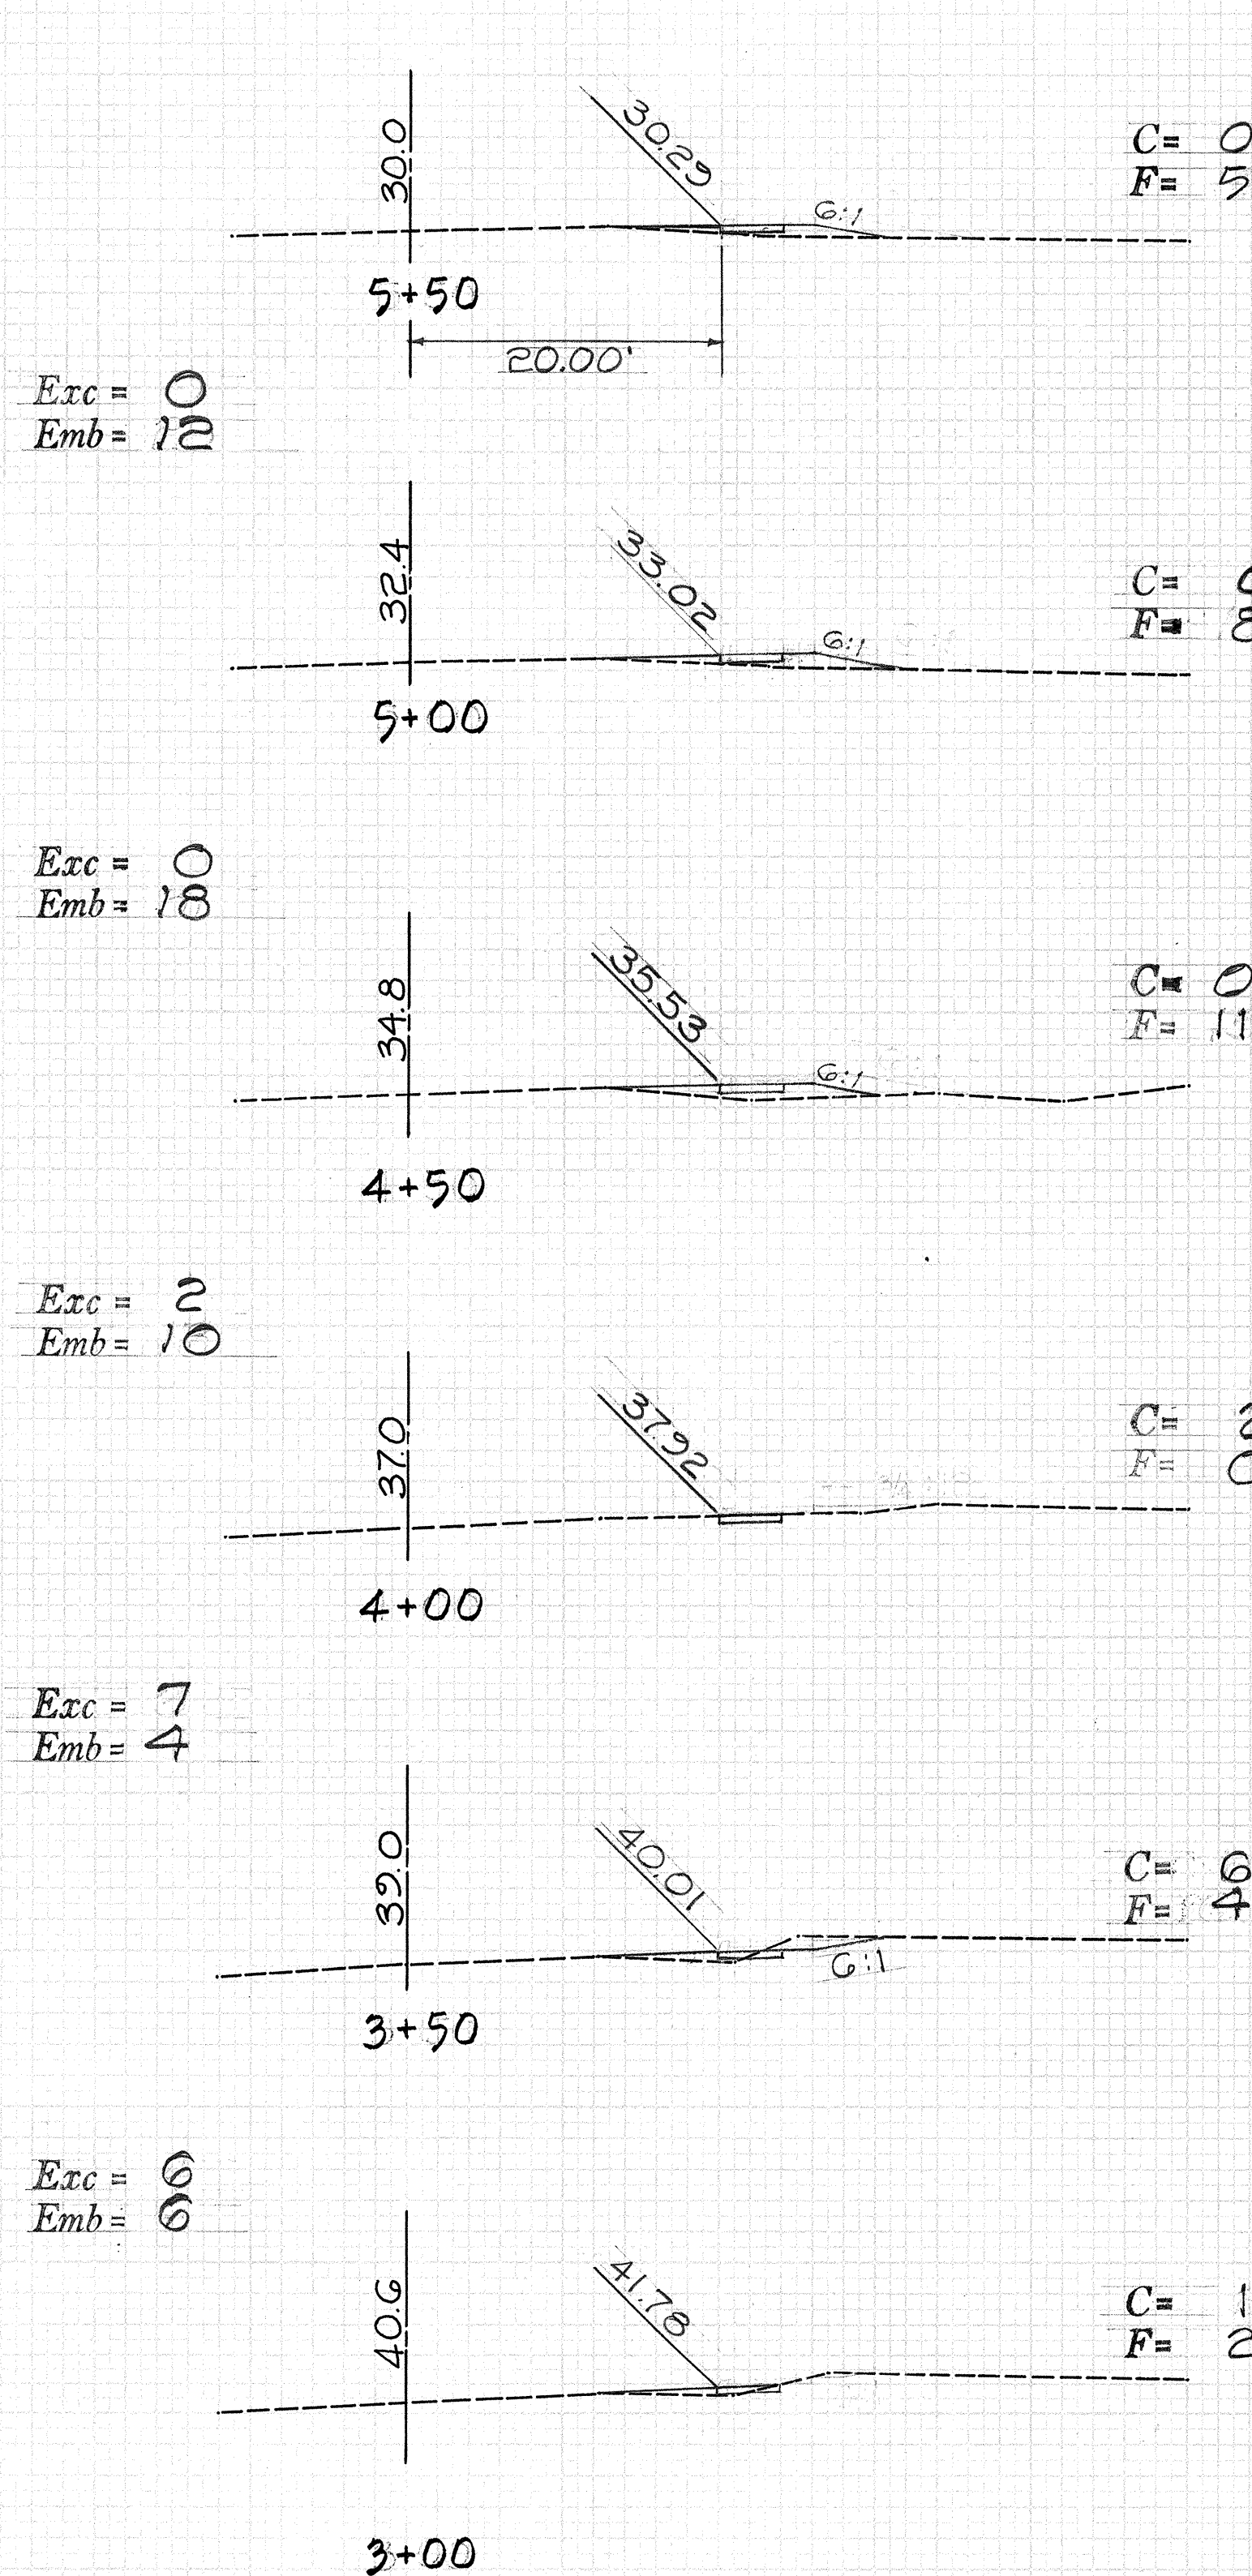




















DIST. NO.	STATE	PROJ. NO.	FISCAL YEAR	SHEET NO.	TOTAL SHEETS
HAWAII	HAW.	BD 62-464	1972	16	23

FINAL	SURVEY	DATE
SURVEY	PLOTTED	
NOTE BOOK	TEMP. ATC	
NO.	AREAS CHECKED	

ORIGINAL	SURVEY	DATE
SURVEY	PLOTTED	
NOTE BOOK	TEMP. ATC	
NO.	AREAS CHECKED	

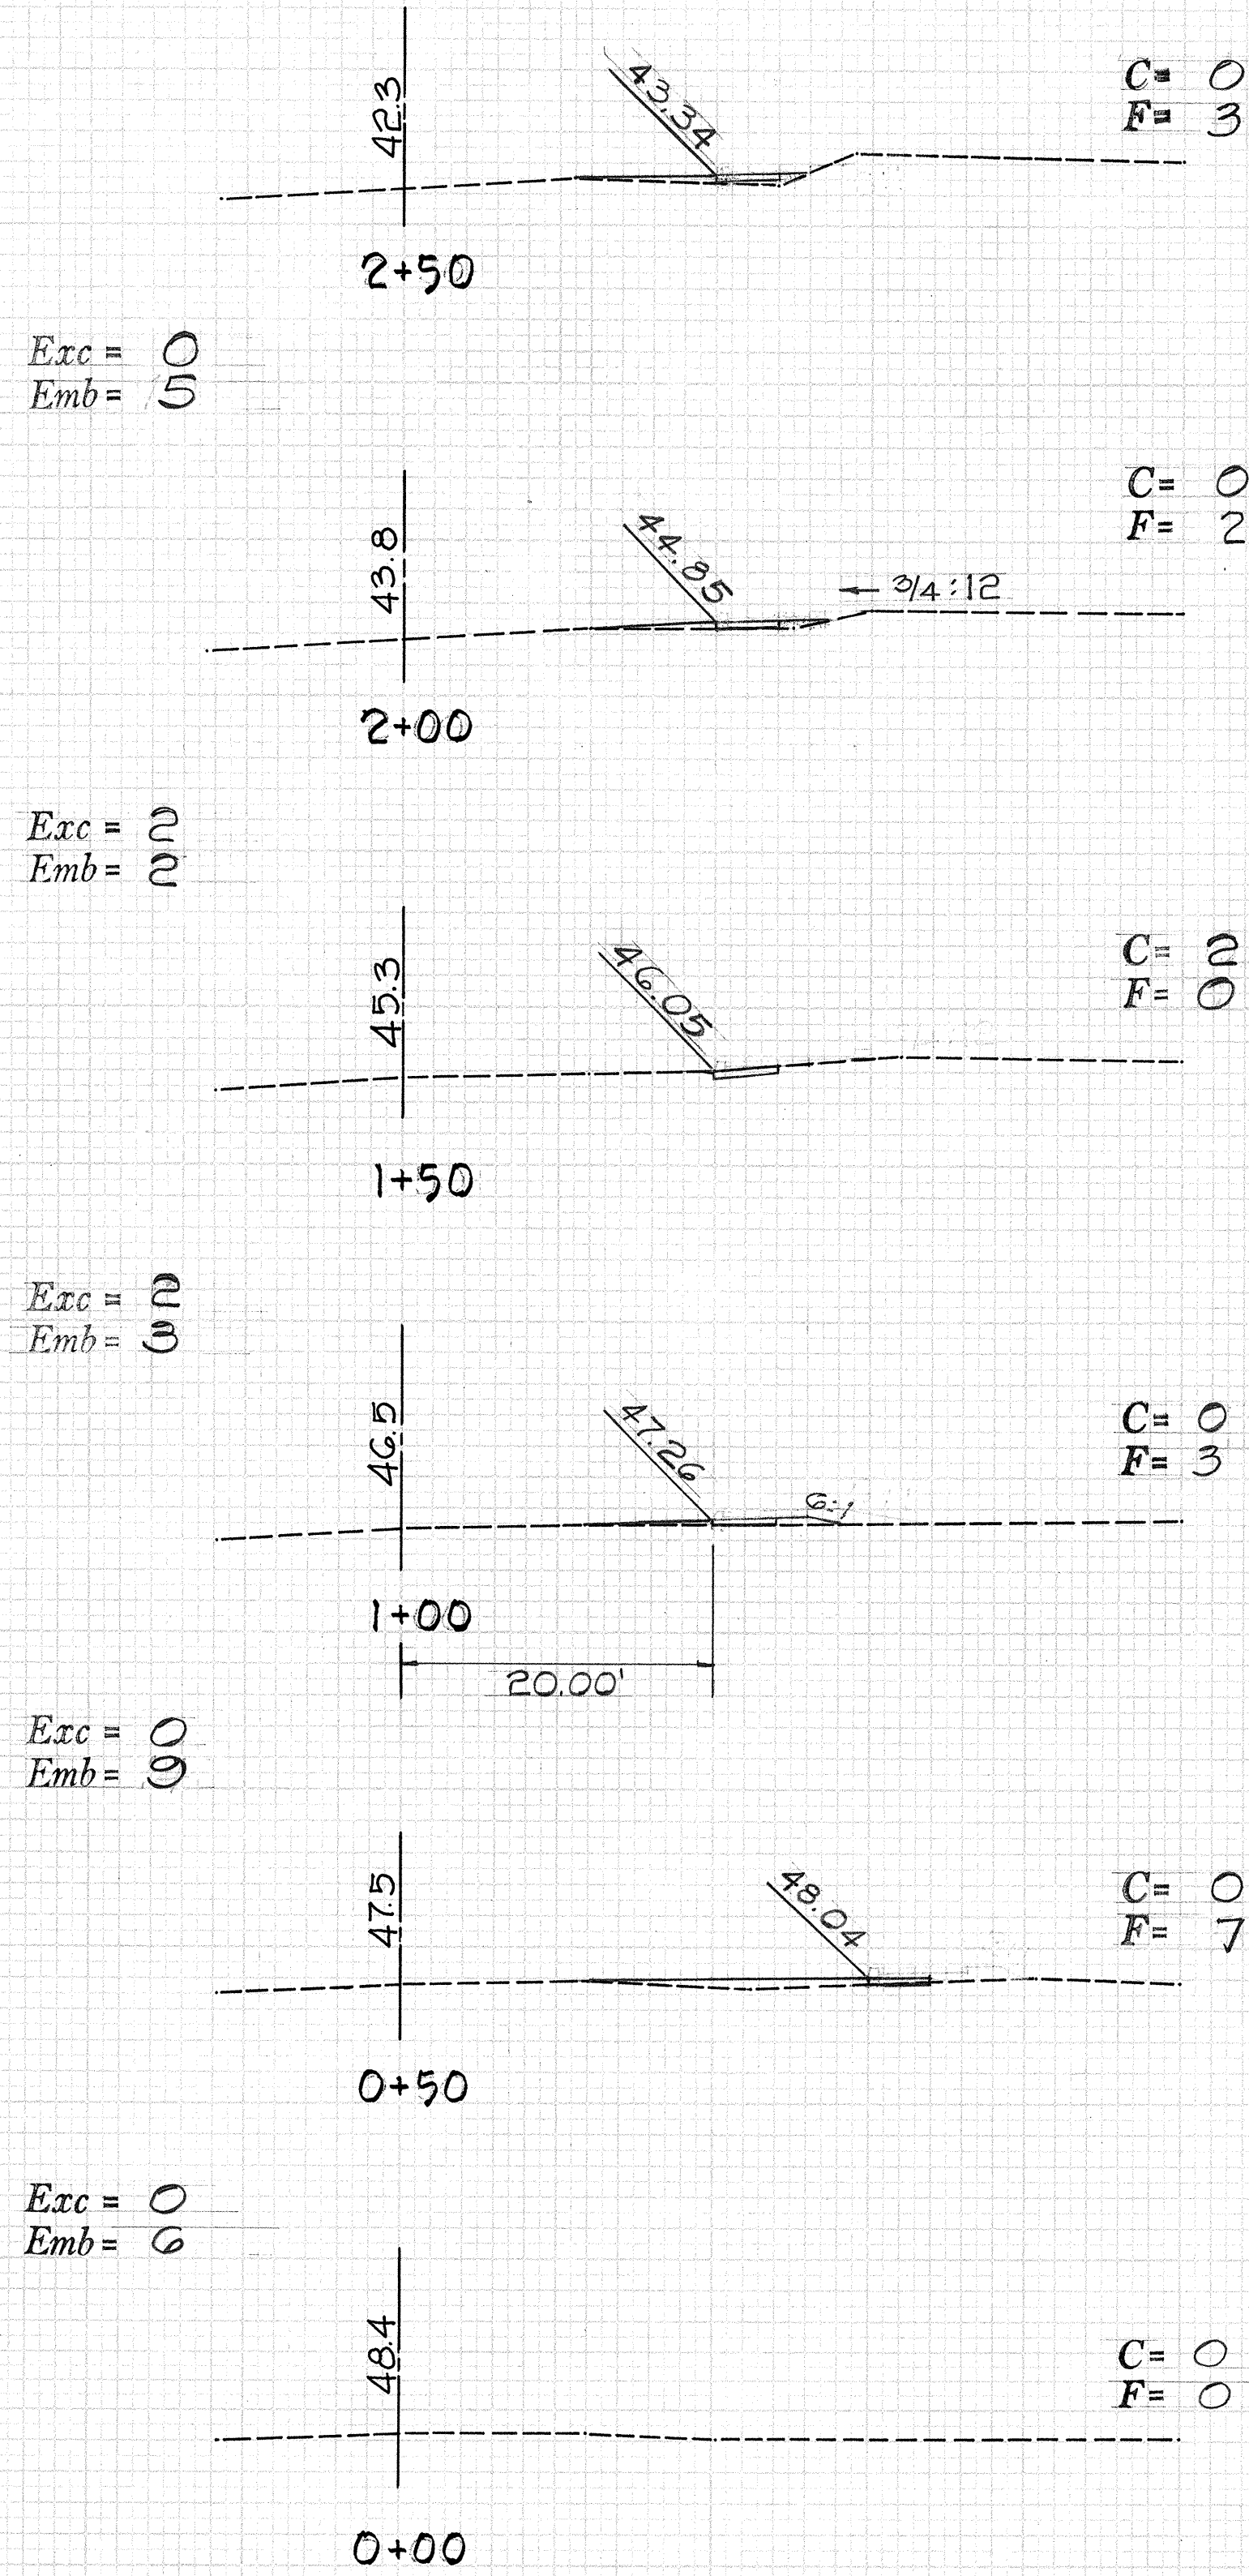

DIST. NO.	STATE	PROJ. NO.	FISCAL YEAR	SHEET NO.	TOTAL SHEETS
HAWAII	HAW.	BD 69-464	1972	17	23

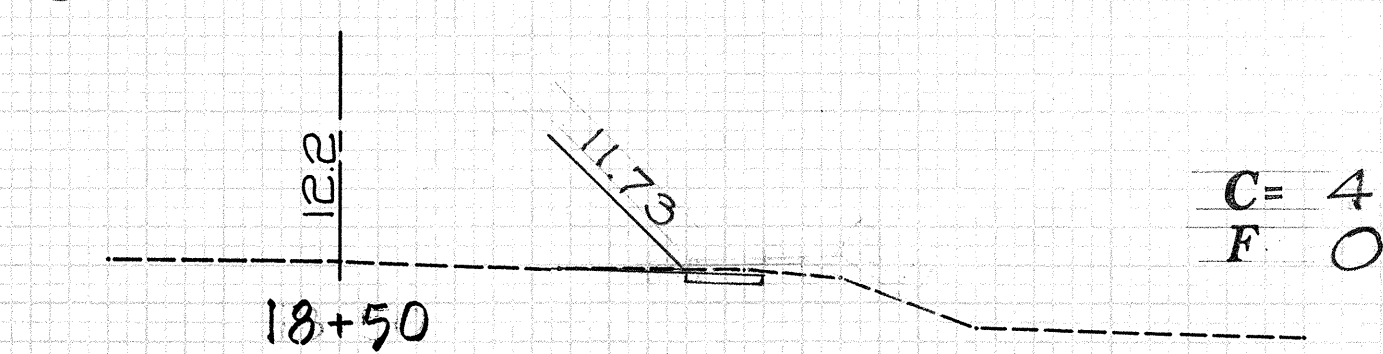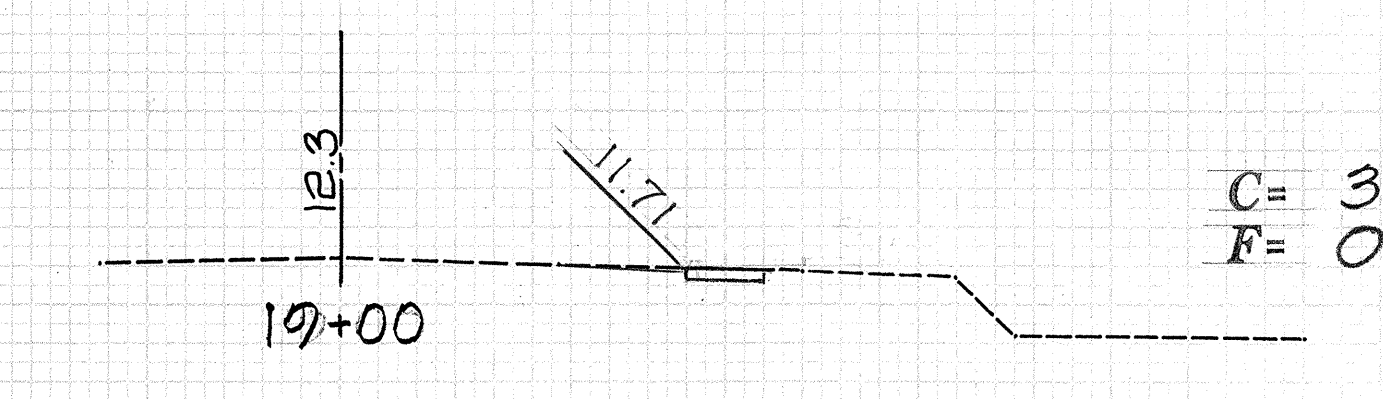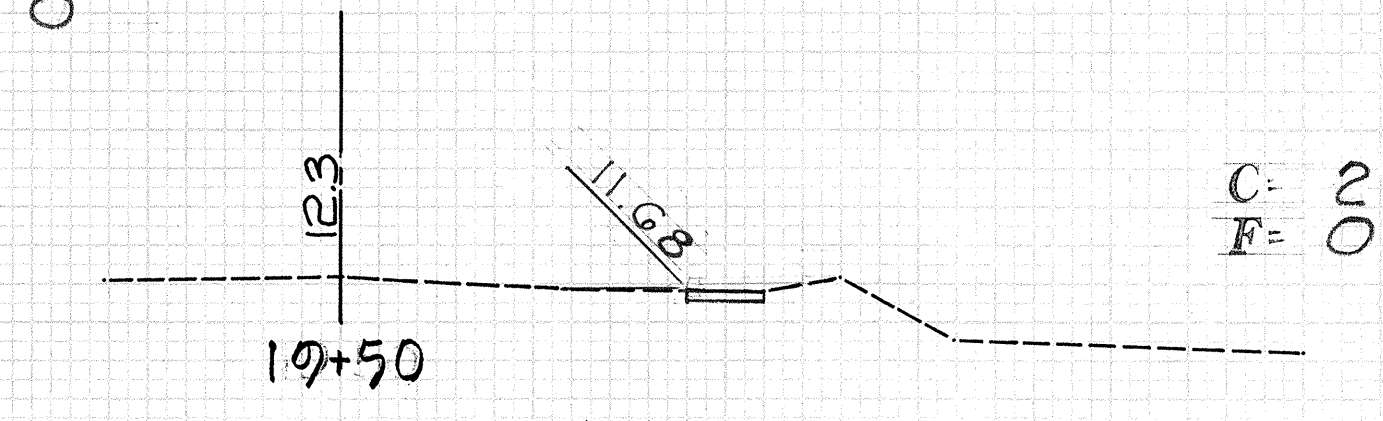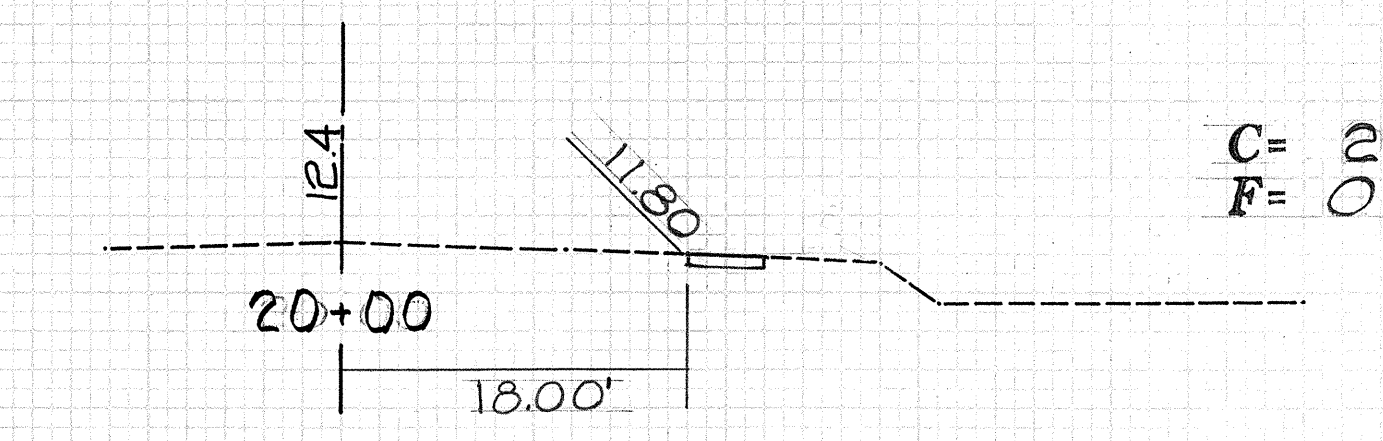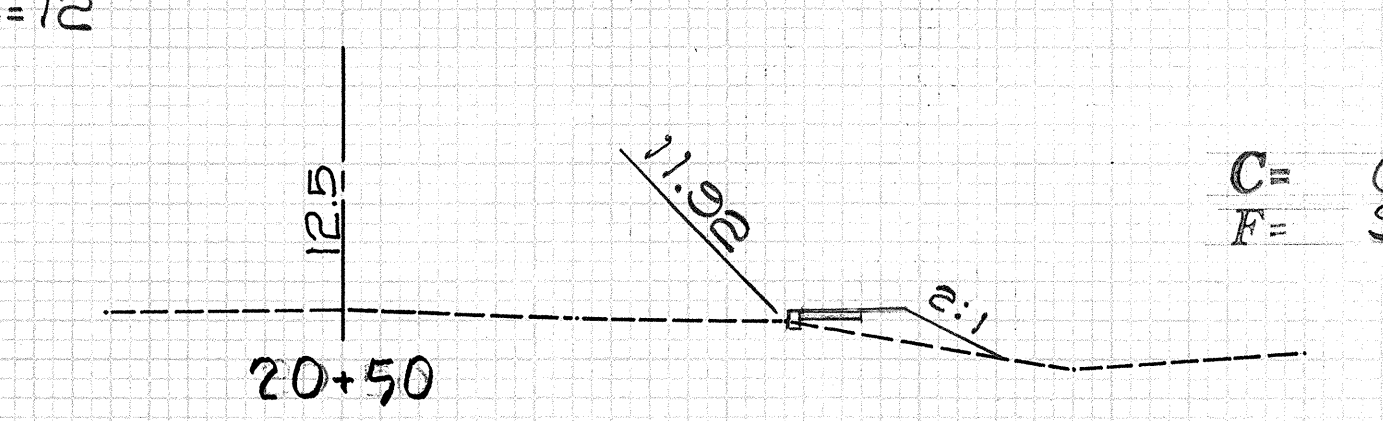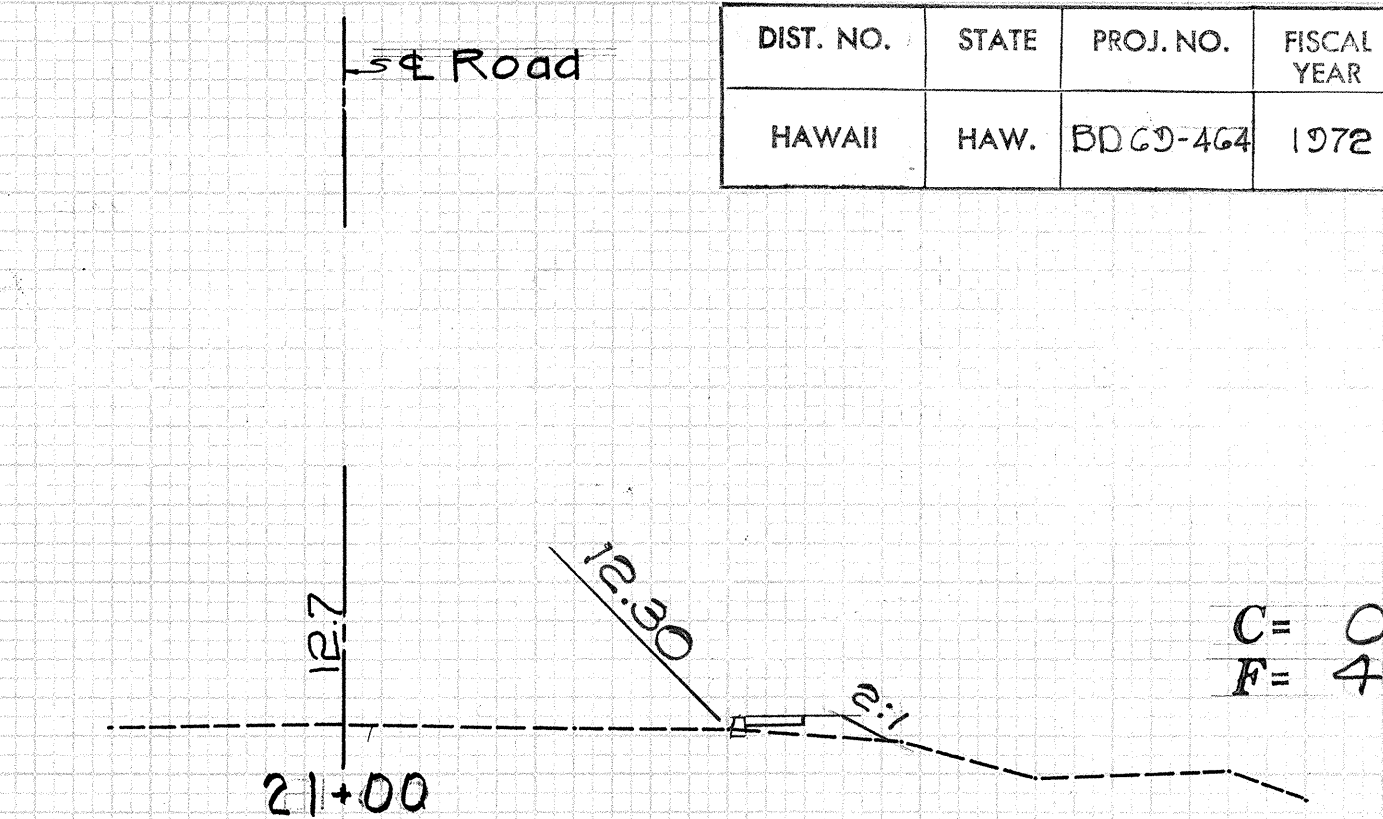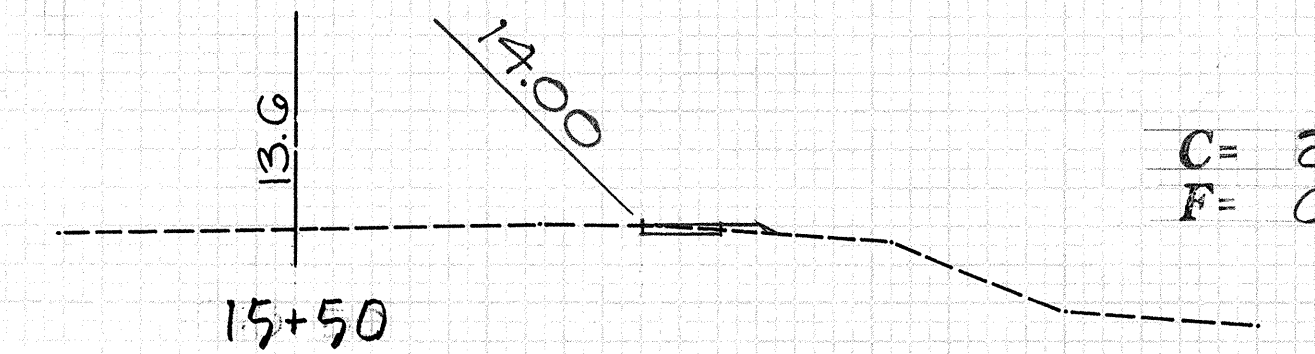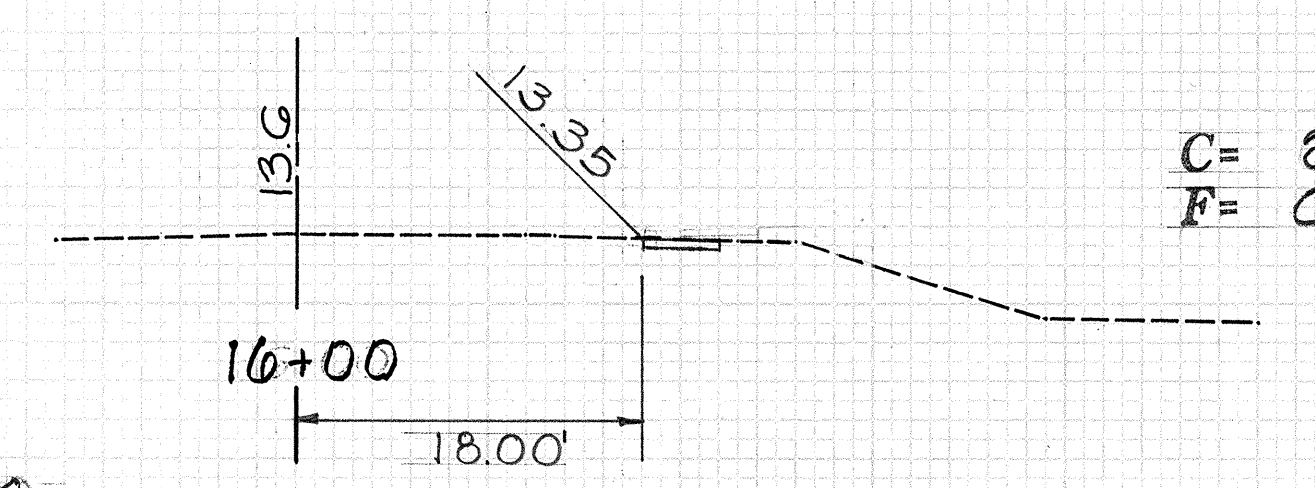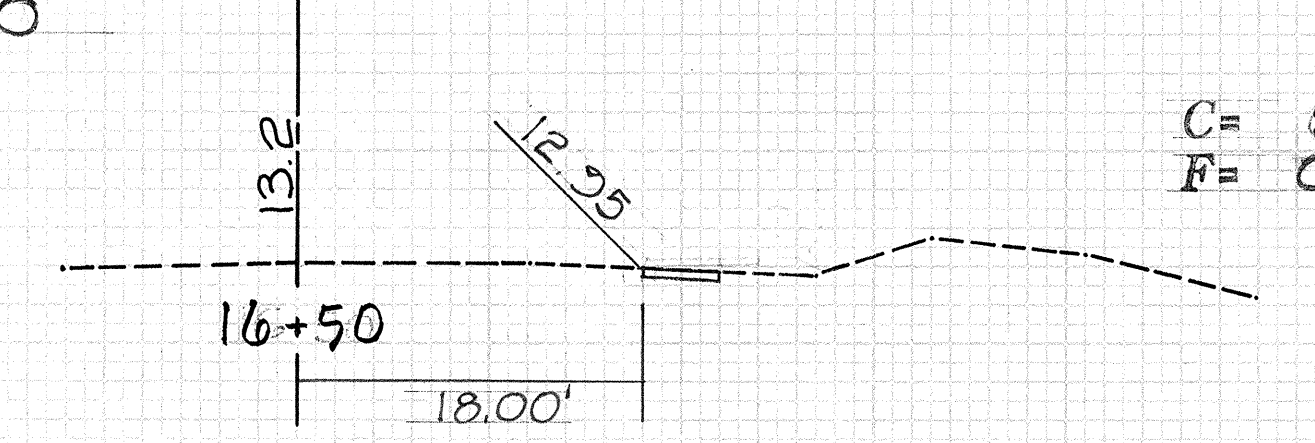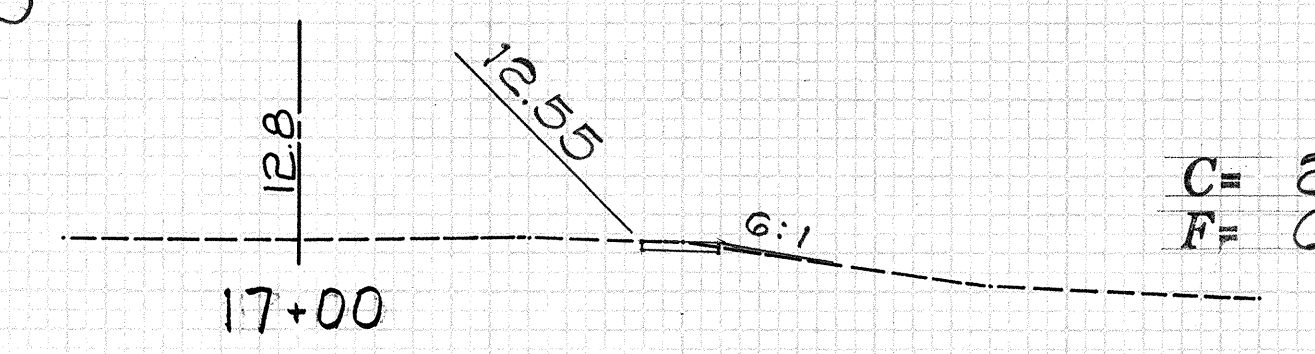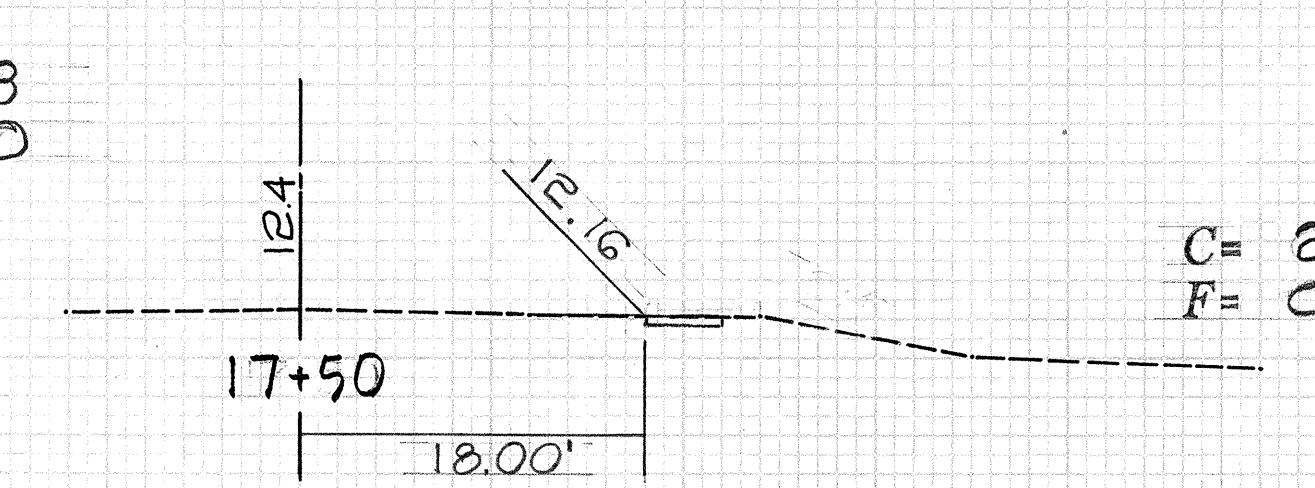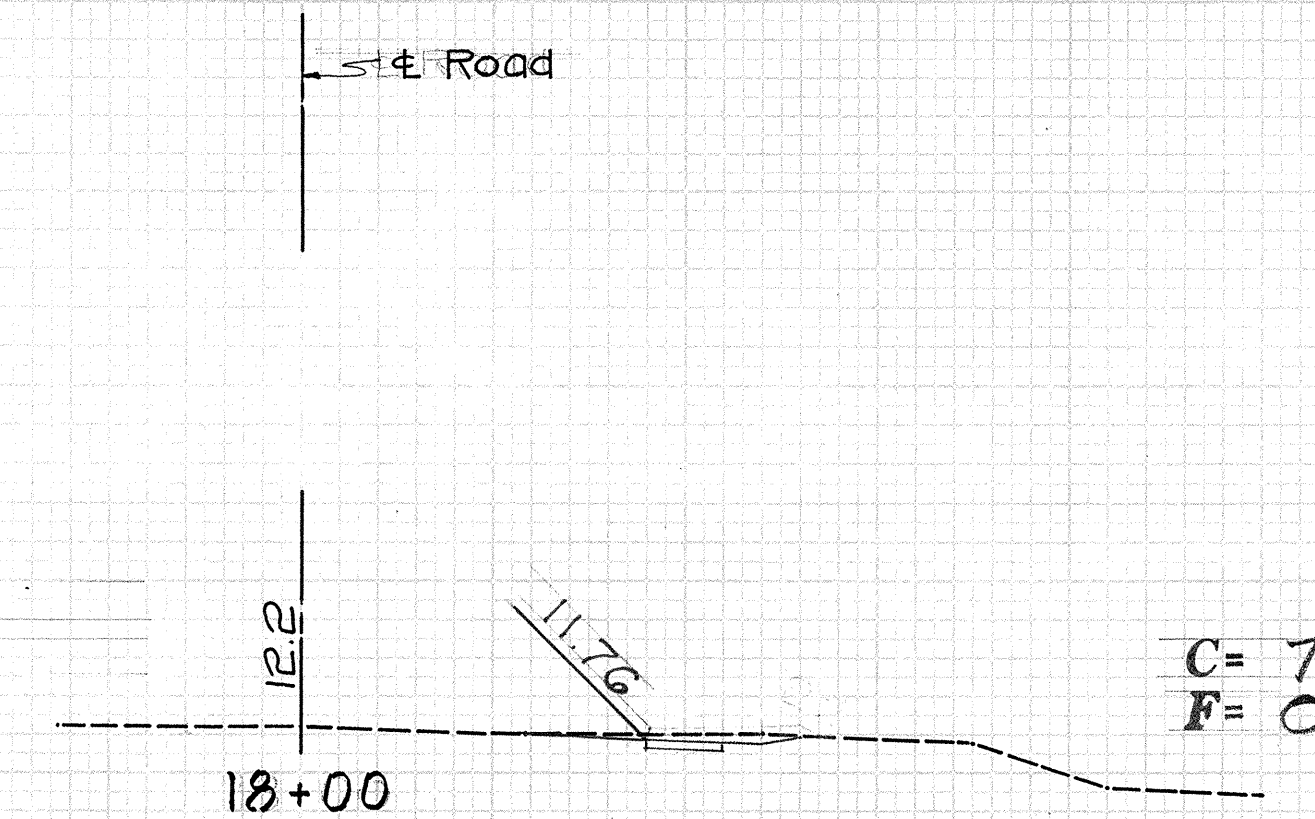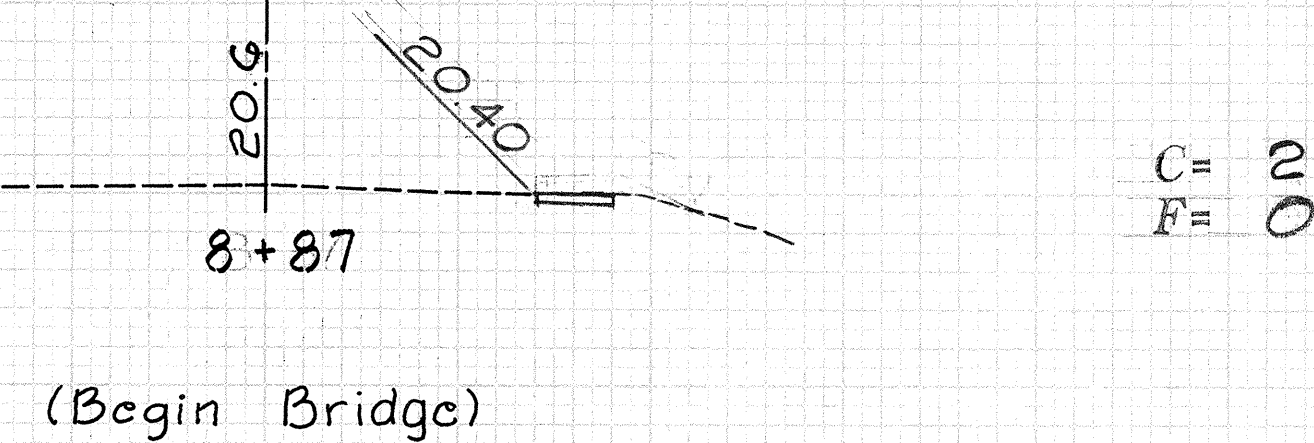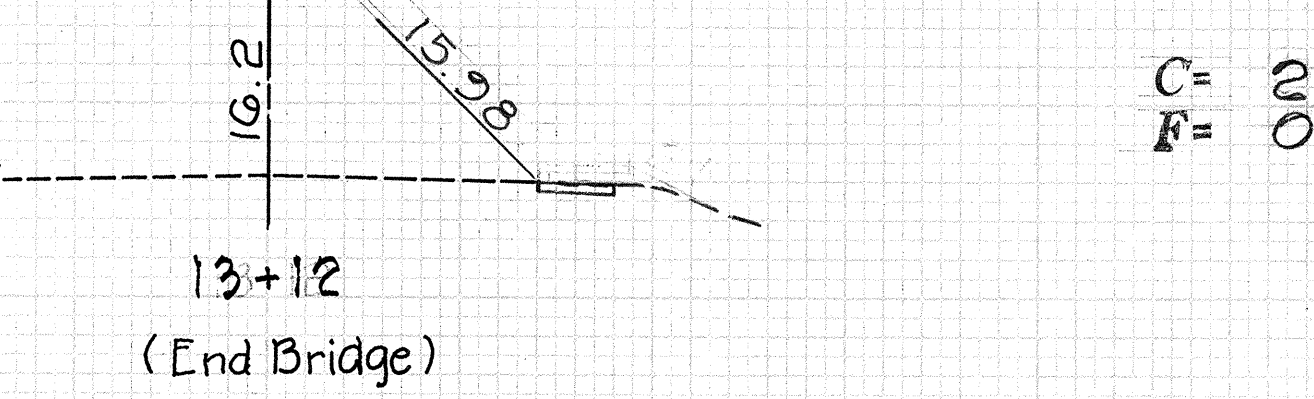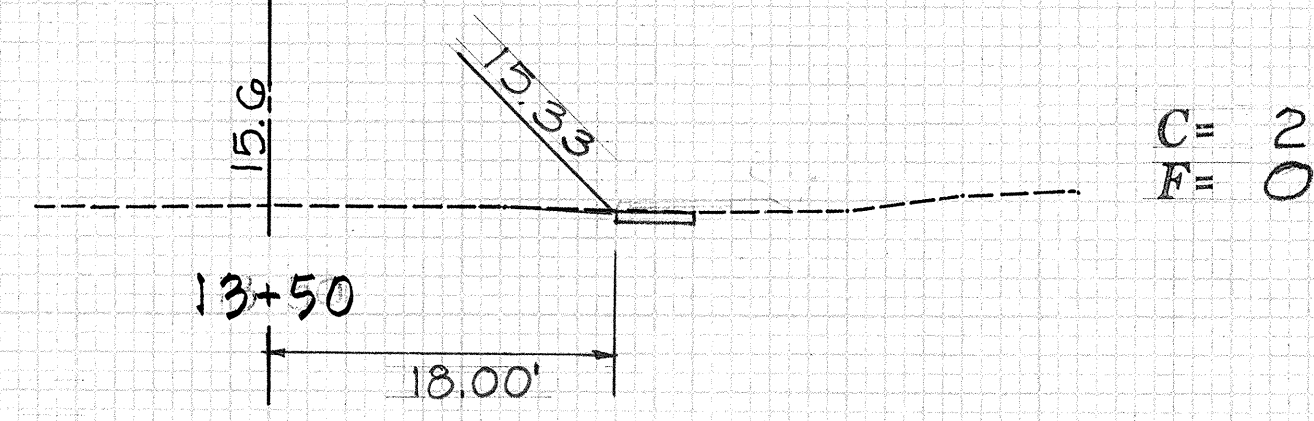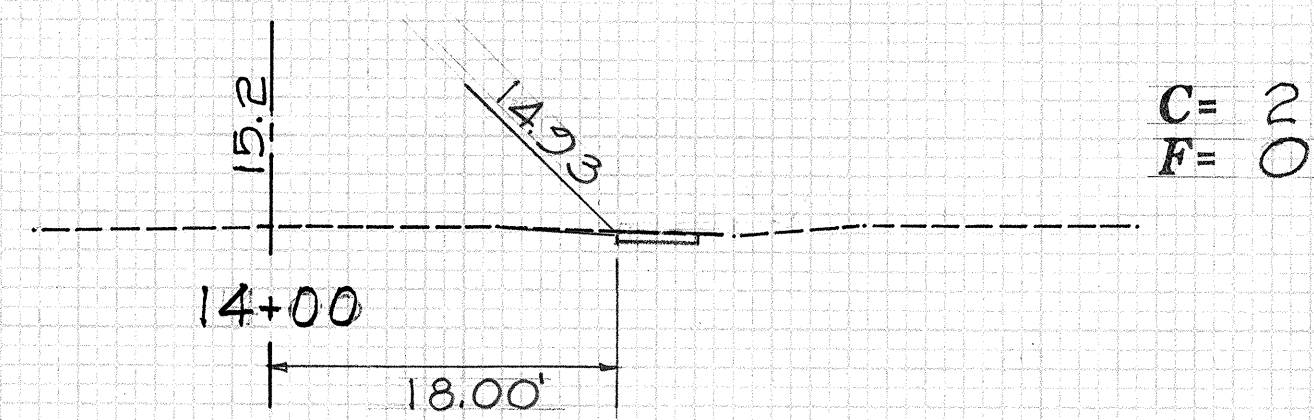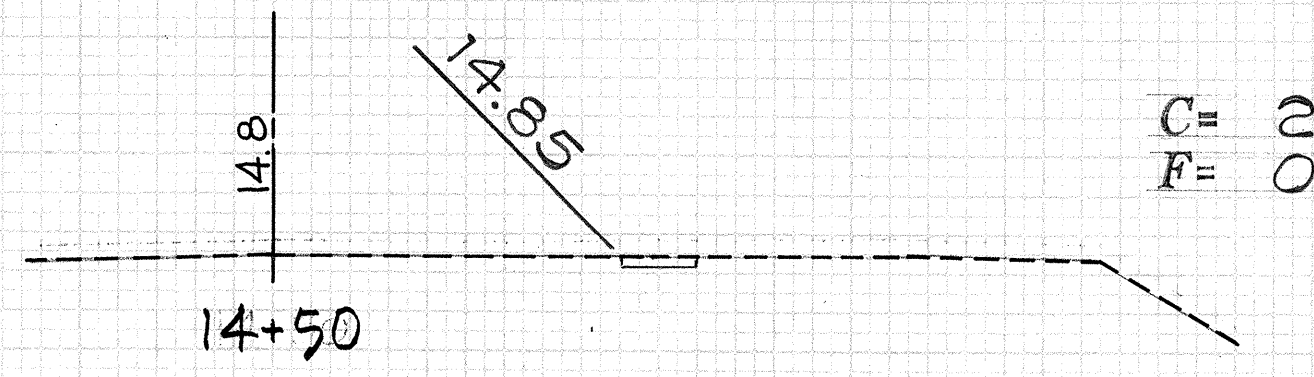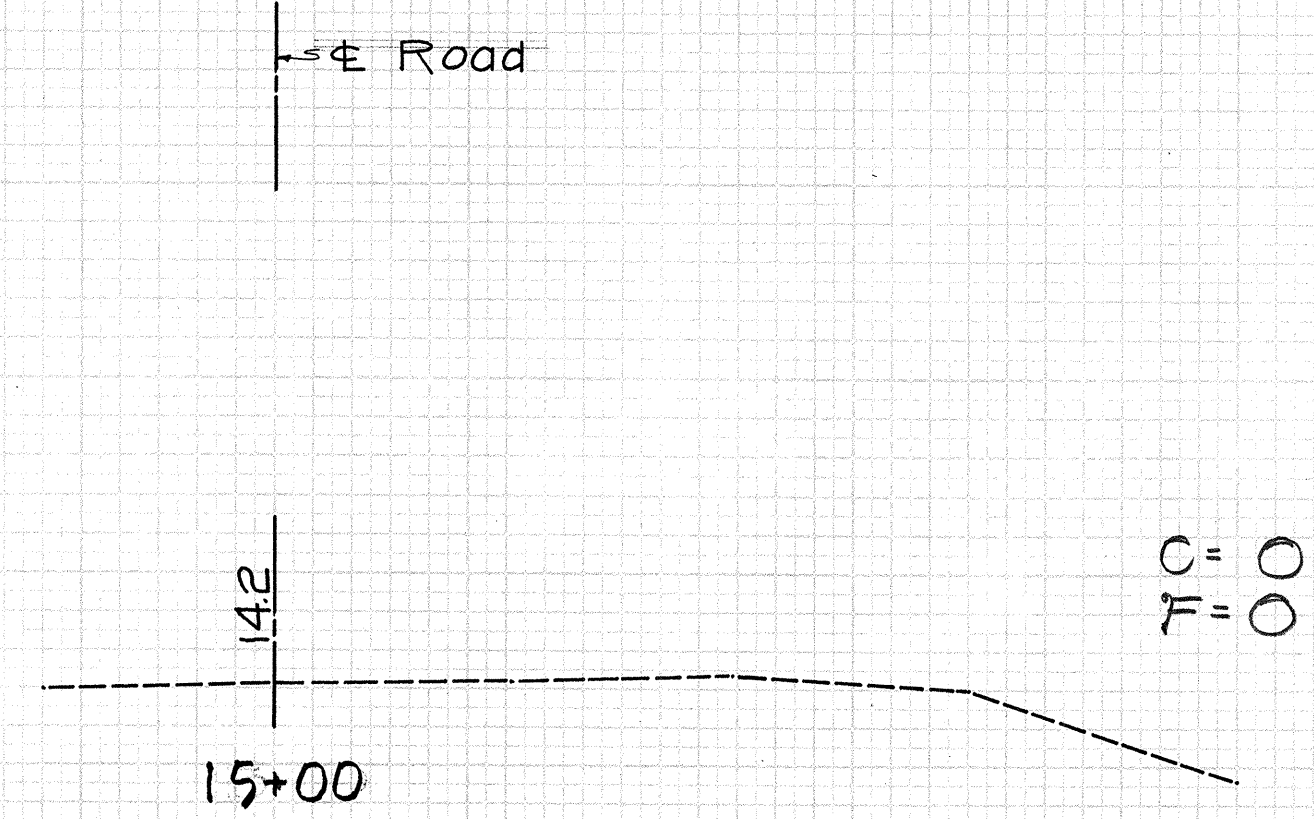

FINAL SURVEY
SURVEY
NOTE BOOK
NO.

ORIGINAL SURVEY
SURVEY
NOTE BOOK
NO.

Exc = 4
Emb = 0

Exc = 4
Emb = 0

Exc = 3
Emb = 0

Exc = 3
Emb = 0

Exc = 8
Emb = 0

Exc = 4
Emb = 0

Exc = 4
Emb = 0

Exc = 4
Emb = 0

Exc = 4
Emb = 0

Exc = 2
Emb = 0

Exc = 0
Emb = 12

Exc = 2
Emb = 8

Exc = 4
Emb = 0

Exc = 5
Emb = 0

Exc = 6
Emb = 0


Exc = 10
Emb = 0

Scale: 1"=10' Bothways


DIST. NO.	STATE	PROJ. NO.	FISCAL YEAR	SHEET NO.	TOTAL SHEETS
HAWAII	HAW.	BD69-464	197	18	23

FINAL SURVEY PLANT
NOTE BOOK
NO.


ORIGINAL SURVEY PLANT
NOTE BOOK
NO.

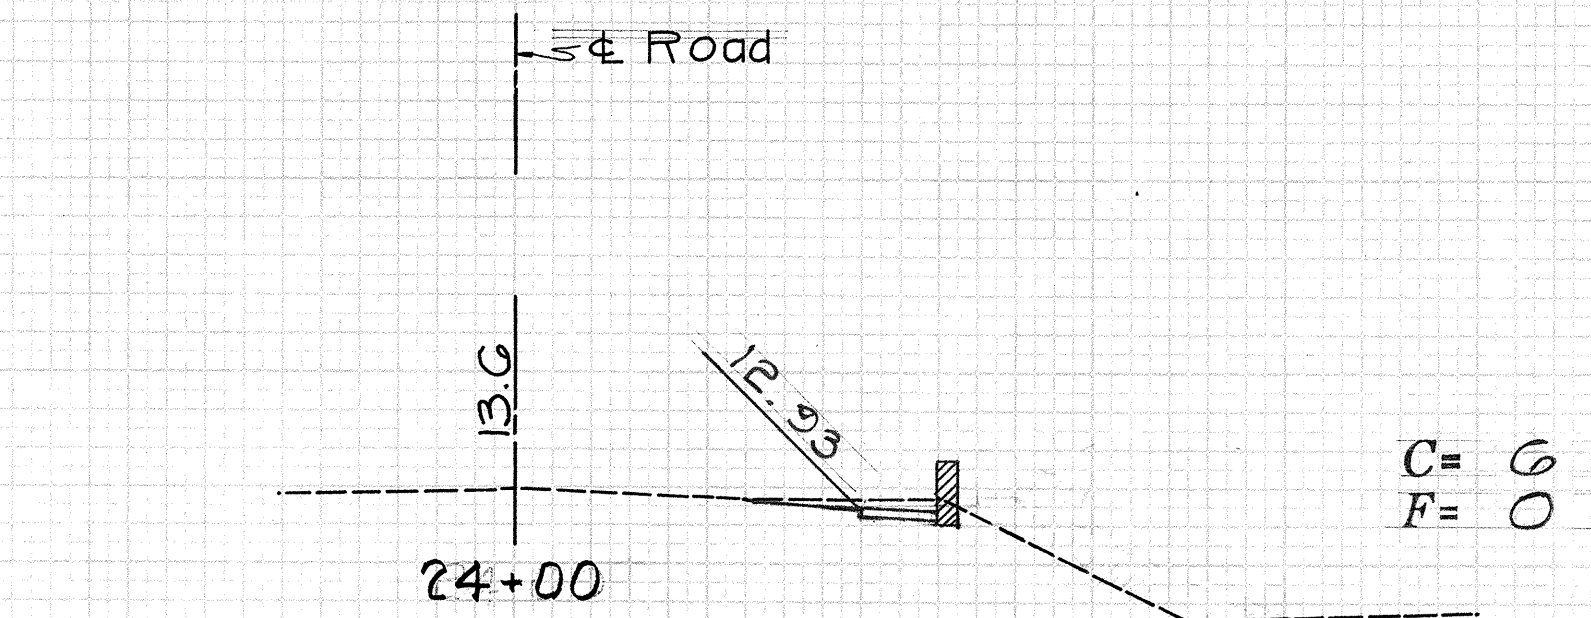


Exc = 6
Emb = 0

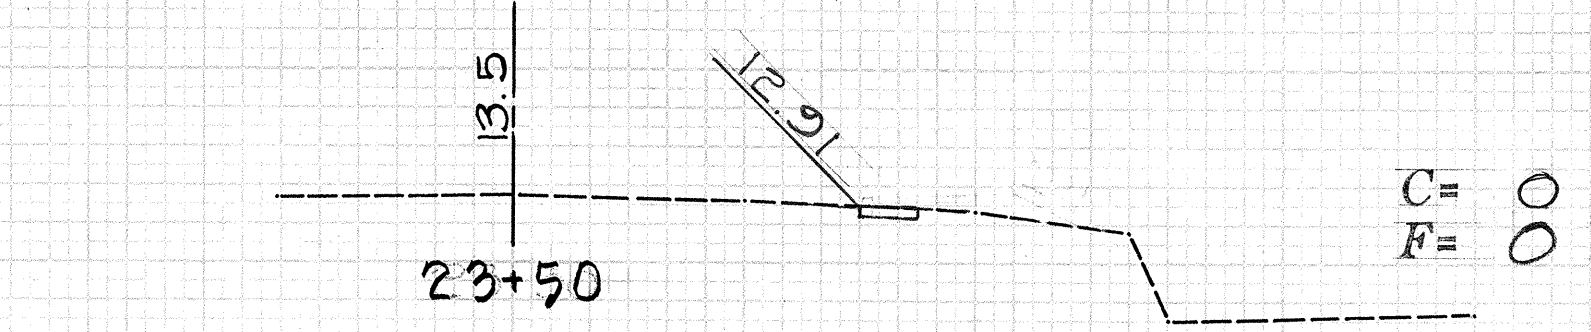


Exc = 3
Emb = 0

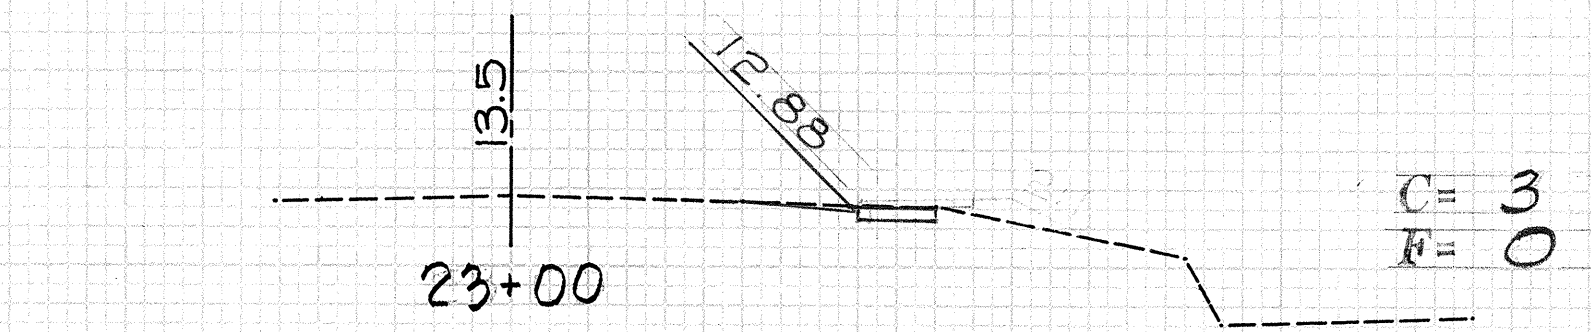


Exc = 6
Emb = 0

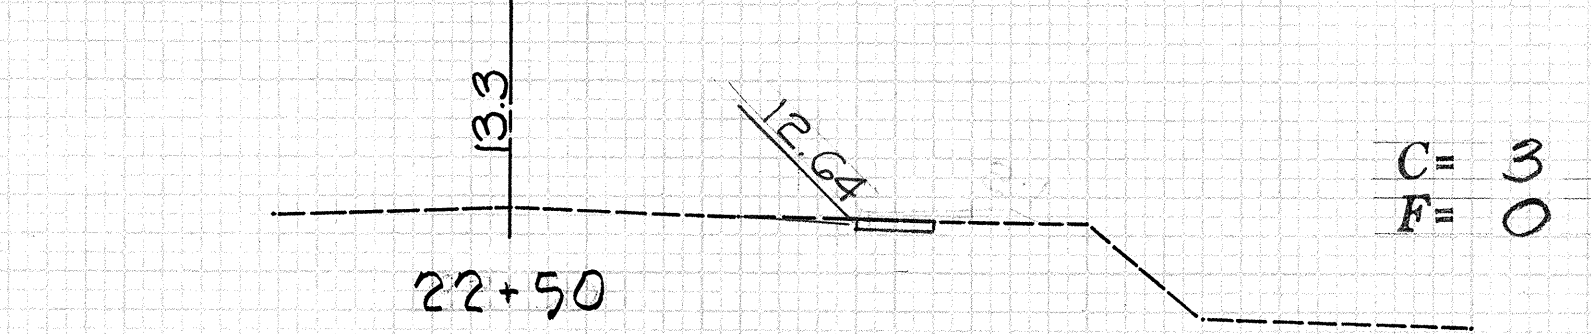


Exc = 5
Emb = 0

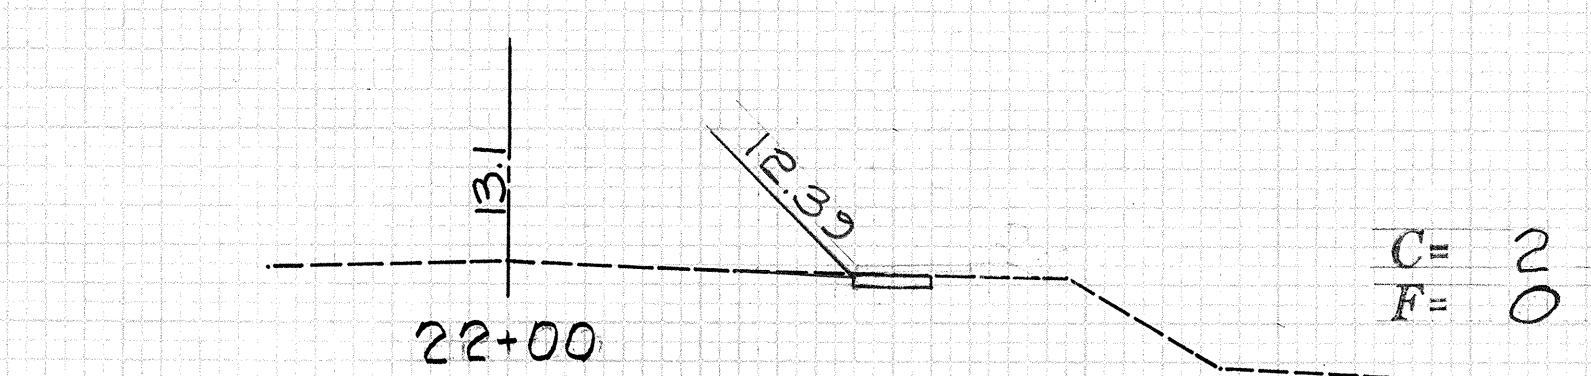


Exc = 4
Emb = 0

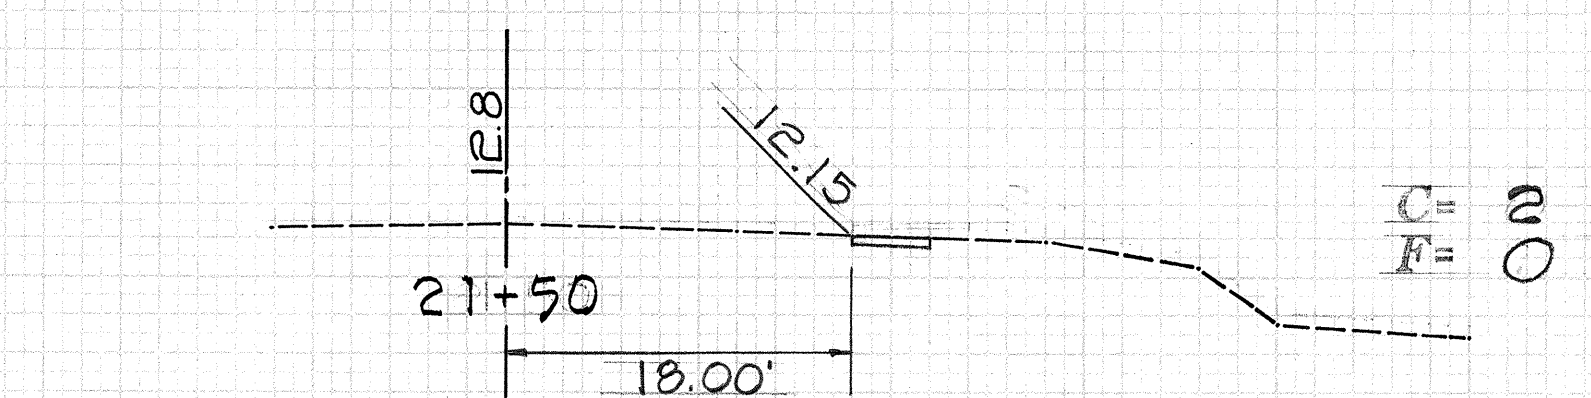


Exc = 2
Emb = 4

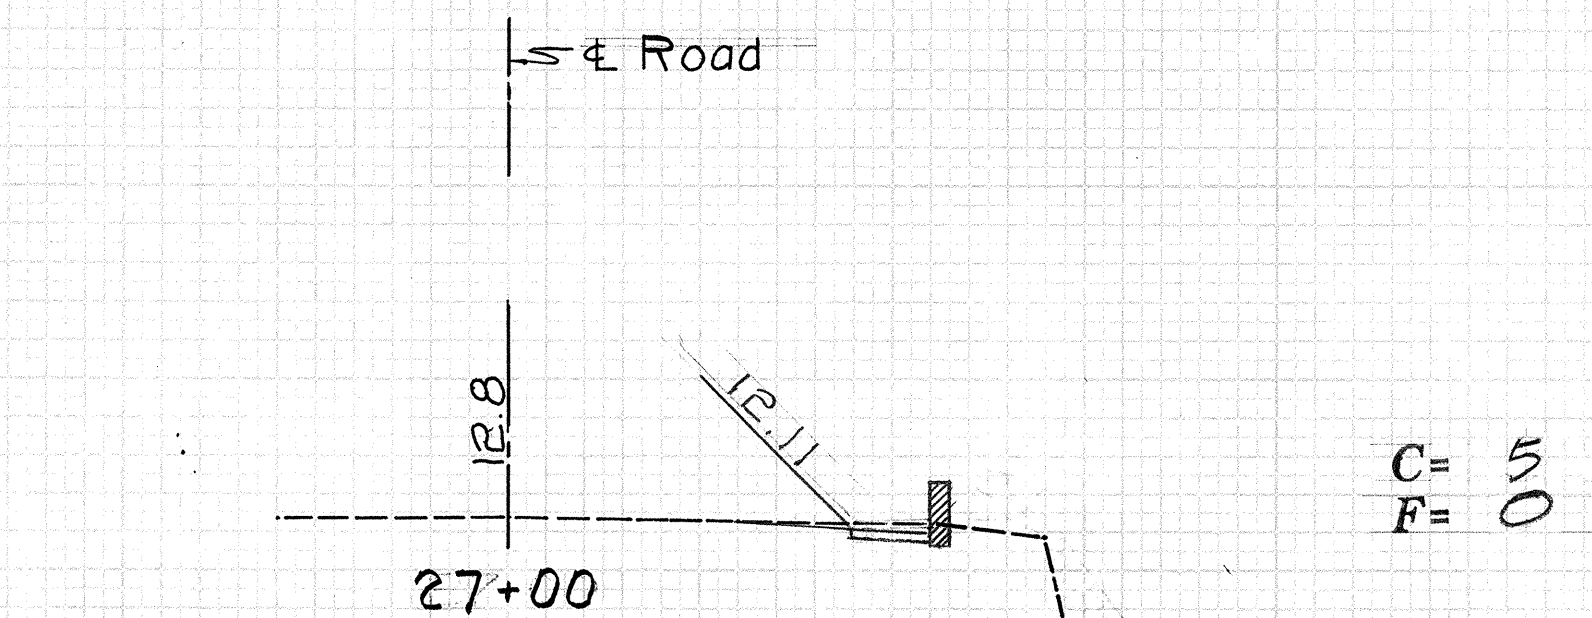


Exc = 6
Emb = 0

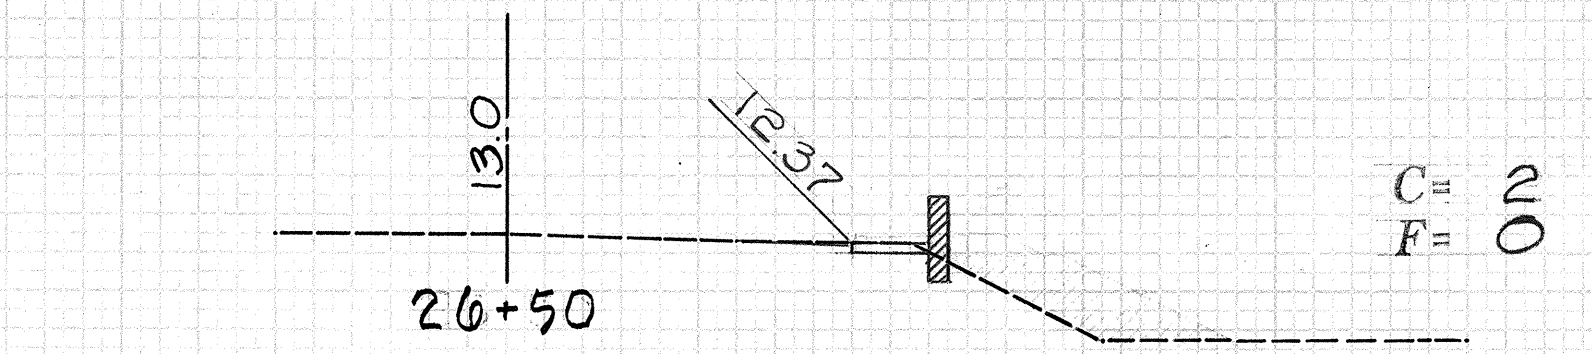


Exc = 6
Emb = 0

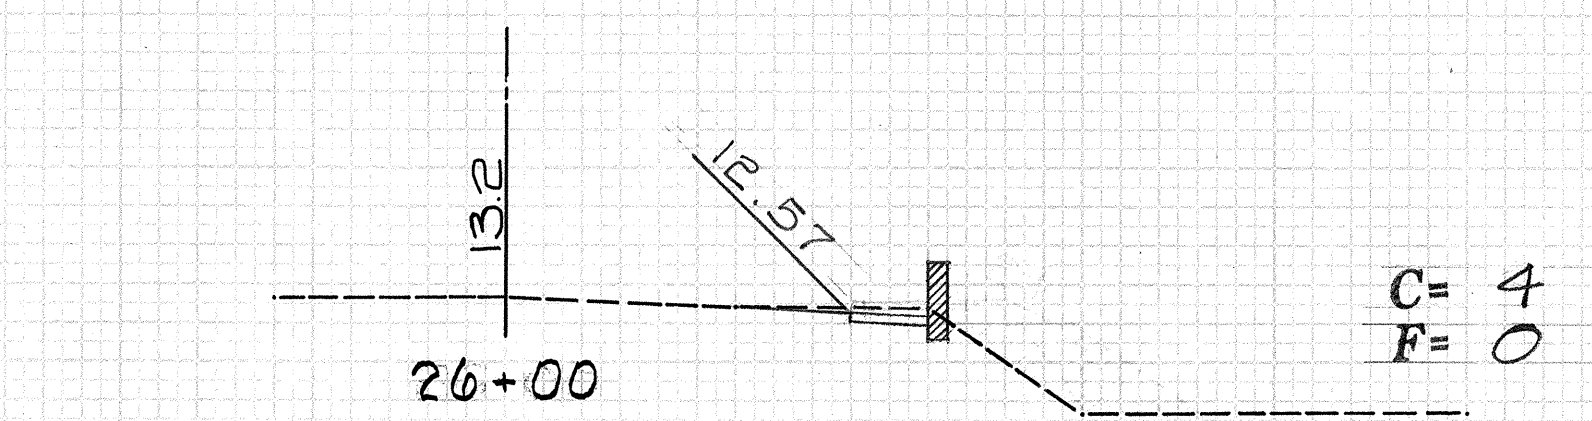


Exc = 6
Emb = 0

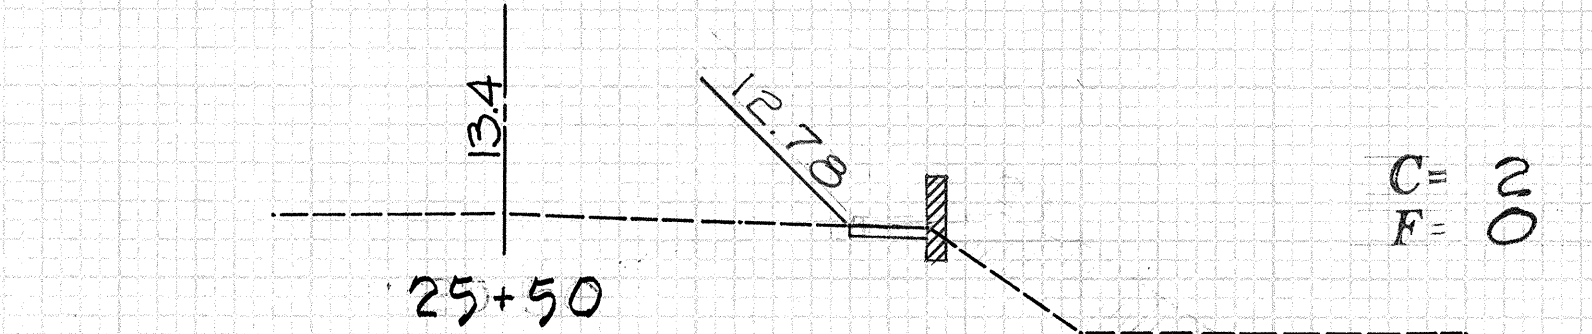


Exc = 6
Emb = 0

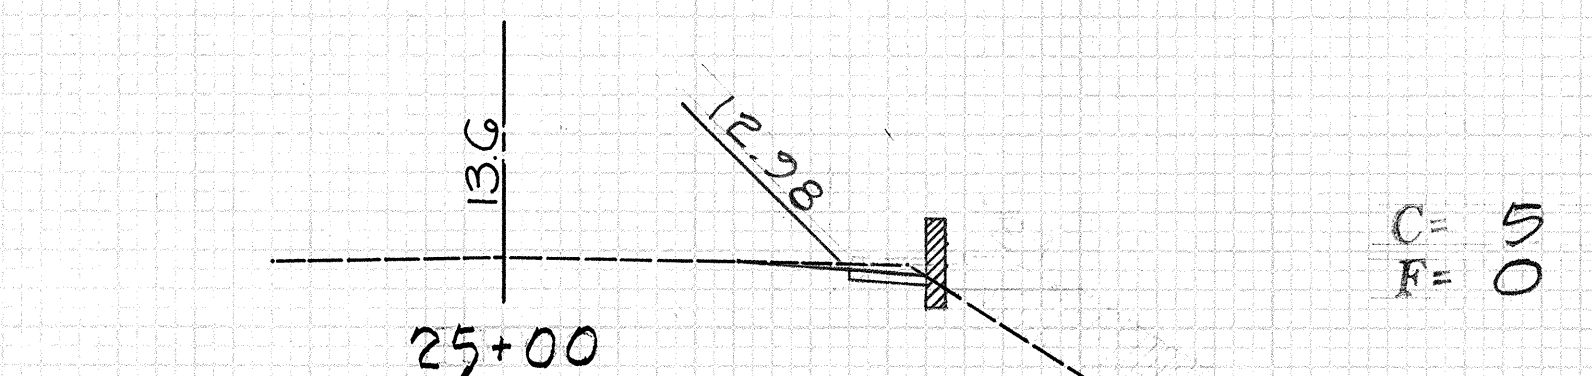


Exc = 6
Emb = 0

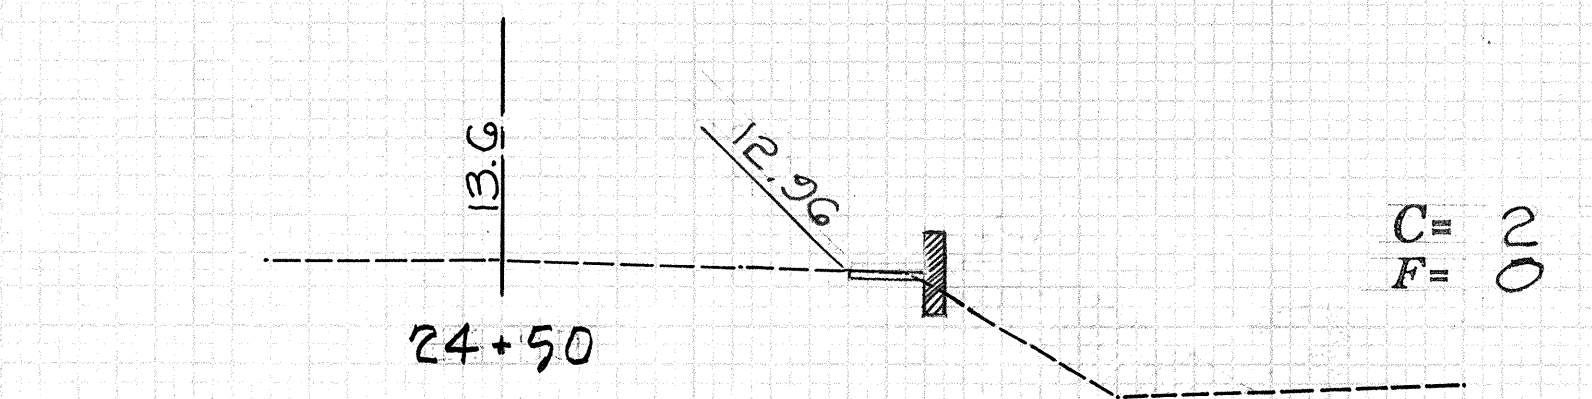


Exc = 7
Emb = 0

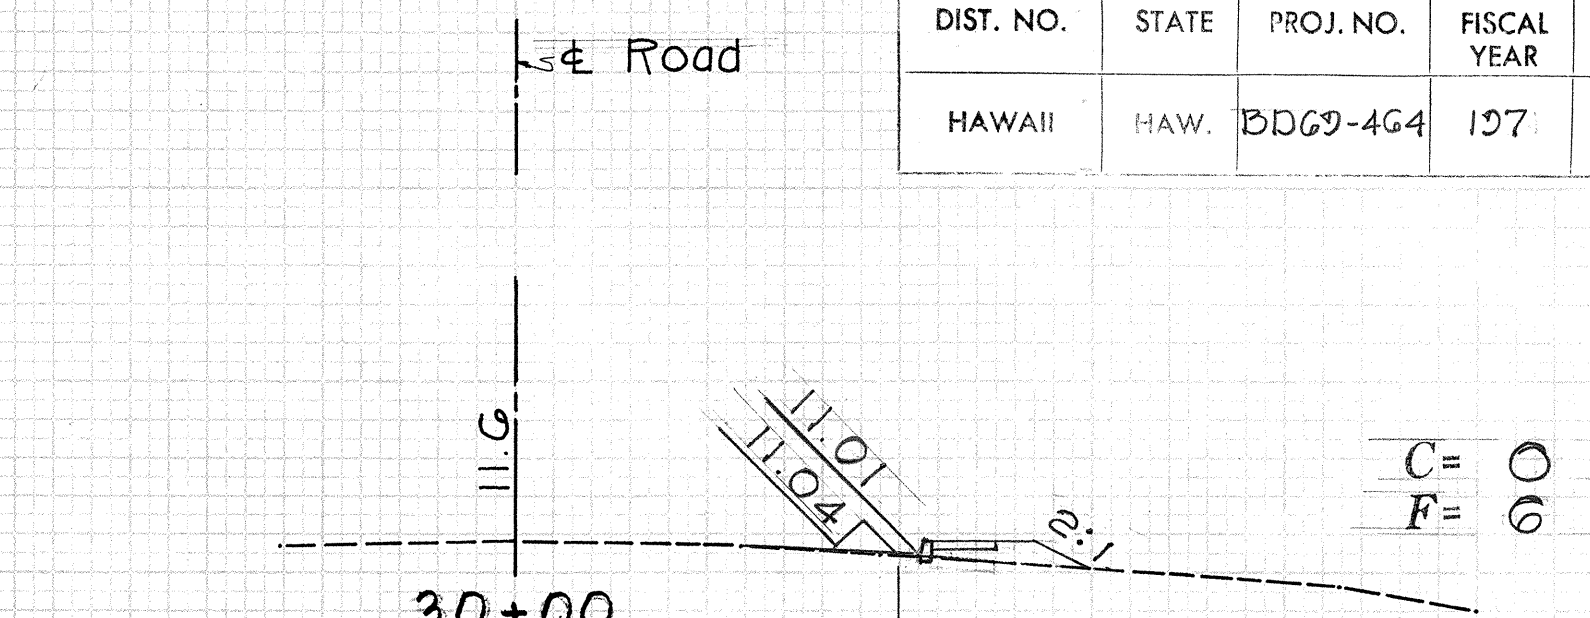


Exc = 0
Emb = 10

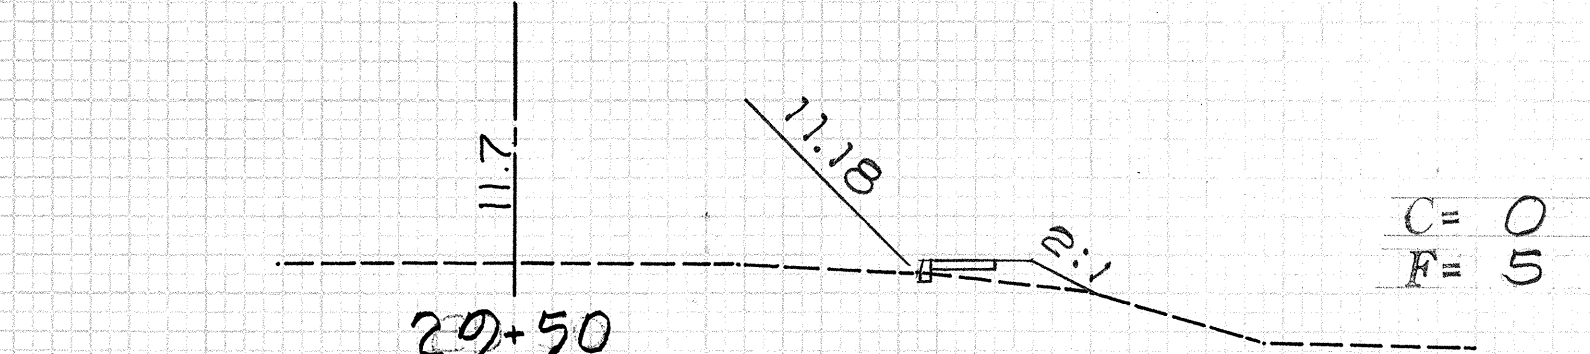


Exc = 0
Emb = 10

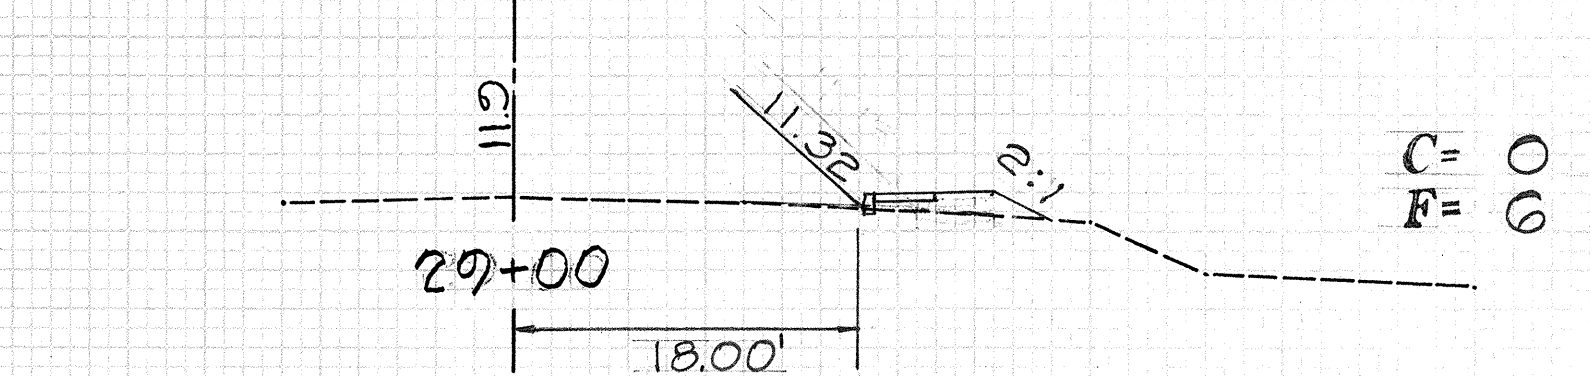


Exc = 2
Emb = 6

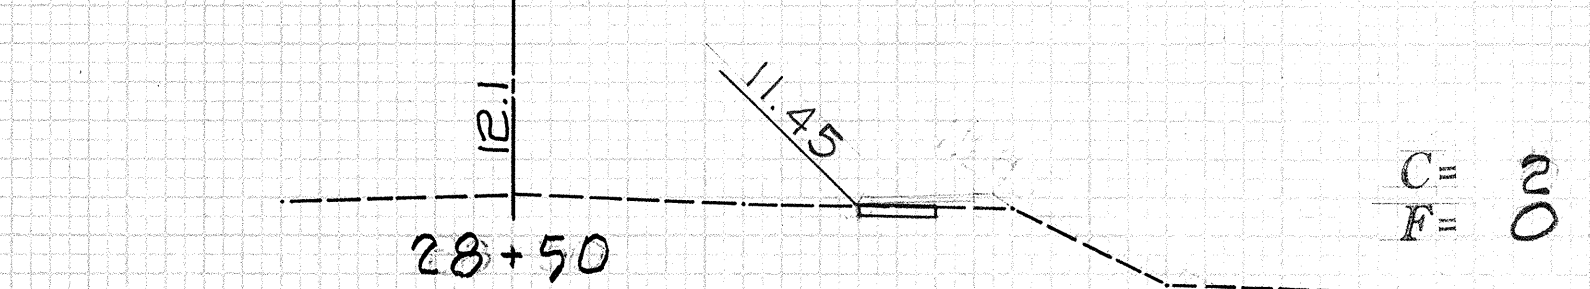

Exc = 4
Emb = 0






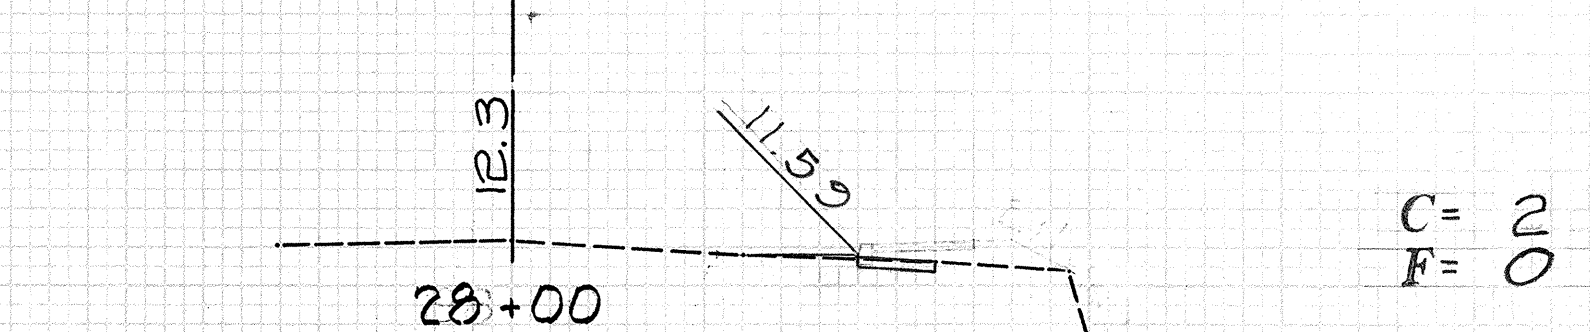


Exc = 5
Emb = 0











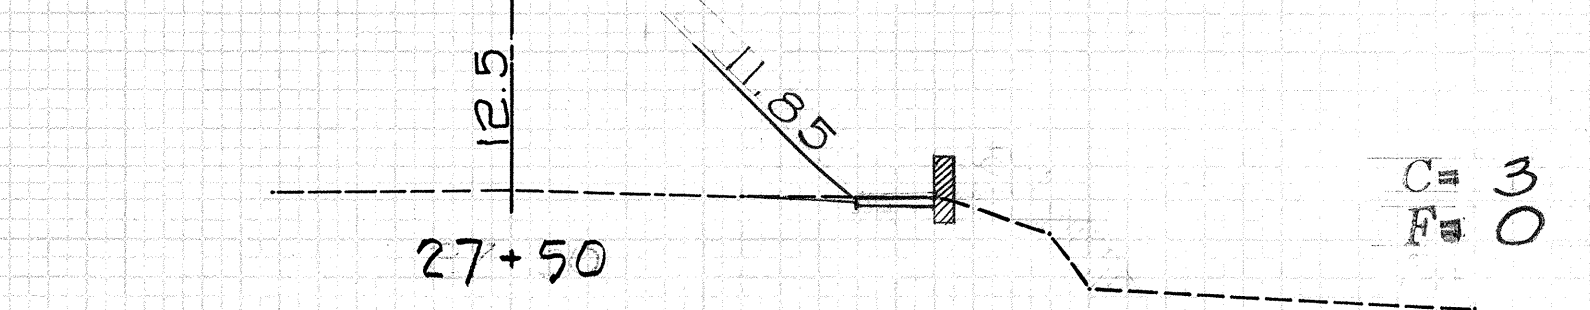


Exc = 7
Emb = 0




Scale: 1"=10' Bothways

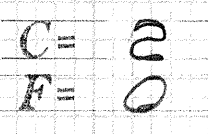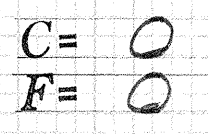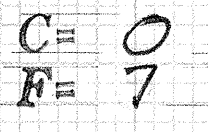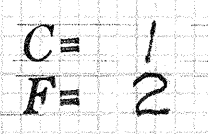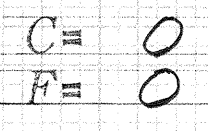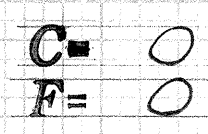

Exc = 2
Emb = 6

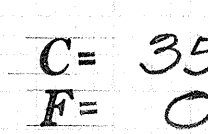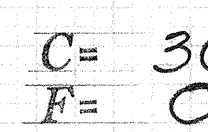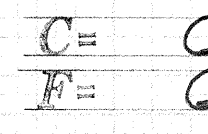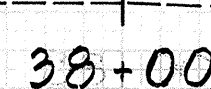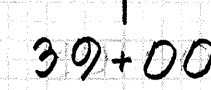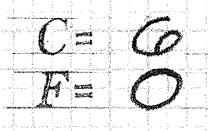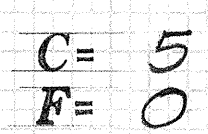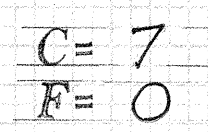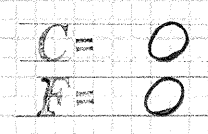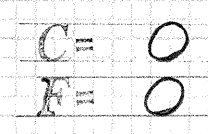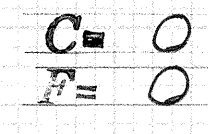

DIST. NO.	STATE	PROJ. NO.	FISCAL YEAR	SHEET NO.	TOTAL SHEETS
HAWAII	HAW.	BDCG-464	1972	20	23




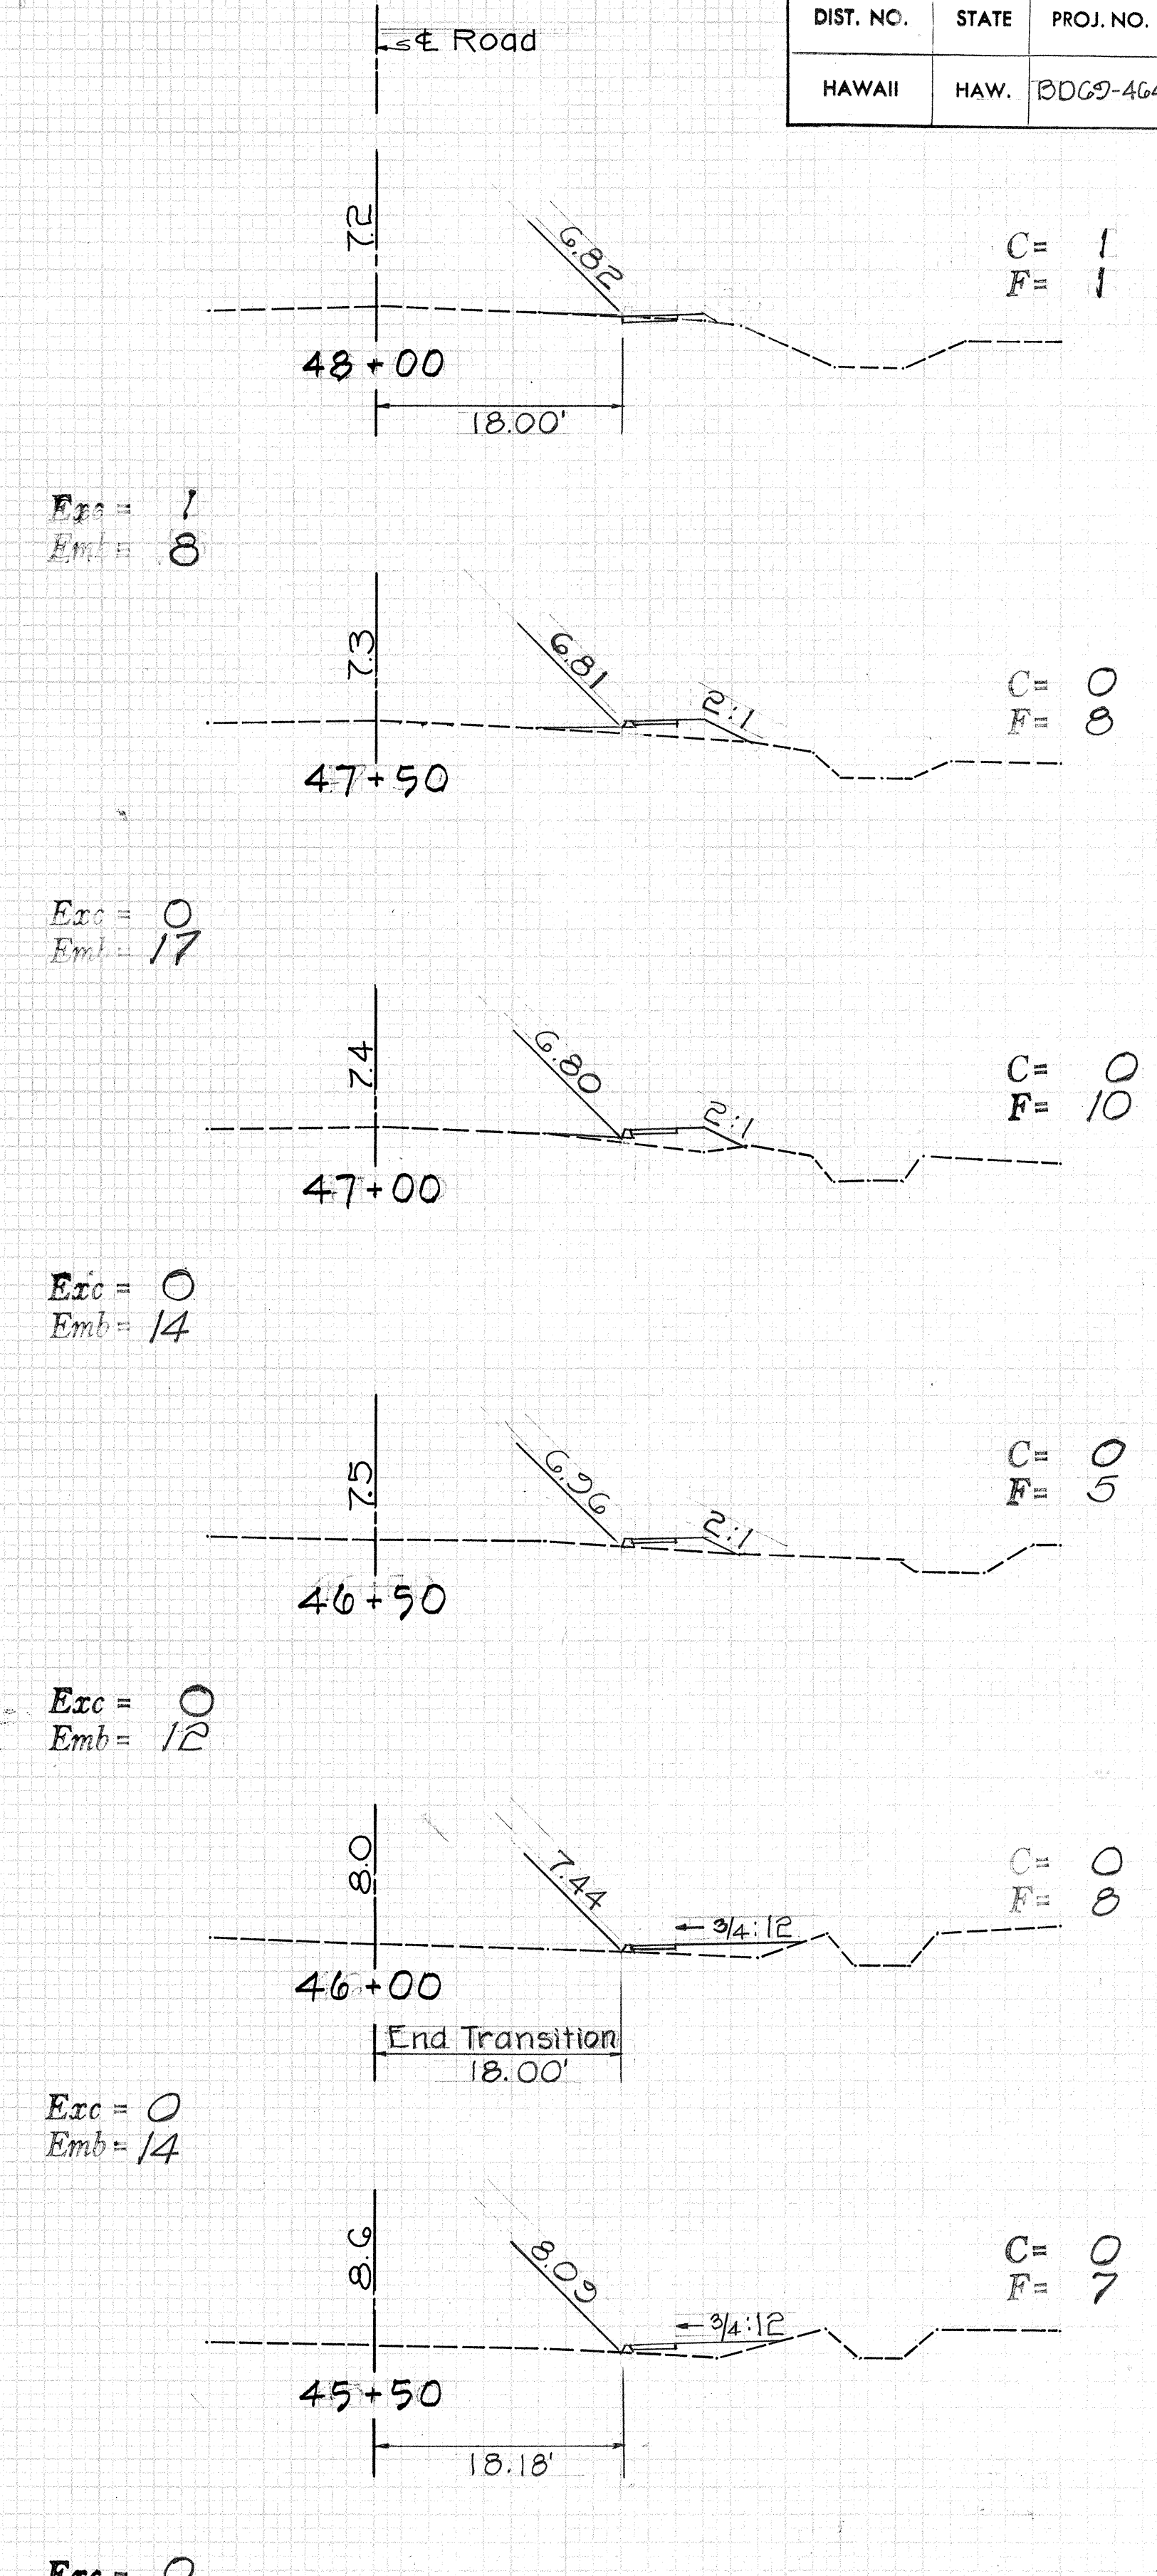
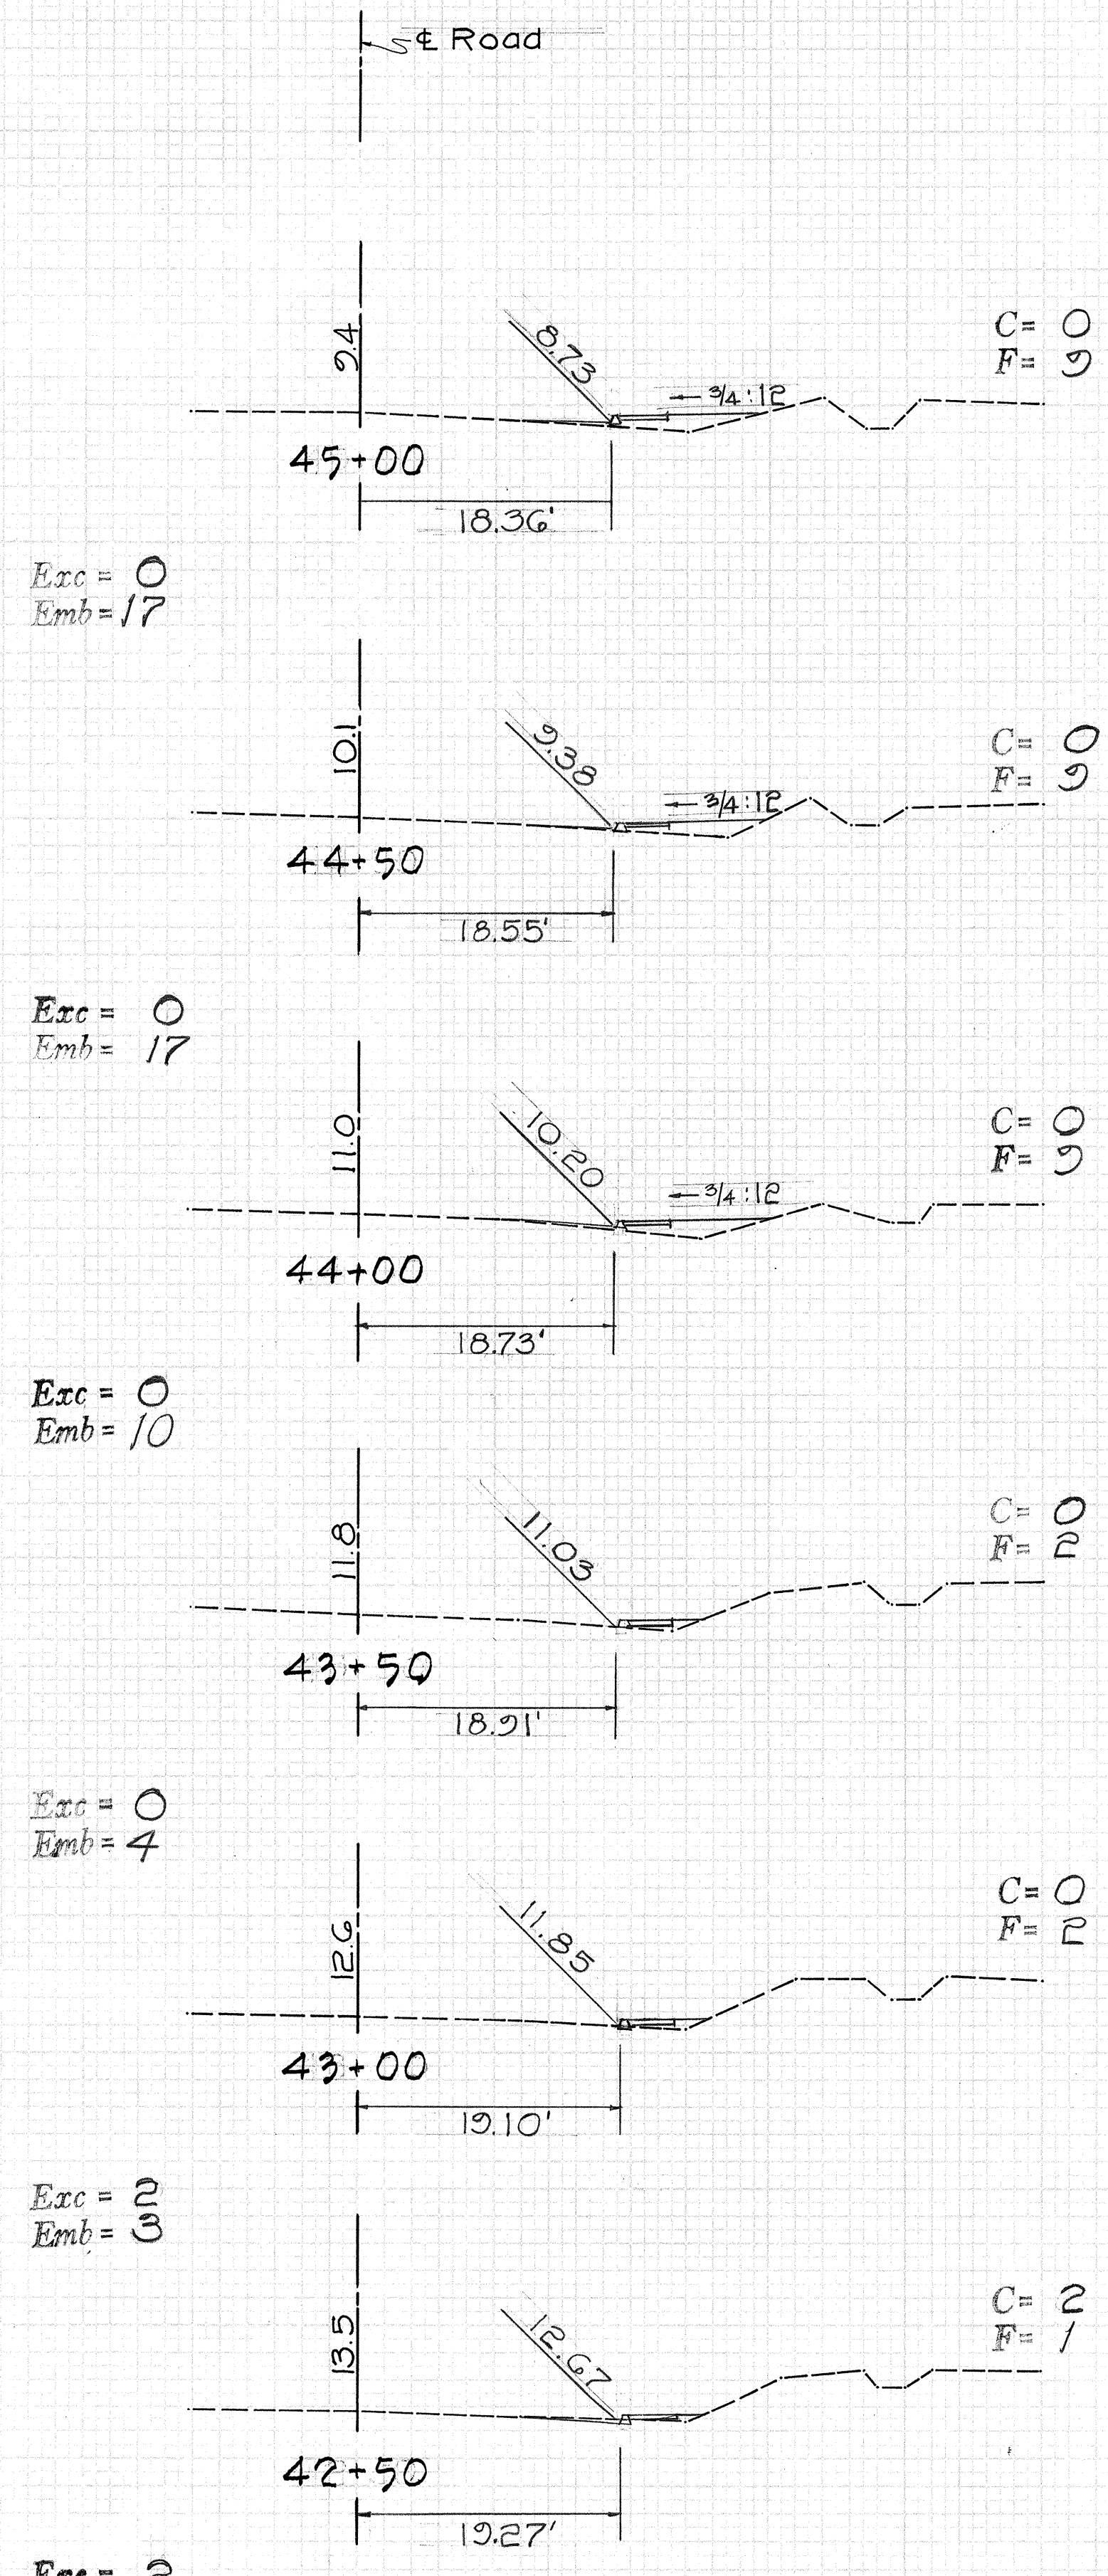
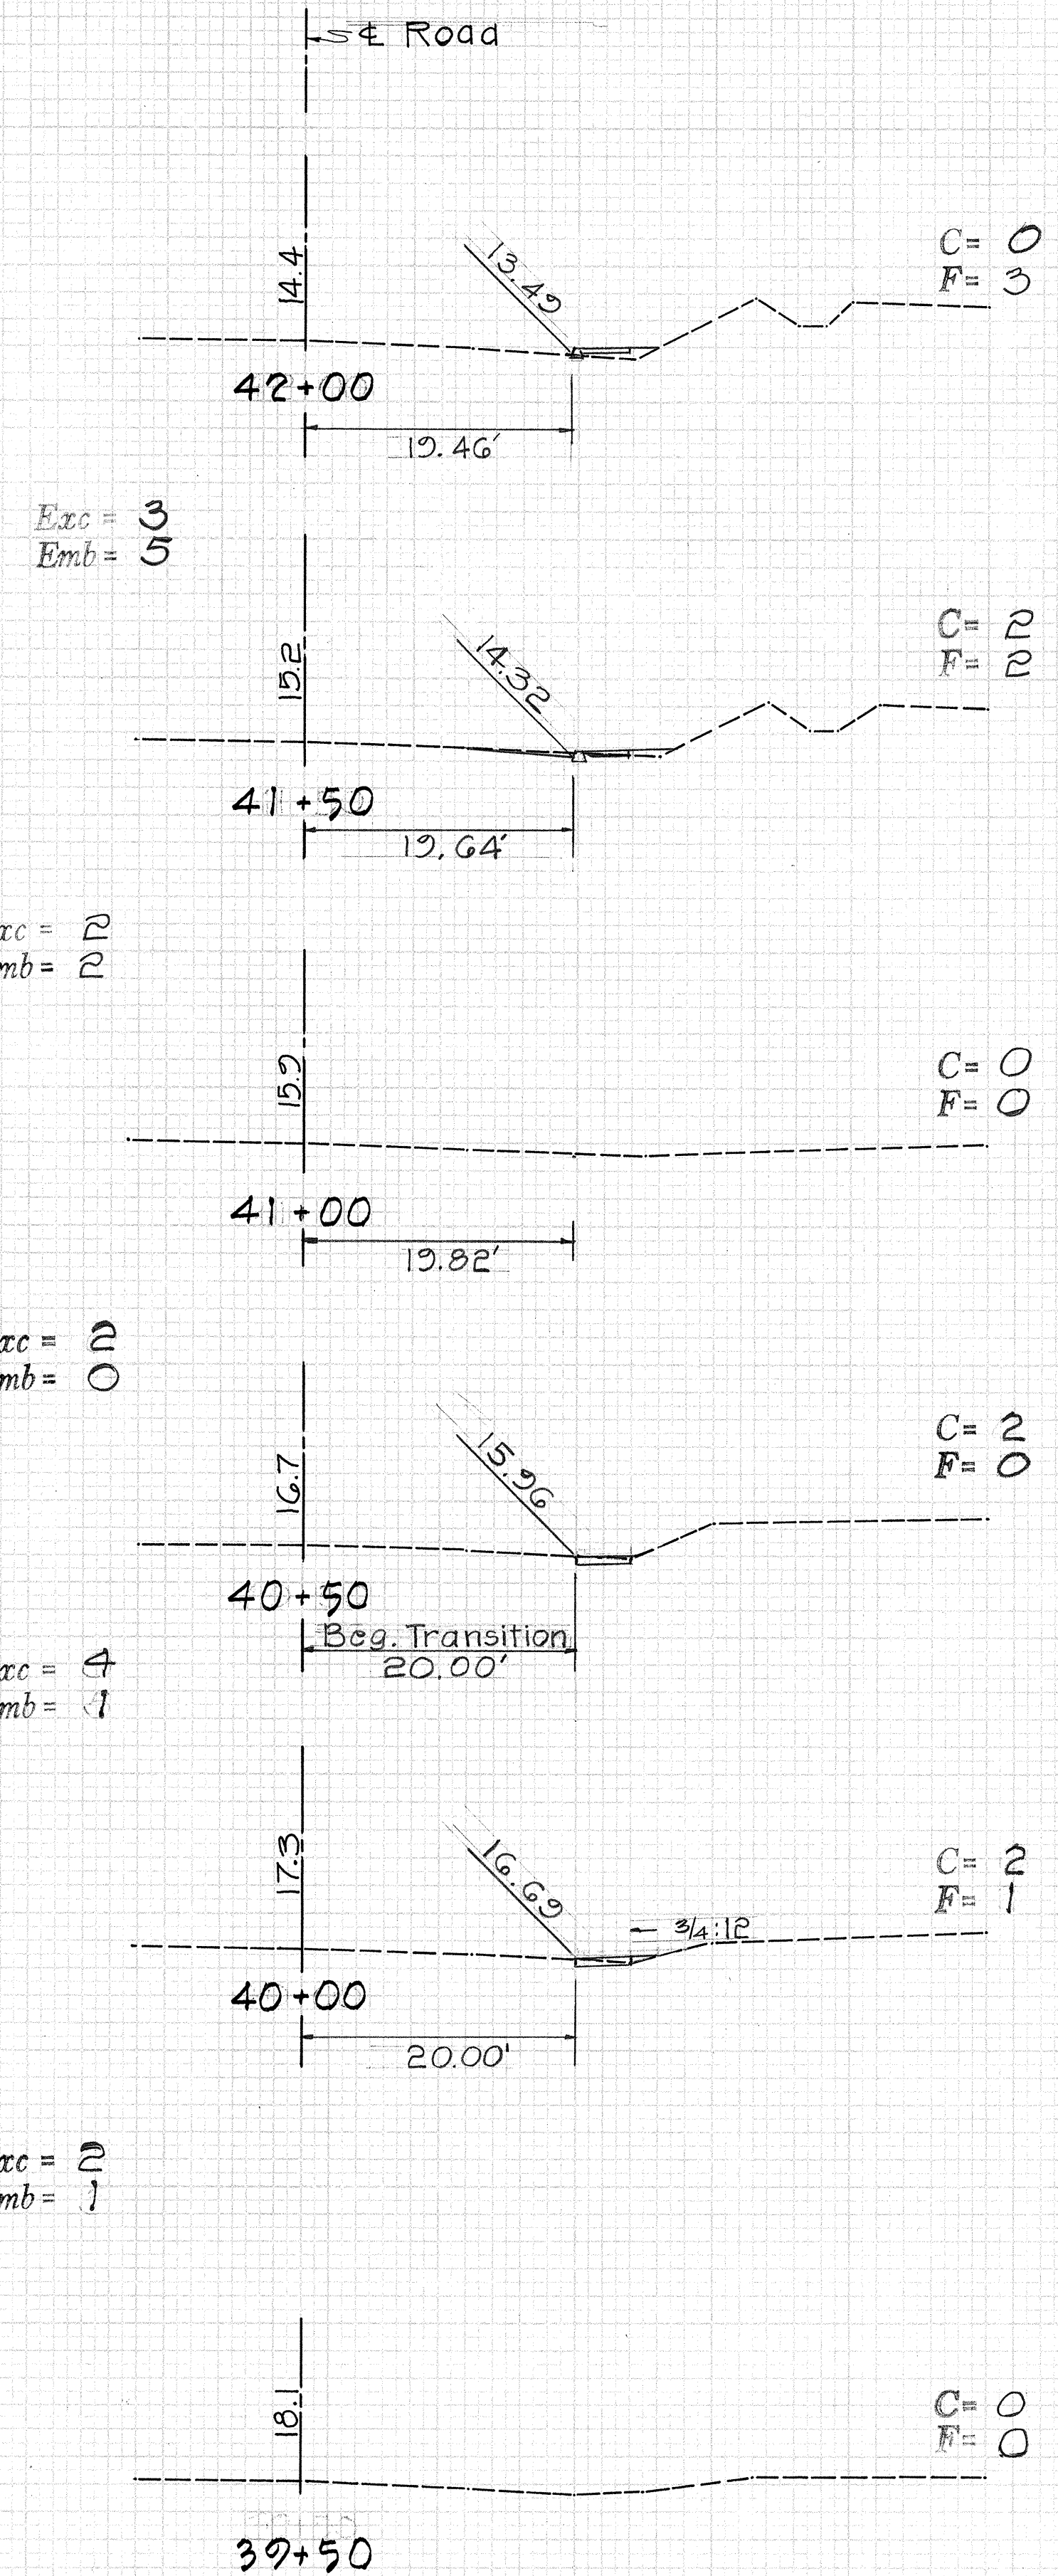


Scale: 1"=10' Bothways













DIST. NO.	STATE	PROJ. NO.	FISCAL YEAR	SHEET NO.	TOTAL SHEETS
HAWAII	HAW.	BD65-464	1972	21	23

FINAL	SURVEY	DATE
BOOK	PLANNED	
NO.	NO.	


ORIGINAL	SURVEY	DATE
BOOK	PLANNED	
NO.	NO.	

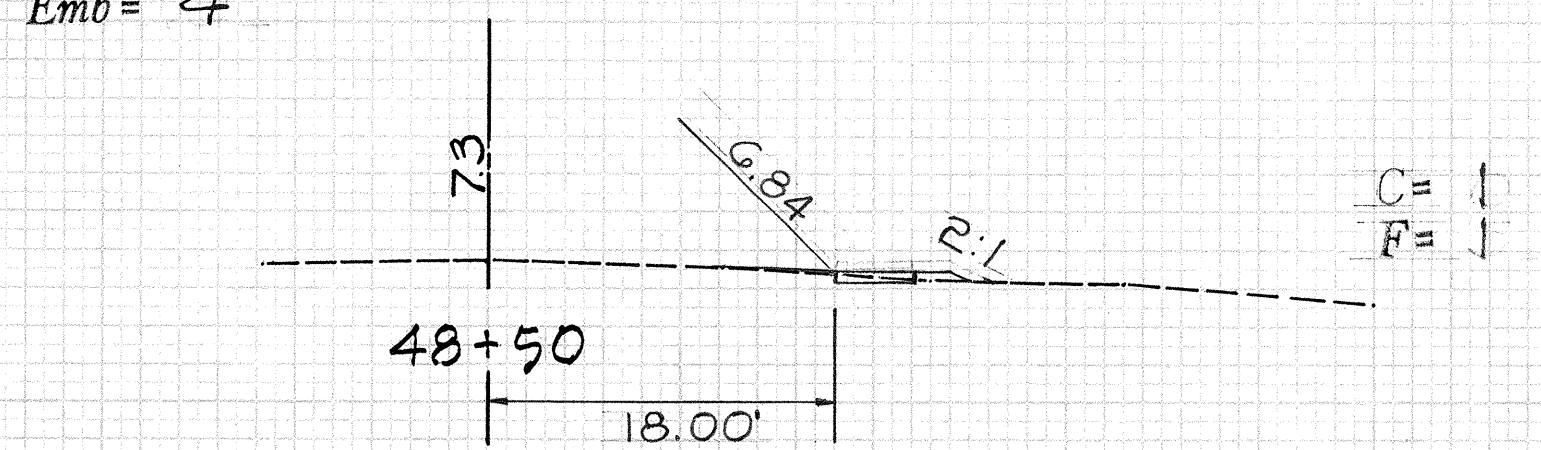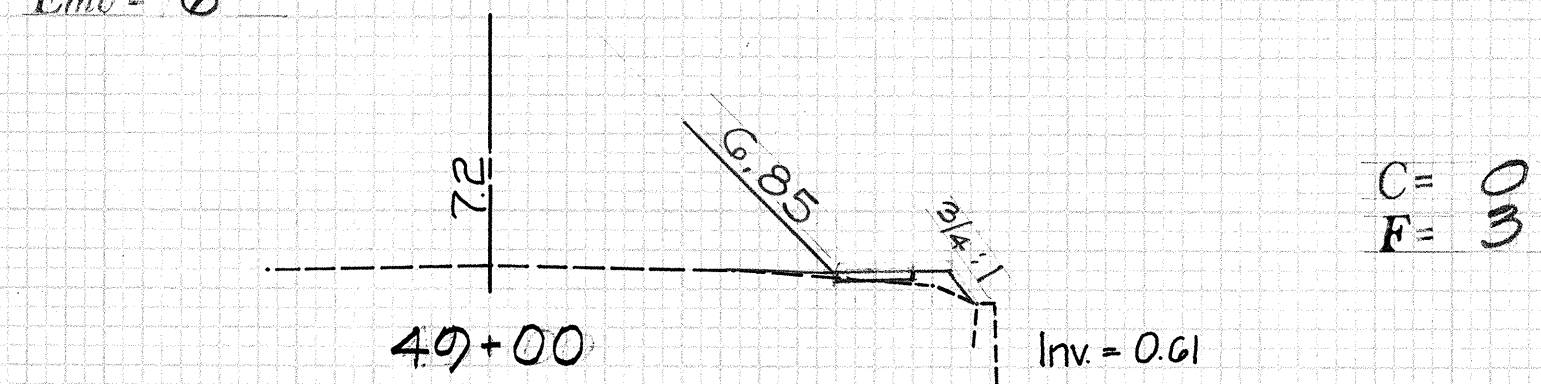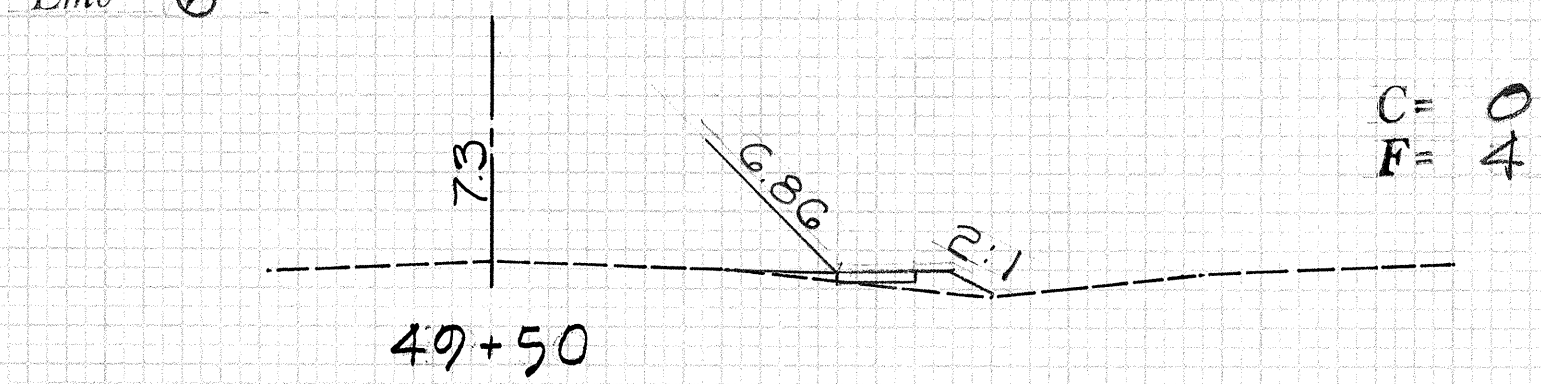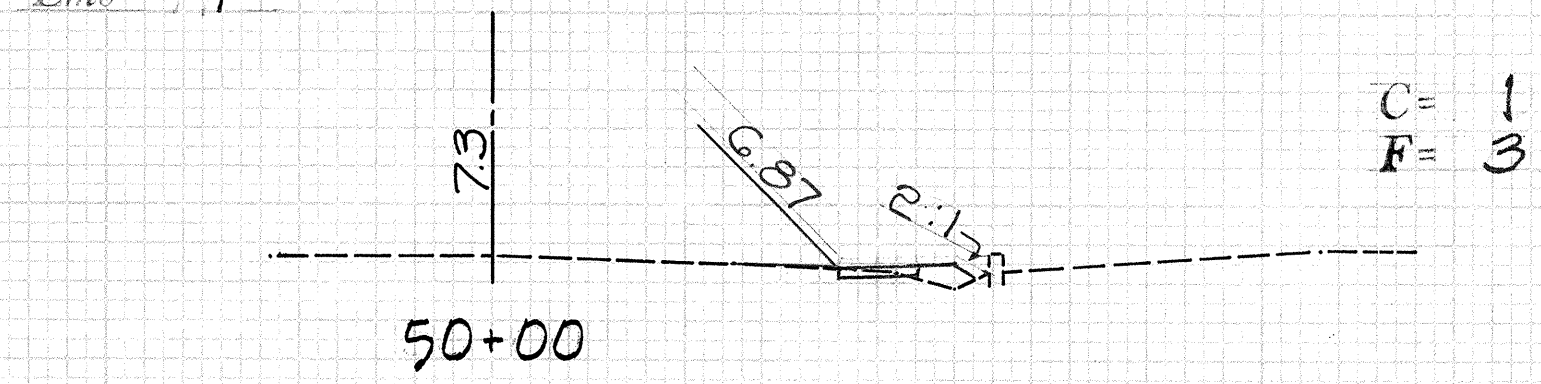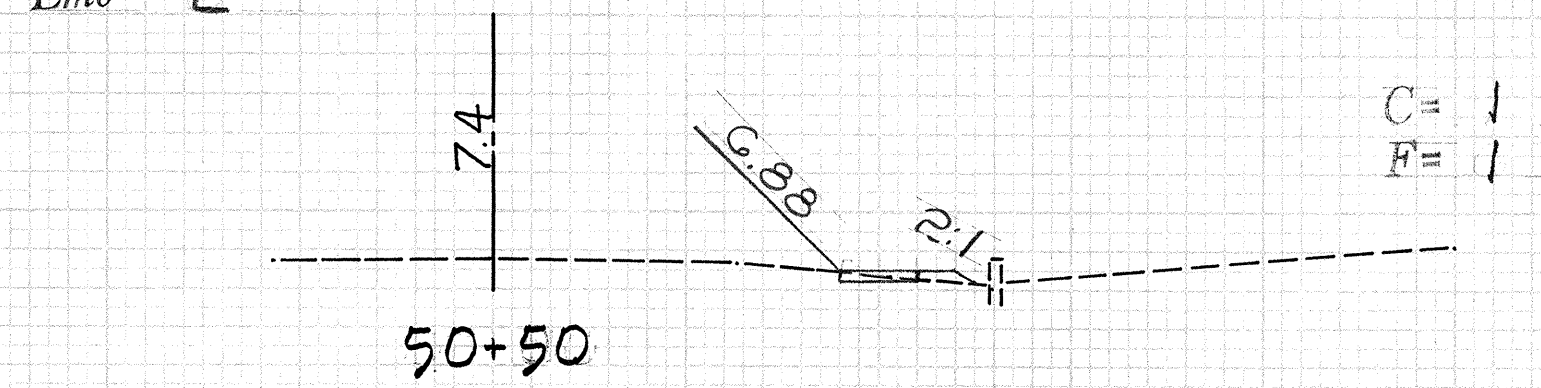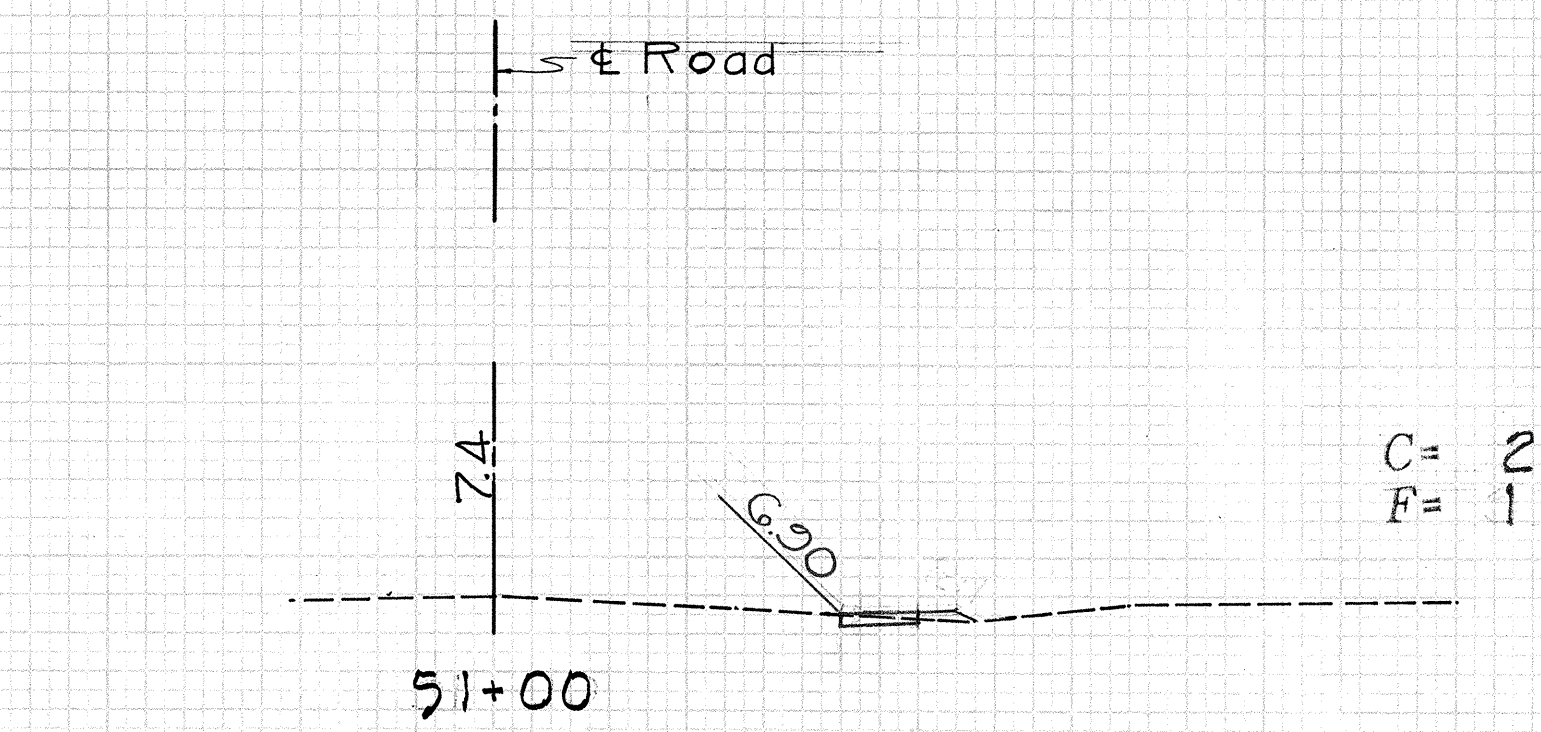

Scale: 1"=10' Bothways

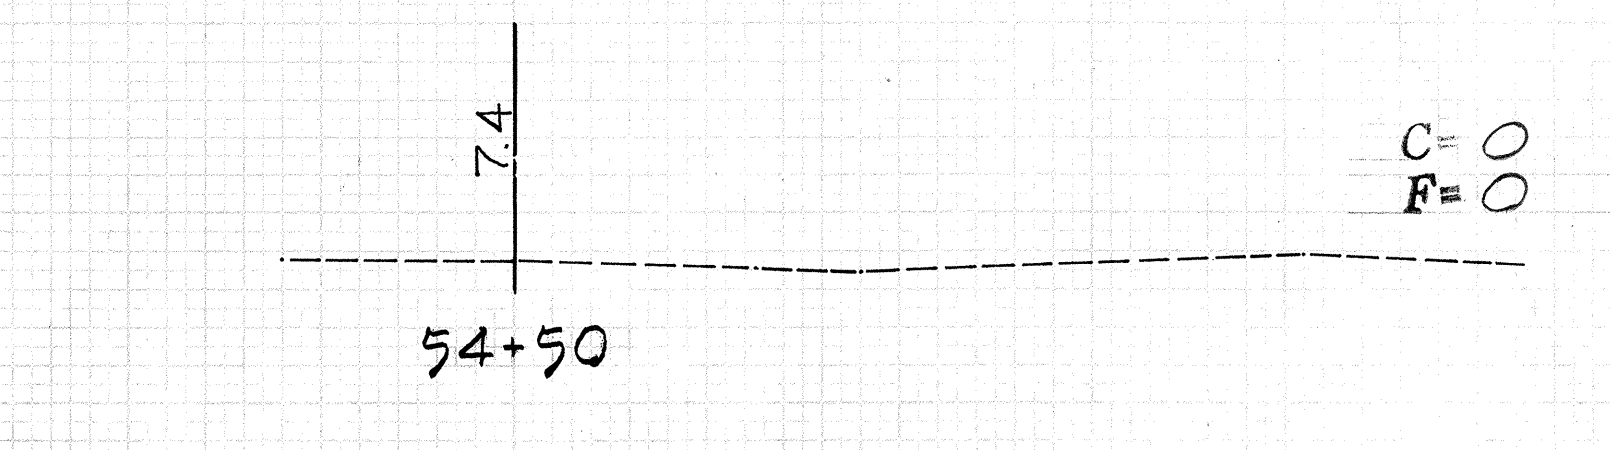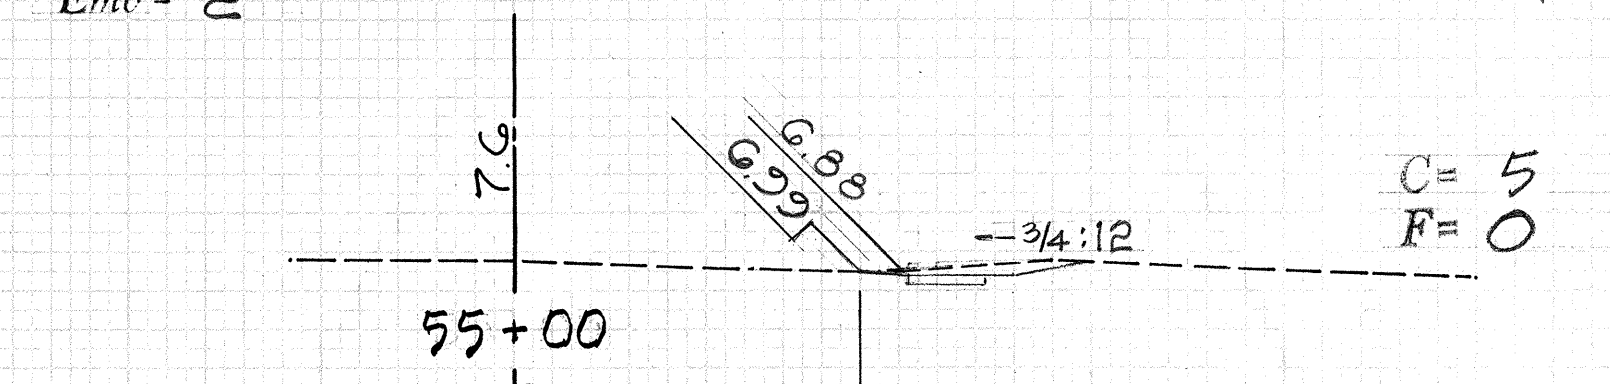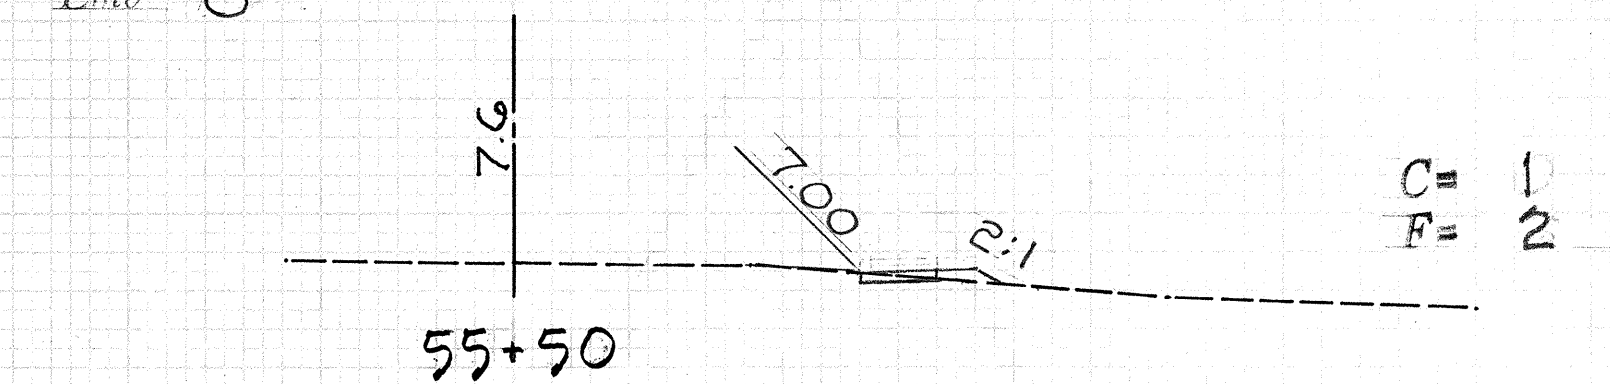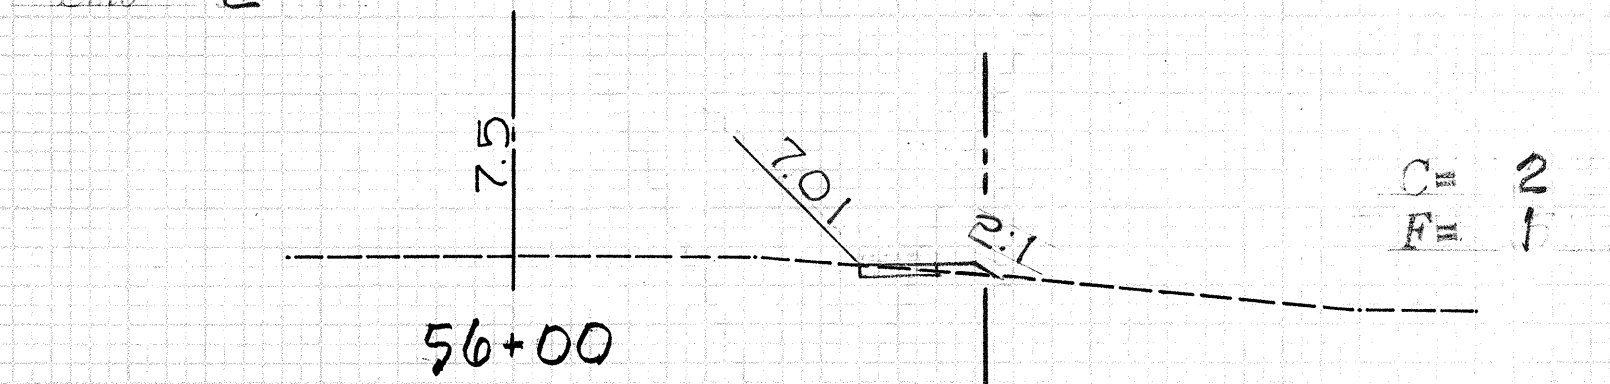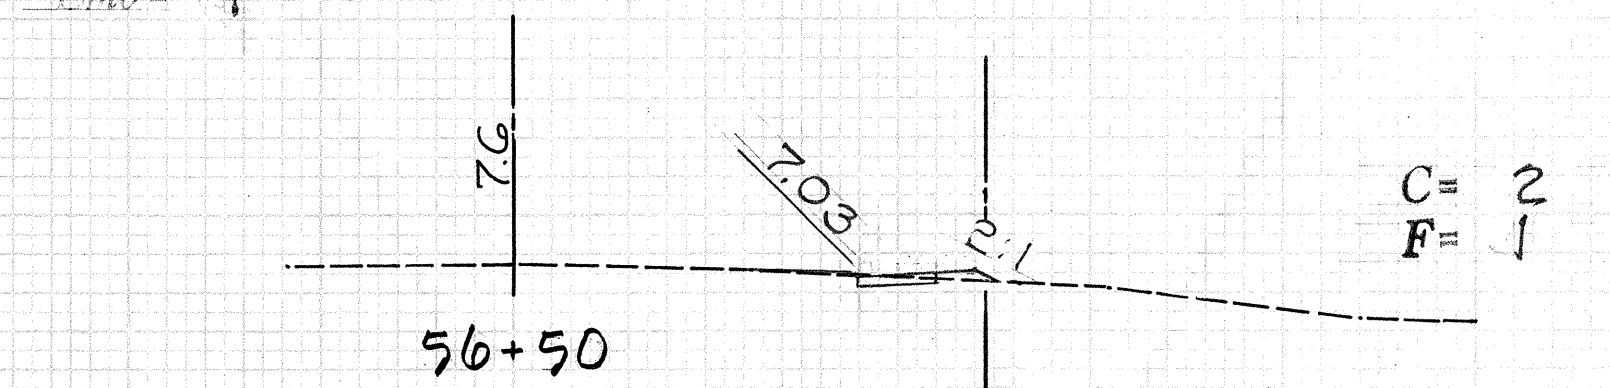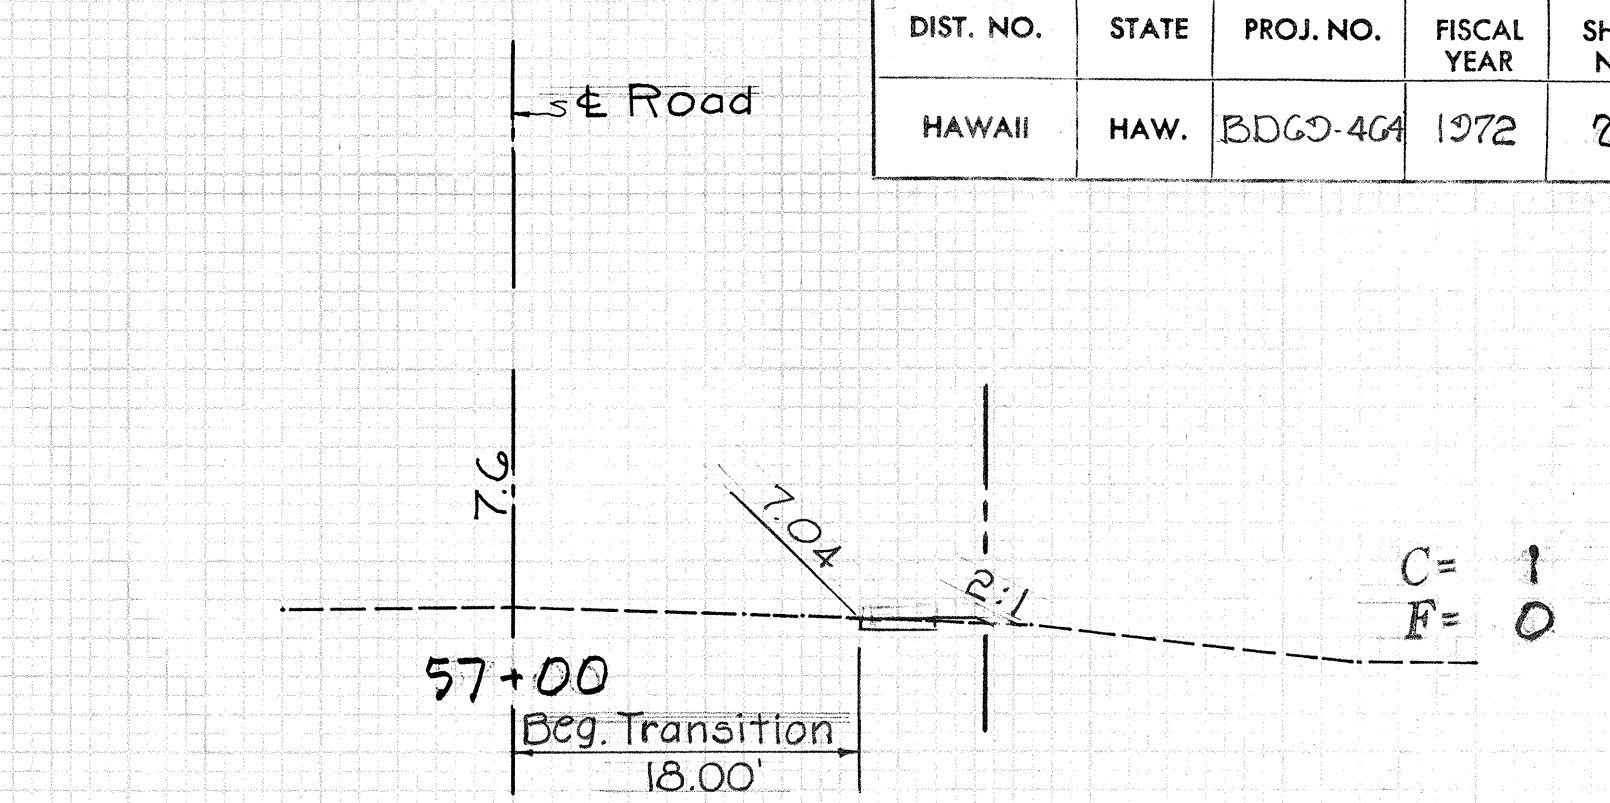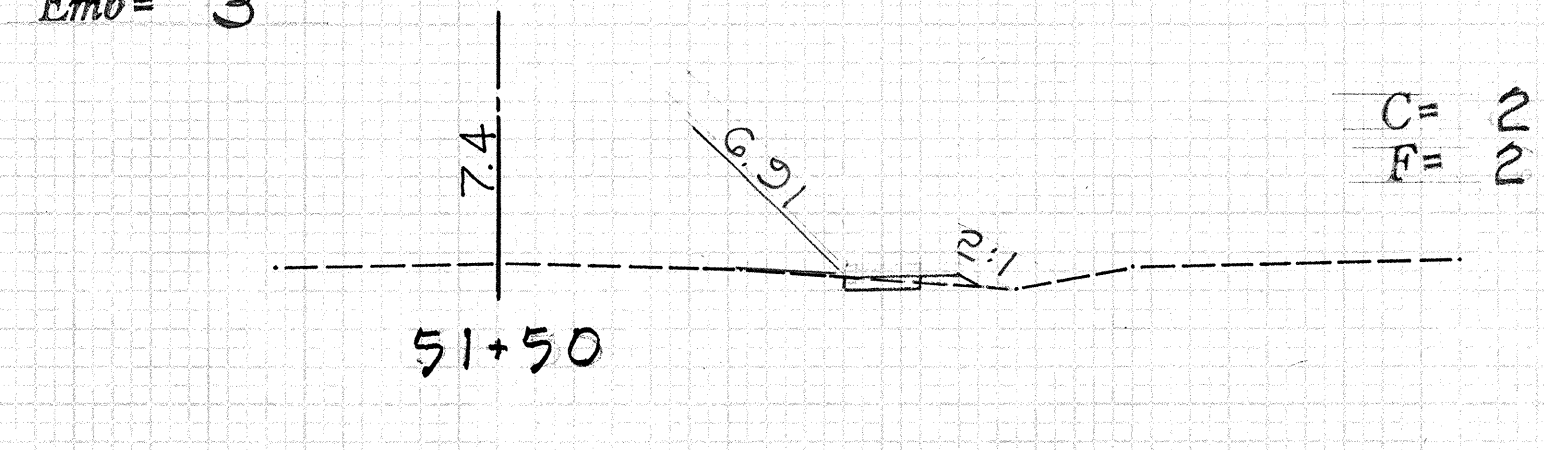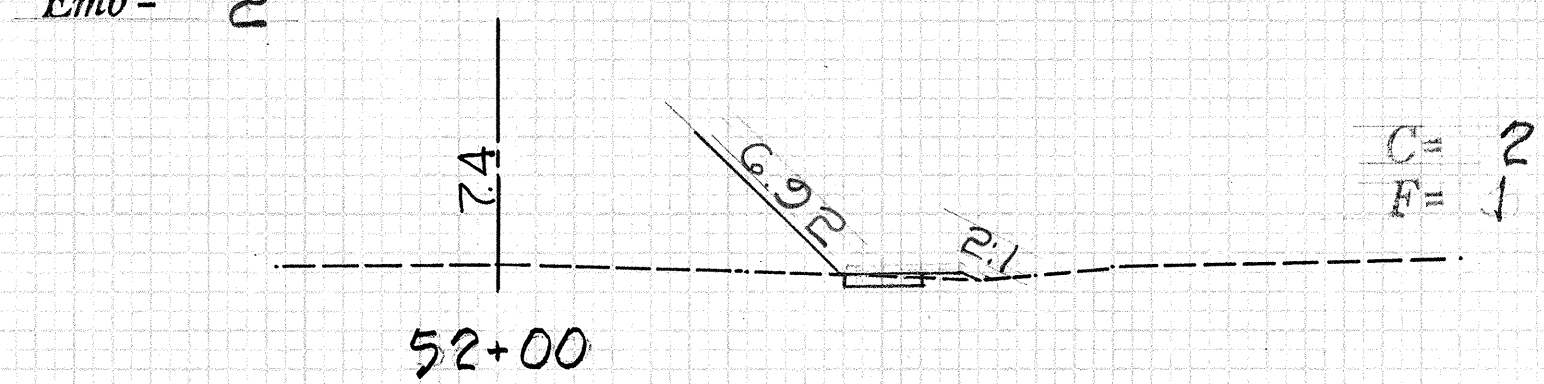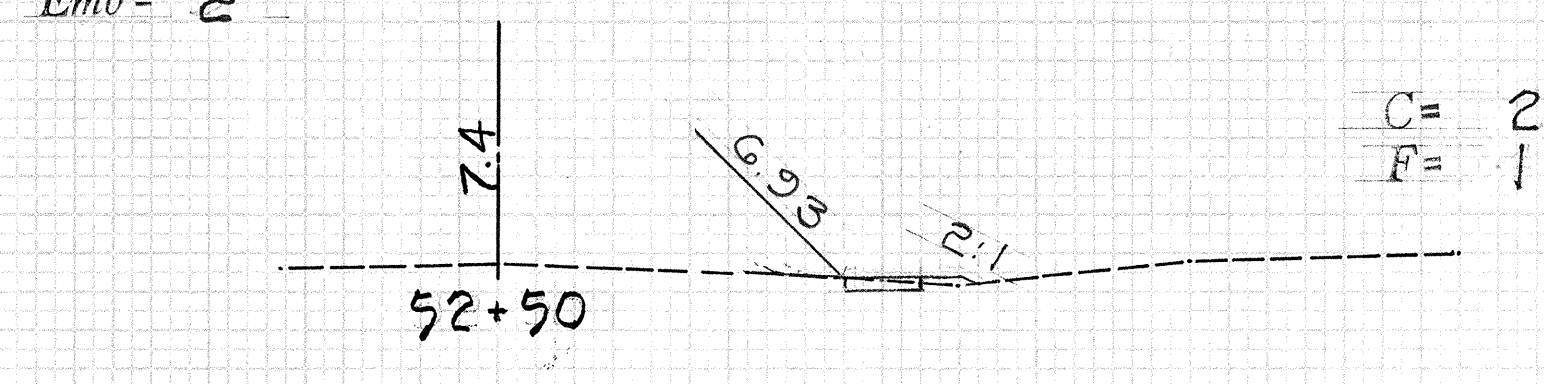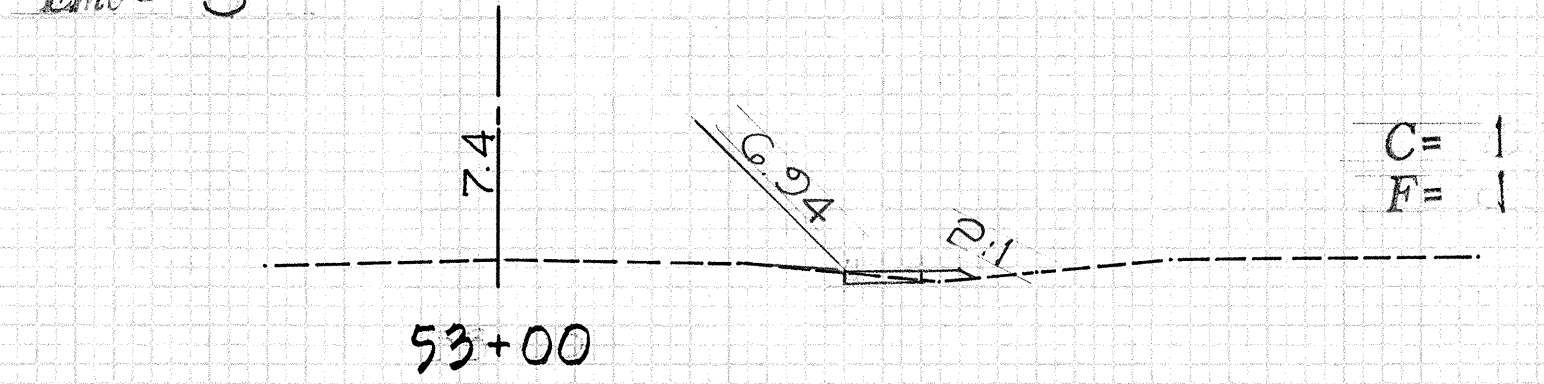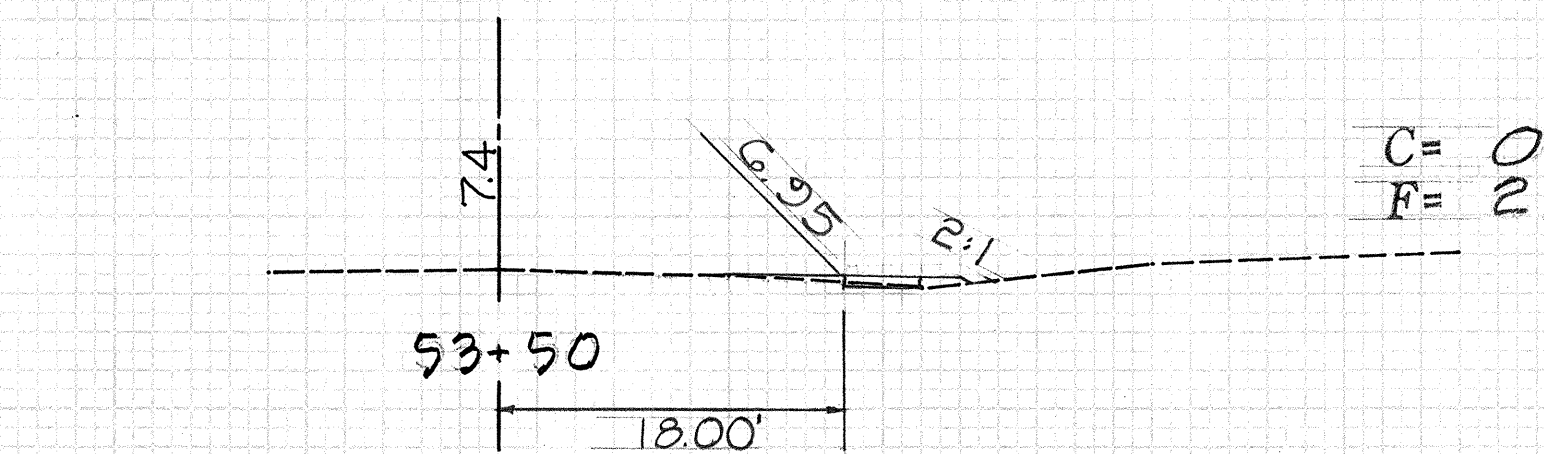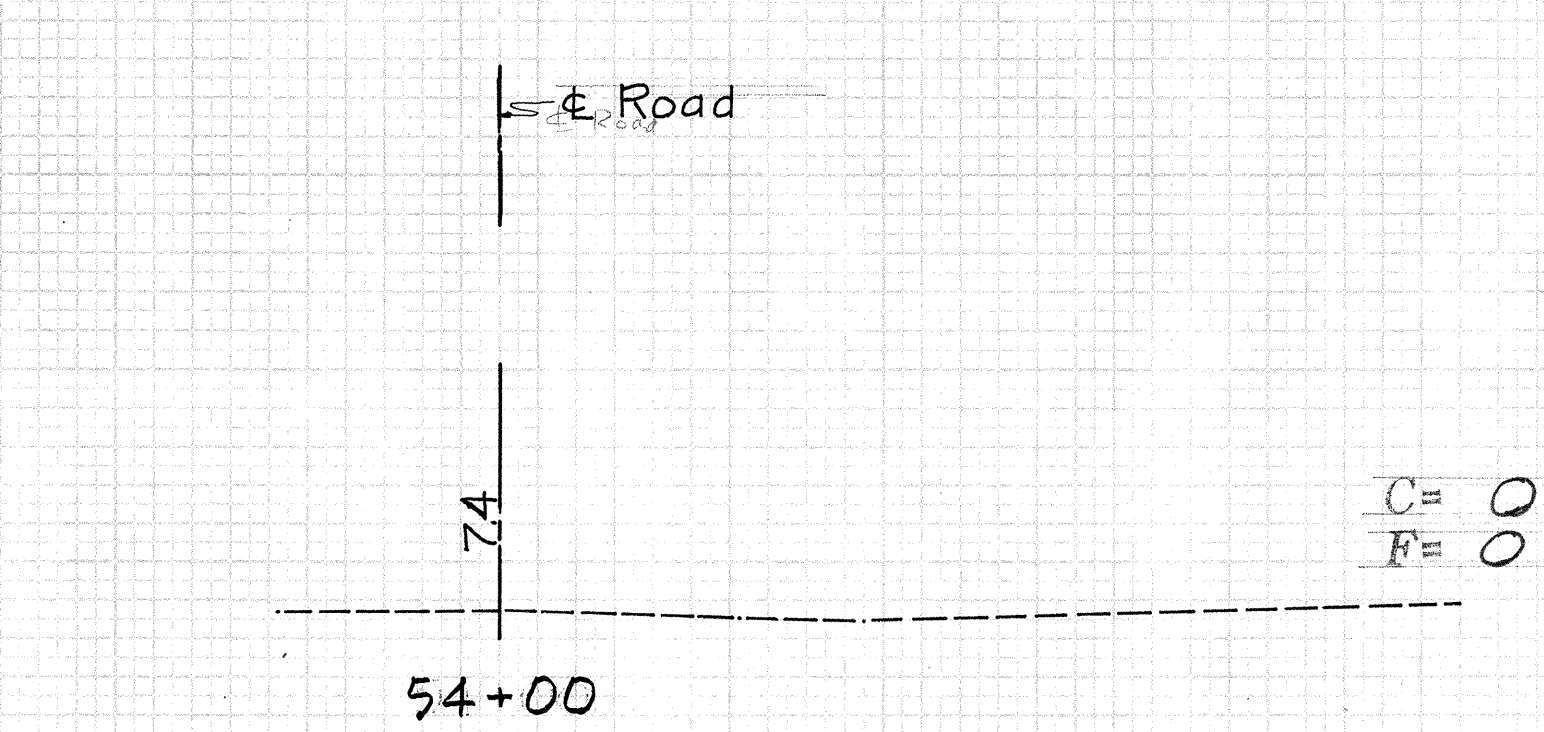


Exc = 0
Emb = 0

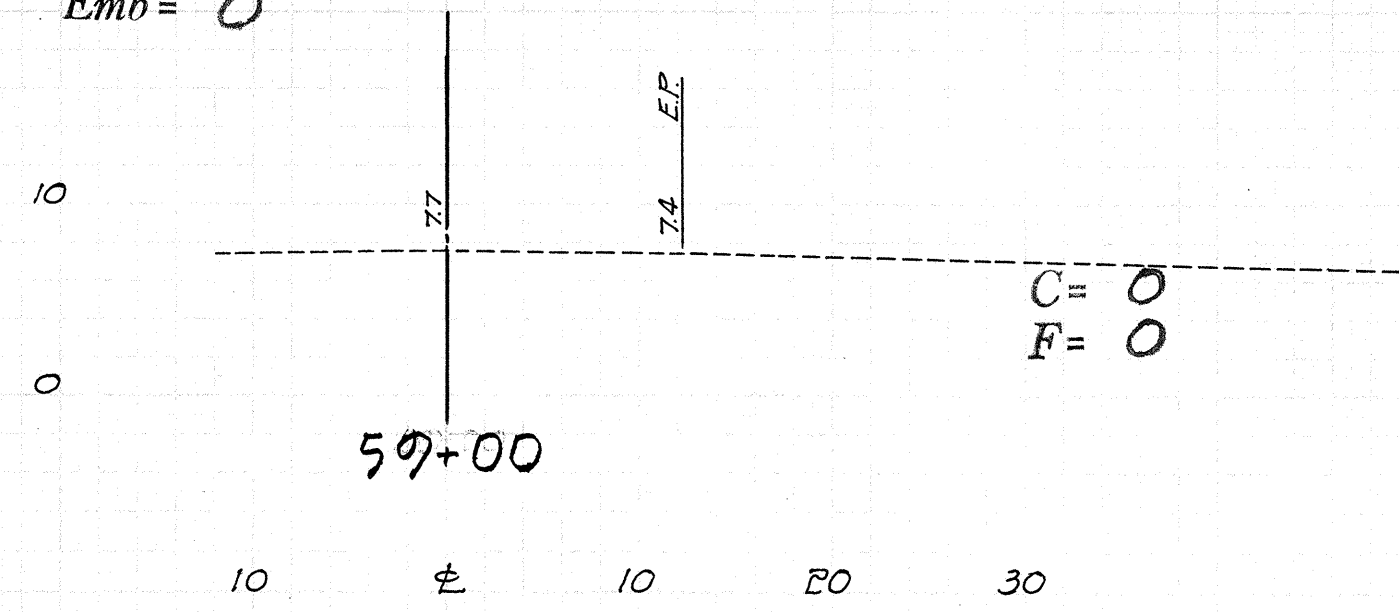


Scale: 1"=10' Bothways


Exc = 0
Emb = 5

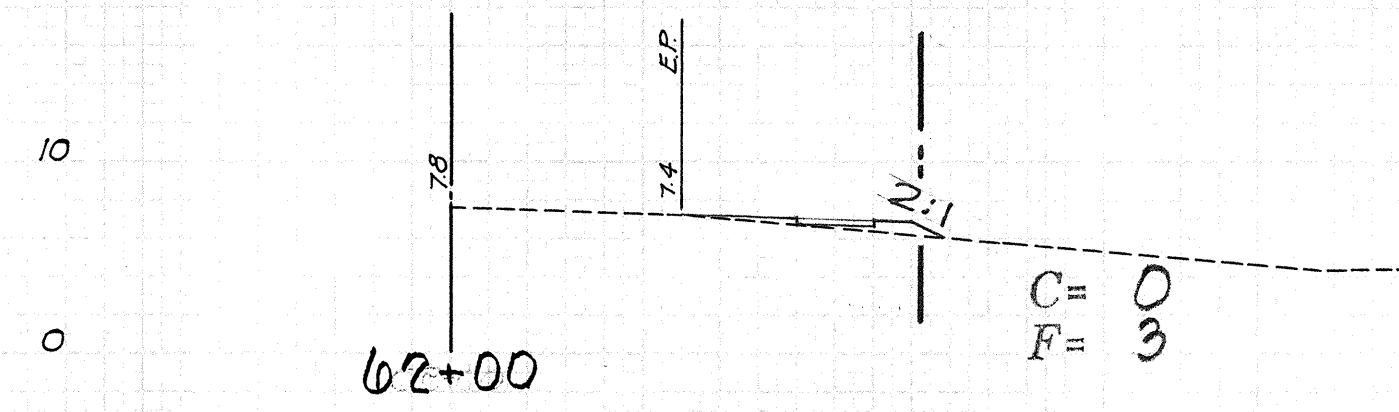


Exc = 0
Emb = 7

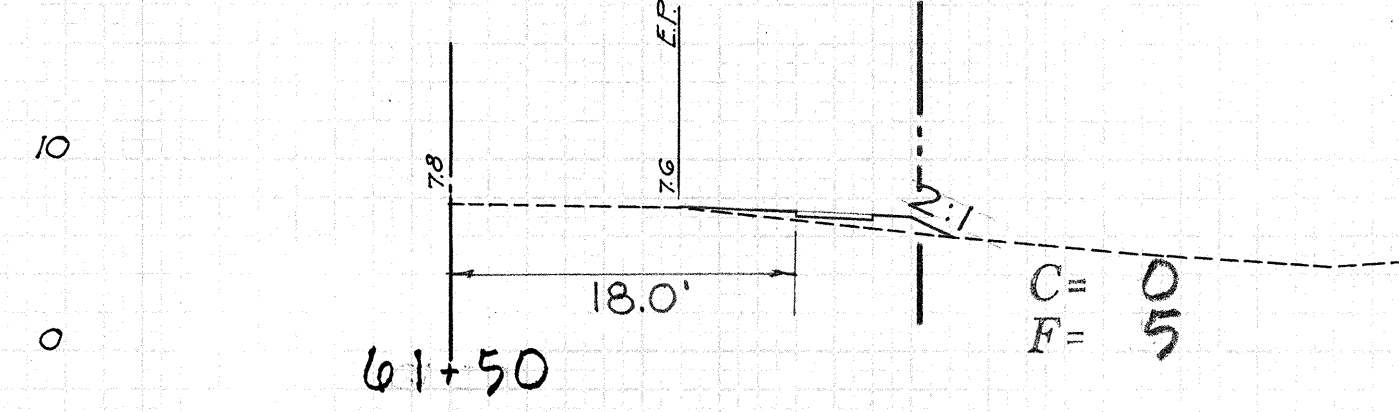


Exc = 1
Emb = 9

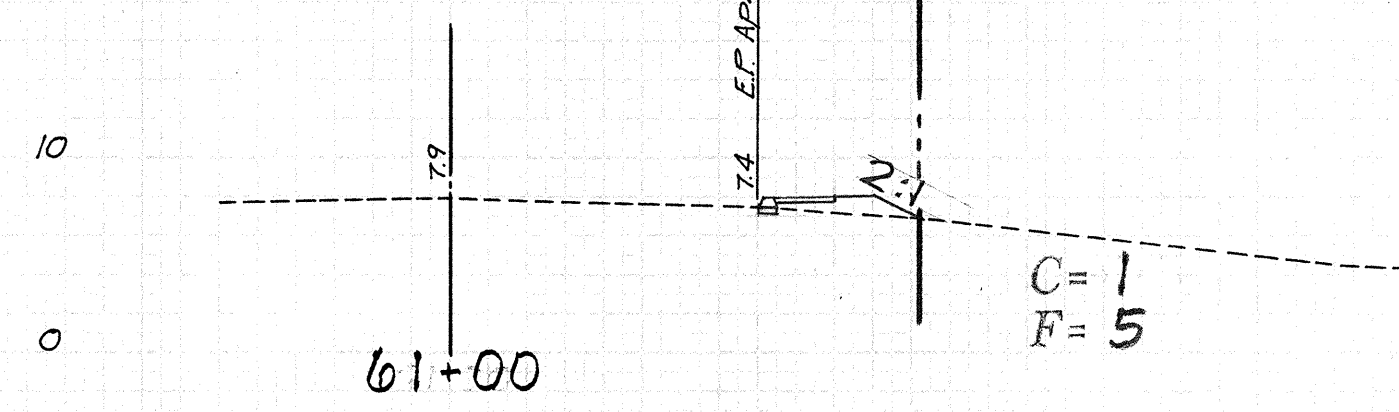


Exc = 2
Emb = 11

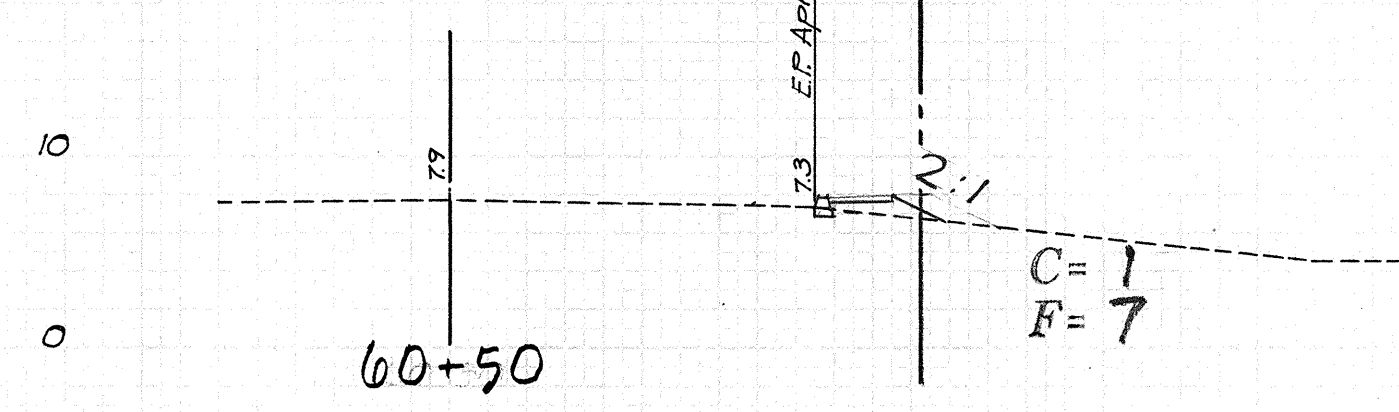


Exc = 0
Emb = 0

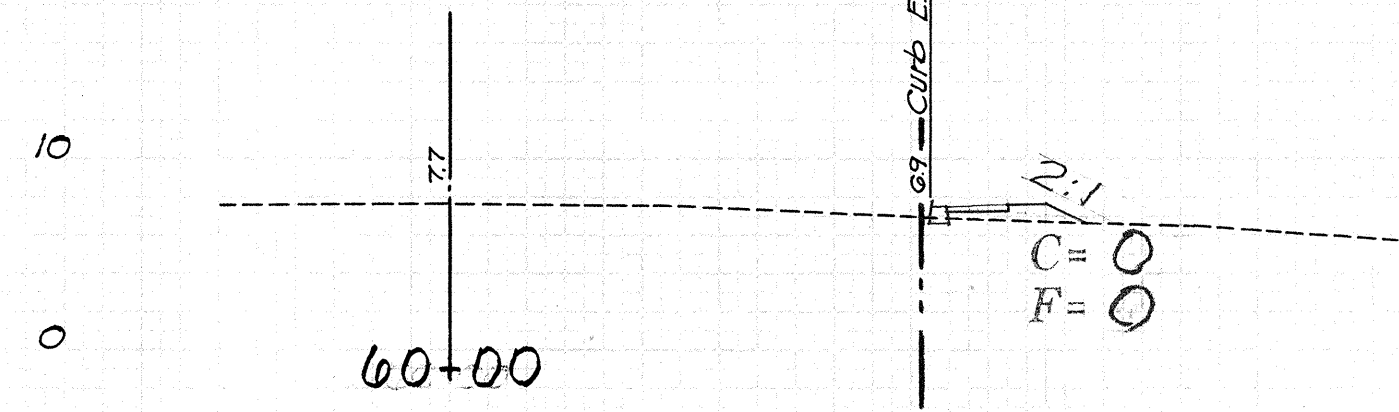


Exc = 0
Emb = 0

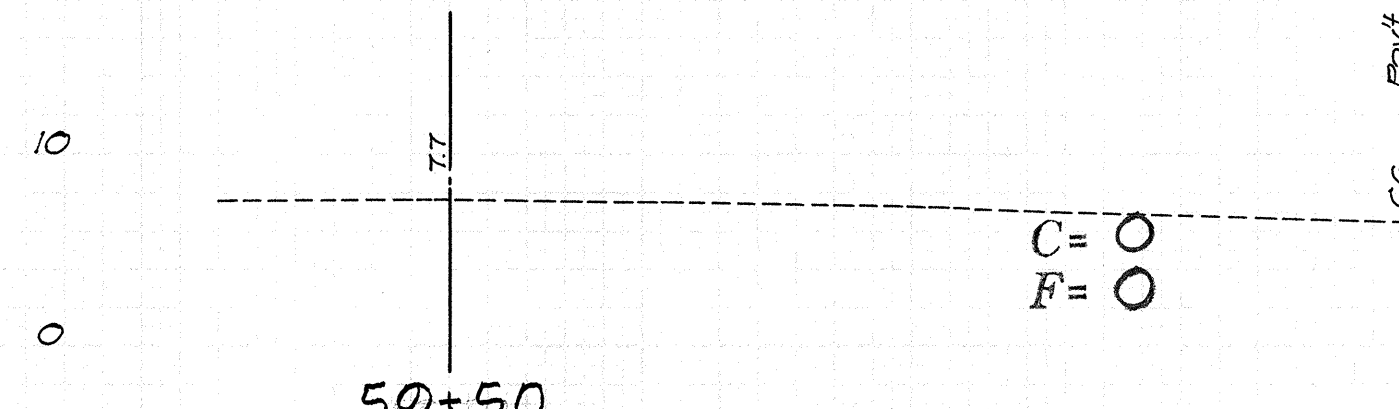


Exc = 1
Emb = 2

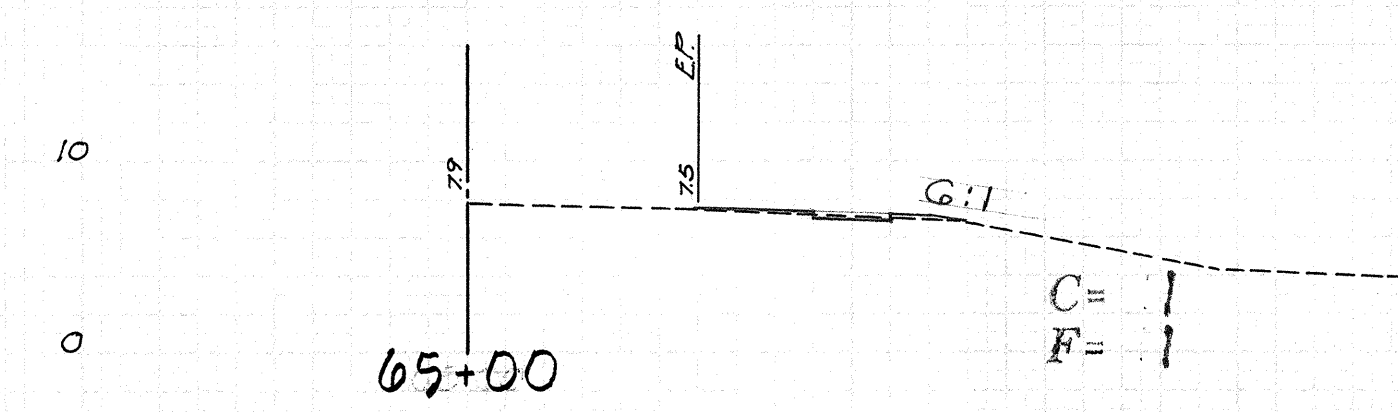


Exc = 1
Emb = 4

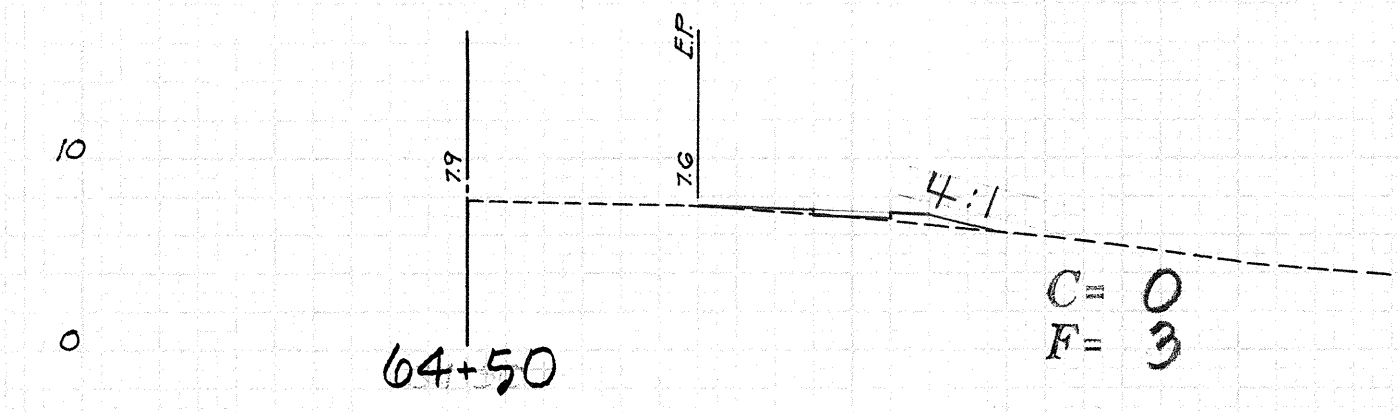


Exc = 0
Emb = 8

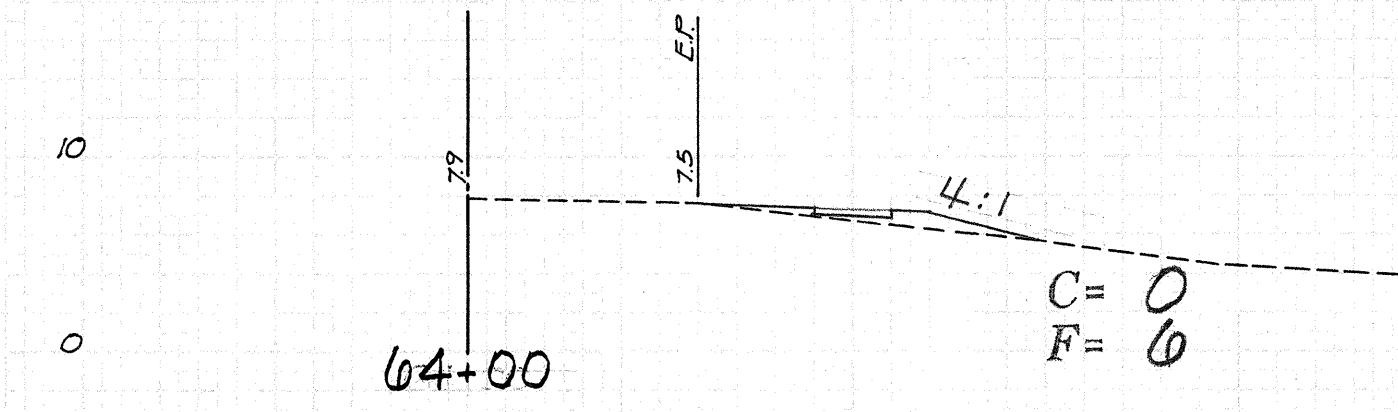


Exc = 0
Emb = 10

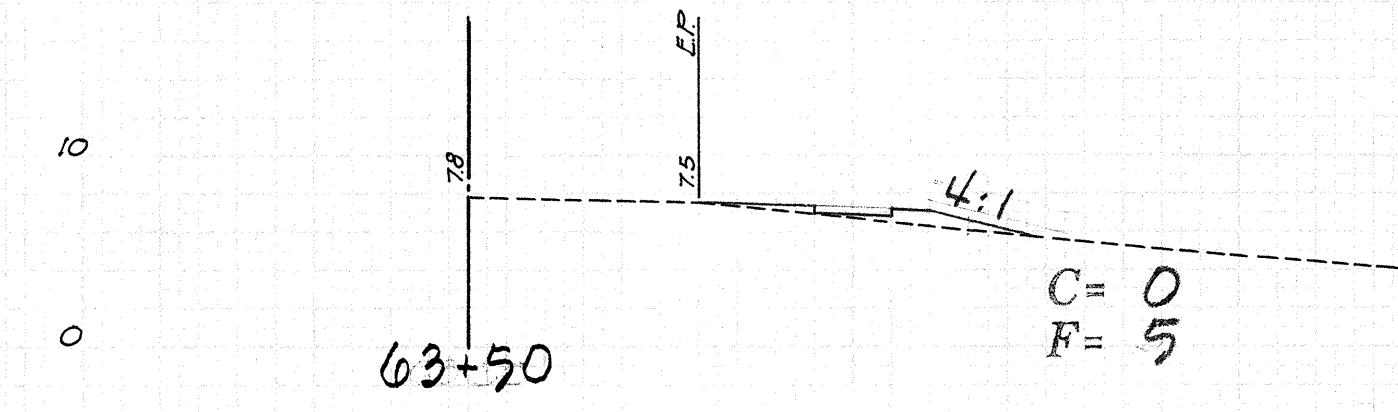


Exc = 0
Emb = 6

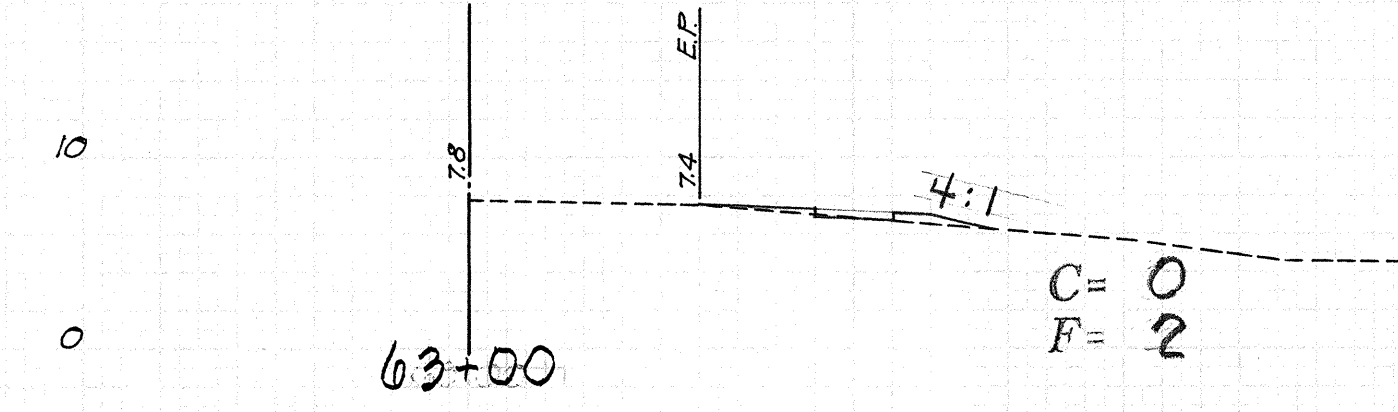


Exc = 0
Emb = 4

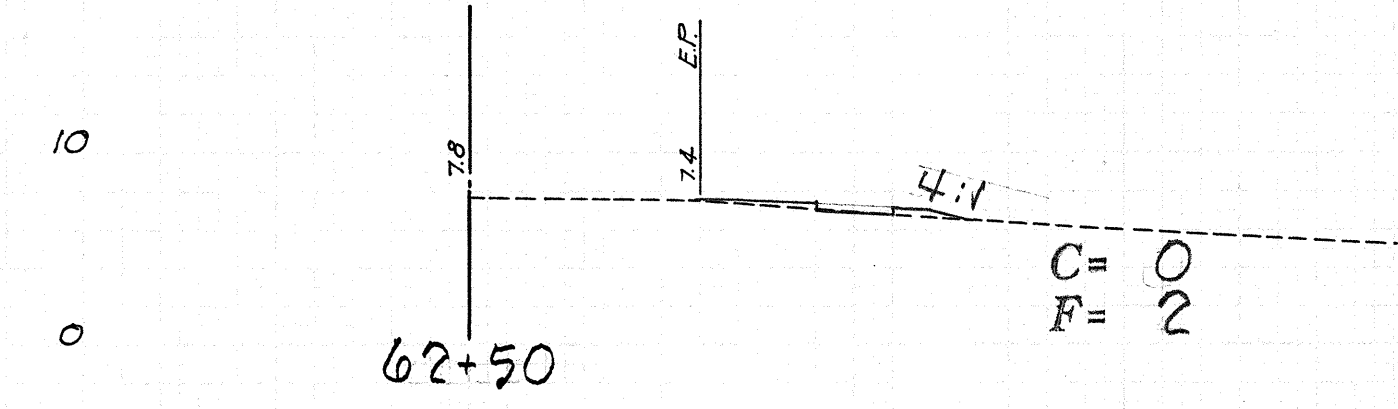


Exc = 1
Emb = 6

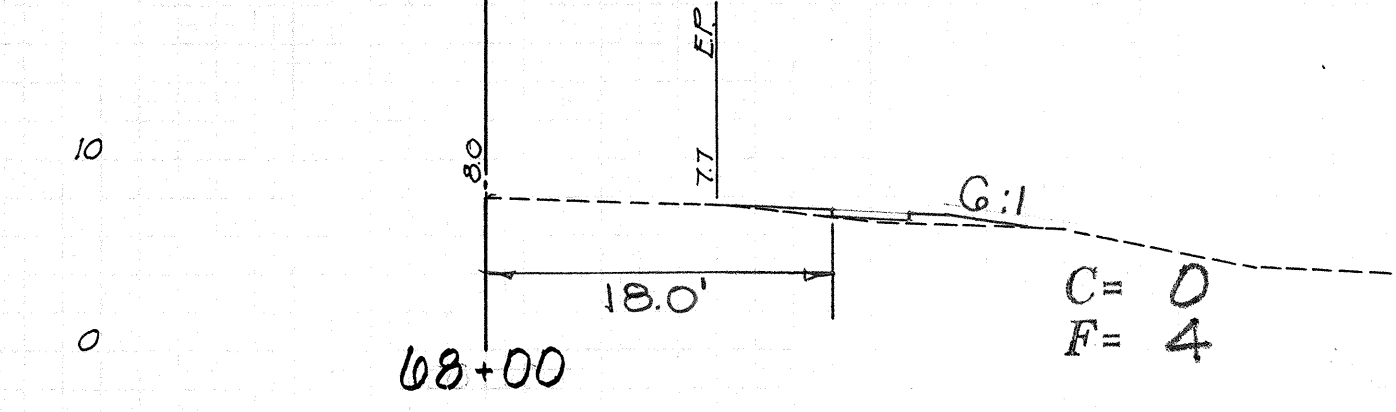


Exc = 0
Emb = 7

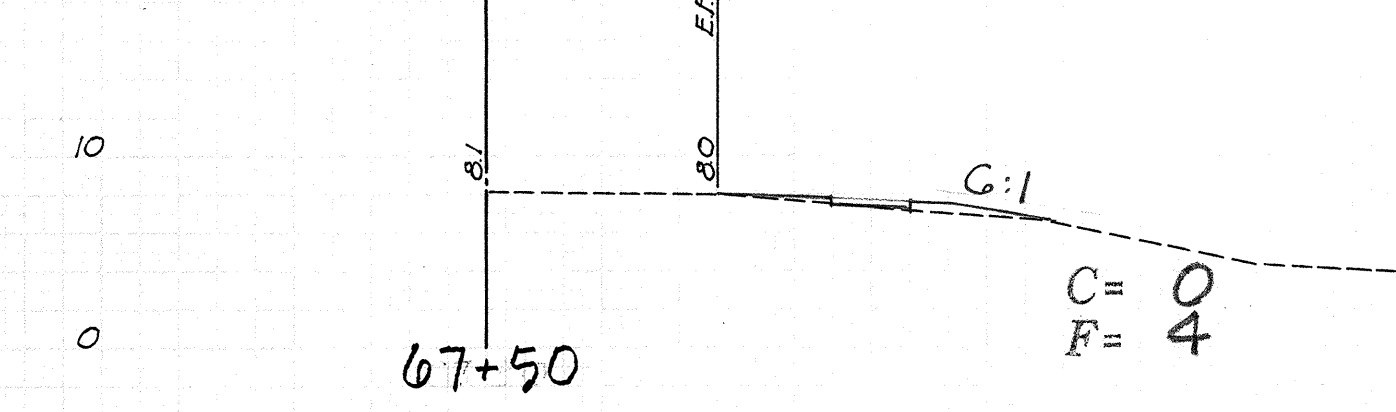


Exc = 1
Emb = 6

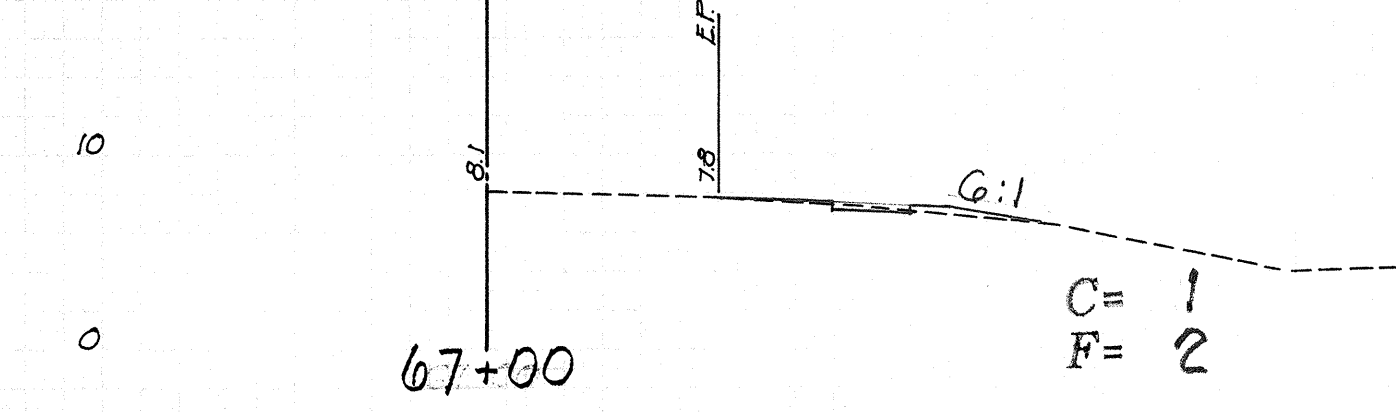


Exc = 1
Emb = 5

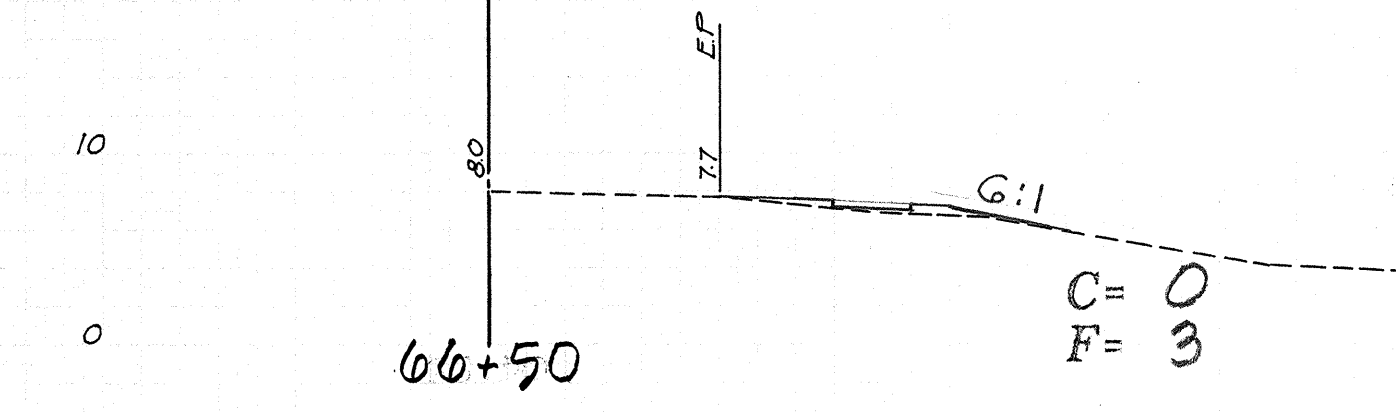

Exc = 0
Emb = 6

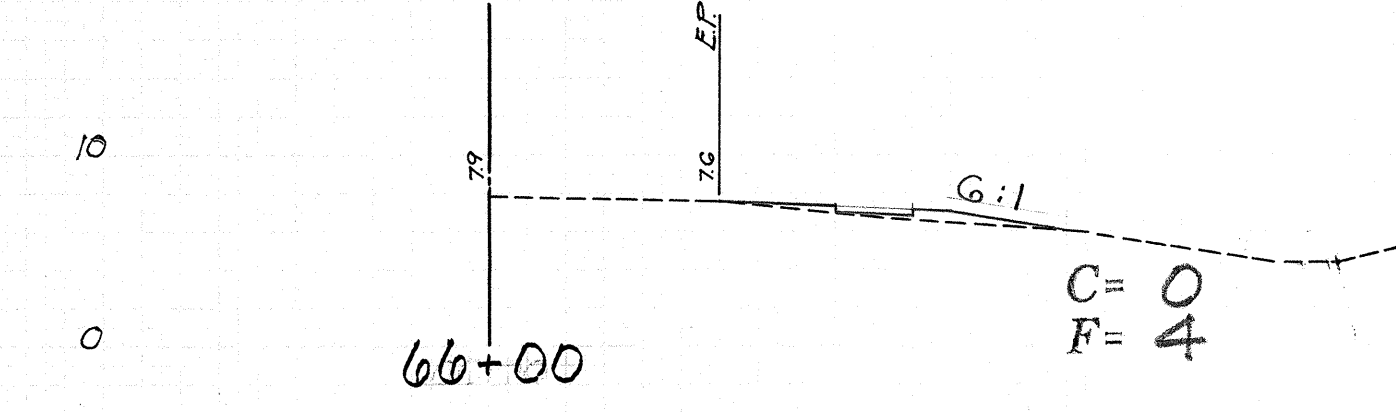

Exc = 0
Emb = 5

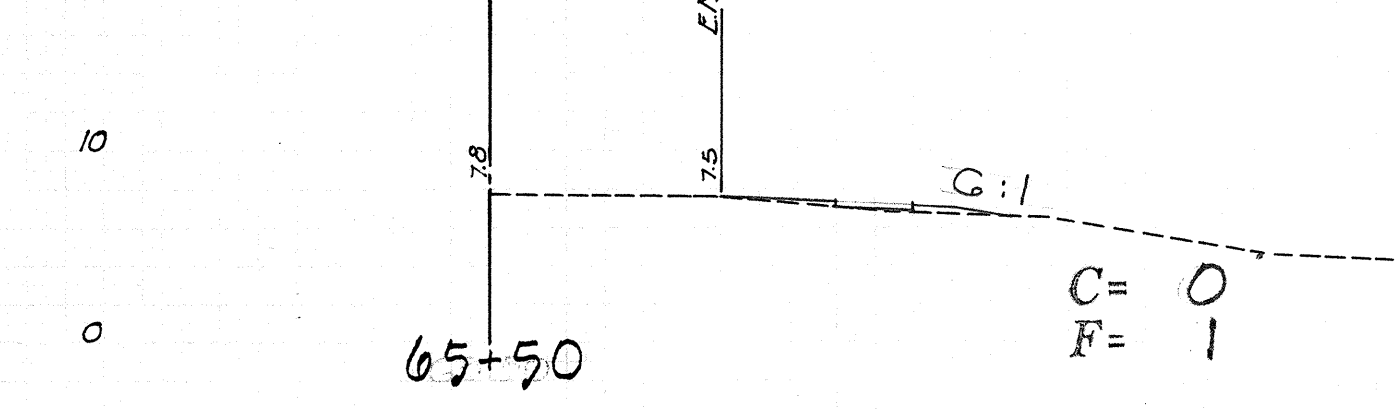

FED. ROAD DIST. NO.	STATE	FED. AID PROJ. NO.	FISCAL YEAR	SHEET NO.	TOTAL SHEETS
HAWAII	HAW.	PD 69-464	1972	22	23

EXCEPTION:
STA. 57+25 TO STA. 60+25


57+25

C = 1
F = 0


Exc = 1
Emb = 0

FED. ROAD DIST. NO.	STATE	PROJ. NO.	FISCAL YEAR	SHEET NO.	TOTAL SHEETS
HAWAII	HAW.	BD69-464	1972	23	23


Exc = 0
Emb = 5

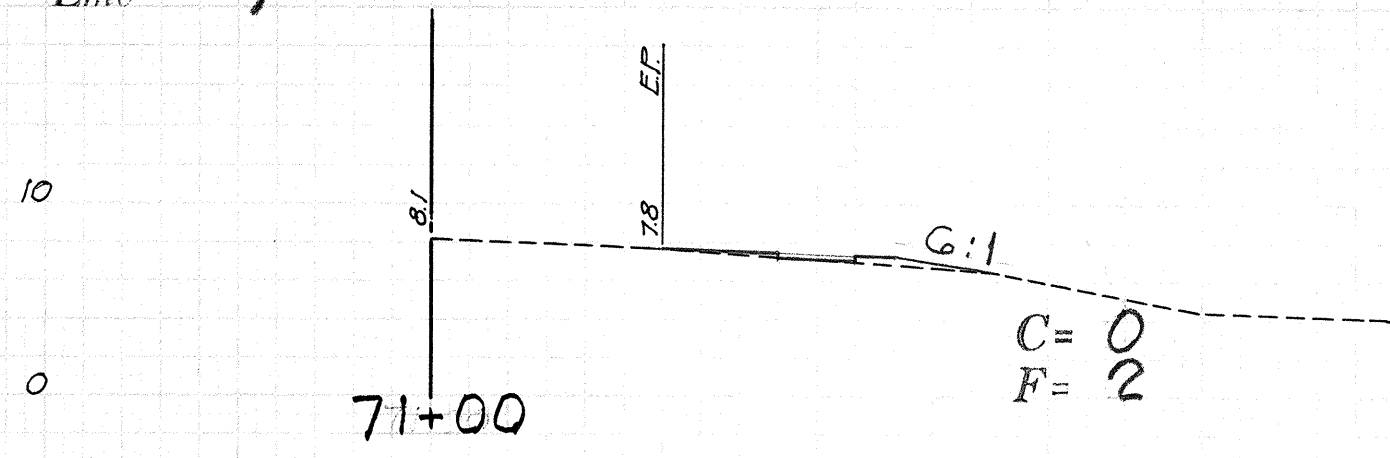


Exc = 0
Emb = 6

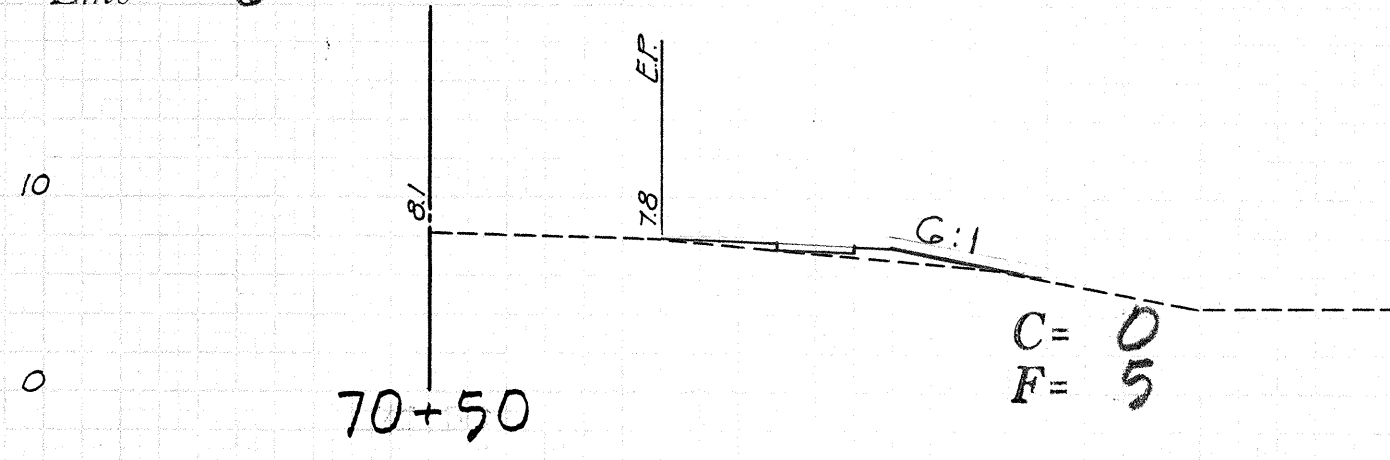


Exc = 0
Emb = 9

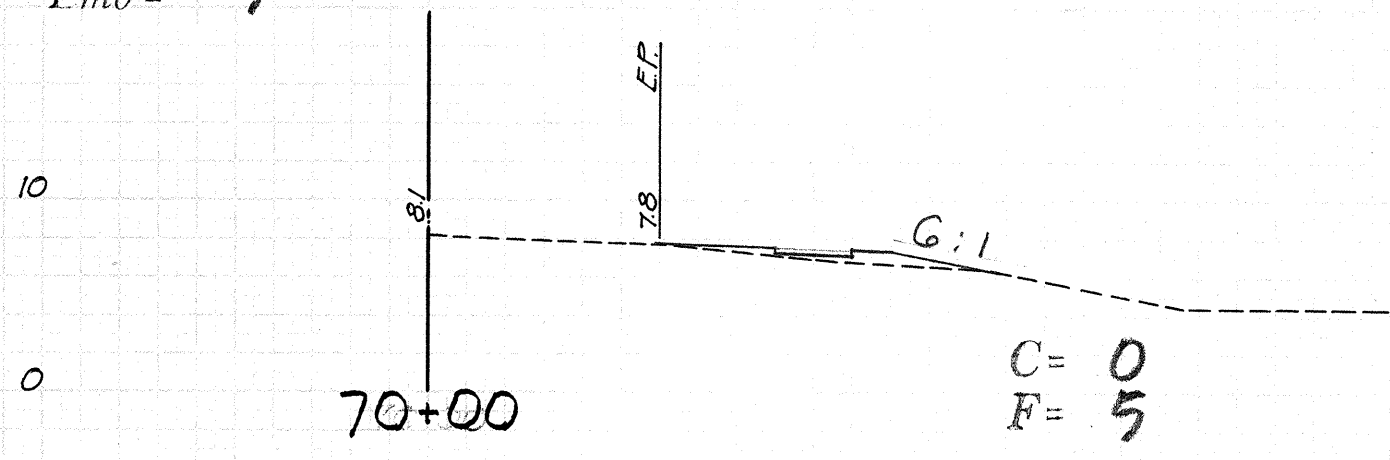


Exc = 1
Emb = 6

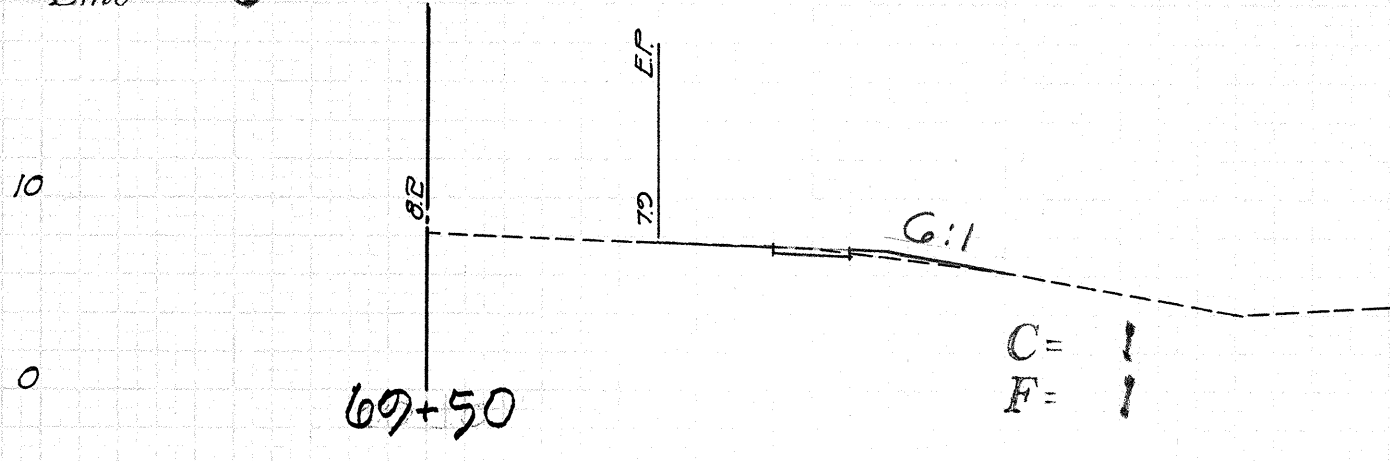


Exc = 1
Emb = 6

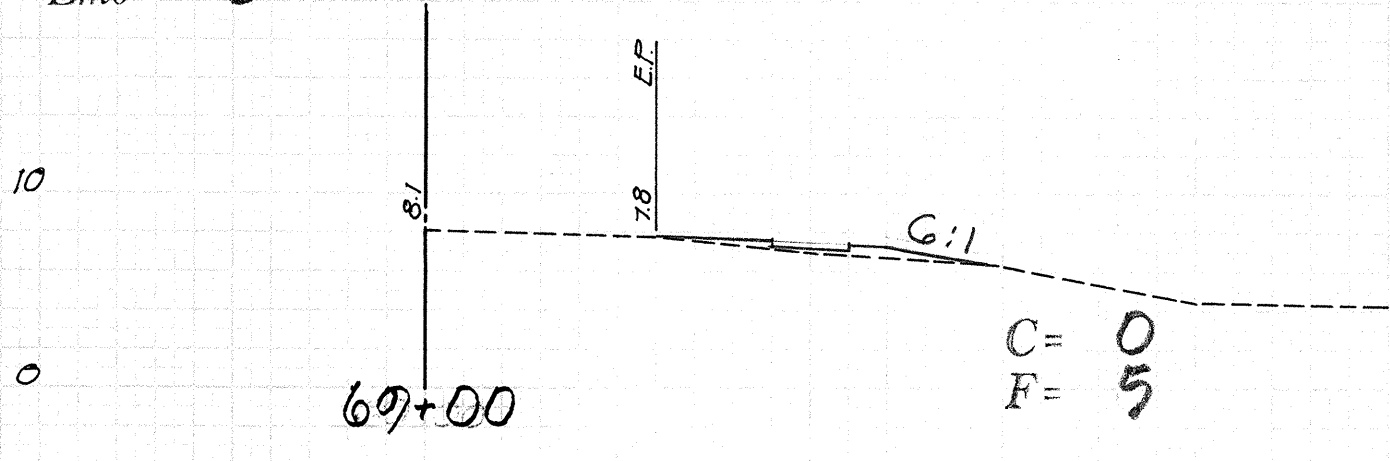


Exc = 1
Emb = 6

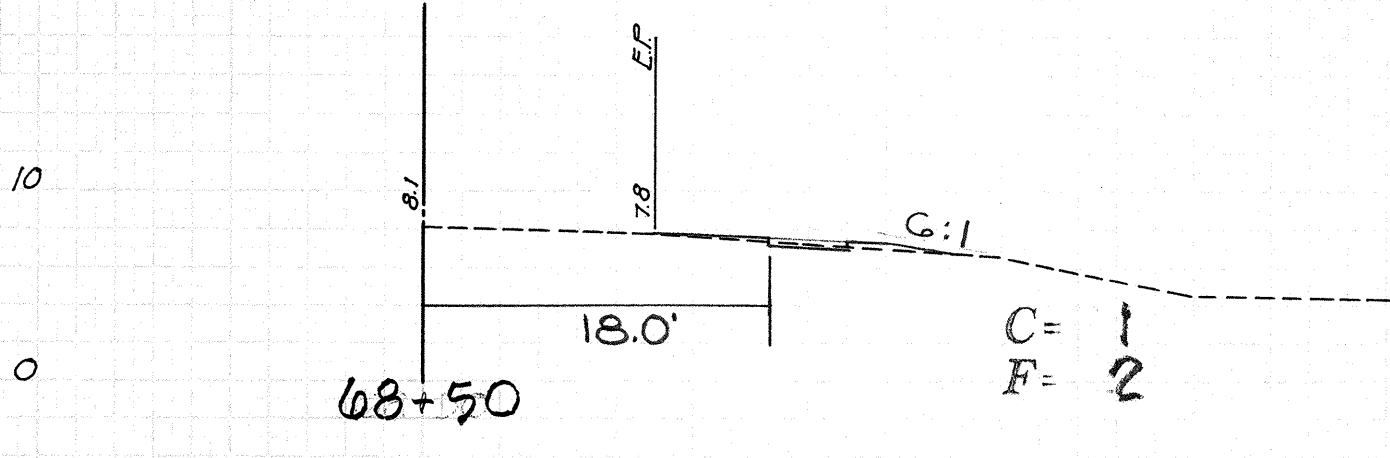


Exc = 0
Emb = 12

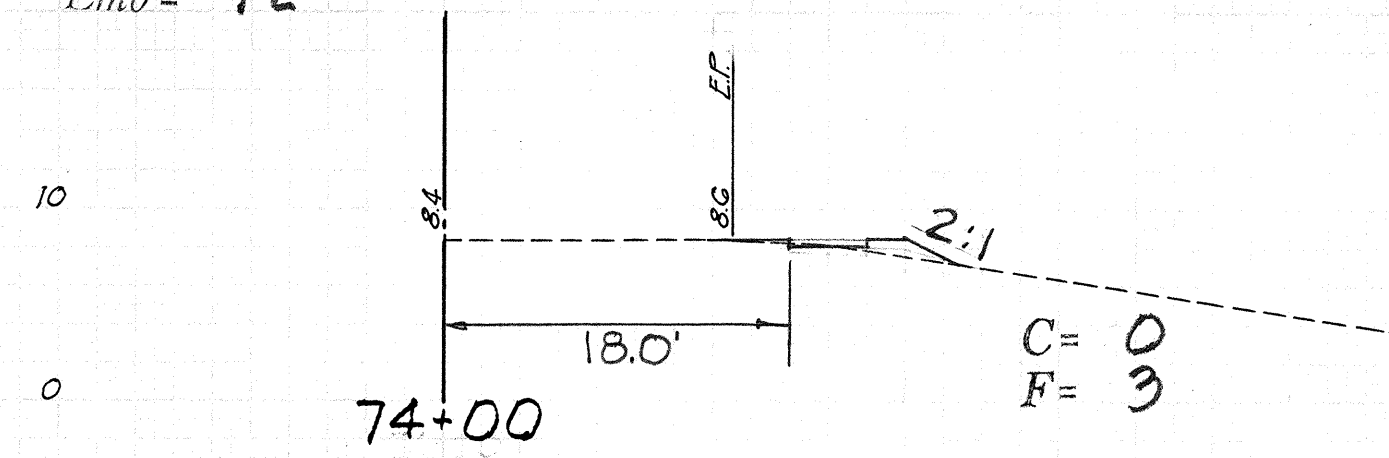


Exc = 1
Emb = 7

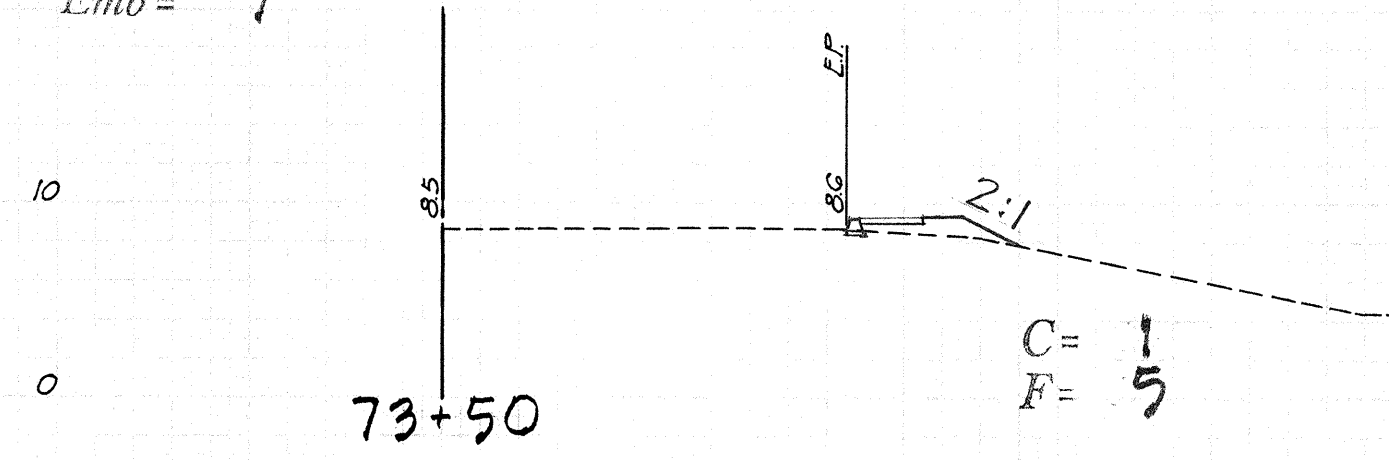


Exc = 2
Emb = 13

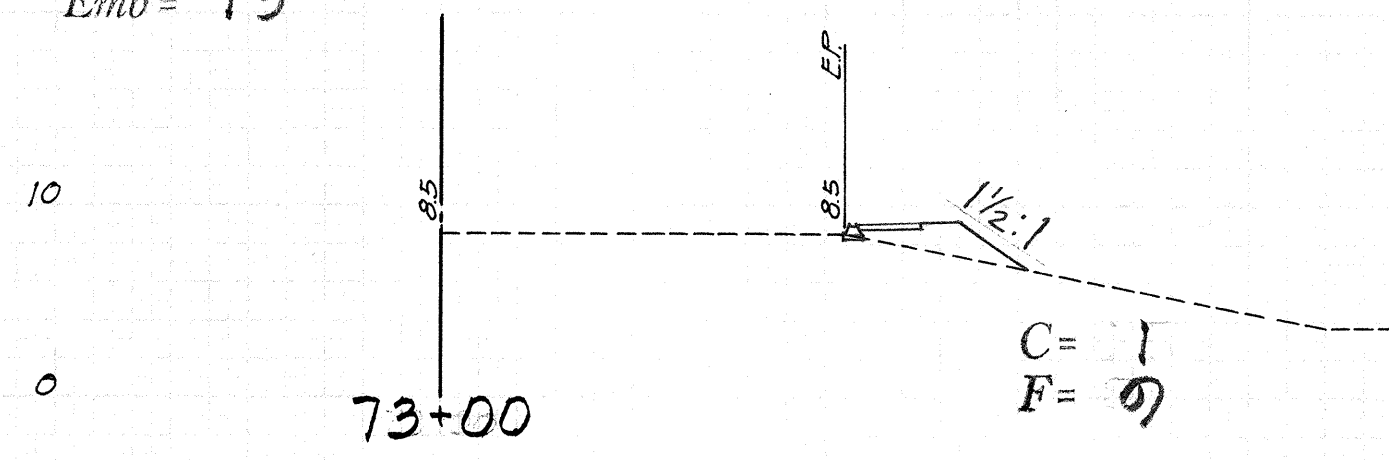


Exc = 2
Emb = 14

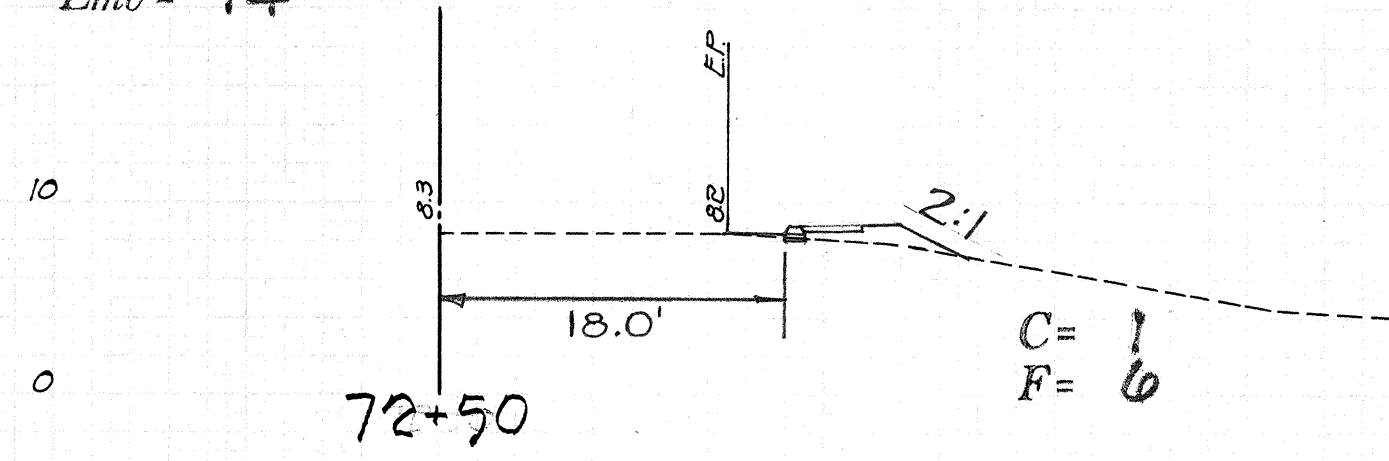


Exc = 2
Emb = 7

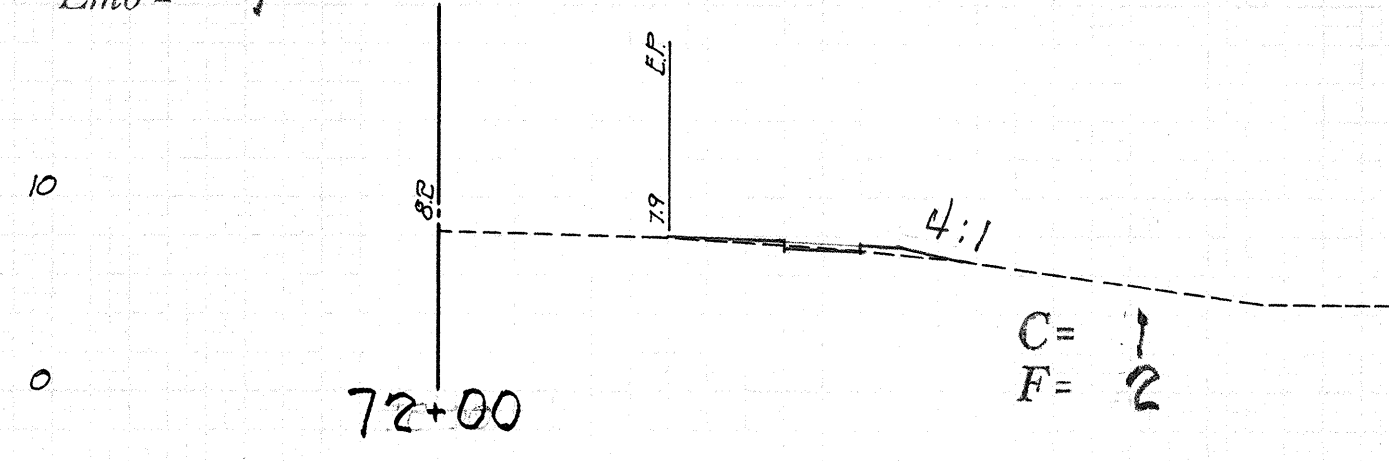


Exc = 1
Emb = 5

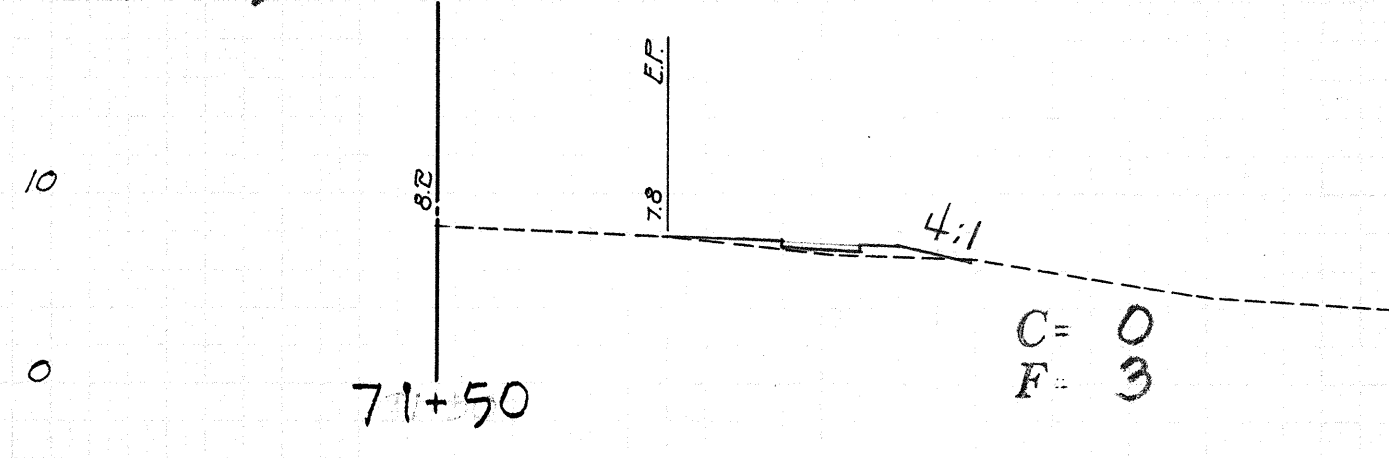


Exc = 2
Emb = 8

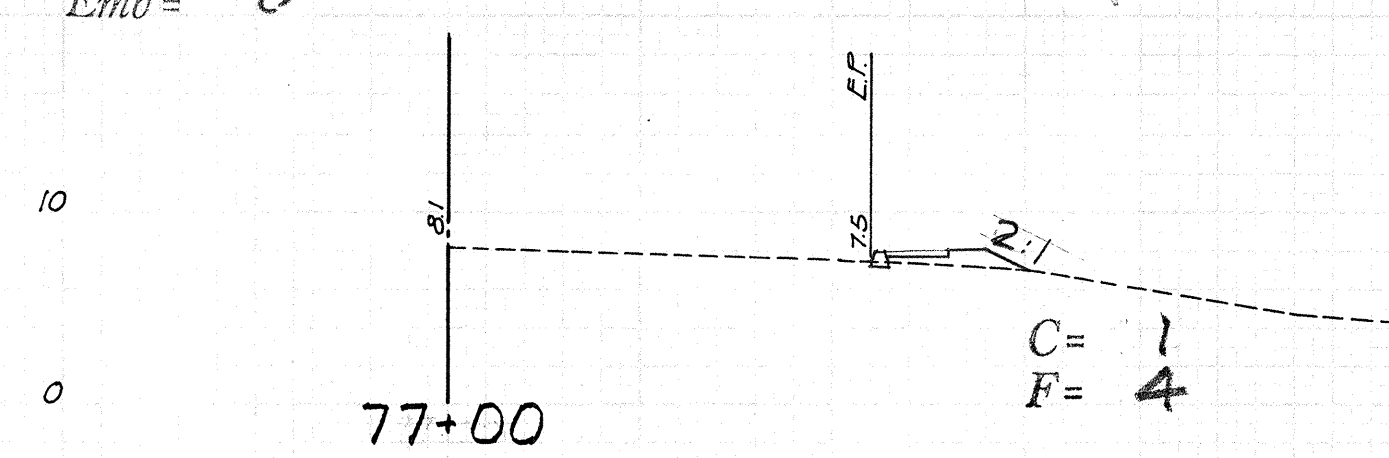


Exc = 2
Emb = 7

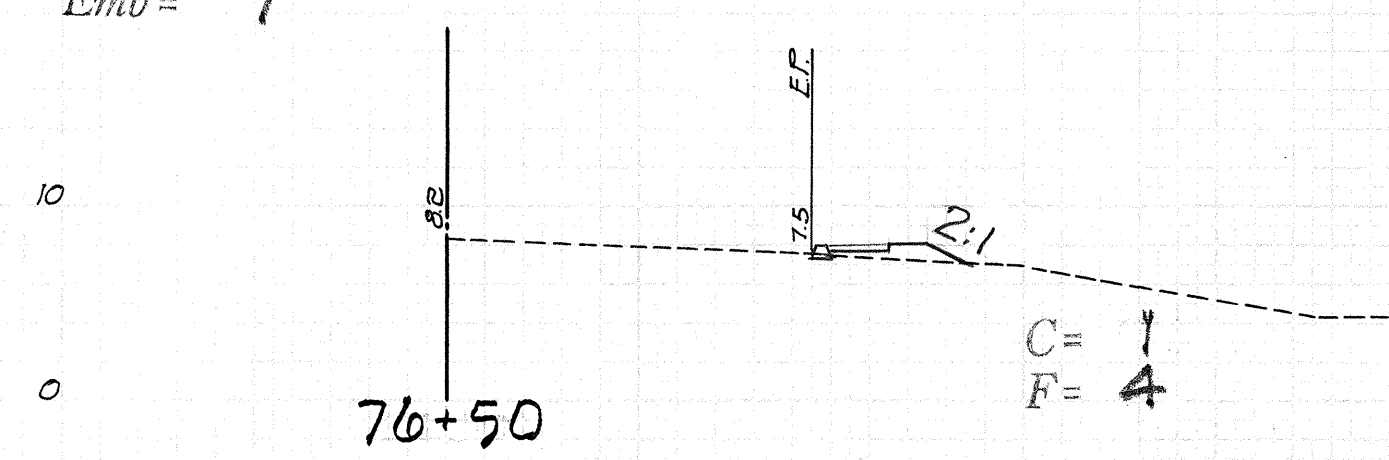


Exc = 3
Emb = 5

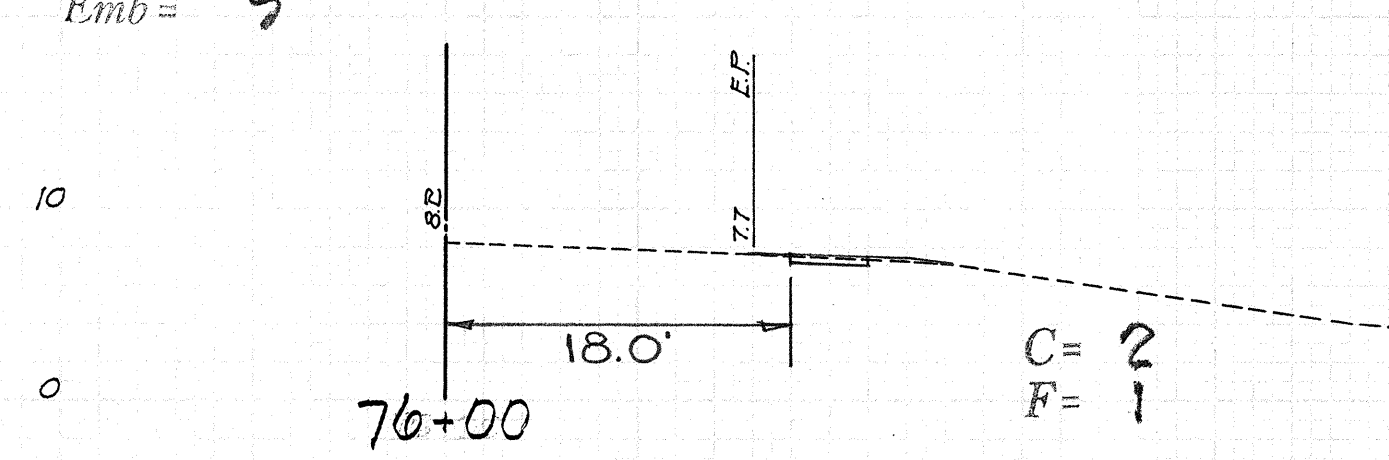


Exc = 2
Emb = 6

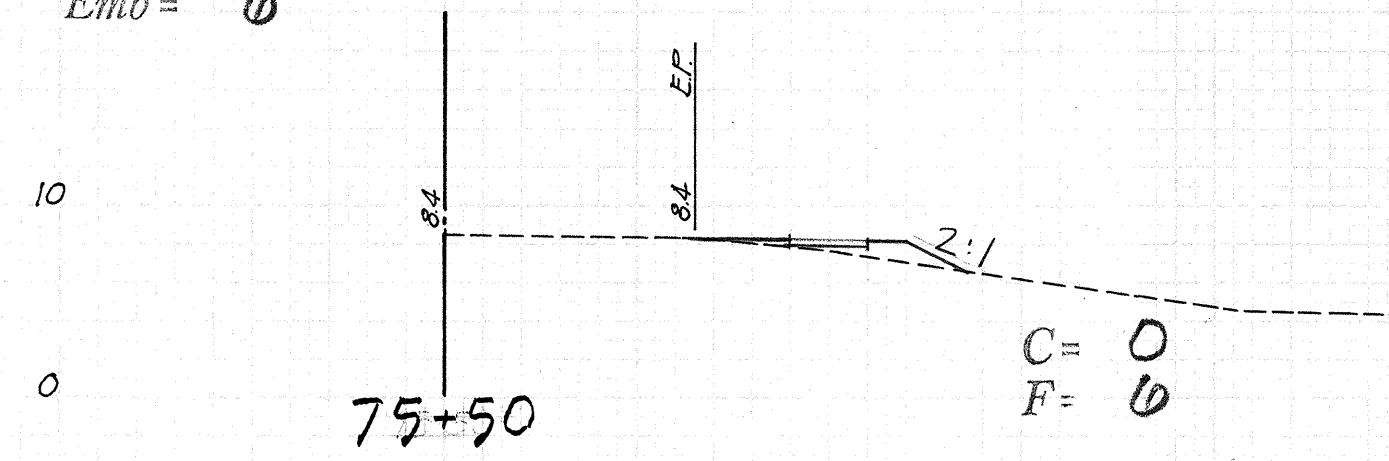


Exc = 0
Emb = 15

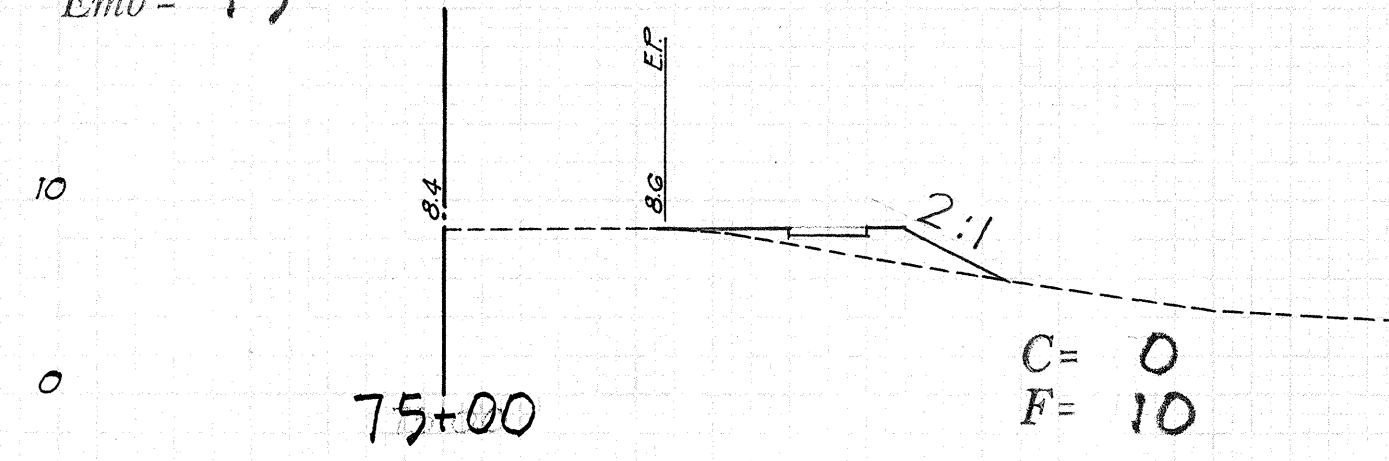


Exc = 0
Emb = 19

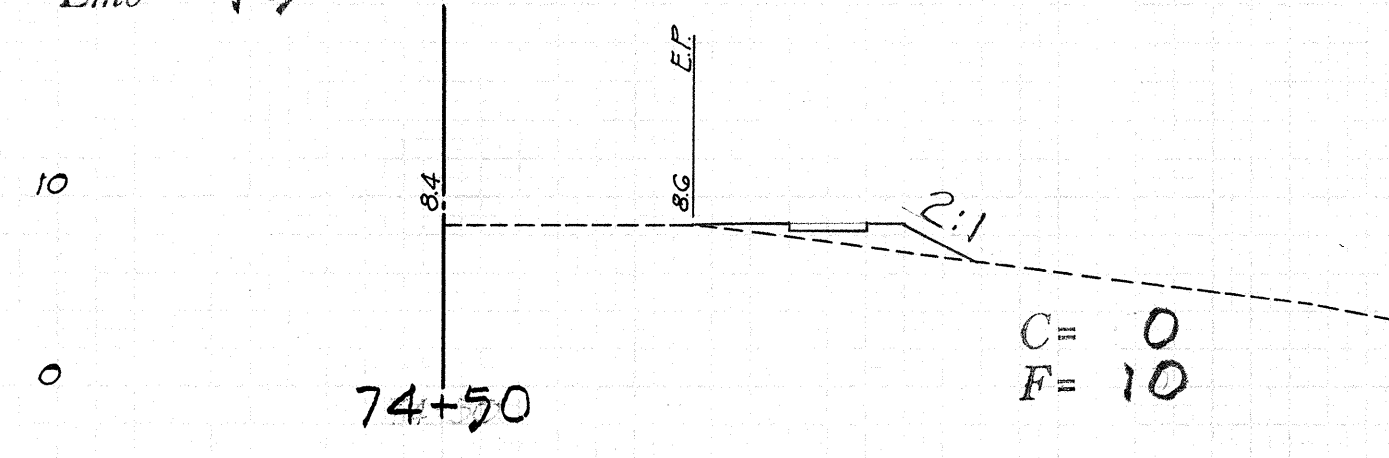


Exc = 0
Emb = 0

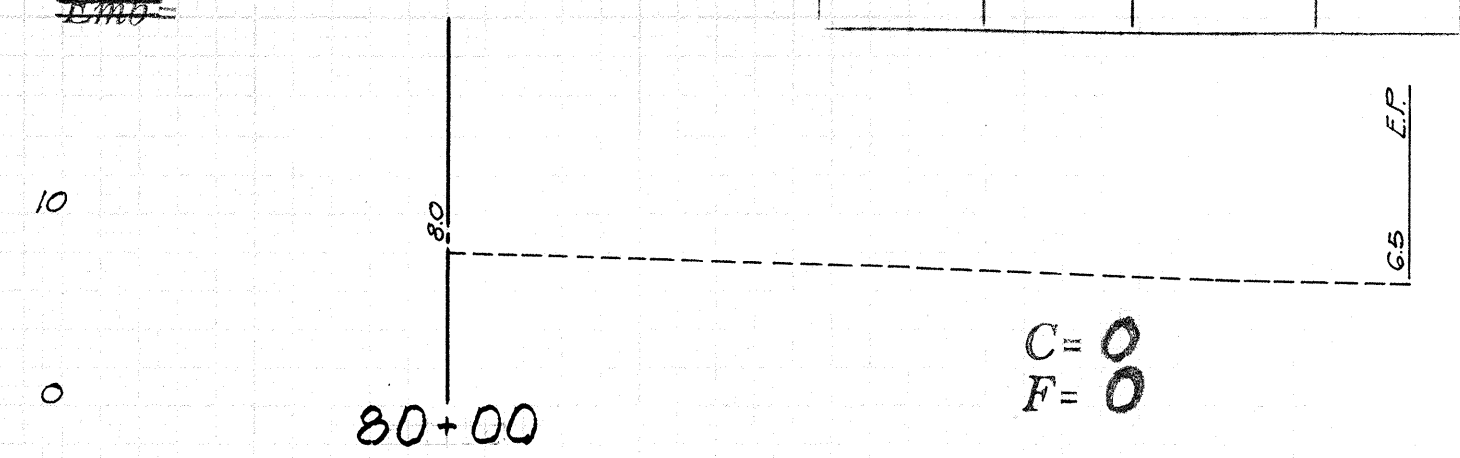


Exc = 0
Emb = 0

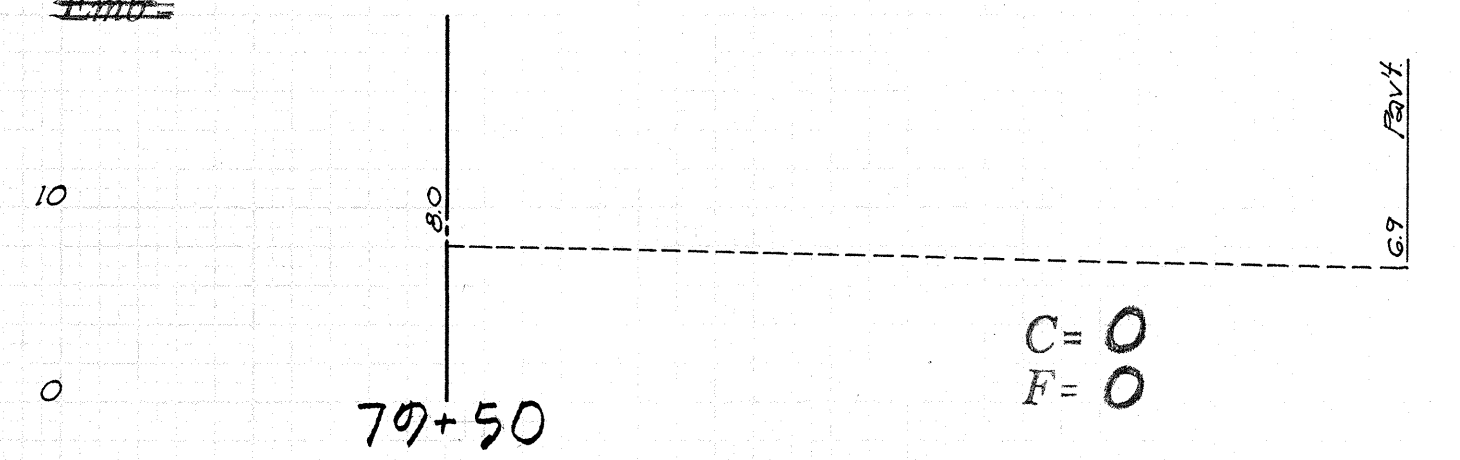


Exc = 0
Emb = 0

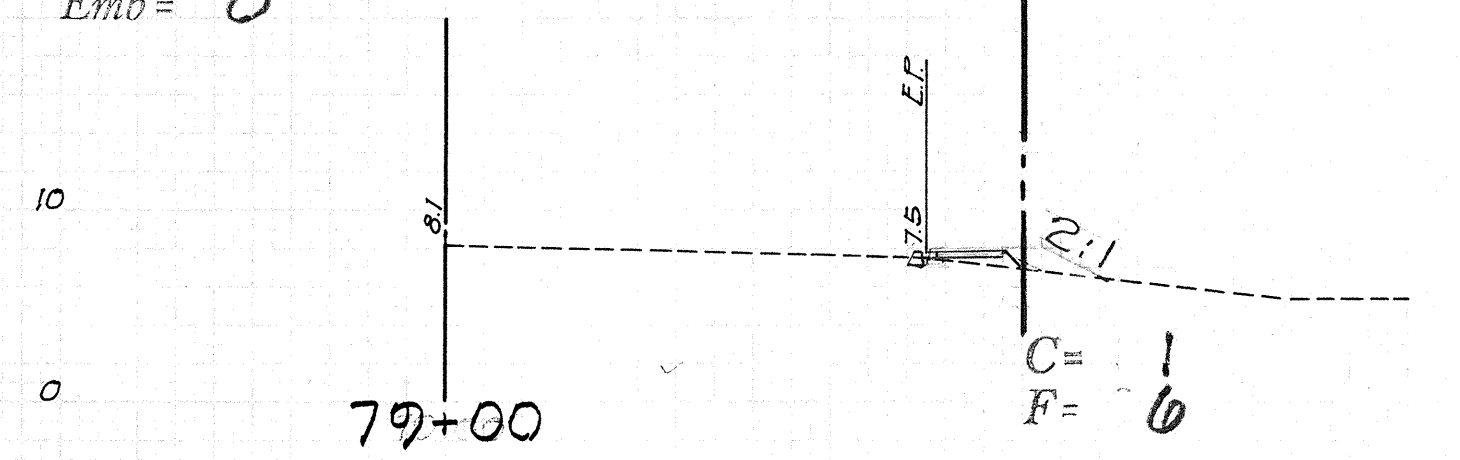


Exc = 2
Emb = 9

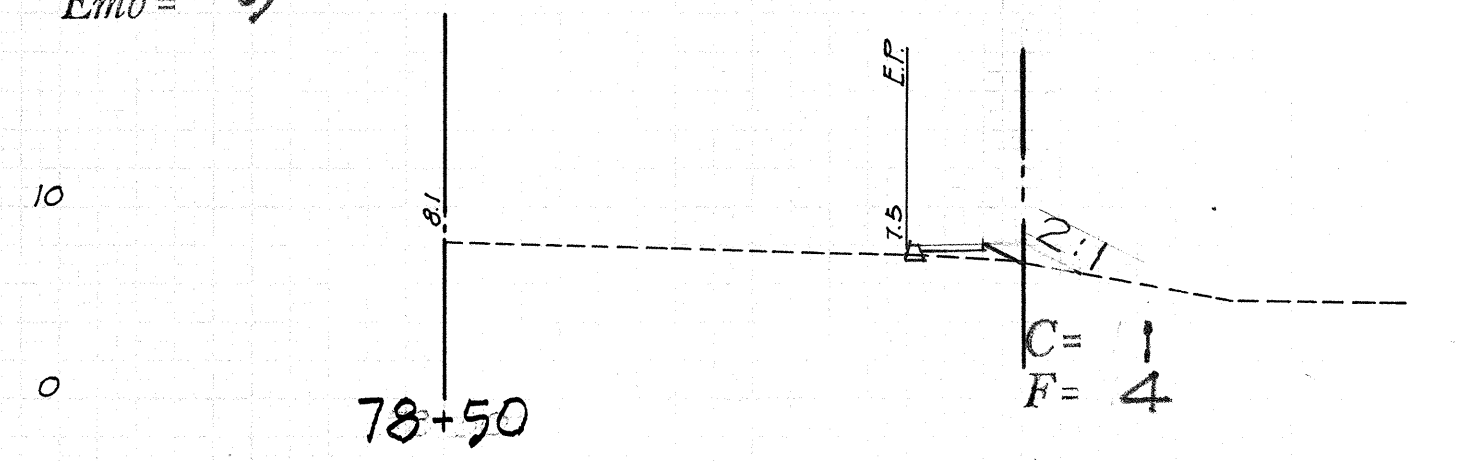

Exc = 2
Emb = 8

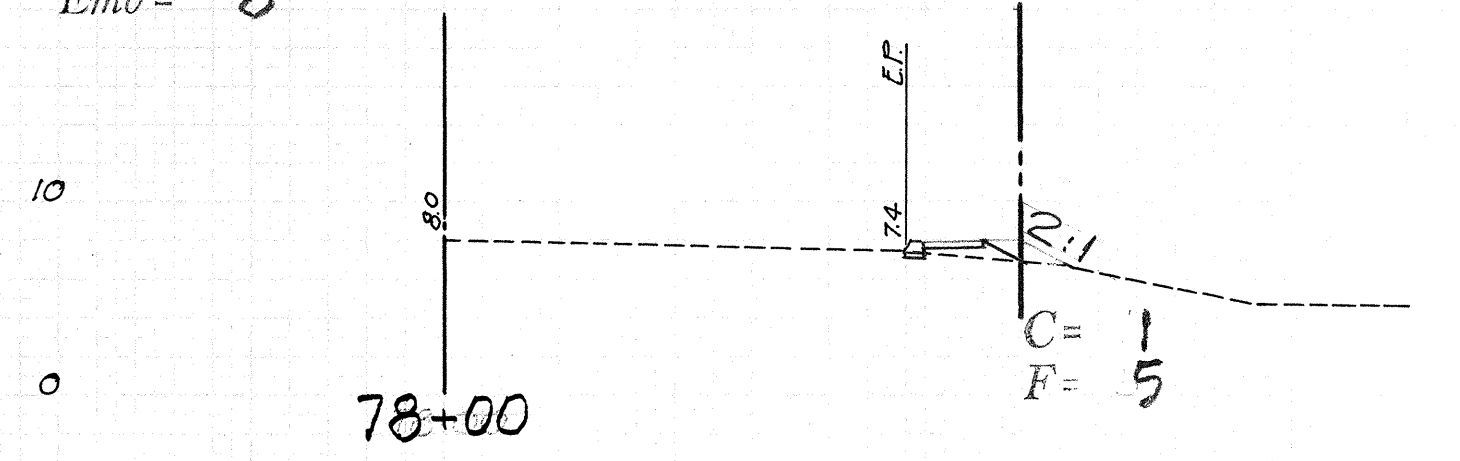

Exc = 2
Emb = 9

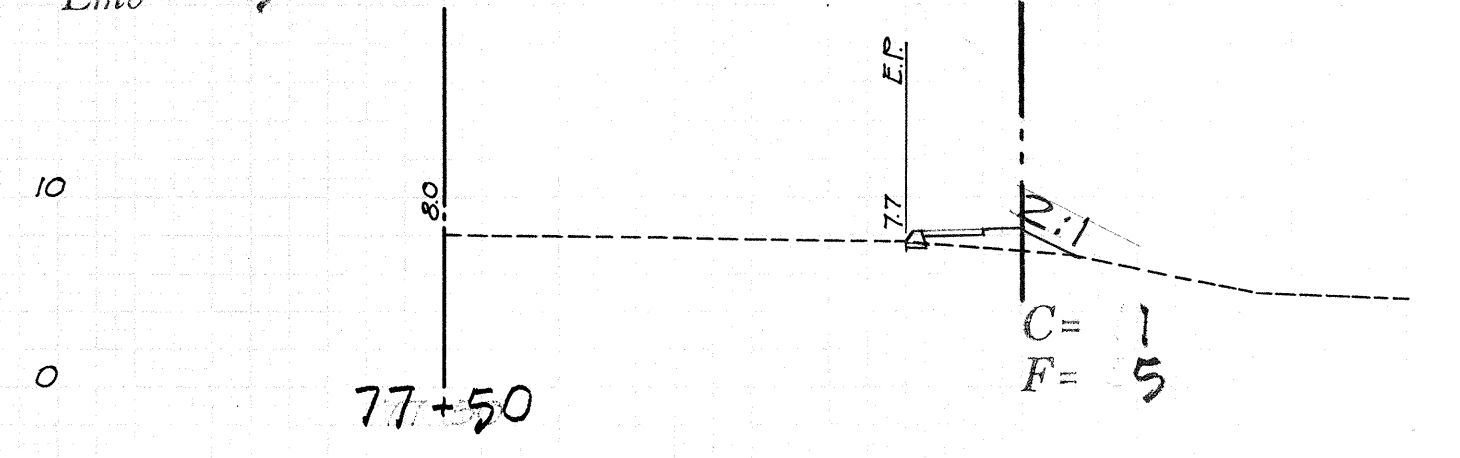

Scale: 1" = 10' Bothways